



GALLAGHER
A COMMUNITY ORIENTED COMPANY

ADDENDUM NO. 1

TO THE CONTRACT DOCUMENTS FOR:

CRANDALL ISD – PERFORMING ARTS CENTER ADDITION TO CRANDALL HIGH SCHOOL

AUGUST 26, 2024

GENERAL CLARIFICATIONS TO ALL PROPOSERS

1. **CRANDALL ISD – PERFORMING ARTS CENTER ADDITION TO CRANDALL HIGH SCHOOL – DLR GROUP - ADDENDUM NO. 1:** The attached Addendum No. 1 to the Drawings and Specifications for Crandall ISD – Performing Arts Center Addition To Crandall High School, as prepared by DLR Group and dated August 20, 2024 is included in this Addendum and shall become a part of the Contract Documents for this project.
2. **BID DATE:** The project “Proposal Due” remains **2:00 PM, on September 12, 2024**
3. **A REMINDER TO EACH BIDDER:** Please review the Gallagher “Contract Conditions and CSP Package Scope of Work” specification Volume #1 in its entirety.
 - a. Reference the bid package as it pertains to your scope, submit your proposal on the bid form provided within this specification.
 - b. Include the performance & payment bond costs in your proposal pricing (if proposal is at/more than \$25,000).
 - c. If a contractor is awarded a CSP package by the owner, contractors will be required to provide the performance & payment bond within 5 days of receiving the contract.

CLARIFICATIONS AND CHANGES TO SECTION 01 81 00 SCOPE OF WORK

1. **CLARIFICATION TO ALL CSP BID PACKAGES:**
 - a. Replace Spec Section 00 01 00 – Table Of Contents
 - b. Please see attached RFI Log
2. **CLARIFICATIONS TO CSP BID PACKAGE 08-A Frames, Doors and Hardware:**
 - a. Replace Spec Section 08 71 00 Door Hardware in this CSP Trade Package in its entirety.
3. **CLARIFICATION TO CSP BID PACKAGE 22-A PLUMBING:**
 - a. Replace Spec Section 22 05 17 – Sleeves And Sleeve Seals For Plumbing Piping in its entirety.
4. **CLARIFICATION TO CSP BID PACKAGE 22-A, PLUMBING:**
 - a. Replace Spec Section 22 05 18 – Escutcheons For Plumbing Piping in its entirety.



GALLAGHER
A COMMUNITY ORIENTED COMPANY

CRANDALL ISD – PERFORMING ARTS CENTER ADDITION TO CRANDALL HIGH SCHOOL
Addendum No. 1 – August 26, 2024

This addendum is being furnished by the Construction Manager for clarification purposes only and shall become and is part of the Contract Documents.

5. CLARIFICATION TO CSP BID PACKAGE 22-A, PLUMBING:

- a. Replace Spec Section 22 05 19 – Hangers And Supports For Plumbing Piping And Equipment in its entirety.

6. CLARIFICATION TO CSP BID PACKAGE 22-A, PLUMBING:

- a. Replace Spec Section 22 13 19 – Sanitary Waste Piping Specialties in its entirety.

End of Gallagher Addendum No. 1





RFI LOG: CRANDALL ISD - PERFORMING ARTS CENTER ADDITION TO CRANDALL HIGH SCHOOL

DATE: 8/22/2024

| DATE | RFI # | CONTRACTOR | CSP/TRADE | REFERENCE | RFI QUESTION | DATE2 | ANSWERED BY | ANSWER |
|-----------|-------|------------|----------------------------|-----------|---|-----------|-------------|--|
| 7/30/2024 | 1 | | | | Sheet C1.02 shows four islands in the parking lot to be sawcut and removed. Sheet L1.01 shows seven island to receive new concrete finishes. What scope of work needs to be performed at the three additional islands shown to receive new concrete finishes ? | 8/15/2024 | CL | Four islands will be removed to replace the concrete curbs. The islands shown without sawcut will keep the existing curb, and the banded concrete will be poured within the existing curbed areas. The banded concrete within all seven islands will ultimately look the same, the only difference is whether the existing curb will remain. |
| 7/30/2024 | 2 | | | | Sheet C1.03 there is a callout for retaining walls at the loading dock drive. Sheet AS1.2 shows the retaining wall layout. Sheet S1.1A - Foundation Plan - Level 1 Area A does not call out the retaining walls. Please provide structural details for the footings and walls. | 8/15/2024 | CL | Sheet C1.14 shows footing detail information in the detail titled "LOADING DOCK WALLS". |
| 7/30/2024 | 3 | | Masonry | | Sheets A6.1 & A6.2 call for a BB-1 Brick Blended. 042000 / 2.5 / B - Clay Face Brick & C - Perforated Clay Face Brick call for color as selected by architect. Which color an from what manufacturer are these to be coming from. Please provide. | 8/15/2024 | CL | Weatherwood Gray |
| 7/30/2024 | 4 | | Millwork | | Sheet A2.16 - at Dressing Rooms A128, Elev 2C & Dressing Room A129, Elev 1C, there are what look to be, wardrobe storage units. There is no callout for what the finish is for these. Is this what spec section 064116 is for ? | 8/15/2024 | CL | Yes, spec section 064116 refers to this millwork - finish is PLAM. Please assume closure panel matching cabinetry from top of cabinet to underside of ceiling. |
| 7/31/2024 | 5 | | Wood Door Frames | | There are seven locations that are scheduled for wood door frames : A111 A146A, A206B, A208B. These are S/L Lock to Auditorium locations. A207 is to the Control Room. A101M & A101N are 3'-1" x 4'-0" openings that are not on the plans. Please verify that these are to be wood frames ? Where are A101M & A101N located ? | 8/15/2024 | CL | No wood door frames, hollow metal painted. a101M & a101N are located at concessions. |
| 7/31/2024 | 6 | | Aluminum Door Frames | | There are twelve locations that are scheuled for aluminum door frames: A109 Custodial Closet, A111B - S/L Lock to Auditorium, A117A - Stage Access, A121A - Stage Entrance, A124B - Band Storage, A125 - Costume Storage, A143A - Sound & Lighting Storage, A146B - S/L Lock to Auditorium, A203 - Custodial Closet, A206A - S/L Lock to Auditorium, A208A - S/L Lock to Auditorium & A300A - Electrical Closet. Please verify that these are to be aluminum door frames. | 8/15/2024 | CL | No aluminum door frames, all hollow metal. |
| 7/31/2024 | 7 | | Room A207 | | Room A207 - Projection Control Room - Interior Elevation callouts shown are for A103 Concession / Box Office. Please provide interior elevations for A207. | 8/15/2024 | CL | To be addressed in coming addendum. |
| 7/31/2024 | 8 | | Rolltop Assembly | | Sheet A11.4 / Detail 4D - Auditorium Rolltop Counter Section - Is this actually inclusive to this project ? Please provide a location for this detail, if so, showing the actual size, along with a specific manufacturer and model number, other than basis of design. | 8/15/2024 | CL | Yes, it is applicable to be located in coming addendum. |
| 8/1/2024 | 9 | | Acoust. Ceil. | | Sheet A3.2A - A207 - Projection / Control Rm - Ceiling callout is for APC-03. There is no APC-03 on the finish schedule. Should this be APC-02 ? Please advise. | 8/15/2024 | CL | Ceiling in A207 Projection Control Room will be APC-02, team will update drawings in coming addendum. |
| 8/5/2024 | 10 | | Floor Base | | Sheet A12.1A - Unisex Toilet A138 - B-01 - Resilient Base is called out for this toilet room. Is this correct ? Please verify. | 8/15/2024 | CL | Base in A138 is B-02, team will update drawings in coming addendum. |
| 8/5/2024 | 11 | | Display Cases | | Spec Section 10 12 00 / 2.3 Display Cases calls out a specific manufacturer with specific KV shelf brackets. On plan sheet A11.5 / 5A, this detail shows a field built display case with a different KV bracket. Are these display cases to be prefabricated units or field built ? Please advise. | | | |
| 8/7/2024 | 12 | | Signage | | Please provide signage schedule showing sizes and types. | 8/22/2024 | CL | To be addressed in future addendum. |
| 8/7/2024 | 13 | | Plaques | | Please provide size of plaque to be priced. | 8/22/2024 | CL | To be addressed in future addendum. |
| 8/7/2024 | 14 | | Dimensional Letter Signage | | 10-14-19 Calls for this signage to be illuminated, Please identify which electrical circuit is designated for this exterior signage to be illuminated. Please provide letter sizes. | | | |

| | | | | | | | | |
|-----------|----|--|-------------------|--|--|-----------|----|--|
| 8/7/2024 | 15 | | School Logos | | 3A/A4.1 & 3A/A4.2 show school logos. Please provide material type that these are to be manufactured in and any other pertinent info for pricing. | 8/22/2024 | CL | To be addressed in future addendum. |
| 8/7/2024 | 16 | | Audience Seating | | Sheet A2.6 shows each row with a number. These numbers total 778, which was the seat count on the 75% CD drawings. The actual seat count on the 100% CD drawings is 816. Which count is correct ? Please advise. | 8/22/2024 | CL | Seat count is 814, including ADA seating. |
| 8/7/2024 | 17 | | Window Treatments | | There are provisions to provide power to window locations for "connection of future motorized shading system" per note E34 on sheets E2.1A & E2.2A. Will there be no louvered blinds, roller shades or motorized shades in this bidding ? Please advise. | 8/22/2024 | CL | No shades/blinds in this bidding. |
| 8/21/2024 | 18 | | Motorized Rigging | | Spec section 11 61 33 / 2.10 - Rigging Of Electrical Multicables / B. "Refer both rigging drawings and theatrical lighting drawings for specific details regarding cable lengths and location." The theatrical drawings show only a generic cable management detail. Please provide clarification on the theatrical rigging cable management. | | | |
| 8/26/2024 | 20 | | Door Locations | | In RFI #5, I asked for the locations of doors A101M & A101N. The response was they are located in the concessions. There is only one concession, A103, which has doors Entry A103B and Storage A104. The hardware schedule issued even calls these doors out as "Openings not found" and "Not tagged on floor plans". Once again, please provide the locations of doors A101M & A101N. | 8/26/2024 | CL | Doors A101M and A101N are located at concession and are counter height pocket doors to conceal the concession counter. See attached image. |

ADDENDUM No. 1

for

Crandall High School: Performing Arts Center Addition

CRANDALL INDEPENDENT SCHOOL DISTRICT

August 20, 2024

The Bidder or proposer is responsible for obtaining all Addenda prior to submitting a bid or proposal to the district.

ADDENDUM NO. 01
TO THE
PROJECT MANUAL AND DRAWINGS
FOR

CLIENT NAME: **Crandall ISD**
PROJECT NAME: **Crandall HS: Performing Arts Center Addition**
DLR Group Project No. 39-23712-00

Prepared by:
DLR Group Inc. of Texas

The Drawings and Project Manual for the above named Project, dated **July 25, 2024**, are modified, amended, and supplemented as set forth in this Addendum and shall be taken into account in preparing Bids. This Addendum shall become part of the Contract Documents.

Wherein this Addendum is in conflict with the Specifications and Drawings, the requirements of this Addendum shall govern.

REVISIONS TO THE PROJECT MANUAL

The following Specification Sections are revised with this Addendum:

- ITEM 1. Specification Section 08 71 00 DOOR HARDWARE has been revised and re-issued in its entirety.
- ITEM 2. Specification Section 22 05 17 SLEEVES AND SLEEVE SEALS FOR PLUMBING PIPING has been revised and re-issued in its entirety.
- ITEM 3. Specification Section 22 05 18 ESCUTCHEONS FOR PLUMBING PIPING has been revised and re-issued in its entirety.
- ITEM 4. Specification Section 22 05 29 HANGERS AND SUPPORTS FOR PLUMBING PIPING AND EQUIPMENT has been revised and re-issued in its entirety.
- ITEM 5. Specification Section 22 13 19 SANITARY WASTE PIPING SPECIALTIES has been revised and re-issued in its entirety.

REVISIONS TO DRAWINGS

The following Drawings are revised and reissued with this Addendum:

- ITEM 6. G0.1 – COVER SHEET – has been revised to include new sheets added to the set as indicated on the re-issued sheet.
- ITEM 7. CP1.1 – LEVEL 01 CODE PLAN – has been revised to include the correct square footage of the lobby on the re-issued sheet.
- ITEM 8. The Drawing Set has been revised to include Sheet EN0.3 – LIGHTING COMPLIANCE CERTIFICATE - has been added to include the interior and exterior lighting compliance certificates. The sheet has been issued in its entirety.
- ITEM 9. C1.00 – COVER SHEET – has been revised to include updated sheets as indicated on the re-issued sheet.
- ITEM 10. C1.03 – SITE PLAN – has been revised to include the proposed fire line and FDC line and noted for contractor to field verify depth of existing utilities as indicated on the re-issued sheet.

- ITEM 11. C1.04 – DIMENSION CONTROL PLAN – has been revised to include new points on the sidewalk coordinate control table as indicated on the re-issued sheet.
- ITEM 12. C1.05 – DIMENSION CONTROL PLAN INSET – has been revised to include new points on the parking coordinate control table as indicated on the re-issued sheet.
- ITEM 13. C1.08 – STORM DRAIN PLAN – has a revised storm drain plan as indicated on the re-issued sheet.
- ITEM 14. C1.09 – STORM DRAIN PROFILES – SD Line ‘A’ and SD Line ‘B’ have been revised as indicated on the re-issued sheet.
- ITEM 15. C1.10 – SANITARY SEWER & WATER PLAN – has been revised to reflect the fire line and FDC line as indicated on the re-issued sheet.
- ITEM 16. C1.11 – PAVING PLAN – has been revised to reflect replacing paving where the fire line and FDC line disturbed existing conditions as indicated on the re-issued sheet.
- ITEM 17. The Drawing Set has been revised to include C1.18 – WATER DETAILS – New details added to include Thrust Block Detail, Pavement Cuts Removal and Replacement, and Gate Valve 4” to 12” Box & Extension Stem. This sheet has been issued in its entirety.
- ITEM 18. A1.1B – LEVEL 01 – AREA B – FLOOR PLAN – Renamed Storage room to change use to Fire Riser Room as indicated on re-issued sheet.
- ITEM 19. A1.4 – OVERALL ROOF PLAN - has been revised as follows and indicated on the re-issued sheet:
 - i. Roof slope has been updated over the audience chamber from to ¼”/1’-0”.
 - ii. Tapered insulation has been updated to match drawings in section.
- ITEM 20. A2.3 – ENLARGED PLAN – AUDIENCE CHAMBER - CATWALK – Revised catwalk to avoid conflict with Theatrical line set as indicated on the re-issued sheet.
- ITEM 21. A2.4 – ENLARGED PLAN – AUDIENCE CHAMBER – LOADING BRIDGE – Revised loading bridge walkway to avoid conflict with Theatrical line set as indicated on the re-issued sheet.
- ITEM 22. A2.5 – ENLARGED PLAN – AUDIENCE CHAMBER – GRID LEVEL – Revised circular stair to meet loading bridge walkway as indicated on the re-issued sheet.
- ITEM 23. A2.11 – ENLARGED PLAN – BAND / PERCUSSION ROOMS RENOVATION – Detail 2A has been revised to include additional scope of reflooring the existing entry to school as indicated on the re-issued sheet.
- ITEM 24. A2.15 – ENLARGED RESTROOM PLANS AND ELEVATIONS – FRONT OF HOUSE – Mirrors in group restroom walls have been changed in size as indicated on the re-issued sheet.
- ITEM 25. A4.1 - EXTERIOR ELEVATIONS – Brick control joints have been added as indicated on the re-issued sheet.
- ITEM 26. A4.2 EXTERIOR ELEVATIONS – Brick control joints have been added as indicated on the re-issued sheet.
- ITEM 27. A7.1 – STAIR VIEWS – has been revised as follows and indicated on the re-issued sheet:

- i. Added Detail 1D.
 - ii. Revised Details 1A, 5A, and 5C as indicated.
- ITEM 28. A8.3 – DOOR & FRAME TYPE & SCHEDULE – Sheet has been revised with updated door schedule as indicated on the re-issued sheet.
- ITEM 29. A9.0 – EXTERIOR ASSEMBLIES – Detail 1A has been revised as indicated on the re-issued sheet.
- ITEM 30. A9.2 – EXTERIOR DETAILS – Details 1E, 2D, 5B, and 5C have been revised as indicated on the re-issued sheet.
- ITEM 31. A11.9 – INTERIOR DETAILS – AUDIENCE CHAMBER – has been revised to include Details 2A Stage Apron Detail (Typ.) and 2B Stage Apron Detail @ Speaker.
- ITEM 32. A12.1A – LEVEL 01 – AREA A – FINISH PLAN – Sheet has been revised to update finish in unisex restroom as indicated on the re-issued sheet.
- ITEM 33. A12.1B – LEVEL 01 – AREA B – FINISH PLAN - has been revised to include additional scope of reflooring the existing entry to school as indicated on the re-issued sheet.
- ITEM 34. S1.1A – LEVEL 01 – AREA A – FOUNDATION PLAN – has been revised to coordinate plumbing sleeves as indicated on the re-issued sheet.
- ITEM 35. S1.2A – LEVEL 02 MEZZANINE – AREA A – FRAMING PLAN – has been revised to include HSS for storefront support as indicated on the re-issued sheet.
- ITEM 36. S2.3A – LEVEL 03 CATWALK – AREA A – FRAMING PLAN – has been revised to accommodate RTU changes as indicated on the re-issued sheet.
- ITEM 37. S2.3B – LEVEL 03 CATWALK – AREA B – FRAMING PLAN – has been revised to accommodate RTU changes as indicated on the re-issued sheet.
- ITEM 38. S3.1 – STRUCTURAL DETAILS – Detail 3A has been revised to include void forms under structure as indicated on the re-issued sheet.
- ITEM 39. S3.4 – STRUCTURAL DETAILS – Detail 1A has been revised to include void forms under structure as indicated on the re-issued sheet.
- ITEM 40. S3.5 – STRUCTURAL DETAILS – Detail 3A has been revised to include continuous angles to protect corners of the dock leveler as indicated on the re-issued sheet.
- ITEM 41. S5.7 – STEEL SECTIONS – Detail 5B has been added as indicated on the re-issued sheet.
- ITEM 42. FP1.1 – LEVEL 01 – FIRE PROTECTION PLAN – has been revised to include FDC water supply, Detail 2, Detail 3, and Detail 4 as indicated on the re-issued sheet.
- ITEM 43. P0.1 – PLUMBING GENERAL NOTES & SYMBOLS – has been revised to include plumbing void form note as indicated on the re-issued sheet.
- ITEM 44. P2.1 – OVERALL UNDERGROUND PLUMBING PLAN – has been revised to include FDC and additional priming ups as indicated on the re-issued sheet.
- ITEM 45. P2.2MA – LEVEL 02 MEZZANINE – AREA A – PLUMBING PLAN – has revised roof drain plumbing locations as indicated on the re-issued sheet.

- ITEM 46. P2.3 – OVERALL ROOF PLUMBING PLAN – has been updated with 8” roof drain and 2 ½” Gas indicated on the re-issued sheet.
- ITEM 47. P3.1 - ENLARGED PLUMBING PLANS – has updated lavatory piping layouts as indicated on the re-issued sheet.
- ITEM 48. P5.1 – PLUMBING DETAILS – has updated Detail 1 and Detail 2 and added Detail 13 and Detail 14 as indicated on the re-issued sheet.
- ITEM 49. P6.1 – PLUMBING SCHEDULES – Schedules have been updated as indicated on the re-issued sheet.
- ITEM 50. MD1.1B – LEVEL 01 – AREA B – HVAC DEMOLITION PLAN – Sheet notes have been revised as indicated on the re-issued sheet.
- ITEM 51. M1.1A – LEVEL 01 – AREA A – HVAC PLAN – RTU ducts have been updated as indicated on the re-issued sheet.
- ITEM 52. M1.2MA – LEVEL 02 MEZZANINE – AREA A – HVAC PLAN – ducts have been revised as indicated on the re-issued sheet.
- ITEM 53. M1.3A – LEVEL 03 – AREA A – ROOF MECHANICAL PLAN – RTU’s and OA have been updated as indicated on the re-issued sheet.
- ITEM 54. M1.3B – LEVEL 03 – AREA B – MECHANICAL PLAN – RTU 2 and 3 have been updated as indicated on the re-issued sheet.
- ITEM 55. M1.4B – LEVEL 04 – AREA B – ROOF MECHANICAL PLAN – RTU 2 and 3 have been updated as indicated on the re-issued sheet.
- ITEM 56. M5.1 – CONTROLS DIAGRAMS – Building pressure triggering exhaust fan and supply plan has been changes to 0.05 IN.WG as indicated on the re-issued sheet.
- ITEM 57. M7.1 – MECHANICAL DETAILS – Detail 2C has been revised as indicated on the re-issued sheet.
- ITEM 58. M8.1 – MECHANICAL SCHEDULES – Schedules have been updated as indicated on the re-issued sheet.
- ITEM 59. E0.1 – ELECTRICAL SYMBOLS, ABBREVIATIONS & NOTES – Symbols have been updated as indicated on the re-issued sheet.
- ITEM 60. ED1.1B – LEVEL 01 – AREA B – ELECTRICAL DEMOLITION PLAN – has been revised to include a note to protect overhead conduits as indicated on the re-issued sheet.
- ITEM 61. ES1.1 – ELECTRICAL SITE PLAN – Site lighting has been updated as indicated on the re-issued sheet.
- ITEM 62. ES1.2 – SITE LIGHTING PHOTOMETRICS – Photometrics have been updates as indicated on the re-issued sheet.
- ITEM 63. EL1.1A – LEVEL 01 – AREA A – LIGHTING PLAN – Lighting has been updated as indicated on the re-issued sheet.
- ITEM 64. EL1.1B – LEVEL 01– AREA B – LIGHTING PLAN – Lighting has been updated as indicated on the re-issued sheet.

- ITEM 65. EL1.2A – LEVEL 02 MEZZANINE – AREA A – LIGHTING PLAN – Lighting has been updated as indicated on the re-issued sheet.
- ITEM 66. E2.1 – LEVEL 01 – POWER PLAN – has been updated as indicated on the re-issued sheet.
- ITEM 67. E2.1A – LEVEL 01 – AREA A – POWER PLAN – has been updated as indicated on the re-issued sheet.
- ITEM 68. E2.1B – LEVEL 01 – AREA B – POWER PLAN – has been revised as indicated on the re-issued sheet.
- ITEM 69. E2.2A – LEVEL 02 MEZZANINE – AREA A – POWER PLAN – has updated conduit layout as indicated on the re-issued sheet.
- ITEM 70. E3.1B – LEVEL 01 – AREA B – SPECIAL SYSTEMS PLAN – has been updated as indicated on the re-issued sheet.
- ITEM 71. E3.2A – LEVEL 02 MEZZANINE – AREA A – SPECIAL SYSTEMS PLAN – has been updated as indicated on the re-issued sheet.
- ITEM 72. E5.1 – ELECTRICAL DIAGRAMS – Feeder Schedule – Copper, Feeder Schedule – Aluminum, 3-Phase Transformer Primary and Secondary Schedule – Copper, and 3-Phase Transformer Primary and Secondary Schedule – Aluminum have been revised as indicated on the re-issued sheet.
- ITEM 73. E6.2 – ELECTRICAL DETAILS – Details 4E and 4F have been added as indicated on the re-issued sheet.
- ITEM 74. E7.1 – LIGHTING SCHEDULES – Lighting Sequence of Operations has been added as indicated on the re-issued sheet.
- ITEM 75. E7.2 – ELECTRICAL SCHEDULES – Updates to Roof-Top Unit Schedule and Electric Water Heater Schedule have been made as indicated on the re-issued sheet.
- ITEM 76. E7.3 – ELECTRICAL SCHEDULES – Updates to Panel H1K, MH1K, and L1AK have been made as indicated on the re-issued sheet.
- ITEM 77. E7.4 – ELECTRICAL SCHEDULES – Updates to Panel L2TK, H2K, L2K, and ML2K have been made as indicated on the re-issued sheet.
- ITEM 78. QT3.21 – THEATRICAL DRAPERY, LONGITUDINAL SECTION – Drapery track has been updated as indicated on re-issued sheet.

END OF ADDENDUM NO. 01

DOCUMENT 00 01 07

PROFESSIONAL SEALS PAGE

The specification sections listed below were prepared by or under the direct supervision of the Architect:

DLR Group
2500 Pacific Avenue, Suite 1600
Dallas, Texas 25226

DIVISION 08 – OPENINGS

08 71 00 Door Hardware
Door Hardware Schedule

SEAL



END OF DOCUMENT

DOCUMENT 00 01 07

PROFESSIONAL SEALS PAGE


The specification sections listed below were prepared by or under the direct supervision of the Mechanical Engineer:

DLR Group
2500 Pacific Avenue, Suite 1600
Dallas, Texas 25226

DIVISION 22 – PLUMBING

- 22 05 17 Sleeves and Sleeve Seals for Plumbing Piping
- 22 05 18 Escutcheons for Plumbing Piping
- 22 05 29 Hangers and Supports for Plumbing Piping and Equipment
- 22 13 19 Sanitary Waste Piping Specialties

SEAL

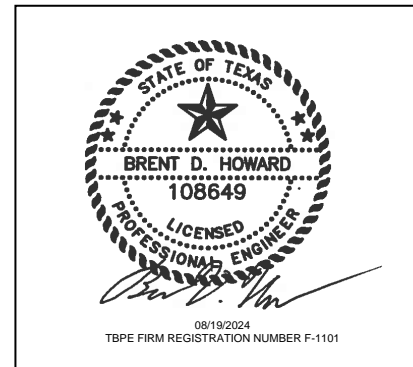

END OF DOCUMENT

DOCUMENT 00 01 10

TABLE OF CONTENTS

INDEX OF ISSUES

Addendum 01 **19 August 2024**
 Issue for Bid and Permit.....25 July 2024

| NUMBER | NAME | ISSUE DATE | REVISED DATE |
|---------------|-------------|-------------------|---------------------|
|---------------|-------------|-------------------|---------------------|

INTRODUCTORY INFORMATION

| | | | |
|----------|-------------------------|-----------|------------------|
| 00 01 01 | Title Page | 25 Jul 24 | |
| 00 01 07 | Seals Page..... | 25 Jul 24 | <u>19 Aug 24</u> |
| 00 01 10 | Table of Contents | 25 Jul 24 | <u>19 Aug 24</u> |

DIVISION 00 – PROCUREMENT AND CONTRACTING REQUIREMENTS

| | | | |
|----------|---|-----------|--|
| 00 26 00 | Procurement Substitution Procedures | 25 Jul 24 | |
| | Procurement Substitution Request Form | 25 Jul 24 | |
| 00 31 32 | Geotechnical Data | 25 Jul 24 | |
| | Geotechnical Report | 25 Jul 24 | |

DIVISION 01 – GENERAL REQUIREMENTS

| | | | |
|----------|---|-----------|--|
| 01 10 00 | Summary | 25 Jul 24 | |
| 01 22 00 | Unit Prices | 25 Jul 24 | |
| 01 25 00 | Substitution Procedures | 25 Jul 24 | |
| | Substitution Request Form | 25 Jul 24 | |
| 01 26 00 | Contract Modification Procedures | 25 Jul 24 | |
| 01 29 00 | Payment Procedures | 25 Jul 24 | |
| 01 31 00 | Project Management and Coordination | 25 Jul 24 | |
| 01 32 00 | Construction Progress Documentation | 25 Jul 24 | |
| 01 32 33 | Photographic Documentation | 25 Jul 24 | |
| 01 33 00 | Submittal Procedures | 25 Jul 24 | |
| 01 35 16 | Alteration Project Procedures | 25 Jul 24 | |
| 01 40 00 | Quality Requirements | 25 Jul 24 | |
| 01 42 00 | References | 25 Jul 24 | |
| 01 43 39 | Mockups | 25 Jul 24 | |
| 01 50 00 | Temporary Facilities and Controls | 25 Jul 24 | |
| 01 56 39 | Temporary Tree and Plant Protection | 25 Jul 24 | |
| 01 57 13 | Erosion and Sedimentation Control | 25 Jul 24 | |
| 01 57 23 | Temporary Storm Water Pollution Control (C) | 25 Jul 24 | |
| 01 60 00 | Product Requirements | 25 Jul 24 | |
| 01 73 00 | Execution | 25 Jul 24 | |
| 01 77 00 | Closeout Procedures | 25 Jul 24 | |
| 01 78 23 | Operation and Maintenance Data | 25 Jul 24 | |
| 01 78 39 | Project Record Documents | 25 Jul 24 | |
| 01 79 00 | Demonstration and Training | 25 Jul 24 | |

DIVISION 02 – EXISTING CONDITIONS

| | | | |
|----------|----------------------------|-----------|--|
| 02 41 19 | Selective Demolition | 25 Jul 24 | |
|----------|----------------------------|-----------|--|

DIVISION 03 – CONCRETE

| | | | |
|----------|---------------------------------------|-----------|--|
| 03 30 00 | Cast-In-Place Concrete (S) | 25 Jul 24 | |
| 03 30 35 | Under Slab Sheet Vapor Retarder | 25 Jul 24 | |
| 03 35 43 | Polished Concrete Finishing | 25 Jul 24 | |
| 03 54 16 | Hydraulic Cement Underlayment | 25 Jul 24 | |

DIVISION 04 – MASONRY

| | | | |
|----------|--------------------|-----------|--|
| 04 20 00 | Unit Masonry | 25 Jul 24 | |
|----------|--------------------|-----------|--|

| NUMBER | NAME | ISSUE DATE | REVISED DATE |
|--|---|-------------------------|---------------------|
| DIVISION 05 – METALS | | | |
| 05 12 00 | Structural Steel Framing (S) | 25 Jul 24 | |
| 05 21 00 | Steel Joist Framing (S) | 25 Jul 24 | |
| 05 31 00 | Steel Decking (S) | 25 Jul 24 | |
| 05 40 00 | Cold-Formed Metal Framing..... | 25 Jul 24 | |
| 05 50 00 | Metal Fabrications | 25 Jul 24 | |
| 05 51 13 | Metal Pan Stairs | 25 Jul 24 | |
| 05 52 13 | Pipe and Tube Railings | 25 Jul 24 | |
| 05 58 13 | Column Covers..... | 25 Jul 24 | |
| 05 73 01 | Decorative Metal Railings..... | 25 Jul 24 | |
| 05 73 13 | Glazed Decorative Metal Railings | 25 Jul 24 | |
| DIVISION 06 – WOOD, PLASTICS, AND COMPOSITES | | | |
| 06 10 53 | Miscellaneous Rough Carpentry | 25 Jul 24 | |
| 06 16 36 | Wood Panel Product Sheathing | 25 Jul 24 | |
| 06 16 43 | Gypsum Sheathing..... | 25 Jul 24 | |
| 06 41 16 | Plastic-Laminate-Clad Architectural Cabinets | 25 Jul 24 | |
| 06 46 00 | Wood Trim..... | 25 Jul 24 | |
| 06 64 00 | Plastic Paneling..... | 25 Jul 24 | |
| DIVISION 07 – THERMAL AND MOISTURE PROTECTION | | | |
| 07 14 00 | Elevator Pit Waterproofing..... | 25 Jul 24 | |
| 07 21 00 | Thermal Insulation | 25 Jul 24 | |
| 07 27 26 | Fluid-Applied Membrane Air Barriers | 25 Jul 24 | |
| 07 42 13.13 | Formed Metal Wall Panels | 25 Jul 24 | |
| 07 42 93 | Soffit Panels | 25 Jul 24 | |
| 07 52 16 | Styrene-Butadiene-Styrene (SBS) Modified Bituminous Membrane Roofing | 25 Jul 24 | |
| 07 62 00 | Sheet Metal Flashing and Trim..... | 25 Jul 24 | |
| 07 62 10 | Flexible Flashing | 25 Jul 24 | |
| 07 71 29 | Manufactured Roof Expansion Joints | 25 Jul 24 | |
| 07 72 00 | Roof Accessories | 25 Jul 24 | |
| 07 81 00 | Applied Fireproofing | 25 Jul 24 | |
| 07 84 13 | Penetration Firestopping | 25 Jul 24 | |
| 07 84 43 | Joint Firestopping | 25 Jul 24 | |
| 07 91 00 | Preformed Joint Seals | 25 Jul 24 | |
| 07 92 00 | Joint Sealants..... | 25 Jul 24 | |
| 07 92 19 | Acoustical Joint Sealants..... | 25 Jul 24 | |
| 07 95 13.13 | Interior Expansion Joint Cover Assemblies | 25 Jul 24 | |
| DIVISION 08 – OPENINGS | | | |
| 08 11 13 | Hollow Metal Doors and Frames | 25 Jul 24 | |
| 08 14 16 | Flush Wood Doors..... | 25 Jul 24 | |
| 08 31 13 | Access Doors and Frames | 25 Jul 24 | |
| 08 33 23 | Overhead Coiling Doors | 25 Jul 24 | |
| 08 34 73.13 | Metal Sound Control Door Assemblies..... | 25 Jul 24 | |
| 08 41 13 | Aluminum-Framed Entrances and Storefronts | 25 Jul 24 | |
| 08 51 13 | Aluminum Windows..... | 25 Jul 24 | |
| 08 62 50 | Tubular Day Lighting Device | 25 Jul 24 | |
| 08 71 00 | Door Hardware | 25 Jul 24 | |
| 08 71 00 | Door Hardware..... | 19 Aug 24 | 19 Aug 24 |
| | <u>Door Hardware Schedule</u> | <u>19 Aug 24</u> | |
| 08 71 13 | Automatic Door Operators..... | 25 Jul 24 | |
| 08 80 00 | Glazing | 25 Jul 24 | |
| 08 83 00 | Mirrors | 25 Jul 24 | |
| 08 87 00 | Glazing Surface Films | 25 Jul 24 | |

| NUMBER | NAME | ISSUE DATE | REVISED DATE |
|----------------------------------|--|-------------------|---------------------|
| DIVISION 09 – FINISHES | | | |
| 09 05 61.13 | Moisture Vapor Emission Control | 25 Jul 24 | |
| 09 21 16.23 | Gypsum Board Shaft Wall Assemblies | 25 Jul 24 | |
| 09 22 16 | Non-Structural Metal Framing | 25 Jul 24 | |
| 09 29 00 | Gypsum Board | 25 Jul 24 | |
| 09 30 13 | Ceramic Tiling | 25 Jul 24 | |
| 09 51 13 | Acoustical Panel Ceilings | 25 Jul 24 | |
| 09 54 26 | Linear Wood Ceiling Panels | 25 Jul 24 | |
| 09 61 16 | Concrete Floor Sealing..... | 25 Jul 24 | |
| 09 64 00 | Wood Flooring..... | 25 Jul 24 | |
| 09 64 34 | Hardboard Stage Flooring | 25 Jul 24 | |
| 09 65 13 | Resilient Base and Accessories | 25 Jul 24 | |
| 09 65 16 | Resilient Sheet Flooring | 25 Jul 24 | |
| 09 65 19 | Resilient Tile Flooring | 25 Jul 24 | |
| 09 65 43 | Linoleum Flooring | 25 Jul 24 | |
| 09 66 23 | Resinous Matrix Terrazzo Flooring..... | 25 Jul 24 | |
| 09 68 13 | Tile Carpeting | 25 Jul 24 | |
| 09 72 00 | Wall Coverings | 25 Jul 24 | |
| 09 81 16 | Acoustical Blanket Insulation..... | 25 Jul 24 | |
| 09 84 15 | Cementitious Wood Fiber Acoustical Panels..... | 25 Jul 24 | |
| 09 84 33 | Sound-Absorbing Wall Units..... | 25 Jul 24 | |
| 09 91 13 | Exterior Painting | 25 Jul 24 | |
| 09 91 23 | Interior Painting | 25 Jul 24 | |
| 09 96 00 | High-Performance Coatings | 25 Jul 24 | |
| DIVISION 10 – SPECIALTIES | | | |
| 10 11 00 | Visual Display Units..... | 25 Jul 24 | |
| 10 12 00 | Display Cases | 25 Jul 24 | |
| 10 14 00 | Signage | 25 Jul 24 | |
| 10 14 16 | Plaques | 25 Jul 24 | |
| 10 14 19 | Dimensional Letter Signage | 25 Jul 24 | |
| 10 18 51 | Shower Pans | 25 Jul 24 | |
| 10 21 13.17 | Phenolic-Core Toilet Compartments | 25 Jul 24 | |
| 10 26 00 | Wall and Door Protection..... | 25 Jul 24 | |
| 10 28 00 | Toilet, Bath, and Laundry Accessories | 25 Jul 24 | |
| 10 41 00 | Fire Department Access Lock and Vault | 25 Jul 24 | |
| 10 43 13 | Emergency Aid Cabinets | 25 Jul 24 | |
| 10 44 13 | Fire Protection Cabinets..... | 25 Jul 24 | |
| 10 44 16 | Fire Extinguishers..... | 25 Jul 24 | |
| DIVISION 11 – EQUIPMENT | | | |
| 11 13 13 | Loading Dock Bumpers | 25 Jul 24 | |
| 11 13 19 | Stationary Loading Dock Equipment | 25 Jul 24 | |
| 11 61 13 | Networked Lighting Control Systems (Th)..... | 25 Jul 24 | |
| 11 61 16 | Theatrical Lighting Wiring Devices (Th)..... | 25 Jul 24 | |
| 11 61 19 | Stage Lighting Fixtures (Th) | 25 Jul 24 | |
| 11 61 23 | Theatrical and Acoustical Drapery and Track (Th) | 25 Jul 24 | |
| 11 61 33 | Motorized Rigging (Th)..... | 25 Jul 24 | |
| 11 61 36 | Counterweight Rigging and Pin Rails (Th)..... | 25 Jul 24 | |
| 11 61 39 | Fire Safety Curtain (Th)..... | 25 Jul 24 | |
| 11 61 63 | Orchestra Shell (Th) | 25 Jul 24 | |
| DIVISION 12 – FURNISHINGS | | | |
| 12 35 51 | Music Instrument Storage Casework..... | 25 Jul 24 | |
| 12 36 23.13 | Plastic-Laminate-Clad Countertops | 25 Jul 24 | |
| 12 36 61.16 | Solid Surfacing Countertops..... | 25 Jul 24 | |
| 12 36 61.19 | Quartz Agglomerate Countertops..... | 25 Jul 24 | |
| 12 61 00 | Upholstered Fixed Audience Seating (Th)..... | 25 Jul 24 | |

| NUMBER | NAME | ISSUE DATE | REVISED DATE |
|--------|------|------------|--------------|
|--------|------|------------|--------------|

DIVISION 13 – SPECIAL CONSTRUCTION NOT USED

DIVISION 14 – CONVEYING EQUIPMENT

14 21 23.16 Machine-Room-Less Electric Traction Passenger Elevators.....25 Jul 24

DIVISIONS 15 – 20 NOT USED

DIVISION 21 – FIRE SUPPRESSION

21 05 00 Common Work Results for Fire Suppression25 Jul 24

21 05 23 General-Duty Valves for Water-Bases
 Fire-Suppression Piping.....25 Jul 24

21 05 29 Hangers and Supports for Fire-Suppression Piping
 and Equipment.....25 Jul 24

21 05 53 Identification for Fire-Suppression Piping and Equipment25 Jul 24

21 10 00 Water-Based Fire-Suppression Systems.....25 Jul 24

DIVISION 22 – PLUMBING

22 05 00 Common Work Results for Plumbing25 Jul 24

22 05 17 Sleeves and Sleeve Seals for Plumbing Piping 19 Aug 24

22 05 18 Escutcheons for Plumbing Piping 19 Aug 24

22 05 23 General-Duty Valves for Plumbing Piping25 Jul 24

22 05 29 Hangers and Supports for Plumbing Piping and Equipment.....25 Jul 24

19 Aug 24

22 05 53 Identification for Plumbing Piping and Equipment25 Jul 24

22 07 19 Plumbing Piping Insulation25 Jul 24

22 11 16 Domestic Water Piping25 Jul 24

22 11 19 Domestic Water Piping Specialties.....25 Jul 24

22 13 16 Sanitary Waste and Vent Piping25 Jul 24

22 13 19 Sanitary Waste Piping Specialties 19 Aug 24

22 14 13 Storm Drainage Piping25 Jul 24

22 14 29 Sump Pumps25 Jul 24

22 33 00 Electric, Domestic-Water Heaters25 Jul 24

22 42 00 Commercial Plumbing Fixtures.....25 Jul 24

22 47 00 Drinking Fountains25 Jul 24

DIVISION 23 – HEATING, VENTILATING, AND AIR-CONDITIONING (HVAC)

23 05 00 Common Work Results for HVAC25 Jul 24

23 05 29 Hangers and Supports for HVAC Piping and Equipment25 Jul 24

23 05 53 Identification for HVAC Piping and Equipment25 Jul 24

23 05 93 Testing, Adjusting, and Balancing for HVAC25 Jul 24

23 07 13 Duct Insulation.....25 Jul 24

23 09 23 Energy Management Control System (BACNET).....25 Jul 24

23 09 23.1 Sequence of Operations General25 Jul 24

23 11 23 Facility Natural-Gas Piping25 Jul 24

23 22 13 Steam and Condensate Piping25 Jul 24

23 23 00 Refrigerant Piping.....25 Jul 24

23 31 13 Metal Ducts25 Jul 24

23 33 00 Air Duct Accessories25 Jul 24

23 33 46 Flexible Ducts25 Jul 24

23 34 00 HVAC Fans25 Jul 24

23 36 00 Air Terminal Units25 Jul 24

23 37 13.13 Air Diffusers.....25 Jul 24

23 37 13.23 Registers and Grilles25 Jul 24

23 73 43.16 Outdoor, Semi-Custom Air-Handling Units25 Jul 24

23 81 26 Split-System Air-Conditioners.....25 Jul 24

23 84 13.29 Self-Contained Steam Humidifiers25 Jul 24

DIVISIONS 24 – 25 NOT USED

| NUMBER | NAME | ISSUE DATE | REVISED DATE |
|---|--|-------------------|---------------------|
| DIVISION 26 – ELECTRICAL | | | |
| 26 05 00 | Common Work Results for Electrical | 25 Jul 24 | |
| 26 05 03 | Demolition of Electrical Systems | 25 Jul 24 | |
| 26 05 19 | Low-Voltage Electrical Power Conductors and Cables | 25 Jul 24 | |
| 26 05 26 | Grounding and Bonding for Electrical Systems | 25 Jul 24 | |
| 26 05 29 | Hangers and Supports for Electrical Systems | 25 Jul 24 | |
| 26 05 33 | Raceways and Boxes for Electrical Systems..... | 25 Jul 24 | |
| 26 05 53 | Identification for Electrical Systems | 25 Jul 24 | |
| 26 05 70 | Overcurrent Protective Device Studies..... | 25 Jul 24 | |
| 26 08 00 | Commissioning of Electrical Systems..... | 25 Jul 24 | |
| 26 09 23 | Lighting Control Systems and Devices | 25 Jul 24 | |
| 26 22 13 | Low-Voltage Distribution Transformers | 25 Jul 24 | |
| 26 24 13 | Switchboards..... | 25 Jul 24 | |
| 26 24 16 | Panelboards | 25 Jul 24 | |
| 26 27 26 | Wiring Devices | 25 Jul 24 | |
| 26 28 13 | Fuses | 25 Jul 24 | |
| 26 28 16 | Disconnect Switches | 25 Jul 24 | |
| 26 28 17 | Company Switches..... | 25 Jul 24 | |
| 26 29 13 | Full Voltage Motor Controllers | 25 Jul 24 | |
| 26 33 23 | Central Battery Equipment for Emergency Lighting..... | 25 Jul 24 | |
| 26 41 13 | Lightning Protection for Structures | 25 Jul 24 | |
| 26 51 00 | Lighting | 25 Jul 24 | |
| DIVISION 27 – COMMUNITCATIONS | | | |
| 27 05 00 | Common Work Results for Communications..... | 25 Jul 24 | |
| 27 05 28 | Pathways for Communications Systems | 25 Jul 24 | |
| 27 11 00 | Communications Equipment Room Fittings..... | 25 Jul 24 | |
| 27 13 00 | Communications Backbone Cabling..... | 25 Jul 24 | |
| 27 15 00 | Communications Horizontal Cabling | 25 Jul 24 | |
| 27 41 16 | Integrated Audiovisual Systems | 25 Jul 24 | |
| 27 51 24 | Educational Intercom and Program Systems | 25 Jul 24 | |
| DIVISION 28 – ELECTRONIC SAFETY AND SECURITY | | | |
| 28 05 00 | Common Work Results for Electronic Safety and Security..... | 25 Jul 24 | |
| 28 05 13 | Conductors and Cables for Electronic Safety and Security | 25 Jul 24 | |
| 28 46 00 | Fire Alarm Systems | 25 Jul 24 | |
| DIVISIONS 29 – 30 NOT USED | | | |
| DIVISION 31 – EARTHWORK | | | |
| 31 00 00 | Earthwork (C) | 25 Jul 24 | |
| 31 10 00 | Site Clearing (C)..... | 25 Jul 24 | |
| 31 23 33 | Trenching and Backfilling (C) | 25 Jul 24 | |
| 31 31 16 | Termite Control..... | 25 Jul 24 | |
| 31 32 00 | Soil Stabilization (C) | 25 Jul 24 | |
| 31 63 29 | Drilled Concrete Piers and Shafts (S)..... | 25 Jul 24 | |
| DIVISION 32 – EXTERIOR IMPROVEMENTS | | | |
| 32 13 13 | Concrete Paving (C) | 25 Jul 24 | |
| 32 17 23 | Pavement Markings (C)..... | 25 Jul 24 | |
| 32 19 00 | Walk Road and Parking Appurtenances (C)..... | 25 Jul 24 | |
| 32 84 00 | Planting Irrigation (LA)..... | 25 Jul 24 | |
| 32 92 13 | Hydromulching (LA)..... | 25 Jul 24 | |
| 32 92 23 | Sod (LA) | 25 Jul 24 | |
| 32 93 00 | Trees, Shrubs, and Groundcovers (LA)..... | 25 Jul 24 | |

| NUMBER | NAME | ISSUE DATE | REVISED DATE |
|-----------------------------------|--------------------------------------|-------------------|---------------------|
| DIVISION 33 – UTILITIES | | | |
| 33 30 00 | Sanitary Sewerage Utilities (C)..... | 25 Jul 24 | |
| 33 40 00 | Storm Drainage Utilities (C)..... | 25 Jul 24 | |
| DIVISIONS 34 – 49 NOT USED | | | |

END OF TABLE OF CONTENTS

SECTION 08 71 00

DOOR HARDWARE

PART 1 - GENERAL

1.1 SUMMARY

- A. This Section includes commercial door hardware for the following:
1. Swinging doors.
 2. Other doors to the extent indicated.
- B. Door hardware includes, but is not necessarily limited to, the following:
1. Mechanical door hardware.
 2. Electromechanical door hardware.
 3. Cylinders specified for doors in other sections.
- C. Related Sections:
1. Division 08 Section "Hollow Metal Doors and Frames".
 2. Division 08 Section "Flush Wood Doors".
 3. Division 08 Section "Sound Control Hollow Metal Door Assemblies".
 4. Division 08 Section "Sound Control Wood Door Assemblies".
 5. Division 08 Section "Aluminum-Framed Entrances and Storefronts".
- D. Codes and References: Comply with the version year adopted by the Authority Having Jurisdiction.
1. ANSI A117.1 - Accessible and Usable Buildings and Facilities.
 2. ICC/IBC - International Building Code.
 3. NFPA 70 - National Electrical Code.
 4. NFPA 80 - Fire Doors and Windows.
 5. NFPA 101 - Life Safety Code.
 6. NFPA 105 - Installation of Smoke Door Assemblies.
 7. State Building Codes, Local Amendments.
- E. Standards: All hardware specified herein shall comply with the following industry standards as applicable. Any undated reference to a standard shall be interpreted as referring to the latest edition of that standard:
1. ANSI/BHMA Certified Product Standards - A156 Series.
 2. UL10C - Positive Pressure Fire Tests of Door Assemblies.
 3. ANSI/UL 294 - Access Control System Units.
 4. UL 305 - Panic Hardware.
 5. ANSI/UL 437- Key Locks.

1.2 SUBMITTALS

- A. Product Data: Manufacturer's product data sheets including installation details, material descriptions, dimensions of individual components and profiles, operational descriptions and finishes.

- B. Door Hardware Schedule: Prepared by or under the supervision of supplier, detailing, fabrication and assembly of door hardware, as well as procedures and diagrams. Coordinate the final Door Hardware Schedule with doors, frames, and related work to ensure proper size, thickness, hand, function, and finish of door hardware.
1. Format: Comply with scheduling sequence and vertical format in DHI's "Sequence and Format for the Hardware Schedule."
 2. Organization: Organize the Door Hardware Schedule into door hardware sets indicating complete designations of every item required for each door or opening. Organize door hardware sets in same order as in the Door Hardware Sets at the end of Part 3. Submittals that do not follow the same format and order as the Door Hardware Sets will be rejected and subject to resubmission.
 3. Content: Include the following information:
 - a. Type, style, function, size, label, hand, and finish of each door hardware item.
 - b. Manufacturer of each item.
 - c. Fastenings and other pertinent information.
 - d. Location of door hardware set, cross-referenced to Drawings, both on floor plans and in door and frame schedule.
 - e. Explanation of abbreviations, symbols, and codes contained in schedule.
 - f. Mounting locations for door hardware.
 - g. Door and frame sizes and materials.
 - h. Warranty information for each product.
 4. Submittal Sequence: Submit the final Door Hardware Schedule at earliest possible date, particularly where approval of the Door Hardware Schedule must precede fabrication of other work that is critical in the Project construction schedule. Include Product Data, Samples, Shop Drawings of other work affected by door hardware, and other information essential to the coordinated review of the Door Hardware Schedule.
- C. Shop Drawings: Details of electrified access control hardware indicating the following:
1. Wiring Diagrams: Upon receipt of approved schedules, submit detailed system wiring diagrams for power, signaling, monitoring, communication, and control of the access control system electrified hardware. Differentiate between manufacturer-installed and field-installed wiring. Include the following:
 - a. Elevation diagram of each unique access controlled opening showing location and interconnection of major system components with respect to their placement in the respective door openings.
 - b. Complete (risers, point-to-point) access control system block wiring diagrams.
 - c. Wiring instructions for each electronic component scheduled herein.
 2. Electrical Coordination: Coordinate with related sections the voltages and wiring details required at electrically controlled and operated hardware openings.
- D. Keying Schedule: After a keying meeting with the owner has taken place prepare a separate keying schedule detailing final instructions. Submit the keying schedule in electronic format. Include keying system explanation, door numbers, key set symbols, hardware set numbers and special instructions. Owner must approve submitted keying schedule prior to the ordering of permanent cylinders/cores.
- E. Informational Submittals:
1. Product Test Reports: Indicating compliance with cycle testing requirements, based on evaluation of comprehensive tests performed by manufacturer and witnessed by a qualified independent testing agency.

1.3 CLOSEOUT SUBMITTALS

- A. Operating and Maintenance Manuals: Provide manufacturers operating and maintenance manuals for each item comprising the complete door hardware installation in quantity as required in Division 01, Closeout Procedures.
 - 1. Maintenance manual must be provided for tornado/hurricane storm shelter impact protective systems.
- B. Project Record Documents: Provide record documentation of as-built door hardware sets in digital format (.pdf, .docx, .xlsx, .csv) and as required in Division 01, Project Record Documents.
- C. Project Record Documents: Provide record documentation of as-built door hardware sets in digital format (.pdf, .docx, .xlsx, .csv) or acceptable integrated file format for updating of Openings Studio™ management software and as required in Division 01, Project Record Documents.

1.4 QUALITY ASSURANCE

- A. Manufacturers Qualifications: Engage qualified manufacturers with a minimum 5 years of documented experience in producing hardware and equipment similar to that indicated for this Project and that have a proven record of successful in-service performance.
- B. Certified Products: Where specified, products must maintain a current listing in the Builders Hardware Manufacturers Association (BHMA) Certified Products Directory (CPD).
- C. Installer Qualifications: A minimum 3 years documented experience installing both standard and electrified door hardware similar in material, design, and extent to that indicated for this Project and whose work has resulted in construction with a record of successful in-service performance.
- D. Door Hardware Supplier Qualifications: Experienced commercial door hardware distributors with a minimum 5 years documented experience supplying both mechanical and electromechanical hardware installations comparable in material, design, and extent to that indicated for this Project. Supplier recognized as a factory direct distributor by the manufacturers of the primary materials with a warehousing facility in Project's vicinity. Supplier to have on staff a certified Architectural Hardware Consultant (AHC) available during the course of the Work to consult with Contractor, Architect, and Owner concerning both standard and electromechanical door hardware and keying.
- E. Source Limitations: Obtain each type and variety of door hardware specified in this section from a single source unless otherwise indicated.
 - 1. Electrified modifications or enhancements made to a source manufacturer's product line by a secondary or third party source will not be accepted.
 - 2. Provide electromechanical door hardware from the same manufacturer as mechanical door hardware, unless otherwise indicated.
- F. Each unit to bear third party permanent label indicating compliance with the referenced testing standards.
- G. Keying Conference: Conduct conference to comply with requirements in Division 01 Section "Project Meetings." Keying conference to incorporate the following criteria into the final keying schedule document:
 - 1. Function of building, purpose of each area and degree of security required.
 - 2. Plans for existing and future key system expansion.
 - 3. Requirements for key control storage and software.
 - 4. Installation of permanent keys, cylinder cores and software.
 - 5. Address and requirements for delivery of keys.

- H. Pre-Submittal Conference: Conduct coordination conference in compliance with requirements in Division 01 Section "Project Meetings" with attendance by representatives of Supplier(s), Installer(s), and Contractor(s) to review proper methods and the procedures for receiving, handling, and installing door hardware.
 - 1. Prior to installation of door hardware, conduct a project specific training meeting to instruct the installing contractors' personnel on the proper installation and adjustment of their respective products. Product training to be attended by installers of door hardware (including electromechanical hardware) for aluminum, hollow metal and wood doors. Training will include the use of installation manuals, hardware schedules, templates and physical product samples as required.
 - 2. Inspect and discuss electrical roughing-in, power supply connections, and other preparatory work performed by other trades.
 - 3. Review sequence of operation narratives for each unique access controlled opening.
 - 4. Review and finalize construction schedule and verify availability of materials.
 - 5. Review the required inspecting, testing, commissioning, and demonstration procedures
- I. At completion of installation, provide written documentation that components were applied according to manufacturer's instructions and recommendations and according to approved schedule.

1.5 DELIVERY, STORAGE AND HANDLING

- A. Inventory door hardware on receipt and provide secure lock-up and shelving for door hardware delivered to Project site. Do not store electronic access control hardware, software or accessories at Project site without prior authorization.
- B. Tag each item or package separately with identification related to the final Door Hardware Schedule, and include basic installation instructions with each item or package.
- C. Deliver, as applicable, permanent keys, cylinders, cores, access control credentials, software and related accessories directly to Owner via registered mail or overnight package service. Instructions for delivery to the Owner shall be established at the "Keying Conference".

1.6 COORDINATION

- A. Templates: Obtain and distribute to the parties involved templates for doors, frames, and other work specified to be factory prepared for installing standard and electrified hardware. Check Shop Drawings of other work to confirm that adequate provisions are made for locating and installing hardware to comply with indicated requirements.
- B. Door and Frame Preparation: Doors and corresponding frames are to be prepared, reinforced and pre-wired (if applicable) to receive the installation of the specified electrified, monitoring, signaling and access control system hardware without additional in-field modifications.

1.7 WARRANTY

- A. General Warranty: Reference Division 01, General Requirements. Special warranties specified in this Article shall not deprive Owner of other rights Owner may have under other provisions of the Contract Documents and shall be in addition to, and run concurrent with, other warranties made by Contractor under requirements of the Contract Documents.
- B. Warranty Period: Written warranty, executed by manufacturer(s), agreeing to repair or replace components of standard and electrified door hardware that fails in materials or workmanship within specified warranty period after final acceptance by the Owner. Failures include, but are not limited to, the following:
 - 1. Structural failures including excessive deflection, cracking, or breakage.

2. Faulty operation of the hardware.
3. Deterioration of metals, metal finishes, and other materials beyond normal weathering.
4. Electrical component defects and failures within the systems operation.

C. Warranty Period: Unless otherwise indicated, warranty shall be one year from date of Substantial Completion.

PART 2 - PRODUCTS

2.1 SCHEDULED DOOR HARDWARE

- A. General: Provide door hardware for each door to comply with requirements in Door Hardware Sets and each referenced section that products are to be supplied under.
- B. Designations: Requirements for quantity, item, size, finish or color, grade, function, and other distinctive qualities of each type of door hardware are indicated in the Door Hardware Sets at the end of Part 3. Products are identified by using door hardware designations, as follows:
 1. Named Manufacturer's Products: Product designation and manufacturer are listed for each door hardware type required for the purpose of establishing requirements. Manufacturers' names are abbreviated in the Door Hardware Schedule.
- C. Substitutions: Requests for substitution and product approval for inclusive mechanical and electromechanical door hardware in compliance with the specifications must be submitted in writing and in accordance with the procedures and time frames outlined in Division 01, Substitution Procedures. Approval of requests is at the discretion of the architect, owner, and their designated consultants.

2.2 BUTT HINGES

- A. Hinges: ANSI/BHMA A156.1 butt hinges with number of hinge knuckles and other options as specified in the Door Hardware Sets.
 1. Quantity: Provide the following hinge quantity:
 - a. Two Hinges: For doors with heights up to 60 inches.
 - b. Three Hinges: For doors with heights 61 to 90 inches.
 - c. Four Hinges: For doors with heights 91 to 120 inches.
 - d. For doors with heights more than 120 inches, provide 4 hinges, plus 1 hinge for every 30 inches of door height greater than 120 inches.
 2. Hinge Size: Provide the following, unless otherwise indicated, with hinge widths sized for door thickness and clearances required:
 - a. Widths up to 3'0": 4-1/2" standard or heavy weight as specified.
 - b. Sizes from 3'1" to 4'0": 5" standard or heavy weight as specified.
 3. Hinge Weight and Base Material: Unless otherwise indicated, provide the following:
 - a. Exterior Doors: Heavy weight, non-ferrous, ball bearing or oil impregnated bearing hinges unless Hardware Sets indicate standard weight.
 - b. Interior Doors: Standard weight, steel, ball bearing or oil impregnated bearing hinges unless Hardware Sets indicate heavy weight.

4. Hinge Options: Comply with the following:
 - a. Non-removable Pins: With the exception of electric through wire hinges, provide set screw in hinge barrel that, when tightened into a groove in hinge pin, prevents removal of pin while door is closed; for the all out-swinging lockable doors.
 - b. Cam Lift Hinges: Where specified provide hinges that move the door up and then lower it to create a tight seal when the door is closed.
5. Manufacturers:
 - a. McKinney (MK) - TA/T4A Series, 5-knuckle.

2.3 CONTINUOUS HINGES

- A. Continuous Geared Hinges: ANSI/BHMA A156.26 Grade 1-600 continuous geared hinge. with minimum 0.120-inch thick extruded 6063-T6 aluminum alloy hinge leaves and a minimum overall width of 4 inches. Hinges are non-handed, reversible and fabricated to template screw locations. Factory trim hinges to suit door height and prepare for electrical cut-outs.
 1. Manufacturers:
 - a. Pemko (PE).

2.4 POWER TRANSFER DEVICES

- A. Concealed Quick Connect Electric Power Transfers: Provide concealed wiring pathway housing mortised into the door and frame for low voltage electrified door hardware. Furnish with Molex™ standardized plug connectors and sufficient number of concealed wires (up to 12) to accommodate the electrified functions specified in the Door Hardware Sets. Connectors plug directly to through-door wiring harnesses for connection to electric locking devices and power supplies. Wire nut connections are not acceptable.
 1. Manufacturers:
 - a. Pemko (PE) - EL-CEPT Series.
 - b. Securitron (SU) - EL-CEPT Series.
- B. Electric Door Wire Harnesses: Provide electric/data transfer wiring harnesses with standardized plug connectors to accommodate up to twelve (12) wires. Connectors plug directly to through-door wiring harnesses for connection to electric locking devices and power supplies. Provide sufficient number and type of concealed wires to accommodate electric function of specified hardware. Provide a connector for through-door electronic locking devices and from hinge to junction box above the opening. Wire nut connections are not acceptable. Determine the length required for each electrified hardware component for the door type, size and construction, minimum of two per electrified opening.
 1. Provide one each of the following tools as part of the base bid contract:
 - a. McKinney (MK) - Electrical Connecting Kit: QC-R001.
 - b. McKinney (MK) - Connector Hand Tool: QC-R003.
 2. Manufacturers:
 - a. McKinney (MK) - QC-C Series.

2.5 DOOR OPERATING TRIM

- A. Flush Bolts and Surface Bolts: Provide products conforming to ANSI/BHMA A156.3 and A156.16, Grade 1.
1. Flush bolts to be furnished with top rod of sufficient length to allow bolt retraction device location approximately six feet from the floor.
 2. Furnish dust proof strikes for bottom bolts.
 3. Surface bolts to be minimum 8" in length and U.L. listed for labeled fire doors and U.L. listed for windstorm components where applicable.
 4. Provide related accessories (mounting brackets, strikes, coordinators, etc.) as required for appropriate installation and operation.
 5. Manufacturers:
 - a. Rockwood (RO).
- B. Coordinators: ANSI/BHMA A156.3 door coordinators consisting of active-leaf, hold-open lever and inactive-leaf release trigger. Model as indicated in hardware sets.
1. Manufacturers:
 - a. Rockwood (RO).
- C. Door Push Plates and Pulls: ANSI/BHMA A156.6 door pushes and pull units of type and design specified in the Hardware Sets. Coordinate and provide proper width and height as required where conflicting hardware dictates.
1. Push/Pull Plates: Minimum .050 inch thick, size as indicated in hardware sets, with beveled edges, secured with exposed screws unless otherwise indicated.
 2. Door Pull and Push Bar Design: Size, shape, and material as indicated in the hardware sets. Minimum clearance of 2 1/2-inches from face of door unless otherwise indicated.
 3. Offset Pull Design: Size, shape, and material as indicated in the hardware sets. Minimum clearance of 2 1/2-inches from face of door and offset of 90 degrees unless otherwise indicated.
 4. Pulls, where applicable, shall be provided with a 10" clearance from the finished floor on the push side to accommodate wheelchair accessibility.
 5. Fasteners: Provide manufacturer's designated fastener type as indicated in Hardware Sets. When through-bolt fasteners are in the same location as a push plate, countersink the fasteners flush with the door face allowing the push plate to sit flat against the door.
 6. Manufacturers:
 - a. Rockwood (RO).

2.6 CYLINDERS AND KEYING

- A. General: Cylinder manufacturer to have minimum (10) years experience designing secured master key systems and have on record a published security keying system policy.
- B. Cylinder Types: Original manufacturer cylinders able to supply the following cylinder formats and types:
1. Threaded mortise cylinders with rings and cams to suit hardware application.
 2. Rim cylinders with back plate, flat-type vertical or horizontal tailpiece, and raised trim ring.
 3. Bored or cylindrical lock cylinders with tailpieces as required to suit locks.
 4. Tubular deadlocks and other auxiliary locks.
 5. Mortise and rim cylinder collars to be solid and recessed to allow the cylinder face to be flush and be free spinning with matching finishes.
 6. Keyway: Manufacturer's Standard.

- C. Large Format Interchangeable Cores: Provide removable cores (LFIC) as specified, core insert, removable by use of a special key, and for use with only the core manufacturer's cylinder and door hardware.
- D. Patented Cylinders: ANSI/BHMA A156.5, Grade 1 Certified Products Directory (CPD) listed cylinders employing a utility patented and restricted keyway requiring the use of a patented key. Cylinders are to be protected from unauthorized manufacture and distribution by manufacturer's United States patents.
 - 1. Patented key systems shall not be established with products that have an expired patent. Expired systems shall only be specified and supplied to support existing systems.
 - 2. Manufacturers:
 - a. Corbin Russwin (RU) - Pyramid.
 - b. No Substitution.
- E. Keying System: Each type of lock and cylinders to be factory keyed.
 - 1. Supplier shall conduct a "Keying Conference" to define and document keying system instructions and requirements.
 - 2. Furnish factory cut, nickel-silver large bow permanently inscribed with a visual key control number as directed by Owner.
 - 3. Existing System: Field verify and key cylinders to match Owner's existing system.
- F. Key Quantity: Provide the following minimum number of keys:
 - 1. Change Keys per Cylinder: Two (2)
 - 2. Master Keys (per Master Key Level/Group): Five (5).
 - 3. Construction Keys (where required): Ten (10).
- G. Construction Keying: Provide construction master keyed cylinders.
- H. Key Registration List (Bitting List):
 - 1. Provide keying transcript list to Owner's representative in the proper format for importing into key control software.
 - 2. Provide transcript list in writing or electronic file as directed by the Owner.

2.7 KEY CONTROL

- A. Key Control Cabinet: Provide a key control system including envelopes, labels, and tags with self-locking key clips, receipt forms, 3-way visible card index, temporary markers, permanent markers, and standard metal cabinet. Key control cabinet shall have expansion capacity of 150% of the number of locks required for the project.
 - 1. Manufacturers:
 - a. Lund Equipment (LU).
 - b. MMF Industries (MM).
 - c. Telkee (TK).
- P. Electronic Key Management System: Provide an electronic key control system with Stand-alone Plug and Play features including advanced RFID technology. Touchscreen interface with PIN access for keys individually locked in place. Minimum 1,000 system users and 21 iFobs for locking receptors. System shall have a minimum 250,000 audit events screen displayed or ability to be exported via USB port.
 - 1. Manufacturers:
 - a. Medeco (MC).

2.8 MORTISE LOCKS AND LATCHING DEVICES

- A. Mortise Locksets, Grade 1 (Heavy Duty): Provide ANSI/BHMA A156.13, Series 1000, Operational Grade 1 Certified Products Directory (CPD) listed mortise locksets. Listed manufacturers shall meet all functions and features as specified herein.
1. Manufacturers:
 - a. Corbin Russwin Hardware (RU) - ML2000 Series.
 - b. No Substitution.

2.9 LOCK AND LATCH STRIKES

- A. Strikes: Provide manufacturer's standard strike with strike box for each latch or lock bolt, with curved lip extended to protect frame, finished to match door hardware set, unless otherwise indicated, and as follows:
1. Flat-Lip Strikes: For locks with three-piece antifriction latchbolts, as recommended by manufacturer.
 2. Extra-Long-Lip Strikes: For locks used on frames with applied wood casing trim.
 3. Aluminum-Frame Strike Box: Provide manufacturer's special strike box fabricated for aluminum framing.
 4. Double-lipped strikes: For locks at double acting doors. Furnish with retractable stop for rescue hardware applications.
- B. Standards: Comply with the following:
1. Strikes for Mortise Locks and Latches: BHMA A156.13.
 2. Strikes for Bored Locks and Latches: BHMA A156.2.
 3. Strikes for Auxiliary Deadlocks: BHMA A156.36.
 4. Dustproof Strikes: BHMA A156.16.

2.10 CONVENTIONAL EXIT DEVICES

- A. General Requirements: All exit devices specified herein shall meet or exceed the following criteria:
1. Exit devices shall have a five-year warranty.
 2. At doors not requiring a fire rating, provide devices complying with NFPA 101 and listed and labeled for "Panic Hardware" according to UL305. Provide proper fasteners as required by manufacturer including sex nuts and bolts at openings specified in the Hardware Sets.
 3. Where exit devices are required on fire rated doors, provide devices complying with NFPA 80 and with UL labeling indicating "Fire Exit Hardware". Provide devices with the proper fasteners for installation as tested and listed by UL. Consult manufacturer's catalog and template book for specific requirements.
 4. Except on fire rated doors, provide exit devices with hex key dogging device to hold the pushbar and latch in a retracted position. Provide optional keyed cylinder dogging on devices where specified in Hardware Sets.
 5. Devices must fit flat against the door face with no gap that permits unauthorized dogging of the push bar. The addition of filler strips is required in any case where the door light extends behind the device as in a full glass configuration.
 6. Lever Operating Trim: Where exit devices require lever trim, furnish manufacturer's heavy duty escutcheon trim with threaded studs for thru-bolts.
 - a. Lock Trim Design: As indicated in Hardware Sets, provide finishes and designs to match that of the specified locksets.
 - b. Where function of exit device requires a cylinder, provide a cylinder (Rim or Mortise) as specified in Hardware Sets.

7. Vertical Rod Exit Devices: Where surface or concealed vertical rod exit devices are used at interior openings, provide as less bottom rod (LBR) unless otherwise indicated. Provide dust proof strikes where thermal pins are required to project into the floor.
 8. Narrow Stile Applications: At doors constructed with narrow stiles, or as specified in Hardware Sets, provide devices designed for maximum 2" wide stiles.
 9. Dummy Push Bar: Nonfunctioning push bar matching functional push bar.
 10. Rail Sizing: Provide exit device rails factory sized for proper door width application.
 11. Through Bolt Installation: For exit devices and trim as indicated in Door Hardware Sets.
- B. Conventional Push Rail Exit Devices (Heavy Duty): ANSI/BHMA A156.3, Grade 1 Certified Products Directory (CPD) listed exit devices. Listed manufacturers shall meet all functions and features as specified herein.
1. Electromechanical exit devices shall have the following functions and features:
 - a. Universal Molex plug-in connectors that have standardized color-coded wiring and are field configurable in fail safe or fail secure and operate from 12vdc to 24vdc regulated.
 - b. Wire routing for all non-access control electromechanical functions and EcoFlex trim to be contained within the carrier of the device eliminating the need for cavities in doors to be drilled. Include a protective film so that wires don't get damaged if the rail needs to be removed.
 - c. EcoFlex or equivalent technology that reduces energy consumption up to 92% as certified by GreenCircle.
 - d. Options to be available for request-to-exit or enter signaling, latchbolt and touchbar monitoring.
 - e. Field configurable electrified trim to fail-safe or fail-secure that operates from 12-24VDC.
 2. Manufacturers:
 - a. Corbin Russwin Hardware (RU) - PED4000 / PED5000 Series.
 - b. No Substitution.
- C. Security Push Rail Exit Devices (Heavy Duty): ANSI/BHMA A156.3, Grade 1 Certified Products Directory (CPD) listed rim panic and fire exit hardware devices furnished in the functions specified in the Hardware Sets. Exit device latch to be constructed of high grade, heat treated, corrosion resistant nickel steel alloy, and have a full 3/4" throw projection with slide action positive deadlocking.
1. Static Load Force Resistance: Minimum 3000 lbs. certified independent tested.
 2. Manufacturers:
 - a. Corbin Russwin Hardware (RU) - ED4000S / ED5000S Series.
 - b. No Substitution.
- D. Tubular Panic Devices: ANSI/BHMA A156.3, Grade 1 Certified Products Directory (CPD) listed panic and fire exit hardware devices furnished in the functions specified in the Hardware Sets. Device to be ADA compliant requiring less than 5 lbs. of force to activate. Post mounting with optional mechanical dogging. Provide proper fasteners as required by manufacturer to meet application requirements. Provide exit devices on both leaves of pairs of doors.
1. Style: Exposed vertical rod. 1-1/4" grip diameter with interior operating panic handle in combination with exterior fixed pull handle. Panic mechanism shall be concealed within brass or stainless steel tubing. Optional entrance from exterior by a keyed cylinder.
 2. Configurations (provide as specified):
 3. Push/pull operation when dogged from the inside.
 4. Latching: Top latching. Reversed, flat, Pullman style. Roller-type latching not acceptable.
 5. Engraved "PUSH" signage with optional paint infill and boundary grooves.

6. Manufacturers:
 - a. Rockwood (RO) - PDU8500 Series.
 - b. No Substitution.

2.11 DOOR CLOSERS

- A. All door closers specified herein shall meet or exceed the following criteria:
 1. General: Door closers to be from one manufacturer, matching in design and style, with the same type door preparations and templates regardless of application or spring size. Closers to be non-handed with full sized covers.
 2. Standards: Closers to comply with UL-10C for Positive Pressure Fire Test and be U.L. listed for use of fire rated doors.
 3. Size of Units: Comply with manufacturer's written recommendations for sizing of door closers depending on size of door, exposure to weather, and anticipated frequency of use. Where closers are indicated for doors required to be accessible to the Americans with Disabilities Act, provide units complying with ANSI ICC/A117.1.
 4. Closer Arms: Provide heavy duty, forged steel closer arms unless otherwise indicated in Hardware Sets.
 5. Closers shall not be installed on exterior or corridor side of doors; where possible install closers on door for optimum aesthetics.
 6. Closer Accessories: Provide door closer accessories including custom templates, special mounting brackets, spacers and drop plates as required for proper installation. Provide through-bolt and security type fasteners as specified in the hardware sets.
- B. Door Closers, Surface Mounted (Large Body Cast Iron): ANSI/BHMA A156.4, Grade 1 Certified Products Directory (CPD) listed surface mounted, heavy duty door closers with complete spring power adjustment, sizes 1 thru 6; and fully operational adjustable according to door size, frequency of use, and opening force. Closers to be rack and pinion type, one piece cast iron body construction, with adjustable backcheck and separate non-critical valves for closing sweep and latch speed control.
 1. Large body cast iron surface mounted door closers shall have a 30-year warranty.
 2. Manufacturers:
 - a. Corbin Russwin Hardware (RU) - DC8000 Series.
 - b. No Substitution.

2.12 SURFACE MOUNTED CLOSER HOLDERS

- A. Electromagnetic Door Holders: ANSI A156.15 electromagnetic door holder/releases with a minimum 20 to 40 pounds holding power and single coil construction able to accommodate 12VDC, 24VAC, 24VDC and 120VAC. Coils to be independently wound, employing an integral fuse and armatures to include a positive release button.
 1. Manufacturers:
 - a. Norton Rixson (RF) - 980/990 Series.
 - b. No Substitution.

2.13 ARCHITECTURAL TRIM

A. Door Protective Trim

1. General: Door protective trim units to be of type and design as specified below or in the Hardware Sets.
2. Size: Fabricate protection plates (kick, armor, or mop) not more than 2" less than door width (LDW) on stop side of single doors and 1" LDW on stop side of pairs of doors, and not more than 1" less than door width on pull side. Coordinate and provide proper width and height as required where conflicting hardware dictates. Height to be as specified in the Hardware Sets.
3. Where plates are applied to fire rated doors with the top of the plate more than 16" above the bottom of the door, provide plates complying with NFPA 80. Consult manufacturer's catalog and template book for specific requirements for size and applications.
4. Protection Plates: ANSI/BHMA A156.6 protection plates (kick, armor, or mop), fabricated from the following:
 - a. Stainless Steel: 300 grade, 050-inch thick.
5. Options and fasteners: Provide manufacturer's designated fastener type as specified in the Hardware Sets. Provide countersunk screw holes.
6. Manufacturers:
 - a. Rockwood (RO).

2.14 DOOR STOPS AND HOLDERS

- A. General: Door stops and holders to be of type and design as specified below or in the Hardware Sets.
- B. Door Stops and Bumpers: ANSI/BHMA A156.16, Grade 1 door stops and wall bumpers. Provide wall bumpers, either convex or concave types with anchorage as indicated, unless floor or other types of door stops are specified in Hardware Sets. Do not mount floor stops where they will impede traffic. Where floor or wall bumpers are not appropriate, provide overhead type stops and holders.
 1. Manufacturers:
 - a. Rockwood (RO).

2.15 ARCHITECTURAL SEALS

- A. General: Thresholds, weatherstripping, and gasket seals to be of type and design as specified below or in the Hardware Sets. Provide continuous weatherstrip gasketing on exterior doors and provide smoke, light, or sound gasketing on interior doors where indicated. At exterior applications provide non-corrosive fasteners and elsewhere where indicated.
- B. Smoke Labeled Gasketing: Assemblies complying with NFPA 105 that are listed and labeled by a testing and inspecting agency acceptable to authorities having jurisdiction, for smoke control ratings indicated, based on testing according to UL 1784.
 1. Provide smoke labeled perimeter gasketing at all smoke labeled openings.
- C. Fire Labeled Gasketing: Assemblies complying with NFPA 80 that are listed and labeled by a testing and inspecting agency acceptable to authorities having jurisdiction, for fire ratings indicated, based on testing according to UL-10C.
 1. Provide intumescent seals as indicated to meet UL10C Standard for Positive Pressure Fire Tests of Door Assemblies, and NFPA 252, Standard Methods of Fire Tests of Door Assemblies.

- D. Sound-Rated Gasketing: Assemblies that are listed and labeled by a testing and inspecting agency, for sound ratings indicated.
- E. Replaceable Seal Strips: Provide only those units where resilient or flexible seal strips are easily replaceable and readily available from stocks maintained by manufacturer.
- F. Manufacturers:
 - 1. Pemko (PE).

2.16 ELECTRONIC ACCESSORIES

- A. Door Position Switches: Door position magnetic reed contact switches specifically designed for use in commercial door applications. On recessed models the contact and magnetic housing snap-lock into a 1" diameter hole. Surface mounted models include wide gap distance design complete with armored flex cabling. Provide SPDT, N/O switches with optional Rare Earth Magnet installation on steel doors with flush top channels.
 - 1. Manufacturers:
 - a. Securitron (SU) - DPS Series.
- B. Switching Power Supplies: Provide power supplies with either single or dual voltage configurations at 12 or 24VDC. Power supplies shall have battery backup function with an integrated battery charging circuit and shall provide capability for power distribution, direct lock control and Fire Alarm Interface (FAI) through add on modules. Power supplies shall be expandable up to 16 individually protected outputs. Output modules shall provide individually protected, continuous outputs and/or individually protected, relay controlled outputs.
 - 1. Manufacturers:
 - a. Securitron (SU) - AQD Series.

2.17 FABRICATION

- A. Fasteners: Provide door hardware manufactured to comply with published templates generally prepared for machine, wood, and sheet metal screws. Provide screws according to manufacturers recognized installation standards for application intended.

2.18 FINISHES

- A. Standard: Designations used in the Hardware Sets and elsewhere indicate hardware finishes complying with ANSI/BHMA A156.18, including coordination with traditional U.S. finishes indicated by certain manufacturers for their products.
- B. Provide quality of finish, including thickness of plating or coating (if any), composition, hardness, and other qualities complying with manufacturer's standards, but in no case less than specified by referenced standards for the applicable units of hardware
- C. Protect mechanical finishes on exposed surfaces from damage by applying a strippable, temporary protective covering before shipping.

PART 3 - EXECUTION

3.1 EXAMINATION

- A. Examine scheduled openings, with Installer present, for compliance with requirements for installation tolerances, labeled fire door assembly construction, wall and floor construction, and other conditions affecting performance.
- B. Notify architect of any discrepancies or conflicts between the door schedule, door types, drawings and scheduled hardware. Proceed only after such discrepancies or conflicts have been resolved in writing.

3.2 PREPARATION

- A. Hollow Metal Doors and Frames: Comply with ANSI/DHI A115 series.
- B. Wood Doors: Comply with ANSI/DHI A115-W series.

3.3 INSTALLATION

- A. Install each item of mechanical and electromechanical hardware and access control equipment to comply with manufacturer's written instructions and according to specifications.
 - 1. Installers are to be trained and certified by the manufacturer on the proper installation and adjustment of fire, life safety, and security products including: hanging devices; locking devices; closing devices; and seals.
- B. Mounting Heights: Mount door hardware units at heights indicated in following applicable publications, unless specifically indicated or required to comply with governing regulations:
 - 1. Standard Steel Doors and Frames: DHI's "Recommended Locations for Architectural Hardware for Standard Steel Doors and Frames."
 - 2. DHI TDH-007-20: Installation Guide for Doors and Hardware.
 - 3. Where indicated to comply with accessibility requirements, comply with ANSI A117.1 "Accessibility Guidelines for Buildings and Facilities."
 - 4. Provide blocking in drywall partitions where wall stops or other wall mounted hardware is located.
- C. Retrofitting: Install door hardware to comply with manufacturer's published templates and written instructions. Where cutting and fitting are required to install door hardware onto or into surfaces that are later to be painted or finished in another way, coordinate removal, storage, and reinstallation of surface protective trim units with finishing work specified in Division 9 Sections. Do not install surface-mounted items until finishes have been completed on substrates involved.
- D. Push Plates and Door Pulls: When through-bolt fasteners are in the same location as a push plate, countersink the fasteners flush with the door face allowing the push plate to sit flat against the door.
- E. Thresholds: Set thresholds for exterior and acoustical doors in full bed of sealant complying with requirements specified in Division 7 Section "Joint Sealants."
- F. Storage: Provide a secure lock up for hardware delivered to the project but not yet installed. Control the handling and installation of hardware items so that the completion of the work will not be delayed by hardware losses before and after installation.

3.4 FIELD QUALITY CONTROL

- A. Field Inspection (Punch Report): Reference Division 01 Sections "Closeout Procedures". Produce project punch report for each installed door opening indicating compliance with approved submittals and verification hardware is properly installed, operating and adjusted. Include list of items to be completed and corrected, indicating the reasons or deficiencies causing the Work to be incomplete or rejected.
 - 1. Organization of List: Include separate Door Opening and Deficiencies and Corrective Action Lists organized by Mark, Opening Remarks and Comments, and related Opening Images and Video Recordings.

3.5 ADJUSTING

- A. Initial Adjustment: Adjust and check each operating item of door hardware and each door to ensure proper operation or function of every unit. Replace units that cannot be adjusted to operate as intended. Adjust door control devices to compensate for final operation of heating and ventilating equipment and to comply with referenced accessibility requirements.

3.6 CLEANING AND PROTECTION

- A. Protect all hardware stored on construction site in a covered and dry place. Protect exposed hardware installed on doors during the construction phase. Install any and all hardware at the latest possible time frame.
- B. Clean adjacent surfaces soiled by door hardware installation.
- C. Clean operating items as necessary to restore proper finish. Provide final protection and maintain conditions that ensure door hardware is without damage or deterioration at time of owner occupancy.

3.7 DEMONSTRATION

- A. Instruct Owner's maintenance personnel to adjust, operate, and maintain mechanical and electromechanical door hardware.

3.8 DOOR HARDWARE SETS

- A. The hardware sets represent the design intent and direction of the owner and architect. They are a guideline only and should not be considered a detailed hardware schedule. Discrepancies, conflicting hardware and missing items should be brought to the attention of the architect with corrections made prior to the bidding process. Omitted items not included in a hardware set should be scheduled with the appropriate additional hardware required for proper application and functionality.
 - 1. Quantities listed are for each pair of doors, or for each single door.
 - 2. The supplier is responsible for handing and sizing all products.
 - 3. Where multiple options for a piece of hardware are given in a single line item, the supplier shall provide the appropriate application for the opening.
 - 4. At existing openings with new hardware the supplier shall field inspect existing conditions prior to the submittal stage to verify the specified hardware will work as required. Provide alternate solutions and proposals as needed.
- B. Refer to attached document for Door Hardware Schedule.

END OF SECTION

DOOR HARDWARE SCHEDULE

A. Manufacturer's Abbreviations:

1. MK - McKinney
2. PE - Pemko
3. SU - Securitron
4. RO - Rockwood
5. RU - Corbin Russwin
6. NO - Norton
7. RF - Rixson
8. OT - Other

Hardware Sets

Set: 1.0

Doors: A101A

Description: EXTERIOR STOREFRONT PAIR CARD READER TUBULAR PANIC (BLACK FINISH)

| | | | | | |
|----------------------------------|--|-------|----|----------|---|
| 2 Continuous Hinge | BSPFM95SLF-HD1 | | PE | 08 71 00 | |
| 2 Storefront Panic Device | PDU8500-3 04 | BSP | RO | 08 71 00 | |
| 2 Mortise Cylinder/Core | Match Existing Pyramid LFIC Key System | Match | RU | 08 71 00 | |
| 1 Electric Strike Kit | ESK-1600-DBL LM | BSP | RO | 08 71 00 | |
| 2 Surface Closer w/ Hvy Dty Stop | DC8210 A11 | BSP | RU | 08 71 00 | |
| 1 Perimeter Seals | By Door & Frame Manufacturer | | OT | | |
| 1 Rain Guard | 346BSP + 4" ODW | | PE | 08 71 00 | |
| 2 Sweep | 345BSPNB | | PE | 08 71 00 | |
| 1 Threshold | 252x3BSPFG | | PE | 08 71 00 | |
| 1 ElectroLynx Harness | QC-C2500P | | MK | 08 71 00 | ⚡ |
| 1 Motion Sensor | XMS | | SU | 08 71 00 | ⚡ |
| 2 Position Switch | DPS-X-BK | | SU | 08 71 00 | ⚡ |
| 1 Power Supply | AQD x Amps Required | | SU | 08 71 00 | ⚡ |
| 1 Card Reader | By Security Contractor | | OT | | |

Set: 2.0

Doors: A196

Description: EXTERIOR STOREFRONT PAIR EXIT ONLY TUBULAR PANIC (BLACK FINISH)

| | | | | | |
|--------------------------------------|------------------------------|-----|----|----------|--|
| 2 Continuous Hinge | BSPFM95SLF-HD1 | | PE | 08 71 00 | |
| 2 Storefront Panic Device, Exit Only | PDU8500 | BSP | RO | 08 71 00 | |
| 2 Surface Closer w/ Hvy Dty Stop | DC8210 A11 | BSP | RU | 08 71 00 | |
| 1 Perimeter Seals | By Door & Frame Manufacturer | | OT | | |
| 1 Rain Guard | 346BSP + 4" ODW | | PE | 08 71 00 | |
| 2 Sweep | 345BSPNB | | PE | 08 71 00 | |
| 1 Threshold | 252x3BSPFG | | PE | 08 71 00 | |

Set: 3.0

Doors: A101B

Description: EXTERIOR STOREFRONT PAIR CARD READER (BLACK FINISH) AUTO OPERATOR

| | | | | | |
|----------------------------------|--|-------|----|----------|---|
| 2 Continuous Hinge | BSPFM95SLF-HD1 PT | | PE | 08 71 00 | |
| 2 Electric Power Transfer | CEPT-10 | BSP | SU | 08 71 00 | ⚡ |
| 1 Mullion | CR908BKM CT7R | | RU | 08 71 00 | |
| 1 Rim Exit Device, Nightlatch | ED5200S K157ET M92 MELR M52 | BSP | RU | 08 71 00 | ⚡ |
| 1 Rim Exit Device, Exit Only | ED5200S EO M92 M52 | BSP | RU | 08 71 00 | ⚡ |
| 3 Mortise Cylinder/Core | Match Existing Pyramid LFIC Key System | Match | RU | 08 71 00 | |
| 1 Rim Cylinder/Core | Match Existing Pyramid LFIC Key System | Match | RU | 08 71 00 | |
| 2 Pull | RM201 | BSP | RO | 08 71 00 | |
| 1 Surface Closer w/ Hvy Dty Stop | DC8210 A11 | BSP | RU | 08 71 00 | |
| 1 Automatic Opener | 6071 RF | BSP | NO | 08 71 00 | ⚡ |
| 1 Perimeter Seals | By Door & Frame Manufacturer | | OT | | |
| 1 Rain Guard | 346BSP + 4" ODW | | PE | 08 71 00 | |
| 2 Sweep | 345BSPNB | | PE | 08 71 00 | |
| 1 Threshold | 252x3BSPFG | | PE | 08 71 00 | |
| 2 ElectroLynx Harness | QC-C012P | | MK | 08 71 00 | ⚡ |
| 2 ElectroLynx Harness | QC-C2500P | | MK | 08 71 00 | ⚡ |
| 2 Door Switch | 504 | | NO | 08 71 00 | ⚡ |
| 2 Position Switch | DPS-X-BK | | SU | 08 71 00 | ⚡ |
| 1 Power Supply | AQD x Amps Required | | SU | 08 71 00 | ⚡ |
| 1 Card Reader | By Security Contractor | | OT | | |

Set: 4.0

Doors: A114B, A127A

Description: EXTERIOR HM PAIR CARD READER SVR (BLACK FINISH)

| | | | | | |
|-------------------------------------|--|-------|----|----------|---|
| 2 Continuous Hinge | BSPFM83HD1 SER12 | | PE | 08 71 00 | |
| 1 Electrified SVR Exit, Fail Secure | ED5470 N9905ET M55 M92 M52 | BSP | RU | 08 71 00 | ⚡ |
| 1 Surface Vert Rod Exit, Dummy | ED5470 N950ET M55 M92 M52 | BSP | RU | 08 71 00 | ⚡ |
| 3 Mortise Cylinder/Core | Match Existing Pyramid LFIC Key System | Match | RU | 08 71 00 | |
| 2 Surface Closer w/ Hvy Dty Stop | DC8210 A11 | BSP | RU | 08 71 00 | |
| 2 Kick Plate | K1050 10" CSK BEV | BSP | RO | 08 71 00 | |
| 1 Astragal | 18041BSPNB | | PE | 08 71 00 | |
| 1 Rain Guard | 346BSP + 4" ODW | | PE | 08 71 00 | |
| 1 Gasketing | 2891BSPV | | PE | 08 71 00 | |
| 2 Sweep | 345BSPNB | | PE | 08 71 00 | |
| 1 Threshold | 252x3BSPFG | | PE | 08 71 00 | |
| 2 ElectroLynx Harness | QC-C2500P | | MK | 08 71 00 | ⚡ |
| 2 ElectroLynx Harness | QC-C300P | | MK | 08 71 00 | ⚡ |
| 2 Position Switch | DPS-X-BK | | SU | 08 71 00 | ⚡ |
| 1 Power Supply | AQD x Amps Required | | SU | 08 71 00 | ⚡ |
| 1 Card Reader | By Security Contractor | | OT | | |

Set: 5.0

Doors: A118

Description: EXTERIOR HM PAIR EXIT ONLY STC

| | | | | | |
|--|--------------------|-------|----|----------|--|
| 2 Continuous Hinge | CFM83HD1 | | PE | 08 71 00 | |
| 1 Mullion | CR972BKM 7'2" CT7R | | RU | 08 71 00 | |
| 2 Rim Exit Device, Exit Only | ED5200S EO | 630 | RU | 08 71 00 | |
| 2 Surface Closer w/ Hvy Dty Stop | DC8210 A11 | 689 | RU | 08 71 00 | |
| 2 Kick Plate | K1050 10" BEV CSK | US32D | RO | 08 71 00 | |
| 1 Rain Guard | 346C + 4" ODW | | PE | 08 71 00 | |
| 1 Gasketing (Mullion) | 5110BL | | PE | 08 71 00 | |
| 1 Acoustic Seal Set (Includes STC Threshold, Astragal) | PEMKOSTCSET-2A | BL | PE | 08 71 00 | |
| 2 Door Bottom | 420APKL 36" | | PE | 08 71 00 | |

Set: 6.0

Doors: A101E

Description: EXTERIOR HM PAIR EXIT ONLY RIM EXIT (BLACK FINISH)

| | | | | |
|----------------------------------|--|-------|----|----------|
| 2 Continuous Hinge | BSPFM83HDI | | PE | 08 71 00 |
| 1 Mullion | CR972BKM 7'2" CT7R | | RU | 08 71 00 |
| 2 Rim Exit Device, Exit Only | ED5200S EO | BSP | RU | 08 71 00 |
| 1 Mortise Cylinder/Core | Match Existing Pyramid LFIC Key System | Match | RU | 08 71 00 |
| 2 Surface Closer w/ Hvy Dty Stop | DC8210 A11 | BSP | RU | 08 71 00 |
| 1 Gasketing (Mullion) | 5110BL | | PE | 08 71 00 |
| 1 Rain Guard | 346BSP + 4" ODW | | PE | 08 71 00 |
| 1 Gasketing | 2891BSPV | | PE | 08 71 00 |
| 2 Sweep | 345BSPNB | | PE | 08 71 00 |
| 1 Threshold | 252x3BSPFG | | PE | 08 71 00 |

Set: 7.0

Doors: A117B

Description: SGL CLASSROOM FUNCTION OUTSWING (BLACK FINISH)

| | | | | |
|-------------------------|--|-------|----|----------|
| 3 Hinge, Full Mortise | TA2714 4-1/2" x 4-1/2" | BSP | MK | 08 71 00 |
| 1 Classroom Lock | ML2055 NSA | BSP | RU | 08 71 00 |
| 1 Mortise Cylinder/Core | Match Existing Pyramid LFIC Key System | Match | RU | 08 71 00 |
| 1 Surface Closer | DC8210 | BSP | RU | 08 71 00 |
| 1 Kick Plate | K1050 10" CSK BEV | BSP | RO | 08 71 00 |
| 1 Wall Stop | 406 | BSP | RO | 08 71 00 |
| 3 Silencer | 608-RKW | | RO | 08 71 00 |

Set: 8.0

Doors: A349A, A349B

Description: SGL STOREROOM FUNCTION INSWING RATED (BLACK FINISH)

| | | | | |
|-------------------------|--|-------|----|----------|
| 3 Hinge, Full Mortise | TA2714 4-1/2" x 4-1/2" | BSP | MK | 08 71 00 |
| 1 Storeroom Lock | ML2057 NSA | BSP | RU | 08 71 00 |
| 1 Mortise Cylinder/Core | Match Existing Pyramid LFIC Key System | Match | RU | 08 71 00 |
| 1 Surface Closer | DC8200 | BSP | RU | 08 71 00 |
| 1 Kick Plate | K1050 10" CSK BEV | BSP | RO | 08 71 00 |
| 1 Wall Stop | 406 | BSP | RO | 08 71 00 |
| 1 Gasketing | S773BL | | PE | 08 71 00 |

Set: 9.0

Doors: A131

Description: SGL STOREROOM FUNCTION INSWING RATED

| | | | | |
|-------------------------|--|-------|----|----------|
| 3 Hinge, Full Mortise | TA2714 4-1/2" x 4-1/2" | US26D | MK | 08 71 00 |
| 1 Storeroom Lock | ML2057 NSA | 626 | RU | 08 71 00 |
| 1 Mortise Cylinder/Core | Match Existing Pyramid LFIC Key System | Match | RU | 08 71 00 |
| 1 Surface Closer | DC8200 | 689 | RU | 08 71 00 |
| 1 Kick Plate | K1050 10" BEV CSK | US32D | RO | 08 71 00 |
| 1 Wall Stop | 406 | US32D | RO | 08 71 00 |
| 1 Gasketing | S773BL | | PE | 08 71 00 |

Set: 10.0

Doors: A109, A143B, A145, A154, A203

Description: SGL STOREROOM FUNCTION INSWING

| | | | | |
|-------------------------|--|-------|----|----------|
| 3 Hinge, Full Mortise | TA2714 4-1/2" x 4-1/2" | US26D | MK | 08 71 00 |
| 1 Storeroom Lock | ML2057 NSA | 626 | RU | 08 71 00 |
| 1 Mortise Cylinder/Core | Match Existing Pyramid LFIC Key System | Match | RU | 08 71 00 |
| 1 Surface Closer | DC8200 | 689 | RU | 08 71 00 |
| 1 Stop (Wall / Floor) | 406 / 481 To Suit | US26D | RO | 08 71 00 |
| 3 Silencer | 608-RKW | | RO | 08 71 00 |

Set: 11.0

Doors: A120B, A126

Description: SGL STOREROOM FUNCTION INSWING KP

| | | | | |
|-------------------------|--|-------|----|----------|
| 3 Hinge, Full Mortise | TA2714 4-1/2" x 4-1/2" | US26D | MK | 08 71 00 |
| 1 Storeroom Lock | ML2057 NSA | 626 | RU | 08 71 00 |
| 1 Mortise Cylinder/Core | Match Existing Pyramid LFIC Key System | Match | RU | 08 71 00 |
| 1 Surface Closer | DC8200 | 689 | RU | 08 71 00 |
| 1 Kick Plate | K1050 10" BEV CSK | US32D | RO | 08 71 00 |
| 1 Stop (Wall / Floor) | 406 / 481 To Suit | US26D | RO | 08 71 00 |
| 3 Silencer | 608-RKW | | RO | 08 71 00 |

Set: 12.0

Doors: A102B

Description: SGL STOREROOM FUNCTION OUTSWING

| | | | | |
|-------------------------|--|-------|----|----------|
| 3 Hinge, Full Mortise | TA2714 4-1/2" x 4-1/2" | US26D | MK | 08 71 00 |
| 1 Storeroom Lock | ML2057 NSA | 626 | RU | 08 71 00 |
| 1 Mortise Cylinder/Core | Match Existing Pyramid LFIC Key System | Match | RU | 08 71 00 |
| 1 Surface Closer | DC8210 | 689 | RU | 08 71 00 |
| 1 Stop (Wall / Floor) | 406 / 481 To Suit | US26D | RO | 08 71 00 |
| 3 Silencer | 608-RKW | | RO | 08 71 00 |

Set: 13.0

Doors: A117A

Description: SGL STOREROOM FUNCTION INSWING WIDE STC

| | | | | |
|---|--|-------|----|----------|
| 3 Hinge, Cam Lift | MKCL180 | US32D | MK | 08 71 00 |
| 1 Storeroom Lock | ML2057 NSA | 626 | RU | 08 71 00 |
| 1 Mortise Cylinder/Core | Match Existing Pyramid LFIC Key System | Match | RU | 08 71 00 |
| 1 Surface Closer | DC8200 | 689 | RU | 08 71 00 |
| 1 Kick Plate | K1050 10" BEV CSK | US32D | RO | 08 71 00 |
| 1 Stop (Wall / Floor) | 406 / 481 To Suit | US26D | RO | 08 71 00 |
| 1 Acoustic Seal Set (Includes Auto Door Bottom) | PEMKOSTCSET-1A | BL | PE | 08 71 00 |
| 1 Threshold | 151A | | PE | 08 71 00 |

Set: 14.0

Doors: A137

Description: SGL STOREROOM FUNCTION INSWING STC

| | | | | |
|---|--|-------|----|----------|
| 3 Hinge, Cam Lift | MKCL134 4-1/2" x 4-1/2" | US32D | MK | 08 71 00 |
| 1 Storeroom Lock | ML2057 NSA | 626 | RU | 08 71 00 |
| 1 Mortise Cylinder/Core | Match Existing Pyramid LFIC Key System | Match | RU | 08 71 00 |
| 1 Surface Closer | DC8200 | 689 | RU | 08 71 00 |
| 1 Stop (Wall / Floor) | 406 / 481 To Suit | US26D | RO | 08 71 00 |
| 1 Acoustic Seal Set (Includes Auto Door Bottom) | PEMKOSTCSET-1A | BL | PE | 08 71 00 |
| 1 Threshold | 151A | | PE | 08 71 00 |

Set: 15.0

Doors: A132, A133, A134

Description: SGL STOREROOM FUNCTION INSWING STC KP

| | | | | |
|---|--|-------|----|----------|
| 3 Hinge, Cam Lift | MKCL134 4-1/2" x 4-1/2" | US32D | MK | 08 71 00 |
| 1 Storeroom Lock | ML2057 NSA | 626 | RU | 08 71 00 |
| 1 Mortise Cylinder/Core | Match Existing Pyramid LFIC Key System | Match | RU | 08 71 00 |
| 1 Surface Closer | DC8200 | 689 | RU | 08 71 00 |
| 1 Kick Plate | K1050 10" BEV CSK | US32D | RO | 08 71 00 |
| 1 Stop (Wall / Floor) | 406 / 481 To Suit | US26D | RO | 08 71 00 |
| 1 Acoustic Seal Set (Includes Auto Door Bottom) | PEMKOSTCSET-1A | BL | PE | 08 71 00 |
| 1 Threshold | 151A | | PE | 08 71 00 |

Set: 16.0

Doors: A301A, A302B, A304

Description: SGL STOREROOM FUNCTION INSWING STC (BLACK FINISH)

| | | | | |
|---|--|-------|----|----------|
| 3 Hinge, Cam Lift | MKCL134 | BSP | MK | 08 71 00 |
| 1 Storeroom Lock | ML2057 NSA | BSP | RU | 08 71 00 |
| 1 Mortise Cylinder/Core | Match Existing Pyramid LFIC Key System | Match | RU | 08 71 00 |
| 1 Surface Closer | DC8200 | BSP | RU | 08 71 00 |
| 1 Wall Stop | 406 | US32D | RO | 08 71 00 |
| 1 Acoustic Seal Set (Includes Auto Door Bottom) | PEMKOSTCSET-1A | BL | PE | 08 71 00 |
| 1 Threshold | 151BSP | | PE | 08 71 00 |

Set: 17.0

Doors: A207

Description: SGL STOREROOM FUNCTION INSWING STC (BLACK FINISH) KP

| | | | | |
|---|--|-------|----|----------|
| 3 Hinge, Cam Lift | MKCL134 | BSP | MK | 08 71 00 |
| 1 Storeroom Lock | ML2057 NSA | BSP | RU | 08 71 00 |
| 1 Mortise Cylinder/Core | Match Existing Pyramid LFIC Key System | Match | RU | 08 71 00 |
| 1 Surface Closer | DC8200 | BSP | RU | 08 71 00 |
| 1 Kick Plate | K1050 10" CSK BEV | BSP | RO | 08 71 00 |
| 1 Wall Stop | 406 | US32D | RO | 08 71 00 |
| 1 Acoustic Seal Set (Includes Auto Door Bottom) | PEMKOSTCSET-1A | BL | PE | 08 71 00 |
| 1 Threshold | 151BSP | | PE | 08 71 00 |

Set: 18.0

Doors: A102, A104, A107

Description: SGL STOREROOM FUNCTION INSWING (BLACK FINISH) WIDE

| | | | | |
|-------------------------------|--|-------|----|----------|
| 3 Hinge, Full Mortise, Hvy Wt | T4A3786 5" x 4-1/2" | BSP | MK | 08 71 00 |
| 1 Storeroom Lock | ML2057 NSA | BSP | RU | 08 71 00 |
| 1 Mortise Cylinder/Core | Match Existing Pyramid LFIC Key System | Match | RU | 08 71 00 |
| 1 Surface Closer | DC8200 | BSP | RU | 08 71 00 |
| 1 Kick Plate | K1050 10" CSK BEV | BSP | RO | 08 71 00 |
| 1 Wall Stop | 406 | BSP | RO | 08 71 00 |
| 3 Silencer | 608-RKW | | RO | 08 71 00 |

Set: 19.0

Doors: A103B, A300, A303

Description: SGL STOREROOM FUNCTION INSWING (BLACK FINISH)

| | | | | |
|-------------------------|--|-------|----|----------|
| 3 Hinge, Full Mortise | TA2714 4-1/2" x 4-1/2" | BSP | MK | 08 71 00 |
| 1 Storeroom Lock | ML2057 NSA | BSP | RU | 08 71 00 |
| 1 Mortise Cylinder/Core | Match Existing Pyramid LFIC Key System | Match | RU | 08 71 00 |
| 1 Surface Closer | DC8200 | BSP | RU | 08 71 00 |
| 1 Wall Stop | 406 | BSP | RO | 08 71 00 |
| 3 Silencer | 608-RKW | | RO | 08 71 00 |

Set: 20.0

Doors: A302A

Description: SGL STOREROOM FUNCTION OUTSWING (BLACK FINISH)

| | | | | |
|-------------------------|--|-------|----|----------|
| 3 Hinge, Full Mortise | TA2714 4-1/2" x 4-1/2" | BSP | MK | 08 71 00 |
| 1 Storeroom Lock | ML2057 NSA | BSP | RU | 08 71 00 |
| 1 Mortise Cylinder/Core | Match Existing Pyramid LFIC Key System | Match | RU | 08 71 00 |
| 1 Surface Closer | DC8210 | BSP | RU | 08 71 00 |
| 1 Wall Stop | 406 | BSP | RO | 08 71 00 |
| 3 Silencer | 608-RKW | | RO | 08 71 00 |

Set: 21.0

Doors: A116B

Description: SGL STOREROOM FUNCTION INSWING WIDE RATED

| | | | | |
|-------------------------------|--|-------|----|----------|
| 3 Hinge, Full Mortise, Hvy Wt | T4A3786 5" x 4-1/2" | US26D | MK | 08 71 00 |
| 1 Storeroom Lock | ML2057 NSA | 626 | RU | 08 71 00 |
| 1 Mortise Cylinder/Core | Match Existing Pyramid LFIC Key System | Match | RU | 08 71 00 |
| 1 Surface Closer | DC8200 | 689 | RU | 08 71 00 |
| 1 Kick Plate | K1050 10" BEV CSK | US32D | RO | 08 71 00 |
| 1 Stop (Wall / Floor) | 406 / 481 To Suit | US26D | RO | 08 71 00 |
| 1 Gasketing | S773BL | | PE | 08 71 00 |

Set: 22.0

Doors: A116D

Description: SGL STOREROOM FUNCTION OUTSWING WIDE RATED CLOSER/STOP

| | | | | |
|-------------------------------|--|-------|----|----------|
| 3 Hinge, Full Mortise, Hvy Wt | T4A3786 5" x 4-1/2" | US26D | MK | 08 71 00 |
| 1 Storeroom Lock | ML2057 NSA | 626 | RU | 08 71 00 |
| 1 Mortise Cylinder/Core | Match Existing Pyramid LFIC Key System | Match | RU | 08 71 00 |
| 1 Surface Closer w/ Stop | DC8210 A4 | 689 | RU | 08 71 00 |
| 1 Kick Plate | K1050 10" BEV CSK | US32D | RO | 08 71 00 |
| 1 Gasketing | S773BL | | PE | 08 71 00 |

Set: 23.0

Doors: A124B, A125

Description: PAIR A/I STOREROOM FUNCTION RATED

| | | | | |
|-------------------------|--|-------|----|----------|
| 6 Hinge, Full Mortise | TA2714 4-1/2" x 4-1/2" | US26D | MK | 08 71 00 |
| 1 Dust Proof Strike | 570 | US26D | RO | 08 71 00 |
| 1 Flush Bolt | 2945 | US26D | RO | 08 71 00 |
| 1 Storeroom Lock | ML2057 NSA | 626 | RU | 08 71 00 |
| 1 Mortise Cylinder/Core | Match Existing Pyramid LFIC Key System | Match | RU | 08 71 00 |
| 1 Coordinator | 1700 | US28 | RO | 08 71 00 |
| 2 Surface Closer | DC8200 | 689 | RU | 08 71 00 |
| 2 Kick Plate | K1050 10" BEV CSK | US32D | RO | 08 71 00 |
| 2 Wall Stop | 406 | US32D | RO | 08 71 00 |
| 1 Astragal | 18041CNB | | PE | 08 71 00 |
| 1 Gasketing | S773BL | | PE | 08 71 00 |

Set: 24.0

Doors: A143A

Description: PAIR A/I STOREROOM FUNCTION

| | | | | |
|-------------------------|--|-------|----|----------|
| 6 Hinge, Full Mortise | TA2714 4-1/2" x 4-1/2" | US26D | MK | 08 71 00 |
| 1 Dust Proof Strike | 570 | US26D | RO | 08 71 00 |
| 1 Flush Bolt | 2945 | US26D | RO | 08 71 00 |
| 1 Storeroom Lock | ML2057 NSA | 626 | RU | 08 71 00 |
| 1 Mortise Cylinder/Core | Match Existing Pyramid LFIC Key System | Match | RU | 08 71 00 |
| 1 Coordinator | 1700 | Black | RO | 08 71 00 |
| 2 Surface Closer | DC8200 | 689 | RU | 08 71 00 |
| 2 Kick Plate | K1050 10" BEV CSK | US32D | RO | 08 71 00 |
| 2 Wall Stop | 406 | US32D | RO | 08 71 00 |
| 1 Astragal | 18041CNB | | PE | 08 71 00 |
| 2 Silencer | 608-RKW | | RO | 08 71 00 |

Set: 25.0

Doors: A115, A115B

Description: SGL STOREROOM FUNCTION RIM EXIT RATED

| | | | | |
|----------------------------------|--|-------|----|----------|
| 3 Hinge, Full Mortise | TA2714 4-1/2" x 4-1/2" | US26D | MK | 08 71 00 |
| 1 Fire Rated Rim Exit, Storeroom | ED5200SA N959ET | 630 | RU | 08 71 00 |
| 1 Rim Cylinder/Core | Match Existing Pyramid LFIC Key System | Match | RU | 08 71 00 |
| 1 Surface Closer | DC8210 | 689 | RU | 08 71 00 |
| 1 Wall Stop | 406 | US32D | RO | 08 71 00 |
| 1 Gasketing | S773BL | | PE | 08 71 00 |

Set: 26.0

Doors: A123

Description: SGL STOREROOM FUNCTION RIM RATED WIDE STC

| | | | | |
|---|--|-------|----|----------|
| 3 Hinge, Cam Lift | MKCL180 | US32D | MK | 08 71 00 |
| 1 Fire Rated Rim Exit, Storeroom | ED5200SA N959ET | 630 | RU | 08 71 00 |
| 1 Rim Cylinder/Core | Match Existing Pyramid LFIC Key System | Match | RU | 08 71 00 |
| 1 Surface Closer | DC8210 | 689 | RU | 08 71 00 |
| 1 Kick Plate | K1050 10" BEV CSK | US32D | RO | 08 71 00 |
| 1 Wall Stop | 406 | US32D | RO | 08 71 00 |
| 1 Acoustic Seal Set (Includes Auto Door Bottom) | PEMKOSTCSET-1A | BL | PE | 08 71 00 |
| 1 Threshold | 151A | | PE | 08 71 00 |

Set: 27.0

Doors: E106B

Description: SGL STOREROOM FUNCTION RIM EXIT RATED CLOSER/STOP

| | | | | |
|----------------------------------|--|-------|----|----------|
| 3 Hinge, Full Mortise | TA2714 4-1/2" x 4-1/2" | US26D | MK | 08 71 00 |
| 1 Fire Rated Rim Exit, Storeroom | ED5200SA N959ET | 630 | RU | 08 71 00 |
| 1 Rim Cylinder/Core | Match Existing Pyramid LFIC Key System | Match | RU | 08 71 00 |
| 1 Surface Closer w/ Hvy Dty Stop | DC8210 A11 | 689 | RU | 08 71 00 |
| 1 Kick Plate | K1050 10" BEV CSK | US32D | RO | 08 71 00 |
| 1 Gasketing | S773BL | | PE | 08 71 00 |

Set: 28.0

Doors: E101, E104

Description: SGL STOREROOM FUNCTION (NO CLOSER) STC

| | | | | |
|---|--|-------|----|----------|
| 3 Hinge, Cam Lift | MKCL134 4-1/2" x 4-1/2" | US32D | MK | 08 71 00 |
| 1 Storeroom Lock | ML2057 NSA | 626 | RU | 08 71 00 |
| 1 Mortise Cylinder/Core | Match Existing Pyramid LFIC Key System | Match | RU | 08 71 00 |
| 1 Wall Stop | 406 | US32D | RO | 08 71 00 |
| 1 Acoustic Seal Set (Includes Auto Door Bottom) | PEMKOSTCSET-1A | BL | PE | 08 71 00 |
| 1 Threshold | 151A | | PE | 08 71 00 |

Set: 29.0

Doors: E100A, E100B, E100C, E106A, E106C

Description: PAIR STOREROOM FUNCTION SVR STC

| | | | | |
|--|--|-------|----|----------|
| 6 Hinge, Cam Lift | MKCL180 | US32D | MK | 08 71 00 |
| 1 Surf Vert Rod, Storeroom | ED5470B N959ET M55 | 630 | RU | 08 71 00 |
| 1 Surf Vert Rod, Dummy | ED5470B N950ET M55 | 630 | RU | 08 71 00 |
| 1 Mortise Cylinder/Core | Match Existing Pyramid LFIC Key System | Match | RU | 08 71 00 |
| 2 Surface Closer w/ Hvy Dty Stop | DC8210 A11 | 689 | RU | 08 71 00 |
| 2 Kick Plate | K1050 10" BEV CSK | US32D | RO | 08 71 00 |
| 1 Acoustic Seal Set (Includes STC Threshold, Astragal) | PEMKOSTCSET-2A | BL | PE | 08 71 00 |

Notes: AT NON-RATED OPENINGS PROVIDE ED5400 PANIC DEVICES IN LIEU OF ED5470B.

A135: OMIT KICK PLATE.

Set: 30.0

Doors: A111A, A146A, A206A, A208A

Description: PAIR SVR x PULLS STC (BLACK FINISH)

| | | | | | |
|--|--|-------|----|----------|---|
| 6 Hinge, Cam Lift | MKCL180 | US32D | MK | 08 71 00 | |
| 1 Surface Vert Rod Exit | PED5450T M52 K157ET M55 | BSP | RU | 08 71 00 | |
| 1 Surface Vert Rod Exit | PED5440 EO M55 M52 | BSP | RU | 08 71 00 | ⚡ |
| 1 Mortise Cylinder/Core | Match Existing Pyramid LFIC Key System | Match | RU | 08 71 00 | |
| 2 Pull | RM3101-48 Mtg-Type 12XHD | BSP | RO | 08 71 00 | |
| 2 Surface Closer w/ Hvy Dty Stop | DC8210 A11 | BSP | RU | 08 71 00 | |
| 1 Acoustic Seal Set (Includes STC Threshold, Astragal) | PEMKOSTCSET-2A | BL | PE | 08 71 00 | |

Notes: MOUNT PULLS 7" FROM DOOR EDGE SO AS NOT TO BE AN OBSTRUCTION TO KEYED CYLINDER.

Set: 31.0

Doors: A135B

Description: PAIR STOREROOM FUNCTION SVR STC RATED (BLACK FINISH)

| | | | | | |
|--|--|-------|----|----------|--|
| 6 Hinge, Cam Lift | MKCL180 | US32D | MK | 08 71 00 | |
| 1 Fire Rated Surf Vert Rod, Storeroom | ED5470B N959ET M55 | BSP | RU | 08 71 00 | |
| 1 Fire Rated Surf Vert Rod, Dummy | ED5470B N950ET M55 | BSP | RU | 08 71 00 | |
| 1 Mortise Cylinder/Core | Match Existing Pyramid LFIC Key System | Match | RU | 08 71 00 | |
| 2 Surface Closer | DC8210 | BSP | RU | 08 71 00 | |
| 2 Kick Plate | K1050 10" CSK BEV | BSP | RO | 08 71 00 | |
| 2 Wall Stop | 406 | BSP | RO | 08 71 00 | |
| 1 Acoustic Seal Set (Includes STC Threshold, Astragal) | PEMKOSTCSET-2A | BL | PE | 08 71 00 | |

Set: 32.0

Doors: A101C

Description: PAIR STOREROOM FUNCTION SVR RATED MHO (CORRIDOR)

| | | | | | |
|----------------------------|--|-------|----|----------|---|
| 2 Continuous Hinge | CFM83HD1 | | PE | 08 71 00 | |
| 1 Surf Vert Rod, Storeroom | ED5470B N959ET M55 | 630 | RU | 08 71 00 | |
| 1 Surf Vert Rod, Dummy | ED5470B N950ET M55 | 630 | RU | 08 71 00 | |
| 1 Mortise Cylinder/Core | Match Existing Pyramid LFIC Key System | Match | RU | 08 71 00 | |
| 2 Surface Closer | DC8210 A3 | 689 | RU | 08 71 00 | |
| 2 Kick Plate | K1050 10" BEV CSK | US32D | RO | 08 71 00 | |
| 2 Electromagnetic Holder | 998M | 689 | RF | 08 71 00 | ⚡ |
| 1 Astragal | 18041CNB | | PE | 08 71 00 | |
| 1 Gasketing | S773BL | | PE | 08 71 00 | |

Set: 33.0

Doors: A112, A127

Description: PAIR STOREROOM FUNCTION SVR MHO (CORRIDOR)

| | | | | | |
|--------------------------------|--|-------|----|----------|---|
| 2 Continuous Hinge | CFM83HD1 | | PE | 08 71 00 | |
| 1 Surf Vert Rod, Storeroom | ED5470 N959ET M55 | 630 | RU | 08 71 00 | |
| 1 Surface Vert Rod Exit, Dummy | ED5470 N950ET M55 | 630 | RU | 08 71 00 | |
| 1 Mortise Cylinder/Core | Match Existing Pyramid LFIC Key System | Match | RU | 08 71 00 | |
| 2 Surface Closer | DC8210 A3 | 689 | RU | 08 71 00 | |
| 2 Kick Plate | K1050 10" BEV CSK | US32D | RO | 08 71 00 | |
| 2 Electromagnetic Holder | 998M | 689 | RF | 08 71 00 | ⚡ |
| 1 Astragal | 18041CNB | | PE | 08 71 00 | |
| 2 Silencer | 608-RKW | | RO | 08 71 00 | |

Set: 34.0

Doors: A127B

Description: PAIR STOREROOM FUNCTION SVR MHO (CORRIDOR) RATED

| | | | | | |
|----------------------------|--|-------|----|----------|---|
| 2 Continuous Hinge | CFM83HD1 | | PE | 08 71 00 | |
| 1 Surf Vert Rod, Storeroom | ED5470B N959ET M55 | 630 | RU | 08 71 00 | |
| 1 Surf Vert Rod, Dummy | ED5470B N950ET M55 | 630 | RU | 08 71 00 | |
| 1 Mortise Cylinder/Core | Match Existing Pyramid LFIC Key System | Match | RU | 08 71 00 | |
| 2 Surface Closer | DC8210 A3 | 689 | RU | 08 71 00 | |
| 2 Kick Plate | K1050 10" BEV CSK | US32D | RO | 08 71 00 | |
| 2 Electromagnetic Holder | 998M | 689 | RF | 08 71 00 | ⚡ |
| 1 Astragal | 18041CNB | | PE | 08 71 00 | |
| 1 Gasketing | S773BL | | PE | 08 71 00 | |

Set: 35.0

Doors: A112A

Description: PAIR CARD READER SVR MHO (CORRIDOR)

| | | | | | |
|-------------------------------------|--|-------|----|----------|---|
| 2 Continuous Hinge | CFM83HD1 EL-CEPTx32D | | PE | 08 71 00 | ↔ |
| 1 Electrified SVR Exit, Fail Secure | ED5470 N9905ET M55 M92 | 630 | RU | 08 71 00 | ↔ |
| 1 Surface Vert Rod Exit, Dummy | ED5470 N950ET M55 M92 | 630 | RU | 08 71 00 | ↔ |
| 1 Mortise Cylinder/Core | Match Existing Pyramid LFIC Key System | Match | RU | 08 71 00 | |
| 2 Surface Closer | DC8210 | 689 | RU | 08 71 00 | |
| 2 Electromagnetic Holder | 998M | 689 | RF | 08 71 00 | ↔ |
| 1 Astragal | 18041CNB | | PE | 08 71 00 | |
| 2 Silencer | 608-RKW | | RO | 08 71 00 | |
| 2 ElectroLynx Harness | QC-C2500P | | MK | 08 71 00 | ↔ |
| 2 ElectroLynx Harness | QC-C300P | | MK | 08 71 00 | ↔ |
| 2 Position Switch | DPS-X-GY | | SU | 08 71 00 | ↔ |
| 1 Power Supply | AQD x Amps Required | | SU | 08 71 00 | ↔ |
| 1 Card Reader | By Security Contractor | | OT | | |

Set: 36.0

Doors: A121A

Description: PAIR STOREROOM FUNCTION RIM EXIT WIDE STC

| | | | | | |
|--|--|-------|----|----------|--|
| 8 Hinge, Cam Lift | MKCL180 | US32D | MK | 08 71 00 | |
| 1 Mullion | CR910BKM CT7R | | RU | 08 71 00 | |
| 1 Rim Exit Device, Storeroom | ED5200S N959ET | 630 | RU | 08 71 00 | |
| 1 Rim Exit Device, Dummy | ED5200S N950ET | 630 | RU | 08 71 00 | |
| 1 Mortise Cylinder/Core | Match Existing Pyramid LFIC Key System | Match | RU | 08 71 00 | |
| 1 Rim Cylinder/Core | Match Existing Pyramid LFIC Key System | Match | RU | 08 71 00 | |
| 2 Surface Closer | DC8210 A3 | 689 | RU | 08 71 00 | |
| 2 Kick Plate | K1050 10" BEV CSK | US32D | RO | 08 71 00 | |
| 2 Wall Stop | 406 | US32D | RO | 08 71 00 | |
| 1 Gasketing | S773BL | | PE | 08 71 00 | |
| 1 Gasketing (Mullion) | 5110BL | | PE | 08 71 00 | |
| 1 Acoustic Seal Set (Includes STC Threshold, Astragal) | PEMKOSTCSET-2A | BL | PE | 08 71 00 | |

Set: 37.0

Doors: E100D

Description: PAIR STOREROOM FUNCTION SVR KP

| | | | | |
|--------------------------------|--|-------|----|----------|
| 6 Hinge, Full Mortise | TA2714 4-1/2" x 4-1/2" | US26D | MK | 08 71 00 |
| 1 Surf Vert Rod, Storeroom | ED5470 N959ET M55 | 630 | RU | 08 71 00 |
| 1 Surface Vert Rod Exit, Dummy | ED5470 N950ET M55 | 630 | RU | 08 71 00 |
| 1 Mortise Cylinder/Core | Match Existing Pyramid LFIC Key System | Match | RU | 08 71 00 |
| 2 Surface Closer | DC8210 | 689 | RU | 08 71 00 |
| 2 Kick Plate | K1050 10" BEV CSK | US32D | RO | 08 71 00 |
| 2 Wall Stop | 406 | US32D | RO | 08 71 00 |
| 1 Astragal | 18041CNB | | PE | 08 71 00 |
| 1 Gasketing | S773BL | | PE | 08 71 00 |

Set: 38.0

Doors: A300A

Description: PAIR STOREROOM FUNCTION SVR

| | | | | |
|--------------------------------|--|-------|----|----------|
| 6 Hinge, Full Mortise | TA2714 4-1/2" x 4-1/2" | US26D | MK | 08 71 00 |
| 1 Surf Vert Rod, Storeroom | ED5470 N959ET M55 | 630 | RU | 08 71 00 |
| 1 Surface Vert Rod Exit, Dummy | ED5470 N950ET M55 | 630 | RU | 08 71 00 |
| 1 Mortise Cylinder/Core | Match Existing Pyramid LFIC Key System | Match | RU | 08 71 00 |
| 2 Surface Closer | DC8210 | 689 | RU | 08 71 00 |
| 2 Wall Stop | 406 | US32D | RO | 08 71 00 |
| 1 Astragal | 18041CNB | | PE | 08 71 00 |
| 1 Gasketing | S773BL | | PE | 08 71 00 |

Set: 39.0

Doors: A205

Description: SGL STOREROOM FUNCTION RIM EXIT (BLACK FINISH)

| | | | | |
|------------------------------|--|-------|----|----------|
| 3 Hinge, Full Mortise | TA2714 4-1/2" x 4-1/2" | BSP | MK | 08 71 00 |
| 1 Rim Exit Device, Storeroom | ED5200S N959ET | BSP | RU | 08 71 00 |
| 1 Rim Cylinder/Core | Match Existing Pyramid LFIC Key System | Match | RU | 08 71 00 |
| 1 Surface Closer w/ Stop | DC8210 A4 | BSP | RU | 08 71 00 |
| 1 Kick Plate | K1050 10" CSK BEV | BSP | RO | 08 71 00 |
| 3 Silencer | 608-RKW | | RO | 08 71 00 |

Set: 40.0

Doors: A144B

Description: SGL STOREROOM FUNCTION RIM EXIT RATED (BLACK FINISH) RATED

| | | | | |
|----------------------------------|--|-------|----|----------|
| 3 Hinge, Full Mortise | TA2714 4-1/2" x 4-1/2" | BSP | MK | 08 71 00 |
| 1 Fire Rated Rim Exit, Storeroom | ED5200SA N959ET | BSP | RU | 08 71 00 |
| 1 Rim Cylinder/Core | Match Existing Pyramid LFIC Key System | Match | RU | 08 71 00 |
| 1 Surface Closer w/ Stop | DC8210 A4 | BSP | RU | 08 71 00 |
| 1 Kick Plate | K1050 10" CSK BEV | BSP | RO | 08 71 00 |
| 1 Gasketing | S773BL | | PE | 08 71 00 |

Set: 41.0

Doors: A108

Description: SGL PRIVACY FUNCTION INSWING (BLACK FINISH)

| | | | | |
|-----------------------|------------------------|-----|----|----------|
| 3 Hinge, Full Mortise | TA2714 4-1/2" x 4-1/2" | BSP | MK | 08 71 00 |
| 1 Privacy Lock | ML2030 NSA M19V | BSP | RU | 08 71 00 |
| 1 Surface Closer | DC8200 | BSP | RU | 08 71 00 |
| 1 Wall Stop | 406 | BSP | RO | 08 71 00 |
| 3 Silencer | 608-RKW | | RO | 08 71 00 |

Set: 42.0

Doors: A128B, A129B, A138

Description: SGL PRIVACY FUNCTION INSWING

| | | | | |
|-----------------------|------------------------|-------|----|----------|
| 3 Hinge, Full Mortise | TA2714 4-1/2" x 4-1/2" | US26D | MK | 08 71 00 |
| 1 Privacy Lock | ML2030 NSA M19V | 626 | RU | 08 71 00 |
| 1 Surface Closer | DC8200 | 689 | RU | 08 71 00 |
| 1 Wall Stop | 406 | US32D | RO | 08 71 00 |
| 3 Silencer | 608-RKW | | RO | 08 71 00 |

Set: 43.0

Doors: A128A, A129A, A130

Description: SGL PRIVACY/ENTRANCE FUNCTION CLOSER/STOP RATED

| | | | | |
|------------------------------|--|-------|----|----------|
| 3 Hinge, Full Mortise | TA2714 4-1/2" x 4-1/2" | US26D | MK | 08 71 00 |
| 1 Entrance Lock w/ Indicator | ML2024 NSVN V33 | 626 | RU | 08 71 00 |
| 1 Mortise Cylinder/Core | Match Existing Pyramid LFIC Key System | Match | RU | 08 71 00 |
| 1 Surface Closer w/ Stop | DC8210 A4 | 689 | RU | 08 71 00 |
| 1 Gasketing | S773BL | | PE | 08 71 00 |

Set: 44.0

Doors: A139

Description: SGL ENTRY FUNCTION CLOSER/STOP

| | | | | |
|-------------------------------|--|-------|----|----------|
| 3 Hinge, Full Mortise, Hvy Wt | T4A3786 5" x 4-1/2" | US26D | MK | 08 71 00 |
| 1 Entrance Lock | ML2024 NSA | 626 | RU | 08 71 00 |
| 1 Mortise Cylinder/Core | Match Existing Pyramid LFIC Key System | Match | RU | 08 71 00 |
| 1 Surface Closer w/ Stop | DC8210 A4 | 689 | RU | 08 71 00 |
| 3 Silencer | 608-RKW | | RO | 08 71 00 |

Set: 45.0

Doors: E102A, E102B, E103

Description: SGL ENTRY FUNCTION STC

| | | | | |
|---|--|-------|----|----------|
| 3 Hinge, Cam Lift | MKCL134 4-1/2" x 4-1/2" | US32D | MK | 08 71 00 |
| 1 Entrance Lock | ML2024 NSA | 626 | RU | 08 71 00 |
| 1 Mortise Cylinder/Core | Match Existing Pyramid LFIC Key System | Match | RU | 08 71 00 |
| 1 Wall Stop | 406 | US32D | RO | 08 71 00 |
| 1 Acoustic Seal Set (Includes Auto Door Bottom) | PEMKOSTCSET-1A | BL | PE | 08 71 00 |
| 1 Threshold | 151A | | PE | 08 71 00 |

Set: 46.0

Doors: A106

Description: SGL ENTRY FUNCTION INSWING (BLACK FINISH)

| | | | | |
|-------------------------|--|-------|----|----------|
| 3 Hinge, Full Mortise | TA2714 4-1/2" x 4-1/2" | BSP | MK | 08 71 00 |
| 1 Entrance Lock | ML2024 NSA | BSP | RU | 08 71 00 |
| 1 Mortise Cylinder/Core | Match Existing Pyramid LFIC Key System | Match | RU | 08 71 00 |
| 1 Surface Closer | DC8200 | BSP | RU | 08 71 00 |
| 1 Wall Stop | 406 | BSP | RO | 08 71 00 |
| 3 Silencer | 608-RKW | | RO | 08 71 00 |

Set: 47.0

Doors: A140

Description: SGL ENTRY FUNCTION NO CLOSER

| | | | | |
|-------------------------|--|-------|----|----------|
| 3 Hinge, Full Mortise | TA2714 4-1/2" x 4-1/2" | US26D | MK | 08 71 00 |
| 1 Entrance Lock | ML2024 NSA | 626 | RU | 08 71 00 |
| 1 Mortise Cylinder/Core | Match Existing Pyramid LFIC Key System | Match | RU | 08 71 00 |
| 1 Wall Stop | 406 | US32D | RO | 08 71 00 |
| 3 Silencer | 608-RKW | | RO | 08 71 00 |

Set: 48.0

Doors: A121C

Description: SGL PUSH/PULL (BSP FINISH) WIDE

| | | | | |
|-------------------------------|--------------------------|-------|----|----------|
| 3 Hinge, Full Mortise, Hvy Wt | T4A3786 5" x 4-1/2" | BSP | MK | 08 71 00 |
| 1 Pull | RM3101-48 Mtg-Type 12XHD | BSP | RO | 08 71 00 |
| 1 Push Plate | RM1010 | Match | RO | 08 71 00 |
| 1 Surface Closer | DC8210 | BSP | RU | 08 71 00 |
| 1 Kick Plate | K1050 10" CSK BEV | BSP | RO | 08 71 00 |
| 1 Wall Stop | 406 | BSP | RO | 08 71 00 |
| 1 Gasketing | S773BL | | PE | 08 71 00 |

Set: 49.0

Doors: A344

Description: SGL PASSAGE FUNCTION RIM EXIT STC (BLACK FINISH)

| | | | | |
|---|-------------------|-----|----|----------|
| 3 Hinge, Cam Lift | MKCL134 | BSP | MK | 08 71 00 |
| 1 Rim Exit Device, Passage | ED5200S N910ET | BSP | RU | 08 71 00 |
| 1 Surface Closer | DC8210 | BSP | RU | 08 71 00 |
| 1 Kick Plate | K1050 10" CSK BEV | BSP | RO | 08 71 00 |
| 1 Wall Stop | 406 | BSP | RO | 08 71 00 |
| 1 Acoustic Seal Set (Includes Auto Door Bottom) | PEMKOSTCSET-1A | BL | PE | 08 71 00 |
| 1 Gasketing | S773BL | | PE | 08 71 00 |
| 1 Threshold | 151BSP | | PE | 08 71 00 |

Set: 50.0

Doors: A144C

Description: SGL PASSAGE FUNCTION RIM EXIT STC

| | | | | |
|---|-------------------|-------|----|----------|
| 3 Hinge, Cam Lift | MKCL134 | US32D | MK | 08 71 00 |
| 1 Rim Exit Device, Passage | ED5200S N910ET | 630 | RU | 08 71 00 |
| 1 Surface Closer | DC8210 | 689 | RU | 08 71 00 |
| 1 Kick Plate | K1050 10" BEV CSK | US32D | RO | 08 71 00 |
| 1 Wall Stop | 406 | US32D | RO | 08 71 00 |
| 1 Acoustic Seal Set (Includes Auto Door Bottom) | PEMKOSTCSET-1A | BL | PE | 08 71 00 |
| 1 Gasketing | S773BL | | PE | 08 71 00 |
| 1 Threshold | 151A | | PE | 08 71 00 |

Set: 51.0

Doors: A144A

Description: SGL PASSAGE FUNCTION RIM EXIT (BLACK FINISH)

| | | | | |
|----------------------------|------------------------|-----|----|----------|
| 3 Hinge, Full Mortise | TA2714 4-1/2" x 4-1/2" | BSP | MK | 08 71 00 |
| 1 Rim Exit Device, Passage | ED5200S N910ET | BSP | RU | 08 71 00 |
| 1 Surface Closer | DC8210 | BSP | RU | 08 71 00 |
| 1 Kick Plate | K1050 10" CSK BEV | BSP | RO | 08 71 00 |
| 1 Wall Stop | 406 | BSP | RO | 08 71 00 |
| 1 Gasketing | S773BL | | PE | 08 71 00 |

Set: 52.0

Doors: A105, A110, A202, A204

Description: SGL PUSH / PULL (BLACK FINISH)

| | | | | |
|-------------------------|--|-------|----|----------|
| 3 Hinge, Full Mortise | TA2714 4-1/2" x 4-1/2" | BSP | MK | 08 71 00 |
| 1 Deadbolt | DL4117 | BSP | RU | 08 71 00 |
| 1 Mortise Cylinder/Core | Match Existing Pyramid LFIC Key System | Match | RU | 08 71 00 |
| 1 Push Plate | RM1010 | Match | RO | 08 71 00 |
| 1 Pull | RM3101-12 Mtg-Type 12XHD | BSP | RO | 08 71 00 |
| 1 Surface Closer | DC8200 | BSP | RU | 08 71 00 |
| 1 Kick Plate | K1050 10" CSK BEV | BSP | RO | 08 71 00 |
| 1 Mop Plate | K1050 6" CSK BEV | BSP | RO | 08 71 00 |
| 1 Wall Stop | 406 | BSP | RO | 08 71 00 |
| 3 Silencer | 608-RKW | | RO | 08 71 00 |

Set: 53.0

Doors: A135A

Description: PAIR PUSH/PULL (BSP FINISH) KP

| | | | | |
|-----------------------|--------------------------|-------|----|----------|
| 6 Hinge, Full Mortise | TA2714 4-1/2" x 4-1/2" | BSP | MK | 08 71 00 |
| 2 Pull | RM3101-48 Mtg-Type 12XHD | BSP | RO | 08 71 00 |
| 2 Push Plate | RM1010 | Match | RO | 08 71 00 |
| 2 Surface Closer | DC8210 | BSP | RU | 08 71 00 |
| 2 Kick Plate | K1050 10" CSK BEV | BSP | RO | 08 71 00 |
| 2 Wall Stop | 406 | BSP | RO | 08 71 00 |
| 1 Astragal | 18041BSPNB | | PE | 08 71 00 |
| 1 Gasketing | S773BL | | PE | 08 71 00 |

Notes:

Set: 54.0

Doors: A111B, A146B, A206B, A208B

Description: PAIR PUSH/PULL (BSP FINISH)

| | | | | | |
|-----------------------|--------------------------|-------|----|----------|--|
| 6 Hinge, Full Mortise | TA2714 4-1/2" x 4-1/2" | BSP | MK | 08 71 00 | |
| 2 Pull | RM3101-48 Mtg-Type 12XHD | BSP | RO | 08 71 00 | |
| 2 Push Plate | RM1010 | Match | RO | 08 71 00 | |
| 2 Surface Closer | DC8210 | BSP | RU | 08 71 00 | |
| 2 Wall Stop | 406 | BSP | RO | 08 71 00 | |
| 1 Astragal | 18041BSPNB | | PE | 08 71 00 | |
| 1 Gasketing | S773BL | | PE | 08 71 00 | |

Notes: MOUNT PULLS 7" FROM EDGE OF DOOR.

Set: 55.0

Doors: A114A, A116A, A116C, A119, A120A, A121B, A124A

Description: OVERHEAD DOOR

| | | | | | |
|-----------------------|--|-------|----|----------|--|
| 2 Rim Cylinder/Core | Match Existing Pyramid LFIC Key System | Match | RU | 08 71 00 | |
| 1 Balance of Hardware | By Assembly Manufacturer | | OT | | |

Set: 56.0

Doors: A205A

Description: SGL CARD READER LOCK OUTSWING WIDE

| | | | | | |
|-------------------------------|--|-------|----|----------|---|
| 3 Hinge, Full Mortise, Hvy Wt | T4A3786 5" x 4-1/2" | US26D | MK | 08 71 00 | |
| 1 Electric Power Transfer | CEPT-10 | 630 | SU | 08 71 00 | ⚡ |
| 1 Fail Secure Lock | ML20906-SEC NSA M92 | 626 | RU | 08 71 00 | ⚡ |
| 1 Mortise Cylinder/Core | Match Existing Pyramid LFIC Key System | Match | RU | 08 71 00 | |
| 1 Surface Closer | DC8210 | 689 | RU | 08 71 00 | |
| 1 Wall Stop | 406 | US32D | RO | 08 71 00 | |
| 3 Silencer | 608-RKW | | RO | 08 71 00 | |
| 1 ElectroLynx Harness | QC-C2500P | | MK | 08 71 00 | ⚡ |
| 1 ElectroLynx Harness | QC-C300P | | MK | 08 71 00 | ⚡ |
| 1 Position Switch | DPS-X-GR | | SU | 08 71 00 | ⚡ |
| 1 Power Supply | AQD x Amps Required | | SU | 08 71 00 | ⚡ |
| 1 Card Reader | By Security Contractor | | OT | | |

Set: 57.0

Doors: A142

Description: SGL CARD READER LOCK INSWING WIDE

| | | | | | |
|-------------------------------|--|-------|----|----------|---|
| 3 Hinge, Full Mortise, Hvy Wt | T4A3786 5" x 4-1/2" | US26D | MK | 08 71 00 | |
| 1 Electric Power Transfer | CEPT-10 | 630 | SU | 08 71 00 | ⚡ |
| 1 Fail Secure Lock | ML20906-SEC NSA M92 | 626 | RU | 08 71 00 | ⚡ |
| 1 Mortise Cylinder/Core | Match Existing Pyramid LFIC Key System | Match | RU | 08 71 00 | |
| 1 Surface Closer | DC8200 | 689 | RU | 08 71 00 | |
| 1 Wall Stop | 406 | US32D | RO | 08 71 00 | |
| 3 Silencer | 608-RKW | | RO | 08 71 00 | |
| 1 ElectroLynx Harness | QC-C2500P | | MK | 08 71 00 | ⚡ |
| 1 ElectroLynx Harness | QC-C300P | | MK | 08 71 00 | ⚡ |
| 1 Position Switch | DPS-X-GR | | SU | 08 71 00 | ⚡ |
| 1 Power Supply | AQD x Amps Required | | SU | 08 71 00 | ⚡ |
| 1 Card Reader | By Security Contractor | | OT | | |

Set: 58.0

Doors: A101M, A101N

Description: OPENING(S) NOT FOUND

| | | | | | |
|------------|-----------|--|--|--|----|
| 1 Openings | Not Found | | | | OT |
|------------|-----------|--|--|--|----|

Notes: OPENINGS LISTED IN DOOR SCHEDULE, NOT TAGGED ON FLOOR PLANS.

END OF DOCUMENT

SECTION 22 05 17

SLEEVES AND SLEEVE SEALS FOR PLUMBING PIPING

PART 1 - GENERAL

1.1 SUMMARY

- A. Section Includes:
 - 1. Sleeves.
 - 2. Stack-sleeve fittings.
 - 3. Sleeve-seal systems.
 - 4. Sleeve-seal fittings.
 - 5. Grout.
 - 6. Silicone sealants.

1.2 WORK INCLUDED

- A. Furnish all labor, materials, services, testing, transportation, and equipment necessary for the completion of all plumbing work as indicated on drawings and specified herein. Work materials and equipment not indicated or specified which is necessary for the complete and proper operation of the work of this Section in accordance with the true intent and meaning of the contract documents shall be provided and incorporated at no additional cost to the Owner.

1.3 QUALITY ASSURANCE

- A. Code Requirements: All work covered by this Section shall conform to the latest requirements of the following regulations:
 - 1. 2018 California Plumbing Code.
 - 2. Any other legally constituted body-having jurisdiction thereof.
- B. Nothing in the specifications or drawings shall be construed to permit deviation from the requirements of governing codes unless approval for said deviation has been obtained from the legally constituted authorities having jurisdiction and from the Owner's representative.
- C. Welding Qualifications: Qualify procedures and personnel according to AWS D1.1/D1.1M, "Structural Welding Code - Steel."
- D. Pipe and Pressure-Vessel Welding Qualifications: Qualify procedures and operators according to ASME Boiler and Pressure Vessel Code.

1.4 DRAWINGS

- A. Because of the small-scale drawings, it is not possible to indicate all offsets, fittings and accessories which may be required. The Contractor shall carefully investigate the conditions surrounding installation of his work, furnishing the necessary piping, fittings, valves, traps, and other devices which may be required to complete the installation.
- B. The general arrangement indicated on the drawings shall be followed as closely as possible. Coordinate with the Architectural, Structural, Mechanical and Electrical Drawings and the work of other trades prior to installation of piping fixtures and equipment to verify adequate space available for installation of the work

shown. In the event a field condition arises which makes it impossible to install the work as indicated, submit, in writing, the proposed departures to the Architect for his approval. Only when Architect's approval is given, in writing, shall Contractor proceed with installation of the work.

- C. Special Note: Should the Contractor make changes in the installation differing from what is indicated on the contract drawings and not necessitated due to field conditions as indicated hereinabove, the Contractor shall be required to re-install the work to comply with what has been indicated on the contract drawings. Should it be impossible to re-install the work and the installation is in accordance with all governing authorities, the architect may permit the installation to remain. However, all costs incurred to revise the contract drawings by the engineer for resubmittal to the building department indicating the as-installed condition shall become the responsibility of the Contractor.
- D. In case of a difference in the specifications or between the specifications and the drawings, the Contractor shall figure the most expensive alternate and after award of contract, shall secure direction from the Architect.

1.5 PROTECTION

- A. All work, equipment and materials shall be protected at all times. Contractor shall make good all damage caused either directly or indirectly by his own workmen. Contractor shall also protect his own work from damage. He shall close all pipe openings with caps or plugs during installation. He shall protect all his equipment and materials against dirt, water, chemical and mechanical injury. Upon completion, all work shall be thoroughly cleaned and delivered in a new condition.
- B. Contractor shall be held responsible for all damage to equipment and materials until he has received written notice from the Architect or Engineer that his work has been accepted.

1.6 LOCATIONS

- A. The locations of apparatus, piping and equipment indicated on the drawings are approximate. Piping and equipment shall be installed in such a manner as to avoid all obstruction, preserve headroom, and keep openings and passages clear. The locations of and mounting heights of all fixtures shall be coordinated with the architectural plans and room elevations.
- B. Clearances and Openings: Contractor shall cooperate and coordinate his work with all other trades to avoid conflict and permit for a neat and orderly appearance of the entire installation. The Contractor shall, in advance of the work, furnish instructions to the General Contractor as to his requirements for equipment and material installation of any kind, whether or not specifically mentioned on drawings or in the specifications, and shall include recesses, chases in walls, and all required openings in the structure. Should furnishing this information be neglected, delayed or incorrect and additional cuttings are found to be required, the cost of the same shall be charged to this Contractor.
- C. Contractor shall verify and coordinate pipe routing with location of all electrical rooms, elevator equipment rooms, telecom/data rooms, and other rooms dedicated to the housing of switchgear, panels, or other electrical equipment. In no case shall piping be installed within or above the ceiling of such rooms.

1.7 ACTION SUBMITTALS

- A. Product Data: For each type of product.

1.8 SUBMITTAL DATA

- A. Submittal Requirements:

1. Furnish, all at one time, prior to any installation, within the time noted below, one (1) digital (PDF) copy of valid submittal data on all fixtures, material, equipment, and devices. Each submitted item shall be indexed and referenced to these specifications (1 pdf submittal for each specification section) and to identification numbers on fixtures and equipment schedules.
2. Manufacturers' submittal literature and shop drawings are required on all items to ensure the latest and most complete manufacturer's data is available for review. Requirements of the submittals and Engineer's submittal notes are a part of the work of this Division except that Engineer's notes may not be used as a means of increasing the scope of work of this Division.
3. Submittals will be checked for general conformance with the design concept of the project, but the review does not guarantee quantities shown and does not supersede requirements of this Division to properly install work.
4. To be valid, all submittals must:
 - a. Be delivered to the Architect's office within thirty-five (35) days of award of the contract. Contractor shall make time allowance for Engineer's review, return of comments, if any, and resubmittal if required. Corrections or changes in submittals returned as inadequate or incomplete shall be accomplished within this time limit.
 - b. Clearly indicate and label as such any items proposed as substitution for that specified or shown on plans.
 - c. Include all pertinent construction, installation, performance, and technical data.
 - d. Have all product data sheets clearly labeled to indicate the individual items being submitted. In addition, all required options and accessories shall be clearly marked.
 - 1) Product data sheets corresponding to items indicated on plans shall be clearly labeled with the corresponding fixture or equipment tag number.
 - 2) Product data sheets corresponding to items indicated in specifications shall be clearly labeled with the specification section, page, and item numbers.
 - e. Include, for every item which differs in size, configuration, connections, service, accessibility or any other significant way, a drawing to the same (or larger) scale as to the pertinent portions of the contract drawings. In this drawing show a complete layout of the system except that which is identical to the contract drawings unless the unchanged portions must be shown to indicate such things as clearances. This drawing, together with the contract design drawings must show the complete system as revised to accommodate the proposed alternative.

B. Substitution Requirements:

1. Any items included in submittals and proposed by the Contractor as substitution for that specified or shown on plans shall be submitted within thirty-five (35) days of award of the contract. After such time, proposed substitutions shall not be accepted for review, and the Contractor shall submit all items as specified or shown on plans.
 - a. For each item proposed as substitution for that specified or shown on plans, copies of product data sheets for the specified item shall be placed side by side with product data sheets for the proposed substitution item within the submittal.
 - 1) In addition to the Submittal Requirements for labeling listed above, product data sheets for the specified item shall be clearly labeled "SPECIFIED ITEM, NOT SUBMITTED". Product data sheets for the corresponding proposed substitution item shall be clearly labeled "PROPOSED SUBSTITUTION".
 - b. Provide calculations and other detailed data justifying how any items proposed as substitution were selected for proposal. Data must be complete enough to permit detailed comparison of every significant characteristic for which the specified item was analyzed during design.
2. It shall be the Contractor's responsibility to provide sufficient information to allow the Engineer to analyze any proposed alternate. If inadequate information is provided, the proposal will not be approved, and resubmittal will not be allowed.

3. The Contractor shall provide or perform tests required by Engineer for purpose of judging acceptability of proposed substitutions.
4. The Contractor assumes full responsibility that alternate items and procedures will meet the job requirements and is responsible for cost of redesign and of modifications to this and other parts of work caused by alternate items furnished under work in this Section. In view of these responsibilities, it is the purpose of these specifications to establish procedures to ensure that the Contractor has considered all the ramifications of proposed alternates before submitting them for review. Submittals which do not comply with the requirements of these specifications, or which indicate proposed alternates that were selected without proper regard to the requirements of the job will not be approved. No more than one proposed alternate will be considered for each item.
5. Alternate items installed without Engineer's approval will be replaced with specified items at Contractor's expense.
6. The Architect or his authorized representative shall be the sole judge as to the quality and suitability of proposed alternate equipment, fixtures, or materials. Decisions of the Architect or that of his representative shall be final and conclusive.

1.9 INFORMATIONAL SUBMITTALS

- A. Field quality-control reports.

1.10 UNINSPECTED WORK

- A. The Contractor shall not allow or cause any of his work to be covered up or closed in until it has been inspected, tested, approved by all authorities have jurisdiction, and until Project Record drawings have been properly annotated.
- B. Should any of his work be covered up or closed in before such inspection, he shall, at his own expense, uncover the work to the satisfaction of the inspection party. All related repair work cost shall be borne by the Contractor.

1.11 RECORD DRAWINGS

- A. Contractor shall provide and keep up to date a complete "as-built" record set of blue-line prints which shall show every change from the original drawings and the exact "as-built" locations and sizes of the work provided under this Section of the specifications. This set shall include locations, dimensions, depth of buried piping, cleanouts, shut-off valves, sewer invert locations, plugged wyes, tees, etc. On completion of the work, the Contractor shall incorporate all as-built information on a set of reproducible tracings provided by the Architect and this set of reproducible tracings shall be delivered to the Architect.

1.12 GUARANTEES

- A. Contractor shall guarantee the entire plumbing and piping systems unconditionally for a period of one (1) year after final acceptance. If, during this period, any materials, equipment, or any part of the systems fail to function properly, the Contractor shall make good the defects promptly and without any expense to the Owner.
- B. Contractor shall be responsible for all damage to any part of the premises caused by leaks in pipelines or equipment furnished and installed under this Section for a period of one (1) year after date of acceptance of his work.
- C. All equipment and fixtures shall carry manufacturer's warranty against defective parts or poor workmanship for not less than one (1) year. See specific equipment specifications for extended warranty requirements.

PART 2 - PRODUCTS

2.1 SLEEVES

- A. Cast-Iron Pipe Sleeves: Cast or fabricated of cast or ductile iron and equivalent to ductile-iron pressure pipe, with plain ends and integral waterstop collar.
- B. Steel Pipe Sleeves: ASTM A53/A53M, Type E, Grade B, Schedule 40, anticorrosion coated or galvanized, with plain ends and integral welded waterstop collar.
- C. Galvanized-Steel Sheet Sleeves: 0.0239-inch minimum thickness; round tube closed with welded longitudinal joint.
- D. PVC Pipe Sleeves: ASTM D1785, Schedule 40.
- E. Molded-PVC Sleeves: With nailing flange for attaching to wooden forms.
- F. Molded-PE or -PP Sleeves: Removable, tapered-cup shaped, and smooth outer surface with nailing flange for attaching to wooden forms.

2.2 STACK-SLEEVE FITTINGS

- A. Manufacturers: Subject to compliance with requirements, provide products by one of the following:
 - 1. Zurn.
 - 2. JR Smith.
- B. Description: Manufactured, Dura-coated or Duco-coated galvanized cast-iron sleeve with integral clamping flange for use in waterproof floors and roofs. Include clamping ring, bolts, and nuts for membrane flashing.
 - 1. Underdeck Clamp: Clamping ring with setscrews.

2.3 SLEEVE-SEAL SYSTEMS

- A. Manufacturers: Subject to compliance with requirements, provide products by one of the following:
 - 1. Advance Products & Systems, Inc.
 - 2. Metraflex Company (The).
 - 3. Pipeline Seal and Insulator, Inc.
- B. Description:
 - 1. Modular sealing-element unit, designed for field assembly, for filling annular space between piping and sleeve.
 - 2. Designed to form a hydrostatic seal of 20 psig minimum.
 - 3. Sealing Elements: EPDM-rubber interlocking links shaped to fit surface of pipe. Include type and number required for pipe material and size of pipe.
 - 4. Pressure Plates: Stainless steel.
 - 5. Connecting Bolts and Nuts: Stainless steel of length required to secure pressure plates to sealing elements.

2.4 SLEEVE-SEAL FITTINGS

- A. Manufacturers: Subject to compliance with requirements, provide products by one of the following:

1. Advance Products & Systems, Inc.
2. Metraflex Company (The).
3. Pipeline Seal and Insulator, Inc.

- B. Description: Manufactured plastic, sleeve-type, waterstop assembly made for imbedding in concrete slab or wall.
- C. Plastic or rubber waterstop collar with center opening to match piping OD.

2.5 GROUT

- A. Description: Nonshrink, for interior and exterior sealing openings in non-fire-rated walls or floors.
- B. Standard: ASTM C1107/C1107M, Grade B, post-hardening and volume-adjusting, dry, hydraulic-cement grout.
- C. Design Mix: 5000-psi, 28-day compressive strength.
- D. Packaging: Premixed and factory packaged.

2.6 SILICONE SEALANTS

- A. Silicone, S, NS, 25, NT: Single-component, nonsag, plus 25 percent and minus 25 percent movement capability, nontraffic-use, neutral-curing silicone joint sealant, ASTM C920, Type S, Grade NS, Class 25, Use NT.
- B. Silicone, S, P, 25, T, NT: Single-component, pourable, plus 25 percent and minus 25 percent movement capability, traffic- and nontraffic-use, neutral-curing silicone joint sealant; ASTM C920, Type S, Grade P, Class 25, Uses T and NT. Grade P Pourable (self-leveling) formulation is for opening in floors and other horizontal surfaces that are not fire rated.
- C. Silicone Foam: Multicomponent, silicone-based liquid elastomers that, when mixed, expand and cure in place to produce a flexible, nonshrinking foam.

PART 3 - EXECUTION

3.1 SLEEVE INSTALLATION

- A. Install sleeves for piping passing through penetrations in floors, partitions, roofs, and walls.
- B. For sleeves that will have sleeve-seal system installed, select sleeves of size large enough to provide 1-inch annular clear space between piping and concrete slabs and walls.
1. Sleeves are not required for core-drilled holes.
- C. Install sleeves in concrete floors, concrete roof slabs, and concrete walls as new slabs and walls are constructed.
1. Permanent sleeves are not required for holes in slabs formed by molded-PE or -PP sleeves.
 2. Cut sleeves to length for mounting flush with both surfaces.
 - a. Exception: Extend sleeves installed in floors of mechanical equipment areas or other wet areas 2 inches above finished floor level.

3. Using grout or silicone sealant, seal the space outside of sleeves in slabs and walls without sleeve-seal system.
- D. Install sleeves for pipes passing through interior partitions.
1. Cut sleeves to length for mounting flush with both surfaces.
 2. Install sleeves that are large enough to provide 1/4-inch annular clear space between sleeve and pipe or pipe insulation.
 3. Seal annular space between sleeve and piping or piping insulation; use joint sealants appropriate for size, depth, and location of joint.
- E. Fire-Resistance-Rated Penetrations, Horizontal Assembly Penetrations, and Smoke Barrier Penetrations: Maintain indicated fire or smoke rating of walls, partitions, ceilings, and floors at pipe penetrations. Seal pipe penetrations with fire- and smoke-stop materials. Comply with requirements for firestopping and fill materials specified in Section 078413 "Penetration Firestopping."

3.2 STACK-SLEEVE-FITTING INSTALLATION

- A. Install stack-sleeve fittings in new slabs as slabs are constructed.
1. Install fittings that are large enough to provide 1/4-inch annular clear space between sleeve and pipe or pipe insulation.
 2. Secure flashing between clamping flanges for pipes penetrating floors with membrane waterproofing. Comply with requirements for flashing specified in Section 076200 "Sheet Metal Flashing and Trim."
 3. Install section of cast-iron soil pipe to extend sleeve to 2 inches above finished floor level.
 4. Extend cast-iron sleeve fittings below floor slab as required to secure clamping ring if ring is specified.
 5. Use silicone sealant to seal the space around outside of stack-sleeve fittings.
- B. Fire-Resistance-Rated Penetrations, Horizontal Assembly Penetrations, and Smoke Barrier Penetrations: Maintain indicated fire or smoke rating of floors at pipe penetrations. Seal pipe penetrations with fire- and smoke-stop materials. Comply with requirements for firestopping specified in Section 078413 "Penetration Firestopping."

3.3 SLEEVE-SEAL-SYSTEM INSTALLATION

- A. Install sleeve-seal systems in sleeves in exterior concrete walls and slabs-on-grade at service piping entries into building.
- B. Select type, size, and number of sealing elements required for piping material and size and for sleeve ID or hole size. Position piping in center of sleeve. Center piping in penetration, assemble sleeve-seal system components, and install in annular space between piping and sleeve. Tighten bolts against pressure plates that cause sealing elements to expand and make a watertight seal.

3.4 SLEEVE-SEAL-FITTING INSTALLATION

- A. Install sleeve-seal fittings in new walls and slabs as they are constructed.
- B. Assemble fitting components of length to be flush with both surfaces of concrete slabs and walls. Position waterstop flange to be centered in concrete slab or wall.
- C. Secure nailing flanges to concrete forms.
- D. Use grout or silicone sealant to seal the space around outside of sleeve-seal fittings.

3.5 FIELD QUALITY CONTROL

- A. Perform the following tests and inspections:
 - 1. Leak Test: After allowing for a full cure, test sleeves and sleeve seals for leaks. Repair leaks and retest until no leaks exist.
- B. Sleeves and sleeve seals will be considered defective if they do not pass tests and inspections.
- C. Prepare test and inspection reports.

3.6 SLEEVE AND SLEEVE-SEAL SCHEDULE

- A. Use sleeves and sleeve seals for the following piping-penetration applications:
 - 1. Exterior Concrete Walls above Grade:
 - a. Piping Smaller Than NPS 6: Cast-iron pipe sleeves.
 - b. Piping NPS 6 and Larger: Cast-iron pipe sleeves.
 - 2. Exterior Concrete Walls below Grade:
 - a. Piping Smaller Than NPS 6: Cast-iron pipe sleeves with sleeve-seal system.
 - 1) Select sleeve size to allow for 1-inch annular clear space between piping and sleeve for installing sleeve-seal system.
 - b. Piping NPS 6 and Larger: Cast-iron pipe sleeves with sleeve-seal system.
 - 1) Select sleeve size to allow for 1-inch annular clear space between piping and sleeve for installing sleeve-seal system.
 - 3. Concrete Slabs-on-Grade:
 - a. Piping Smaller Than NPS 6: Cast-iron pipe sleeves with sleeve-seal system.
 - 1) Select sleeve size to allow for 1-inch annular clear space between piping and sleeve for installing sleeve-seal system.
 - b. Piping NPS 6 and Larger: Cast-iron pipe sleeves with sleeve-seal system.
 - 1) Select sleeve size to allow for 1-inch annular clear space between piping and sleeve for installing sleeve-seal system.
 - 4. Concrete Slabs above Grade:
 - a. Piping Smaller Than NPS 6: Sleeve-seal fittings.
 - b. Piping NPS 6 and Larger: Steel pipe sleeves or Stack-sleeve fittings.
 - 5. Interior Partitions:
 - a. Piping Smaller Than NPS 6: Steel pipe sleeves.
 - b. Piping NPS 6 and Larger: Galvanized-steel sheet sleeves.

END OF SECTION

SECTION 22 05 18

ESCUTCHEONS FOR PLUMBING PIPING

PART 1 - GENERAL

1.1 RELATED DOCUMENTS

- A. Drawings and general provisions of the Contract, including General and Supplementary Conditions and Division 01 Specification Sections, apply to this Section.

1.2 SUMMARY

- A. Section Includes:
 - 1. Escutcheons.
 - 2. Floor plates.

1.3 DEFINITIONS

- A. Existing Piping to Remain: Existing piping that is not to be removed and that is not otherwise indicated to be removed and salvaged, or removed and reinstalled.

1.4 WORK INCLUDED

- A. Furnish all labor, materials, services, testing, transportation, and equipment necessary for the completion of all plumbing work as indicated on drawings and specified herein. Work materials and equipment not indicated or specified which is necessary for the complete and proper operation of the work of this Section in accordance with the true intent and meaning of the contract documents shall be provided and incorporated at no additional cost to the Owner.

1.5 QUALITY ASSURANCE

- A. Code Requirements: All work covered by this Section shall conform to the latest requirements of the following regulations:
 - 1. 2018 International Plumbing Code.
 - 2. Any other legally constituted body-having jurisdiction thereof.
- B. Nothing in the specifications or drawings shall be construed to permit deviation from the requirements of governing codes unless approval for said deviation has been obtained from the legally constituted authorities having jurisdiction and from the Owner's representative.

1.6 DRAWINGS

- A. Because of the small-scale drawings, it is not possible to indicate all offsets, fittings and accessories which may be required. The Contractor shall carefully investigate the conditions surrounding installation of his work, furnishing the necessary piping, fittings, valves, traps, and other devices which may be required to complete the installation.

- B. The general arrangement indicated on the drawings shall be followed as closely as possible. Coordinate with the Architectural, Structural, Mechanical and Electrical Drawings and the work of other trades prior to installation of piping fixtures and equipment to verify adequate space available for installation of the work shown. In the event a field condition arises which makes it impossible to install the work as indicated, submit, in writing, the proposed departures to the Architect for his approval. Only when Architect's approval is given, in writing, shall Contractor proceed with installation of the work.
- C. Special Note: Should the Contractor make changes in the installation differing from what is indicated on the contract drawings and not necessitated due to field conditions as indicated hereinabove, the Contractor shall be required to re-install the work to comply with what has been indicated on the contract drawings. Should it be impossible to re-install the work and the installation is in accordance with all governing authorities, the architect may permit the installation to remain. However, all costs incurred to revise the contract drawings by the engineer for resubmittal to the building department indicating the as-installed condition shall become the responsibility of the Contractor.
- D. In case of a difference in the specifications or between the specifications and the drawings, the Contractor shall figure the most expensive alternate and after award of contract, shall secure direction from the Architect.

1.7 PERMITS, INSPECTIONS AND LICENSES

- A. All permits, inspections and licenses required by the legally constituted authorities for installation of the work according to the plans and specifications shall be obtained and paid as a part of the work of this section.

1.8 PROTECTION

- A. All work, equipment and materials shall be protected at all times. Contractor shall make good all damage caused either directly or indirectly by his own workmen. Contractor shall also protect his own work from damage. He shall close all pipe openings with caps or plugs during installation. He shall protect all his equipment and materials against dirt, water, chemical and mechanical injury. Upon completion, all work shall be thoroughly cleaned and delivered in a new condition.
- B. Contractor shall be held responsible for all damage to equipment and materials until he has received written notice from the Architect or Engineer that his work has been accepted.

1.9 LOCATIONS

- A. The locations of apparatus, piping and equipment indicated on the drawings are approximate. Piping and equipment shall be installed in such a manner as to avoid all obstruction, preserve headroom, and keep openings and passages clear. The locations of and mounting heights of all fixtures shall be coordinated with the architectural plans and room elevations.
- B. Clearances and Openings: Contractor shall cooperate and coordinate his work with all other trades to avoid conflict and permit for a neat and orderly appearance of the entire installation. The Contractor shall, in advance of the work, furnish instructions to the General Contractor as to his requirements for equipment and material installation of any kind, whether or not specifically mentioned on drawings or in the specifications, and shall include recesses, chases in walls, and all required openings in the structure. Should furnishing this information be neglected, delayed or incorrect and additional cuttings are found to be required, the cost of the same shall be charged to this Contractor.
- C. Contractor shall verify and coordinate pipe routing with location of all electrical rooms, elevator equipment rooms, telecom/data rooms, and other rooms dedicated to the housing of switchgear, panels, or other electrical equipment. In no case shall piping be installed within or above the ceiling of such rooms.

1.10 ACTION SUBMITTALS

- A. Product Data: For each type of product.

1.11 SUBMITTAL DATA

A. Submittal Requirements:

1. Furnish, all at one time, prior to any installation, within the time noted below, one (1) digital (PDF) copy of valid submittal data on all fixtures, material, equipment, and devices. Each submitted item shall be indexed and referenced to these specifications (1 pdf submittal for each specification section) and to identification numbers on fixtures and equipment schedules.
2. Manufacturers' submittal literature and shop drawings are required on all items to ensure the latest and most complete manufacturer's data is available for review. Requirements of the submittals and Engineer's submittal notes are a part of the work of this Division except that Engineer's notes may not be used as a means of increasing the scope of work of this Division.
3. Submittals will be checked for general conformance with the design concept of the project, but the review does not guarantee quantities shown and does not supersede requirements of this Division to properly install work.
4. To be valid, all submittals must:
 - a. Be delivered to the Architect's office within thirty-five (35) days of award of the contract. Contractor shall make time allowance for Engineer's review, return of comments, if any, and resubmittal if required. Corrections or changes in submittals returned as inadequate or incomplete shall be accomplished within this time limit.
 - b. Clearly indicate and label as such any items proposed as substitution for that specified or shown on plans.
 - c. Include all pertinent construction, installation, performance, and technical data.
 - d. Have all product data sheets clearly labeled to indicate the individual items being submitted. In addition, all required options and accessories shall be clearly marked.
 - 1) Product data sheets corresponding to items indicated on plans shall be clearly labeled with the corresponding fixture or equipment tag number.
 - 2) Product data sheets corresponding to items indicated in specifications shall be clearly labeled with the specification section, page, and item numbers.
 - e. Include, for every item which differs in size, configuration, connections, service, accessibility or any other significant way, a drawing to the same (or larger) scale as to the pertinent portions of the contract drawings. In this drawing show a complete layout of the system except that which is identical to the contract drawings unless the unchanged portions must be shown to indicate such things as clearances. This drawing, together with the contract design drawings must show the complete system as revised to accommodate the proposed alternative.

B. Substitution Requirements:

1. Any items included in submittals and proposed by the Contractor as substitution for that specified or shown on plans shall be submitted within thirty-five (35) days of award of the contract. After such time, proposed substitutions shall not be accepted for review, and the Contractor shall submit all items as specified or shown on plans.
 - a. For each item proposed as substitution for that specified or shown on plans, copies of product data sheets for the specified item shall be placed side by side with product data sheets for the proposed substitution item within the submittal.
 - 1) In addition to the Submittal Requirements for labeling listed above, product data sheets for the specified item shall be clearly labeled "SPECIFIED ITEM, NOT SUBMITTED". Product data sheets for the corresponding proposed substitution item shall be clearly labeled "PROPOSED SUBSTITUTION".

- b. Provide calculations and other detailed data justifying how any items proposed as substitution were selected for proposal. Data must be complete enough to permit detailed comparison of every significant characteristic for which the specified item was analyzed during design.
2. It shall be the Contractor's responsibility to provide sufficient information to allow the Engineer to analyze any proposed alternate. If inadequate information is provided, the proposal will not be approved, and resubmittal will not be allowed.
 3. The Contractor shall provide or perform tests required by Engineer for purpose of judging acceptability of proposed substitutions.
 4. The Contractor assumes full responsibility that alternate items and procedures will meet the job requirements and is responsible for cost of redesign and of modifications to this and other parts of work caused by alternate items furnished under work in this Section. In view of these responsibilities, it is the purpose of these specifications to establish procedures to ensure that the Contractor has considered all the ramifications of proposed alternates before submitting them for review. Submittals which do not comply with the requirements of these specifications, or which indicate proposed alternates that were selected without proper regard to the requirements of the job will not be approved. No more than one proposed alternate will be considered for each item.
 5. Alternate items installed without Engineer's approval will be replaced with specified items at Contractor's expense.
 6. The Architect or his authorized representative shall be the sole judge as to the quality and suitability of proposed alternate equipment, fixtures, or materials. Decisions of the Architect or that of his representative shall be final and conclusive.

1.12 UNINSPECTED WORK

- A. The Contractor shall not allow or cause any of his work to be covered up or closed in until it has been inspected, tested, approved by all authorities have jurisdiction, and until Project Record drawings have been properly annotated.
- B. Should any of his work be covered up or closed in before such inspection, he shall, at his own expense, uncover the work to the satisfaction of the inspection party. All related repair work cost shall be borne by the Contractor.

1.13 RECORD DRAWINGS

- A. Contractor shall provide and keep up to date a complete "as-built" record set of blue-line prints which shall show every change from the original drawings and the exact "as-built" locations and sizes of the work provided under this Section of the specifications. This set shall include locations, dimensions, depth of buried piping, cleanouts, shut-off valves, sewer invert locations, plugged wyes, tees, etc. On completion of the work, the Contractor shall incorporate all as-built information on a set of reproducible tracings provided by the Architect and this set of reproducible tracings shall be delivered to the Architect.

1.14 GUARANTEES

- A. Contractor shall guarantee the entire plumbing and piping systems unconditionally for a period of one (1) year after final acceptance. If, during this period, any materials, equipment, or any part of the systems fail to function properly, the Contractor shall make good the defects promptly and without any expense to the Owner.
- B. Contractor shall be responsible for all damage to any part of the premises caused by leaks in pipelines or equipment furnished and installed under this Section for a period of one (1) year after date of acceptance of his work.
- C. All equipment and fixtures shall carry manufacturer's warranty against defective parts or poor workmanship for not less than one (1) year. See specific equipment specifications for extended warranty requirements.

PART 2 - PRODUCTS

2.1 ESCUTCHEONS

- A. One-Piece, Steel Type: With polished, chrome-plated finish and setscrew fastener.
- B. One-Piece, Stainless-Steel Type: With polished stainless-steel finish.
- C. One-Piece, Cast-Brass Type: With polished, chrome-plated finish and setscrew fastener.
- D. One-Piece, Deep-Pattern Type: Deep-drawn, box-shaped brass with polished, chrome-plated finish and spring-clip fasteners.
- E. One-Piece, Stamped-Steel Type: With polished, chrome-plated finish and spring-clip fasteners.
- F. Split-Plate, Stamped-Steel Type: With polished, chrome-plated finish; concealed hinge; and spring-clip fasteners.

2.2 FLOOR PLATES

- A. Split Floor Plates: Cast brass with concealed hinge.

PART 3 - EXECUTION

3.1 INSTALLATION

- A. Install escutcheons for piping penetrations of walls, ceilings, and finished floors.
- B. Install escutcheons with ID to closely fit around pipe, tube, and insulation of insulated piping and with OD that completely covers opening.
 - 1. Escutcheons for Piping:
 - a. Piping with Fitting or Sleeve Protruding from Wall: One-piece, deep pattern.
 - b. Chrome-Plated Piping: One-piece steel with polished, chrome-plated finish.
 - c. Insulated Piping: One-piece steel with polished, chrome-plated finish.
 - d. Insulated Piping: One-piece stainless steel with polished stainless-steel finish.
 - e. Insulated Piping: One-piece cast brass with polished, chrome-plated finish.
 - f. Insulated Piping: One-piece stamped steel with polished, chrome-plated finish.
 - g. Bare Piping at Wall and Floor Penetrations in Finished Spaces: One-piece steel with polished, chrome-plated finish.
 - h. Bare Piping at Wall and Floor Penetrations in Finished Spaces: One-piece stainless steel with polished stainless-steel finish.
 - i. Bare Piping at Wall and Floor Penetrations in Finished Spaces: One-piece cast brass with polished, chrome-plated finish.
 - j. Bare Piping at Wall and Floor Penetrations in Finished Spaces: One-piece stamped steel with polished, chrome-plated finish.
 - k. Bare Piping at Ceiling Penetrations in Finished Spaces: One-piece steel with polished, chrome-plated finish.
 - l. Bare Piping at Ceiling Penetrations in Finished Spaces: One-piece stainless steel with polished stainless-steel finish.
 - m. Bare Piping at Ceiling Penetrations in Finished Spaces: One-piece cast brass with polished, chrome-plated finish.
 - n. Bare Piping at Ceiling Penetrations in Finished Spaces: One-piece stamped steel with polished, chrome-plated finish.

- o. Bare Piping in Unfinished Service Spaces: One-piece steel with polished, chrome-plated finish.
 - p. Bare Piping in Unfinished Service Spaces: One-piece cast brass with polished, chrome-plated finish.
 - q. Bare Piping in Unfinished Service Spaces: One-piece stamped steel with polished, chrome-plated finish.
 - r. Bare Piping in Equipment Rooms: One-piece steel with polished, chrome-plated finish.
 - s. Bare Piping in Equipment Rooms: One-piece cast brass with polished, chrome-plated finish.
 - t. Bare Piping in Equipment Rooms: One-piece stamped steel with polished, chrome-plated finish.
2. Escutcheons for Existing Piping to Remain:
- a. Chrome-Plated Piping: Split-casting, stamped steel with concealed hinge with polished, chrome-plated finish.
 - b. Insulated Piping: Split-plate, stamped steel with concealed hinge with polished, chrome-plated finish
 - c. Bare Piping at Wall and Floor Penetrations in Finished Spaces: Split-plate, stamped steel with concealed hinge with polished, chrome-plated finish.
 - d. Bare Piping at Ceiling Penetrations in Finished Spaces: Split-plate, stamped steel with concealed hinge with polished, chrome-plated finish.
 - e. Bare Piping in Unfinished Service Spaces: Split-plate, stamped steel with concealed hinge with polished, chrome-plated finish.
 - f. Bare Piping in Equipment Rooms: Split-plate, stamped steel with concealed hinge with polished, chrome-plated finish.
- C. Install floor plates for piping penetrations of equipment-room floors.
- D. Install floor plates with ID to closely fit around pipe, tube, and insulation of piping and with OD that completely covers opening.
- 1. New Piping and Relocated Existing Piping: One-piece, floor plate.
 - 2. Existing Piping: Split floor plate.
- 3.2 FIELD QUALITY CONTROL
- A. Using new materials, replace broken and damaged escutcheons and floor plates.

END OF SECTION

SECTION 22 05 29

HANGERS AND SUPPORTS FOR PLUMBING PIPING AND EQUIPMENT

PART 1 - GENERAL

1.1 SUMMARY

A. Section Includes:

1. Metal pipe hangers and supports.
2. Trapeze pipe hangers.
3. Metal framing systems.
4. Thermal hanger-shield inserts.
5. Fastener systems.
6. Pipe stands.
7. Pipe-positioning systems.
8. **VoidForm System**
9. Equipment supports.

1.2 DEFINITIONS

- A. MSS: Manufacturers Standardization Society of The Valve and Fittings Industry Inc.

1.3 PERFORMANCE REQUIREMENTS

- A. Delegated Design: Design trapeze pipe hangers and equipment supports, including comprehensive engineering analysis by a qualified professional engineer, using performance requirements and design criteria indicated.
- B. Structural Performance: Hangers and supports for plumbing piping and equipment shall withstand the effects of gravity loads and stresses within limits and under conditions indicated according to ASCE/SEI 7.
- C. Design supports for multiple pipes, including pipe stands, capable of supporting combined weight of supported systems, system contents, and test water.
- D. Design equipment supports capable of supporting combined operating weight of supported equipment and connected systems and components.
- E. Design seismic-restraint hangers and supports for piping and equipment and obtain approval from authorities having jurisdiction.

1.4 WORK INCLUDED

- A. Furnish all labor, materials, services, testing, transportation, and equipment necessary for the completion of all plumbing work as indicated on drawings and specified herein. Work materials and equipment not indicated or specified which is necessary for the complete and proper operation of the work of this Section in accordance with the true intent and meaning of the contract documents shall be provided and incorporated at no additional cost to the Owner.

1.5 QUALITY ASSURANCE

- A. Code Requirements: All work covered by this Section shall conform to the latest requirements of the following regulations:
 - 1. 2018 International Plumbing Code
 - 2. Any other legally constituted body-having jurisdiction thereof.
- B. Nothing in the specifications or drawings shall be construed to permit deviation from the requirements of governing codes unless approval for said deviation has been obtained from the legally constituted authorities having jurisdiction and from the Owner's representative.
- C. Structural-Steel Welding Qualifications: Qualify procedures and personnel according to AWS D1.1/D1.1M.
- D. Pipe Welding Qualifications: Qualify procedures and operators according to 2021 ASME Boiler and Pressure Vessel Code, Section IX.

1.6 DRAWINGS

- A. Because of the small-scale drawings, it is not possible to indicate all offsets, fittings and accessories which may be required. The Contractor shall carefully investigate the conditions surrounding installation of his work, furnishing the necessary piping, fittings, valves, traps, and other devices which may be required to complete the installation.
- B. The general arrangement indicated on the drawings shall be followed as closely as possible. Coordinate with the Architectural, Structural, Mechanical and Electrical Drawings and the work of other trades prior to installation of piping fixtures and equipment to verify adequate space available for installation of the work shown. In the event a field condition arises which makes it impossible to install the work as indicated, submit, in writing, the proposed departures to the Architect for his approval. Only when Architect's approval is given, in writing, shall Contractor proceed with installation of the work.
- C. Special Note: Should the Contractor make changes in the installation differing from what is indicated on the contract drawings and not necessitated due to field conditions as indicated hereinabove, the Contractor shall be required to re-install the work to comply with what has been indicated on the contract drawings. Should it be impossible to re-install the work and the installation is in accordance with all governing authorities, the architect may permit the installation to remain. However, all costs incurred to revise the contract drawings by the engineer for resubmittal to the building department indicating the as-installed condition shall become the responsibility of the Contractor.
- D. In case of a difference in the specifications or between the specifications and the drawings, the Contractor shall figure the most expensive alternate and after award of contract, shall secure direction from the Architect.

1.7 PROTECTION

- A. All work, equipment and materials shall be protected at all times. Contractor shall make good all damage caused either directly or indirectly by his own workmen. Contractor shall also protect his own work from damage. He shall close all pipe openings with caps or plugs during installation. He shall protect all his equipment and materials against dirt, water, chemical and mechanical injury. Upon completion, all work shall be thoroughly cleaned and delivered in a new condition.
- B. Contractor shall be held responsible for all damage to equipment and materials until he has received written notice from the Architect or Engineer that his work has been accepted.

1.8 LOCATIONS

- A. The locations of apparatus, piping and equipment indicated on the drawings are approximate. Piping and equipment shall be installed in such a manner as to avoid all obstruction, preserve headroom, and keep openings and passages clear. The locations of and mounting heights of all fixtures shall be coordinated with the architectural plans and room elevations.
- B. Clearances and Openings: Contractor shall cooperate and coordinate his work with all other trades to avoid conflict and permit for a neat and orderly appearance of the entire installation. The Contractor shall, in advance of the work, furnish instructions to the General Contractor as to his requirements for equipment and material installation of any kind, whether or not specifically mentioned on drawings or in the specifications, and shall include recesses, chases in walls, and all required openings in the structure. Should furnishing this information be neglected, delayed or incorrect and additional cuttings are found to be required, the cost of the same shall be charged to this Contractor.
- C. Contractor shall verify and coordinate pipe routing with location of all electrical rooms, elevator equipment rooms, telecom/data rooms, and other rooms dedicated to the housing of switchgear, panels, or other electrical equipment. In no case shall piping be installed within or above the ceiling of such rooms.

1.9 ACTION SUBMITTALS

- A. Product Data: For each type of product.
- B. Shop Drawings: Show fabrication and installation details and include calculations for the following:
 - 1. Trapeze pipe hangers.
 - 2. Metal framing systems.
 - 3. Fiberglass strut systems.
 - 4. Pipe stands.
 - 5. Equipment supports.
- C. Delegated-Design Submittal: For trapeze hangers indicated to comply with performance requirements and design criteria, including analysis data signed and sealed by the qualified professional engineer responsible for their preparation.
 - 1. Detail fabrication and assembly of trapeze hangers.
 - 2. Include design calculations for designing trapeze hangers.

1.10 SUBMITTAL DATA

- A. Submittal Requirements:
 - 1. Furnish, all at one time, prior to any installation, within the time noted below, one (1) digital (PDF) copy of valid submittal data on all fixtures, material, equipment, and devices. Each submitted item shall be indexed and referenced to these specifications (1 pdf submittal for each specification section) and to identification numbers on fixtures and equipment schedules.
 - 2. Manufacturers' submittal literature and shop drawings are required on all items to ensure the latest and most complete manufacturer's data is available for review. Requirements of the submittals and Engineer's submittal notes are a part of the work of this Division except that Engineer's notes may not be used as a means of increasing the scope of work of this Division.
 - 3. Submittals will be checked for general conformance with the design concept of the project, but the review does not guarantee quantities shown and does not supersede requirements of this Division to properly install work.
 - 4. To be valid, all submittals must:

- a. Be delivered to the Architect's office within thirty-five (35) days of award of the contract. Contractor shall make time allowance for Engineer's review, return of comments, if any, and resubmittal if required. Corrections or changes in submittals returned as inadequate or incomplete shall be accomplished within this time limit.
- b. Clearly indicate and label as such any items proposed as substitution for that specified or shown on plans.
- c. Include all pertinent construction, installation, performance, and technical data.
- d. Have all product data sheets clearly labeled to indicate the individual items being submitted. In addition, all required options and accessories shall be clearly marked.
 - 1) Product data sheets corresponding to items indicated on plans shall be clearly labeled with the corresponding fixture or equipment tag number.
 - 2) Product data sheets corresponding to items indicated in specifications shall be clearly labeled with the specification section, page, and item numbers.
- e. Include, for every item which differs in size, configuration, connections, service, accessibility or any other significant way, a drawing to the same (or larger) scale as to the pertinent portions of the contract drawings. In this drawing show a complete layout of the system except that which is identical to the contract drawings unless the unchanged portions must be shown to indicate such things as clearances. This drawing, together with the contract design drawings must show the complete system as revised to accommodate the proposed alternative.

B. Substitution Requirements:

1. Any items included in submittals and proposed by the Contractor as substitution for that specified or shown on plans shall be submitted within thirty-five (35) days of award of the contract. After such time, proposed substitutions shall not be accepted for review, and the Contractor shall submit all items as specified or shown on plans.
 - a. For each item proposed as substitution for that specified or shown on plans, copies of product data sheets for the specified item shall be placed side by side with product data sheets for the proposed substitution item within the submittal.
 - 1) In addition to the Submittal Requirements for labeling listed above, product data sheets for the specified item shall be clearly labeled "SPECIFIED ITEM, NOT SUBMITTED". Product data sheets for the corresponding proposed substitution item shall be clearly labeled "PROPOSED SUBSTITUTION".
 - b. Provide calculations and other detailed data justifying how any items proposed as substitution were selected for proposal. Data must be complete enough to permit detailed comparison of every significant characteristic for which the specified item was analyzed during design.
2. It shall be the Contractor's responsibility to provide sufficient information to allow the Engineer to analyze any proposed alternate. If inadequate information is provided, the proposal will not be approved, and resubmittal will not be allowed.
3. The Contractor shall provide or perform tests required by Engineer for purpose of judging acceptability of proposed substitutions.
4. The Contractor assumes full responsibility that alternate items and procedures will meet the job requirements and is responsible for cost of redesign and of modifications to this and other parts of work caused by alternate items furnished under work in this Section. In view of these responsibilities, it is the purpose of these specifications to establish procedures to ensure that the Contractor has considered all the ramifications of proposed alternates before submitting them for review. Submittals which do not comply with the requirements of these specifications, or which indicate proposed alternates that were selected without proper regard to the requirements of the job will not be approved. No more than one proposed alternate will be considered for each item.

5. Alternate items installed without Engineer's approval will be replaced with specified items at Contractor's expense.
6. The Architect or his authorized representative shall be the sole judge as to the quality and suitability of proposed alternate equipment, fixtures, or materials. Decisions of the Architect or that of his representative shall be final and conclusive.

1.11 INFORMATIONAL SUBMITTALS

- A. Welding certificates.

1.12 UNINSPECTED WORK

- A. The Contractor shall not allow or cause any of his work to be covered up or closed in until it has been inspected, tested, approved by all authorities have jurisdiction, and until Project Record drawings have been properly annotated.
- B. Should any of his work be covered up or closed in before such inspection, he shall, at his own expense, uncover the work to the satisfaction of the inspection party. All related repair work cost shall be borne by the Contractor.

1.13 RECORD DRAWINGS

- A. Contractor shall provide and keep up to date a complete "as-built" record set of blueline prints which shall show every change from the original drawings and the exact "as-built" locations and sizes of the work provided under this Section of the specifications. This set shall include locations, dimensions, depth of buried piping, cleanouts, shut-off valves, sewer invert locations, plugged wyes, tees, etc. On completion of the work, the Contractor shall incorporate all as-built information on a set of reproducible tracings provided by the Architect and this set of reproducible tracings shall be delivered to the Architect.

1.14 GUARANTEES

- A. Contractor shall guarantee the entire plumbing and piping systems unconditionally for a period of one (1) year after final acceptance. If, during this period, any materials, equipment, or any part of the systems fail to function properly, the Contractor shall make good the defects promptly and without any expense to the Owner.
- B. Contractor shall be responsible for all damage to any part of the premises caused by leaks in pipelines or equipment furnished and installed under this Section for a period of one (1) year after date of acceptance of his work.
- C. All equipment and fixtures shall carry manufacturer's warranty against defective parts or poor workmanship for not less than one (1) year. See specific equipment specifications for extended warranty requirements.

PART 2 - PRODUCTS

2.1 PERFORMANCE REQUIREMENTS

- A. Delegated Design: Engage a qualified professional engineer, as defined in Section 014000 "Quality Requirements," to design trapeze pipe hangers and equipment supports.
- B. Structural Performance: Hangers and supports for plumbing piping and equipment shall withstand the effects of gravity loads and stresses within limits and under conditions indicated according to **ASCE/SEI 7**.
 - 1. Design supports for multiple pipes, including pipe stands, capable of supporting combined weight of supported systems, system contents, and test water.
 - 2. Design equipment supports capable of supporting combined operating weight of supported equipment and connected systems and components.
 - 3. Design seismic-restraint hangers and supports for piping and equipment and obtain approval from authorities having jurisdiction.

2.2 METAL PIPE HANGERS AND SUPPORTS

- A. Carbon-Steel Pipe Hangers and Supports:
 - 1. Description: MSS SP-58, Types 1 through 58, factory-fabricated components.
 - 2. Galvanized Metallic Coatings: Pregalvanized, hot-dip galvanized, or electro-galvanized.
 - 3. Nonmetallic Coatings: Plastic coated or epoxy powder coated.
 - 4. Padded Hangers: Hanger with fiberglass or other pipe insulation pad or cushion to support bearing surface of piping.
 - 5. Hanger Rods: Continuous-thread rod, nuts, and washer made of stainless steel.
- B. Stainless-Steel Pipe Hangers and Supports:
 - 1. Description: MSS SP-58, Types 1 through 58, factory-fabricated components.
 - 2. Padded Hangers: Hanger with fiberglass or other pipe insulation pad or cushion to support bearing surface of piping.
 - 3. Hanger Rods: Continuous-thread rod, nuts, and washer made of stainless steel.
- C. Copper Pipe and Tube Hangers:
 - 1. Description: MSS SP-58, Types 1 through 58, copper-coated-steel, factory-fabricated components.
 - 2. Hanger Rods: Continuous-thread rod, nuts, and washer made of copper-coated steel.

2.3 TRAPEZE PIPE HANGERS

- A. Description: MSS SP-58, Type 59, shop- or field-fabricated pipe-support assembly, made from structural-carbon-steel shapes, with MSS SP-58 carbon-steel hanger rods, nuts, saddles, and U-bolts.

2.4 THERMAL HANGER-SHIELD INSERTS

- A. Manufacturers: Subject to compliance with requirements, provide products by one of the following:
 - 1. ERICO International Corporation.
 - 2. PHS Industries, Inc.

3. Pipe Shields, Inc.; a subsidiary of Piping Technology & Products, Inc.
 4. Piping Technology & Products, Inc.
- B. Insulation-Insert Material for Cold Piping: ASTM C552, Type II cellular glass with 100-psig or ASTM C591, Type VI, Grade 1 polyisocyanurate with 125-psig minimum compressive strength and vapor barrier.
- C. Insulation-Insert Material for Hot Piping: ASTM C552, Type II cellular glass with 100-psig or ASTM C591, Type VI, Grade 1 polyisocyanurate with 125-psig minimum compressive strength.
- D. For Trapeze or Clamped Systems: Insert and shield shall cover entire circumference of pipe.
- E. For Clevis or Band Hangers: Insert and shield shall cover lower 180 degrees of pipe.
- F. Insert Length: Extend 2 inches beyond sheet metal shield for piping operating below ambient air temperature.

2.5 FASTENER SYSTEMS

- A. Powder-Actuated Fasteners: Threaded-steel stud, for use in hardened portland cement concrete, with pull-out, tension, and shear capacities appropriate for supported loads and building materials where used.
- B. Mechanical-Expansion Anchors: Insert-wedge-type anchors, for use in hardened portland cement concrete, with pull-out, tension, and shear capacities appropriate for supported loads and building materials where used.
1. Indoor Applications: Zinc-coated or stainless steel.
 2. Outdoor Applications: Stainless steel.

2.6 PIPE STANDS

- A. General Requirements for Pipe Stands: Shop- or field-fabricated assemblies made of manufactured corrosion-resistant components to support roof-mounted piping.
- B. Compact Pipe Stand:
1. Description: Single base unit with integral-rod roller, pipe clamps, or V-shaped cradle to support pipe, for roof installation without membrane penetration.
 2. Base: Single, vulcanized rubber, molded polypropylene, or polycarbonate.
 3. Hardware: Galvanized steel or polycarbonate.
 4. Accessories: Protection pads.
- C. Low-Profile, Single-Base, Single-Pipe Stand:
1. Description: Single base with vertical and horizontal members, and pipe support, for roof installation without membrane protection.
 2. Base: Single, vulcanized rubber, molded polypropylene, or polycarbonate.
 3. Vertical Members: Two galvanized-steel, continuous-thread, 1/2-inch rods.
 4. Horizontal Member: Adjustable horizontal, galvanized-steel pipe support channels.
 5. Pipe Supports: Clevis hanger.
 6. Hardware: Galvanized steel.
 7. Accessories: Protection pads.

8. Height: 12 inches above roof.

D. High-Profile, Single-Base, Single-Pipe Stand:

1. Description: Single base, vertical and horizontal members, and pipe support, for roof installation without membrane penetration.
2. Base: Single vulcanized rubber or molded polypropylene.
3. Vertical Members: Two galvanized-steel, continuous-thread, 1/2-inch rods.
4. Horizontal Member: One adjustable-height, galvanized-steel, pipe-support slotted channel or plate.
5. Pipe Supports: Clevis hanger.
6. Hardware: Galvanized steel.
7. Accessories: Protection pads, 1/2-inch, continuous-thread, galvanized-steel rod.
8. Height: 36 inches above roof.

E. High-Profile, Multiple-Pipe Stand:

1. Description: Assembly of bases, vertical and horizontal members, and pipe supports, for roof installation without membrane penetration.
2. Bases: Two or more; vulcanized rubber.
3. Vertical Members: Two or more, galvanized-steel channels.
4. Horizontal Members: One or more, adjustable-height, galvanized-steel pipe support.
5. Pipe Supports: Clevis hanger.
6. Hardware: Galvanized steel.
7. Accessories: Protection pads, 1/2-inch, continuous-thread rod.
8. Height: 36 inches above roof.

F. Curb-Mounted-Type Pipe Stands: Shop- or field-fabricated pipe supports made from structural-steel shapes, continuous-thread rods, and rollers, for mounting on permanent stationary roof curb.

2.7 PIPE-POSITIONING SYSTEMS

- A. Description: IAPMO PS 42 positioning system composed of metal brackets, clips, and straps for positioning piping in pipe spaces; for plumbing fixtures in commercial applications.

2.8 VOIDForm SYSTEM - Plumbing Pipe Support Below Structural Slabs on Grade

- A. Manufacturers: Subject to compliance with requirements, provide products by one of the following:

1. VoidForm-PlumbingVoid System

- B. Description: Comprised of corrosion-proof components made from materials that include fiber-reinforced polymer (FRP), polypropylene, and polyacetal plastics. The polypropylene material is produced as a fluted (i.e. channeled) plastic panel having supports perpendicular to the exterior faces that connect to create a rigid sheet. This sheet is used to fabricate the Side Panels, End Caps (i.e. bulkheads) and TopCaps™ that form the exterior shell, which is held in position with U-shaped Connectors and Crossbars. This assembly forms a rigid structure that resists lateral soil pressures. Additional Connector/Crossbar Assemblies, as well as the provided Washer Assemblies, are positioned on the top edge of the Side Panels and span between them. This provides a supporting structure by which the pipes can be temporarily suspended and adjusted to the proper slope. Two different configurations are available: one for trench depths up to 6' and another for trench depths ranging from 6' to 10'.

- C. After the Side Panels and End Caps have been joined together with the appropriate Connectors and Crossbars, the clevis hanger spacing is determined. An embed plate, strut channel, or other attachment device used with each clevis hanger assembly is positioned at the top of a vertical threaded rod and will become anchored into the concrete slab as it sets for permanent support. After the pipes are inspected (initially visible from above through the open top), the slit-scored TopCap™ is formed and
- held in place with Connectors and Crossbars to create an enclosing cover. Once the PlumbingVoid System is backfilled, the underlying, swelling soils can expand vertically through the open bottom and into the empty space that has been created. Side Panels in contact with the soil at the bottom can be safely forced upwards by vertical soil expansion; the system is designed to disengage from the supporting threaded rod at the Washer Assembly. The assembled PlumbingVoid® System effectively isolates the plumbing network from the damaging soil upheaval that causes broken, leaking pipes.
- D. All plumbing pipes shall be supported by an approved suspension system.
- E. System Structure:
1. Provides a dimensionally stable underground void space that is independent from the overhead structural slab. The subterranean system shall support the weight of suspended lateral pipes and typical backfill material throughout the construction process.
 2. The system shall be designed to temporarily position and suspend the lateral pipes at the specified height and slope until pipes are permanently anchored to the overhead structural slab by the securing hanger (clevis) system. The open, underground system will then remain independent from the securing hangers.
 3. The open space of the system beneath the structural slab is designed to receive the infill of vertical expansion from the underlying soils. If vertical pressure is applied to the edges of the system in contact with the soil, the uplifting soil pressure will apply exclusively to the system and not the pipes. Therefore, the system shall be designed to move separately and independently of the lateral pipes.
- F. System Components:
1. The system shall have waterproof components related to its intended performance.
 2. The system must maintain its structural integrity in all humid environments.
 3. The system must have industry-proven performance in inclement weather conditions.
 4. The system shall be able to perform when submerged in water.
 5. All system components, excluding clevises, threaded rods, and nuts, shall be furnished by the designed system manufacturer.
 6. It is recommended that all independent components not included in the designed system should comply with the project specifications in order to get the intended results of the designed system.
 7. Each vertical threaded rod must have a component secured toward the top end and be permanently affixed into the concrete slab in order to maintain the specified elevation.
 8. System shall be installed per the manufacturer's requirements and recommendations.
 9. Acceptable Products: Proven systems that comply with these requirements.

2.9 EQUIPMENT SUPPORTS

- A. Description: Welded, shop- or field-fabricated equipment support made from structural-carbon-steel shapes.

2.10 MATERIALS

- A. Aluminum: ASTM B221.
- B. Carbon Steel: ASTM A1011/A1011M.
- C. Structural Steel: ASTM A36/A36M carbon-steel plates, shapes, and bars; black and galvanized.
- D. Stainless Steel: ASTM A240/A240M.
- E. Grout: ASTM C1107/C1107M, factory-mixed and -packaged, dry, hydraulic-cement, nonshrink and nonmetallic grout; suitable for interior and exterior applications.
 - 1. Properties: Nonstaining, noncorrosive, and nongaseous.
 - 2. Design Mix: 5000-psi, 28-day compressive strength.

PART 3 - EXECUTION

3.1 APPLICATION

- A. Comply with requirements in Section 078413 "Penetration Firestopping" for firestopping materials and installation, for penetrations through fire-rated walls, ceilings, and assemblies.
- B. Strength of Support Assemblies: Where not indicated, select sizes of components, so strength will be adequate to carry present and future static loads within specified loading limits. Minimum static design load used for strength determination shall be weight of supported components plus 200 lb.

3.2 HANGER AND SUPPORT INSTALLATION

- A. Metal Pipe-Hanger Installation: Comply with MSS SP-58. Install hangers, supports, clamps, and attachments as required to properly support piping from building structure.
- B. Metal Trapeze Pipe-Hanger Installation: Comply with MSS SP-58. Arrange for grouping of parallel runs of horizontal piping, and support together on field-fabricated trapeze pipe hangers.
 - 1. Pipes of Various Sizes: Support together and space trapezes for smallest pipe size, or install intermediate supports for smaller-diameter pipes as specified for individual pipe hangers.
 - 2. Field fabricate from ASTM A36/A36M carbon-steel shapes selected for loads being supported. Weld steel according to AWS D1.1/D1.1M.
- C. Fiberglass Pipe-Hanger Installation: Comply with applicable portions of MSS SP-58. Install hangers and attachments as required to properly support piping from building structure.
- D. Metal Framing System Installation: Arrange for grouping of parallel runs of piping, and support together on field-assembled metal framing systems.

- E. Thermal Hanger-Shield Installation: Install in pipe hanger or shield for insulated piping.
- F. Fastener System Installation:
 - 1. Install powder-actuated fasteners for use in lightweight concrete or concrete slabs less than 4 inches thick in concrete, after concrete is placed and completely cured. Use operators that are licensed by powder-actuated tool manufacturer. Install fasteners according to powder-actuated tool manufacturer's operating manual.
 - 2. Install mechanical-expansion anchors in concrete, after concrete is placed and completely cured. Install fasteners according to manufacturer's written instructions.
- G. Pipe Stand Installation:
 - 1. Pipe Stand Types, except Curb-Mounted Type: Assemble components and mount on smooth roof surface. Do not penetrate roof membrane.
 - 2. Curb-Mounted-Type Pipe Stands: Assemble components or fabricate pipe stand and mount on permanent, stationary roof curb. See Section 077200 "Roof Accessories" for curbs.
- H. Pipe-Positioning-System Installation: Install support devices to make rigid supply and waste piping connections to each plumbing fixture.
- I. **Plumbing Void System Installation: For Plumbing Pipe Support Below Structural Slabs on Grade: Install support system including clevis hangers, panels, connector/crossbar assemblies, top cap assemblies, stiffening rods, complete with necessary attachments, corrosive proof threaded rod, nuts, washers and other accessories. Adhere to manufacturer recommendations for device and support spacing. Refer to Geotechnical Technical Report and Structural for required void space following the most stringent requirement. Provide suitability backfill materials. Refer to manufacturer instructions to protect installation during construction.**
- J. Install hangers and supports complete with necessary attachments, inserts, bolts, rods, nuts, washers, and other accessories.
- K. Equipment Support Installation: Fabricate from welded-structural-steel shapes.
- L. Install hangers and supports to allow controlled thermal and seismic movement of piping systems, to permit freedom of movement between pipe anchors, and to facilitate action of expansion joints, expansion loops, expansion bends, and similar units.
- M. Install lateral bracing with pipe hangers and supports to prevent swaying.
- N. Install building attachments within concrete slabs or attach to structural steel. Install additional attachments at concentrated loads, including valves, flanges, and strainers, NPS 2-1/2 and larger and at changes in direction of piping. Install concrete inserts before concrete is placed; fasten inserts to forms and install reinforcing bars through openings at top of inserts.
- O. Load Distribution: Install hangers and supports, so that piping live and dead loads and stresses from movement will not be transmitted to connected equipment.
- P. Pipe Slopes: Install hangers and supports to provide indicated pipe slopes and to not exceed maximum pipe deflections allowed by ASME B31.9 for building services piping.
- Q. Insulated Piping:
 - 1. Attach clamps and spacers to piping.
 - a. Piping Operating Above Ambient Air Temperature: Clamp may project through insulation.

- b. Piping Operating Below Ambient Air Temperature: Use thermal hanger-shield insert with clamp sized to match OD of insert.
 - c. Do not exceed pipe stress limits allowed by ASME B31.9 for building services piping.
 2. Install MSS SP-58, Type 39 protection saddles if insulation without vapor barrier is indicated. Fill interior voids with insulation that matches adjoining insulation.
 - a. Option: Thermal hanger-shield inserts may be used. Include steel weight-distribution plate for pipe NPS 4 and larger if pipe is installed on rollers.
 3. Install MSS SP-58, Type 40 protective shields on cold piping with vapor barrier. Shields shall span an arc of 180 degrees.
 - a. Option: Thermal hanger-shield inserts may be used. Include steel weight-distribution plate for pipe NPS 4 and larger if pipe is installed on rollers.
 4. Shield Dimensions for Pipe: Not less than the following:
 - a. NPS 1/4 to NPS 3-1/2: 12 inches long and 0.048 inch thick.
 - b. NPS 4: 12 inches long and 0.06 inch thick.
 - c. NPS 5 and NPS 6: 18 inches long and 0.06 inch thick.
 - d. NPS 8 to NPS 14: 24 inches long and 0.075 inch thick.
 - e. NPS 16 to NPS 24: 24 inches long and 0.105 inch thick.
 5. Pipes NPS 8 and Larger: Include wood or reinforced calcium-silicate-insulation inserts of length at least as long as protective shield.
 6. Thermal Hanger Shields: Install with insulation of same thickness as piping insulation.

3.3 EQUIPMENT SUPPORTS

- A. Fabricate structural-steel stands to suspend equipment from structure overhead or to support equipment above floor.
- B. Grouting: Place grout under supports for equipment and make bearing surface smooth.
- C. Provide lateral bracing, to prevent swaying, for equipment supports.

3.4 METAL FABRICATIONS

- A. Cut, drill, and fit miscellaneous metal fabrications for trapeze pipe hangers and equipment supports.
- B. Fit exposed connections together to form hairline joints. Field weld connections that cannot be shop welded because of shipping size limitations.
- C. Field Welding: Comply with AWS D1.1/D1.1M procedures for shielded, metal arc welding; appearance and quality of welds; and methods used in correcting welding work; and with the following:
 1. Use materials and methods that minimize distortion and develop strength and corrosion resistance of base metals.
 2. Obtain fusion without undercut or overlap.
 3. Remove welding flux immediately.
 4. Finish welds at exposed connections, so no roughness shows after finishing and so contours of welded surfaces match adjacent contours.

3.5 ADJUSTING

- A. Hanger Adjustments: Adjust hangers to distribute loads equally on attachments and to achieve indicated slope of pipe.
- B. Trim excess length of continuous-thread hanger and support rods to 1-1/2 inches.

3.6 PAINTING

- A. Touchup: Clean field welds and abraded, shop-painted areas. Paint exposed areas immediately after erecting hangers and supports. Use same materials as those used for shop painting. Comply with SSPC-PA 1 requirements for touching up field-painted surfaces.
 - 1. Apply paint by brush or spray to provide a minimum dry film thickness of 2.0 mils.
- B. Touchup: Cleaning and touchup painting of field welds, bolted connections, and abraded, shop-painted areas on miscellaneous metal are specified in Section 099113 "Exterior Painting," Section 099123 "Interior Painting" or Section 099600 "High-Performance Coatings."
- C. Galvanized Surfaces: Clean welds, bolted connections, and abraded areas, and apply galvanizing-repair paint to comply with ASTM A780/A780M.

3.7 HANGER AND SUPPORT SCHEDULE

- A. Specific hanger and support requirements are in Sections specifying piping systems and equipment.
- B. Comply with MSS SP-58 for pipe-hanger selections and applications that are not specified in piping system Sections.
- C. Use hangers and supports with galvanized metallic coatings for piping and equipment that will not have field-applied finishes.
- D. Use nonmetallic coatings on attachments for electrolytic protection where attachments are in direct contact with copper tubing.
- E. Use carbon-steel pipe hangers and supports, metal trapeze pipe hangers and metal framing systems and attachments for general service applications.
- F. Use stainless-steel pipe hangers and stainless-steel or corrosion-resistant attachments for hostile environment applications.
- G. Use copper-plated pipe hangers and copper attachments for copper piping and tubing.
- H. Use padded hangers for piping that is subject to scratching.
- I. Use thermal hanger-shield inserts for insulated piping and tubing.
- J. Horizontal-Piping Hangers and Supports: Unless otherwise indicated and except as specified in piping system Sections, install the following types:
 - 1. Adjustable, Steel Clevis Hangers (MSS Type 1): For suspension of noninsulated or insulated, stationary pipes NPS 1/2 to NPS 30.

2. Yoke-Type Pipe Clamps (MSS Type 2): For suspension of up to 1050 deg F pipes NPS 4 to NPS 24, requiring up to 4 inches of insulation.
 3. Carbon- or Alloy-Steel, Double-Bolt Pipe Clamps (MSS Type 3): For suspension of pipes NPS 3/4 to NPS 36, requiring clamp flexibility and up to 4 inches of insulation.
 4. Steel Pipe Clamps (MSS Type 4): For suspension of cold and hot pipes NPS 1/2 to NPS 24 if little or no insulation is required.
 5. Pipe Hangers (MSS Type 5): For suspension of pipes NPS 1/2 to NPS 4, to allow off-center closure for hanger installation before pipe erection.
 6. Adjustable, Swivel Split- or Solid-Ring Hangers (MSS Type 6): For suspension of noninsulated, stationary pipes NPS 3/4 to NPS 8.
 7. Adjustable, Steel Band Hangers (MSS Type 7): For suspension of noninsulated, stationary pipes NPS 1/2 to NPS 8.
 8. Adjustable, Swivel-Ring Band Hangers (MSS Type 10): For suspension of noninsulated, stationary pipes NPS 1/2 to NPS 8.
 9. Split Pipe Ring with or without Turnbuckle Hangers (MSS Type 11): For suspension of noninsulated, stationary pipes NPS 3/8 to NPS 8.
 10. Extension Hinged or Two-Bolt Split Pipe Clamps (MSS Type 12): For suspension of noninsulated, stationary pipes NPS 3/8 to NPS 3.
 11. U-Bolts (MSS Type 24): For support of heavy pipes NPS 1/2 to NPS 30.
 12. Clips (MSS Type 26): For support of insulated pipes not subject to expansion or contraction.
 13. Pipe Saddle Supports (MSS Type 36): For support of pipes NPS 4 to NPS 36, with steel-pipe base stanchion support and cast-iron floor flange or carbon-steel plate.
 14. Pipe Stanchion Saddles (MSS Type 37): For support of pipes NPS 4 to NPS 36, with steel-pipe base stanchion support and cast-iron floor flange or carbon-steel plate, and with U-bolt to retain pipe.
 15. Adjustable Pipe Saddle Supports (MSS Type 38): For stanchion-type support for pipes NPS 2-1/2 to NPS 36 if vertical adjustment is required, with steel-pipe base stanchion support and cast-iron floor flange.
 16. Single-Pipe Rolls (MSS Type 41): For suspension of pipes NPS 1 to NPS 30, from two rods if longitudinal movement caused by expansion and contraction occurs.
 17. Adjustable Roller Hangers (MSS Type 43): For suspension of pipes NPS 2-1/2 to NPS 24, from single rod if horizontal movement caused by expansion and contraction occurs.
 18. Complete Pipe Rolls (MSS Type 44): For support of pipes NPS 2 to NPS 42 if longitudinal movement caused by expansion and contraction occurs but vertical adjustment is unnecessary.
 19. Pipe Roll and Plate Units (MSS Type 45): For support of pipes NPS 2 to NPS 24 if small horizontal movement caused by expansion and contraction occurs and vertical adjustment is unnecessary.
 20. Adjustable Pipe Roll and Base Units (MSS Type 46): For support of pipes NPS 2 to NPS 30 if vertical and lateral adjustment during installation, in addition to expansion and contraction, is required.
- K. Vertical-Piping Clamps: Unless otherwise indicated and except as specified in piping system Sections, install the following types:
1. Extension Pipe or Riser Clamps (MSS Type 8): For support of pipe risers NPS 3/4 to NPS 24.
 2. Carbon- or Alloy-Steel Riser Clamps (MSS Type 42): For support of pipe risers NPS 3/4 to NPS 24 if longer ends are required for riser clamps.
- L. Hanger-Rod Attachments: Unless otherwise indicated and except as specified in piping system Sections, install the following types:
1. Steel Turnbuckles (MSS Type 13): For adjustment of up to 6 inches for heavy loads.
 2. Steel Clevises (MSS Type 14): For 120 to 450 deg F piping installations.
 3. Swivel Turnbuckles (MSS Type 15): For use with MSS Type 11 split pipe rings.
 4. Malleable-Iron Sockets (MSS Type 16): For attaching hanger rods to various types of building attachments.
 5. Steel Weldless Eye Nuts (MSS Type 17): For 120 to 450 deg F piping installations.

- M. Building Attachments: Unless otherwise indicated and except as specified in piping system Sections, install the following types:
1. Steel or Malleable-Concrete Inserts (MSS Type 18): For upper attachment to suspend pipe hangers from concrete ceiling.
 2. Top-Beam C-Clamps (MSS Type 19): For use under roof installations with bar-joint construction, to attach to top flange of structural shape.
 3. Side-Beam or Channel Clamps (MSS Type 20): For attaching to bottom flange of beams, channels, or angles.
 4. Center-Beam Clamps (MSS Type 21): For attaching to center of bottom flange of beams.
 5. Welded Beam Attachments (MSS Type 22): For attaching to bottom of beams if loads are considerable and rod sizes are large.
 6. C-Clamps (MSS Type 23): For structural shapes.
 7. Top-Beam Clamps (MSS Type 25): For top of beams if hanger rod is required tangent to flange edge.
 8. Side-Beam Clamps (MSS Type 27): For bottom of steel I-beams.
 9. Steel-Beam Clamps with Eye Nuts (MSS Type 28): For attaching to bottom of steel I-beams for heavy loads.
 10. Linked-Steel Clamps with Eye Nuts (MSS Type 29): For attaching to bottom of steel I-beams for heavy loads, with link extensions.
 11. Malleable-Beam Clamps with Extension Pieces (MSS Type 30): For attaching to structural steel.
 12. Welded-Steel Brackets: For support of pipes from below or for suspending from above by using clip and rod. Use one of the following for indicated loads:
 - a. Light (MSS Type 31): 750 lb.
 - b. Medium (MSS Type 32): 1500 lb.
 - c. Heavy (MSS Type 33): 3000 lb.
 13. Side-Beam Brackets (MSS Type 34): For sides of steel or wooden beams.
 14. Plate Lugs (MSS Type 57): For attaching to steel beams if flexibility at beam is required.
 15. Horizontal Travelers (MSS Type 58): For supporting piping systems subject to linear horizontal movement where headroom is limited.
- N. Saddles and Shields: Unless otherwise indicated and except as specified in piping system Sections, install the following types:
1. Steel-Pipe-Covering Protection Saddles (MSS Type 39): To fill interior voids with insulation that matches adjoining insulation.
 2. Protection Shields (MSS Type 40): Of length recommended in writing by manufacturer to prevent crushing insulation.
 3. Thermal Hanger-Shield Inserts: For supporting insulated pipe.
- O. Comply with MSS SP-58 for trapeze pipe-hanger selections and applications that are not specified in piping system Sections.
- P. Comply with MFMA-103 for metal framing system selections and applications that are not specified in piping system Sections.
- Q. Use powder-actuated fasteners or mechanical-expansion anchors instead of building attachments where required in concrete construction.
- R. Use pipe-positioning systems in pipe spaces behind plumbing fixtures to support supply and waste piping for plumbing fixtures.

END OF SECTION

SECTION 22 13 19

SANITARY WASTE PIPING SPECIALTIES

PART 1 - GENERAL

1.1 RELATED DOCUMENTS

- A. Drawings and general provisions of the Contract, including General and Supplementary Conditions and Division 01 Specification Sections, apply to this Section.

1.2 SUMMARY

- A. Section Includes:
 - 1. Floor drains.
 - 2. Floor sinks
 - 3. Trench drains.
 - 4. Cleanouts.
 - 5. Miscellaneous sanitary drainage piping specialties.

1.3 DEFINITIONS

- A. ABS: Acrylonitrile butadiene styrene.
- B. PVC: Polyvinyl chloride.
- C. FOG: Fats, oils, and greases.
- D. HDPE: High-density polyethylene plastic.

1.4 WORK INCLUDED

- A. Furnish all labor, materials, services, testing, transportation, and equipment necessary for the completion of all plumbing work as indicated on drawings and specified herein. Work materials and equipment not indicated or specified which is necessary for the complete and proper operation of the work of this Section in accordance with the true intent and meaning of the contract documents shall be provided and incorporated at no additional cost to the Owner.

1.5 QUALITY ASSURANCE

- A. Code Requirements: All work covered by this Section shall conform to the latest requirements of the following regulations:
 - 1. 2018 International Plumbing Code.
 - 2. Any other legally constituted body-having jurisdiction thereof.
- B. Nothing in the specifications or drawings shall be construed to permit deviation from the requirements of governing codes unless approval for said deviation has been obtained from the legally constituted authorities having jurisdiction and from the Owner's representative.

1.6 PERFORMANCE REQUIREMENTS

- A. Components and installation shall be capable of withstanding the following minimum working pressure unless otherwise indicated:
 - 1. Soil, Waste, and Vent Piping: 10-foot head of water.
- B. Seismic Performance: Soil, waste, and vent piping and support and installation shall withstand the effects of earthquake motions determined according to ASCE/SEI 7.

1.7 DRAWINGS

- A. Because of the small-scale drawings, it is not possible to indicate all offsets, fittings and accessories which may be required. The Contractor shall carefully investigate the conditions surrounding installation of his work, furnishing the necessary piping, fittings, valves, traps, and other devices which may be required to complete the installation.
- B. The general arrangement indicated on the drawings shall be followed as closely as possible. Coordinate with the Architectural, Structural, Mechanical and Electrical Drawings and the work of other trades prior to installation of piping fixtures and equipment to verify adequate space available for installation of the work shown. In the event a field condition arises which makes it impossible to install the work as indicated, submit, in writing, the proposed departures to the Architect for his approval. Only when Architect's approval is given, in writing, shall Contractor proceed with installation of the work.
- C. Special Note: Should the Contractor make changes in the installation differing from what is indicated on the contract drawings and not necessitated due to field conditions as indicated hereinabove, the Contractor shall be required to re-install the work to comply with what has been indicated on the contract drawings. Should it be impossible to re-install the work and the installation is in accordance with all governing authorities, the architect may permit the installation to remain. However, all costs incurred to revise the contract drawings by the engineer for resubmittal to the building department indicating the as-installed condition shall become the responsibility of the Contractor.
- D. In case of a difference in the specifications or between the specifications and the drawings, the Contractor shall figure the most expensive alternate and after award of contract, shall secure direction from the Architect.

1.8 PERMITS, INSPECTIONS AND LICENSES

- A. All permits, inspections and licenses required by the legally constituted authorities for installation of the work according to the plans and specifications shall be obtained and paid as a part of the work of this section.

1.9 PROTECTION

- A. All work, equipment and materials shall be protected at all times. Contractor shall make good all damage caused either directly or indirectly by his own workmen. Contractor shall also protect his own work from damage. He shall close all pipe openings with caps or plugs during installation. He shall protect all his equipment and materials against dirt, water, chemical and mechanical injury. Upon completion, all work shall be thoroughly cleaned and delivered in a new condition.
- B. Contractor shall be held responsible for all damage to equipment and materials until he has received written notice from the Architect or Engineer that his work has been accepted.

1.10 LOCATIONS

- A. The locations of apparatus, piping and equipment indicated on the drawings are approximate. Piping and equipment shall be installed in such a manner as to avoid all obstruction, preserve headroom, and keep openings and passages clear. The locations of and mounting heights of all fixtures shall be coordinated with the architectural plans and room elevations.
- B. Clearances and Openings: Contractor shall cooperate and coordinate his work with all other trades to avoid conflict and permit for a neat and orderly appearance of the entire installation. The Contractor shall, in advance of the work, furnish instructions to the General Contractor as to his requirements for equipment and material installation of any kind, whether or not specifically mentioned on drawings or in the specifications, and shall include recesses, chases in walls, and all required openings in the structure. Should furnishing this information be neglected, delayed or incorrect and additional cuttings are found to be required, the cost of the same shall be charged to this Contractor.
- C. Contractor shall verify and coordinate pipe routing with location of all electrical rooms, elevator equipment rooms, telecom/data rooms, and other rooms dedicated to the housing of switchgear, panels, or other electrical equipment. In no case shall piping be installed within or above the ceiling of such rooms.

1.11 ACTION SUBMITTALS

- A. Product Data: For each type of product.

1.12 SUBMITTAL DATA

- A. Submittal Requirements:
 - 1. Furnish, all at one time, prior to any installation, within the time noted below, one (1) digital (PDF) copy of valid submittal data on all fixtures, material, equipment, and devices. Each submitted item shall be indexed and referenced to these specifications (1 pdf submittal for each specification section) and to identification numbers on fixtures and equipment schedules.
 - 2. Manufacturers' submittal literature and shop drawings are required on all items to ensure the latest and most complete manufacturer's data is available for review. Requirements of the submittals and Engineer's submittal notes are a part of the work of this Division except that Engineer's notes may not be used as a means of increasing the scope of work of this Division.
 - 3. Submittals will be checked for general conformance with the design concept of the project, but the review does not guarantee quantities shown and does not supersede requirements of this Division to properly install work.
 - 4. To be valid, all submittals must:
 - a. Be delivered to the Architect's office within thirty-five (35) days of award of the contract. Contractor shall make time allowance for Engineer's review, return of comments, if any, and resubmittal if required. Corrections or changes in submittals returned as inadequate or incomplete shall be accomplished within this time limit.
 - b. Clearly indicate and label as such any items proposed as substitution for that specified or shown on plans.
 - c. Include all pertinent construction, installation, performance, and technical data.
 - d. Have all product data sheets clearly labeled to indicate the individual items being submitted. In addition, all required options and accessories shall be clearly marked.
 - 1) Product data sheets corresponding to items indicated on plans shall be clearly labeled with the corresponding fixture or equipment tag number.
 - 2) Product data sheets corresponding to items indicated in specifications shall be clearly labeled with the specification section, page, and item numbers.
 - e. Include, for every item which differs in size, configuration, connections, service, accessibility or any other significant way, a drawing to the same (or larger) scale as to the pertinent

portions of the contract drawings. In this drawing show a complete layout of the system except that which is identical to the contract drawings unless the unchanged portions must be shown to indicate such things as clearances. This drawing, together with the contract design drawings must show the complete system as revised to accommodate the proposed alternative.

B. Substitution Requirements:

1. Any items included in submittals and proposed by the Contractor as substitution for that specified or shown on plans shall be submitted within thirty-five (35) days of award of the contract. After such time, proposed substitutions shall not be accepted for review, and the Contractor shall submit all items as specified or shown on plans.
 - a. For each item proposed as substitution for that specified or shown on plans, copies of product data sheets for the specified item shall be placed side by side with product data sheets for the proposed substitution item within the submittal.
 - 1) In addition to the Submittal Requirements for labeling listed above, product data sheets for the specified item shall be clearly labeled "SPECIFIED ITEM, NOT SUBMITTED". Product data sheets for the corresponding proposed substitution item shall be clearly labeled "PROPOSED SUBSTITUTION".
 - b. Provide calculations and other detailed data justifying how any items proposed as substitution were selected for proposal. Data must be complete enough to permit detailed comparison of every significant characteristic for which the specified item was analyzed during design.
2. It shall be the Contractor's responsibility to provide sufficient information to allow the Engineer to analyze any proposed alternate. If inadequate information is provided, the proposal will not be approved, and resubmittal will not be allowed.
3. The Contractor shall provide or perform tests required by Engineer for purpose of judging acceptability of proposed substitutions.
4. The Contractor assumes full responsibility that alternate items and procedures will meet the job requirements and is responsible for cost of redesign and of modifications to this and other parts of work caused by alternate items furnished under work in this Section. In view of these responsibilities, it is the purpose of these specifications to establish procedures to ensure that the Contractor has considered all the ramifications of proposed alternates before submitting them for review. Submittals which do not comply with the requirements of these specifications, or which indicate proposed alternates that were selected without proper regard to the requirements of the job will not be approved. No more than one proposed alternate will be considered for each item.
5. Alternate items installed without Engineer's approval will be replaced with specified items at Contractor's expense.
6. The Architect or his authorized representative shall be the sole judge as to the quality and suitability of proposed alternate equipment, fixtures, or materials. Decisions of the Architect or that of his representative shall be final and conclusive.

1.13 CLOSEOUT SUBMITTALS

- A. Operation and Maintenance Data: For drainage piping specialties to include in emergency, operation, and maintenance manuals.

1.14 UNINSPECTED WORK

- A. The Contractor shall not allow or cause any of his work to be covered up or closed in until it has been inspected, tested, approved by all authorities have jurisdiction, and until Project Record drawings have been properly annotated.

- B. Should any of his work be covered up or closed in before such inspection, he shall, at his own expense, uncover the work to the satisfaction of the inspection party. All related repair work cost shall be borne by the Contractor.

1.15 RECORD DRAWINGS

- A. Contractor shall provide and keep up to date a complete "as-built" record set of blueline prints which shall show every change from the original drawings and the exact "as-built" locations and sizes of the work provided under this Section of the specifications. This set shall include locations, dimensions, depth of buried piping, cleanouts, shut-off valves, sewer invert locations, plugged wyes, tees, etc. On completion of the work, the Contractor shall incorporate all as-built information on a set of reproducible tracings provided by the Architect and this set of reproducible tracings shall be delivered to the Architect.

1.16 GUARANTEES

- A. Contractor shall guarantee the entire plumbing and piping systems unconditionally for a period of one (1) year after final acceptance. If, during this period, any materials, equipment, or any part of the systems fail to function properly, the Contractor shall make good the defects promptly and without any expense to the Owner.
- B. Contractor shall be responsible for all damage to any part of the premises caused by leaks in pipelines or equipment furnished and installed under this Section for a period of one (1) year after date of acceptance of his work.
- C. All equipment and fixtures shall carry manufacturer's warranty against defective parts or poor workmanship for not less than one (1) year. See specific equipment specifications for extended warranty requirements.

1.17 COORDINATION

- A. Coordinate size and location of concrete bases. Cast anchor-bolt inserts into bases. Concrete, reinforcement, and formwork requirements are specified in Section 033000 "Cast-in-Place Concrete."
- B. Coordinate size and location of roof penetrations.

1.18 MAINTENANCE MATERIAL SUBMITTALS

- A. Furnish extra materials described below that match products installed and that are packaged with protective covering for storage and identified with labels describing contents.

1.19 WARRANTY

- A. Listed manufacturers to provide labeling and warranty of their respective products.

PART 2 - PRODUCTS

2.1 ASSEMBLY DESCRIPTIONS

- A. Sanitary waste piping specialties shall bear label, stamp, or other markings of specified testing agency.
- B. Comply with NSF 14 for plastic sanitary waste piping specialty components.

2.2 FLOOR DRAINS

A. Cast-Iron Floor Drains:

1. Manufacturers: Subject to compliance with requirements, provide products by one of the following:
 - a. Zurn Industries, LLC; Plumbing Products Group.
 - b. Jay R. Smith Mfg. Co.
 - c. Watts; a division of Watts Water Technologies, Inc.
2. Standard: ASME A112.6.3.
3. Pattern: Floor drain.
4. Body Material: Gray iron.
5. Seepage Flange: Required.
6. Anchor Flange: Required.
7. Clamping Device: Required.
8. Outlet: Bottom.
9. Coating in first subparagraph below is usually used only on sanitary floor drains.
10. Coating on Interior and Exposed Exterior Surfaces: Acid-resistant enamel.
11. Sediment Bucket: Not required.
12. Top or Strainer Material: Nickel bronze.
13. Top of Body and Strainer Finish: Nickel bronze.
14. Top Shape: Round.

B. Stainless-Steel Floor Drains:

1. Manufacturers: Subject to compliance with requirements, provide products by the following:
 - a. Josam Company.
2. Standard: ASME A112.3.1.
3. Outlet: Bottom.
4. Top or Strainer Material: Stainless steel.
5. Top Shape: Round.
6. Trap-Primer Connection: Required.

2.3 FLOOR SINKS

A. Cast-Iron Floor Sinks:

1. Manufacturers: Subject to compliance with requirements, provide products by one of the following:
 - a. Zurn Industries, LLC; Plumbing Products Group.
 - b. Jay R. Smith Mfg. Co.
 - c. Watts; a division of Watts Water Technologies, Inc.
2. Standard: ASME A112.6.3.
3. Pattern: Floor Sink.
4. Body Material: Gray iron with enameled finish.
5. Seepage Flange: Required.
6. Anchor Flange: Required.
7. Clamping Device: Required.
8. Outlet: Bottom.
9. Coating on Interior and Exposed Exterior Surfaces: Acid-resistant enamel.
10. Sediment Bucket: Not required.
11. Top or Strainer Material: Nickel bronze.
12. Top of Body and Strainer Finish: Nickel bronze.
13. Top Shape: Square.

2.4 TRENCH DRAINS

A. Trench Drains:

1. Manufacturers: Subject to compliance with requirements, provide products by one of the following:
 - a. Zurn Industries, LLC; Plumbing Products Group.
 - b. Watts; a division of Watts Water Technologies, Inc.
2. Standard: ASME A112.6.3 for trench drains.
3. Material: Ductile or gray iron.
4. Flange: Anchor.
5. Clamping Device: Required.
6. Outlet: Bottom.
7. Grate Material: Ductile iron.
8. Grate Finish: Painted.
9. Top Loading Classification: Medium Duty.

2.5 CLEANOUTS

A. Cast-Iron Exposed Cleanouts:

1. Manufacturers: Subject to compliance with requirements, provide products by one of the following:
 - a. Zurn Industries, LLC; Plumbing Products Group.
 - b. Jay R. Smith Mfg. Co.
 - c. Watts; a division of Watts Water Technologies, Inc.
2. Size: Same as connected drainage piping.
3. Body Material: Hubless, cast-iron soil pipe test tee as required to match connected piping.
4. Closure: Countersunk, brass plug.
5. Closure Plug Size: Same as or not more than one size smaller than cleanout size.

B. Stainless Steel Exposed Cleanouts:

1. Manufacturers: Subject to compliance with requirements, provide products by one of the following:
 - a. Zurn Industries, LLC; Plumbing Products Group.
 - b. Jay R. Smith Mfg. Co.
 - c. Watts; a division of Watts Water Technologies, Inc.
2. Standard: ASME A112.3.1.
3. Size: Same as connected drainage piping.
4. Body Material: Stainless steel tee with side cleanout as required to match connected piping.
5. Closure: Stainless steel plug with seal.

C. Cast-Iron Exposed Floor Cleanouts:

1. Manufacturers: Subject to compliance with requirements, provide products by one of the following:
 - a. Zurn Industries, LLC; Plumbing Products Group.
 - b. Jay R. Smith Mfg. Co.
 - c. Watts; a division of Watts Water Technologies, Inc.
2. Standard: ASME A112.36.2M for threaded, adjustable housing cleanout.
3. Size: Same as connected branch.
4. Type: Threaded, adjustable housing.

5. Body or Ferrule: Cast iron.
6. Clamping Device: Required.
7. Outlet Connection: Threaded.
8. Closure: Brass plug with straight threads and gasket.
9. Adjustable Housing Material: Cast iron with threads.
10. Frame and Cover Material and Finish: Stainless steel.
11. Frame and Cover Shape: Round.
12. Top-Loading Classification: Heavy Duty.
13. Riser: ASTM A74, Service Class, cast-iron drainage pipe fitting and riser to cleanout.

D. Stainless Steel Exposed Floor Cleanouts:

1. Manufacturers: Subject to compliance with requirements, provide products by one of the following:
 - a. Zurn Industries, LLC; Plumbing Products Group.
 - b. Jay R. Smith Mfg. Co.
 - c. Watts; a division of Watts Water Technologies, Inc.
2. Standards: ASME A112.3.1NSF listed.
3. Size: Same as connected branch.
4. Housing: Type 316 stainless steel.
5. Closure: Stainless steel with seal.
6. Riser: ASTM A74, Service Class, cast-iron drainage pipe fitting and riser to cleanout.
7. Body or Ferrule: Stainless steel.
8. Clamping Device: Required.
9. Outlet Connection: Threaded.
10. Adjustable Housing Material: Cast iron with threads.
11. Frame and Cover Material and Finish: Stainless steel.
12. Frame and Cover Shape: Round.
13. Top-Loading Classification: Heavy Duty.

E. Cast-Iron Wall Cleanouts:

1. Manufacturers: Subject to compliance with requirements, provide products by one of the following:
 - a. Zurn Industries, LLC; Plumbing Products Group.
 - b. Jay R. Smith Mfg. Co.
 - c. Watts; a division of Watts Water Technologies, Inc.
2. Standard: ASME A112.36.2M. Include wall access.
3. Size: Same as connected drainage piping.
4. Body: Hubless, cast-iron soil pipe test tee as required to match connected piping.
5. Closure Plug:
 - a. Brass.
 - b. Countersunk head.
 - c. Drilled and threaded for cover attachment screw.
 - d. Size: Same as or not more than one size smaller than cleanout size.
6. Wall Access, Cover Plate: Round, flat, chrome-plated brass, or stainless-steel cover plate with screw.
7. Wall Access, Frame and Cover: Round, stainless steel.

2.6 MISCELLANEOUS SANITARY DRAINAGE PIPING SPECIALTIES

A. Open Drains:

1. Description: Shop or field fabricate from ASTM A74, Service Class, hubless, cast-iron soil-pipe fittings. Include P-trap, hubless riser section; and where required, increaser fitting joined with ASTM C564 rubber gaskets.
2. Size: Same as connected waste piping with increaser fitting of size indicated.

B. Air-Gap Fittings:

1. Standard: ASME A112.1.2, for fitting designed to ensure fixed, positive air gap between installed inlet and outlet piping.
2. Body: Bronze or cast iron.
3. Inlet: Opening in top of body.
4. Outlet: Larger than inlet.
5. Size: Same as connected waste piping and with inlet large enough for associated indirect waste piping.

C. Sleeve Flashing Device:

1. Description: Manufactured, cast-iron fitting, with clamping device that forms sleeve for pipe floor penetrations of floor membrane. Include galvanized-steel pipe extension in top of fitting that will extend 2 inches above finished floor and galvanized-steel pipe extension in bottom of fitting that will extend through floor slab.
2. Size: As required for close fit to riser or stack piping.

D. Vent Caps:

1. Description: Cast-iron body with threaded or hub inlet and vandal-proof design. Include vented hood and setscrews to secure to vent pipe.
2. Size: Same as connected stack vent or vent stack.
3. inside of flashing collar extension, with counterflashing.

E. Expansion Joints:

1. Standard: ASME A112.6.4.
2. Body: Cast iron with bronze sleeve, packing, and gland.
3. End Connections: Matching connected piping.
4. Size: Same as connected soil, waste, or vent piping.

PART 3 - EXECUTION

3.1 INSTALLATION

- A. Install cleanouts in aboveground piping and building drain piping according to the following, unless otherwise indicated:
 1. Size same as drainage piping up to NPS 4. Use NPS 4 for larger drainage piping unless larger cleanout is indicated.
 2. Locate at each change in direction of piping greater than 45 degrees.
 3. Locate at minimum intervals of 50 feet for piping NPS 4 and smaller and 100 feet for larger piping.
 4. Locate at base of each vertical soil and waste stack.
- B. For floor cleanouts for piping below floors, install cleanout deck plates with top flush with finished floor.
- C. For cleanouts located in concealed piping, install cleanout wall access covers, of types indicated, with frame and cover flush with finished wall.
- D. Assemble open drain fittings and install with top of hub 2 inches above floor.

- E. Install deep-seal traps on floor drains and other waste outlets, if indicated.
- F. Install floor-drain, trap-seal primer fittings on inlet to floor drains that require trap-seal primer connection.
 - 1. Exception: Fitting may be omitted if trap has trap-seal primer connection.
 - 2. Size: Same as floor drain inlet.
- G. Install air-gap fittings on draining-type backflow preventers and on indirect-waste piping discharge into sanitary drainage system.
- H. Install sleeve and sleeve seals with each riser and stack passing through floors with waterproof membrane.
- I. Install vent caps on each vent pipe passing through roof.
- J. Install expansion joints on vertical stacks and conductors. Position expansion joints for easy access and maintenance.
- K. Install wood-blocking reinforcement for wall-mounting-type specialties.
- L. Install traps on plumbing specialty drain outlets. Omit traps on indirect wastes unless trap is indicated.

3.2 PIPING CONNECTIONS

- A. Comply with requirements in Section 221316 "Sanitary Waste and Vent Piping" for piping installation requirements. Drawings indicate general arrangement of piping, fittings, and specialties.
- B. Install piping adjacent to equipment, to allow service and maintenance.

3.3 LABELING AND IDENTIFYING


- A. Distinguish among multiple units, inform operator of operational requirements, indicate safety and emergency precautions, and warn of hazards and improper operations, in addition to identifying unit.
 - 1. Nameplates and signs are specified in Section 220553 "Identification for Plumbing Piping and Equipment."

3.4 PROTECTION

- A. Protect drains during remainder of construction period to avoid clogging with dirt or debris and to prevent damage from traffic or construction work.
- B. Place plugs in ends of uncompleted piping at end of each day or when work stops.

END OF SECTION

| OCCUPANT LOAD TABLE - LEVEL 01 | | | | | |
|---|---|---------|-----------|-----|---------------|
| NAME | FUNCTION OF SPACE | AREA | GROSS/NET | OLF | OCCUPANT LOAD |
| ACCESSORY STORAGE, MECH EQUIP ROOMS | ACCESSORY STORAGE, MECH EQUIP ROOMS | 37 SF | GROSS | 300 | 1 |
| BUDG MANT / FIRE PANEL / PHONE | ACCESSORY STORAGE, MECH EQUIP ROOMS | 88 SF | GROSS | 300 | 1 |
| STORAGE | ACCESSORY STORAGE, MECH EQUIP ROOMS | 121 SF | GROSS | 300 | 1 |
| ACCESSORY STORAGE, MECH EQUIP ROOMS | ACCESSORY STORAGE, MECH EQUIP ROOMS | 131 SF | GROSS | 300 | 1 |
| IDF | ACCESSORY STORAGE, MECH EQUIP ROOMS | 149 SF | GROSS | 300 | 1 |
| ELECTRICAL ROOM | ACCESSORY STORAGE, MECH EQUIP ROOMS | 215 SF | GROSS | 300 | 1 |
| S & L STORAGE | ACCESSORY STORAGE, MECH EQUIP ROOMS | 374 SF | GROSS | 300 | 2 |
| PERCUSSION CAGE | ACCESSORY STORAGE, MECH EQUIP ROOMS | 470 SF | GROSS | 300 | 2 |
| FOH STORAGE | ACCESSORY STORAGE, MECH EQUIP ROOMS | 714 SF | GROSS | 300 | 3 |
| STAGE SUPPORT | ACCESSORY STORAGE, MECH EQUIP ROOMS | 2108 SF | GROSS | 300 | 8 |
| ASSEMBLY W/O FIXED SEATS (CONCENTRATED) | | | | | |
| LOBBY | ASSEMBLY W/O FIXED SEATS (CONCENTRATED) | 2816 SF | NET | 7 | 10 |
| BUSINESS AREAS | BUSINESS AREAS | | | | |
| PRACTICE ROOMS | BUSINESS AREAS | 105 SF | GROSS | 150 | 1 |
| BUSINESS AREAS | BUSINESS AREAS | 113 SF | GROSS | 150 | 1 |
| BUSINESS AREAS | BUSINESS AREAS | 130 SF | GROSS | 150 | 1 |
| PRACTICE ROOMS | BUSINESS AREAS | 161 SF | GROSS | 150 | 2 |
| BUSINESS AREAS | BUSINESS AREAS | 296 SF | GROSS | 150 | 2 |
| BUSINESS AREAS | BUSINESS AREAS | 337 SF | GROSS | 150 | 3 |
| BUSINESS AREAS | BUSINESS AREAS | 356 SF | GROSS | 150 | 3 |
| BUSINESS AREAS | BUSINESS AREAS | 453 SF | GROSS | 150 | 4 |
| EDUCATIONAL CLASSROOMS | EDUCATIONAL CLASSROOMS | | | | |
| EDUCATIONAL CLASSROOMS | EDUCATIONAL CLASSROOMS | 1667 SF | NET | 20 | 84 |
| BAND ROOM | EDUCATIONAL CLASSROOMS | 3958 SF | NET | 20 | 198 |
| EDUCATIONAL CLASSROOMS - SHOPS/VOCATIONAL | | | | | |
| MAKEUP | EDUCATIONAL CLASSROOMS - SHOPS/VOCATIONAL | 218 SF | NET | 50 | 5 |
| LOADING DOCK | EDUCATIONAL CLASSROOMS - SHOPS/VOCATIONAL | 380 SF | NET | 50 | 8 |
| WORKSHOP | EDUCATIONAL CLASSROOMS - SHOPS/VOCATIONAL | 786 SF | NET | 50 | 16 |
| LOCKER ROOMS | LOCKER ROOMS | | | | |
| DRESSING ROOMS | LOCKER ROOMS | 628 SF | GROSS | 50 | 13 |
| STAGE AND PLATFORMS | STAGE AND PLATFORMS | 3428 SF | NET | 15 | 229 |
| Grand total | | | | | 591 |

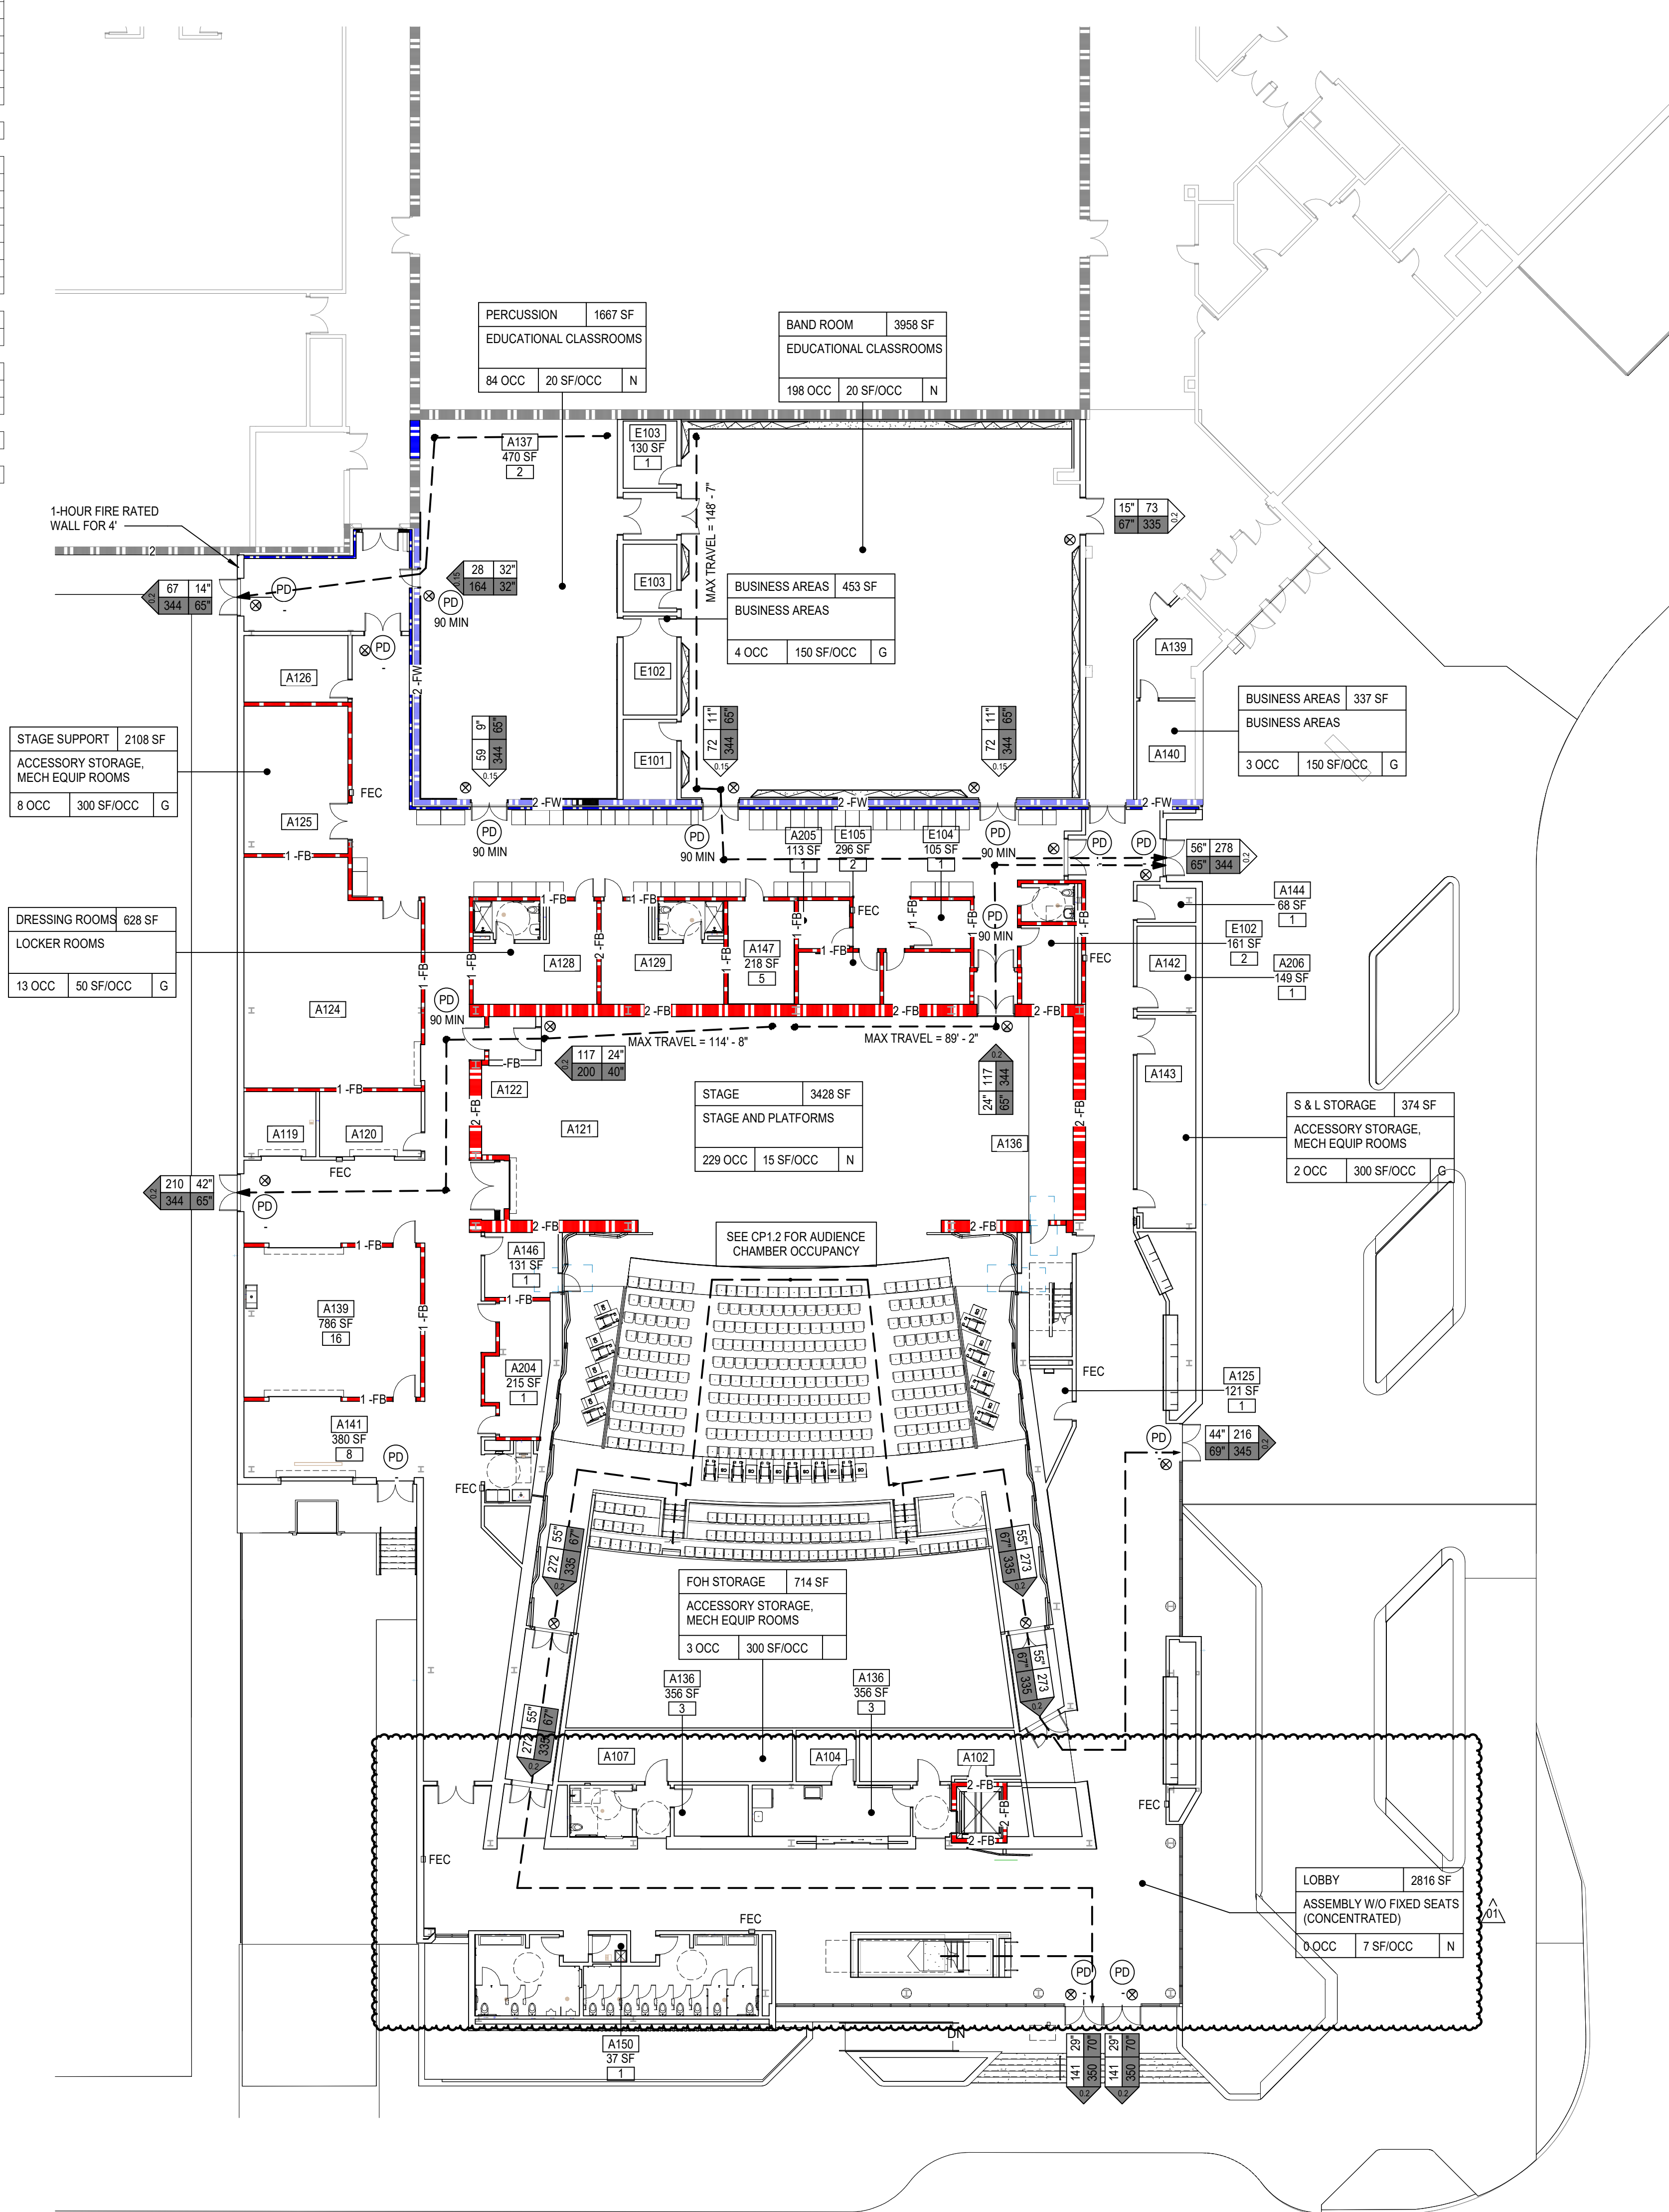

LEGEND - CODE FLOOR PLANS

Area name XXXX SF OCCUPANT LOAD TAG (GROSS)
Space Function XXXX OCC XXX SF/OCC G - SEE PATTERN FOR APPLIED LOAD FACTOR

ROOM NUMBER XXXX SF XXXX OCC OCCUPANT LOAD TAG (NET)
AREA (SF) - THIS LOAD DOES NOT EXTEND BEYOND THIS SPACE
OCCUPANT LOAD - SEE PATTERN FOR APPLIED LOAD FACTOR

EXIT TAG
- CUMULATIVE OCCUPANT LOAD
- EGRESS CAPACITY

REQUIRED OCCUPANT LOAD
REQUIRED WIDTH FOR OCCUPANT LOAD (INCHES)

CAPACITY OF EGRESS COMPONENT (WIDTH IN INCHES)
CAPACITY OF EGRESS COMPONENT (OCCUPANTS)

LOAD FACTOR (INCHES/OCCUPANT)
- WHEN CAPACITY FACTOR TRIANGLE IS FILLED - THIS IS TOTAL OCCUPANT LOAD AT THIS EXIT FROM THIS STORY

DOOR TAG
- PANIC DEVICE
- DOOR FIRE RATING

EXIT SIGN

MAX TRAVEL = Length EXIT ACCESS TRAVEL DISTANCE
MAX CP = Length COMMON PATH OF EGRESS TRAVEL DISTANCE
MAX DIAG DIM = X'-X" MAX OVERALL DIAGONAL DIM OF AREA SERVED
MIN SEPARATION DISTANCE = X'-X" MIN EXIT SEPARATION

SEPARATION LEGEND

HOURLY RATING

| | |
|----|-------------------|
| 0 | = 0 HOUR |
| 5 | = 1/2 HOUR |
| 1 | = 1 HOUR |
| 2 | = 2 HOUR |
| 3 | = 3 HOUR |
| 4 | = 4 HOUR |
| SP | = SMOKE PARTITION |


FIRE AND SMOKE SEPARATION TYPES

- C = CORRIDOR (CYAN)
- EW = EXTERIOR WALL (PURPLE)
- FW = FIRE WALL (BLUE)
- FB = FIRE BARRIER (RED)
- FP = FIRE PARTITION (MAGENTA)
- SP = SMOKE PARTITION (GREEN)
- SB = SMOKE BARRIER (GREEN)
- VS = VERTICAL SHAFT (ORANGE)
- VX = VERTICAL EXIT ENCLOSURE (ORANGE)
- XP = EXIT PASSAGEWAY (YELLOW)

OCCUPANT LOAD FACTOR PATTERNS

| | |
|-----------|--------------|
| [Pattern] | 7 NET SF |
| [Pattern] | 15 NET SF |
| [Pattern] | 20 NET SF |
| [Pattern] | 50 NET SF |
| [Pattern] | 50 GROSS SF |
| [Pattern] | 150 GROSS SF |
| [Pattern] | 300 GROSS SF |

LEVEL 01 - CODE PLAN
SCALE: 1/16" = 1'-0"

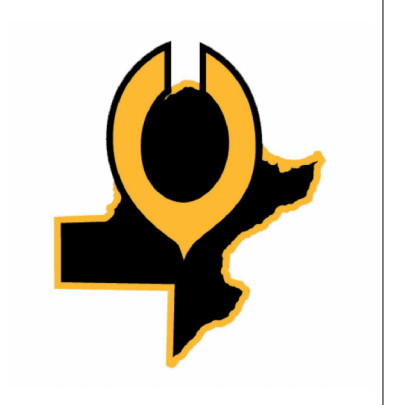

CRANDALL ISD HIGH SCHOOL
PAC ADDITION
13385 Fm 3039, Crandall, TX 75114

ISSUE FOR BID AND PERMIT
2024.07.25
REVISIONS
01 08/19/24 ADDENDUM 01

39-23712-00
LEVEL 01 - CODE PLAN

CP1.1

Autodesk Docs://99-23712-00 Crandall ISD - PAC/39-23712-00 Crandall ISD_AR_2024.rvt
8/19/2024 7:51:01 PM

CONSTRUCTION/RENOVATION PLANS FOR

CRANDALL ISD HIGH SCHOOL PAC ADDITION

SITE DEVELOPMENT CITY OF CRANDALL KAUFMAN COUNTY, TEXAS


OWNER/APPLICANT:
CRANDALL I.S.D.
400 W LEWIS ST
CRANDALL, TEXAS 75114
PHONE: 972.427.6000
CONTACT: MS. CHRISTY STARRETT

ARCHITECT:
DLR ARCHITECTS
2500 PACIFIC AVE., SUITE 1600
DALLAS, TX 75236
214.747.2511
CONTACT: CHARLES BRANDT

ENGINEER:
TEAGUE NALL & PERKINS, INC.
825 WATTERS CREEK BLVD., STE. M300
ALLEN, TEXAS 75013
214.396.9564
CONTACT: JOEL RICHEY, P.E.

SURVEYOR:
TEAGUE NALL & PERKINS, INC.
825 WATTERS CREEK BLVD., STE. M300
ALLEN, TEXAS 75013
214.461.9918
CONTACT: BRIAN J. MADDOX II, R.P.L.S.

LANDSCAPE ARCHITECT:
TEAGUE NALL & PERKINS, INC.
5237 N RIVERSIDE, SUITE 100
FORT WORTH, TEXAS 76137
817.336.5773
CONTACT: WILLIAM H. SMITH, R.L.A.

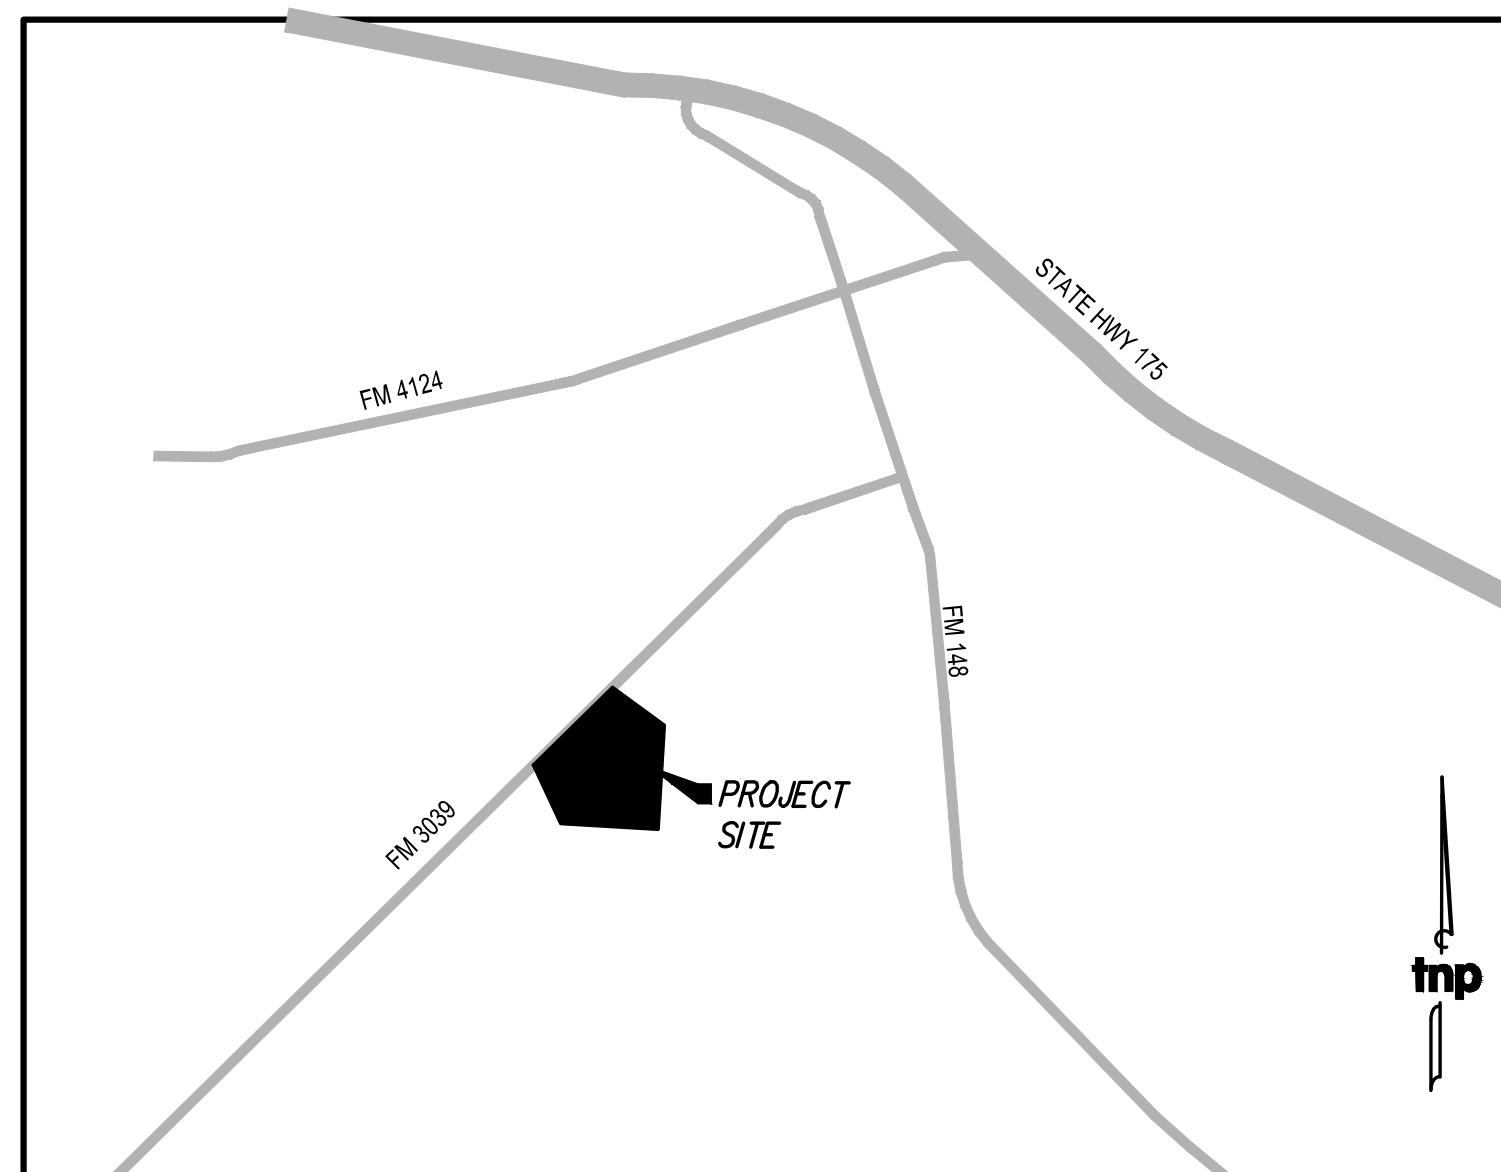

LOCATION MAP
NTS

| Sheet List Table | |
|------------------|---------------------------------|
| SHEET NUMBER | SHEET TITLE |
| C1.00 | COVER SHEET |
| C1.01 | EXISTING TOPOGRAPHIC PLAN |
| C1.02 | DEMOLITION PLAN |
| C1.03 | SITE PLAN |
| C1.04 | DIMENSION CONTROL PLAN |
| C1.05 | DIMENSION CONTROL PLAN INSET |
| C1.06 | GRADING PLAN |
| C1.07 | GRADING PLAN LOADING DOCK INSET |
| C1.08 | STORM DRAIN PLAN |
| C1.09 | STORM DRAIN PROFILES |
| C1.10 | SANITARY SEWER & WATER PLAN |
| C1.11 | PAVING PLAN |
| C1.12 | EROSION CONTROL PLAN |
| C1.13 | EROSION CONTROL DETAILS |
| C1.14 | SITE DETAILS |
| C1.15 | PAVING DETAILS |
| C1.16 | STORM DRAIN DETAILS |
| C1.17 | SANITARY SEWER DETAILS |
| C1.18 | WATER DETAILS |
| L1.01 | LANDSCAPE PLAN |
| L1.02 | LANDSCAPE NOTES |
| L1.03 | LANDSCAPE DETAILS (1 of 2) |
| L1.04 | LANDSCAPE DETAILS (2 of 2) |
| IR1.01 | IRRIGATION PLAN |
| IR1.02 | TREE IRRIGATION PLAN |
| IR1.03 | IRRIGATION SCHEDULE & NOTES |
| IR1.04 | IRRIGATION DETAILS |



AUGUST 2024




teague nall and perkins, inc
825 Watters Creek Blvd., Suite M300
Allen, Texas 75013
214.461.9867 ph 214.461.9864 fx
www.tnpinc.com
TBPELS: ENGR F-230; SURV 10011600, 10011601, 10194381
GBPE: PEF007431; TBAE: BR 2673

| no. | revision | by | date |
|-----|-------------|----|----------|
| 1 | ADDENDUM 01 | | 08/19/24 |
| | | | |
| | | | |

tnp Project DLR23073

CITY OF CRANDALL, TX

CRANDALL ISD - HIGH SCHOOL - PAC ADDITION

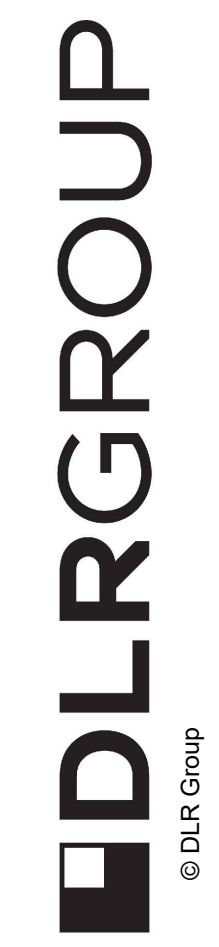

tnp
teague nall & perkins
825 Watters Creek Blvd.,
Suite M300
Allen, Texas 75013
214.461.9867 ph
214.461.9864 fx
TBPELS: ENGR F-230;
SURV 10011600,
10011601,
10194381
GBPE: PEF007431;
TBAE: BR 2673
www.tnpinc.com




CRANDALL ISD HIGH SCHOOL
PAC ADDITION

COVER SHEET
138452-Fm 3038, Crandall, TX 75114

100% CD
2024.07.25
REVISIONS
ADDENDUM 01 08/19/2024

COVER SHEET

C1.00

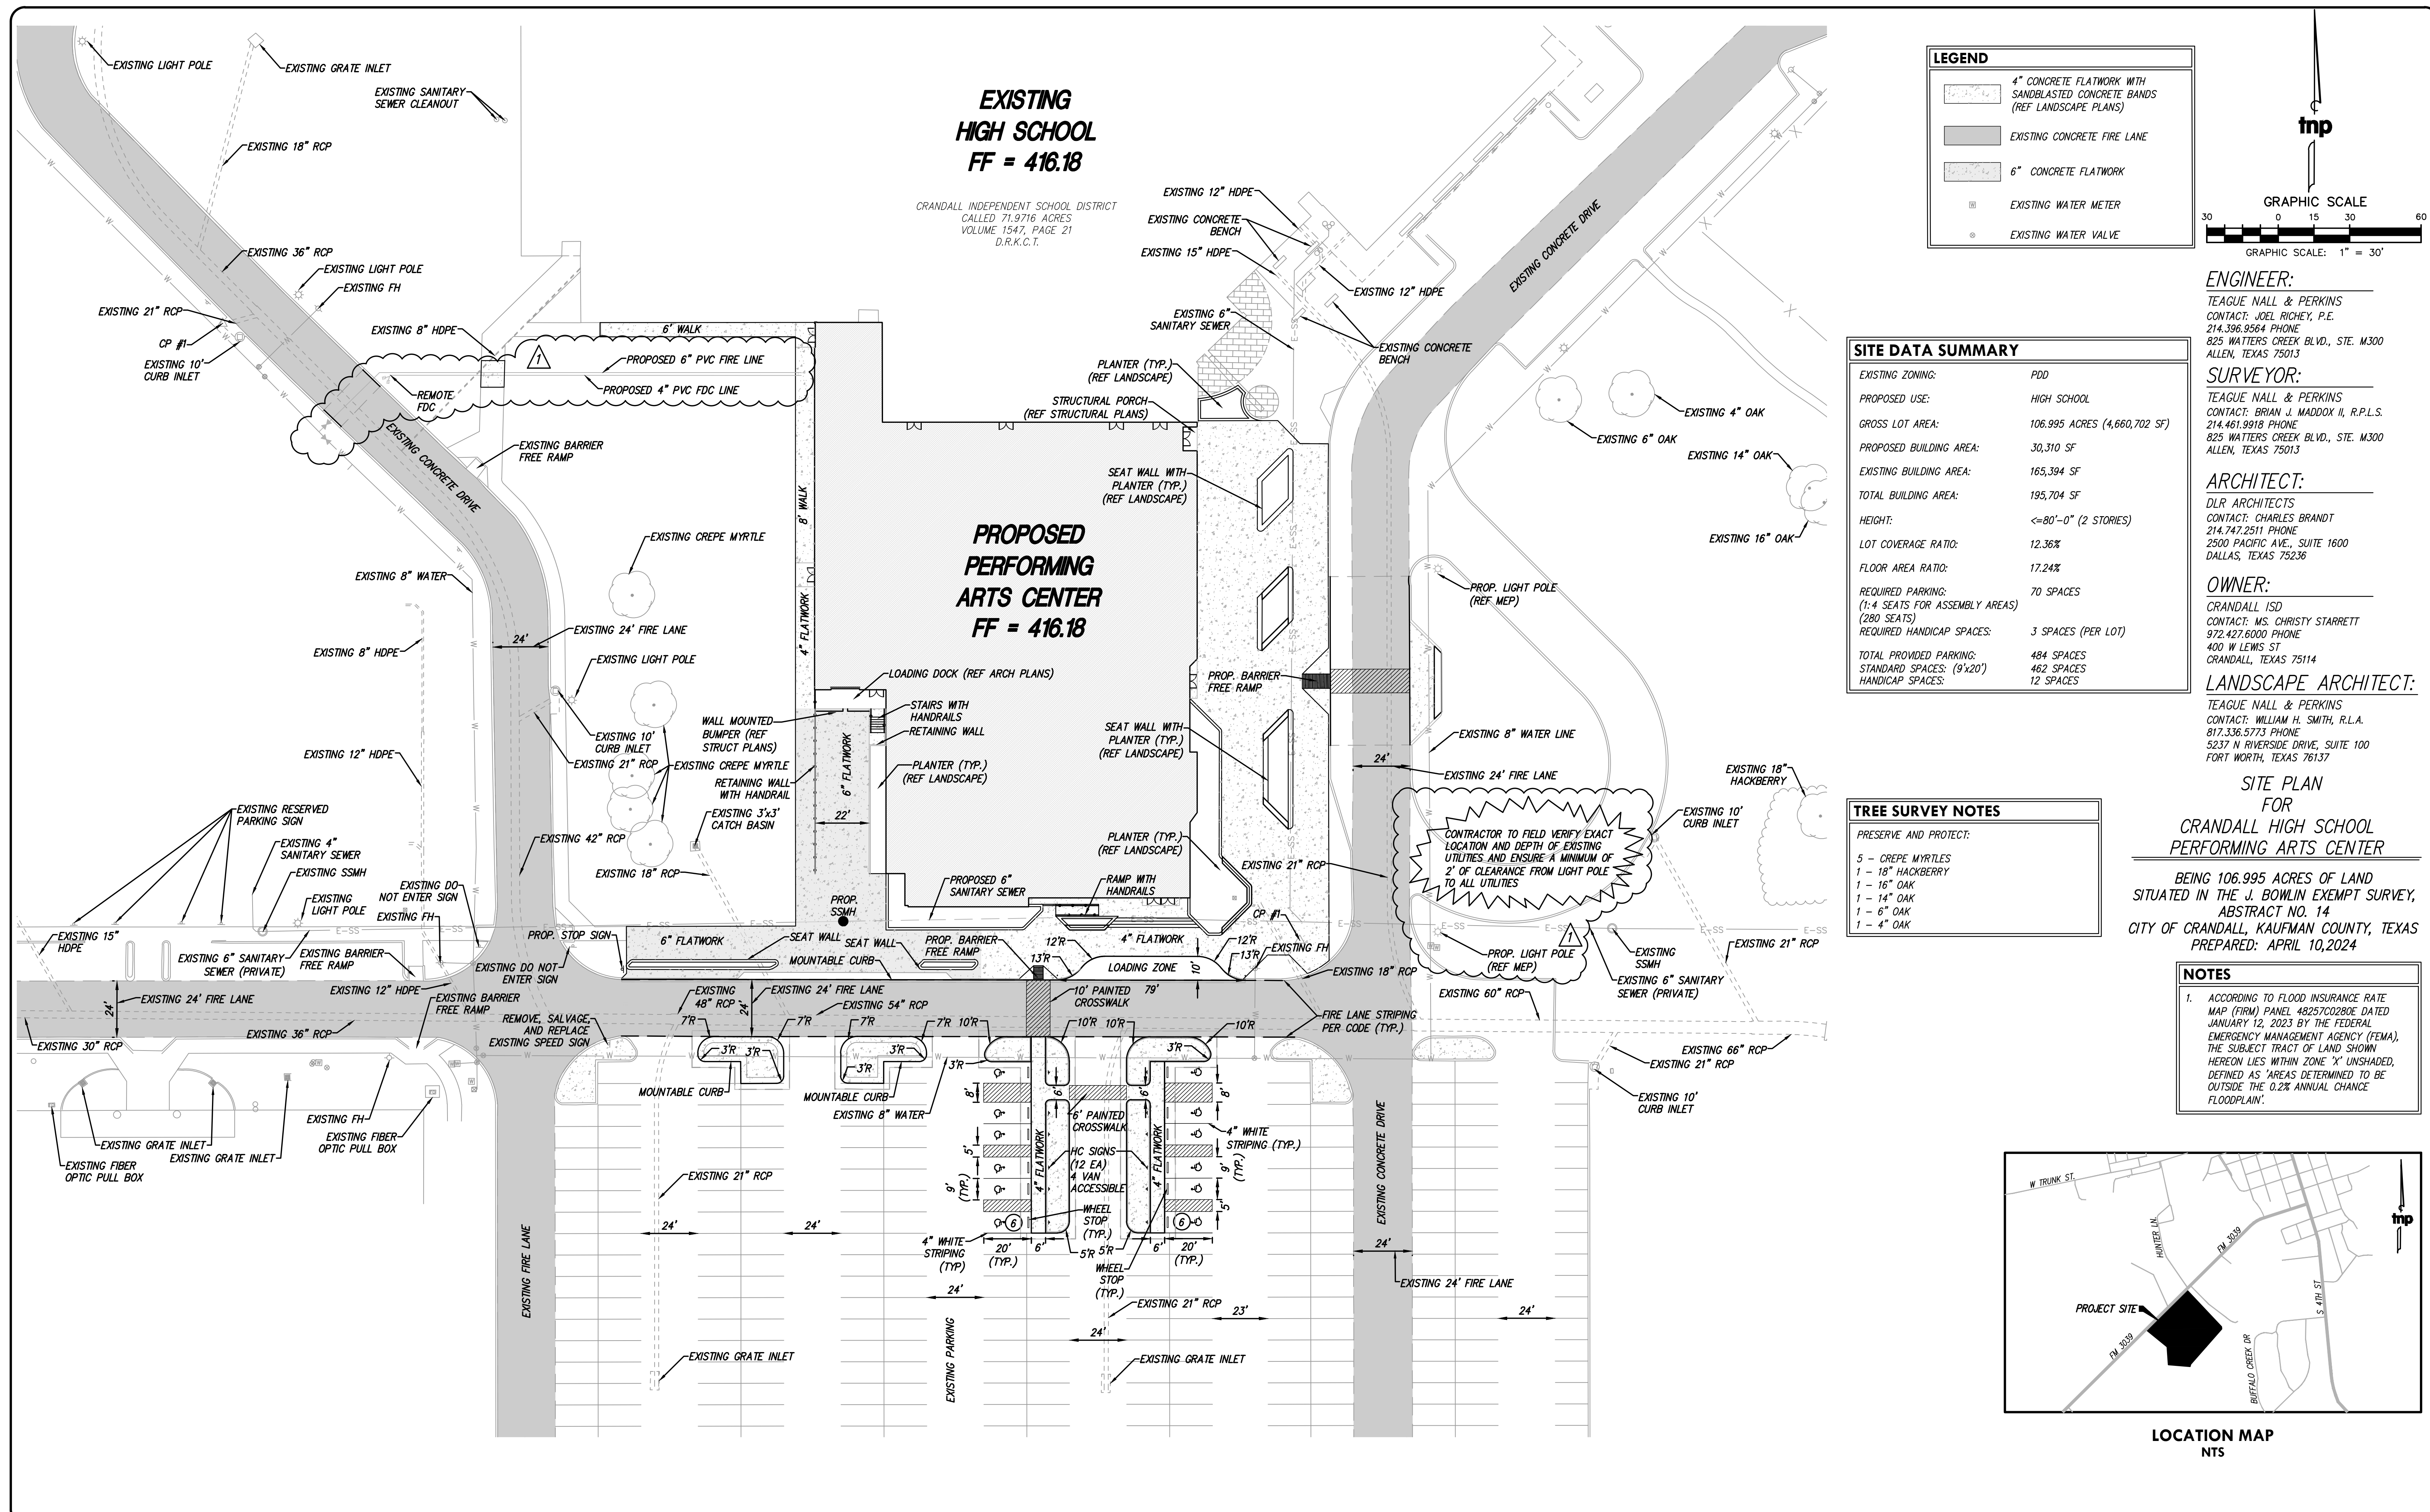

LEGEND

- 4" CONCRETE FLATWORK WITH SANDBLASTED CONCRETE BANDS (REF LANDSCAPE PLANS)
- EXISTING CONCRETE FIRE LANE
- 6" CONCRETE FLATWORK
- EXISTING WATER METER
- EXISTING WATER VALVE

GRAPHIC SCALE
1" = 30'

ENGINEER:
TEAGUE NALL & PERKINS
CONTACT: JOEL RICHEY, P.E.
214.396.9864 PHONE
825 WATERS CREEK BLVD., STE. M300
ALLEN, TEXAS 75013

SURVEYOR:
TEAGUE NALL & PERKINS
CONTACT: BRIAN J. MADDOX II, R.P.L.S.
214.396.9818 PHONE
825 WATERS CREEK BLVD., STE. M300
ALLEN, TEXAS 75013

ARCHITECT:
DLR ARCHITECTS
CONTACT: CHARLES BRANDT
214.747.2511 PHONE
2500 PACIFIC AVE., SUITE 1600
DALLAS, TEXAS 75236

OWNER:
CRANDALL ISD
CONTACT: MS. CHRISTY STARRETT
972.427.6000 PHONE
400 W LEWIS ST
CRANDALL, TEXAS 75114

LANDSCAPE ARCHITECT:
TEAGUE NALL & PERKINS
CONTACT: WILLIAM H. SMITH, R.L.A.
817.336.5773 PHONE
5237 N RIVERSIDE DRIVE, SUITE 100
FORT WORTH, TEXAS 76137

SITE DATA SUMMARY

| | |
|--|------------------------------|
| EXISTING ZONING: | PDD |
| PROPOSED USE: | HIGH SCHOOL |
| GROSS LOT AREA: | 106.995 ACRES (4,660,702 SF) |
| PROPOSED BUILDING AREA: | 30,310 SF |
| EXISTING BUILDING AREA: | 165,394 SF |
| TOTAL BUILDING AREA: | 195,704 SF |
| HEIGHT: | <=80'-0" (2 STORIES) |
| LOT COVERAGE RATIO: | 12.36% |
| FLOOR AREA RATIO: | 17.24% |
| REQUIRED PARKING: (14 SEATS FOR ASSEMBLY AREAS) | 70 SPACES |
| (280 SEATS) | |
| REQUIRED HANDICAP SPACES: | 3 SPACES (PER LOT) |
| TOTAL PROVIDED PARKING: | 484 SPACES |
| STANDARD SPACES: (9'x20') | 462 SPACES |
| HANDICAP SPACES: | 12 SPACES |

TREE SURVEY NOTES

PRESERVE AND PROTECT:


- 5 - CREPE MYRTLES
- 1 - 18" HACKBERRY
- 1 - 16" OAK
- 1 - 14" OAK
- 1 - 8" OAK
- 1 - 4" OAK

SITE PLAN FOR CRANDALL HIGH SCHOOL PERFORMING ARTS CENTER

BEING 106.995 ACRES OF LAND SITUATED IN THE J. BOWLIN EXEMPT SURVEY, ABSTRACT NO. 14 CITY OF CRANDALL, KAUFMAN COUNTY, TEXAS PREPARED: APRIL 10, 2024

NOTES

- ACCORDING TO FLOOD INSURANCE RATE MAP (FIRM) PANEL 4825702020E DATED JANUARY 12, 2023 BY THE FEDERAL EMERGENCY MANAGEMENT AGENCY (FEMA), THE SUBJECT TRACT OF LAND SHOWN HEREON LIES WITHIN ZONE "X" UNSHADED, DEFINED AS "AREAS DETERMINED TO BE OUTSIDE THE 0.2% ANNUAL CHANCE FLOODPLAIN."

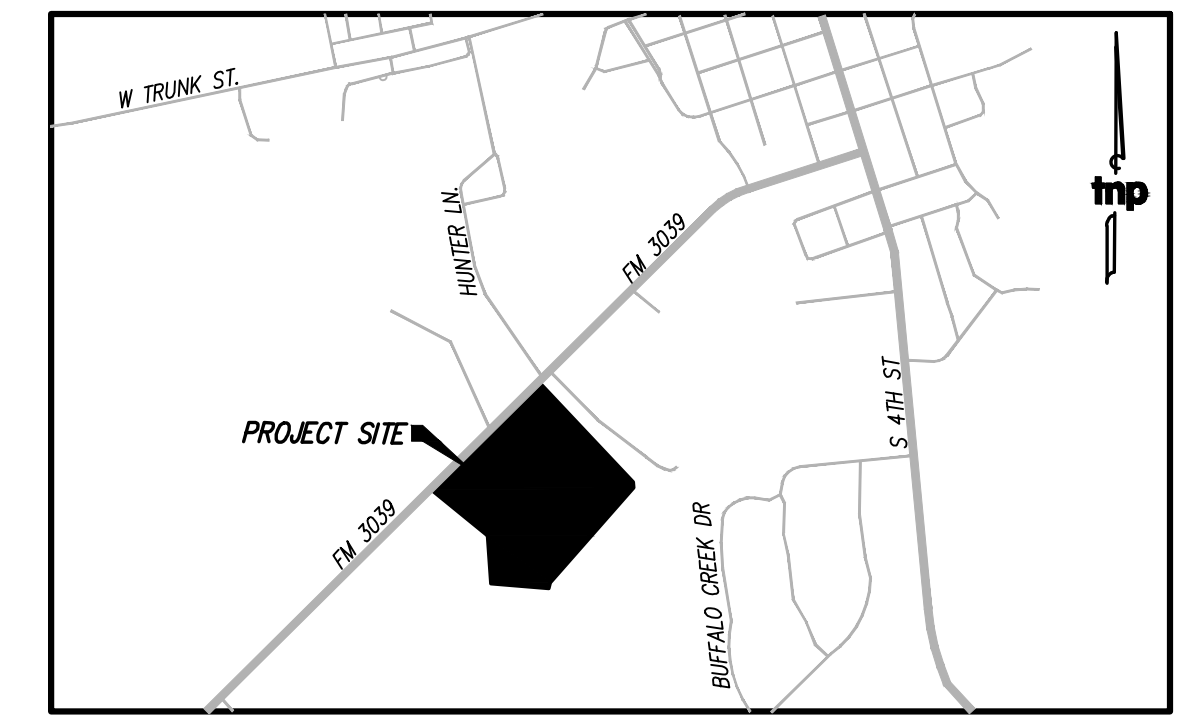

| | | |
|-----|-------------|----------|
| 1 | ADDENDUM 01 | 08/19/24 |
| no. | revision | by date |

Crandall Independent School District

scale
horiz
1"=30'
vert
N/A
date
AUG 2024

tnp


teague nall and perkins, inc
825 Waters Creek Blvd., Suite M300
Allen, Texas 75013
214.461.9867 ph 214.461.9864 fx
www.tnplnc.com
TBPELS: ENGR F-230, SURV 10011650, 10011601, 10194381
GPPE: PEF007431; TBAE: BR 2673

STATE OF TEXAS
JOEL M. RICHEY
136432
PROFESSIONAL ENGINEER
08/19/2024

City of Crandall, Texas
Crandall Independent School District
High School - PAC Addition
SITE PLAN

tnp project
DLR23073
sheet
C1.03



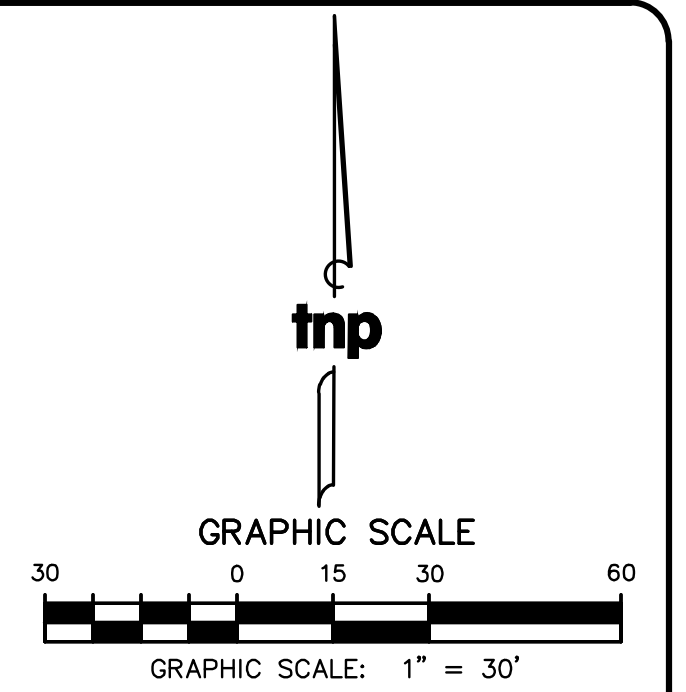


- NOTES: 1. THIS PLAN SHALL BE USED TO CONTROL THE GEOMETRICS OF THE SITE LAYOUT... 2. ALL DIMENSIONS AND COORDINATES ARE TO THE FACE OF CURB AND BUILDING... 3. ALL BUILDING TIES AND DIMENSIONS SHALL BE COORDINATED AND VERIFIED WITH THE ARCHITECT'S PLANS... 4. ALL CURB RADI ARE 5' UNLESS OTHERWISE NOTED.

COORDINATE CONTROL TABLE for BUILDING with columns for Point #, Northing, Easting, Desc.

COORDINATE CONTROL TABLE for SIDEWALK with columns for Point #, Northing, Easting, Desc.

COORDINATE CONTROL TABLE for SIDEWALK with columns for Point #, Northing, Easting, Desc.

BENCHMARKS table with columns for BM #, description, Northing, Easting, Elevation.

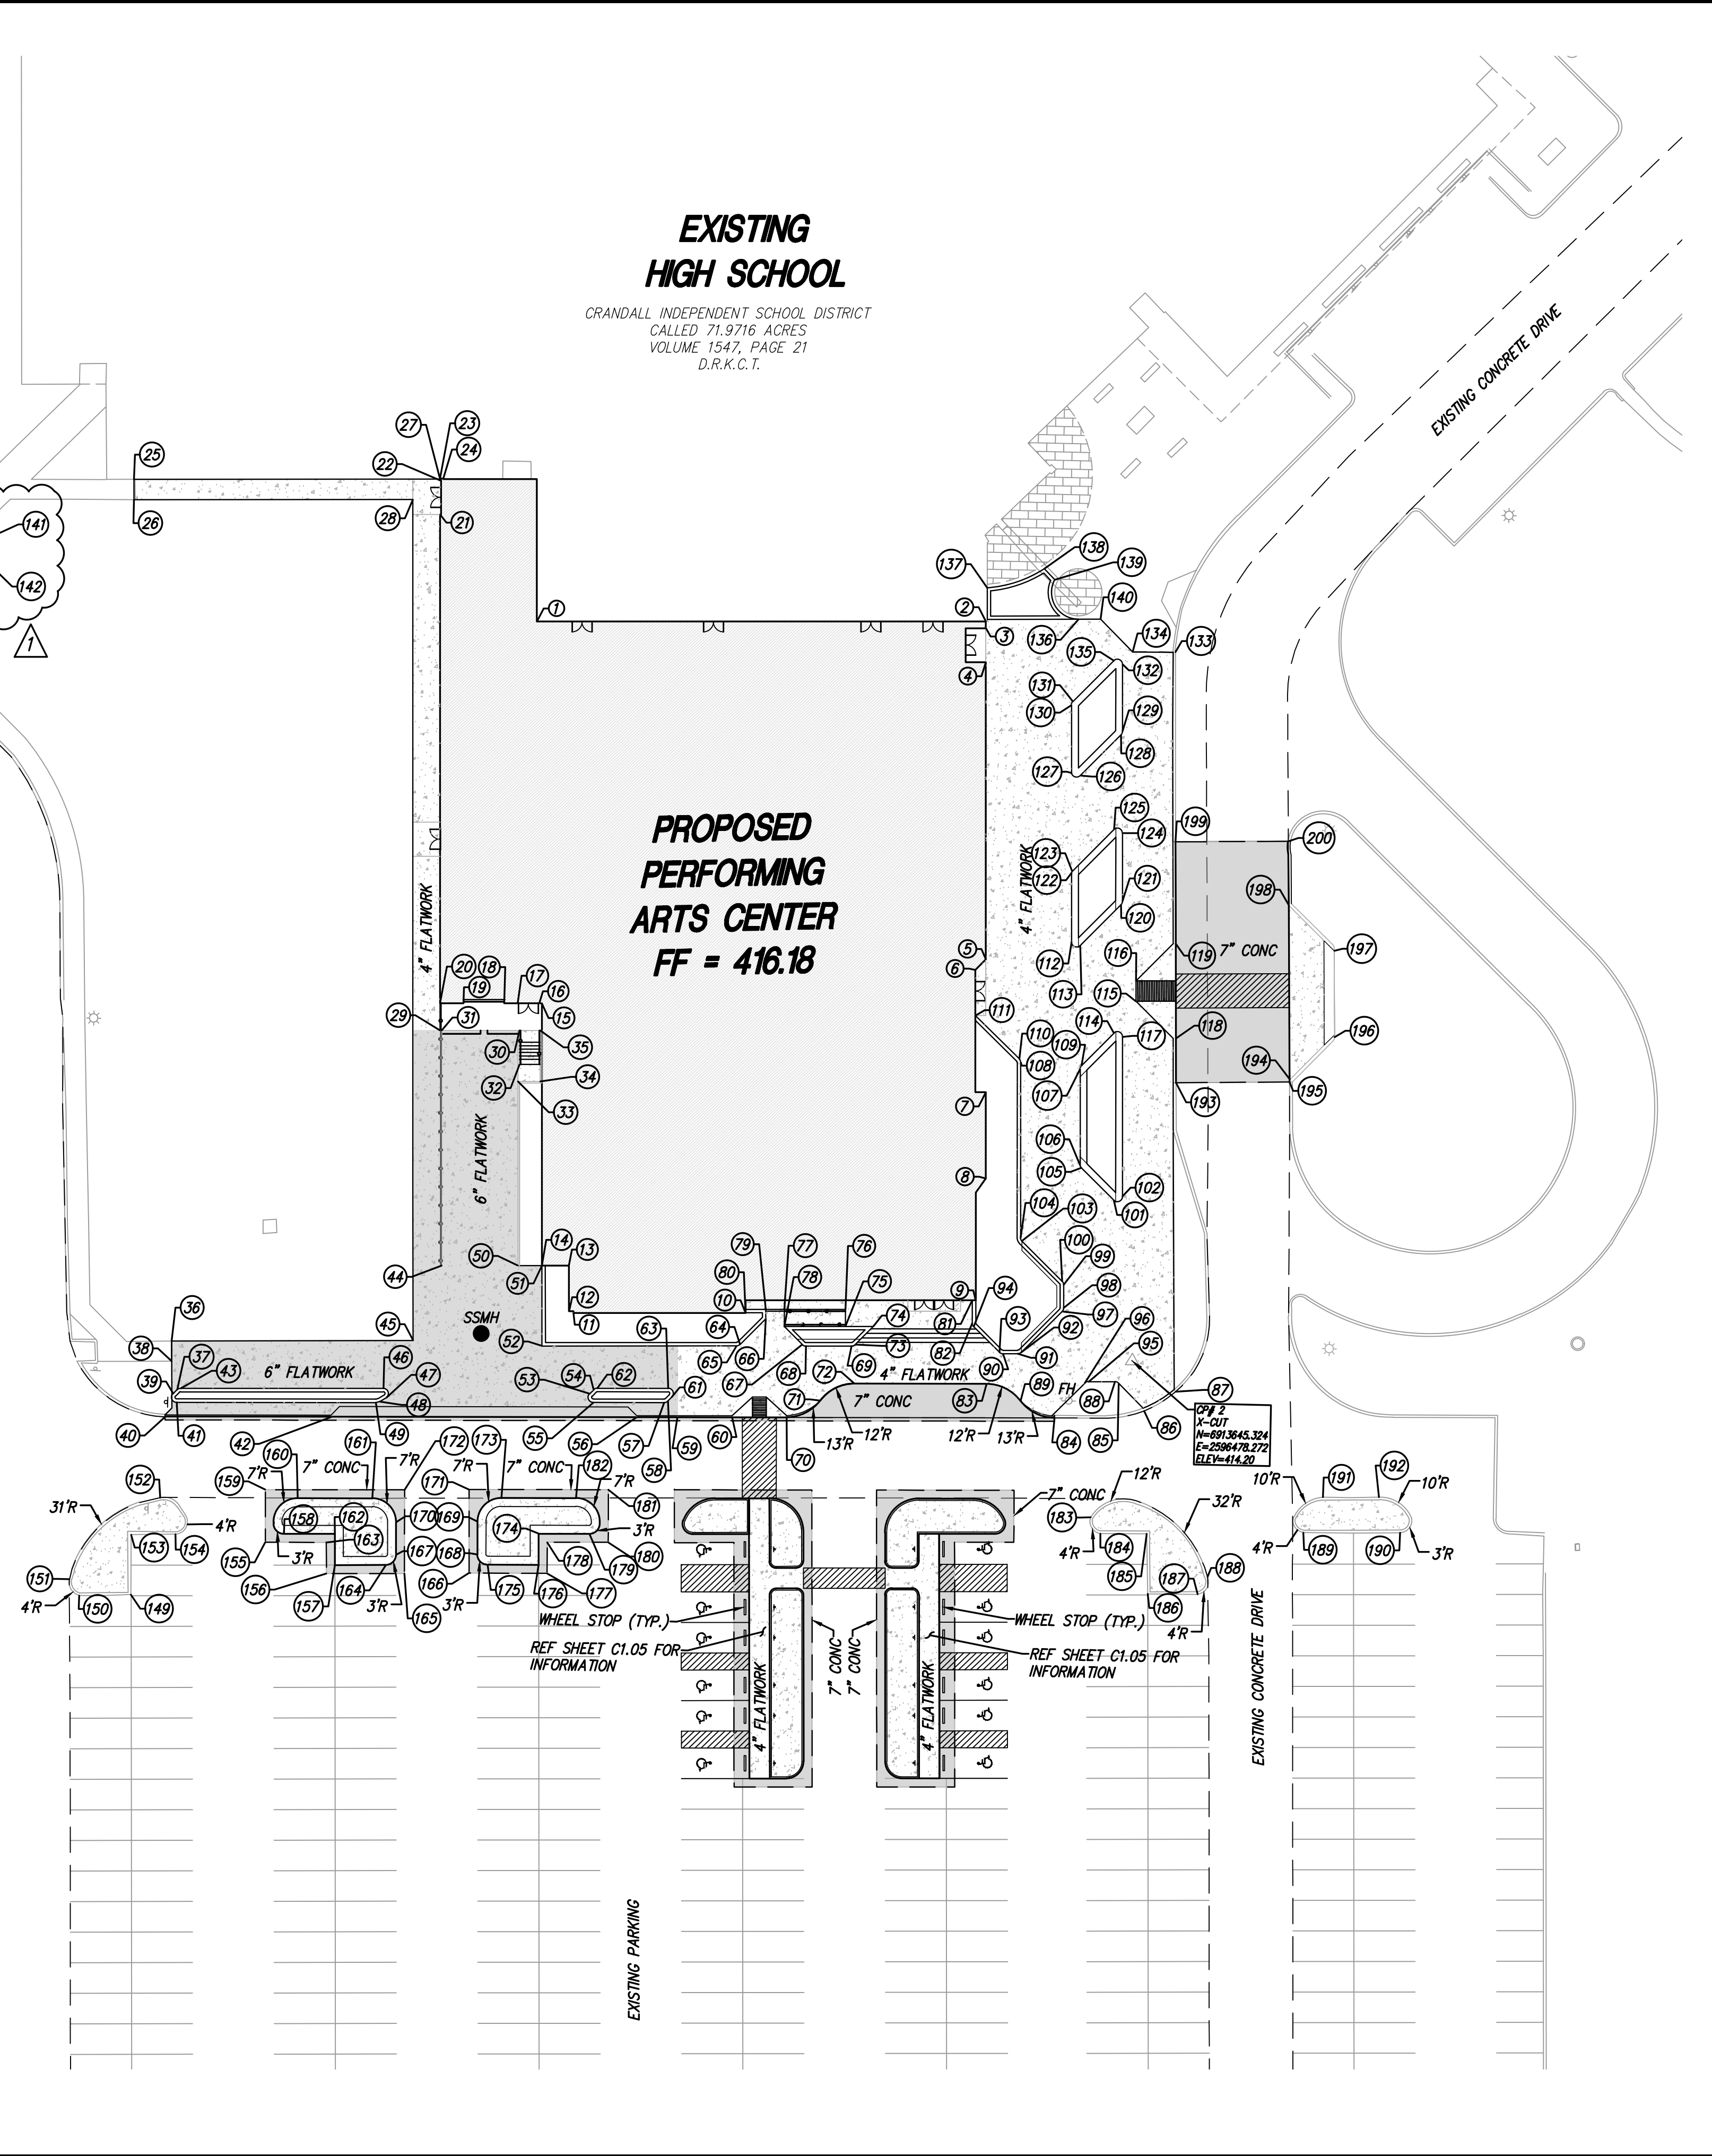


CONTROL POINTS COORDINATE CONTROL TABLE with columns for Point #, Northing, Easting, Desc.

PARKING COORDINATE CONTROL TABLE with columns for Point #, Northing, Easting, Desc.

PARKING COORDINATE CONTROL TABLE with columns for Point #, Northing, Easting, Desc.


Revision table with columns for no., revision, by, date.

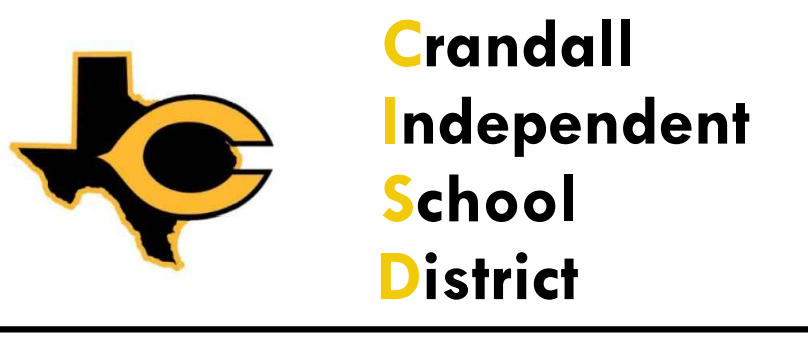

scale horiz 1"=30' vert N/A date AUG 2024






teague nall and perkins, inc 825 Walters Creek Blvd., Suite M300 Allen, Texas 75013

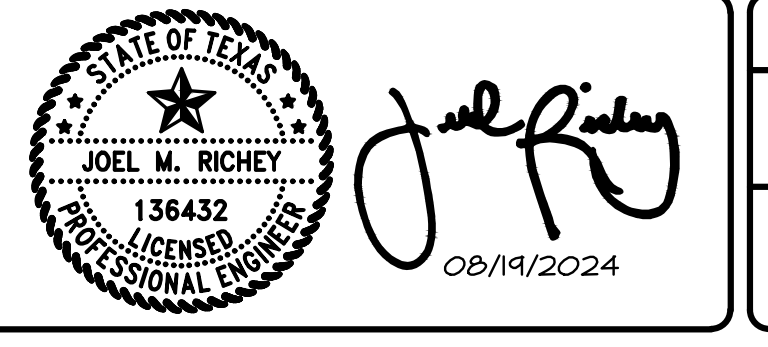


City of Crandall, Texas Crandall Independent School District High School - PAC Addition DIMENSION CONTROL PLAN

tnp project DLR23073 sheet C1.04

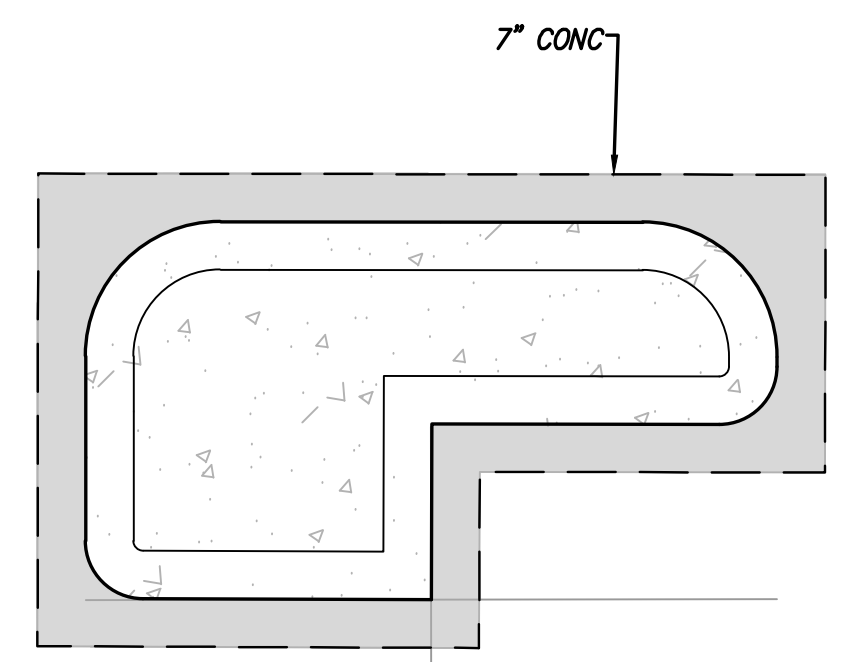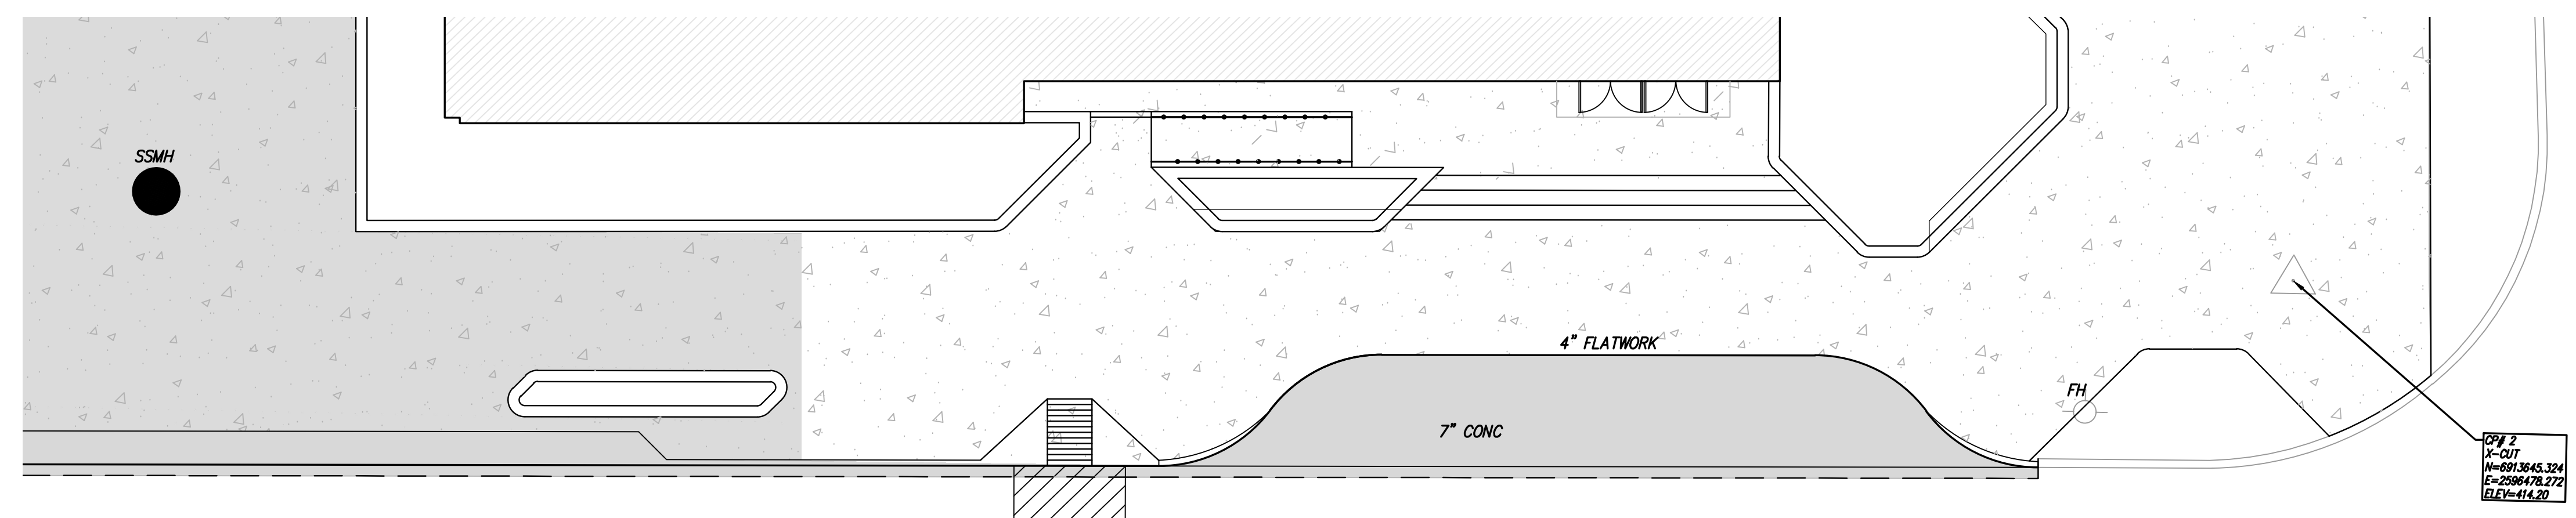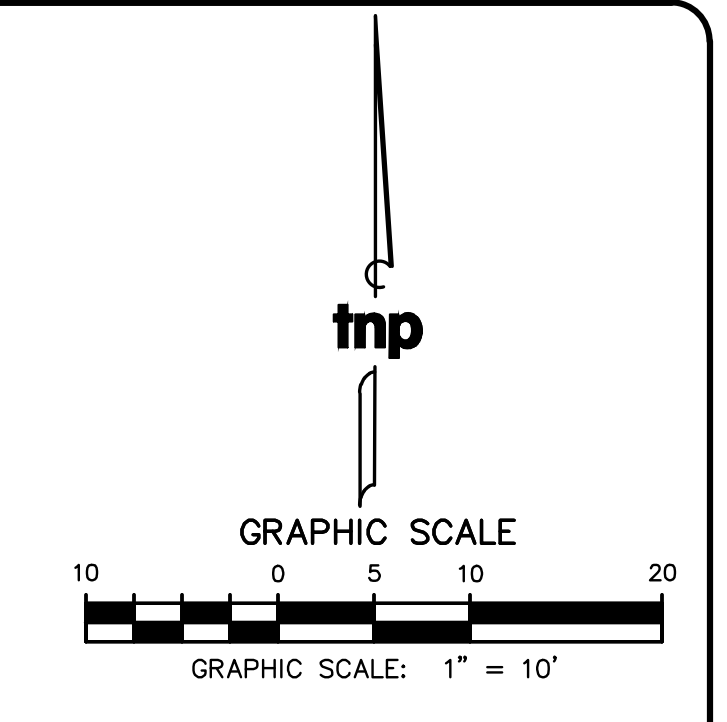


PARKING
COORDINATE CONTROL TABLE

| Point # | Northing | Eastng | Desc |
|---------|------------|------------|---------|
| 201 | 6913604.60 | 2596344.25 | PARKING |
| 202 | 6913602.33 | 2596356.36 | PARKING |
| 203 | 6913602.49 | 2596364.31 | PARKING |
| 204 | 6913592.02 | 2596366.53 | PARKING |
| 205 | 6913589.42 | 2596362.09 | PARKING |
| 206 | 6913591.66 | 2596350.01 | PARKING |
| 207 | 6913589.04 | 2596344.55 | PARKING |
| 208 | 6913595.66 | 2596347.12 | PARKING |
| 209 | 6913602.64 | 2596372.33 | PARKING |
| 210 | 6913602.49 | 2596374.27 | PARKING |
| 211 | 6913605.38 | 2596384.75 | PARKING |
| 212 | 6913582.86 | 2596382.52 | PARKING |
| 213 | 6913584.37 | 2596382.70 | PARKING |
| 214 | 6913582.33 | 2596380.75 | PARKING |
| 215 | 6913582.20 | 2596374.75 | PARKING |
| 216 | 6913584.15 | 2596372.71 | PARKING |
| 217 | 6913576.20 | 2596374.88 | PARKING |
| 218 | 6913574.15 | 2596372.92 | PARKING |
| 219 | 6913576.33 | 2596380.88 | PARKING |
| 220 | 6913574.37 | 2596382.92 | PARKING |
| 221 | 6913517.44 | 2596363.65 | PARKING |
| 222 | 6913520.04 | 2596368.10 | PARKING |
| 223 | 6913520.17 | 2596374.10 | PARKING |
| 224 | 6913520.28 | 2596379.10 | PARKING |
| 225 | 6913525.38 | 2596383.99 | PARKING |
| 226 | 6913517.94 | 2596386.65 | PARKING |
| 227 | 6913605.75 | 2596403.79 | PARKING |
| 228 | 6913603.49 | 2596416.36 | PARKING |
| 229 | 6913603.79 | 2596432.34 | PARKING |
| 230 | 6913606.52 | 2596444.25 | PARKING |
| 231 | 6913597.83 | 2596441.68 | PARKING |
| 232 | 6913591.25 | 2596444.54 | PARKING |
| 233 | 6913593.62 | 2596439.00 | PARKING |
| 234 | 6913590.84 | 2596427.07 | PARKING |
| 235 | 6913593.27 | 2596422.52 | PARKING |
| 236 | 6913583.11 | 2596416.52 | PARKING |
| 237 | 6913593.28 | 2596406.56 | PARKING |
| 238 | 6913584.89 | 2596406.74 | PARKING |
| 239 | 6913582.94 | 2596408.78 | PARKING |
| 240 | 6913583.06 | 2596414.74 | PARKING |
| 241 | 6913585.11 | 2596416.70 | PARKING |
| 242 | 6913577.07 | 2596414.87 | PARKING |
| 243 | 6913574.89 | 2596406.95 | PARKING |
| 244 | 6913576.94 | 2596408.90 | PARKING |
| 245 | 6913575.11 | 2596416.91 | PARKING |
| 246 | 6913525.91 | 2596407.98 | PARKING |
| 247 | 6913518.35 | 2596405.64 | PARKING |
| 248 | 6913521.01 | 2596413.09 | PARKING |
| 249 | 6913521.12 | 2596418.09 | PARKING |
| 250 | 6913521.25 | 2596424.09 | PARKING |
| 251 | 6913518.85 | 2596428.64 | PARKING |

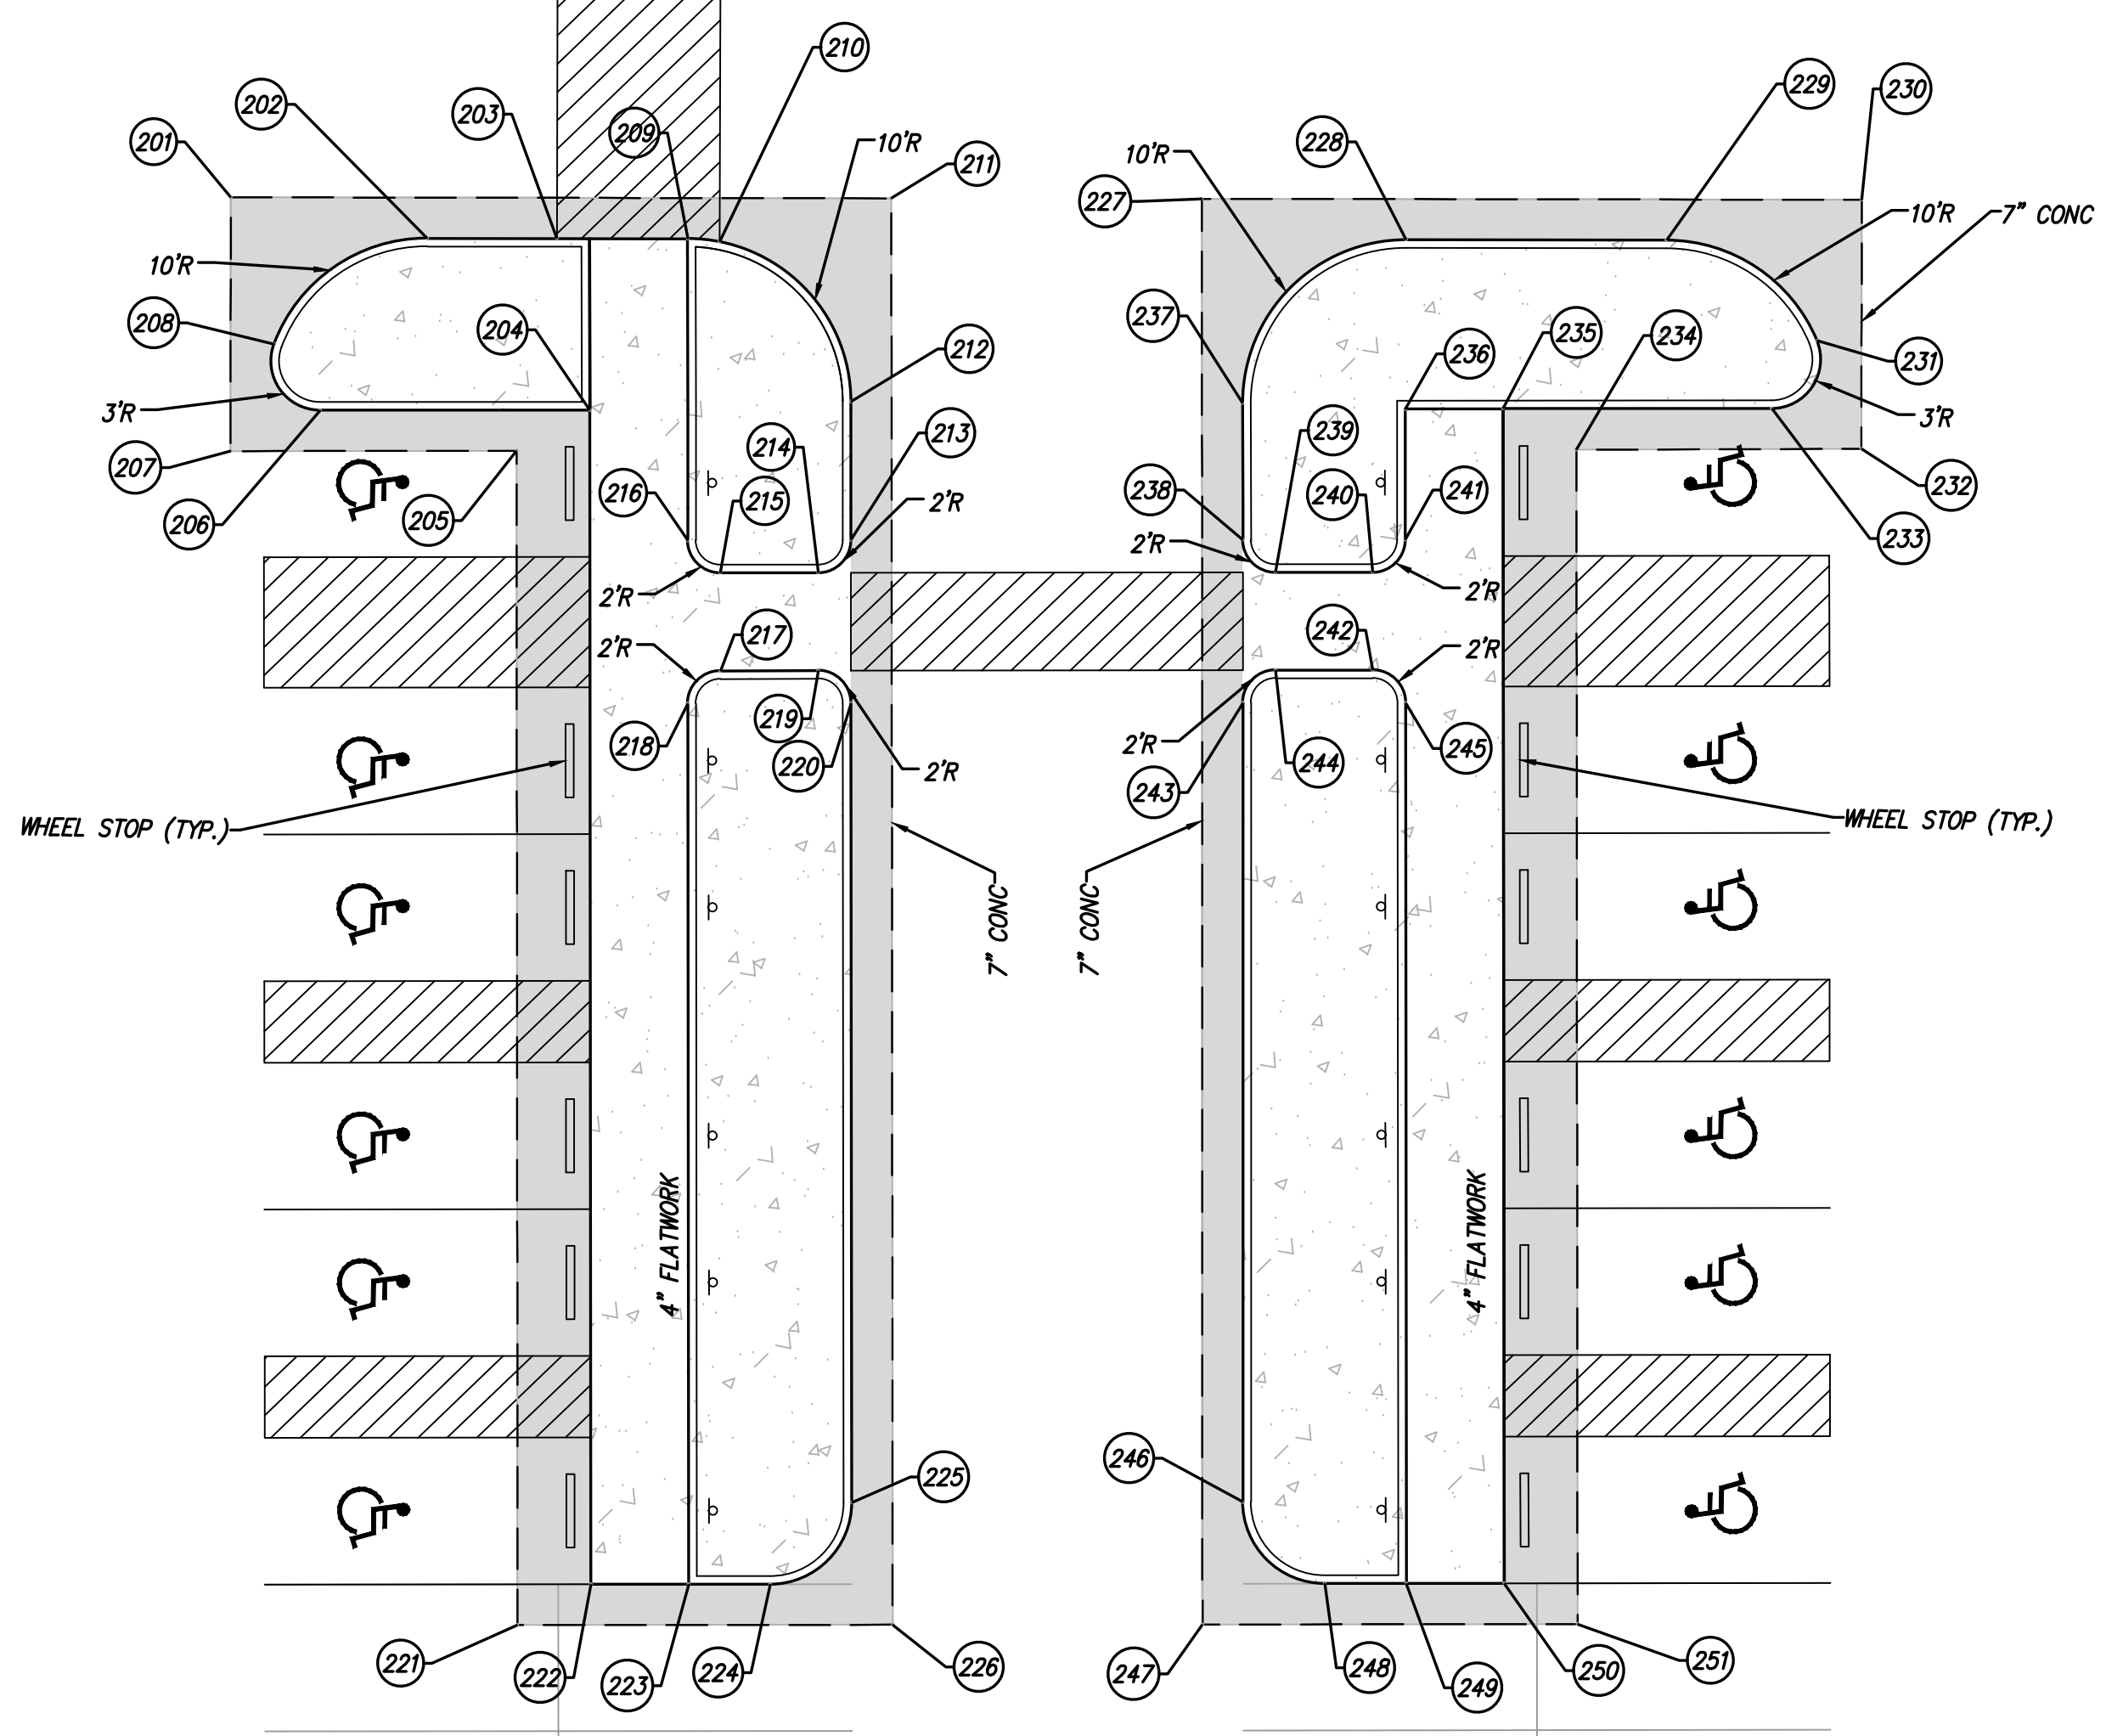


EXISTING CONCRETE DRIVE


| no. | revision | by | date |
|-----|-------------|----|----------|
| 1 | ADDENDUM 01 | | 08/19/24 |

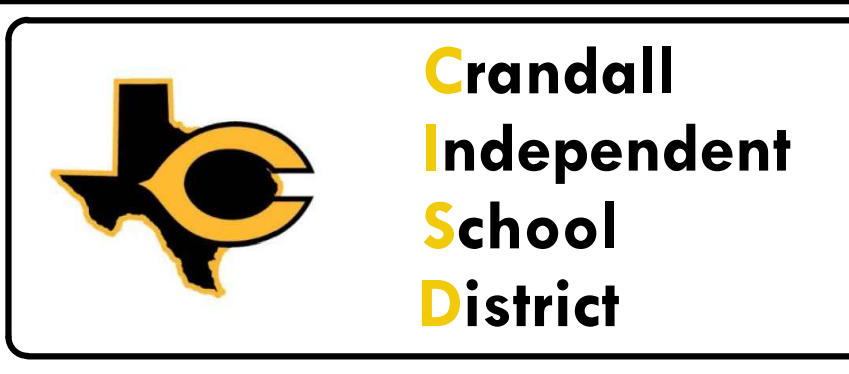

scale
horiz
1"=10'
vert
N/A
date
AUG 2024


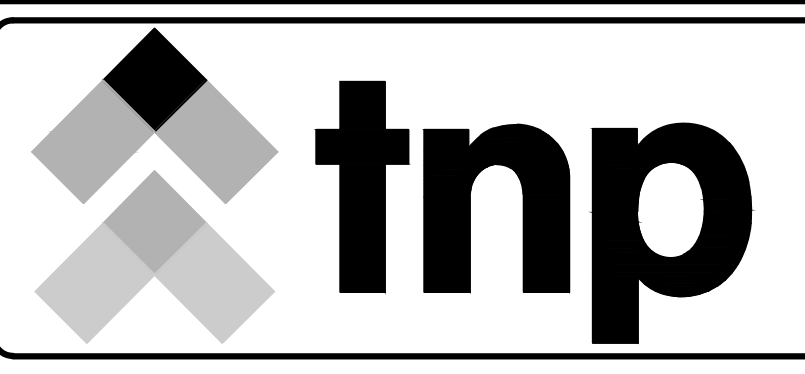


teague nall and perkins, inc
825 Walters Creek Blvd., Suite M300
Allen, Texas 75013
214.461.9867 ph 214.461.9864 fx
www.tnplinc.com
TBPELS: ENGR F-230; SURV 10011600, 10011601, 10194381
GPPE: PEFO07431; TBAE: BR 2673

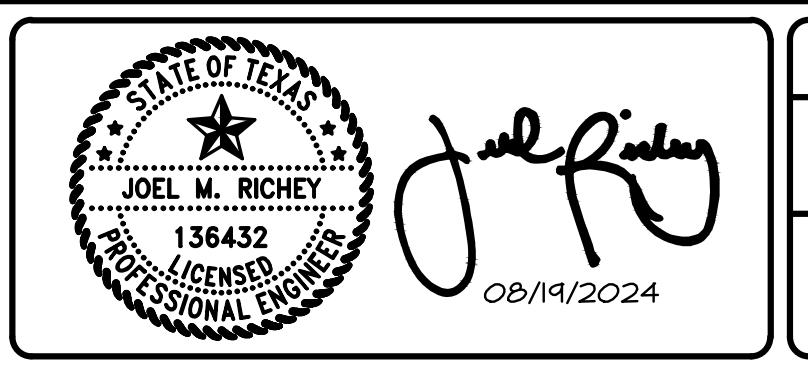

City of Crandall, Texas
Crandall Independent School District
High School - PAC Addition
DIMENSION CONTROL PLAN INSET

tnp project
DLR23073
sheet
C1.05

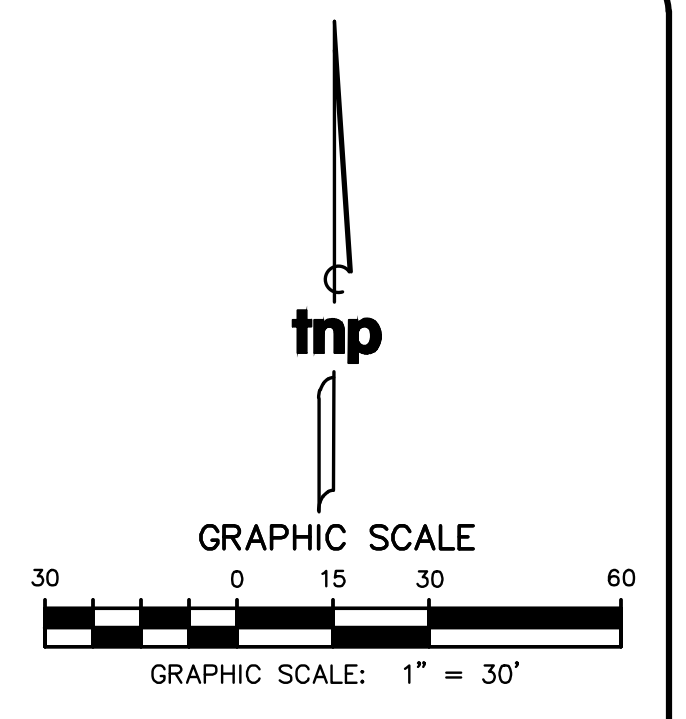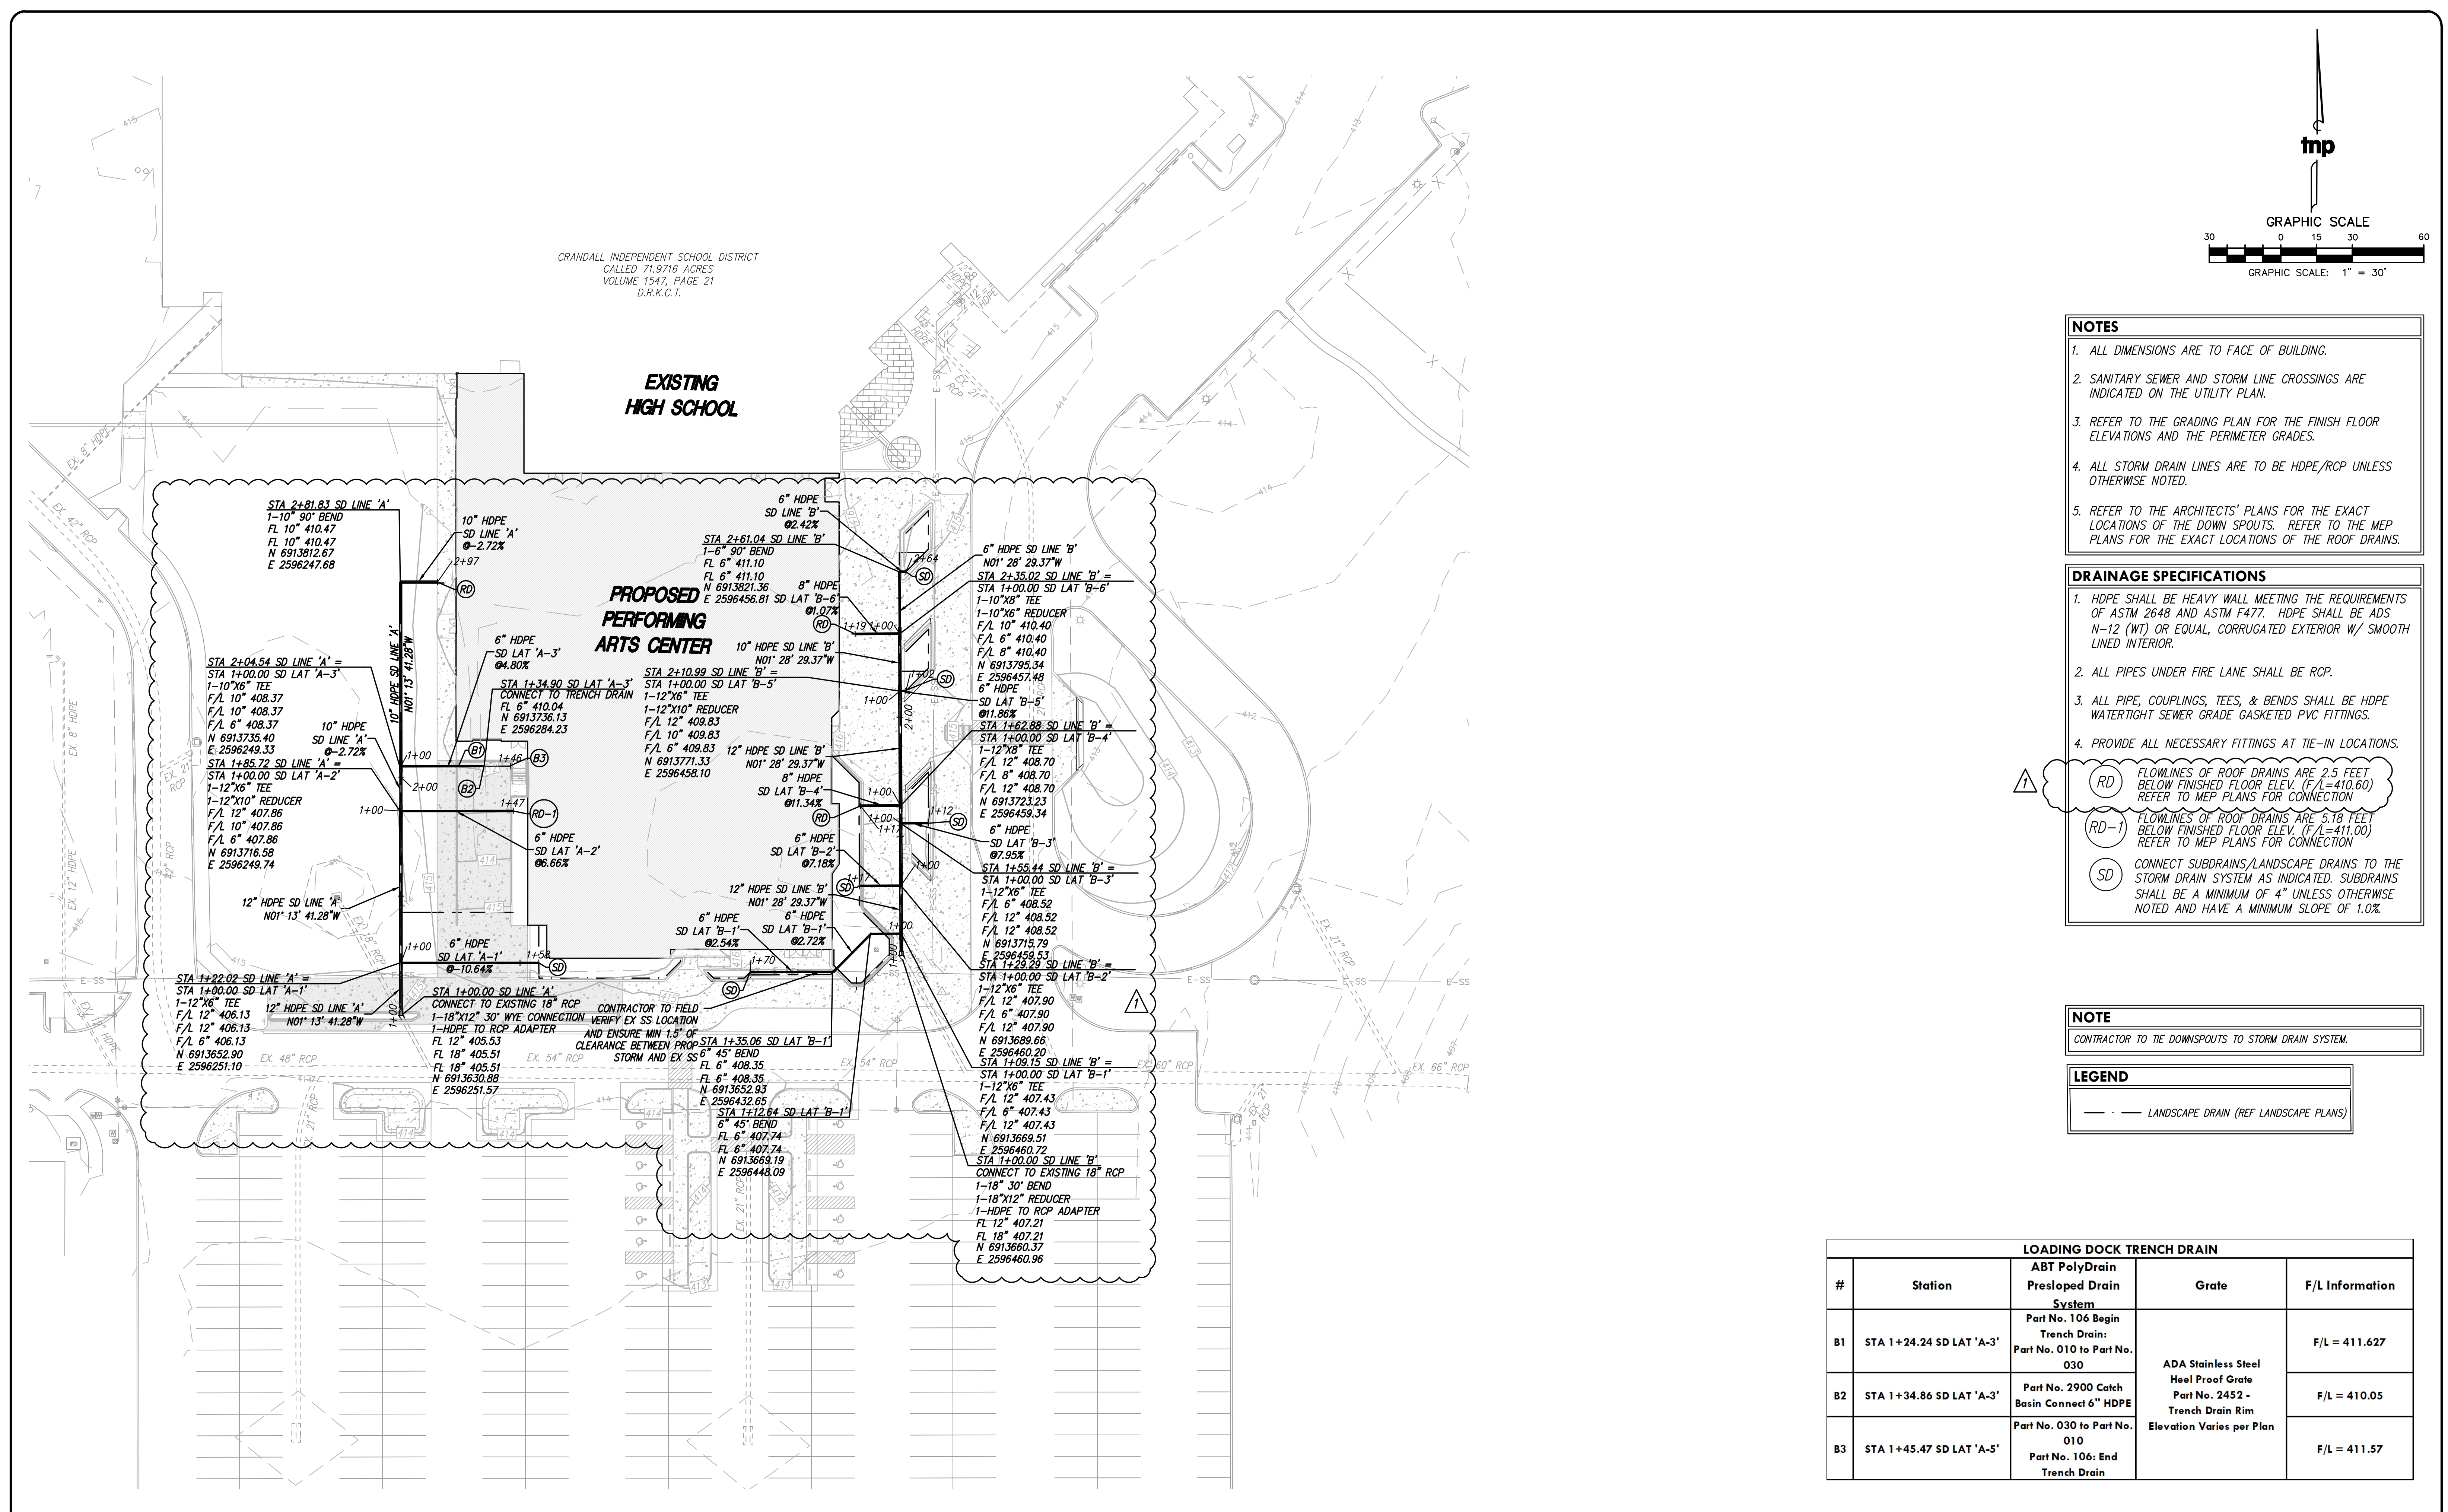

- NOTES**
1. ALL DIMENSIONS ARE TO FACE OF BUILDING.
 2. SANITARY SEWER AND STORM LINE CROSSINGS ARE INDICATED ON THE UTILITY PLAN.
 3. REFER TO THE GRADING PLAN FOR THE FINISH FLOOR ELEVATIONS AND THE PERIMETER GRADES.
 4. ALL STORM DRAIN LINES ARE TO BE HDPE/RCP UNLESS OTHERWISE NOTED.
 5. REFER TO THE ARCHITECTS' PLANS FOR THE EXACT LOCATIONS OF THE DOWN SPOUTS. REFER TO THE MEP PLANS FOR THE EXACT LOCATIONS OF THE ROOF DRAINS.

- DRAINAGE SPECIFICATIONS**
1. HDPE SHALL BE HEAVY WALL MEETING THE REQUIREMENTS OF ASTM 2648 AND ASTM F477. HDPE SHALL BE ADS N-12 (WT) OR EQUAL, CORRUGATED EXTERIOR W/ SMOOTH LINED INTERIOR.
 2. ALL PIPES UNDER FIRE LANE SHALL BE RCP.
 3. ALL PIPE, COUPLINGS, TEES, & BENDS SHALL BE HDPE WATERTIGHT SEWER GRADE GASKETED PVC FITTINGS.
 4. PROVIDE ALL NECESSARY FITTINGS AT TIE-IN LOCATIONS.
- RD** FLOWLINES OF ROOF DRAINS ARE 2.5 FEET BELOW FINISHED FLOOR ELEV. (F/L=410.60) REFER TO MEP PLANS FOR CONNECTION
- RD-1** FLOWLINES OF ROOF DRAINS ARE 5.18 FEET BELOW FINISHED FLOOR ELEV. (F/L=411.00) REFER TO MEP PLANS FOR CONNECTION
- SD** CONNECT SUBDRAINS/LANDSCAPE DRAINS TO THE STORM DRAIN SYSTEM AS INDICATED. SUBDRAINS SHALL BE A MINIMUM OF 4" UNLESS OTHERWISE NOTED AND HAVE A MINIMUM SLOPE OF 1.0%.

NOTE
CONTRACTOR TO TIE DOWNSPOUTS TO STORM DRAIN SYSTEM.

LEGEND

| | |
|--|---------------------------------------|
| | LANDSCAPE DRAIN (REF LANDSCAPE PLANS) |
|--|---------------------------------------|

| LOADING DOCK TRENCH DRAIN | | | | |
|---------------------------|--------------------------|---|---|-----------------|
| # | Station | ABT PolyDrain Presloped Drain System | Grate | F/L Information |
| B1 | STA 1+24.24 SD LAT 'A-3' | Part No. 106 Begin Trench Drain: Part No. 010 to Part No. 030 | ADA Stainless Steel Heel Proof Grate Part No. 2452 - Trench Drain Rim Elevation Varies per Plan | F/L = 411.627 |
| B2 | STA 1+34.86 SD LAT 'A-3' | Part No. 2900 Catch Basin Connect 6" HDPE | | F/L = 410.05 |
| B3 | STA 1+45.47 SD LAT 'A-5' | Part No. 030 to Part No. 010 Part No. 106: End Trench Drain | | F/L = 411.57 |

| | | |
|-----|-------------|----------|
| 1 | ADDENDUM 01 | 08/19/24 |
| no. | revision | by date |

Crandall Independent School District

scale
horiz
1"=30'
vert
N/A
date
AUG 2024


teague nall and perkins, inc
825 Walters Creek Blvd., Suite M300
Allen, Texas 75013
214.461.9867 ph 214.461.9864 fx
www.tnpgroup.com
TBP/ELS: ENGR F-230; SURV 10011600, 10011601, 10194381
GPPE: PEF007431; TBAE: BR 2673

STATE OF TEXAS
JOEL M. RICHEY
136432
PROFESSIONAL ENGINEER


08/19/2024

City of Crandall, Texas
Crandall Independent School District
High School - PAC Addition
STORM DRAIN PLAN


Inp project
DLR23073
sheet
C1.08

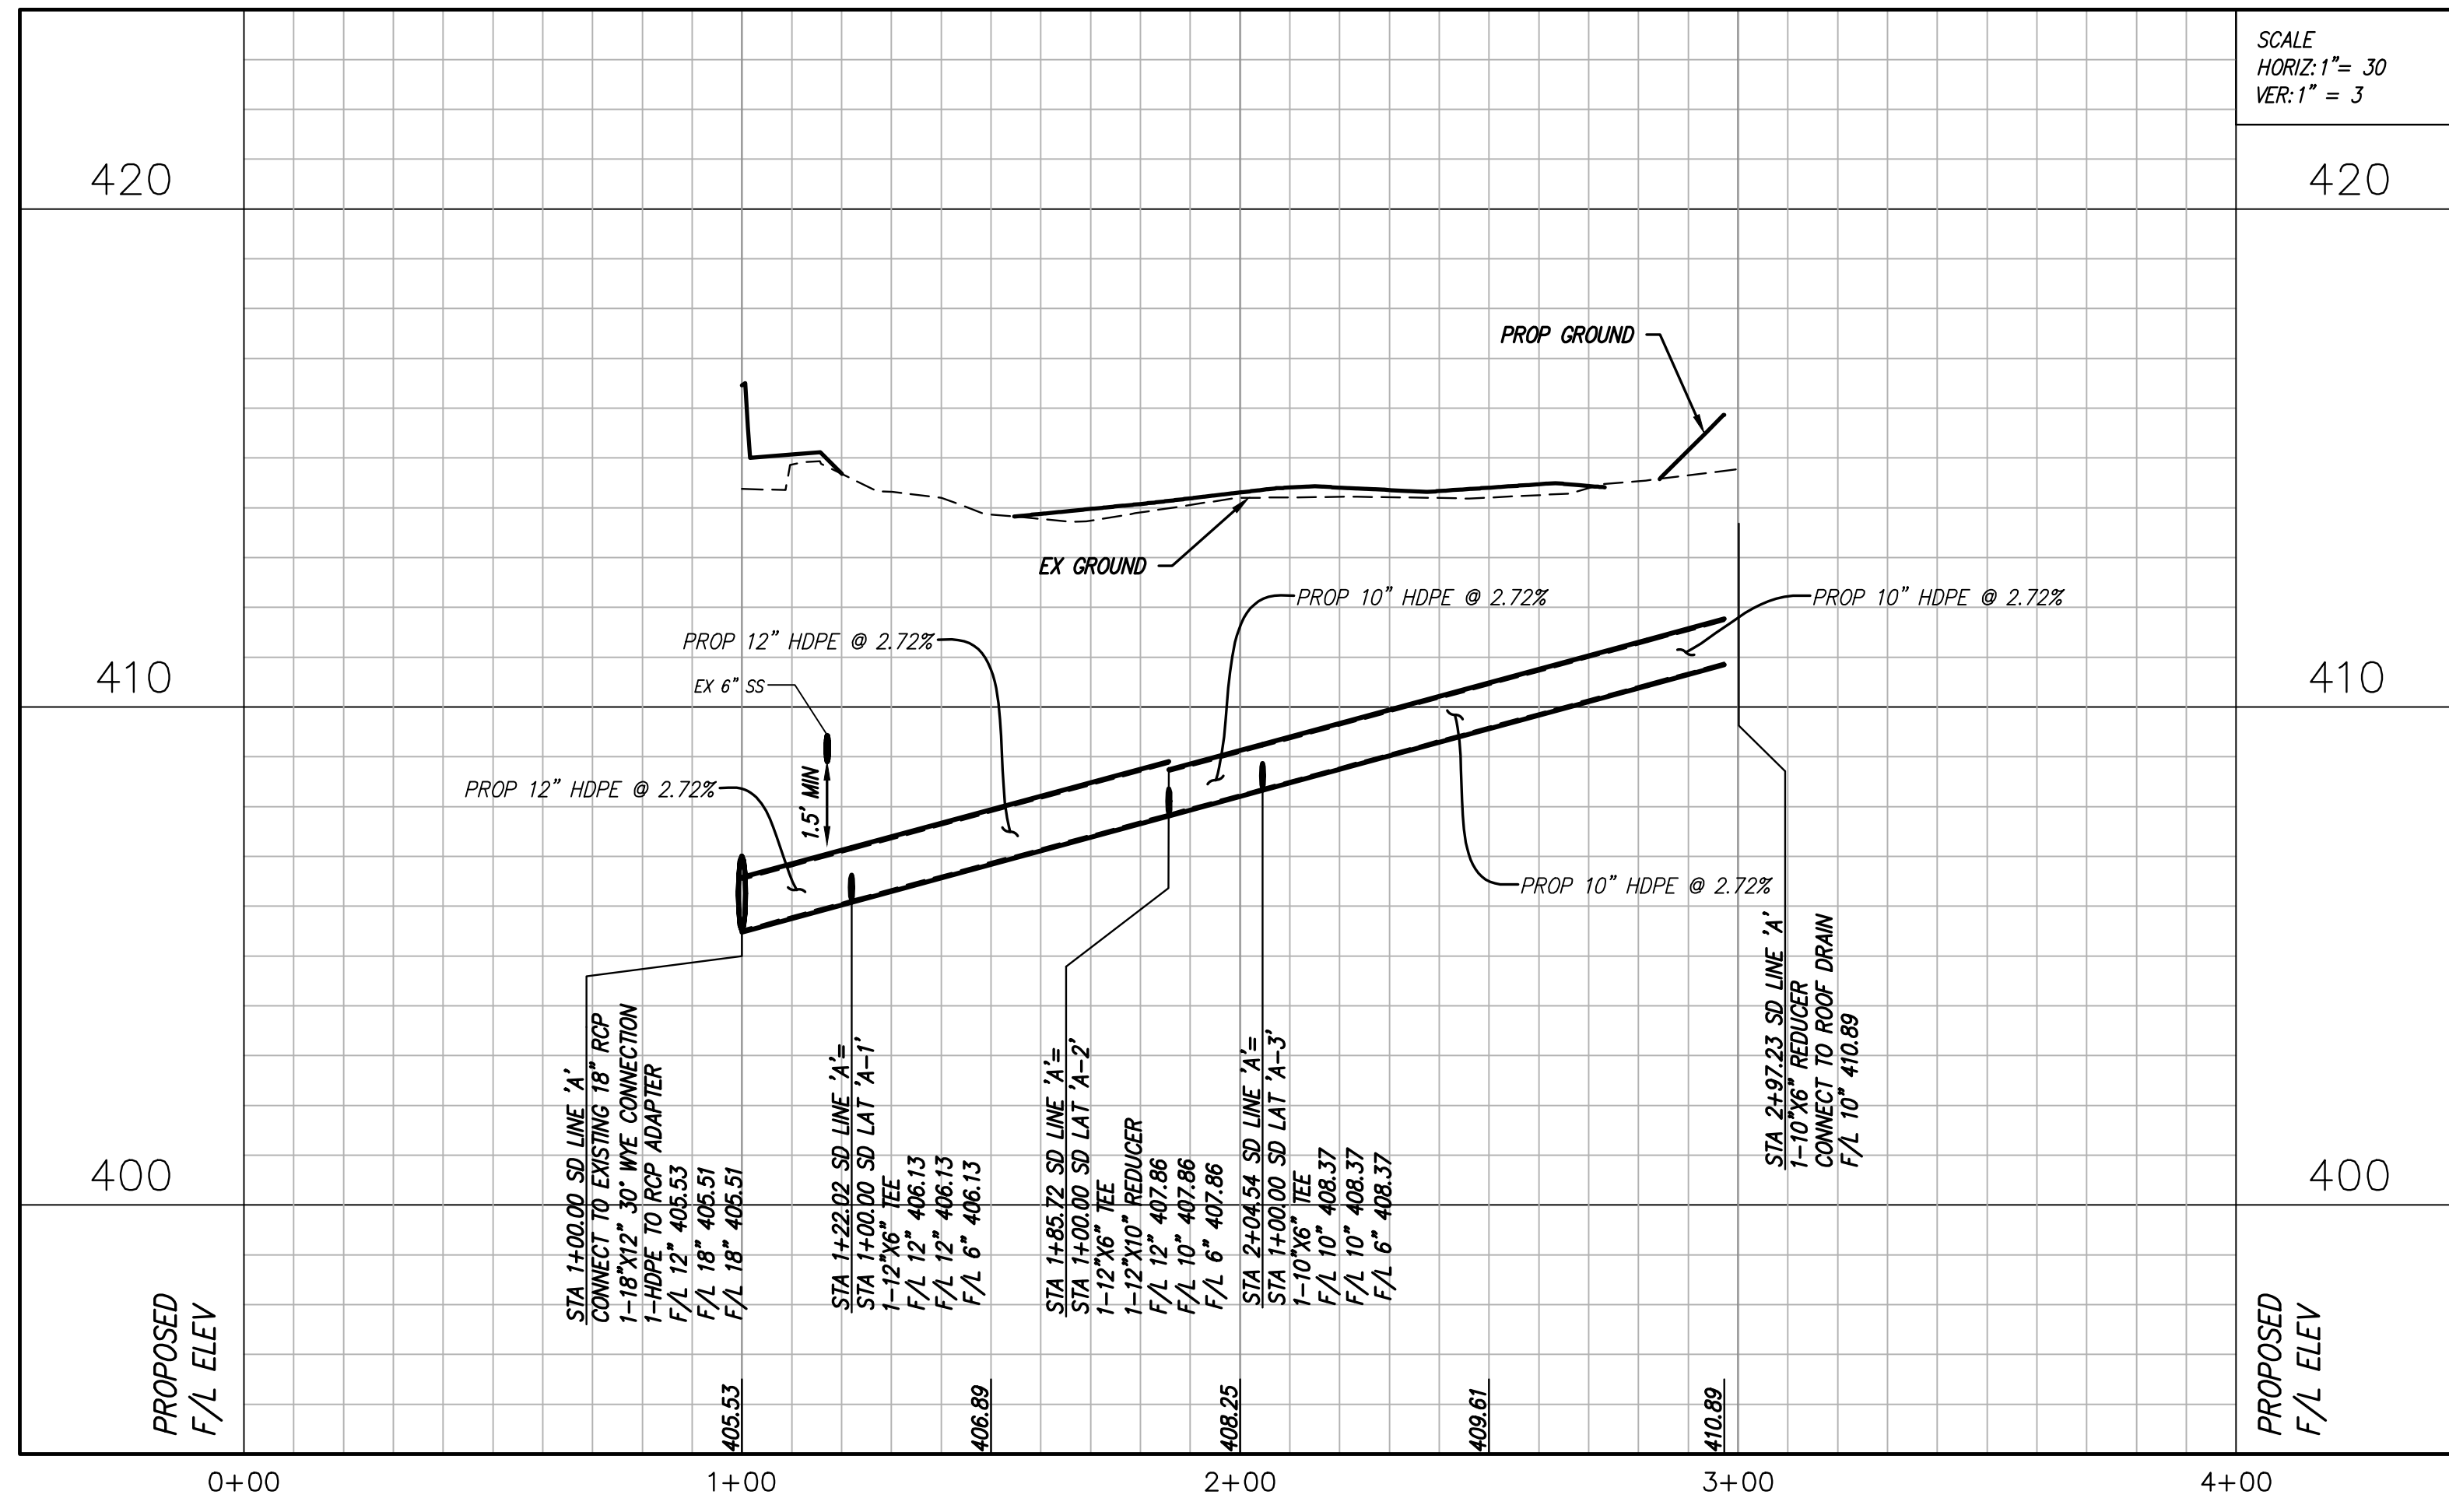

SD LINE 'A'

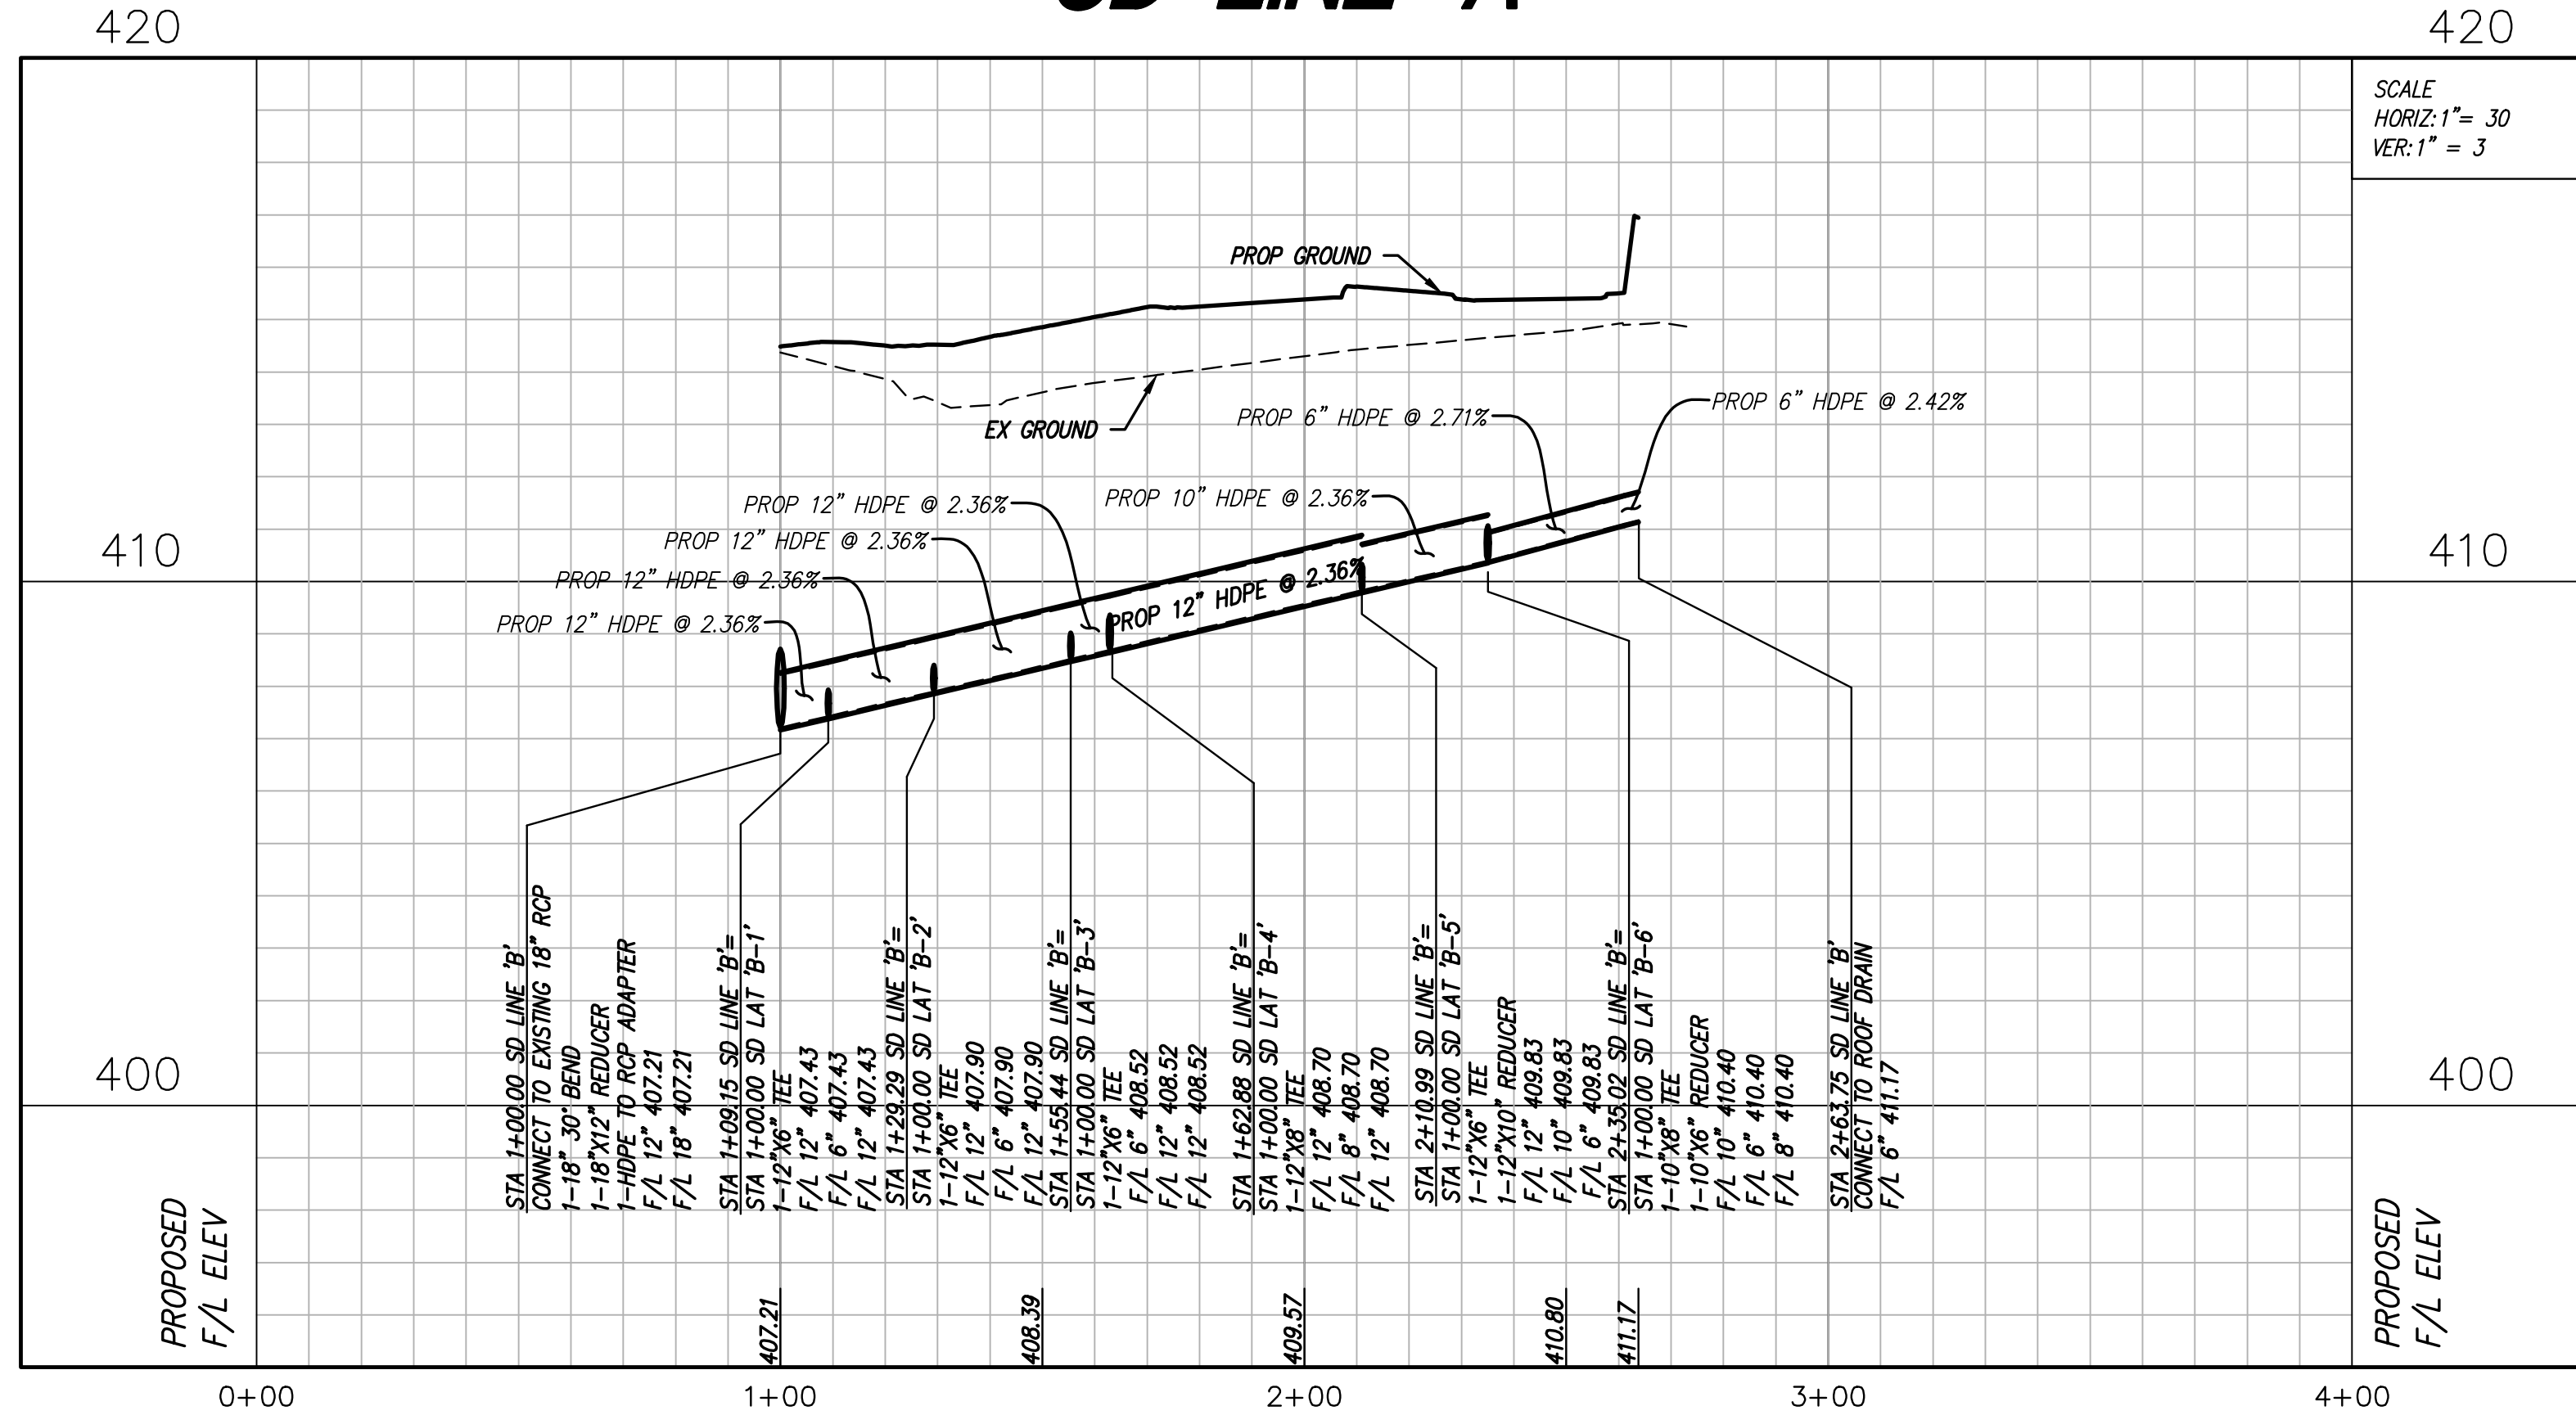

SD LINE 'B'

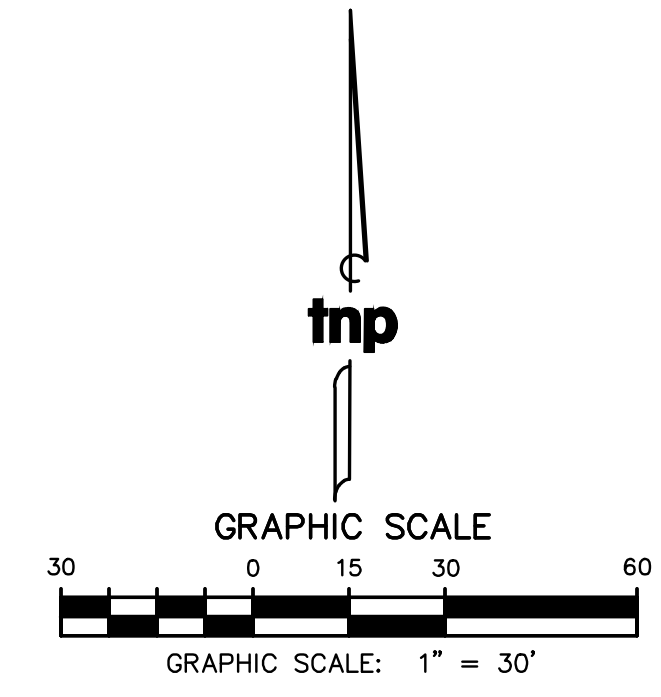


| | | |
|-----|-------------|----------|
| 1 | ADDENDUM 01 | 08/19/24 |
| no. | revision | by date |



scale
horiz 1"=30'
vert 1"=3'
date
AUG 2024






teague nall and perkins, inc
825 Walters Creek Blvd., Suite M300
Allen, Texas 75013
214.461.9867 ph 214.461.9864 fx
www.tnpinc.com
TBPELS: ENGR F-230; SURV 10011660, 10011601, 10194381
OBPE: PFE007431; TBAE: BR 2673

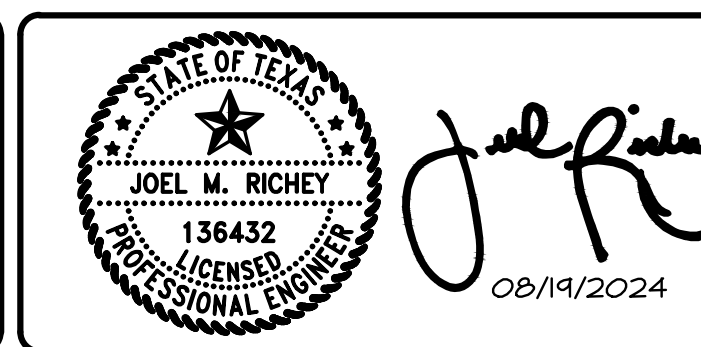

City of Crandall, Texas
Crandall Independent School District
High School - PAC Addition
STORM DRAIN PROFILES

tnp project
DLR23073
sheet
C1.09



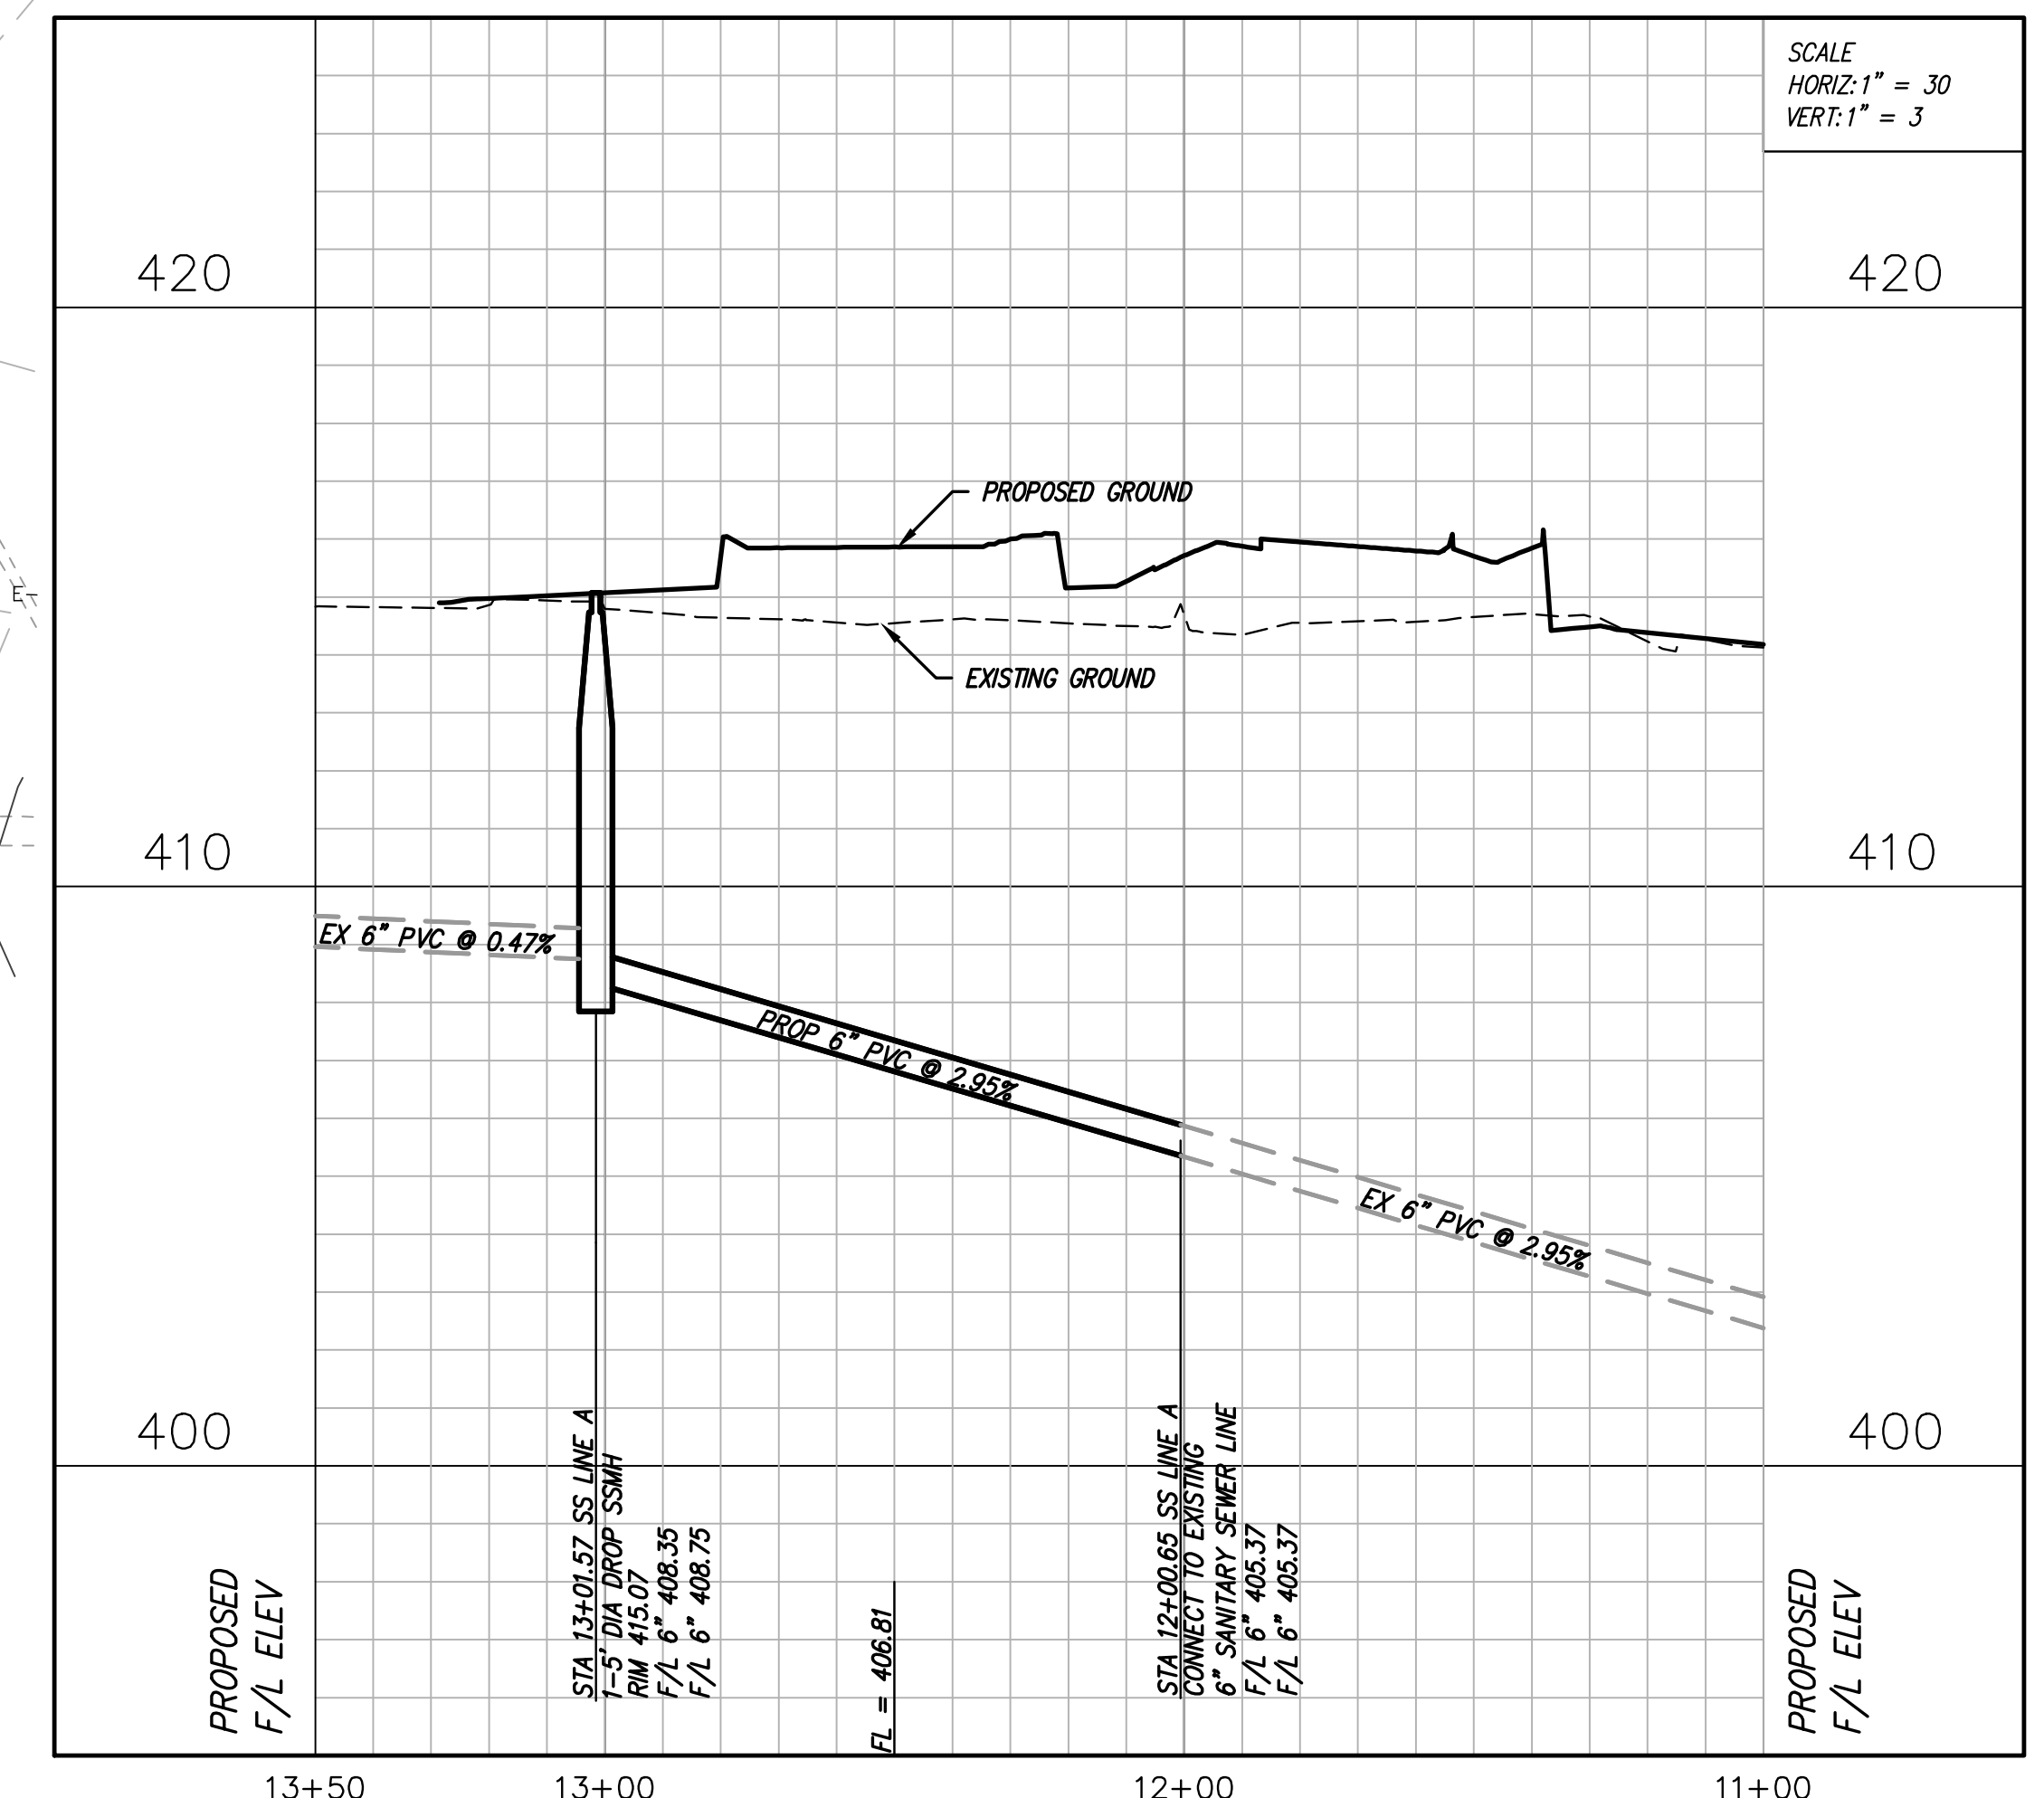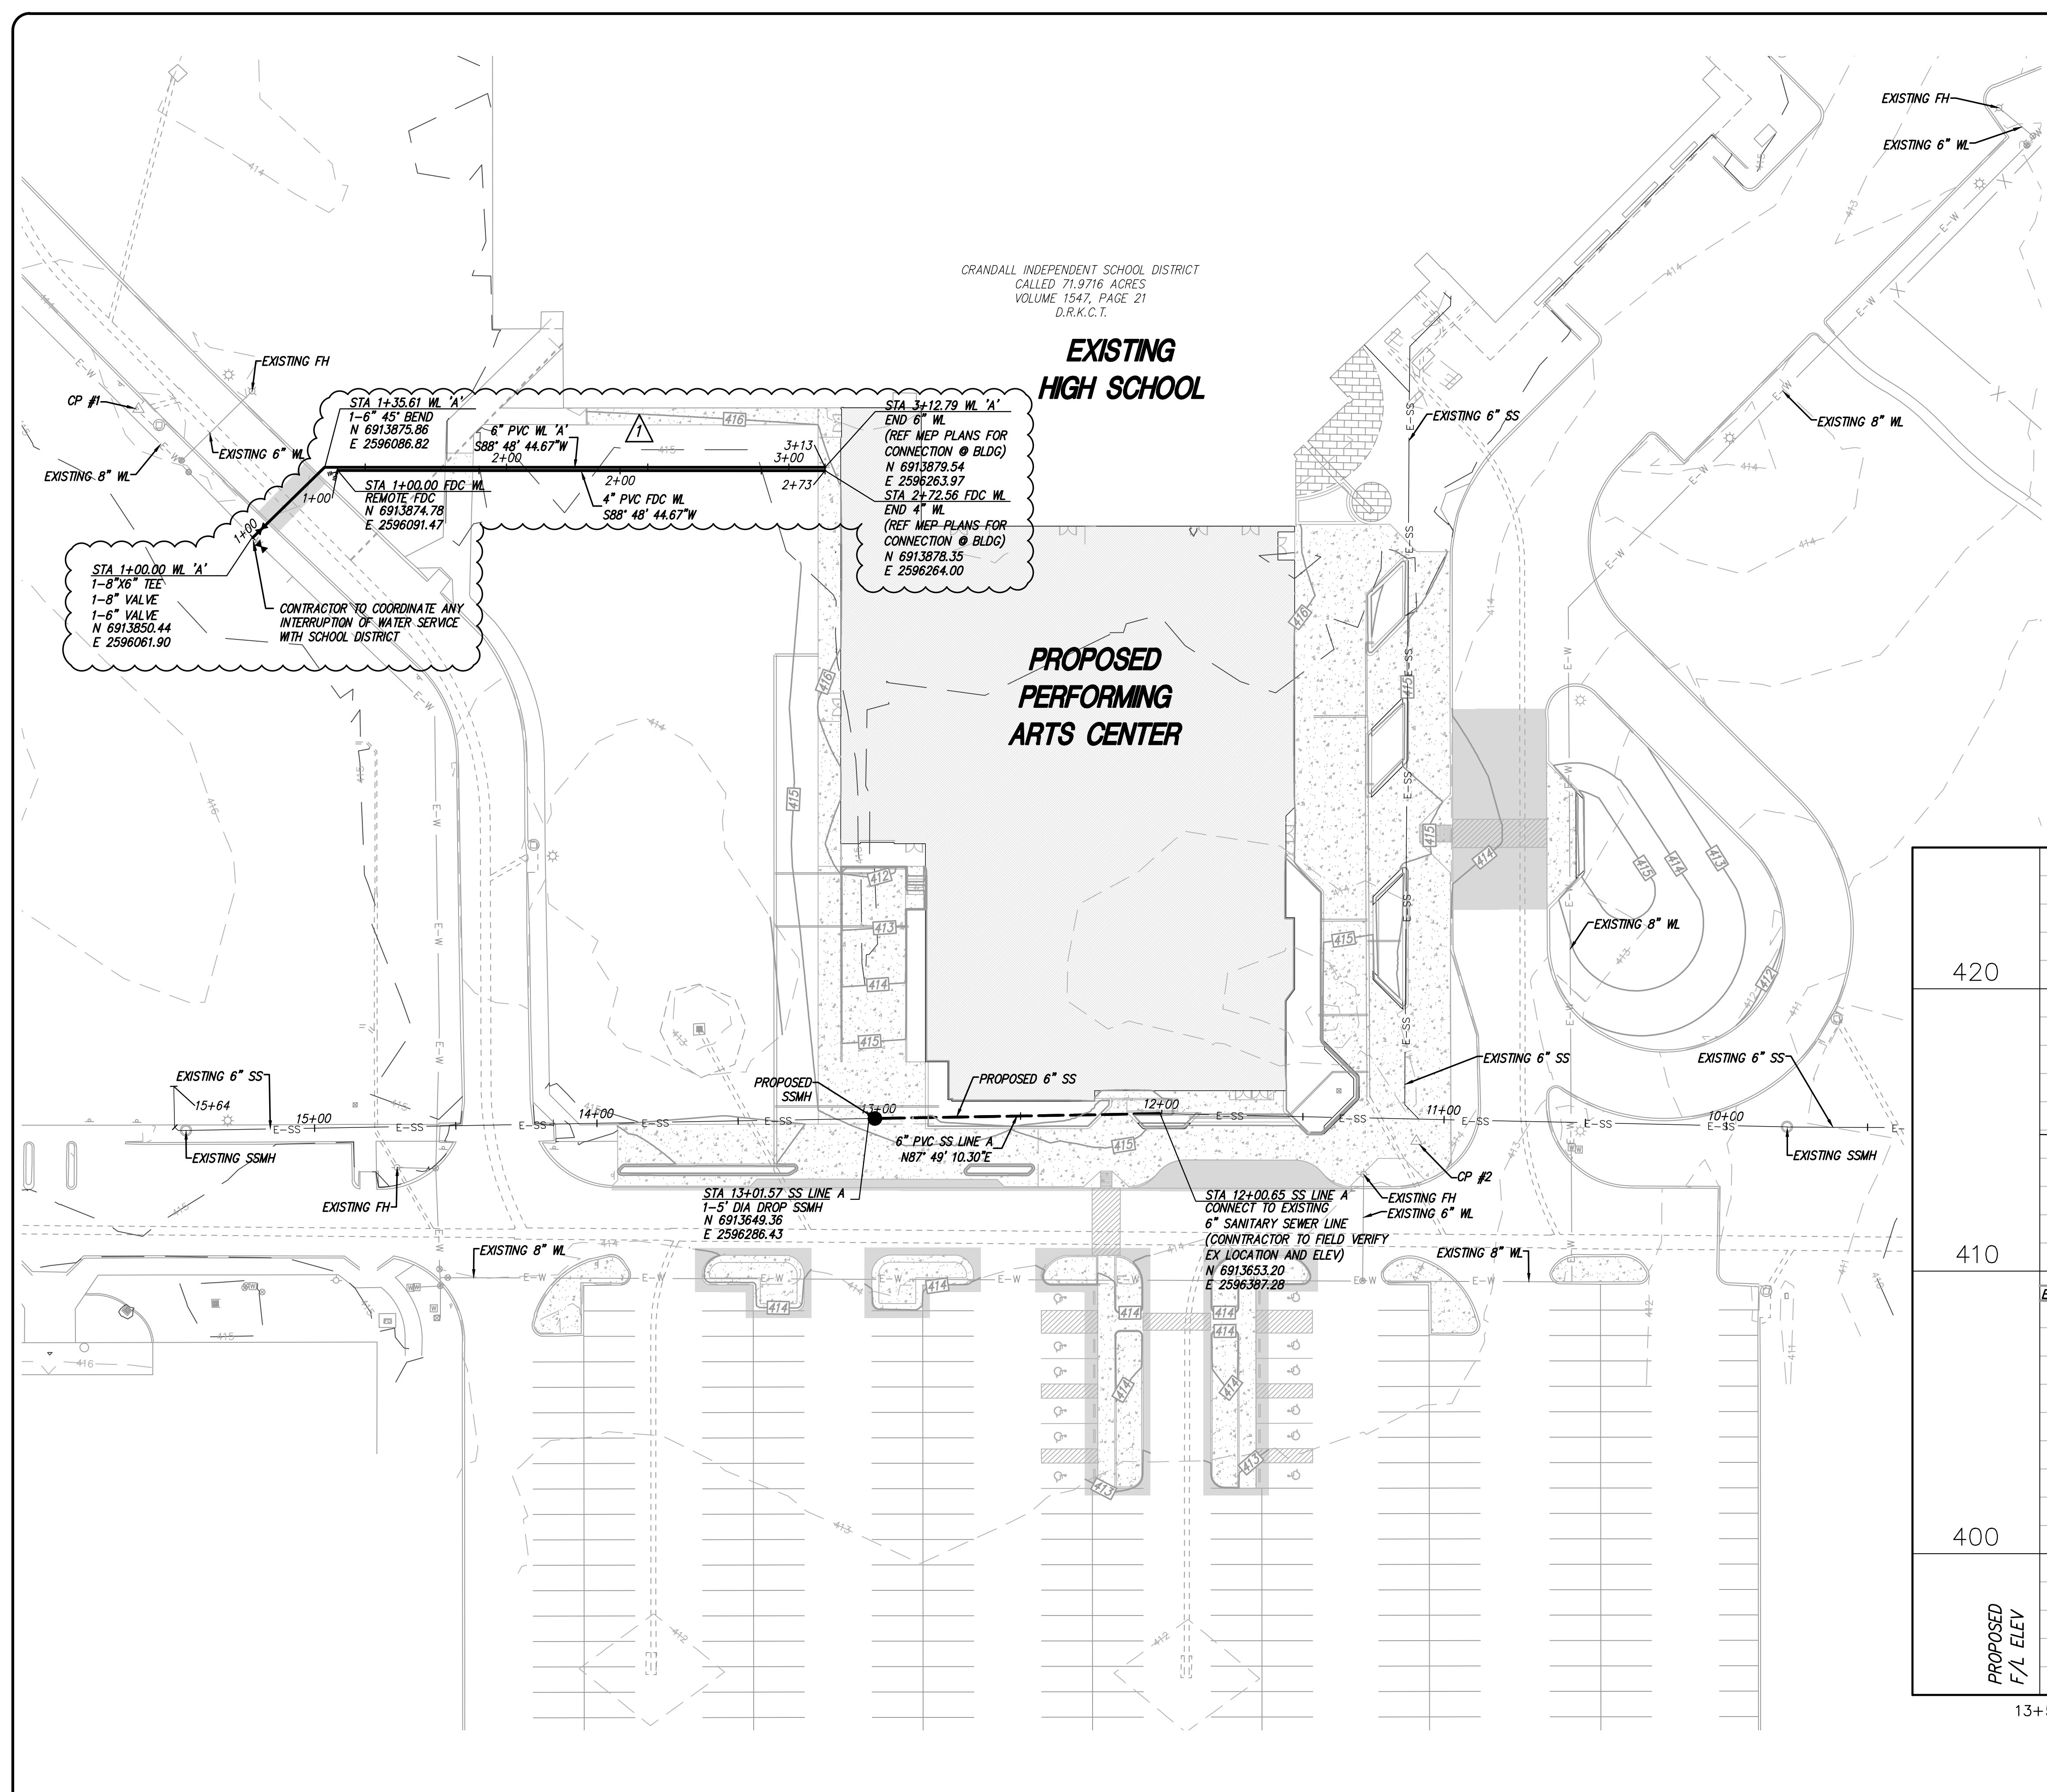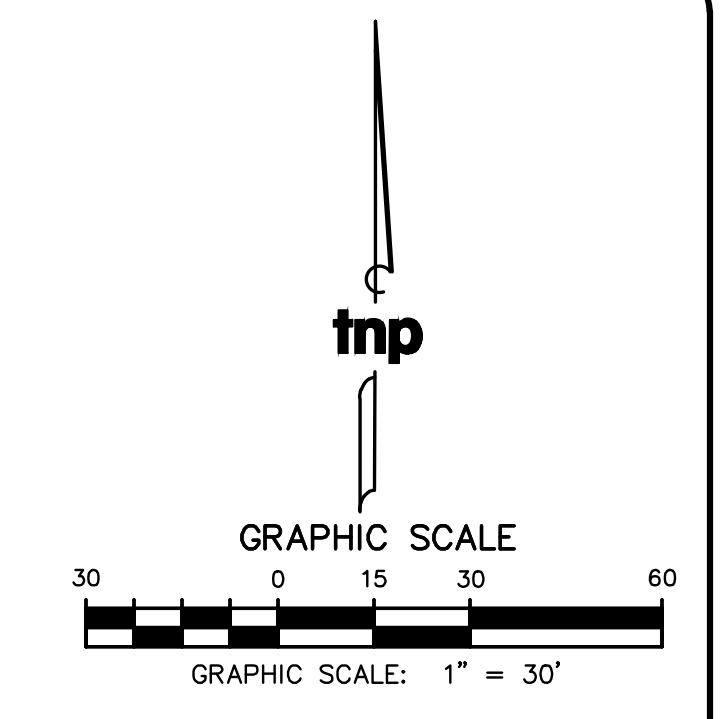


SS LINE A


| | | |
|-----|-------------|----------|
| 1 | ADDENDUM 01 | 08/19/24 |
| no. | revision | by date |

Crandall Independent School District

scale
horiz 1"=30'
vert 1"=3'
date
AUG 2024


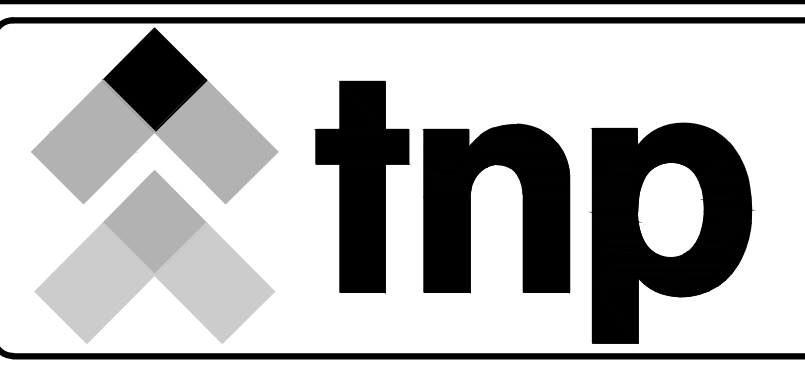


teague nall and perkins, inc
825 Walters Creek Blvd., Suite M300
Allen, Texas 75013
214.461.9867 ph 214.461.9864 fx
www.tnpsc.com
TBPELS: ENGR F-230; SURV 10011600, 10011601, 10194381
GPPE: PEFO07431; TBAE: BR 2673

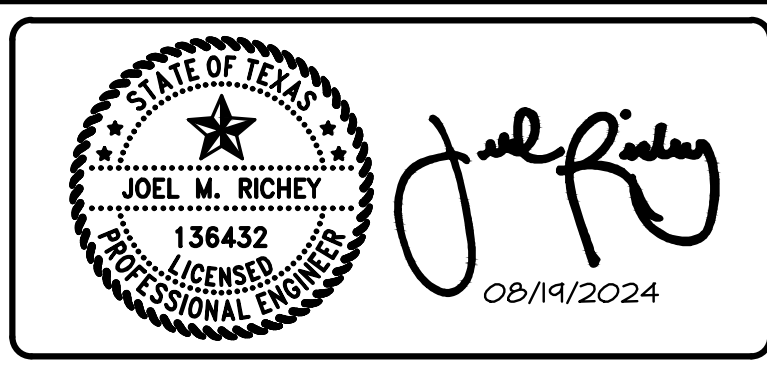

City of Crandall, Texas
Crandall Independent School District
High School - PAC Addition
SANITARY SEWER & WATER PLAN

tnp project
DLR23073
sheet
C1.10

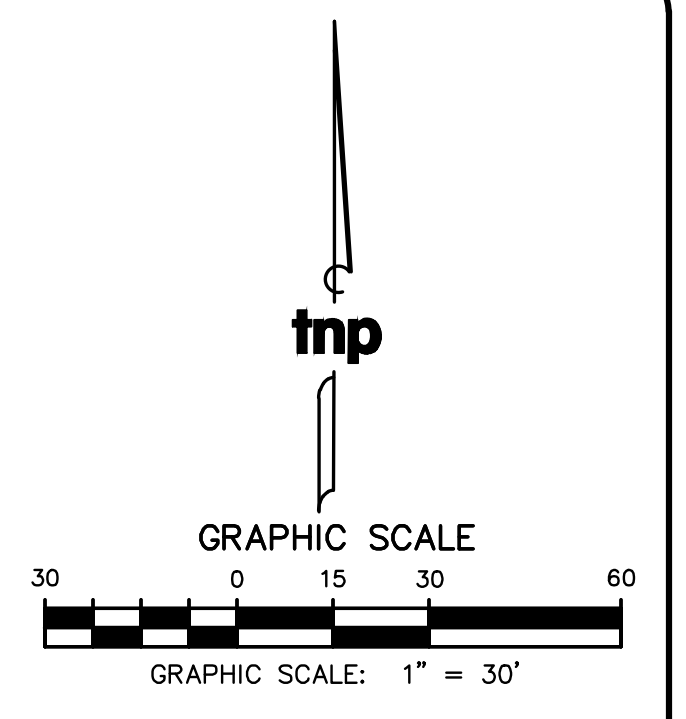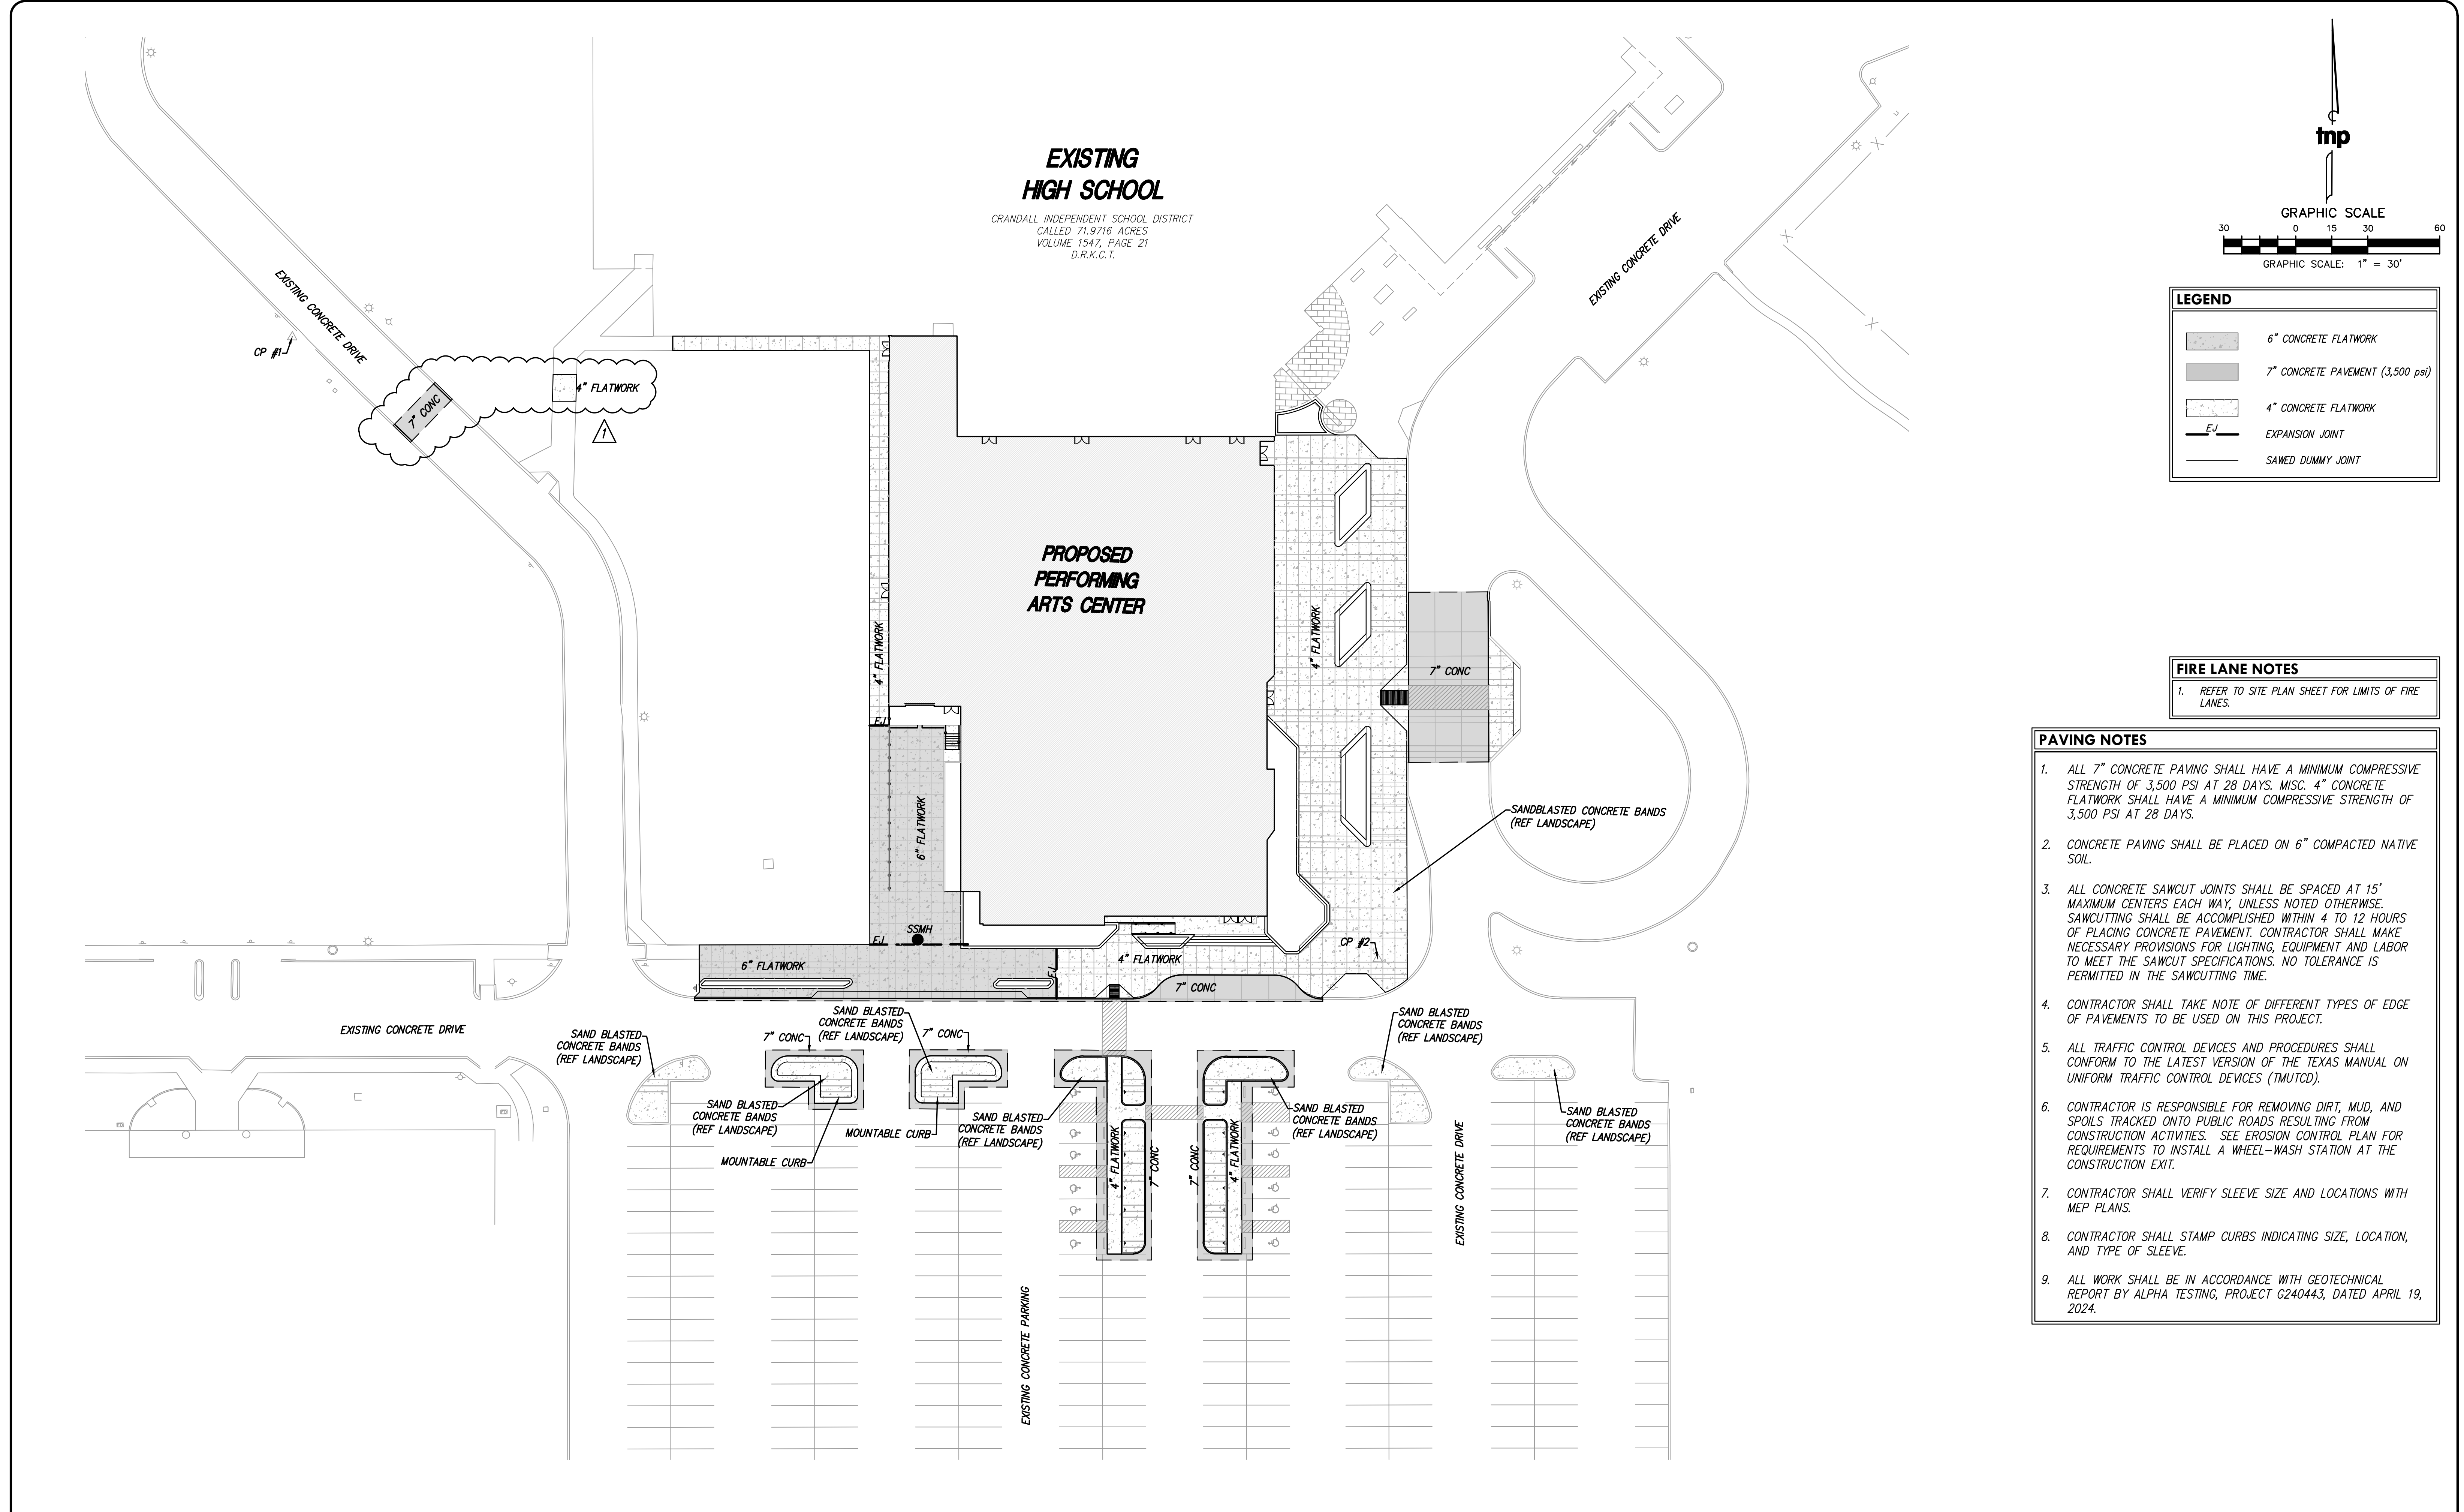


LEGEND

| | |
|--|----------------------------------|
| | 6" CONCRETE FLATWORK |
| | 7" CONCRETE PAVEMENT (3,500 psi) |
| | 4" CONCRETE FLATWORK |
| | EXPANSION JOINT |
| | SAWED DUMMY JOINT |


FIRE LANE NOTES
1. REFER TO SITE PLAN SHEET FOR LIMITS OF FIRE LANES.

- PAVING NOTES**
- ALL 7" CONCRETE PAVING SHALL HAVE A MINIMUM COMPRESSIVE STRENGTH OF 3,500 PSI AT 28 DAYS. MISC. 4" CONCRETE FLATWORK SHALL HAVE A MINIMUM COMPRESSIVE STRENGTH OF 3,500 PSI AT 28 DAYS.
 - CONCRETE PAVING SHALL BE PLACED ON 6" COMPACTED NATIVE SOIL.
 - ALL CONCRETE SAWCUT JOINTS SHALL BE SPACED AT 15' MAXIMUM CENTERS EACH WAY, UNLESS NOTED OTHERWISE. SAWCUTTING SHALL BE ACCOMPLISHED WITHIN 4 TO 12 HOURS OF PLACING CONCRETE PAVEMENT. CONTRACTOR SHALL MAKE NECESSARY PROVISIONS FOR LIGHTING, EQUIPMENT AND LABOR TO MEET THE SAWCUT SPECIFICATIONS. NO TOLERANCE IS PERMITTED IN THE SAWCUTTING TIME.
 - CONTRACTOR SHALL TAKE NOTE OF DIFFERENT TYPES OF EDGE OF PAVEMENTS TO BE USED ON THIS PROJECT.
 - ALL TRAFFIC CONTROL DEVICES AND PROCEDURES SHALL CONFORM TO THE LATEST VERSION OF THE TEXAS MANUAL ON UNIFORM TRAFFIC CONTROL DEVICES (TMUTCD).
 - CONTRACTOR IS RESPONSIBLE FOR REMOVING DIRT, MUD, AND SPOILS TRACKED ONTO PUBLIC ROADS RESULTING FROM CONSTRUCTION ACTIVITIES. SEE EROSION CONTROL PLAN FOR REQUIREMENTS TO INSTALL A WHEEL-WASH STATION AT THE CONSTRUCTION EXIT.
 - CONTRACTOR SHALL VERIFY SLEEVE SIZE AND LOCATIONS WITH MEP PLANS.
 - CONTRACTOR SHALL STAMP CURBS INDICATING SIZE, LOCATION, AND TYPE OF SLEEVE.
 - ALL WORK SHALL BE IN ACCORDANCE WITH GEOTECHNICAL REPORT BY ALPHA TESTING, PROJECT G240443, DATED APRIL 19, 2024.


| | | |
|-----|-------------|----------|
| 1 | ADDENDUM 01 | 08/19/24 |
| no. | revision | by date |

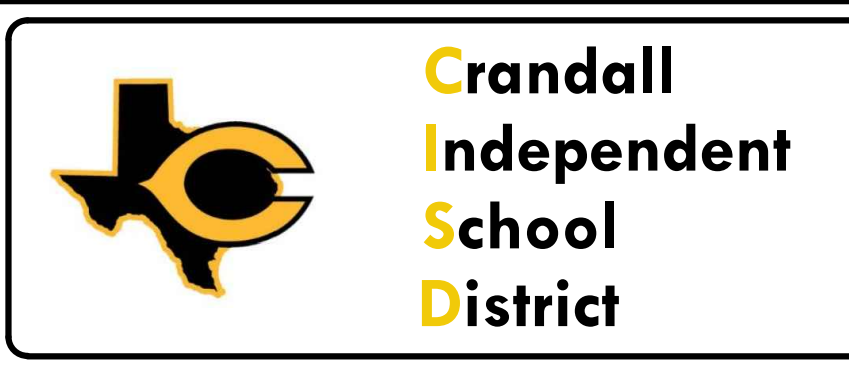

scale
horiz
1"=30'
vert
N/A
date
AUG 2024

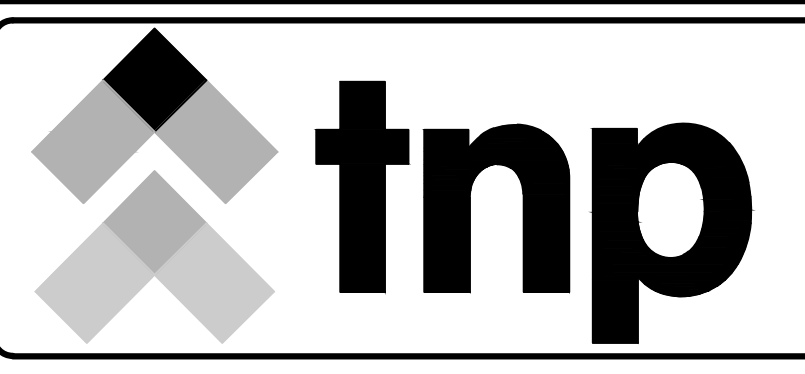


teague nall and perkins, inc
825 Walters Creek Blvd., Suite M300
Allen, Texas 75013
214.461.9867 ph 214.461.9864 fx
www.tnpsc.com
TBPELS: ENGR F-230; SURV 10011600, 10011601, 10194381
OBPE: PEF007431; TBAE: BR 2673

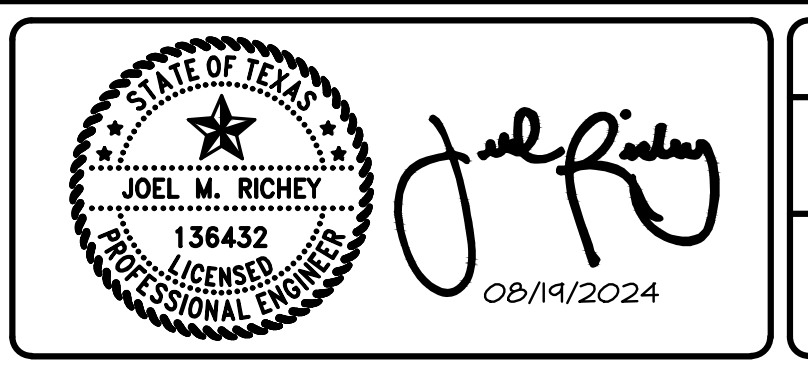

City of Crandall, Texas
Crandall Independent School District
High School - PAC Addition
PAVING PLAN


tnp project
DLR23073
sheet
C1.11

NOTE:
THRUST BLOCKS AT TRENCH FACE MUST HAVE A MINIMUM BEARING SURFACE OF 10 SQ. FEET AND THE LEAST DIMENSION SHALL BE NO SMALLER THAN 1.5 TIME PIPE DIAMETER, BUT NOT LESS THAN 10 FT. ALL CONCRETE SHALL BE MINIMUM 55K, 3000 PSI

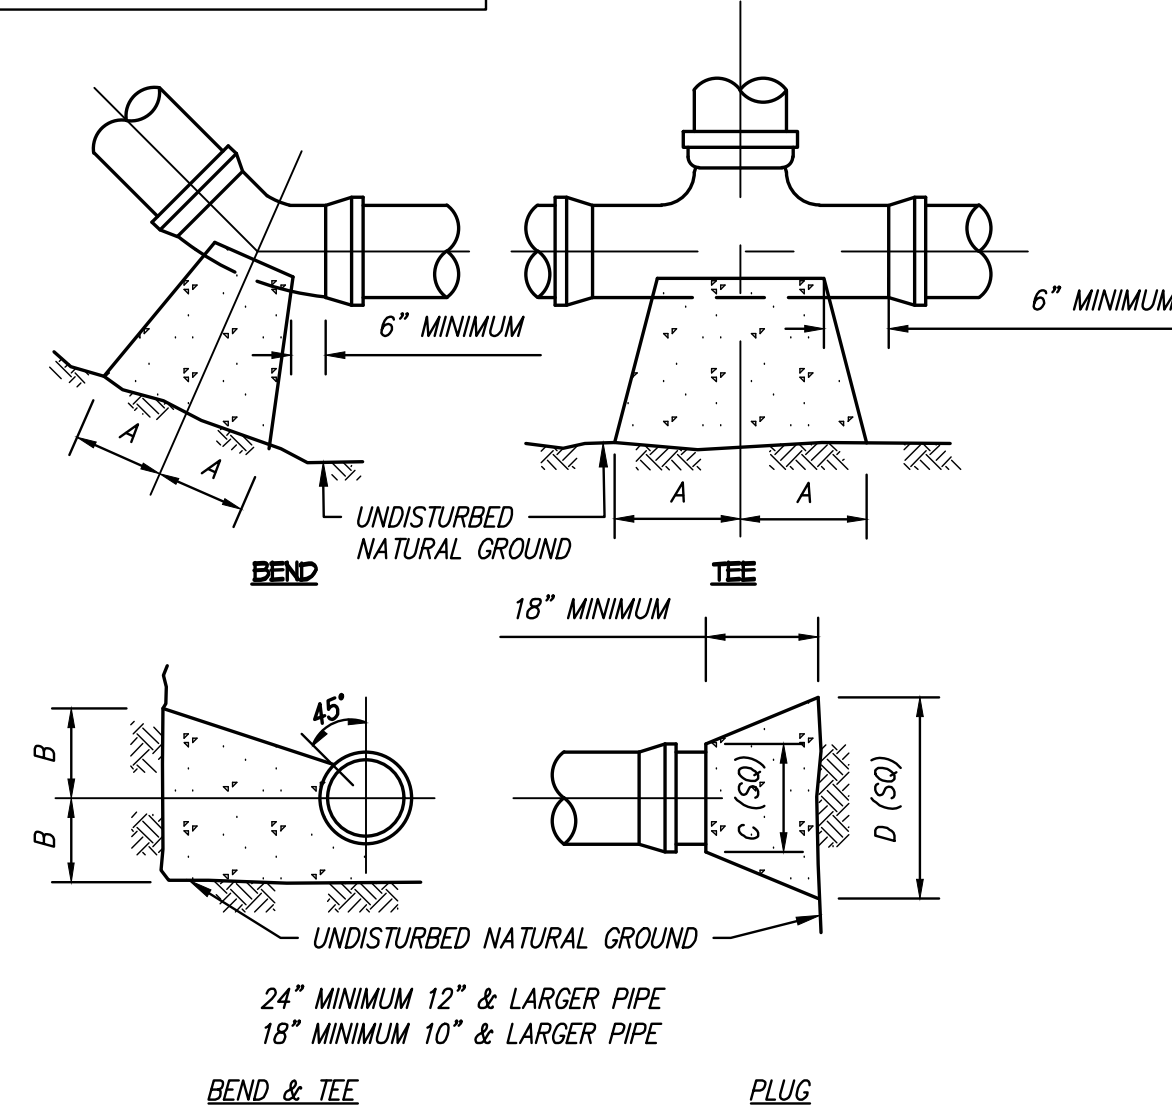


| SIZE | 90° BEND | | 45° BEND | | 22 1/2° BEND | | TEES | | PLUGS | |
|--------|----------|-----|----------|-----|--------------|-----|------|-----|-------|-----|
| | A | B | A | B | A | B | A | B | A | B |
| 2 1/2" | 12" | 7" | 6" | 7" | 6" | 6" | 7" | 8" | 8" | 14" |
| 6" | 16" | 10" | 9" | 10" | 8" | 12" | 10" | 12" | 10" | 21" |
| 8" | 22" | 13" | 12" | 13" | 8" | 10" | 13" | 16" | 12" | 29" |
| 10" | 26" | 17" | 14" | 17" | 10" | 13" | 16" | 20" | 14" | 36" |
| 12" | 29" | 21" | 16" | 21" | 11" | 16" | 18" | 24" | 16" | 41" |
| 14" | 35" | 24" | 19" | 24" | 12" | 20" | 22" | 27" | 18" | 48" |
| 16" | 38" | 27" | 21" | 27" | 12" | 24" | 24" | 30" | 20" | 54" |

THRUST BLOCK DETAIL
NOT TO SCALE

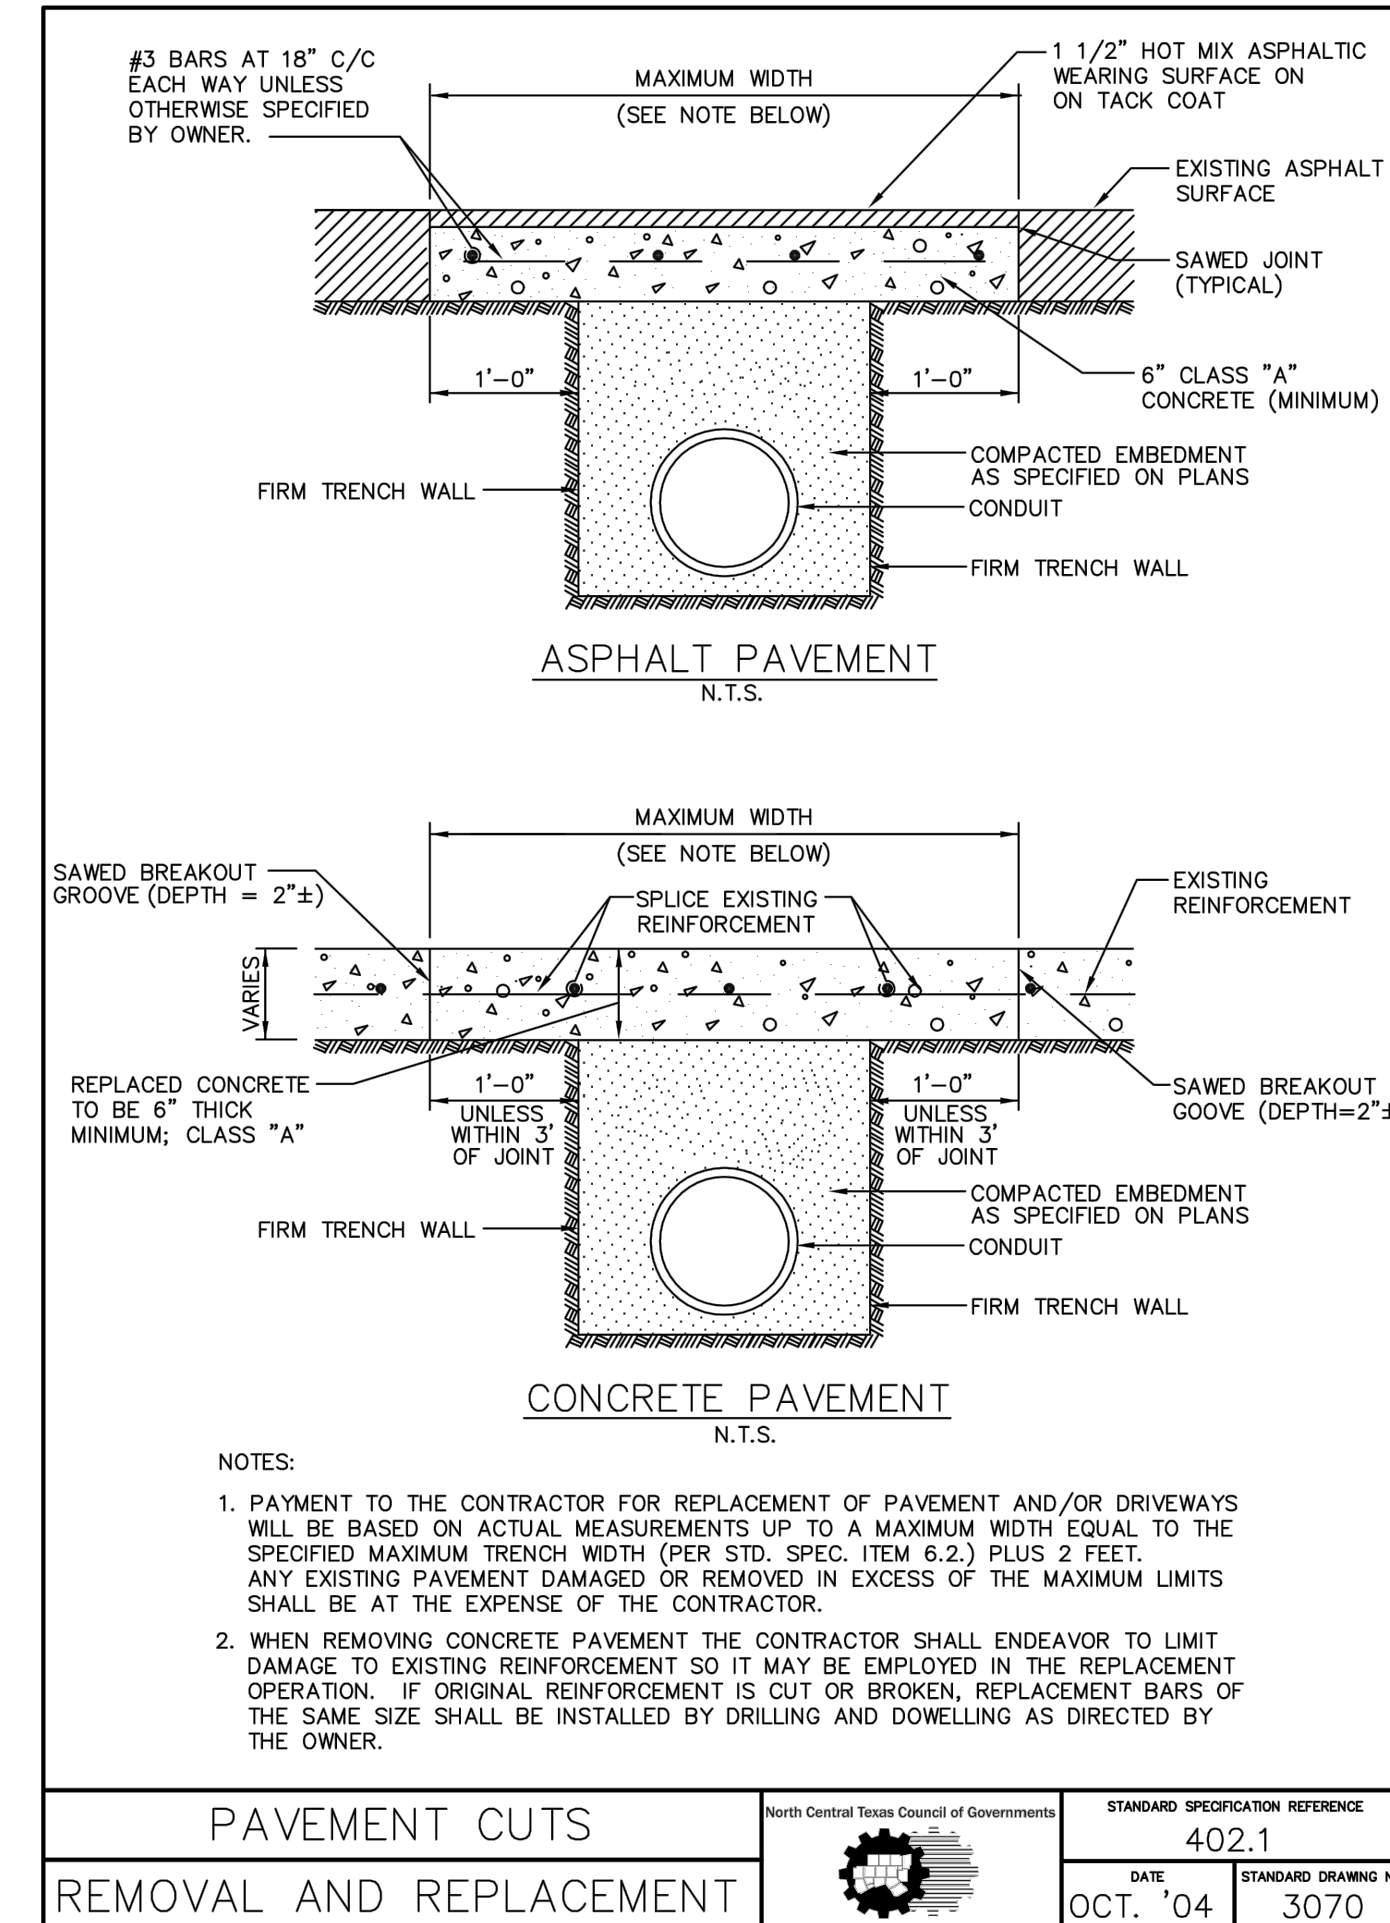

| PAVEMENT CUTS | North Central Texas Council of Governments | STANDARD SPECIFICATION REFERENCE |
|-------------------------|--|----------------------------------|
| REMOVAL AND REPLACEMENT | | 402.1 |
| | DATE | STANDARD DRAWING NO. |
| | OCT. '04 | 3070 |

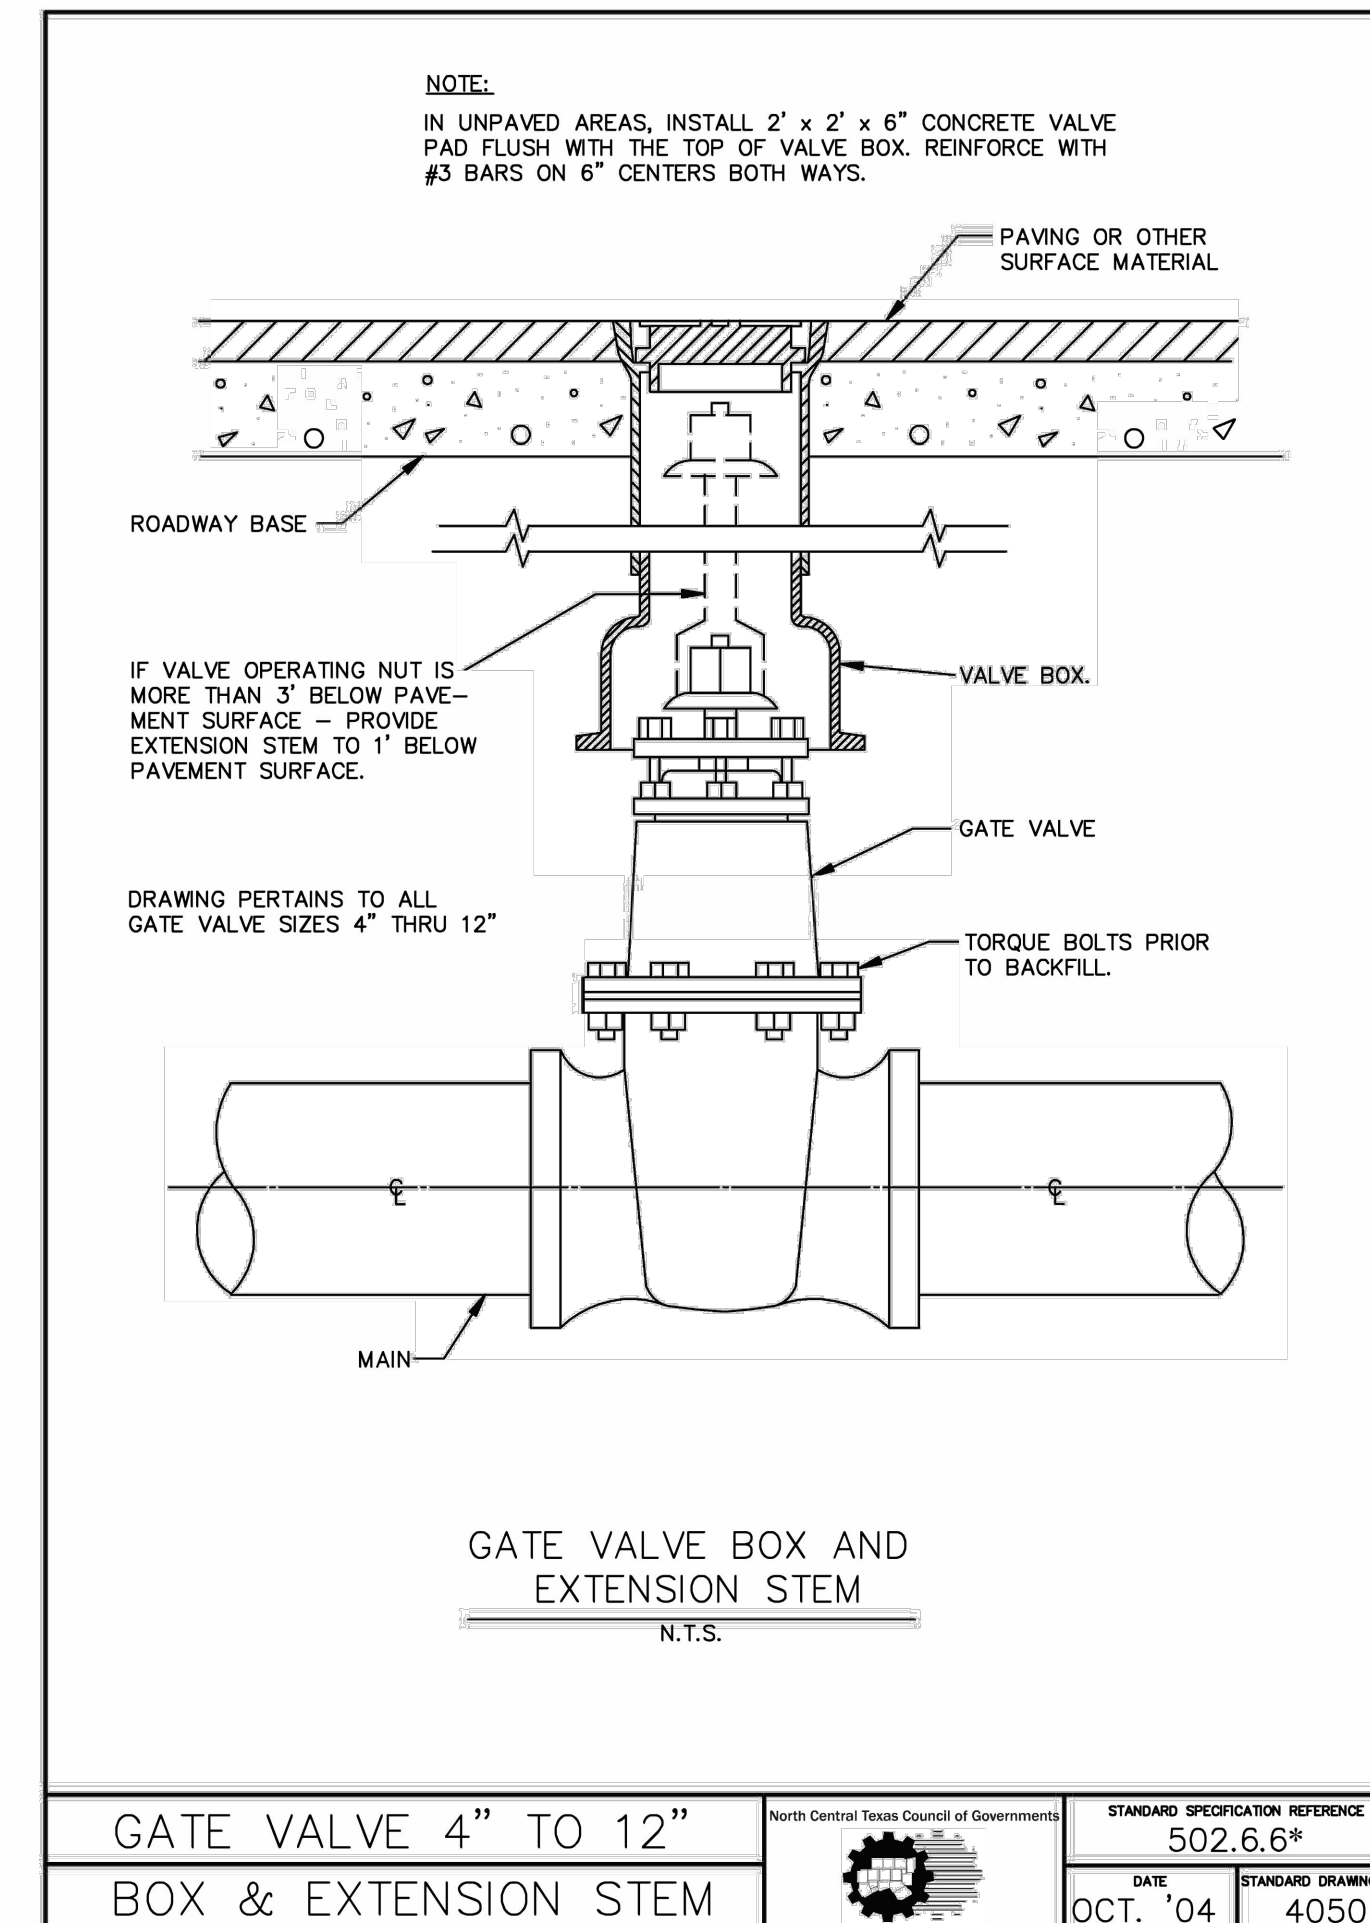

| GATE VALVE 4" TO 12" | North Central Texas Council of Governments | STANDARD SPECIFICATION REFERENCE |
|----------------------|--|----------------------------------|
| BOX & EXTENSION STEM | | 502.6.6* |
| | DATE | STANDARD DRAWING NO. |
| | OCT. '04 | 4050 |

*Section II Standard Drawings as of October 2004. Reference number only has been updated for Fifth Edition Specifications, Public Works Construction Standards North Central Texas, Fifth Edition.


| no. | revision | by | date |
|-----|-------------|----|----------|
| 1 | ADDENDUM 01 | | 08/19/24 |



| scale |
|------------------|
| horiz N/A |
| vert N/A |
| date AUG 2024 |




teague nall and perkins, inc
825 Walters Creek Blvd., Suite M300
Allen, Texas 75013
214.461.9867 ph 214.461.9864 fx
www.tnplnc.com
TBPELS: ENGR F-230; SURV 10011600, 10011601, 10194381
GPPE: PEF007431; TBAE: BR 2673

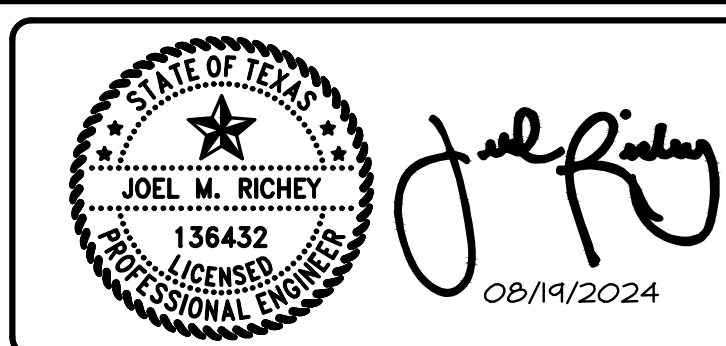

City of Crandall, Texas
Crandall Independent School District
High School - PAC Addition
WATER DETAILS

tnp project
DLR23073
sheet
C1.18



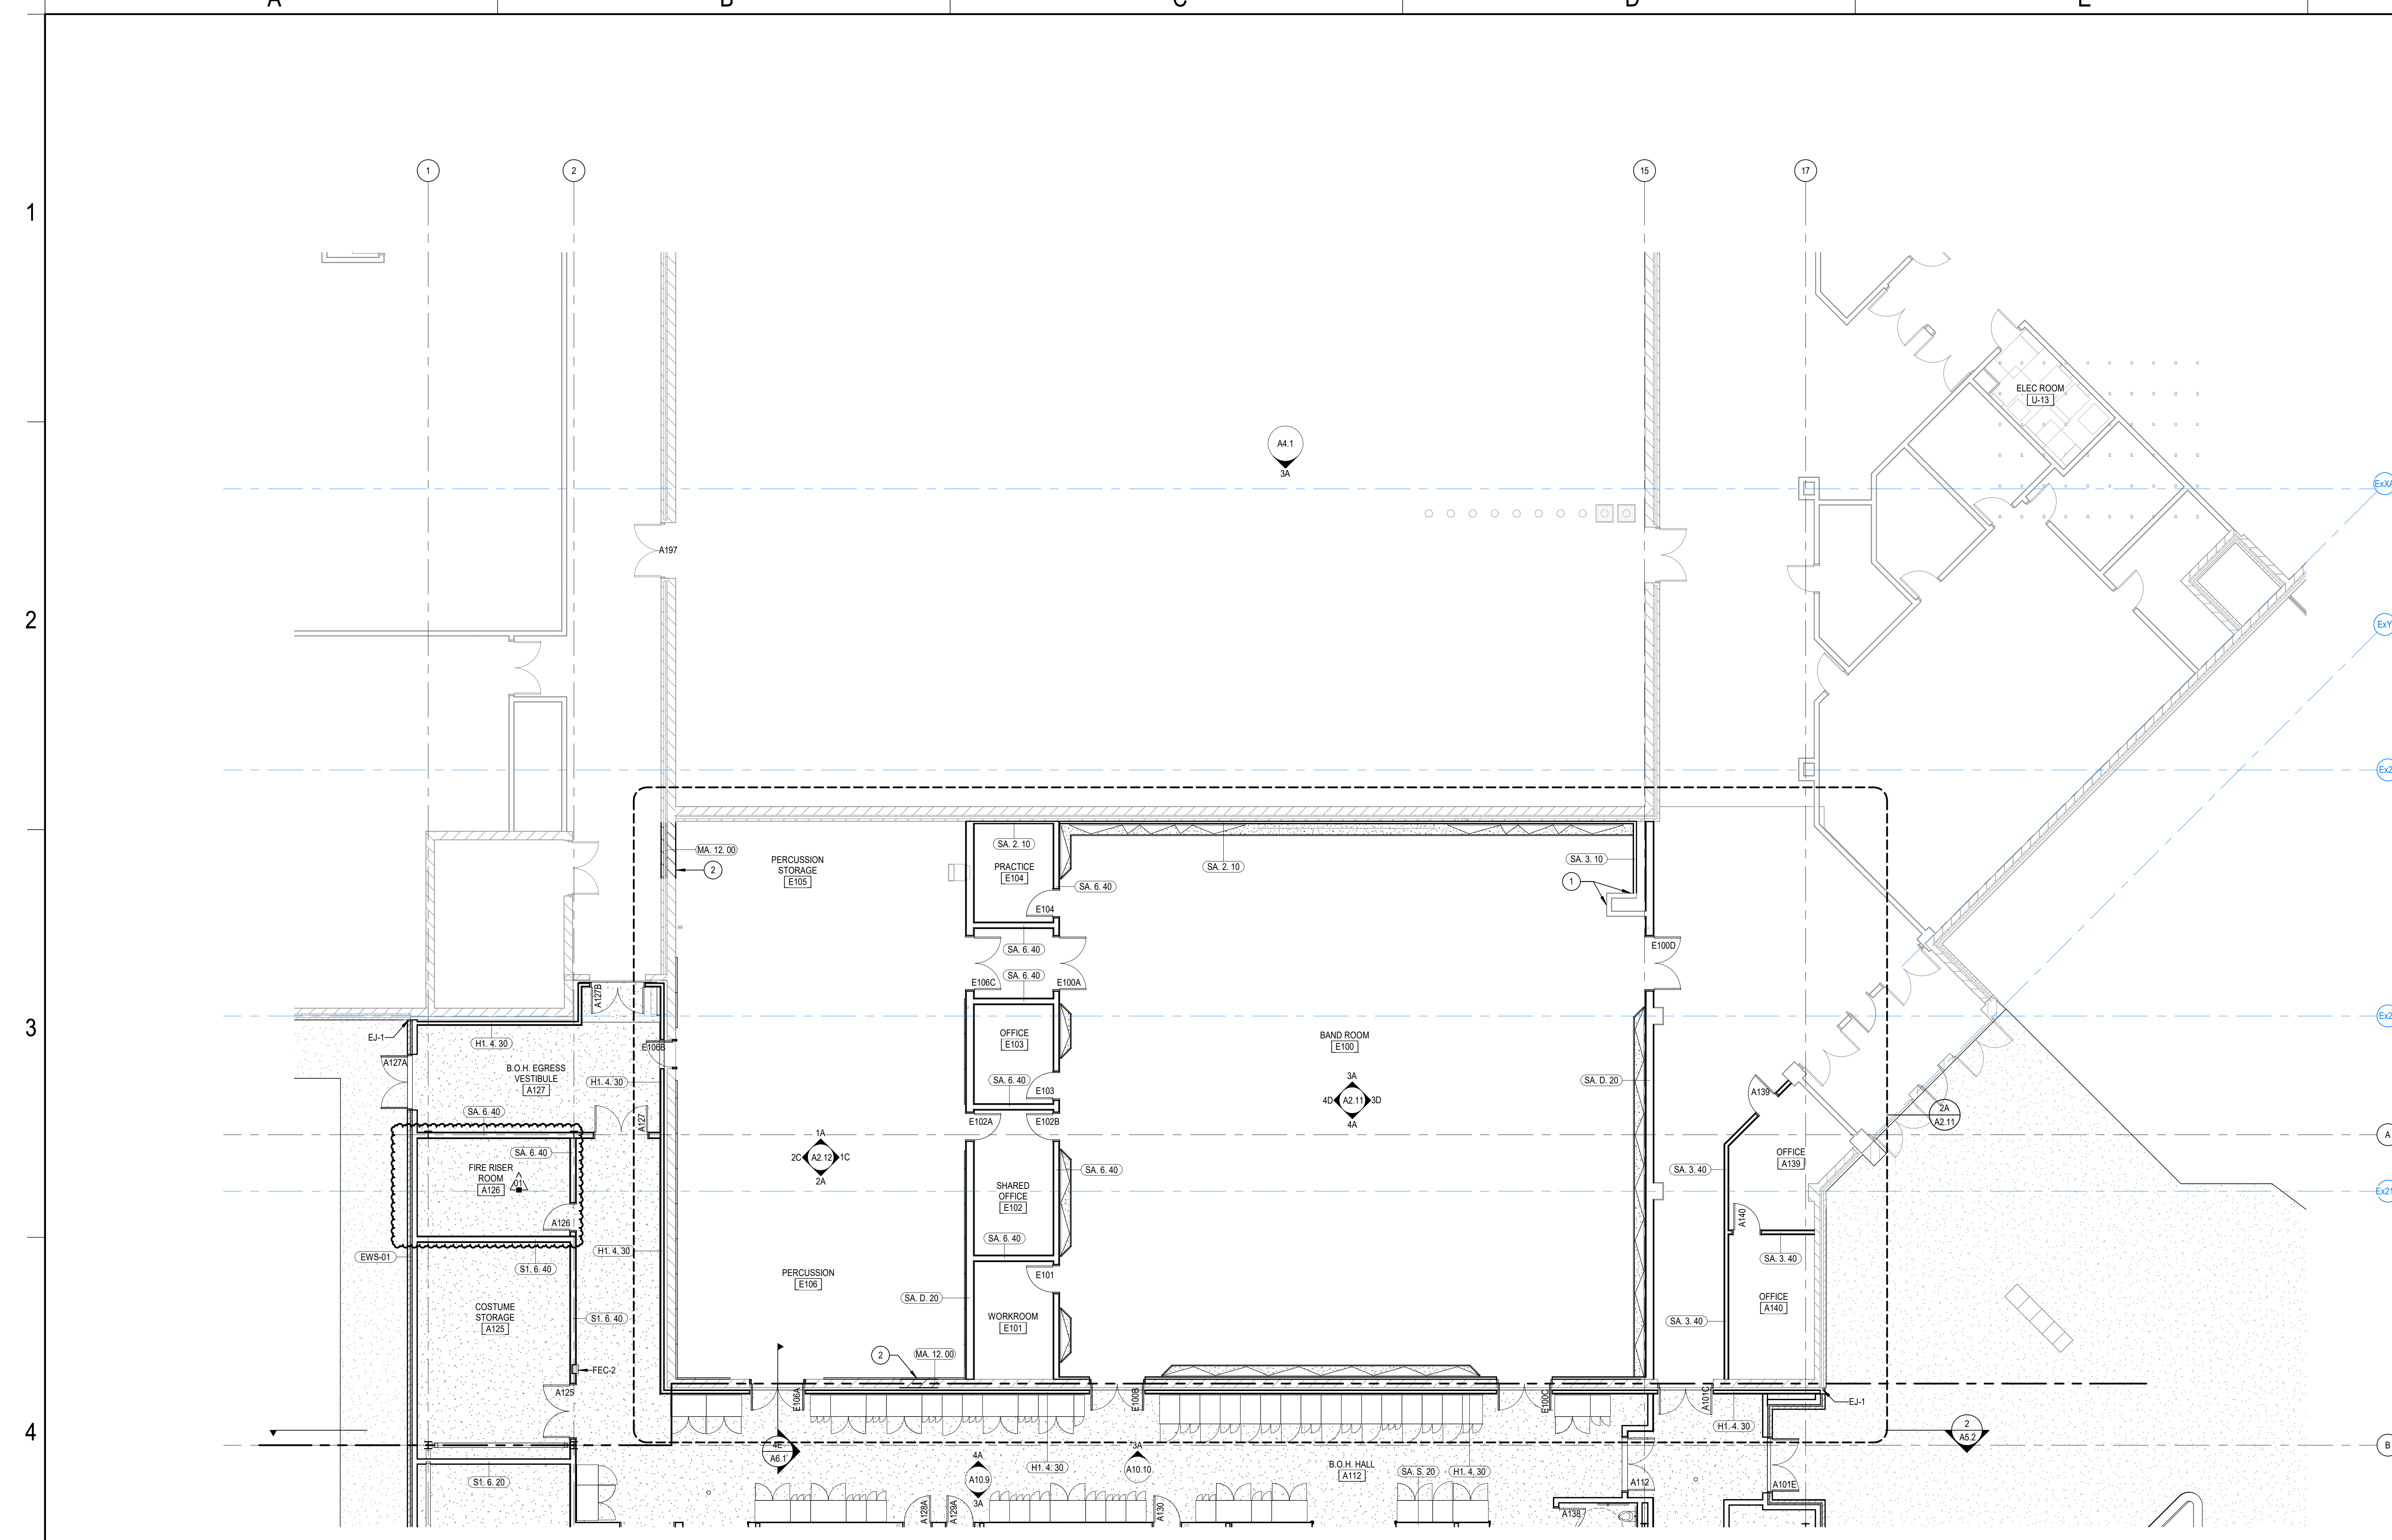

LEVEL 01 - AREA B - FLOOR PLAN
SCALE: 1/8" = 1'-0"

GENERAL ARCHITECTURAL NOTES

- PARTITION TYPES SHALL BE DESIGNATED ON FLOOR PLANS (XX X XX) THUS SEE SHEET A8.3 FOR TYPES. ALL INTERIOR PARTITIONS ARE TYPE SA.3.20 UNLESS NOTED OTHERWISE.
- ALL MASONRY WALLS AND INTERIOR STUD WALLS SHALL EXTEND TO UNDERSIDE OF FLOOR OR ROOF DECK ABOVE UNLESS NOTED OTHERWISE, PER PARTITION TYPE.
- PROVISIONS SHALL BE MADE AT ALL FULL HEIGHT NON-BEARING WALLS FOR 1-INCH VERTICAL MOVEMENT OF THE BUILDING STRUCTURE WITHOUT TRANSFER OF COMPRESSIVE LOADS TO WALL. FILL IRREGULARITIES BETWEEN TOP OF WALL AND DECK ABOVE WITH MINERAL WOOL INSULATION OR FIRE STOPPING MATERIALS AS REQUIRED TO MEET FIRE RATING OF RESPECTIVE WALLS. SEE DETAILS ON SHEET XX.X.
- SEE STRUCTURAL DRAWINGS FOR BRACING OF NON-LOAD BEARING MASONRY WALLS.
- FURNISH AND INSTALL FIRE-TREATED WOOD BLOCKING OR METAL BACKING PLATE IN METAL STUD PARTITIONS FOR THE PROPER ANCHORAGE OF ALL WALL ATTACHED ITEMS, I.E. TOILET ACCESSORIES, CASEWORK, MILLWORK, WALL-MOUNTED FIXTURES, MARKER BOARDS, TACK BOARDS, DOOR STOPS, AUDIO VISUAL BRACKETS, AND OTHER WALL ATTACHED ITEMS.
- GYPSUM BOARD SURFACES SHALL BE ISOLATED WITH CONTROL JOINTS WHERE SHOWN ON DRAWINGS AND AS DESCRIBED IN THE SPECIFICATIONS.
- MASONRY CONTROL JOINTS (CJ) AND CONTROL JOINTS ABOVE (CAJ) SHALL BE LOCATED AS SHOWN ON THE FLOOR PLAN AND BUILDING ELEVATIONS, AND WHERE LARGE PLUMBING VENTS OR RISERS OCCUR IN SINGLE WYTHE MASONRY WALLS, AND WHERE MASONRY WALLS BEARING ON THE CONCRETE FLOOR SLAB ABUT MASONRY WALLS BEARING ON CONCRETE FOOTINGS OR AS INDICATED ON DRAWINGS.
- EXTEND FURRING CHANNELS AND GYPSUM BOARD UP 4 INCHES ABOVE FINISHED CEILING ON CMU WALLS.
- SCRIBE GYPSUM WALL BOARD OF WALLS AND PARTITIONS TO IRREGULARITIES OF DECK ABOVE. SEAL TIGHTLY AROUND ALL PENETRATIONS.



REFERENCE KEYNOTES

- EJ-1 EXPANSION JOINT TYPE 1
- FEC-2 FIRE EXTINGUISHER CABINET RECESSED

SHEET NOTES

- EXISTING WALL COVERING IN-WALL UTILITIES TO REMAIN, NEW WALLS TO TIE IN.
- EXISTING WALL INFILL.

KEY PLAN

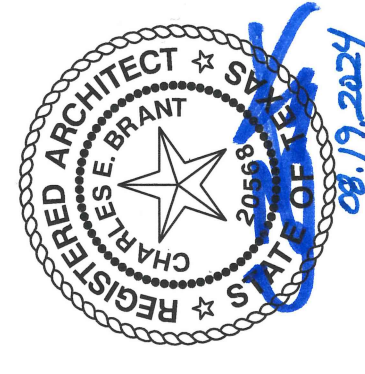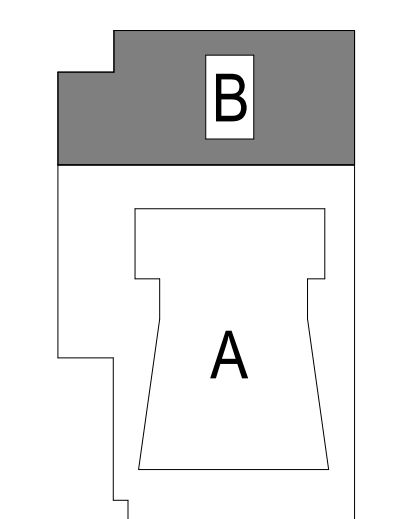

CRANDALL ISD HIGH SCHOOL
PAC ADDITION
13385 Fm 3039, Crandall, TX 75114

ISSUE FOR BID AND PERMIT
2024.07.25
REVISIONS
01 08/19/24 ADDENDUM 01


39-23712-00
LEVEL 01 - AREA B - FLOOR PLAN

A1.1B

Autodesk Docs://99-23712-00 Crandall ISD - PAC/39-23712-00 Crandall ISD_AR_2024.rvt
18/20/2024 1:25:21 PM

Autodesk Docs://99-23712-00_Crandall ISD - PAC/39-23712-00_Crandall ISD - PAC/2024.rvt
8/9/2024 7:52:00 PM

1
2
3
4
5

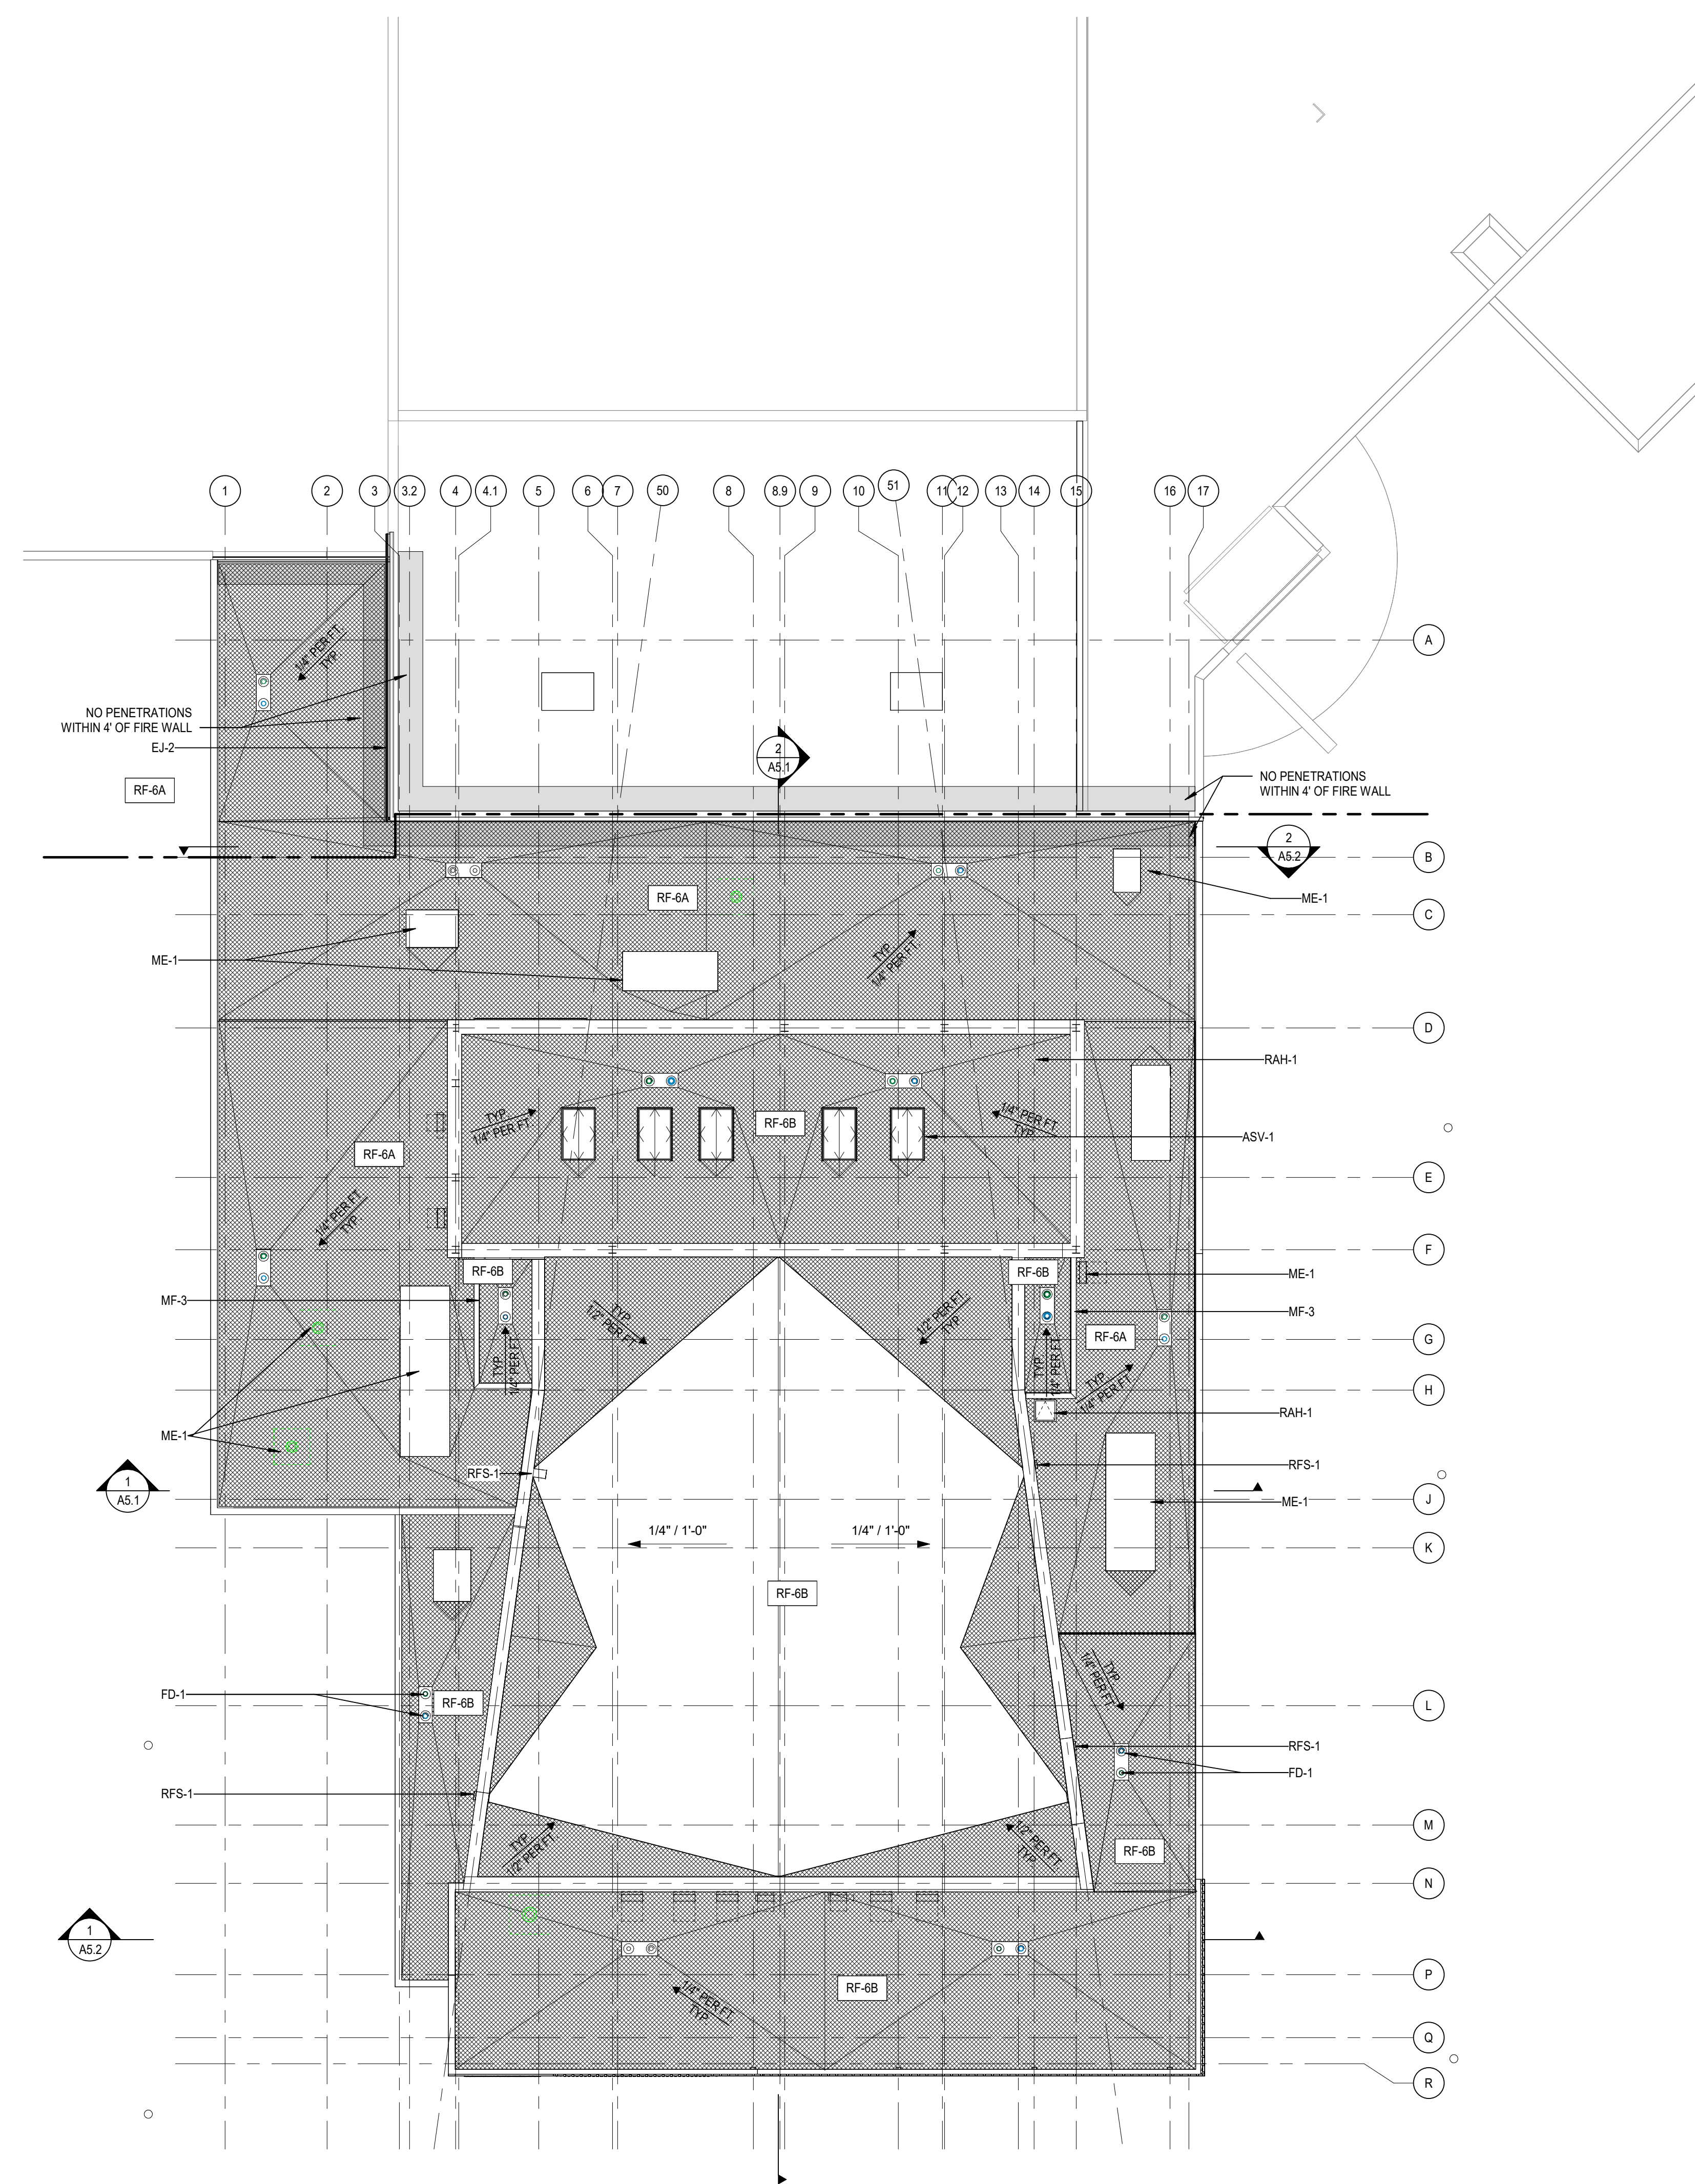

OVERALL ROOF PLAN
SCALE: 1/16" = 1'-0"

STAGEHOUSE SMOKE VENT INFORMATION:

- STAGE AREA 3,308 SF
- 5% TOTAL AREA REQUIRED, .05 X 3508 SF = 175.4 SF PER IBC 410.2.7 ROOF VENTS
- 5 X 40 SF ROOF VENT OPENINGS = 200 SF TOTAL ROOF VENT OPENING


ROOF PLAN GENERAL NOTES

- ROOF PLAN GENERAL NOTES APPLY TO ALL ROOF PLAN SHEETS.
- ROOF SLOPES ARE CREATED BY SLOPING THE ROOF STRUCTURE UNLESS NOTED OTHERWISE. SEE STRUCTURAL DRAWINGS FOR ELEVATIONS OF THE HIGH AND LOW POINTS TO DETERMINE PROPER TAPER IN INSULATION.
- TAPERED INSULATION SHALL PROVIDE A MINIMUM OF 1/4-INCH PER FOOT OF SLOPE TO ROOF DRAINS, UNLESS NOTED OTHERWISE.
- AREAS MARKED WITH A HATCHED PATTERN INDICATE TAPERED INSULATION.
- ALL ROOF CURBS TO BE A MINIMUM OF 12 INCHES ABOVE ROOFING LEVELS. PROVIDE TAPERED INSULATION ROOF SADDLES AT ROOF CURBS TO PROVIDE DRAINAGE AROUND CURB.
- SEE STRUCTURAL DRAWINGS FOR FRAMING AROUND ROOF PENETRATIONS.
- COORDINATE THE SIZE AND LOCATION OF ROOF PENETRATIONS FOR MECHANICAL AND ELECTRICAL EQUIPMENT. REFER TO MECHANICAL AND ELECTRICAL DRAWINGS FOR PENETRATIONS NOT SHOWN ON THIS DRAWING.
- FLASH DRAINS, CURBS, VENTS AND STACKS PER MANUFACTURER'S RECOMMENDATIONS IF DETAIL NOT SHOWN ON DRAWINGS.
- NO ROOF PENETRATIONS ALLOWED WITHIN 4'-0" EACH SIDE OF FIREWALL. SEE CODE PLAN FOR FIRE WALL LOCATIONS.

REFERENCE KEYNOTES

- ASV-1 AUTOMATIC SMOKE VENT
- EJ-2 EXPANSION JOINT COVER TYPE 2
- FD-1 METAL ROOF DRAIN
- ME-1 MECHANICAL EQUIPMENT
- MF-3 PREFINISHED SHEET METAL PARAPET CAP W/ CONT CLEAT
- RAH-1 ROOF ACCESS HATCH
- RFS-1 ROOF SCUPPER

KEY PLAN

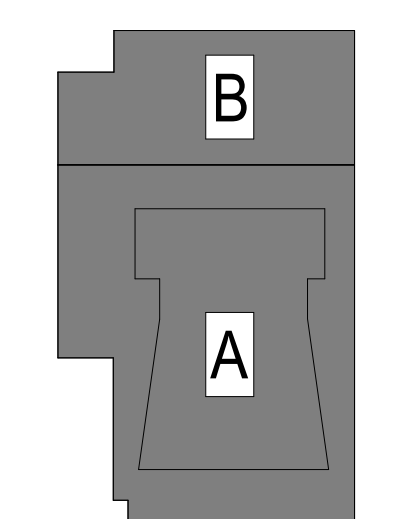


CRANDALL ISD HIGH SCHOOL
PAC ADDITION
13385 Fm 3038, Crandall, TX 75114

ISSUE FOR BID AND PERMIT
2024.07.25
REVISIONS
01 08/19/24 ADDENDUM 01

39-23712-00
OVERALL ROOF PLAN

A1.4

Autodesk Docs://99-23712-00_Crandall ISD - PAC/39-23712-00_Crandall ISD - AR_2024.rvt
8/9/2024 7:52:21 PM

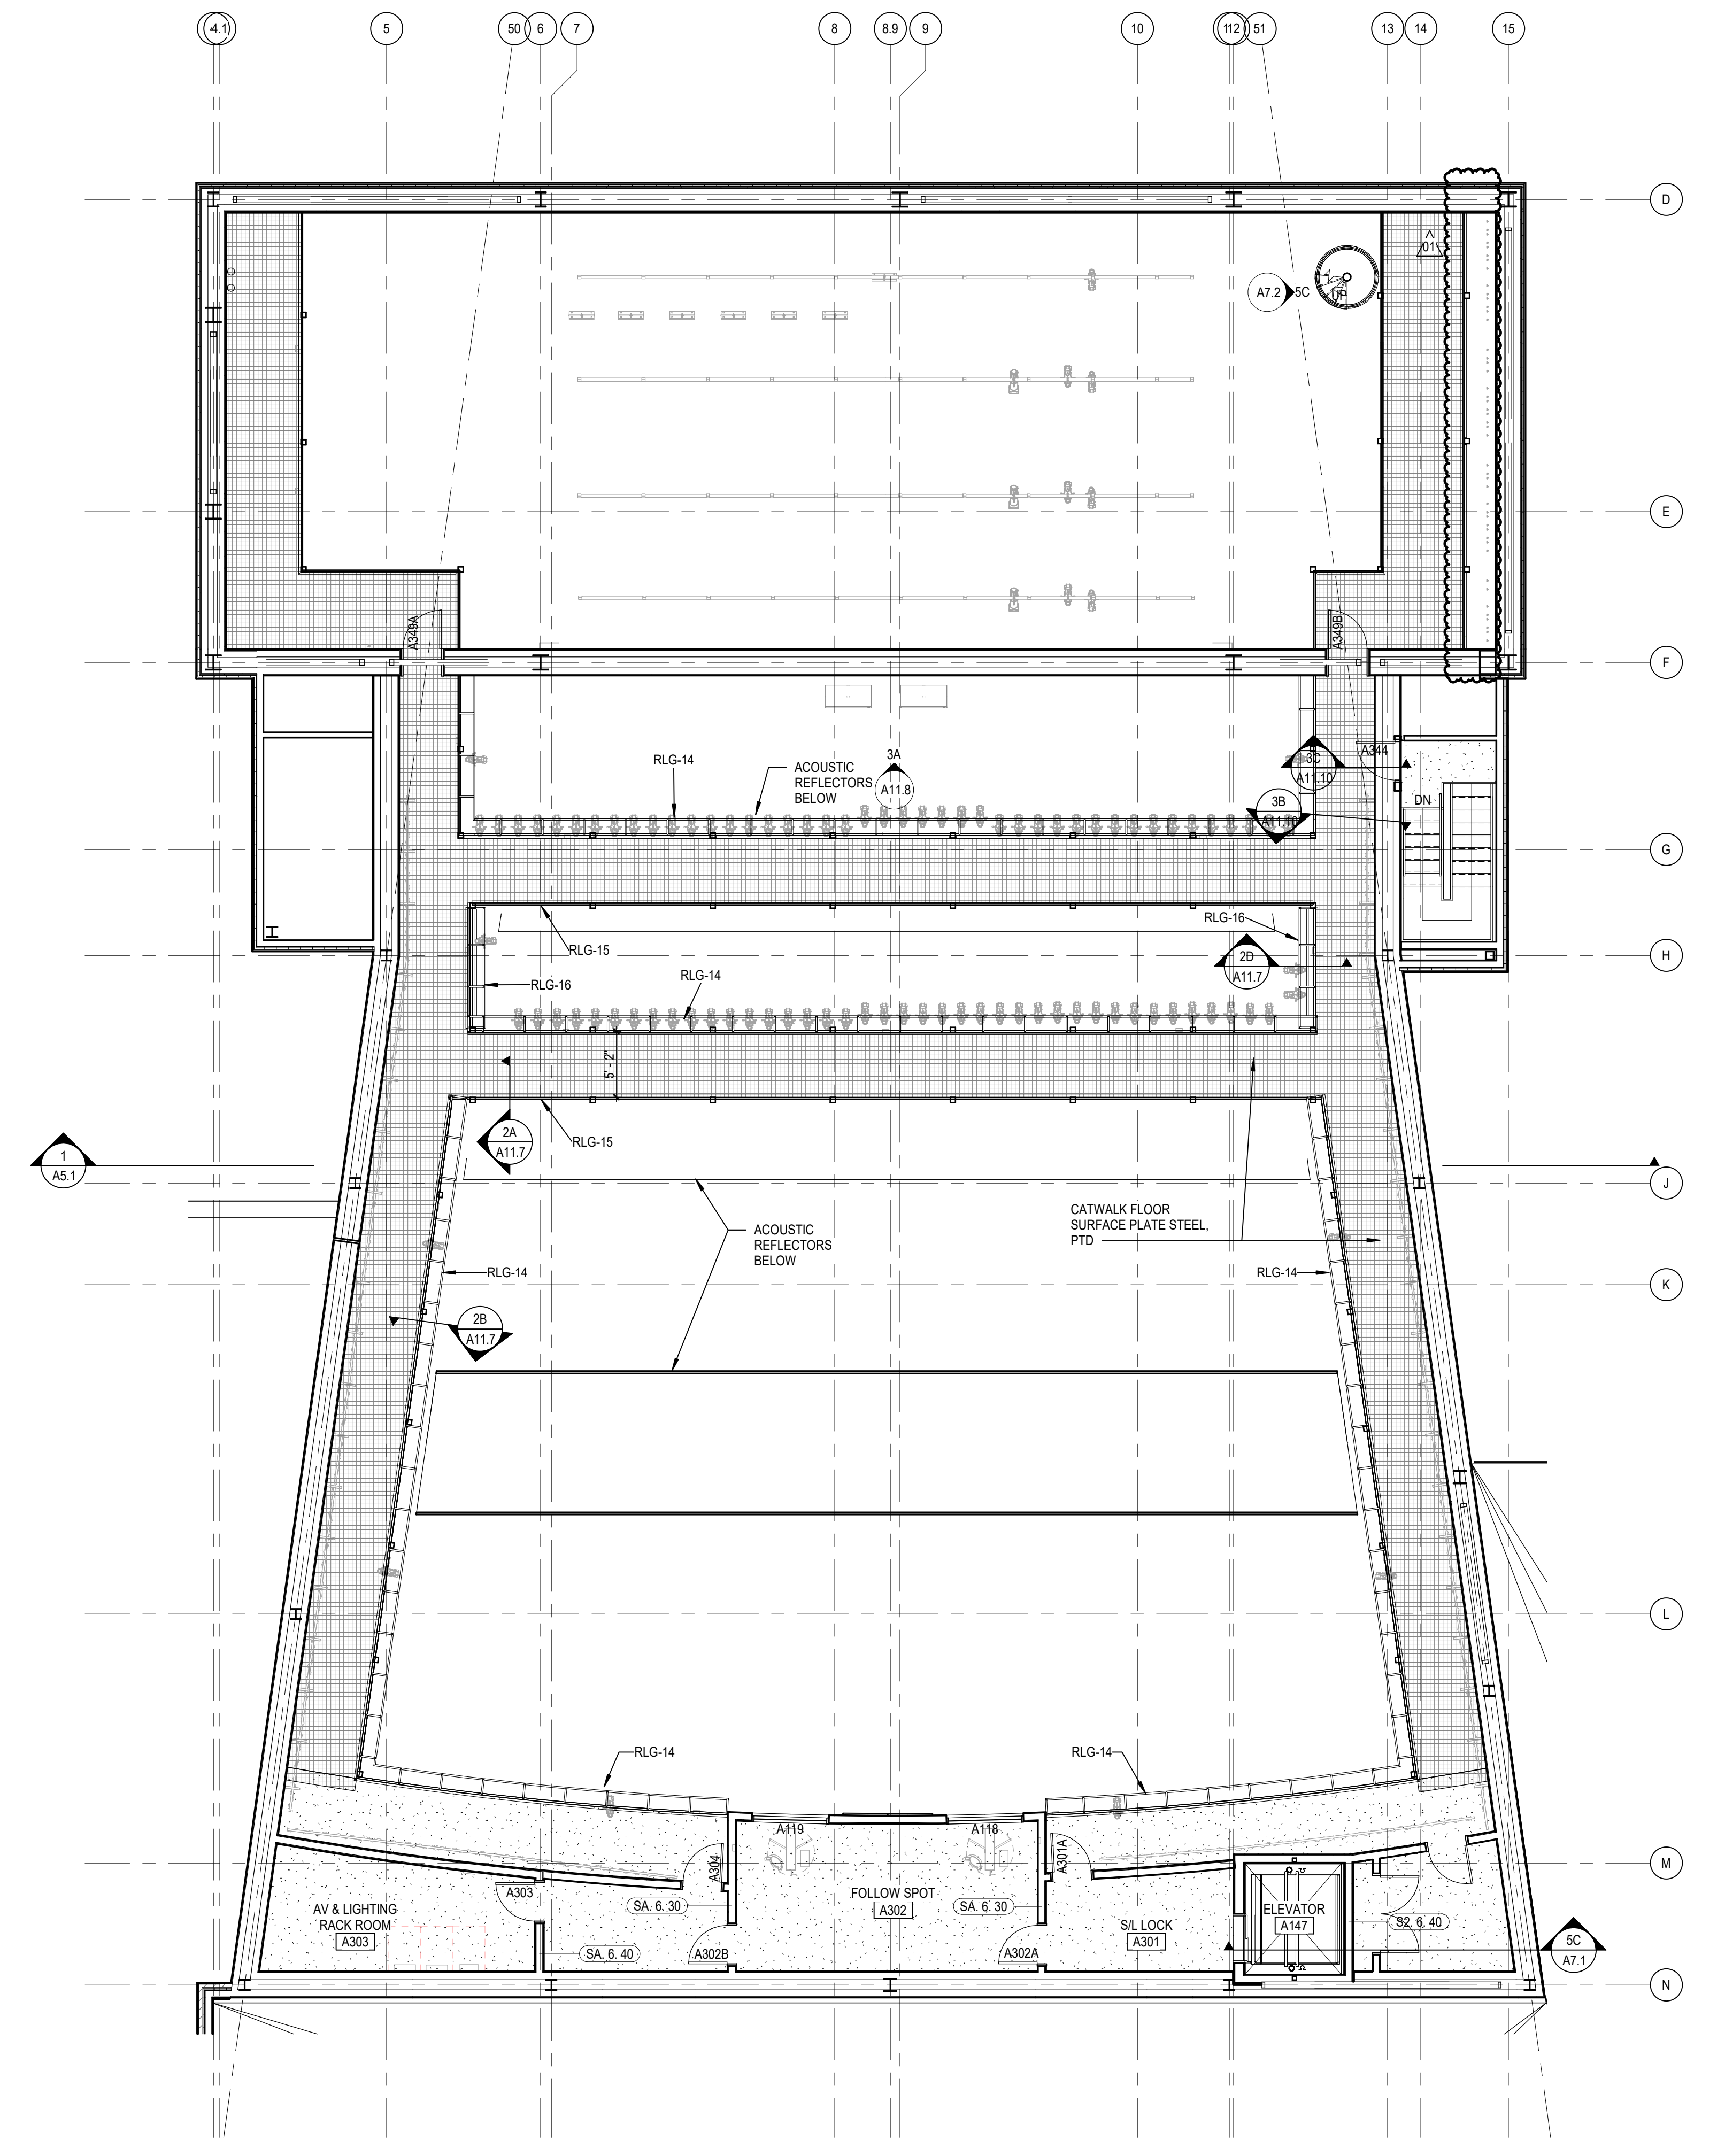

LEVEL 03 - AREA A - FLOOR PLAN
SCALE: 1/8" = 1'-0"

GENERAL ARCHITECTURAL NOTES

1. PARTITION TYPES SHALL BE DESIGNATED ON FLOOR PLANS (XX X XX) THIS SEE SHEET A8.3 FOR TYPES. ALL INTERIOR PARTITIONS ARE TYPE SA.3.20 UNLESS NOTED OTHERWISE.
2. ALL MASONRY WALLS AND INTERIOR STUD WALLS SHALL EXTEND TO UNDERSIDE OF FLOOR OR ROOF DECK ABOVE UNLESS NOTED OTHERWISE. PER PARTITION TYPE.
3. PROVISIONS SHALL BE MADE AT ALL FULL HEIGHT NON-BEARING WALLS FOR 1-INCH VERTICAL MOVEMENT OF THE BUILDING STRUCTURE WITHOUT TRANSFER OF COMPRESSIVE LOADS TO WALL. FILL IRREGULARITIES BETWEEN TOP OF WALL AND DECK ABOVE WITH MINERAL WOOL INSULATION OR FIRE STOPPING MATERIALS AS REQUIRED TO MEET FIRE RATING OF RESPECTIVE WALLS. SEE DETAILS ON SHEET XX.X.
4. SEE STRUCTURAL DRAWINGS FOR BRACING OF NON-LOAD BEARING MASONRY WALLS.
5. FURNISH AND INSTALL FIRE-TREATED WOOD BLOCKING OR METAL BACKING PLATE IN METAL STUD PARTITIONS FOR THE PROPER ANCHORAGE OF ALL WALL ATTACHED ITEMS, I.E. TOILET ACCESSORIES, CASEWORK, MILLWORK, WALL-MOUNTED FIXTURES, MARKER BOARDS, TACK BOARDS, DOOR STOPS, AUDIO VISUAL BRACKETS, AND OTHER WALL ATTACHED ITEMS.
6. GYPSUM BOARD SURFACES SHALL BE ISOLATED WITH CONTROL JOINTS WHERE SHOWN ON DRAWINGS AND AS DESCRIBED IN THE SPECIFICATIONS.
7. MASONRY CONTROL JOINTS (CJ) AND CONTROL JOINTS ABOVE (CAJ) SHALL BE LOCATED AS SHOWN ON THE FLOOR PLAN AND BUILDING ELEVATIONS, AND WHERE LARGE PLUMBING VENTS OR RISERS OCCUR IN SINGLE WYTHE MASONRY WALLS, AND WHERE MASONRY WALLS BEARING ON THE CONCRETE FLOOR SLAB ABUT MASONRY WALLS BEARING ON CONCRETE FOOTINGS OR AS INDICATED ON DRAWINGS.
8. EXTEND FURRING CHANNELS AND GYPSUM BOARD UP 4 INCHES ABOVE FINISHED CEILING ON CMU WALLS.
9. SCRIBE GYPSUM WALL BOARD OF WALLS AND PARTITIONS TO IRREGULARITIES OF DECK ABOVE. SEAL TIGHTLY AROUND ALL PENETRATIONS.


REFERENCE KEYNOTES

- RLG-14 CATWALK STEEL PIPE / TUBE RAIL WITH LIGHTING OUTRIGGER; BLACK
 RLG-15 CATWALK RAILING, NO OUTRIGGER
 RLG-16

SHEET NOTES

1. EXISTING WALL COVERING IN-WALL UTILITIES TO REMAIN, NEW WALLS TO TIE IN.
2. EXISTING WALL INFILL.

KEY PLAN

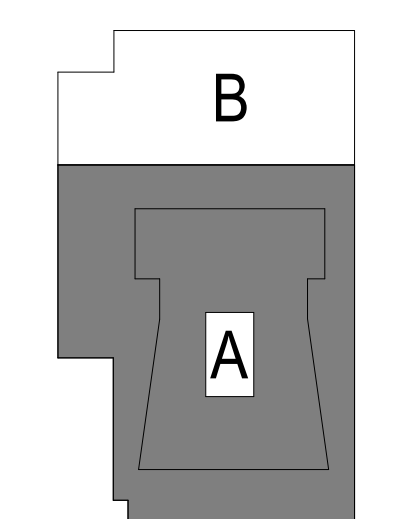

CRANDALL ISD HIGH SCHOOL
PAC ADDITION
13385 Fm 3038, Crandall, TX 75114

ISSUE FOR BID AND PERMIT
2024.07.25
REVISIONS
01 08/19/24 ADDENDUM 01

39-23712-00
ENLARGED PLAN - AUDIENCE CHAMBER - CATWALK

A2.3


1

2

3

4

5

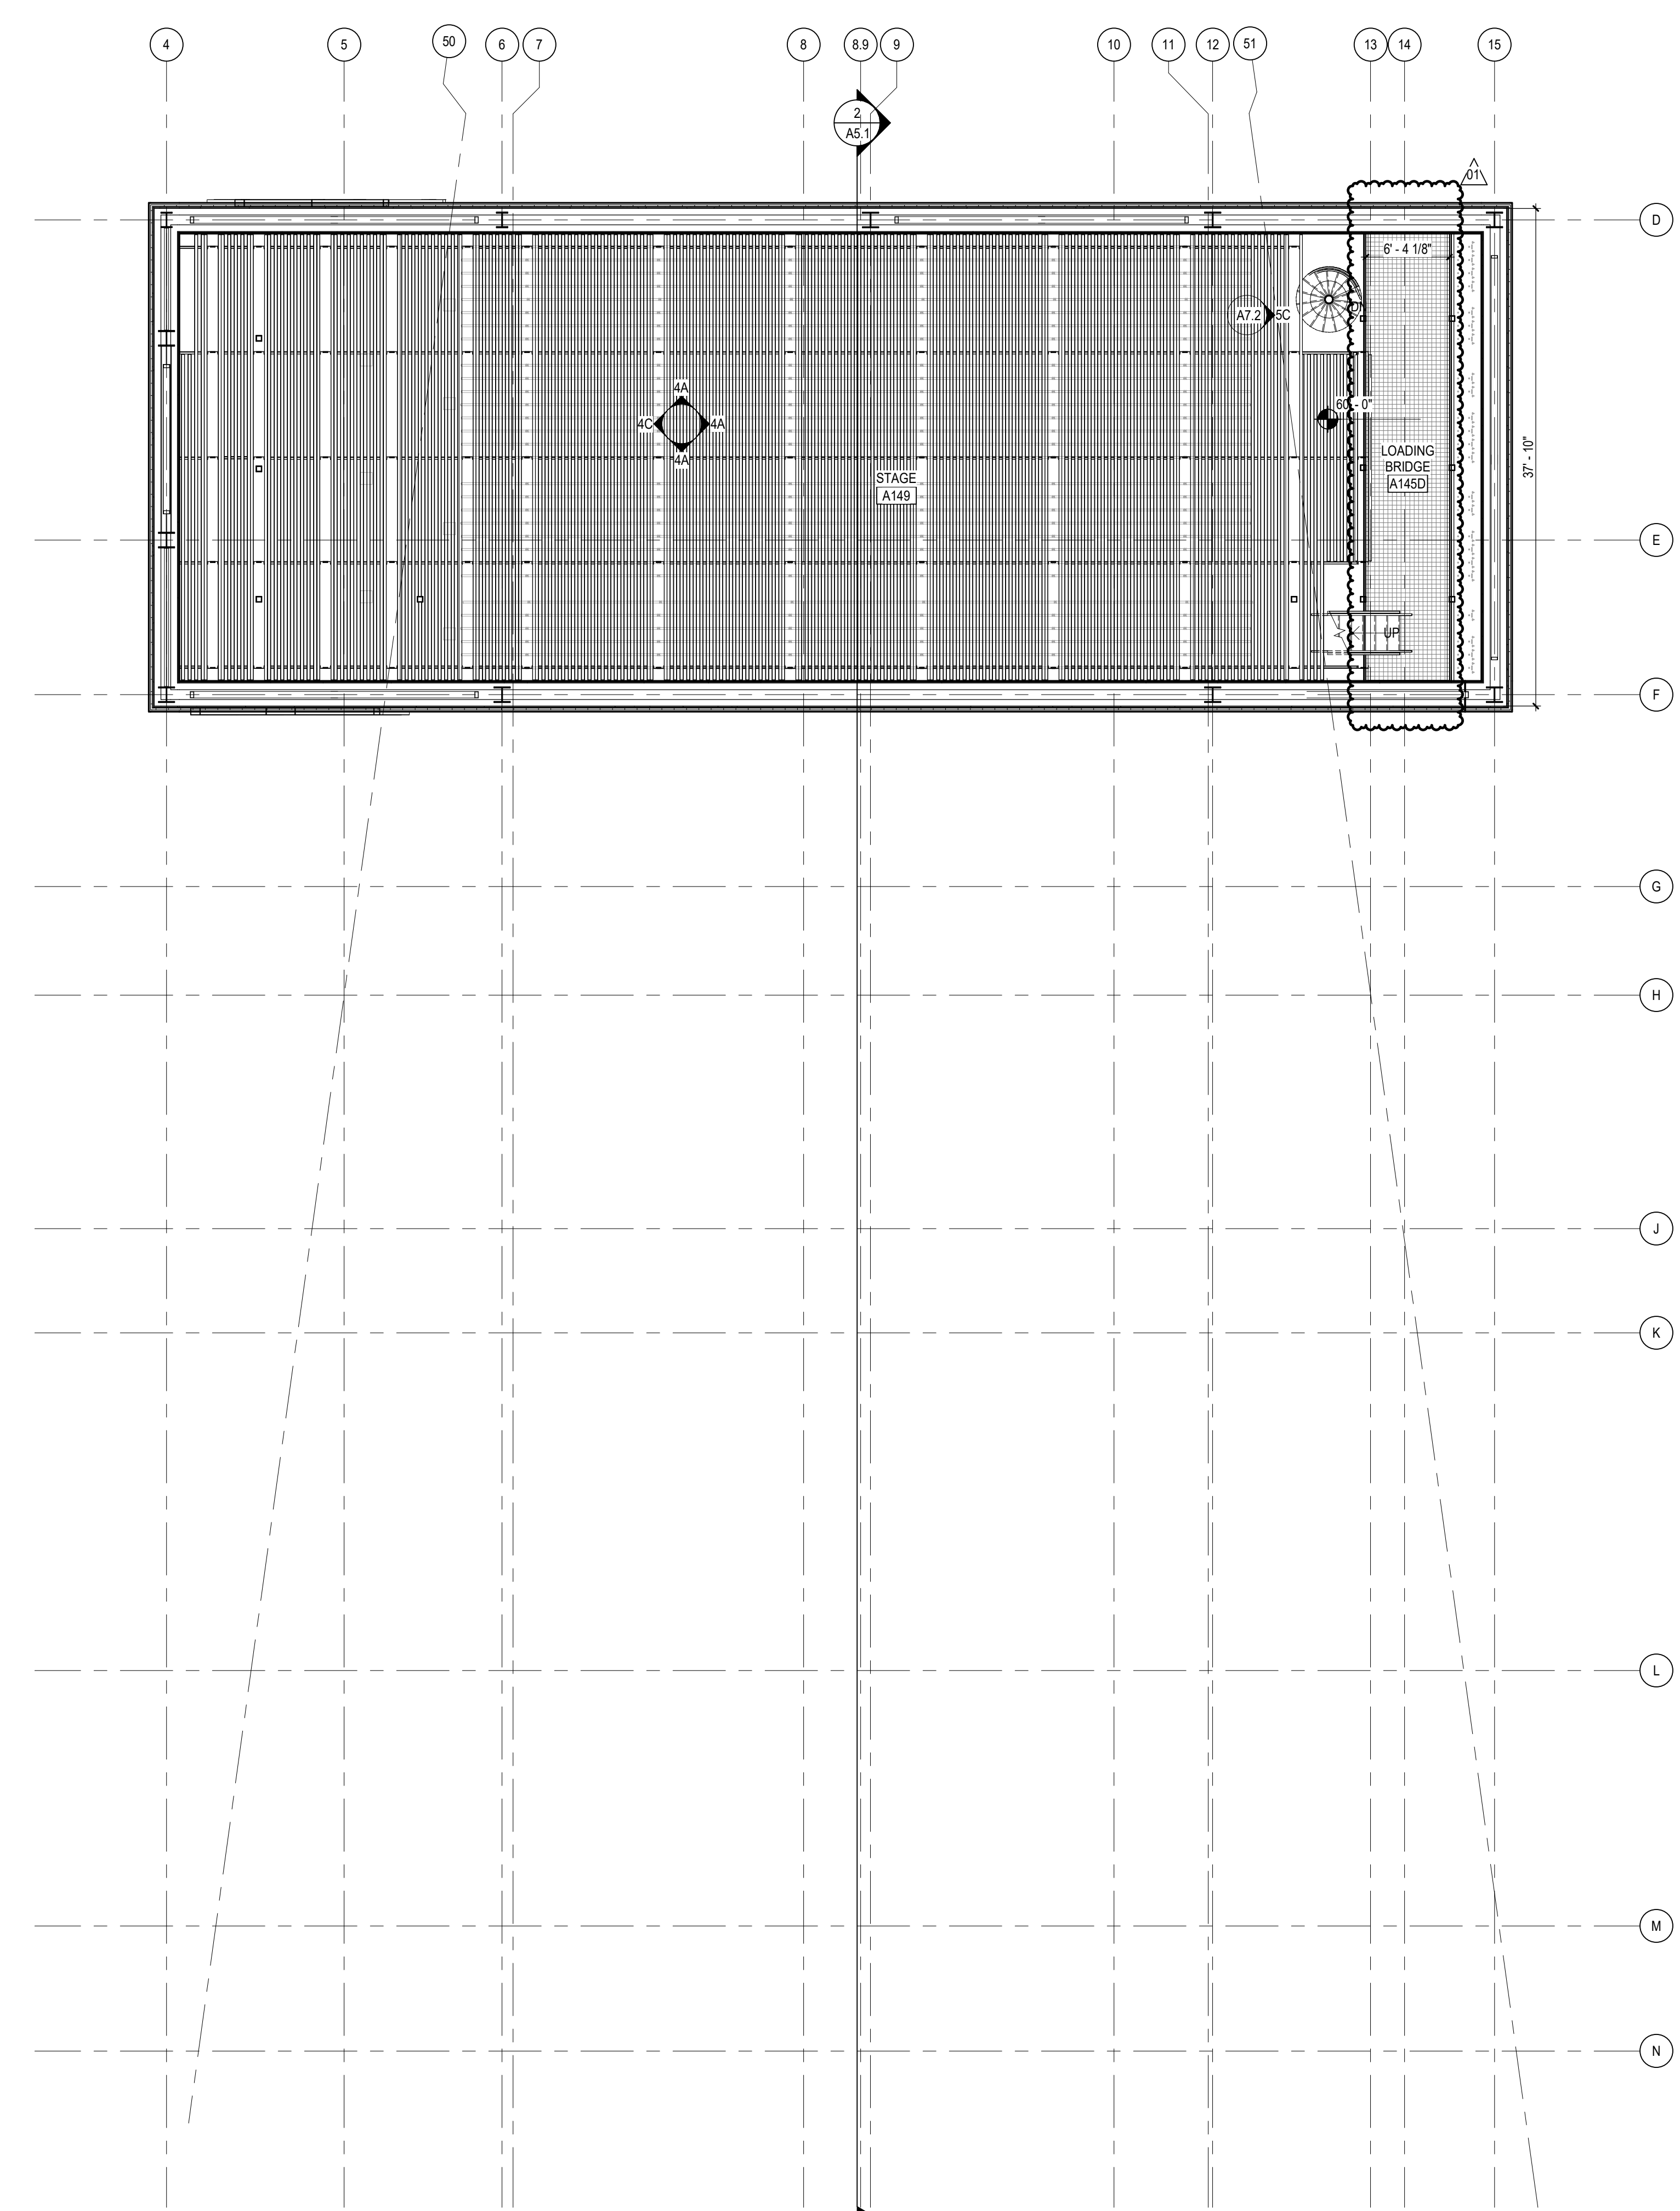

LEVEL 04 LOADING BRIDGE - AREA A_C - FLOOR PLAN
SCALE: 1/8" = 1'-0"

GENERAL ARCHITECTURAL NOTES



1. PARTITION TYPES SHALL BE DESIGNATED ON FLOOR PLANS (XX X XX) THUS SEE SHEET A8.3 FOR TYPES. ALL INTERIOR PARTITIONS ARE TYPE S1.30 UNLESS NOTED OTHERWISE.
2. ALL MASONRY WALLS AND INTERIOR STUD WALLS SHALL EXTEND TO UNDERSIDE OF FLOOR OR ROOF DECK ABOVE UNLESS NOTED OTHERWISE, PER PARTITION TYPE.
3. PROVISIONS SHALL BE MADE AT ALL FULL HEIGHT NON-BEARING WALLS FOR 1-INCH VERTICAL MOVEMENT OF THE BUILDING STRUCTURE WITHOUT TRANSFER OF COMPRESSIVE LOADS TO WALL. FILL IRREGULARITIES BETWEEN TOP OF WALL AND DECK ABOVE WITH MINERAL WOOL INSULATION OR FIRE STOPPING MATERIALS AS REQUIRED TO MEET FIRE RATING OF RESPECTIVE WALLS. SEE DETAILS ON SHEET XX.X.
4. SEE STRUCTURAL DRAWINGS FOR BRACING OF NON-LOAD BEARING MASONRY WALLS.
5. FURNISH AND INSTALL FIRE-TREATED WOOD BLOCKING OR METAL BACKING PLATE IN METAL STUD PARTITIONS FOR THE PROPER ANCHORAGE OF ALL WALL ATTACHED ITEMS, I.E. TOILET ACCESSORIES, CASEWORK, MILLWORK, WALL-MOUNTED FIXTURES, MARKER BOARDS, TACK BOARDS, DOOR STOPS, AUDIO VISUAL BRACKETS, AND OTHER WALL ATTACHED ITEMS.
6. GYPSUM BOARD SURFACES SHALL BE ISOLATED WITH CONTROL JOINTS WHERE SHOWN ON DRAWINGS AND AS DESCRIBED IN THE SPECIFICATIONS.
7. MASONRY CONTROL JOINTS (CJ) AND CONTROL JOINTS ABOVE (CA) SHALL BE LOCATED AS SHOWN ON THE FLOOR PLAN AND BUILDING ELEVATIONS, AND WHERE LARGE PLUMBING VENTS OR RISERS OCCUR IN SINGLE WYTHE MASONRY WALLS, AND WHERE MASONRY WALLS BEARING ON THE CONCRETE FLOOR SLAB ABUT MASONRY WALLS BEARING ON CONCRETE FOOTINGS OR AS INDICATED ON DRAWINGS.
8. EXTEND FURRING CHANNELS AND GYPSUM BOARD UP 4 INCHES ABOVE FINISHED CEILING ON CMU WALLS.
9. SCRIBE GYPSUM WALL BOARD OF WALLS AND PARTITIONS TO IRREGULARITIES OF DECK ABOVE. SEAL TIGHTLY AROUND ALL PENETRATIONS.

REFERENCE KEYNOTES

SHEET NOTES

1. EXISTING WALL COVERING IN-WALL UTILITIES TO REMAIN, NEW WALLS TO TIE IN.
2. EXISTING WALL INFILL.

KEY PLAN

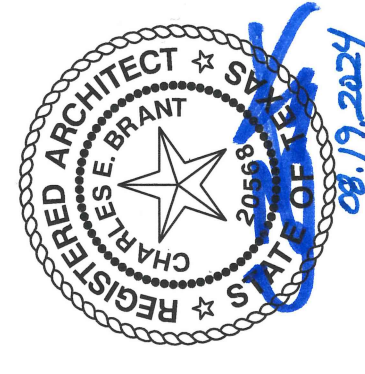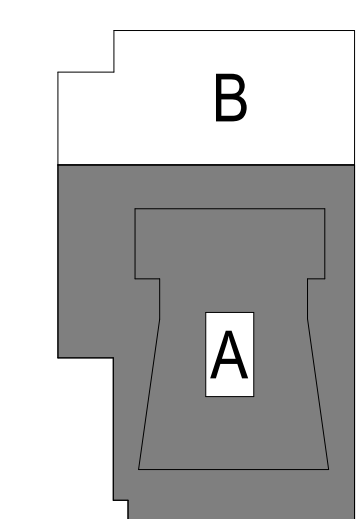

CRANDALL ISD HIGH SCHOOL
PAC ADDITION
13385 Fm 3038, Crandall, TX 75114


ISSUE FOR BID AND PERMIT
2024.07.25
REVISIONS
01 08/19/24 ADDENDUM 01


39-23712-00
ENLARGED PLAN - AUDIENCE CHAMBER - LOADING BRIDGE

A2.4

Autodesk Docs://99-23712-00_Crandall ISD - PAC/39-23712-00_Crandall ISD_AR_2024.rvt
8/9/2024 7:52:26 PM

1
2
3
4
5

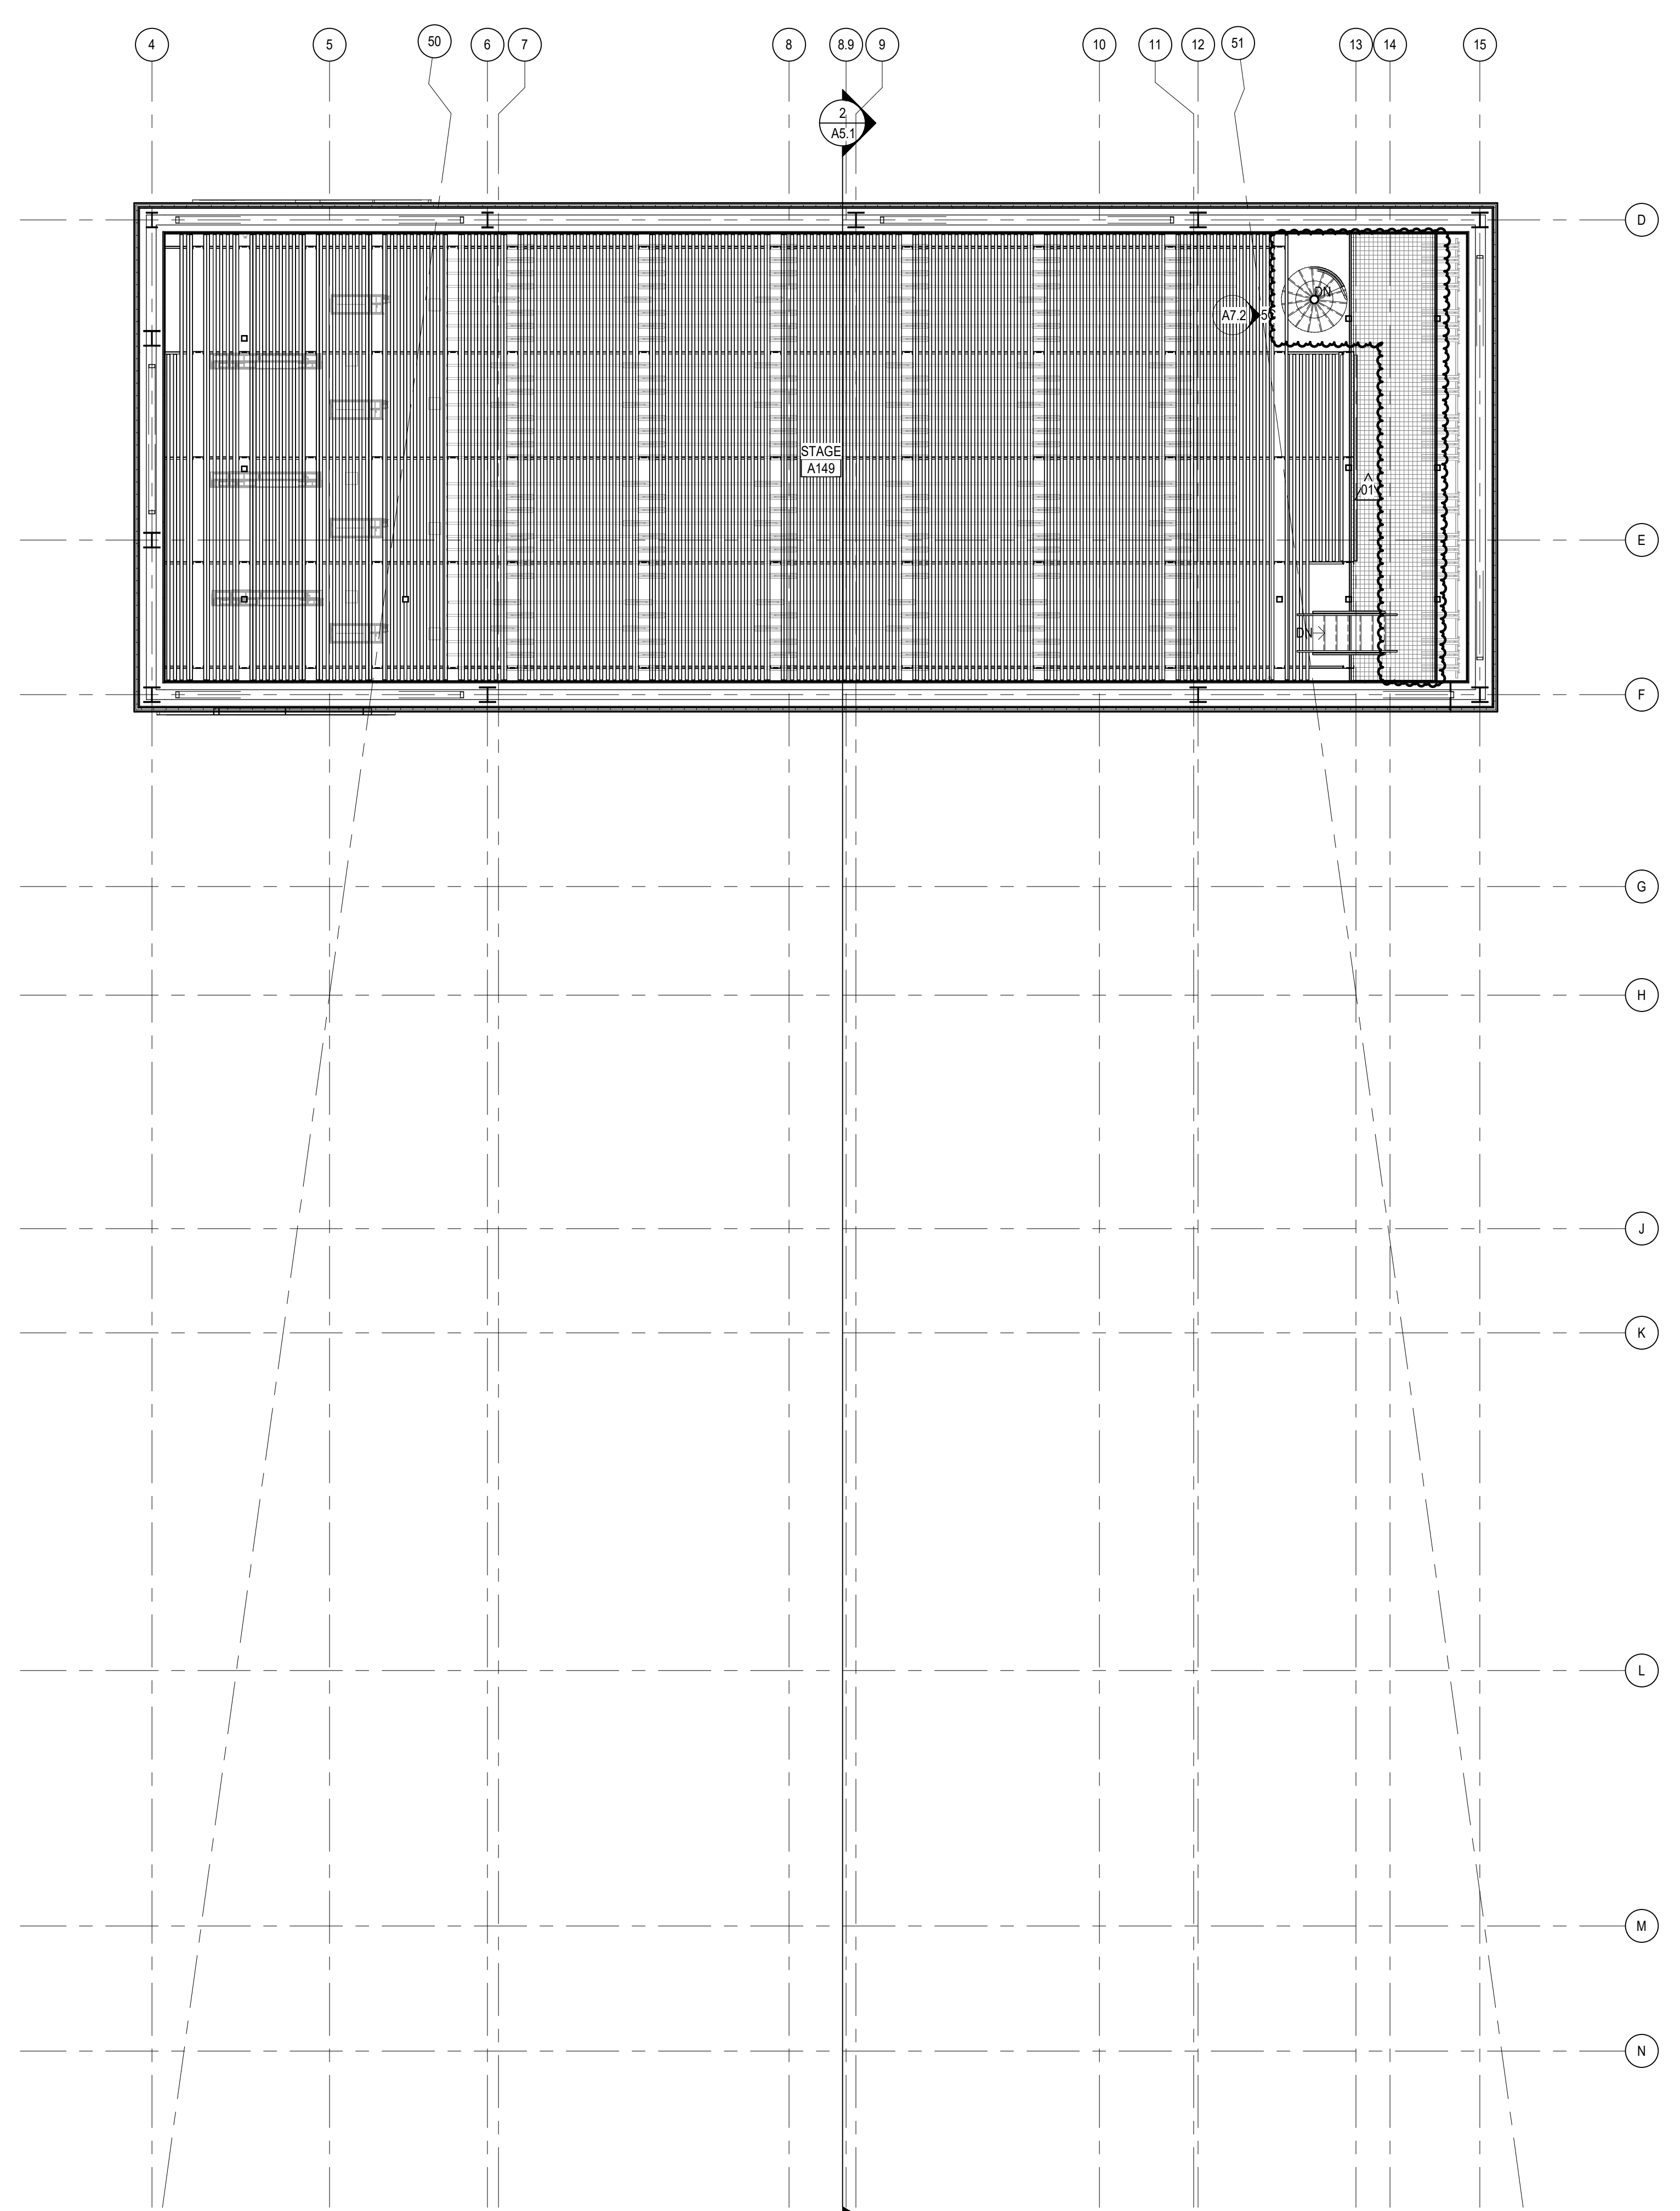

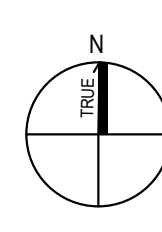 **GRID LEVEL 05 - AREA A C - FLOOR PLAN**
SCALE: 1/8" = 1'-0"

GENERAL ARCHITECTURAL NOTES



1. PARTITION TYPES SHALL BE DESIGNATED ON FLOOR PLANS (XX X XX) THUS SEE SHEET A8.3 FOR TYPES. ALL INTERIOR PARTITIONS ARE TYPE SA.3.20 UNLESS NOTED OTHERWISE.
2. ALL MASONRY WALLS AND INTERIOR STUD WALLS SHALL EXTEND TO UNDERSIDE OF FLOOR OR ROOF DECK ABOVE UNLESS NOTED OTHERWISE, PER PARTITION TYPE.
3. PROVISIONS SHALL BE MADE AT ALL FULL HEIGHT NON-BEARING WALLS FOR 1-INCH VERTICAL MOVEMENT OF THE BUILDING STRUCTURE WITHOUT TRANSFER OF COMPRESSIVE LOADS TO WALL. FILL IRREGULARITIES BETWEEN TOP OF WALL AND DECK ABOVE WITH MINERAL WOOL INSULATION OR FIRE STOPPING MATERIALS AS REQUIRED TO MEET FIRE RATING OF RESPECTIVE WALLS. SEE DETAILS ON SHEET XX.X.
4. SEE STRUCTURAL DRAWINGS FOR BRACING OF NON-LOAD BEARING MASONRY WALLS.
5. FURNISH AND INSTALL FIRE-TREATED WOOD BLOCKING OR METAL BACKING PLATE IN METAL STUD PARTITIONS FOR THE PROPER ANCHORAGE OF ALL WALL ATTACHED ITEMS, I.E. TOILET ACCESSORIES, CASEWORK, MILLWORK, WALL-MOUNTED FIXTURES, MARKER BOARDS, TACK BOARDS, DOOR STOPS, AUDIO VISUAL BRACKETS, AND OTHER WALL ATTACHED ITEMS.
6. GYPSUM BOARD SURFACES SHALL BE ISOLATED WITH CONTROL JOINTS WHERE SHOWN ON DRAWINGS AND AS DESCRIBED IN THE SPECIFICATIONS.
7. MASONRY CONTROL JOINTS (CJ) AND CONTROL JOINTS ABOVE (CA) SHALL BE LOCATED AS SHOWN ON THE FLOOR PLAN AND BUILDING ELEVATIONS, AND WHERE LARGE PLUMBING VENTS OR RISERS OCCUR IN SINGLE WYTHE MASONRY WALLS, AND WHERE MASONRY WALLS BEARING ON THE CONCRETE FLOOR SLAB ABUT MASONRY WALLS BEARING ON CONCRETE FOOTINGS OR AS INDICATED ON DRAWINGS.
8. EXTEND FURRING CHANNELS AND GYPSUM BOARD UP 4 INCHES ABOVE FINISHED CEILING ON CMU WALLS.
9. SCRIBE GYPSUM WALL BOARD OF WALLS AND PARTITIONS TO IRREGULARITIES OF DECK ABOVE. SEAL TIGHTLY AROUND ALL PENETRATIONS.

REFERENCE KEYNOTES

SHEET NOTES

1. EXISTING WALL COVERING IN-WALL UTILITIES TO REMAIN, NEW WALLS TO TIE IN.
2. EXISTING WALL INFILL.

KEY PLAN

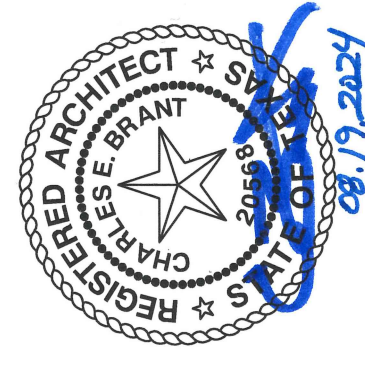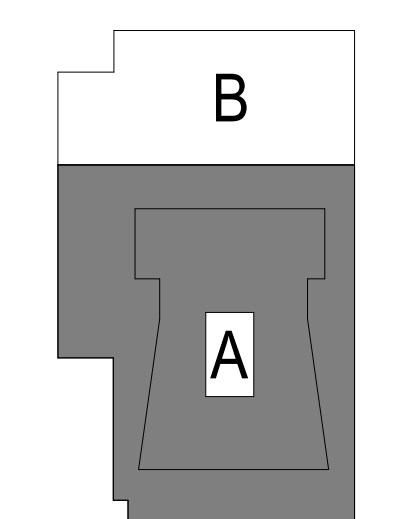


CRANDALL ISD HIGH SCHOOL
PAC ADDITION
13385 Fm 3038, Crandall, TX 75114


ISSUE FOR BID AND PERMIT
2024.07.25
REVISIONS
01 08/19/24 ADDENDUM 01

39-23712-00
ENLARGED PLAN - AUDIENCE CHAMBER - GRID LEVEL


A2.5

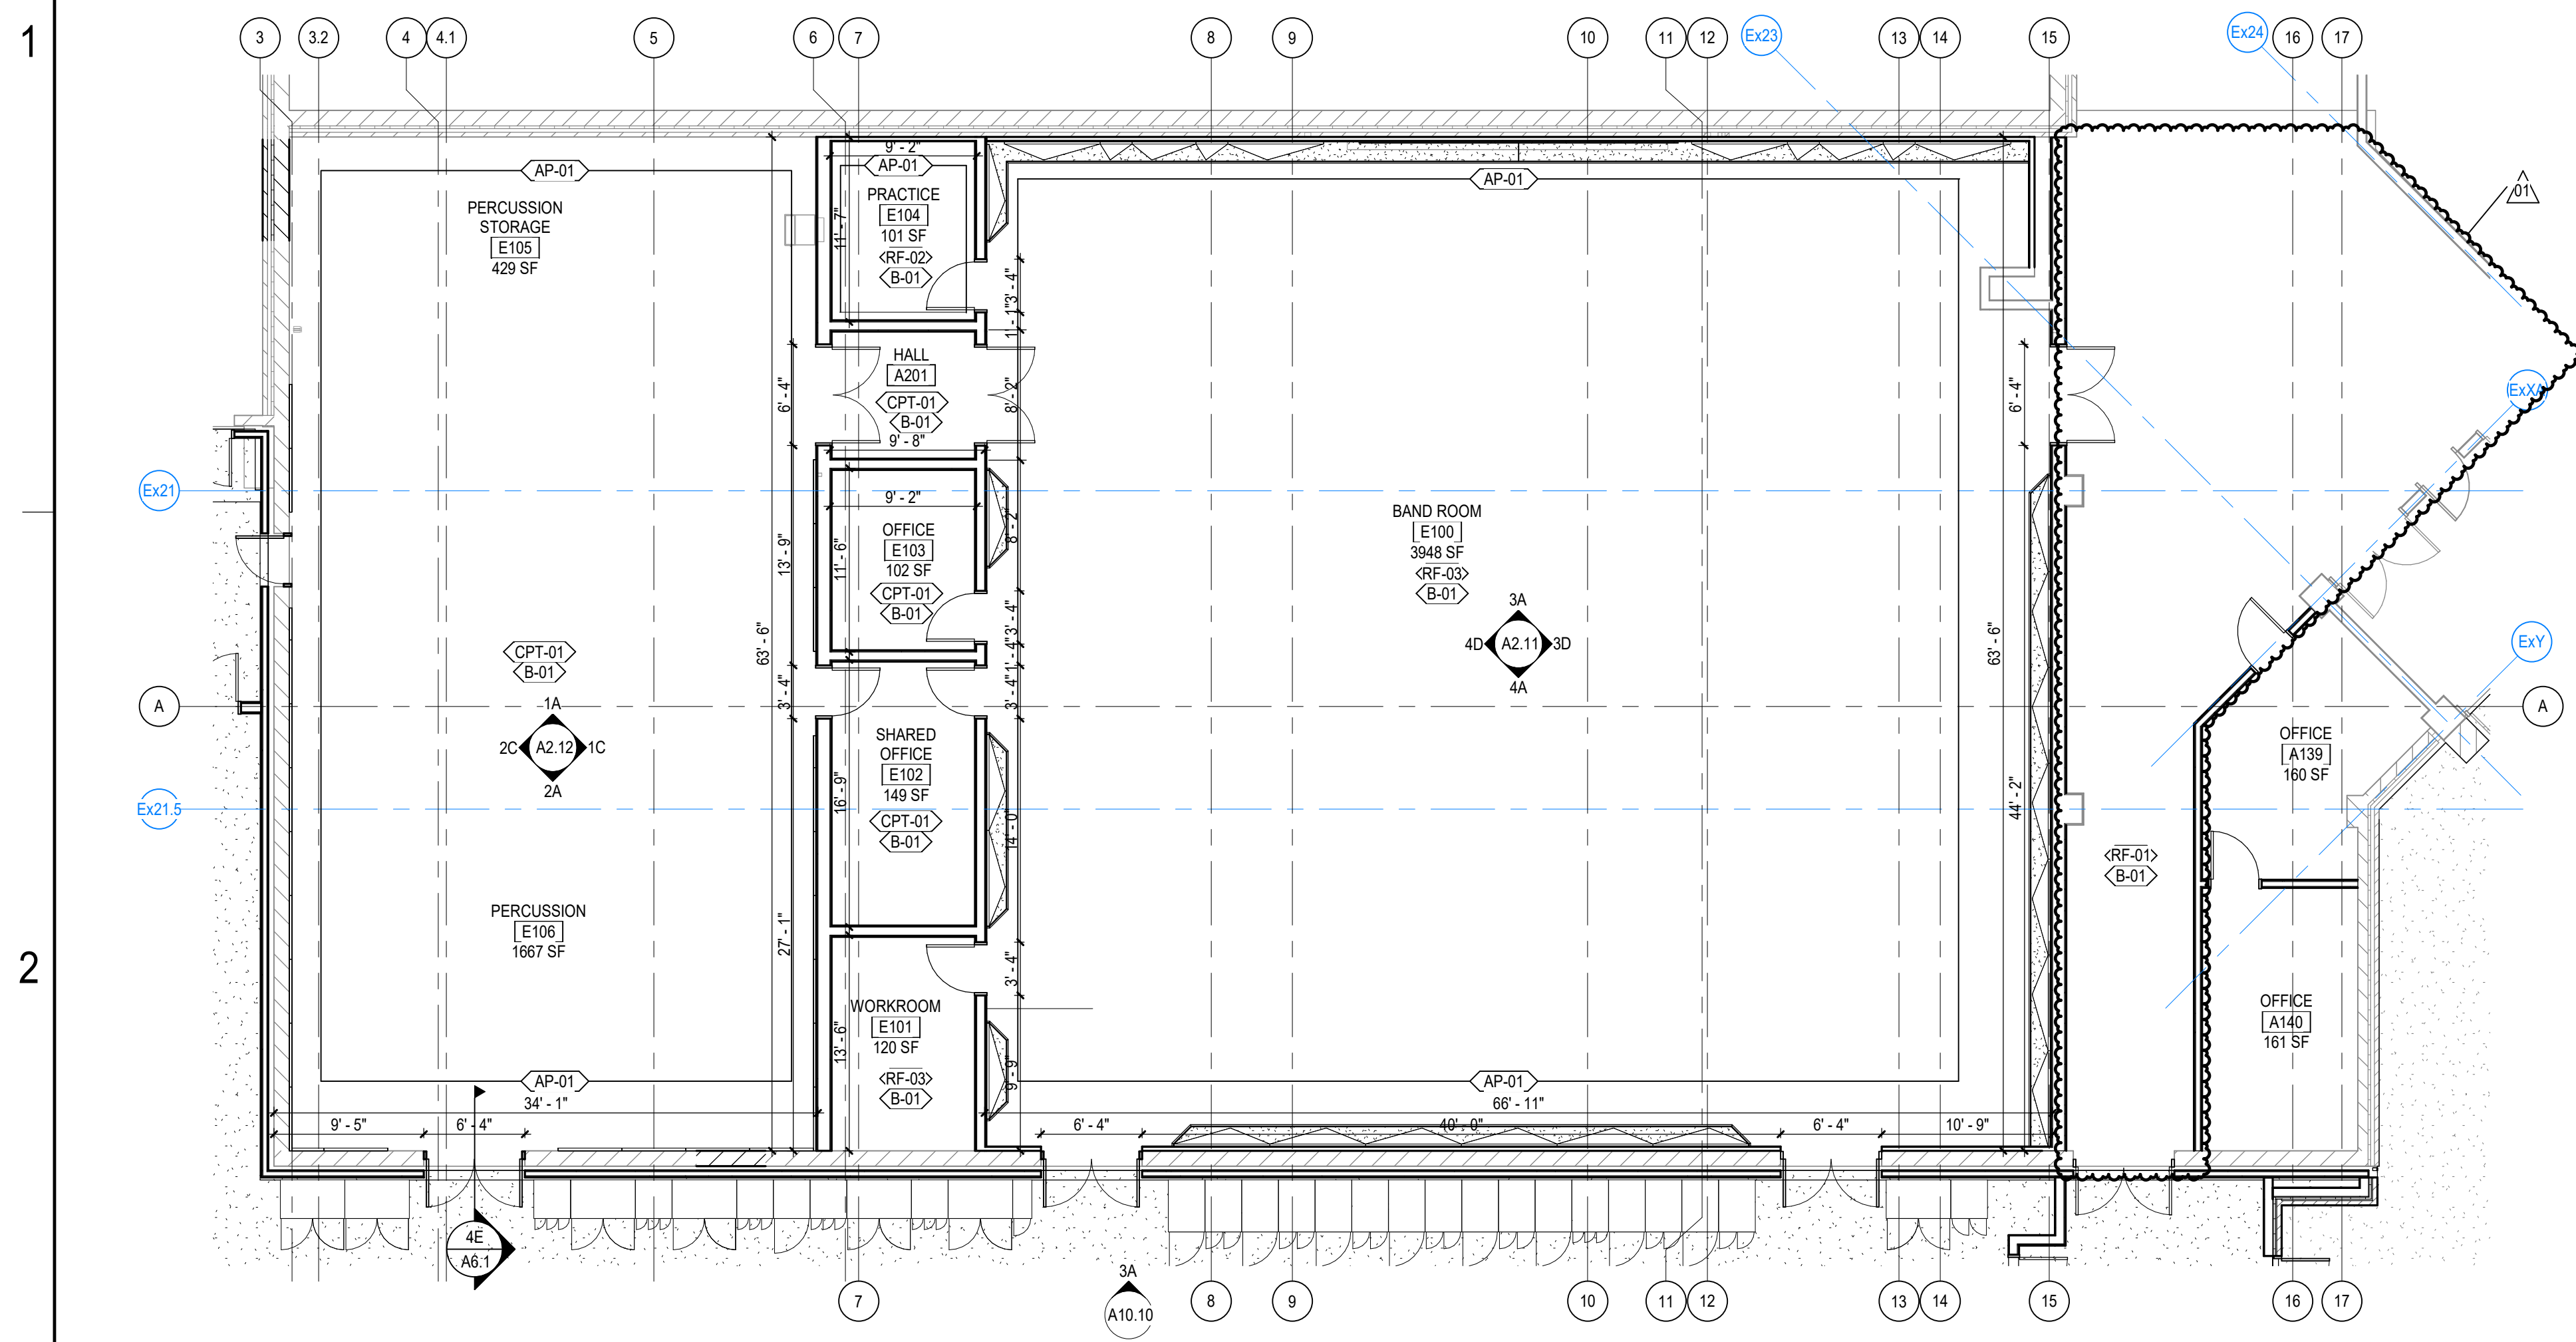


2A BAND RENOVATION - ENLARGED PLAN
A2.11 SCALE: 1/8" = 1'-0"

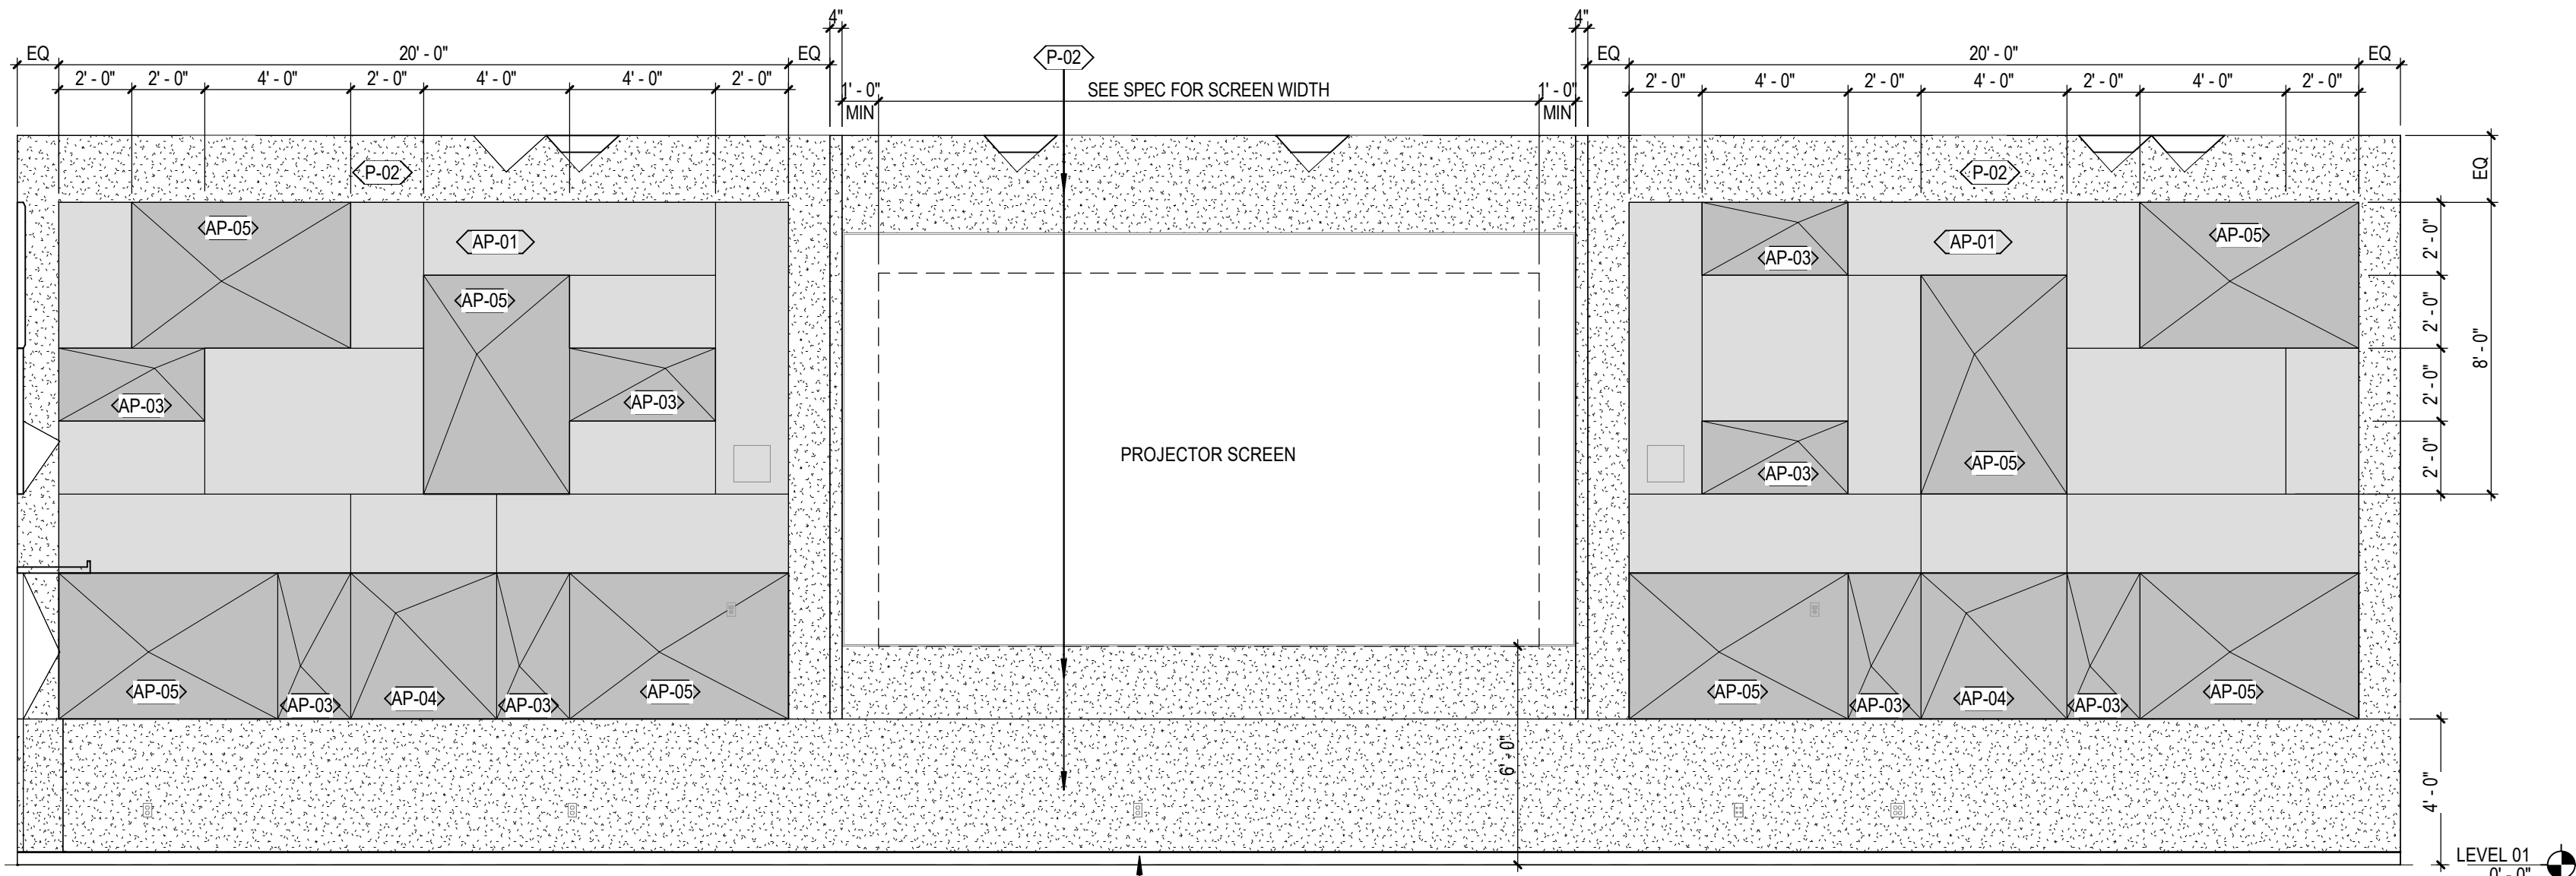


3A E100 - BAND ROOM - NORTH
A2.11 SCALE: 1/4" = 1'-0"

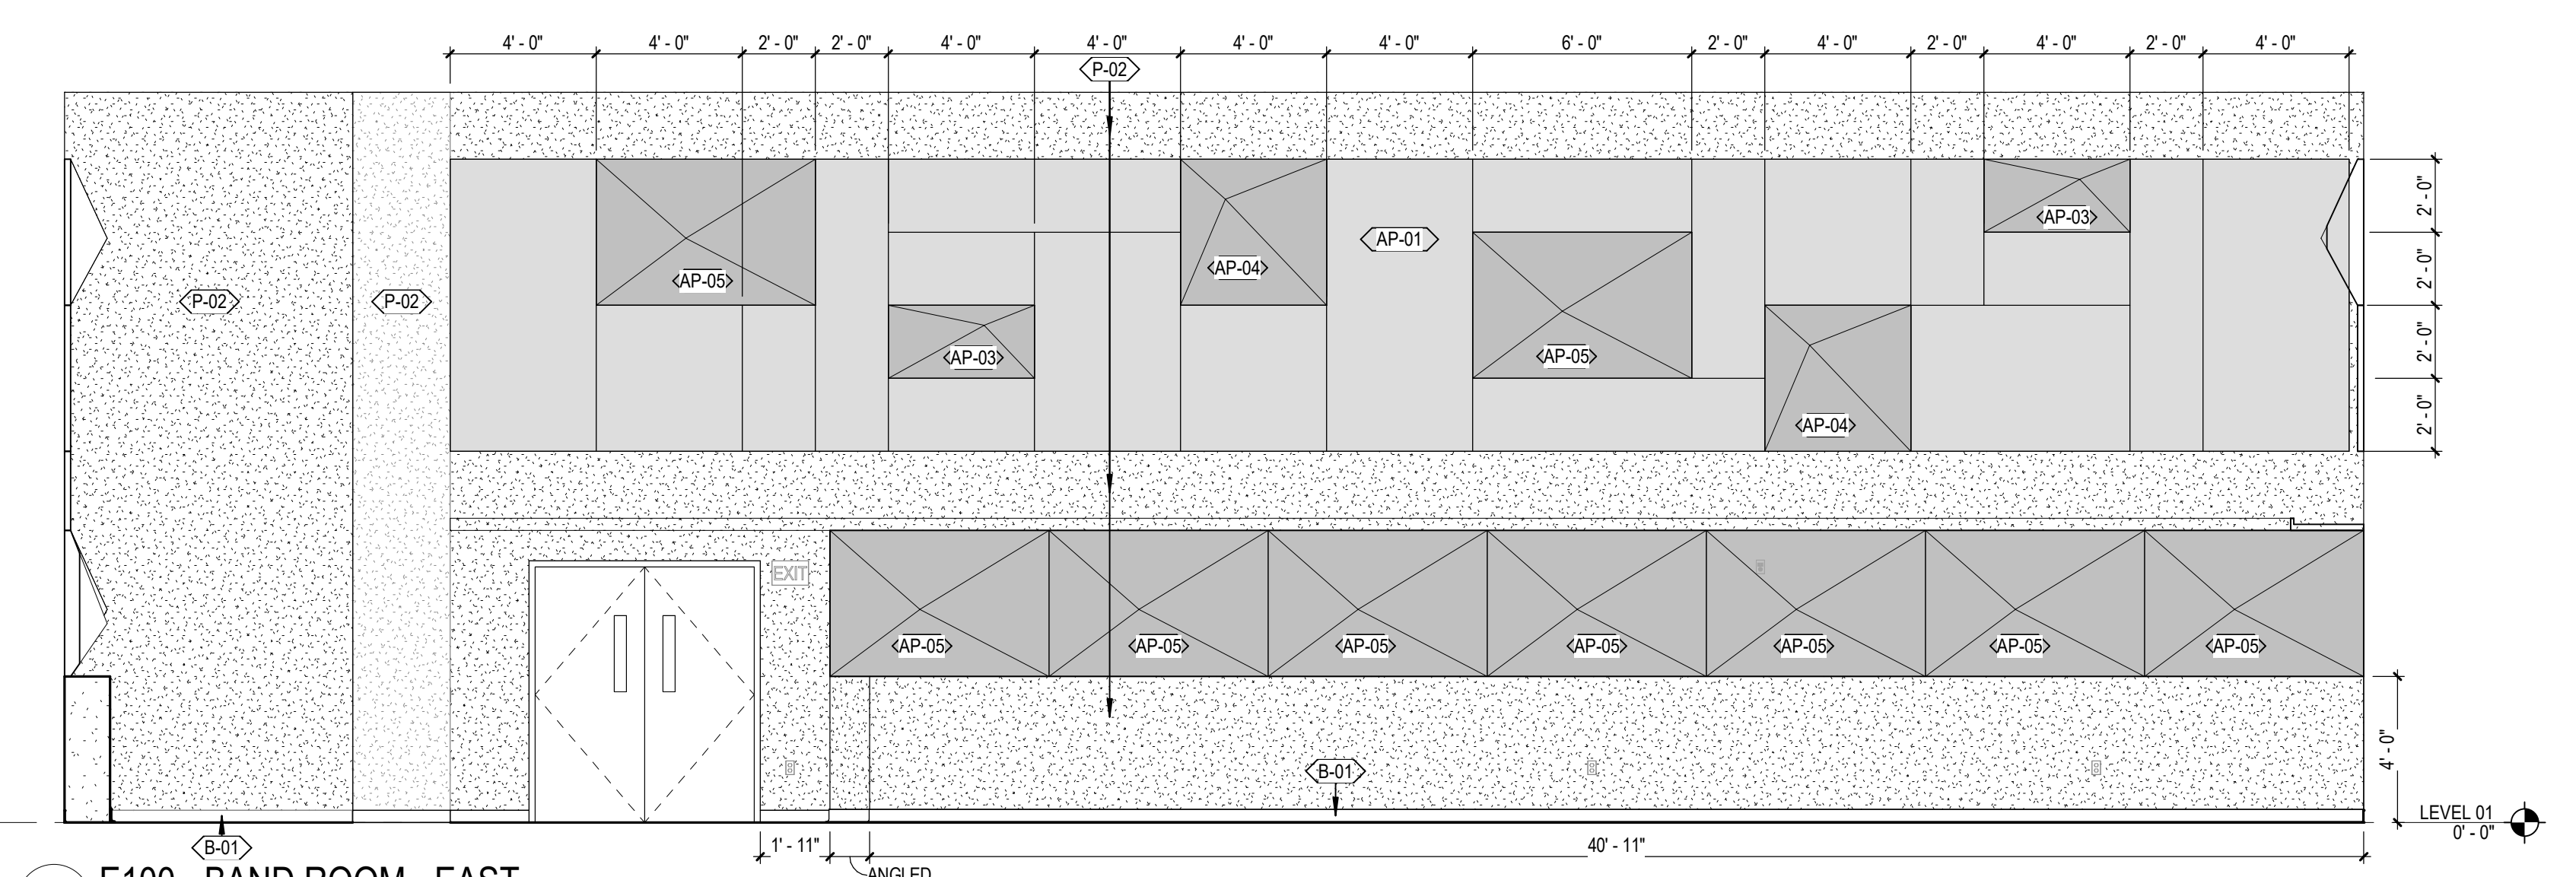

3D E100 - BAND ROOM - EAST
A2.11 SCALE: 1/4" = 1'-0"

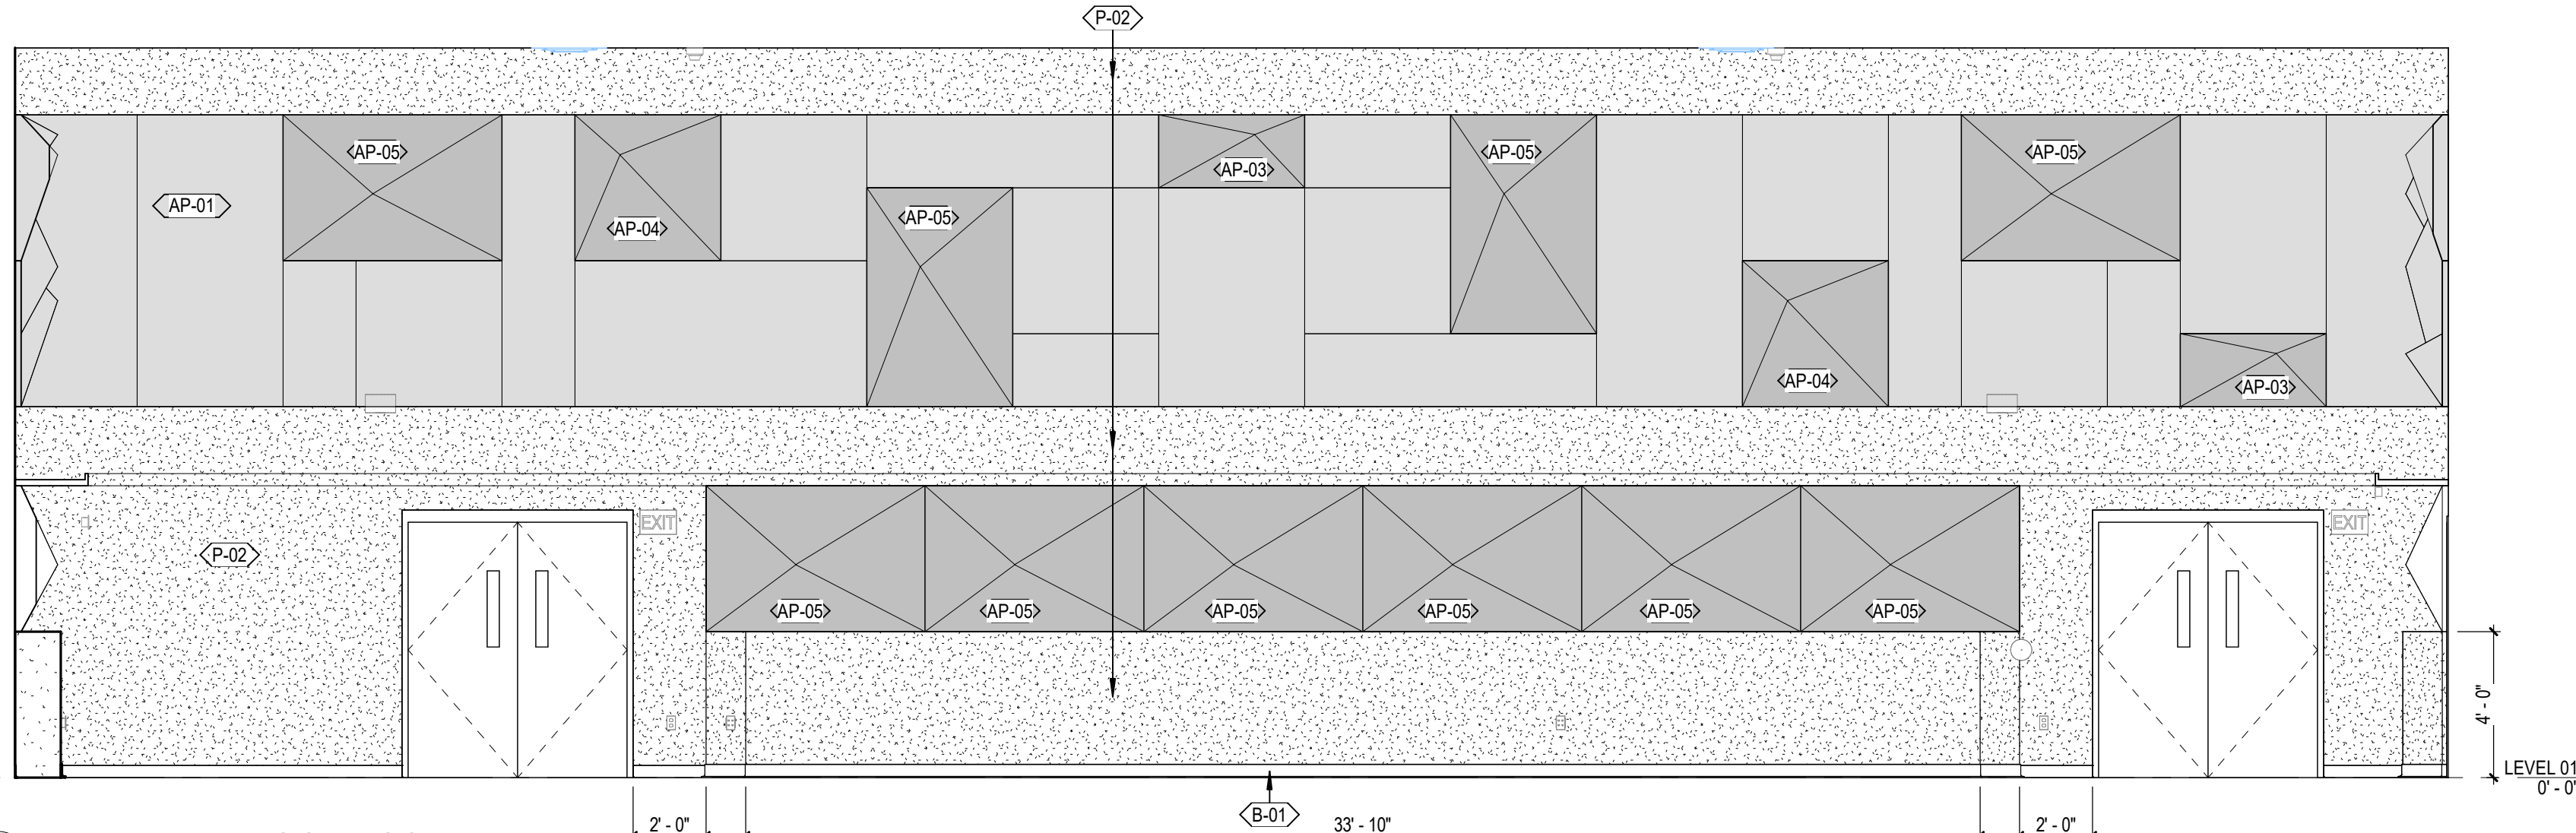


4A E100 - BAND ROOM - SOUTH
A2.11 SCALE: 1/4" = 1'-0"

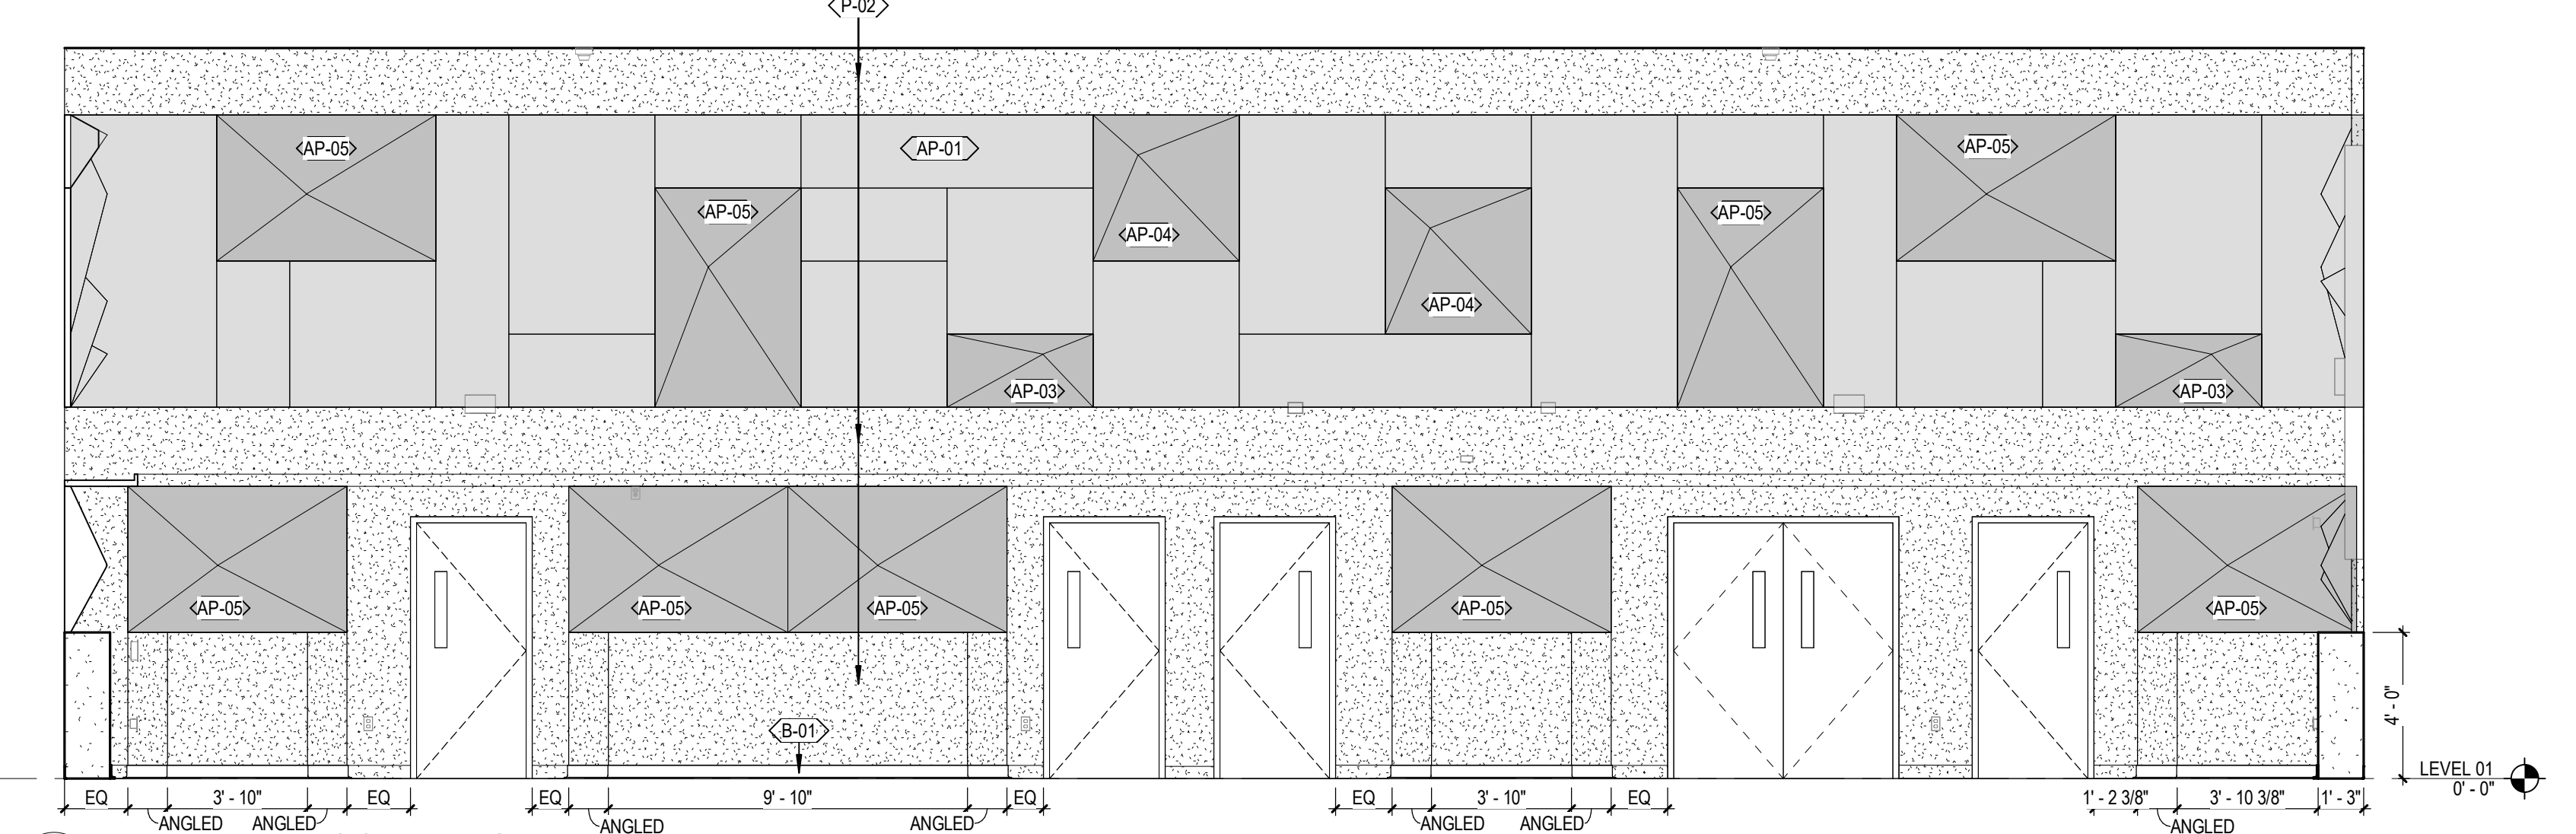


4D E100 - BAND ROOM - WEST
A2.11 SCALE: 1/4" = 1'-0"




Autodesk Docs/39-23712-00 Crandall ISD - PAC/39-23712-00 Crandall ISD_AR_2024.rvt 8/19/2024 7:52:34 PM

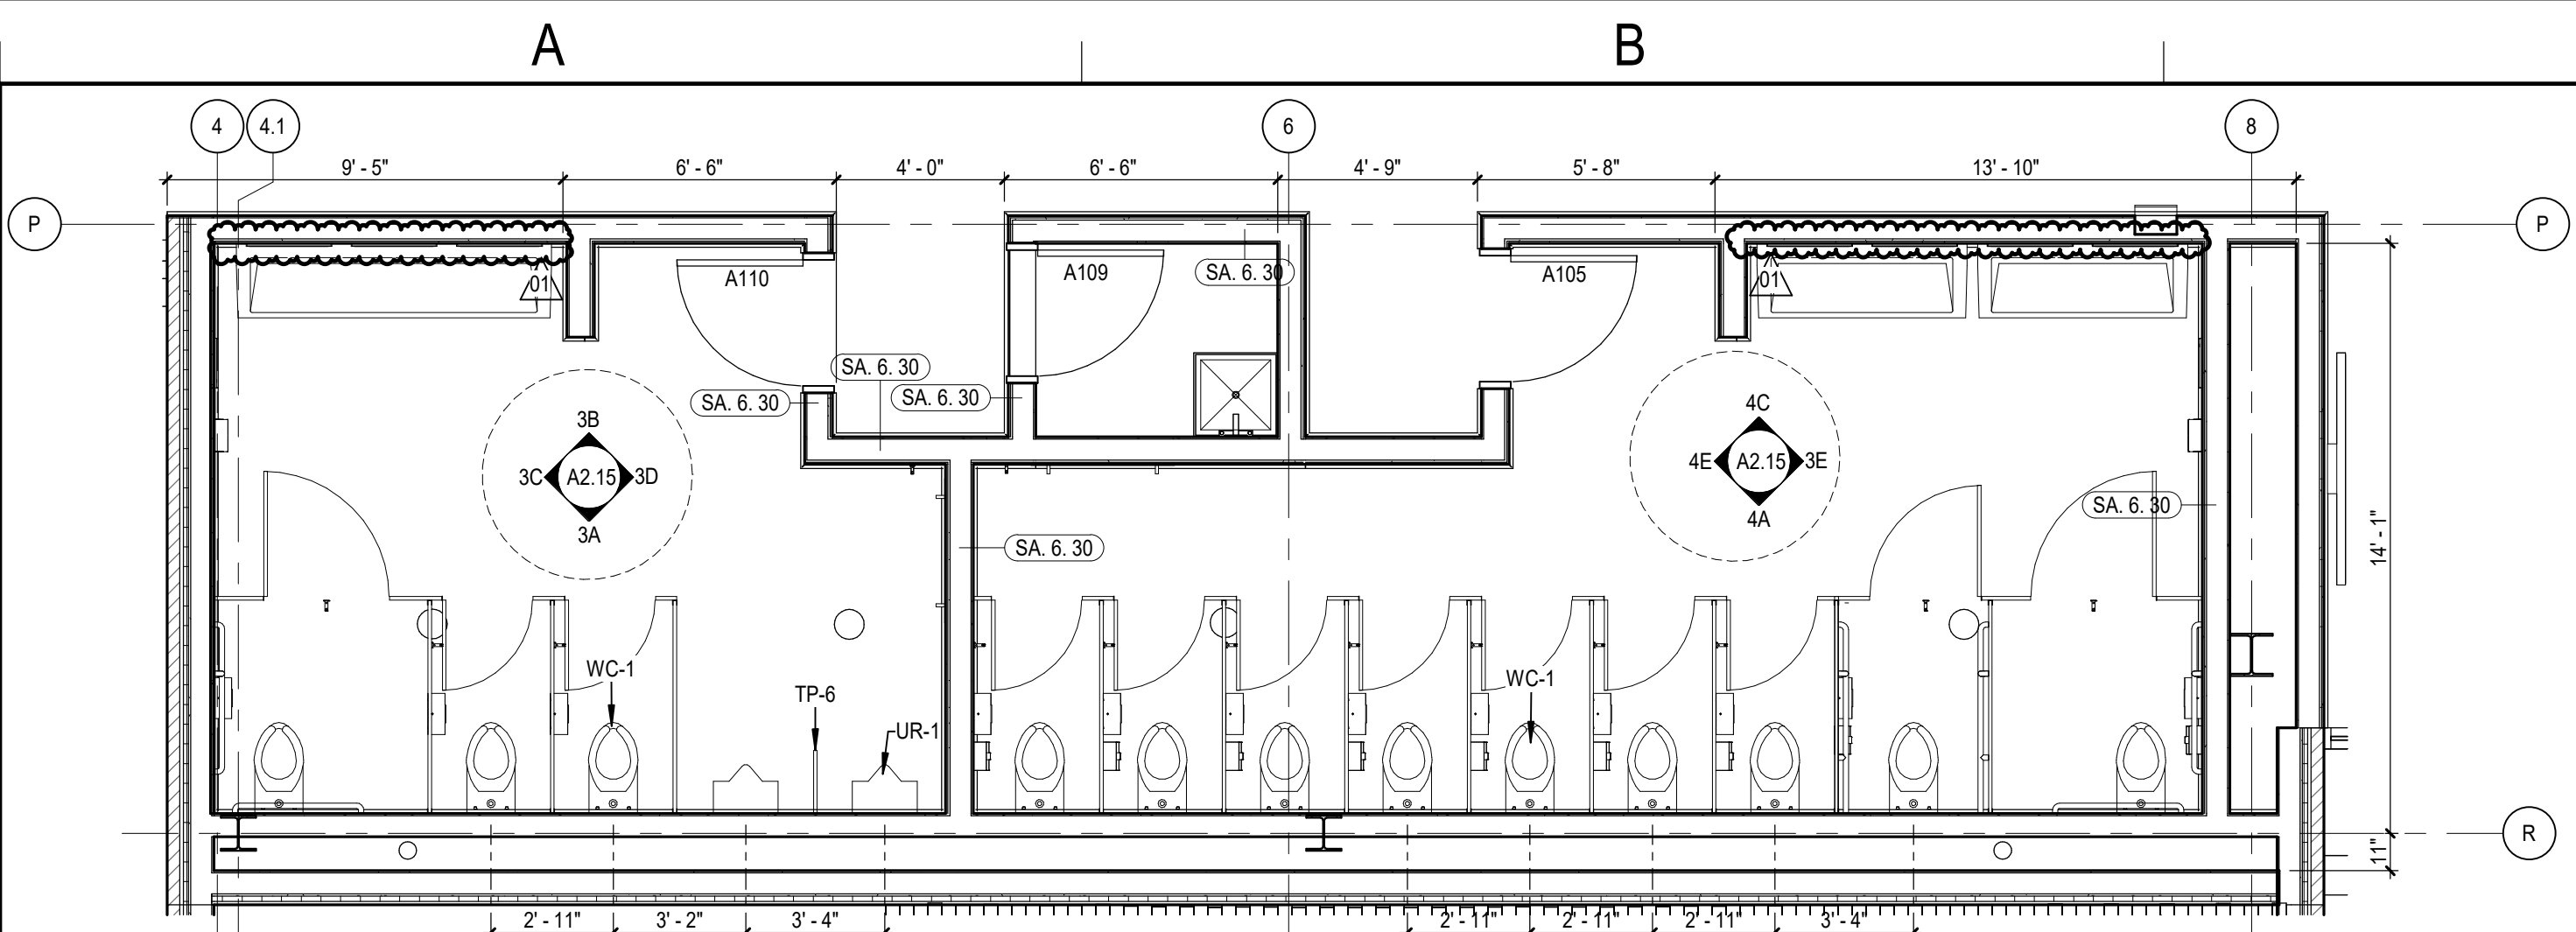

1A TYPICAL ENLARGED GROUP RESTROOMS - FLOOR PLAN
A2.15 SCALE: 1/4" = 1'-0"

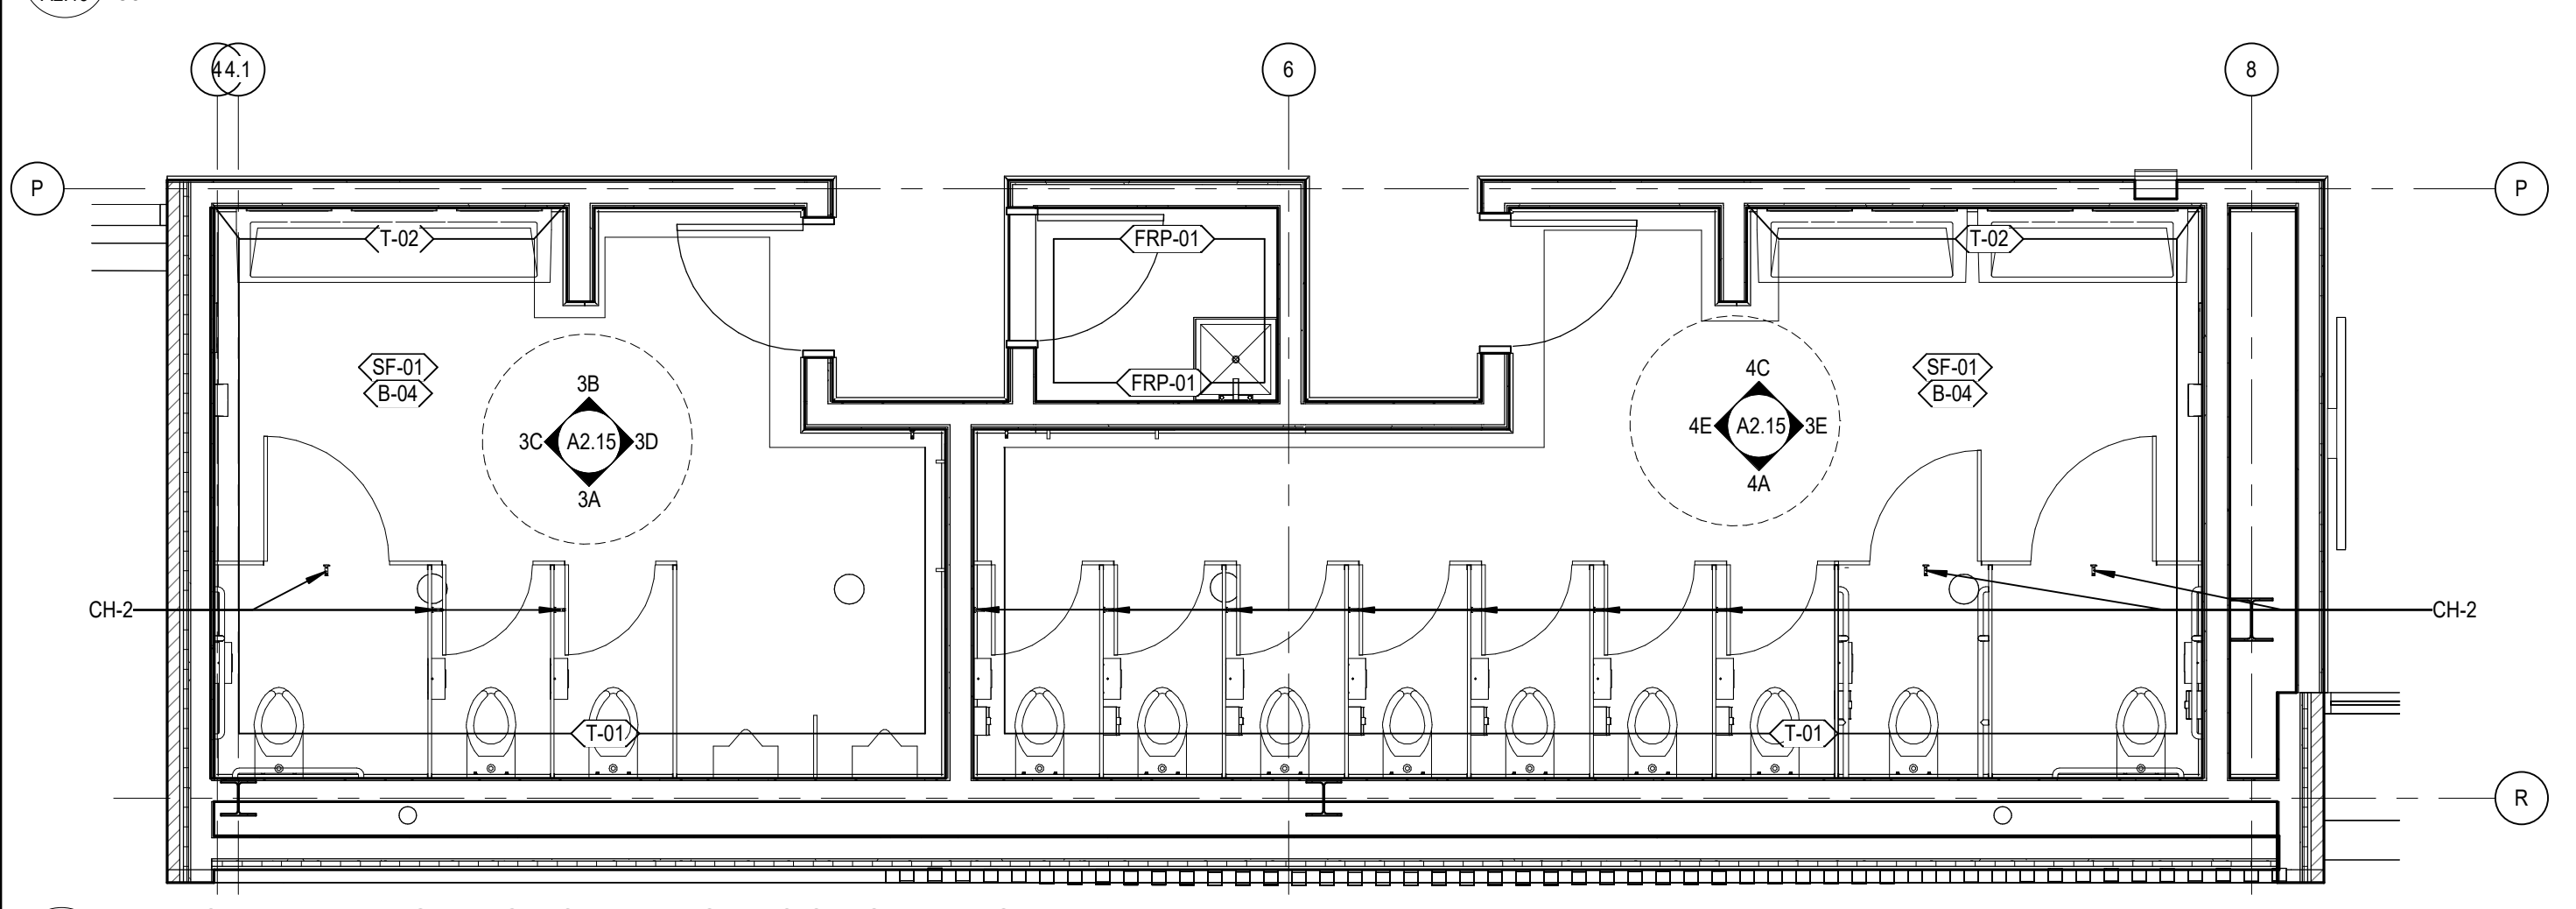

2A TYPICAL ENLARGED GROUP RESTROOMS - FINISH PLAN
A2.15 SCALE: 1/4" = 1'-0"

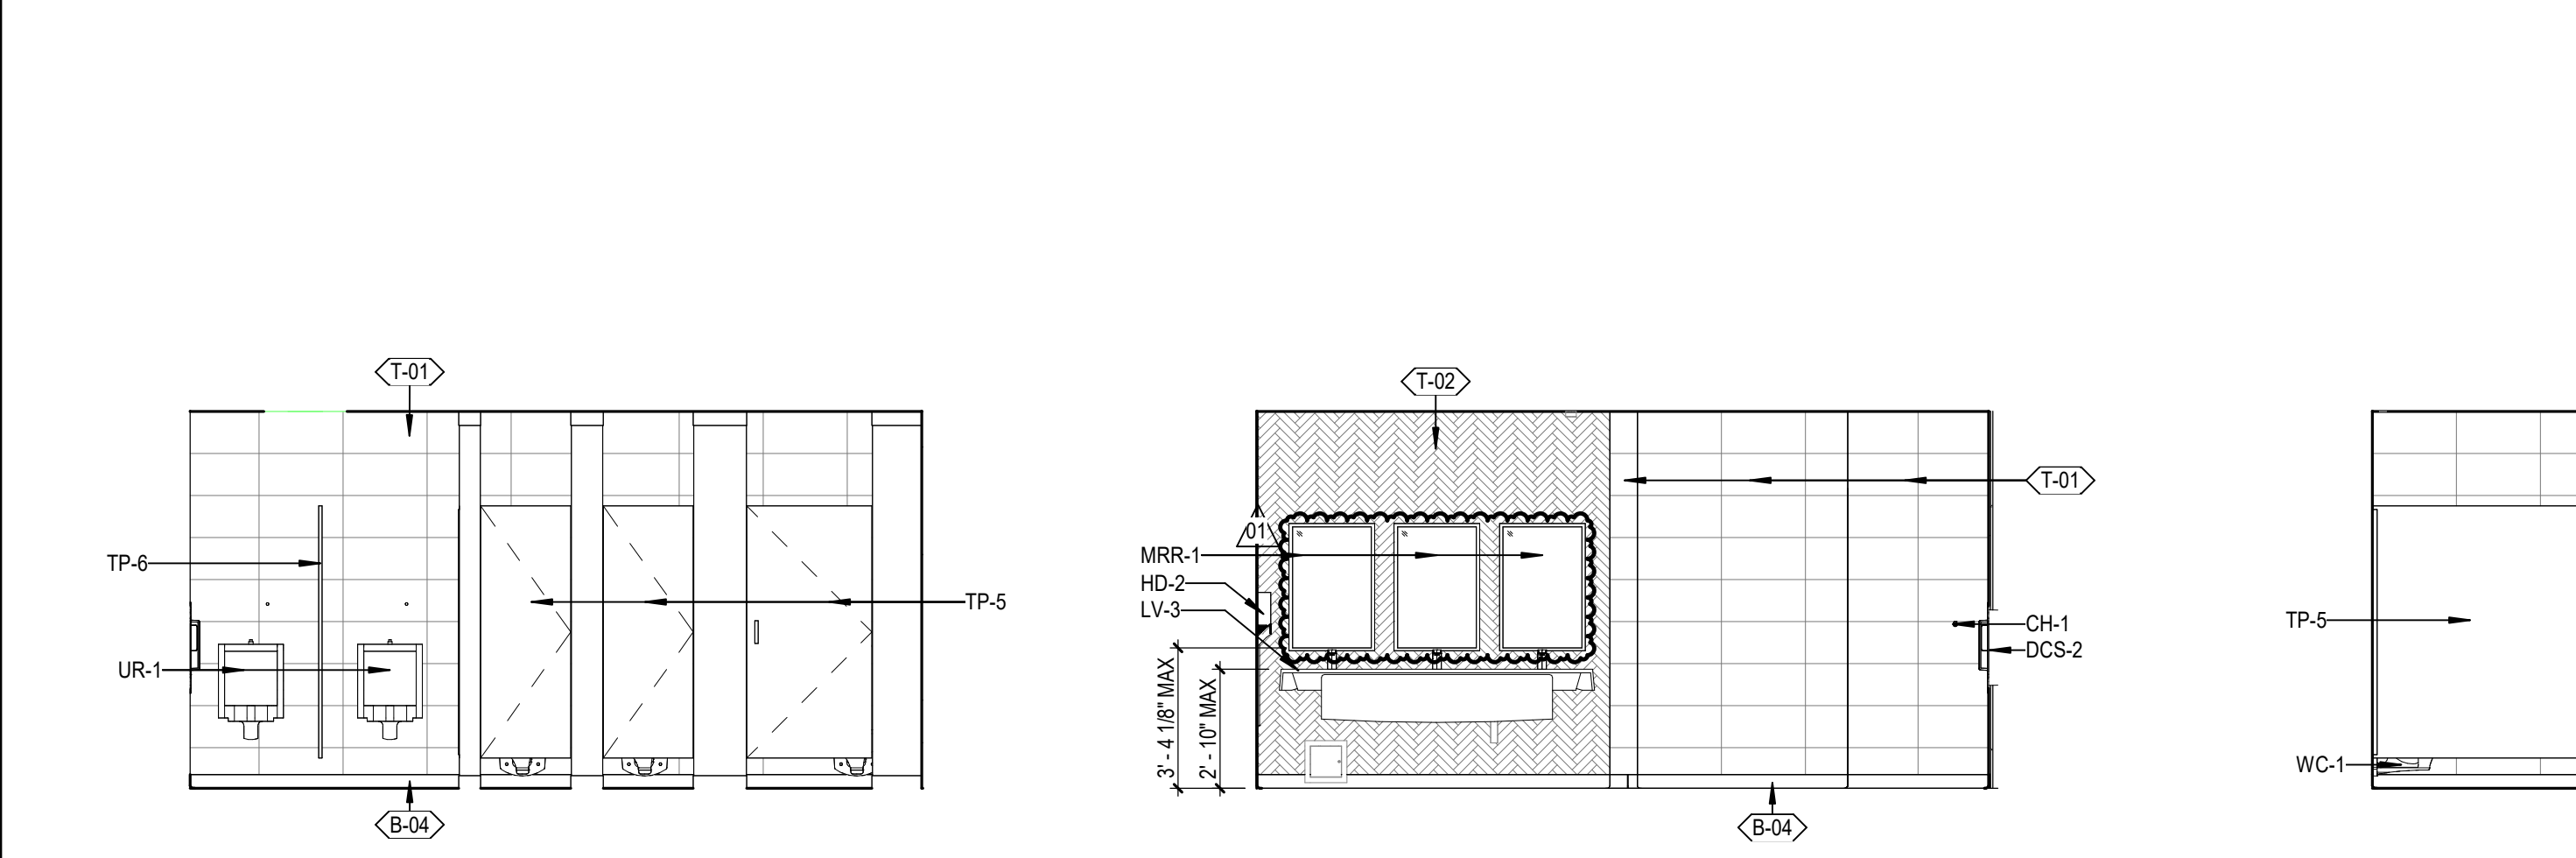


3A A173 RESTROOM - SOUTH
A2.15 SCALE: 1/4" = 1'-0"

3B A173 RESTROOM - NORTH
A2.15 SCALE: 1/4" = 1'-0"


3C A173 RESTROOM - WEST
A2.15 SCALE: 1/4" = 1'-0"

3D A173 RESTROOM - EAST
A2.15 SCALE: 1/4" = 1'-0"

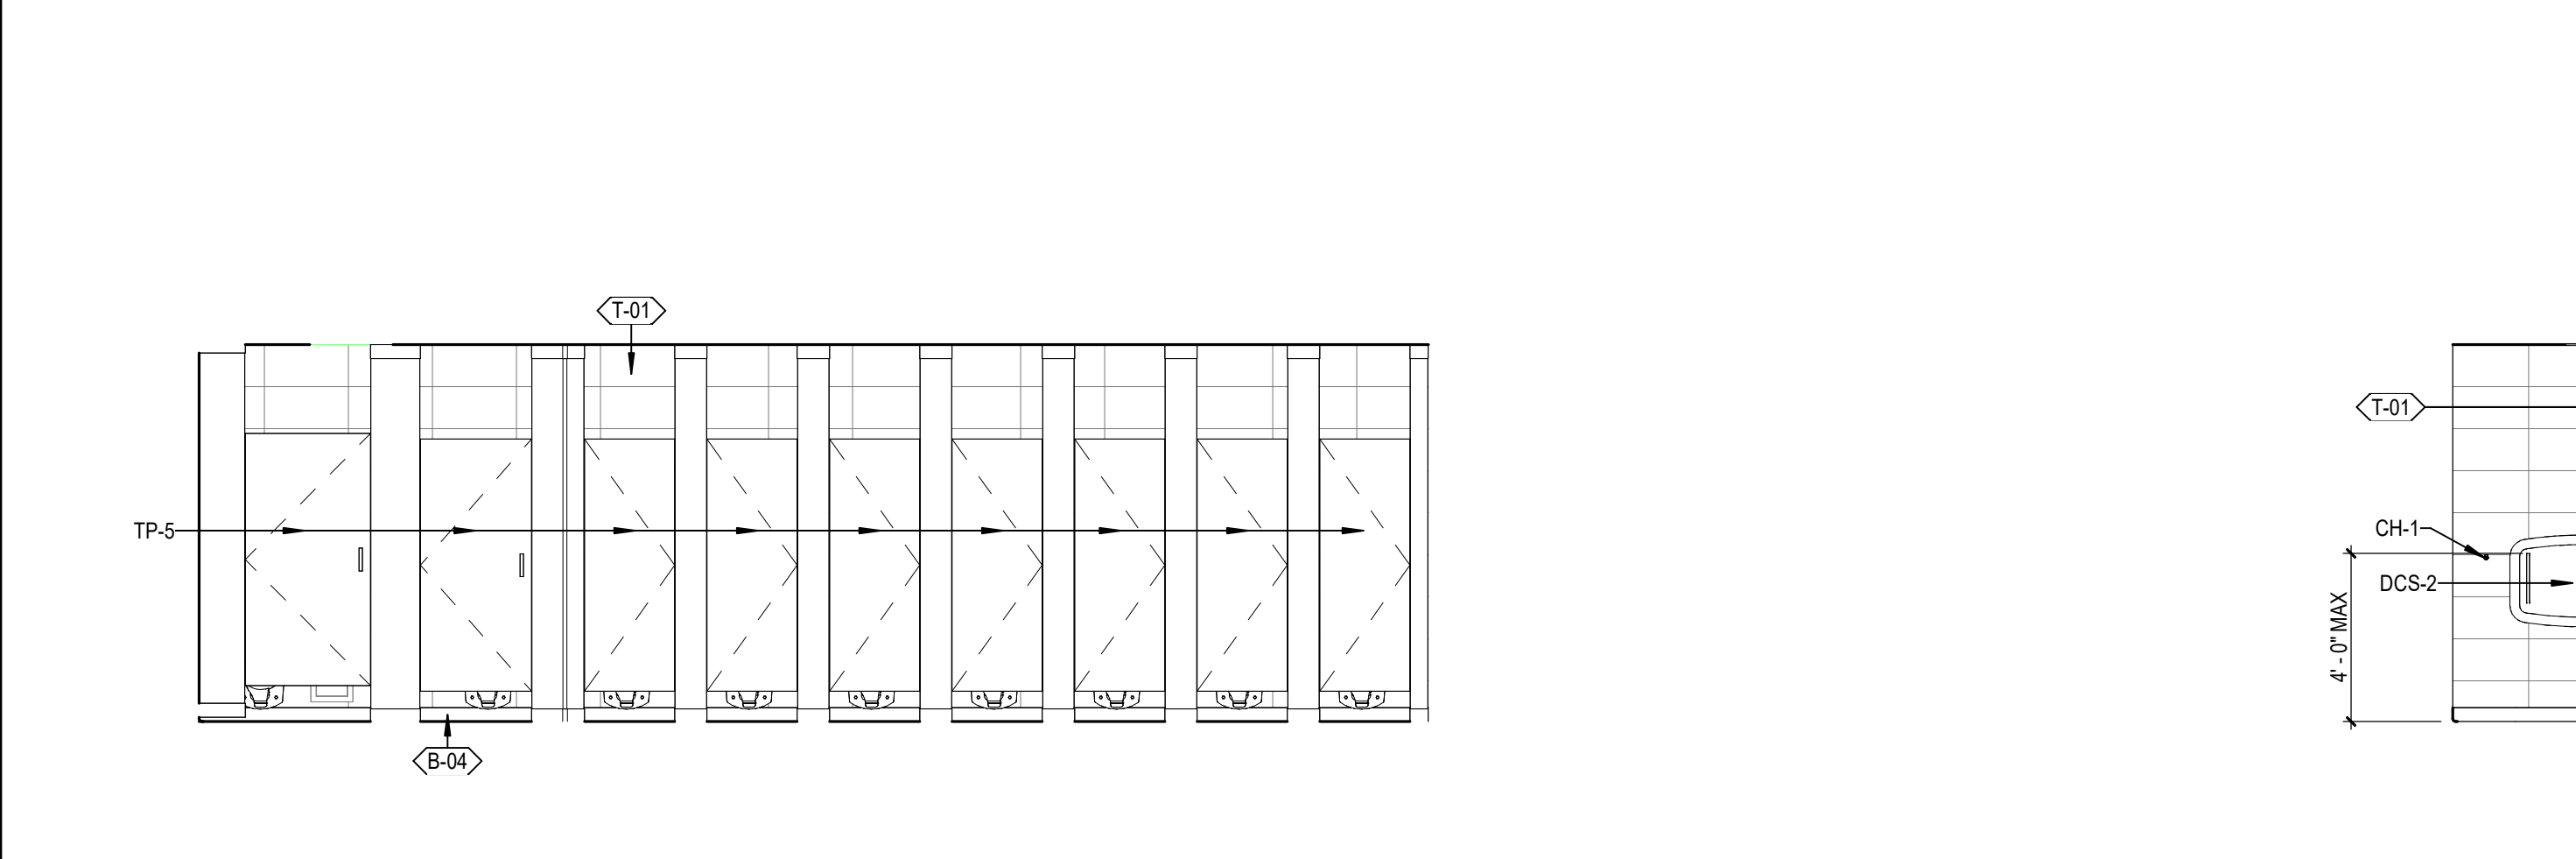

4A A171 RESTROOM - SOUTH
A2.15 SCALE: 1/4" = 1'-0"

4C A171 RESTROOM - NORTH
A2.15 SCALE: 1/4" = 1'-0"

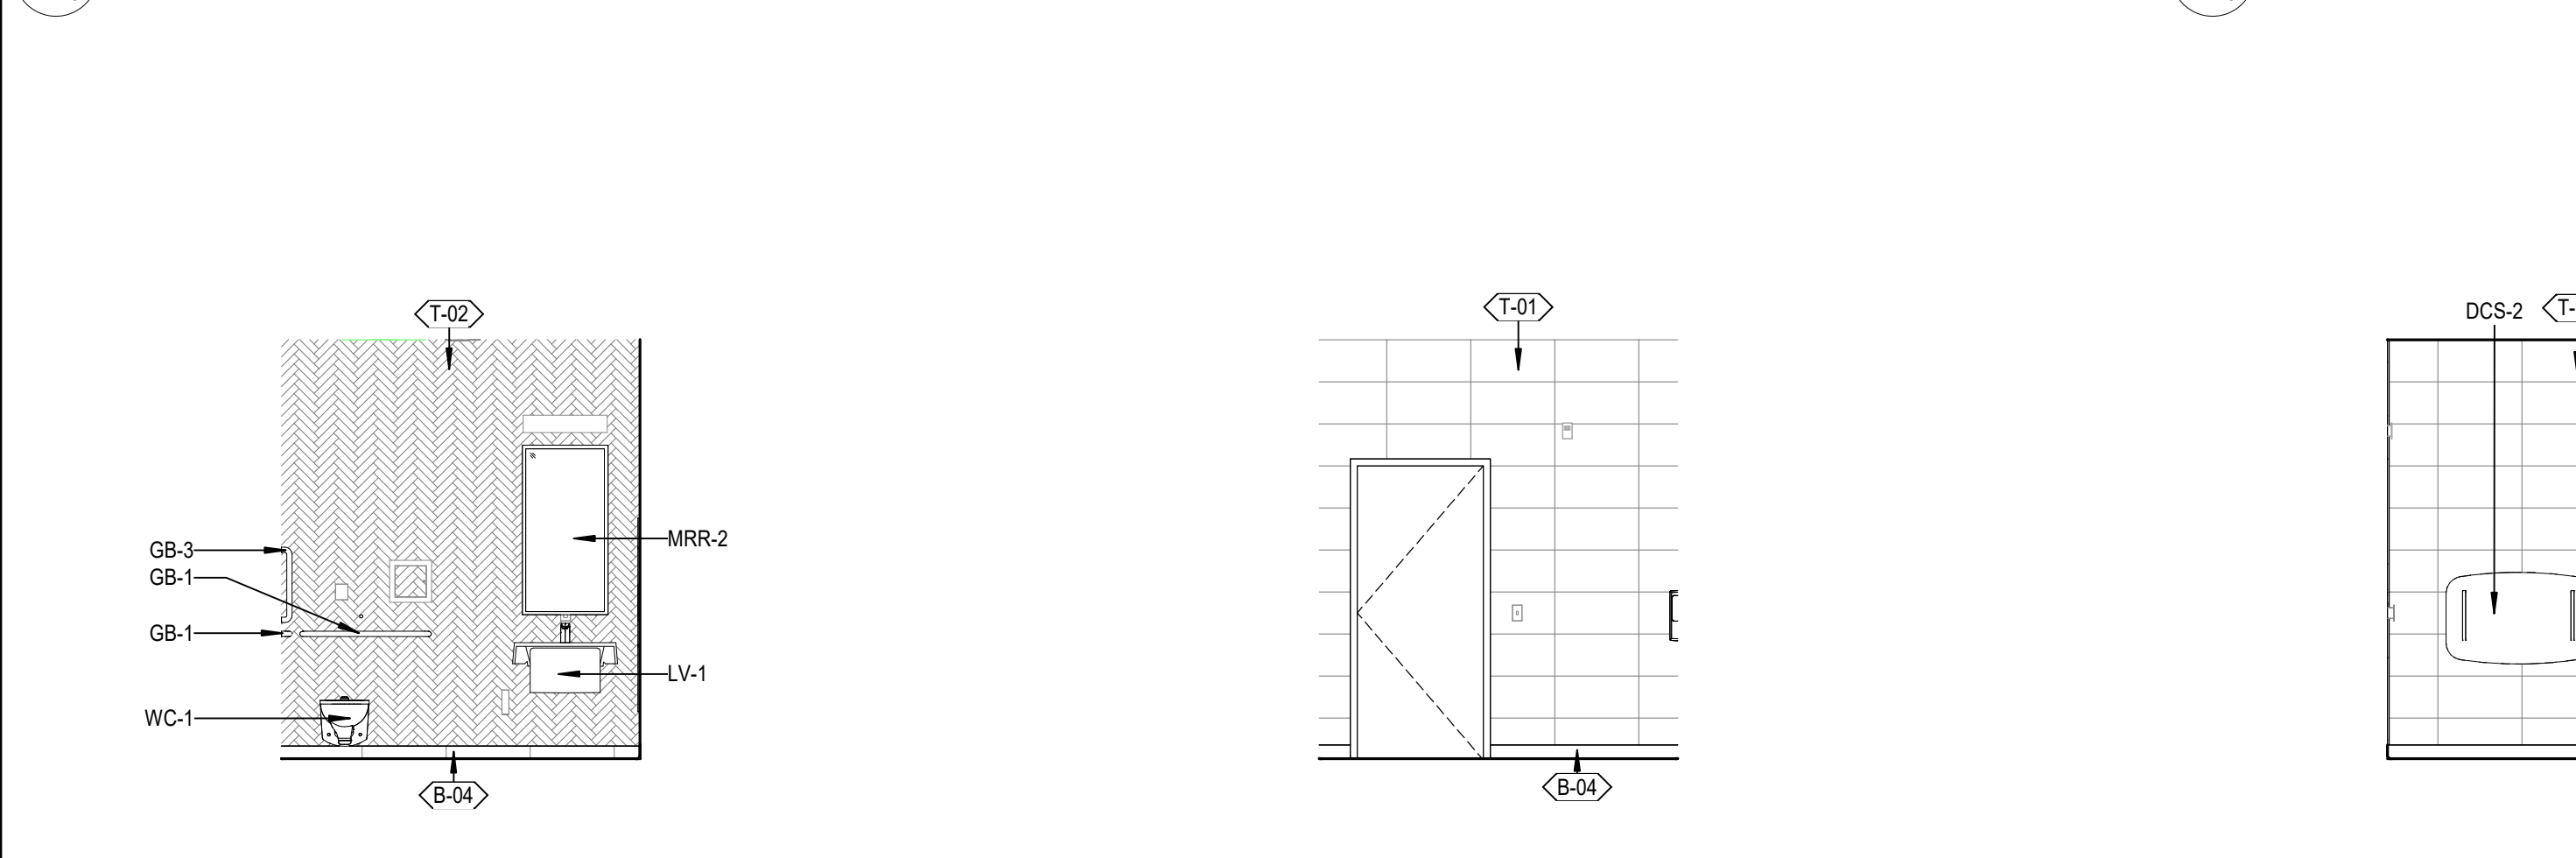


5A A167 RESTROOM - WEST
A2.15 SCALE: 1/4" = 1'-0"


5B A167 RESTROOM - EAST
A2.15 SCALE: 1/4" = 1'-0"

5C A167 RESTROOM - SOUTH
A2.15 SCALE: 1/4" = 1'-0"


5D A167 RESTROOM - NORTH
A2.15 SCALE: 1/4" = 1'-0"

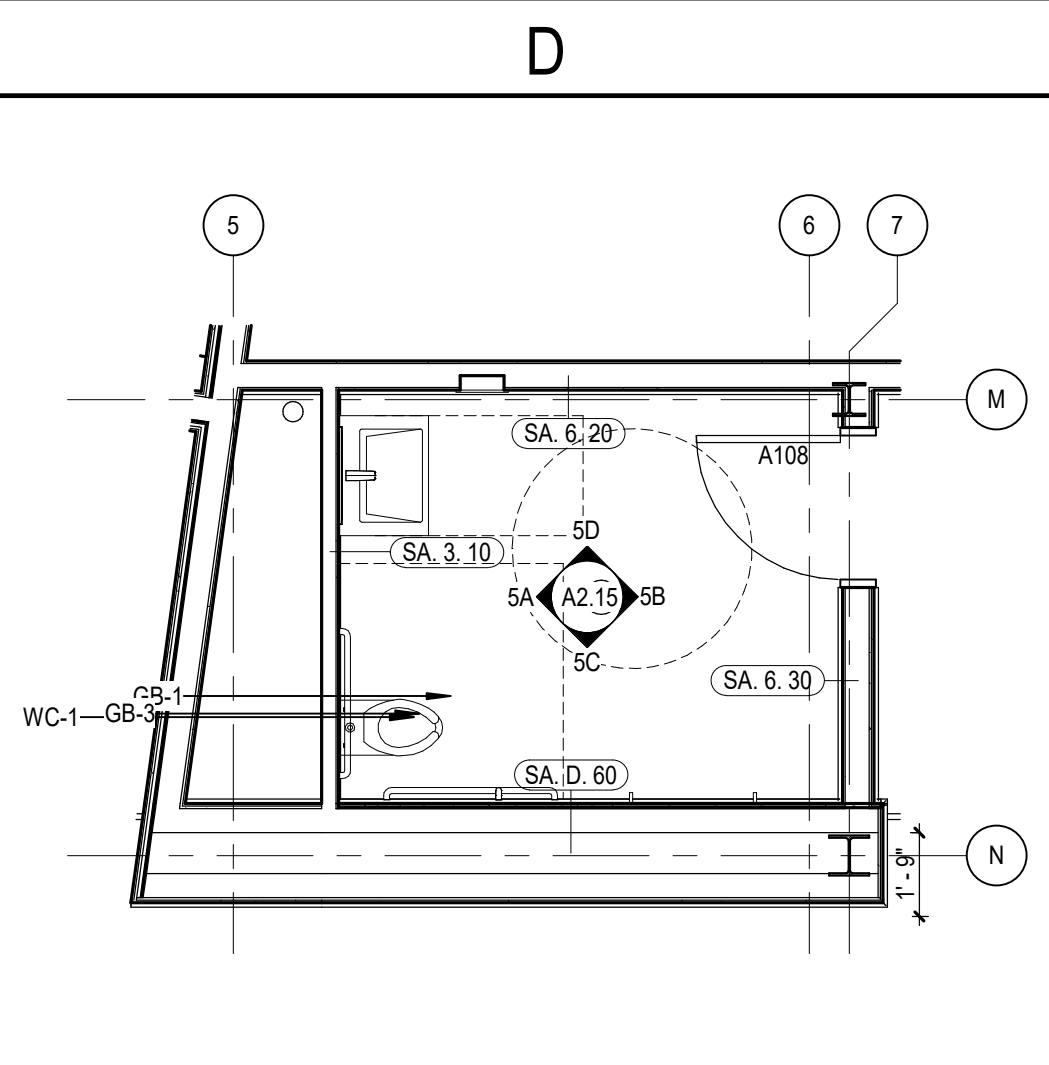

1D ENLARGED RESTROOM A108
A2.15 SCALE: 1/4" = 1'-0"

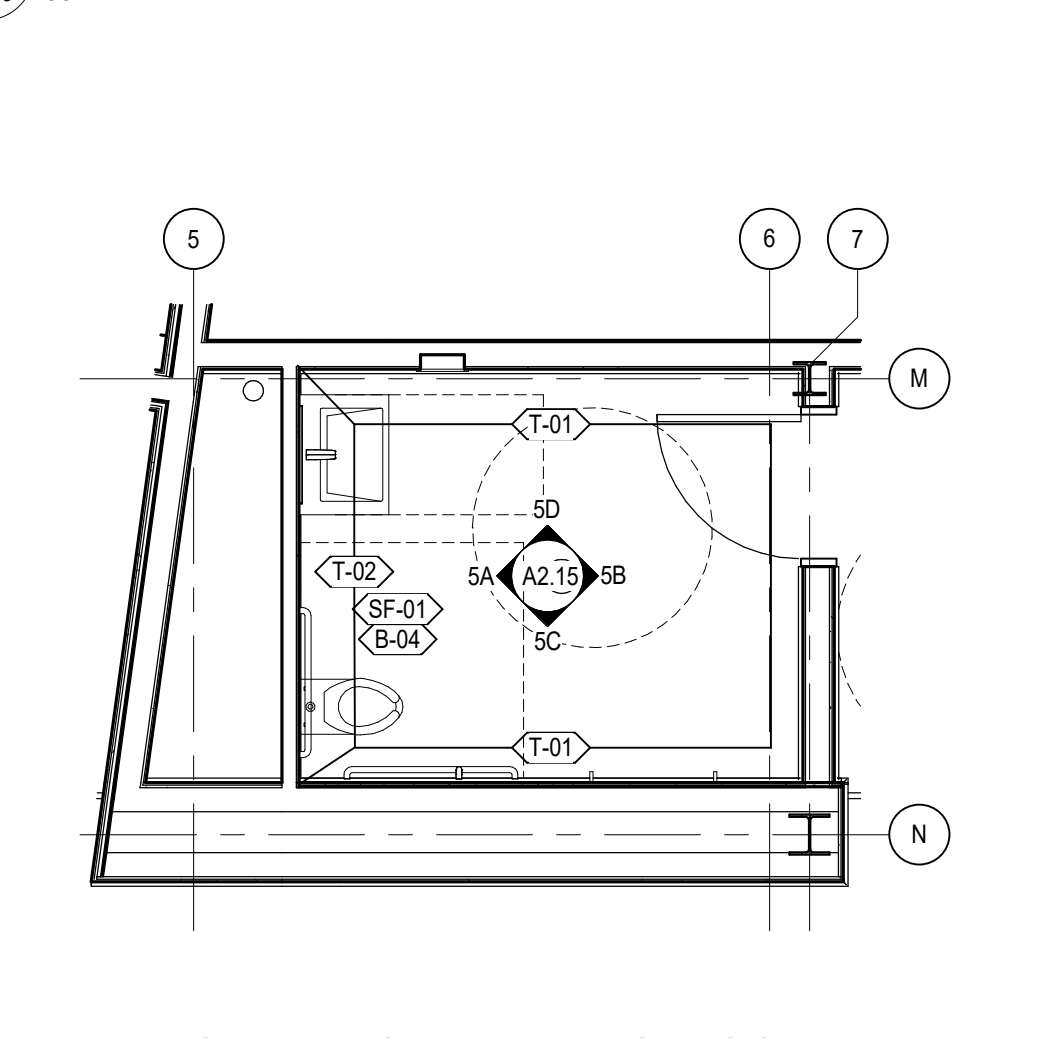

2D ENLARGED FINISH PLAN RESTROOM A108
A2.15 SCALE: 1/4" = 1'-0"

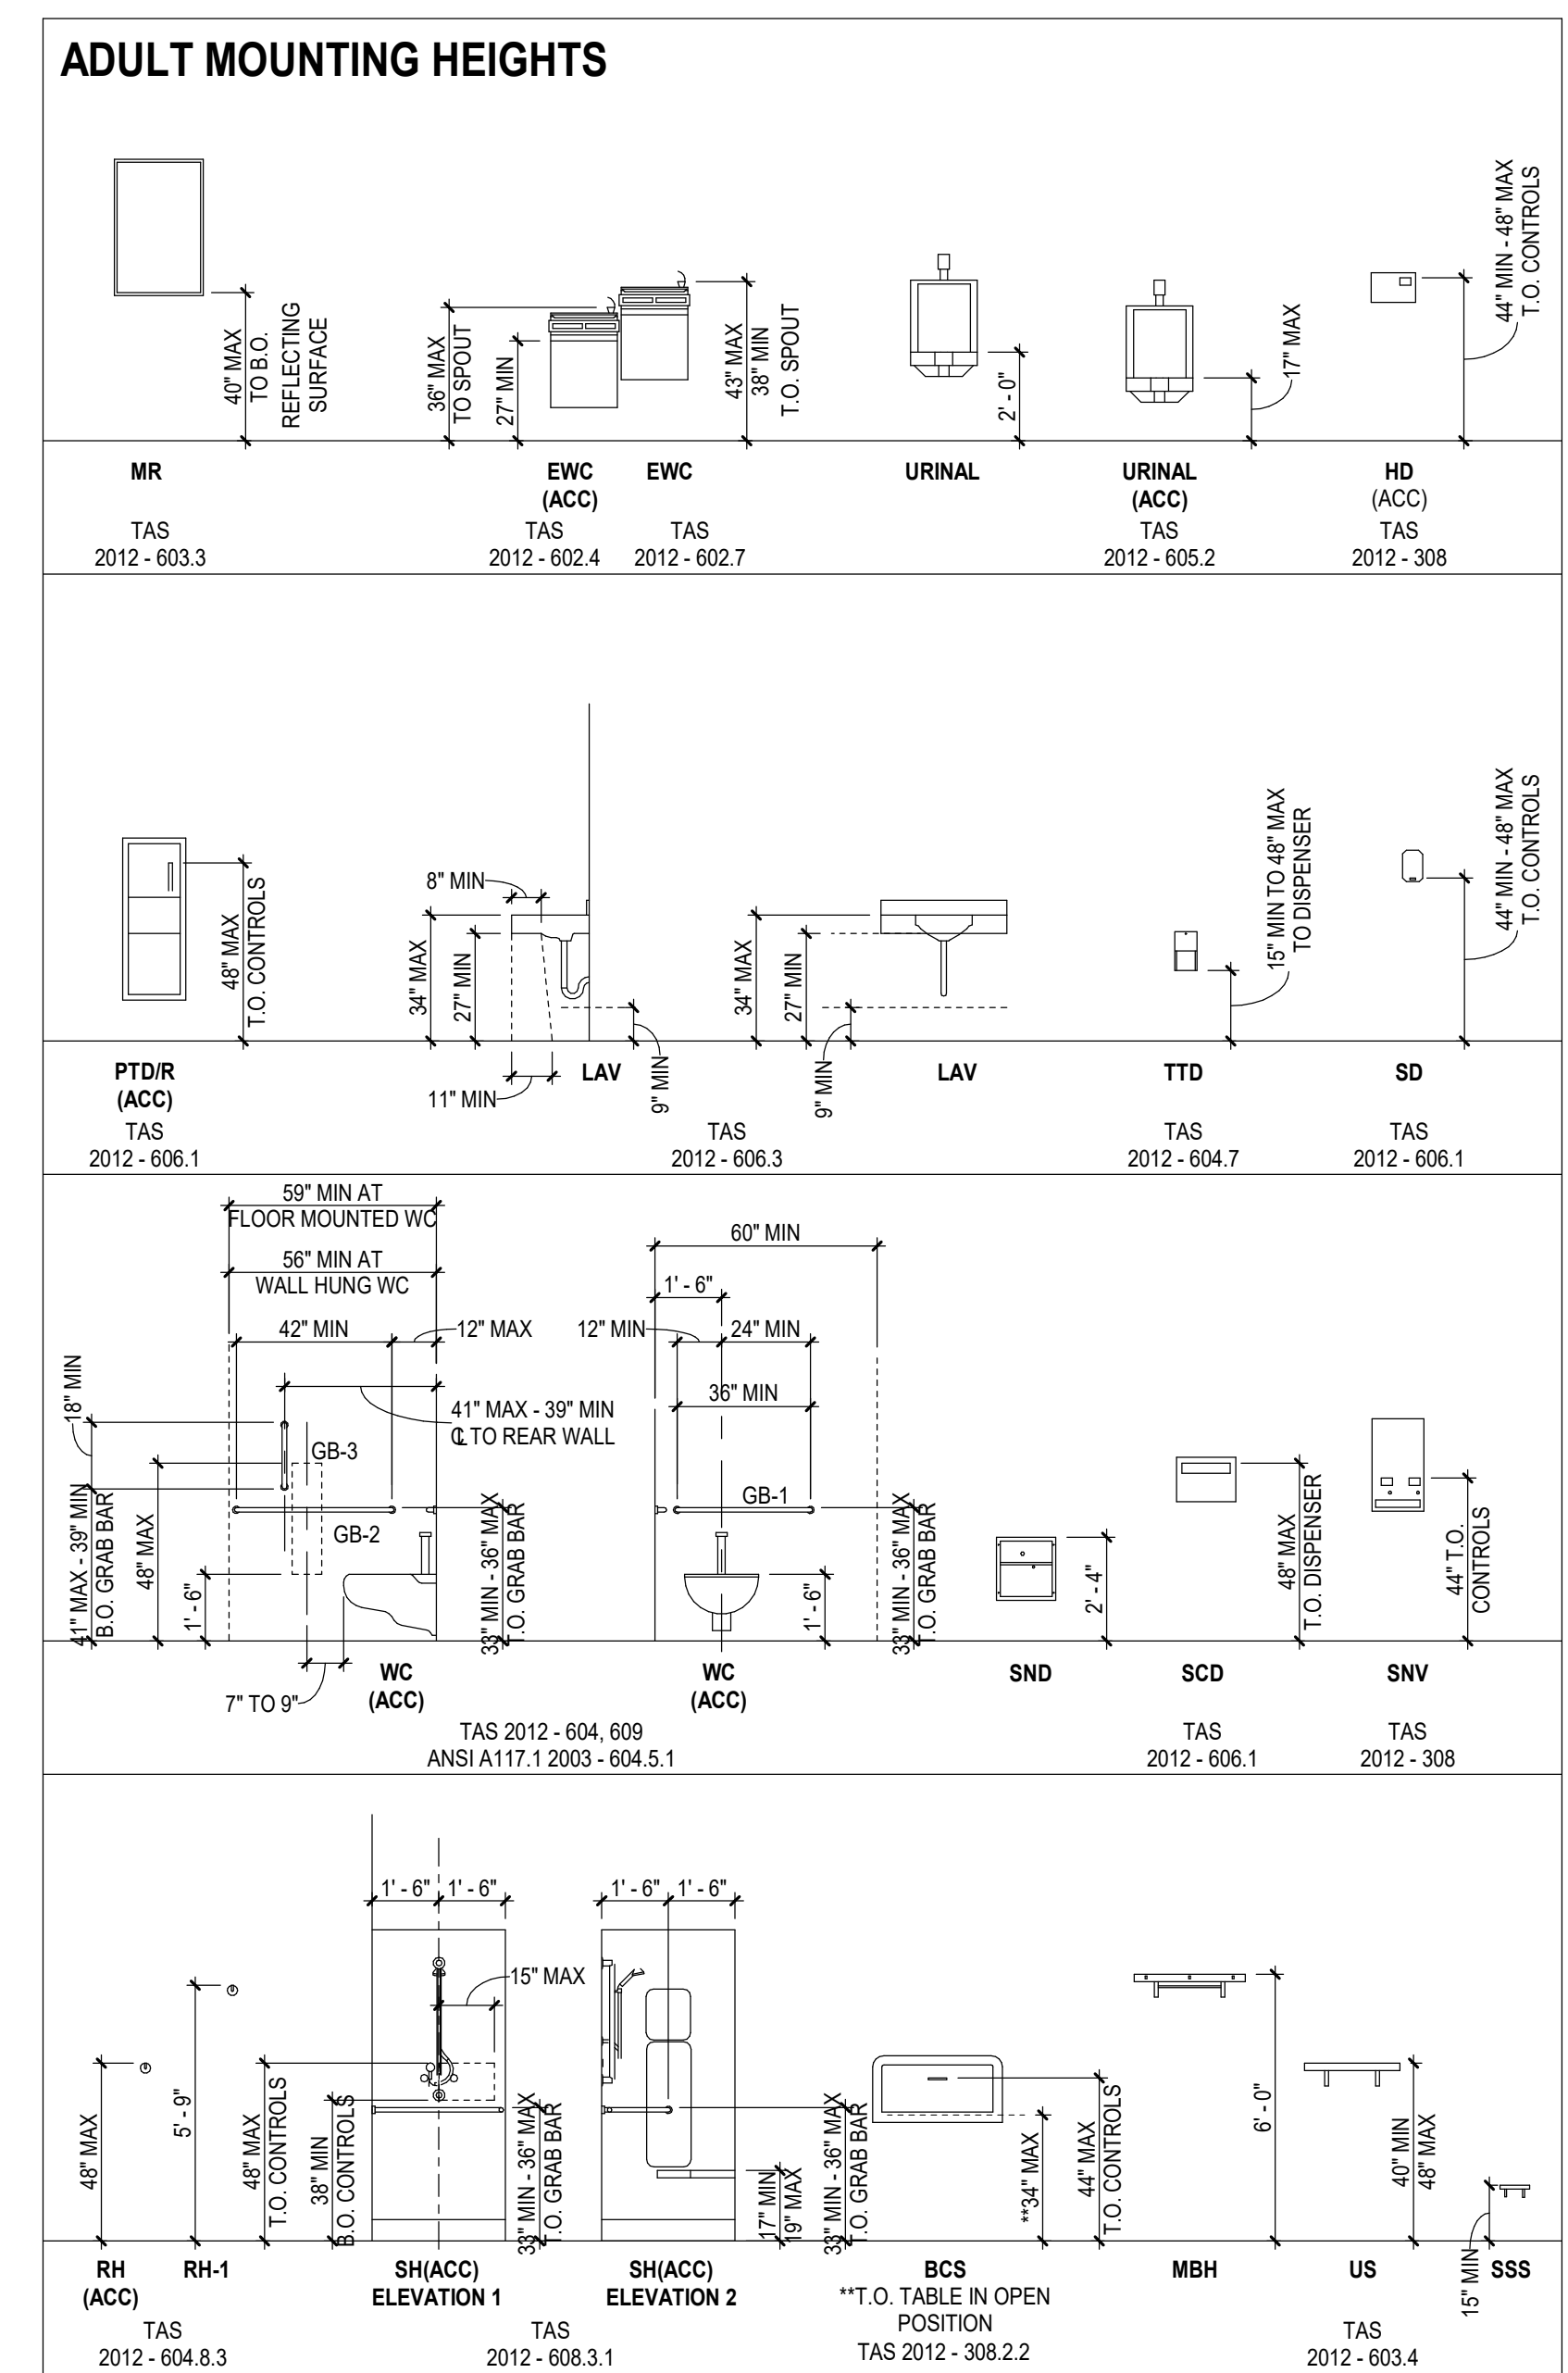

- REFERENCE KEYNOTES**
- CH-1 COAT HOOK
 - CH-2 COAT HOOK
 - DCS-2 DIAPER CHANGING STATION - STAINLESS STEEL
 - GB-1 HORIZONTAL GRAB BAR - 36"
 - GB-3 VERTICAL GRAB BAR - 18"
 - HD-2 HAND DRYER - HIGH SPEED
 - LV-1 LAVATORY - SINGLE TROUGH
 - LV-2 LAVATORY - 2 FIXTURE TROUGH
 - LV-3 LAVATORY - 3 FIXTURE TROUGH
 - MRR-1 MIRROR
 - MRR-2 MIRROR WITH SHELF
 - PTDWR-1 PAPER TOWEL DISPENSER AND WASTE RECEPTACLE - SURFACE MOUNTED
 - TP-5 PHENOLIC TOILET PARTITION
 - TP-6 PHENOLIC URINAL PARTITION
 - UR-1 URINAL
 - WC-1 TOILET - WALL MOUNT
 - WR-1 WATER REPELLENT




CRANDALL ISD HIGH SCHOOL
PAC ADDITION
13385 Fm 3038, Crandall, TX 75114

ISSUE FOR BID AND PERMIT
2024.07.25
REVISIONS
01 08/19/24 ADDENDUM 01


39-23712-00
ENLARGED RESTROOM PLANS AND ELEVATIONS - FRONT OF HOUSE

A2.15

Autodesk Docs://99-23712-00_Crandall ISD - PAC/39-23712-00_Crandall ISD_AR_2024.rvt
8/9/2024 7:52:50 PM

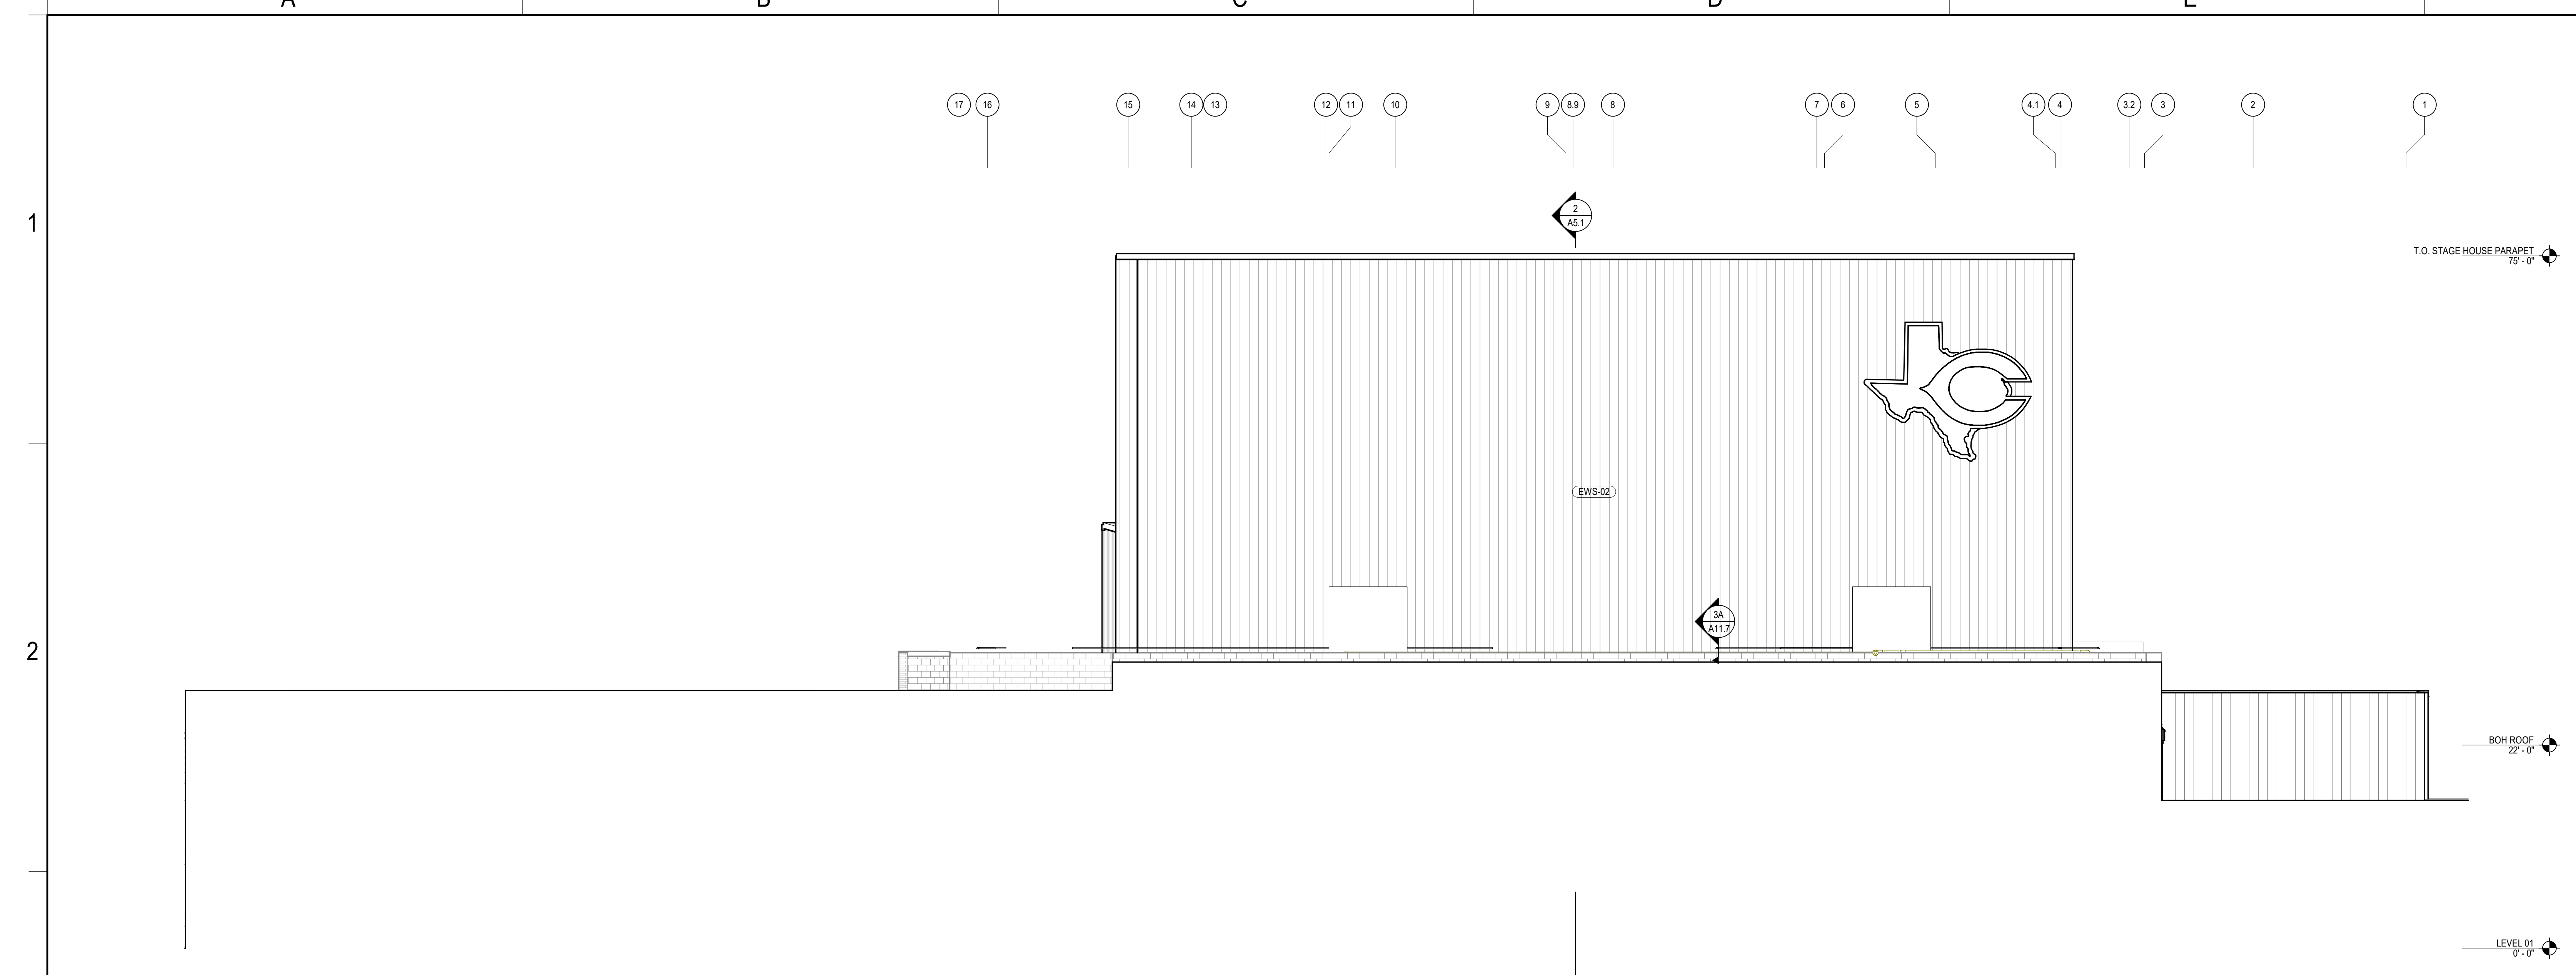


3A NORTH BUILDING ELEVATION
 A4.1 SCALE: 1/8" = 1'-0"

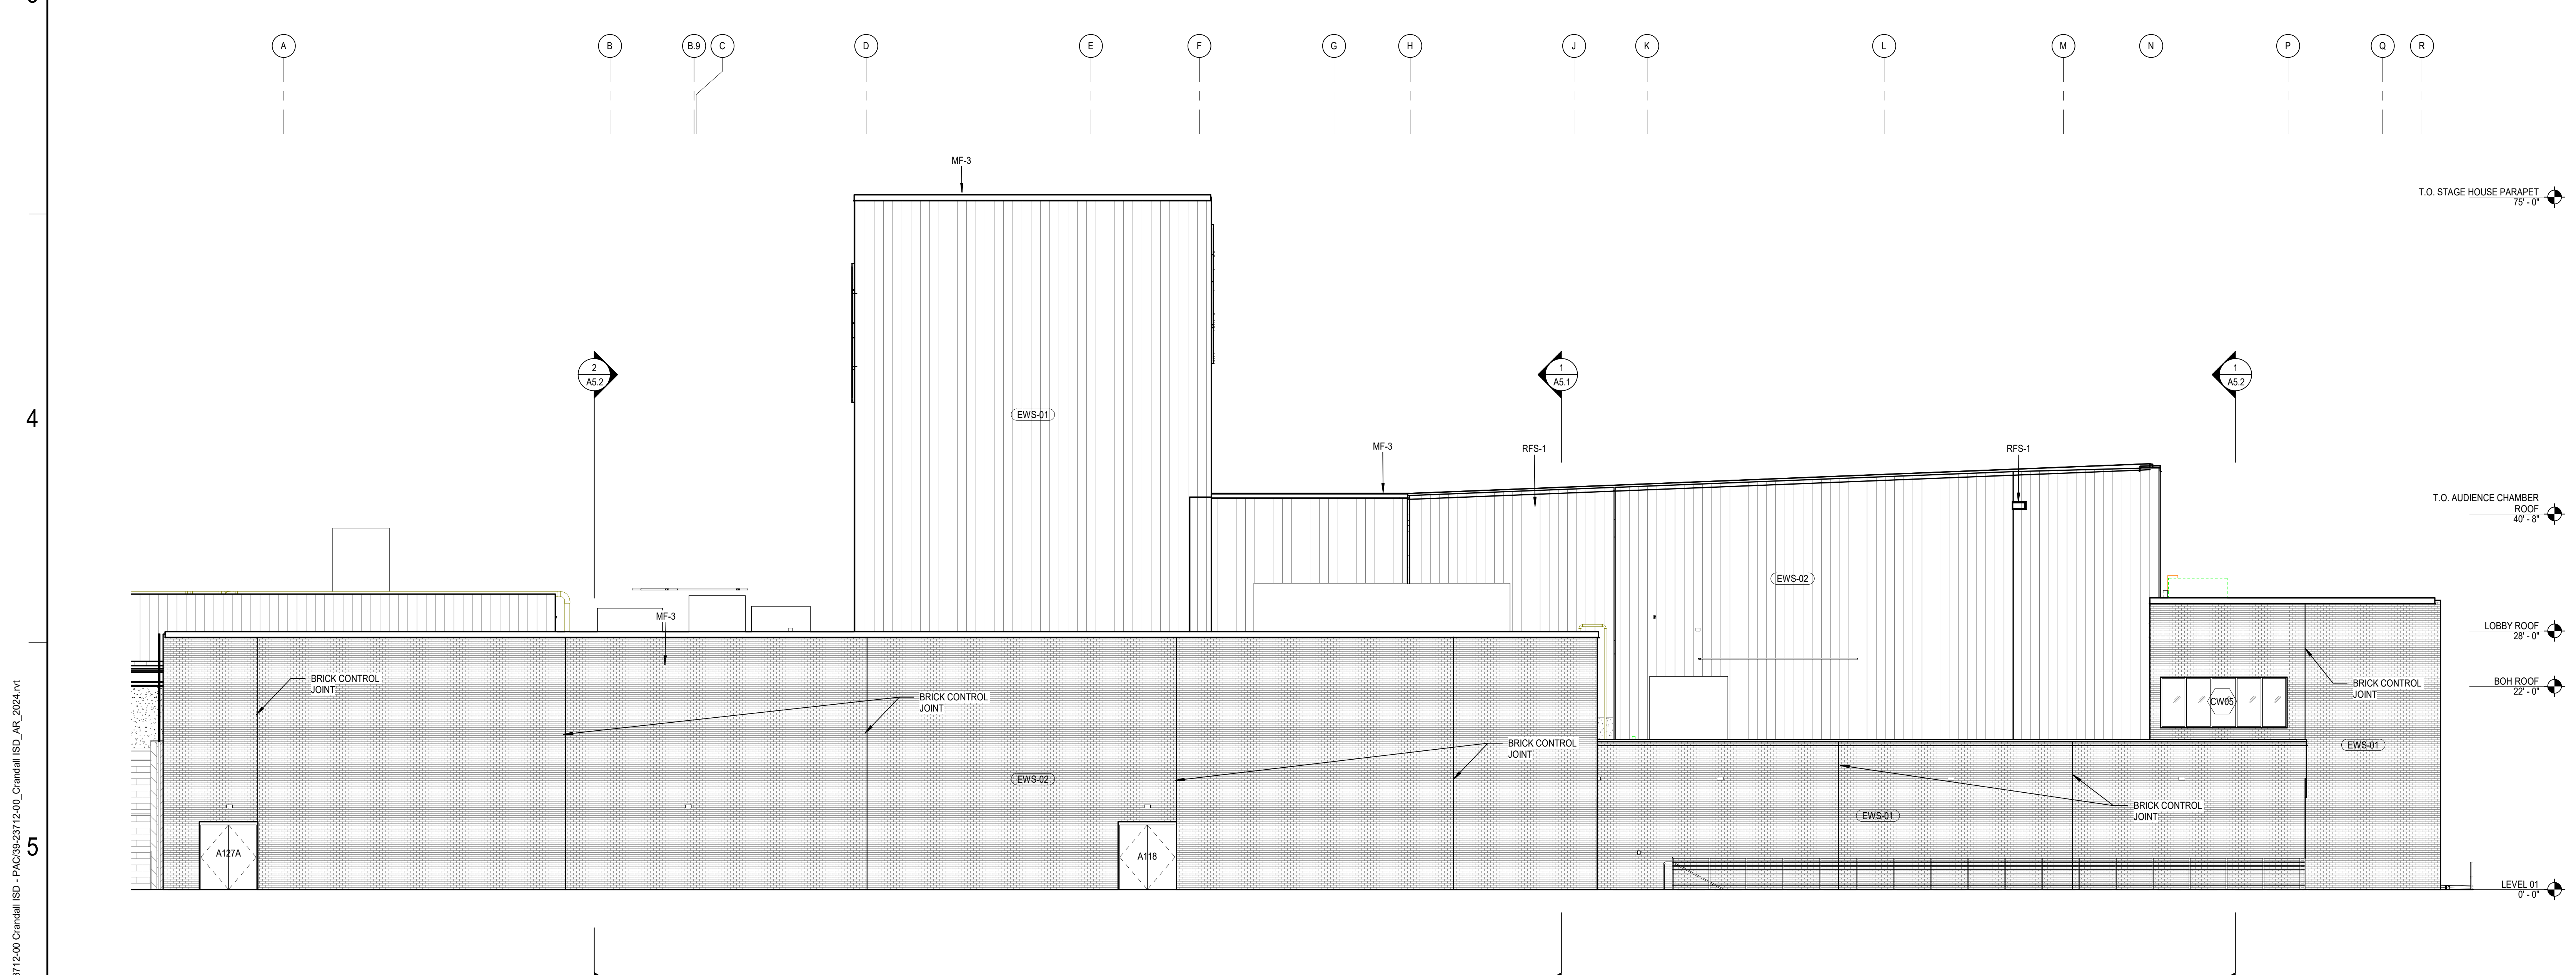

5A WEST BUILDING ELEVATION
 A4.1 SCALE: 1/8" = 1'-0"

REFERENCE KEYNOTES

| | |
|-------|---|
| MF-3 | PREFINISHED SHEET METAL PARAPET CAP W/ CONT CLEAT |
| RFS-1 | ROOF SCUPPER |

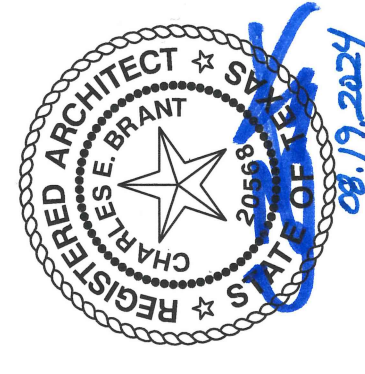

CRANDALL ISD HIGH SCHOOL
 PAC ADDITION
 13385 Fm 3039, Crandall, TX 75114

ISSUE FOR BID AND PERMIT
 2024.07.25
 REVISIONS
 01 08/19/24 ADDENDUM 01

39-23712-00
 EXTERIOR ELEVATIONS

A4.1

Autodesk Docs://99-23712-00_Crandall ISD - PAC/39-23712-00_Crandall ISD_AR_2024.rvt
 8/19/2024 7:53:50 PM

Autodesk Docs://99-23712-00_Crandall ISD - PAC/39-23712-00_Crandall ISD - AR_2024.rvt
8/9/2024 7:54:02 PM

1

2

3

4

5

A


B

C


D

E

F

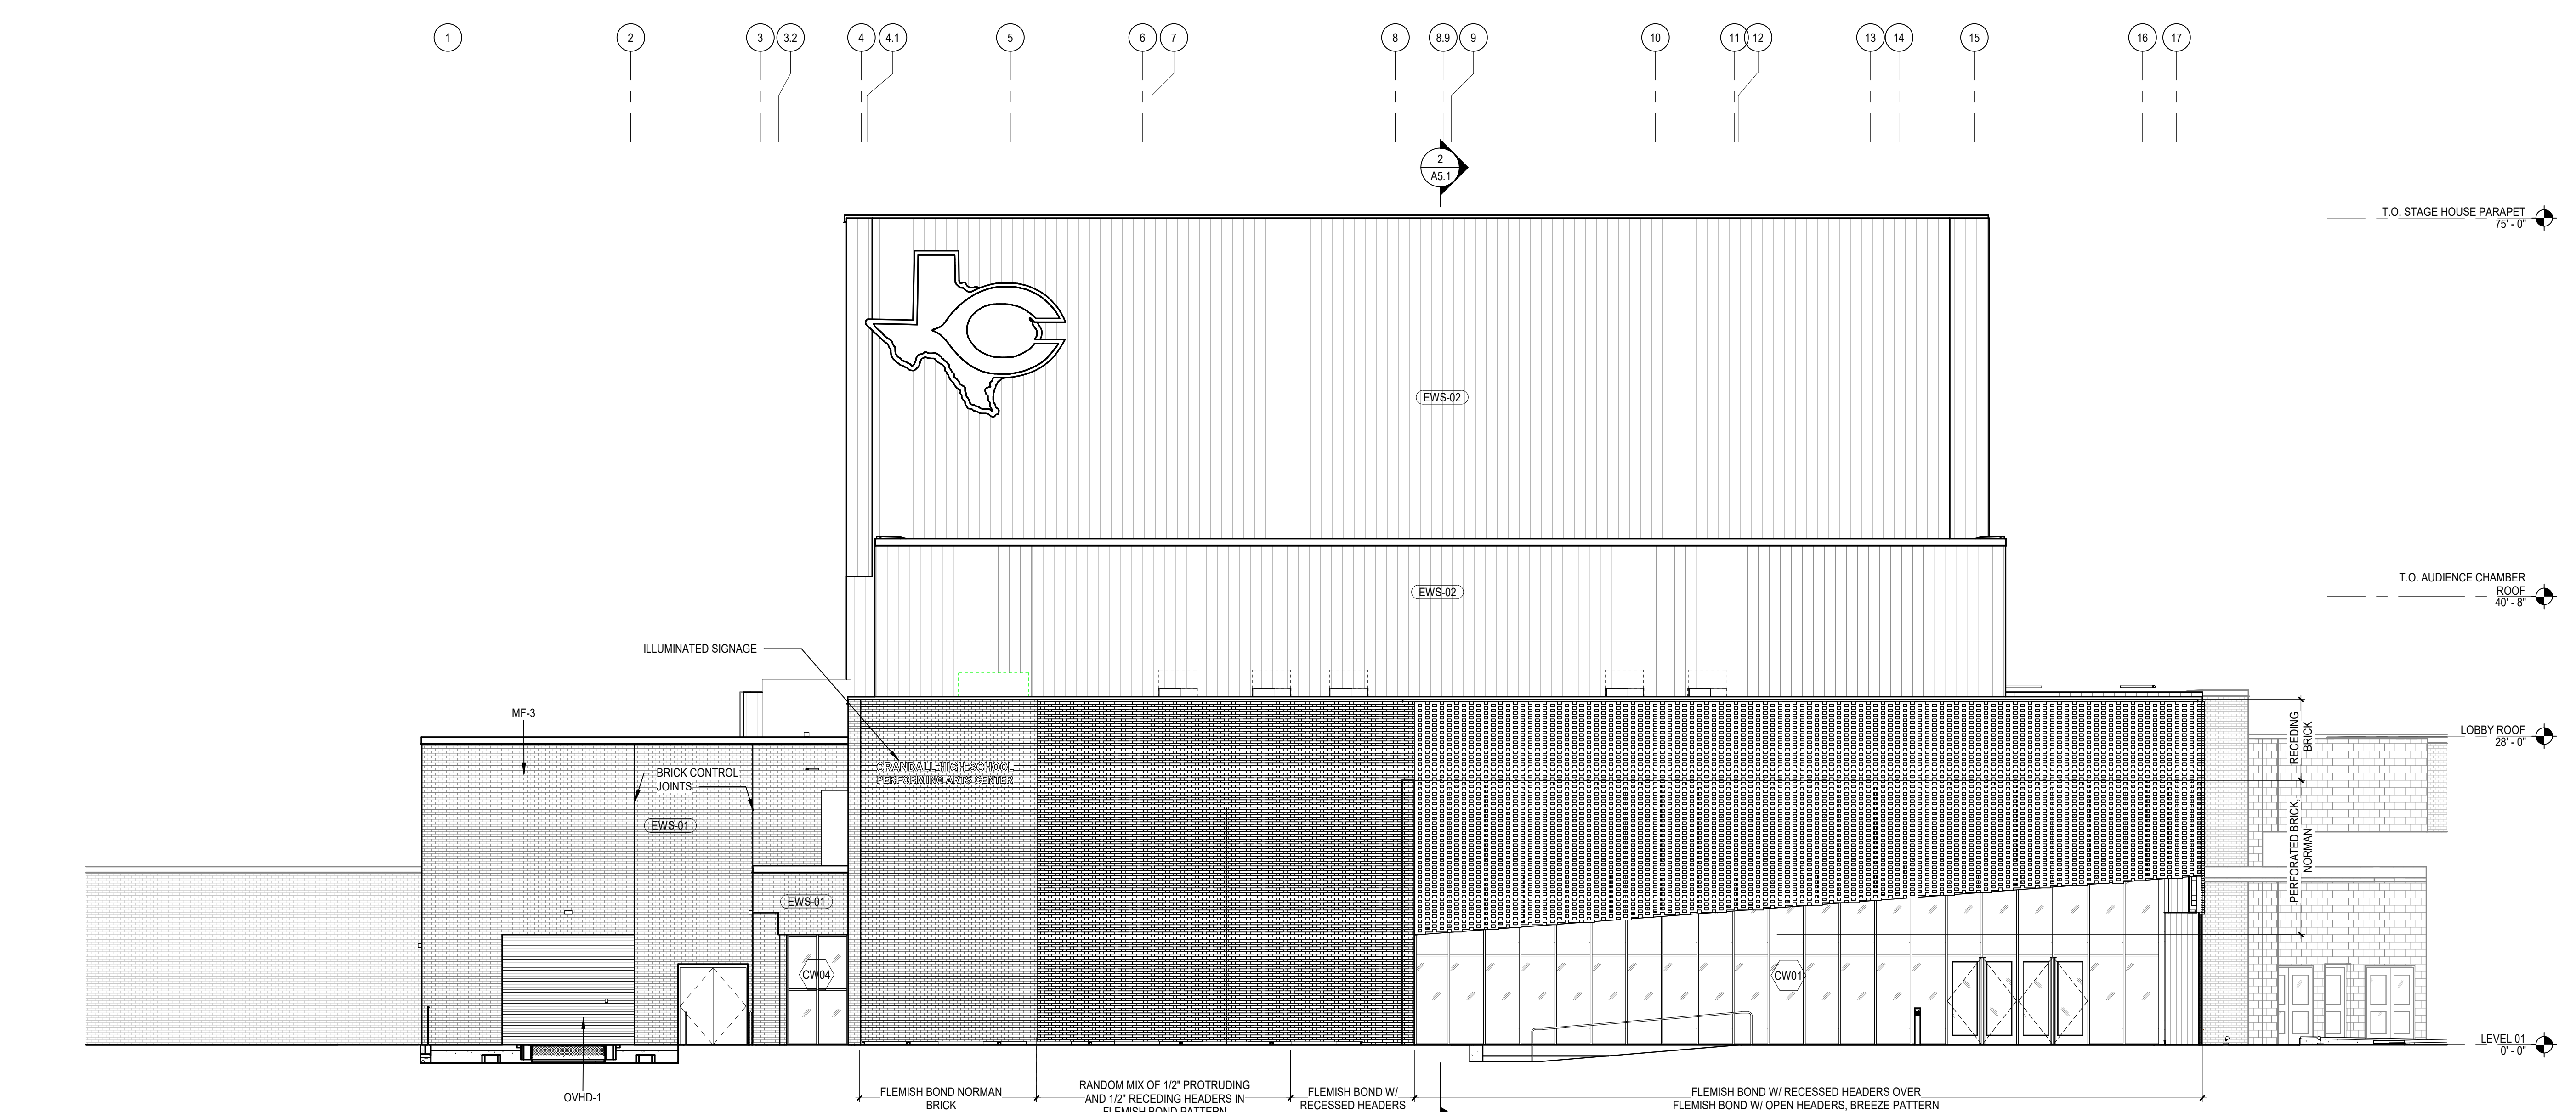


3A SOUTH BUILDING ELEVATION
A4.2 / SCALE: 1/8" = 1'-0"

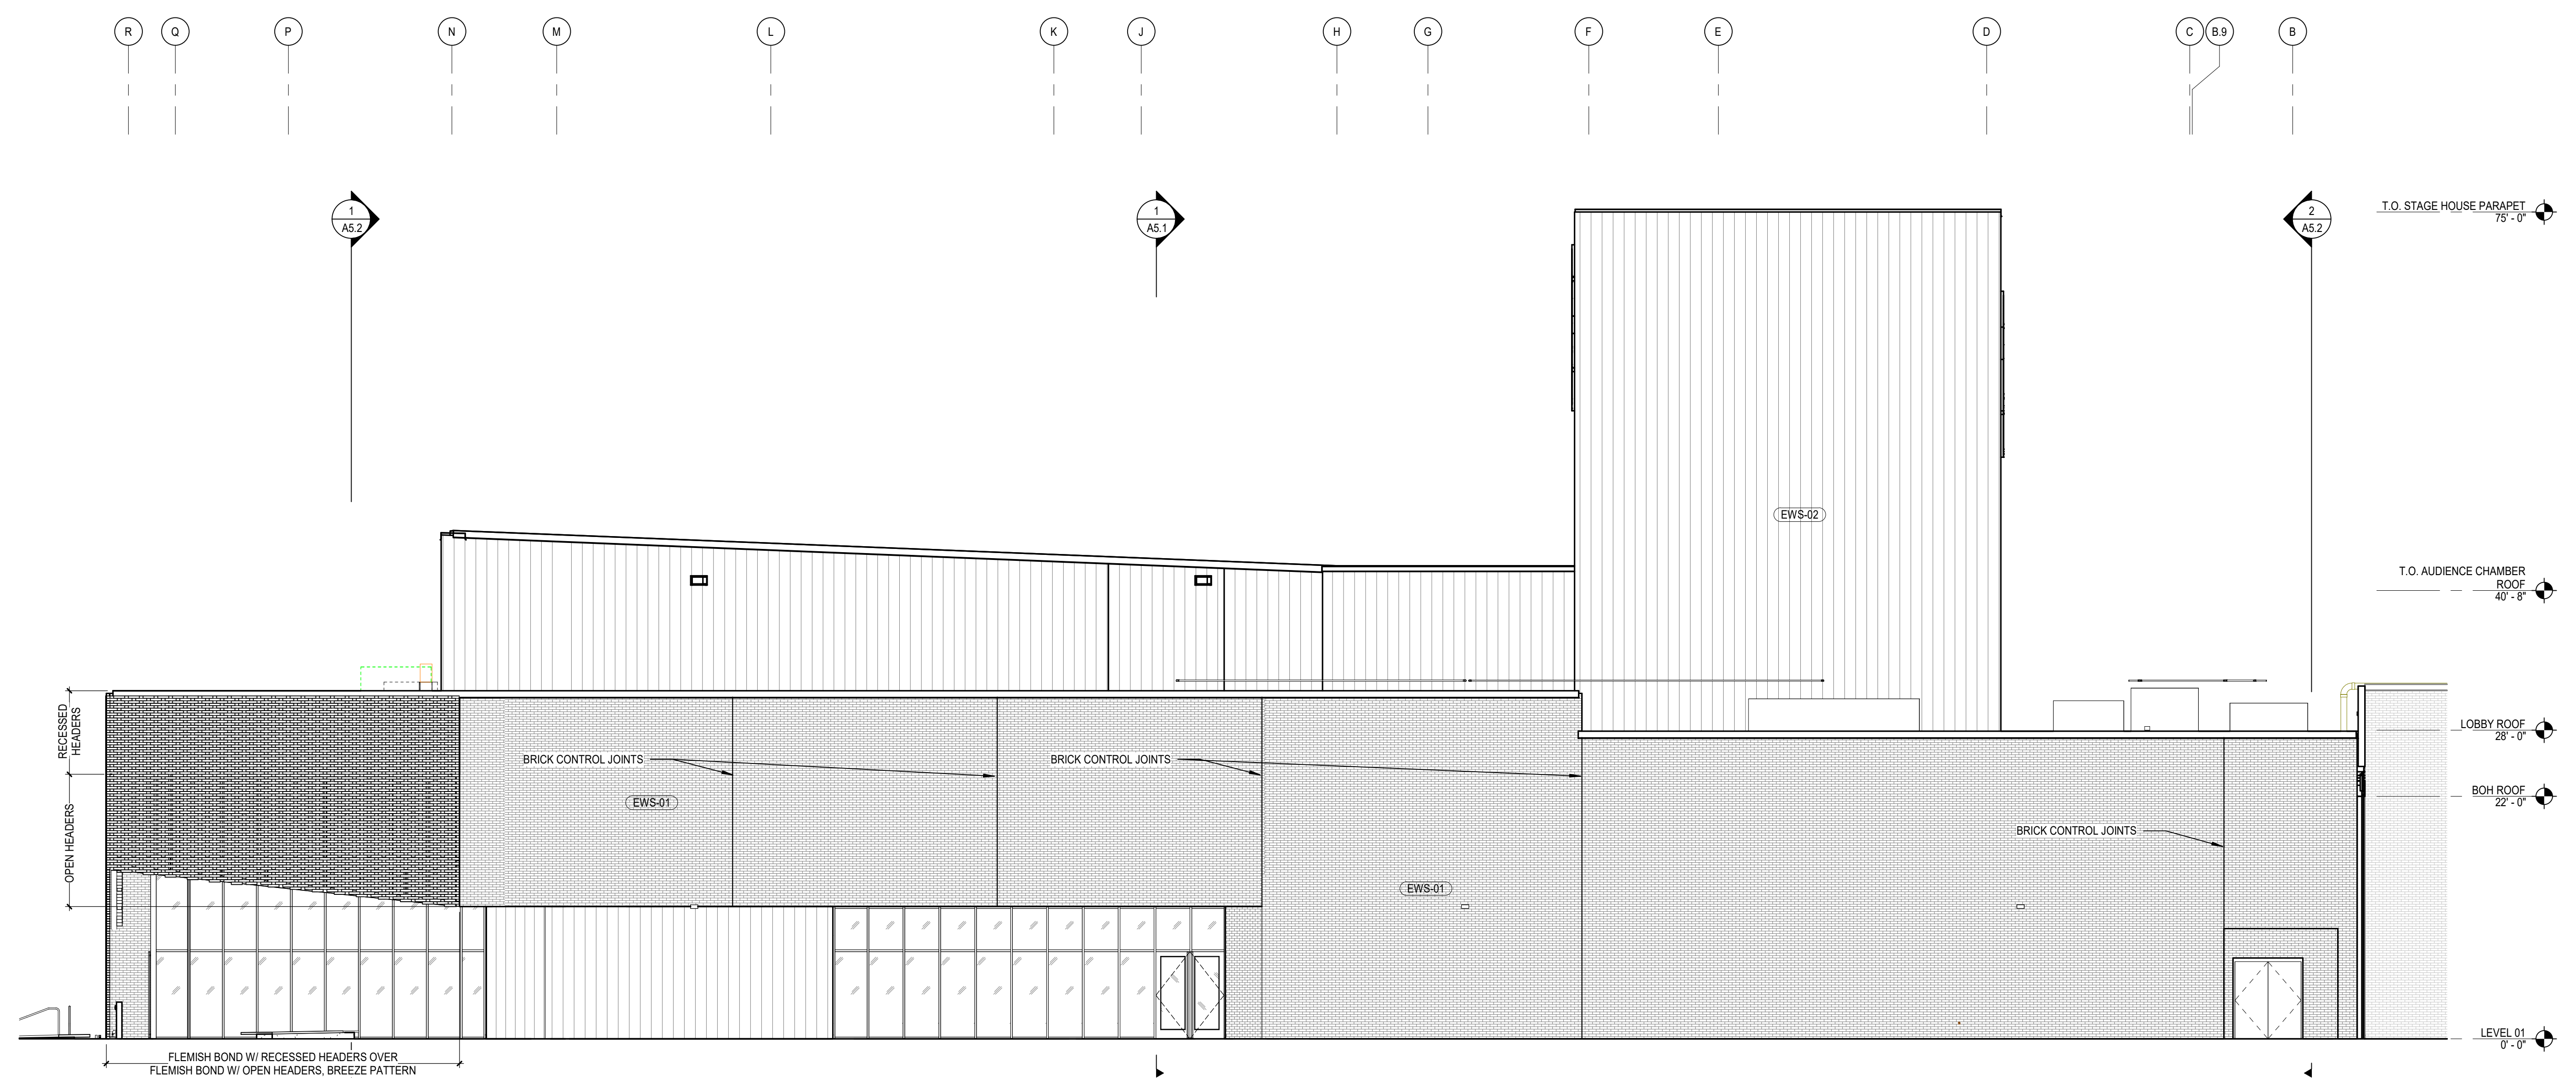

3A EAST BUILDING ELEVATION
A4.2 / SCALE: 1/8" = 1'-0"

REFERENCE KEYNOTES

- MF-3 PREFINISHED SHEET METAL PARAPET CAP W/ CONT CLEAT
- OVHD-1 OVERHEAD COILING DOOR

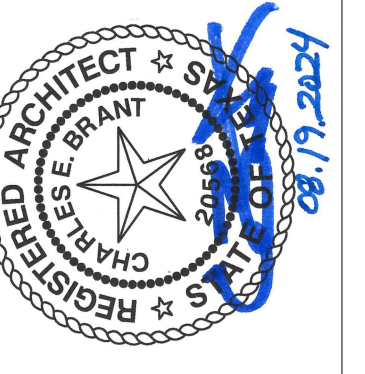


CRANDALL ISD HIGH SCHOOL
PAC ADDITION
13385 Fm 3039, Crandall, TX 75114


ISSUE FOR BID AND PERMIT
2024.07.25
REVISIONS
01 08/19/24 ADDENDUM 01

39-23712-00
EXTERIOR ELEVATIONS


A4.2

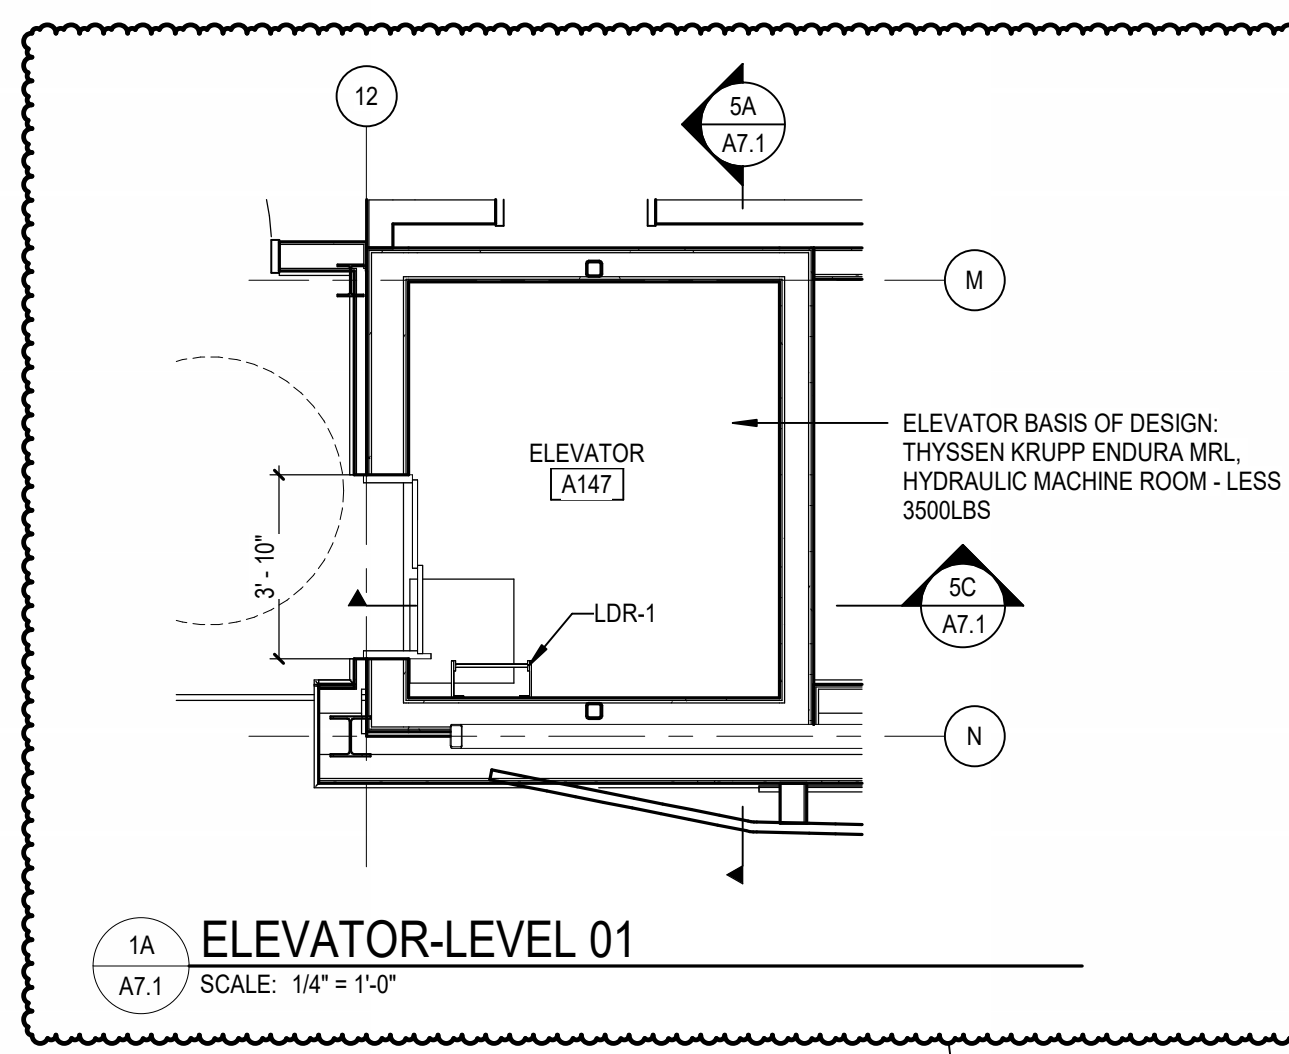


1A ELEVATOR-LEVEL 01
SCALE: 1/4" = 1'-0"

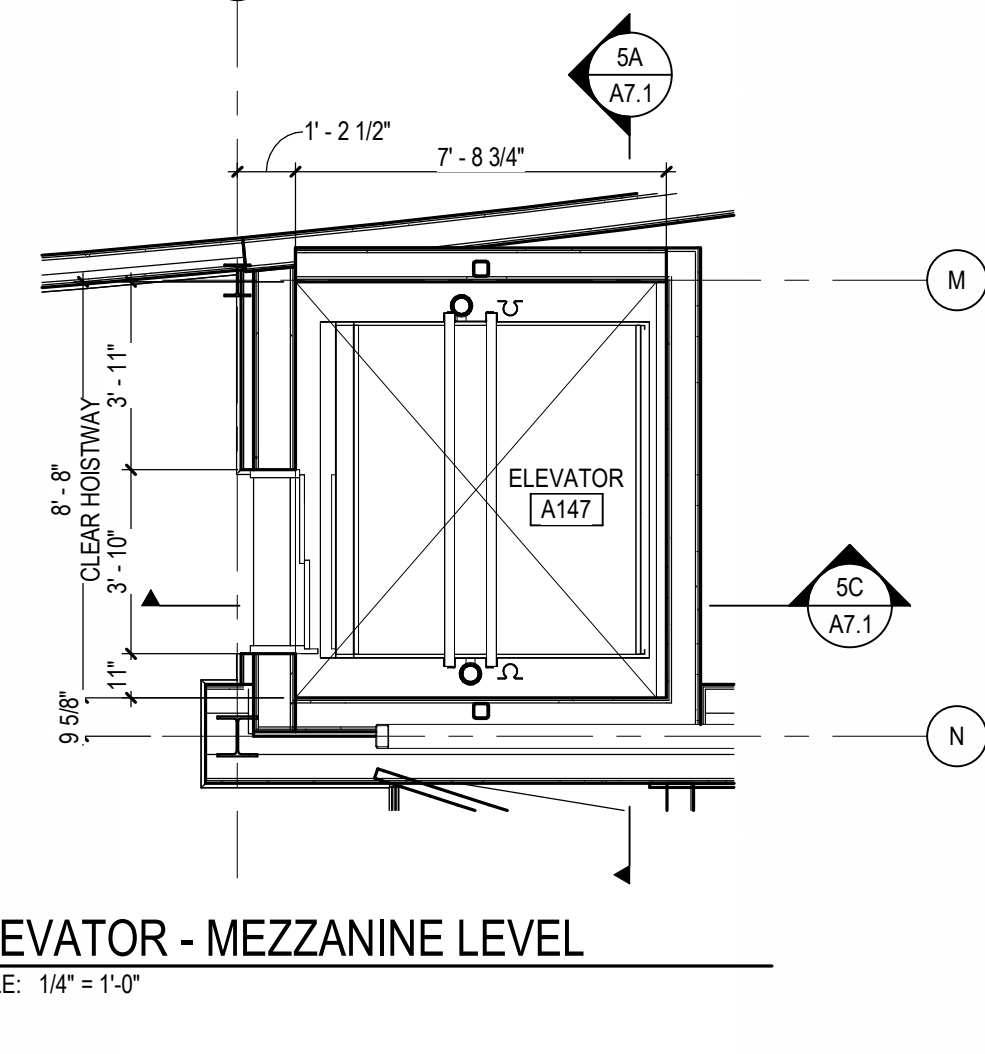


1B ELEVATOR - MEZZANINE LEVEL
SCALE: 1/4" = 1'-0"

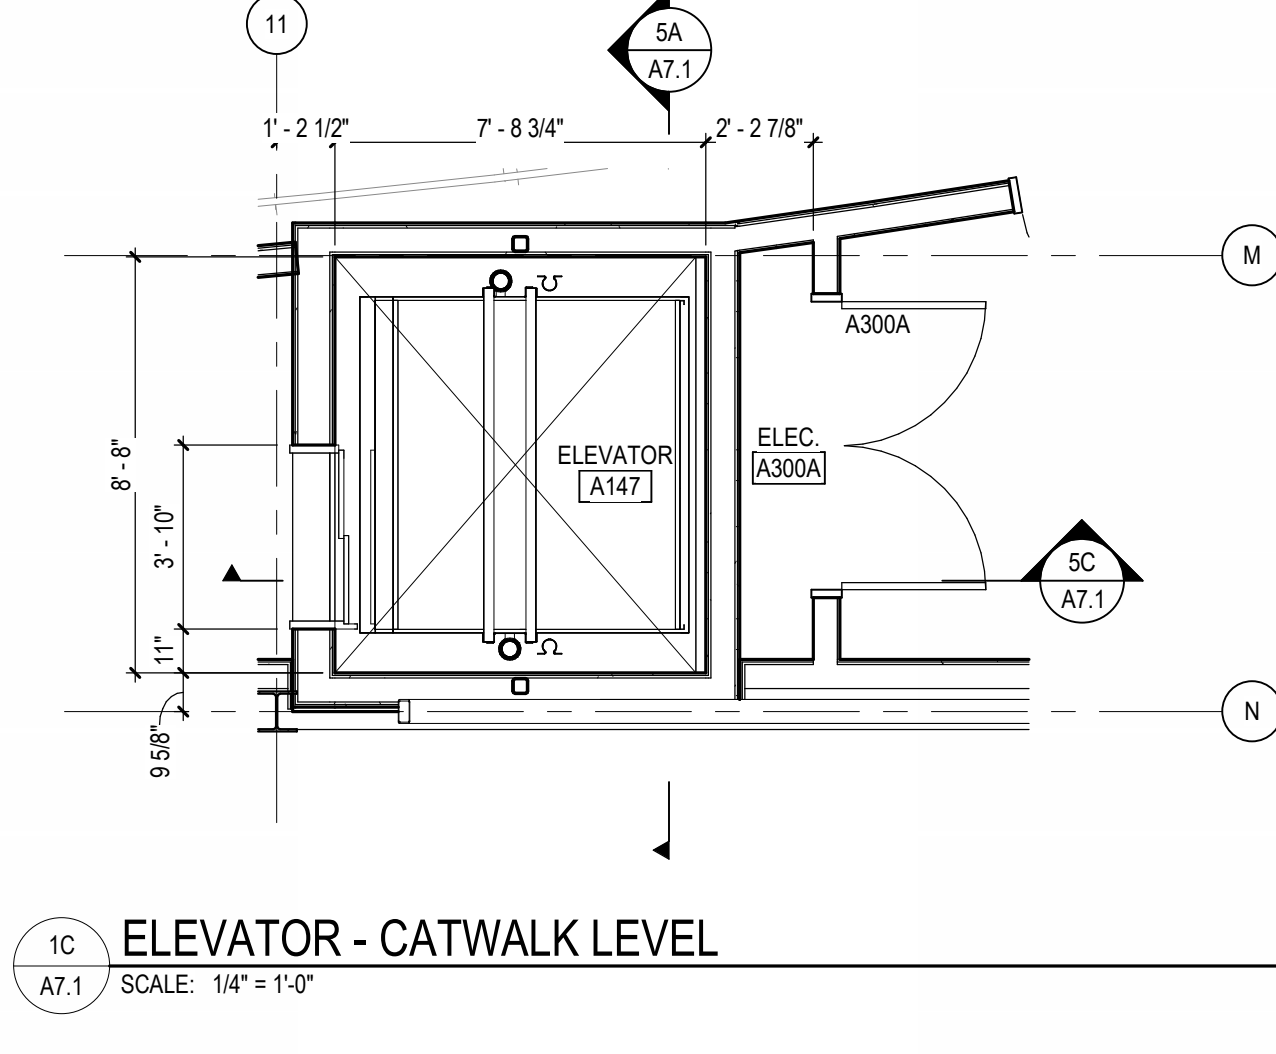

1C ELEVATOR - CATWALK LEVEL
SCALE: 1/4" = 1'-0"

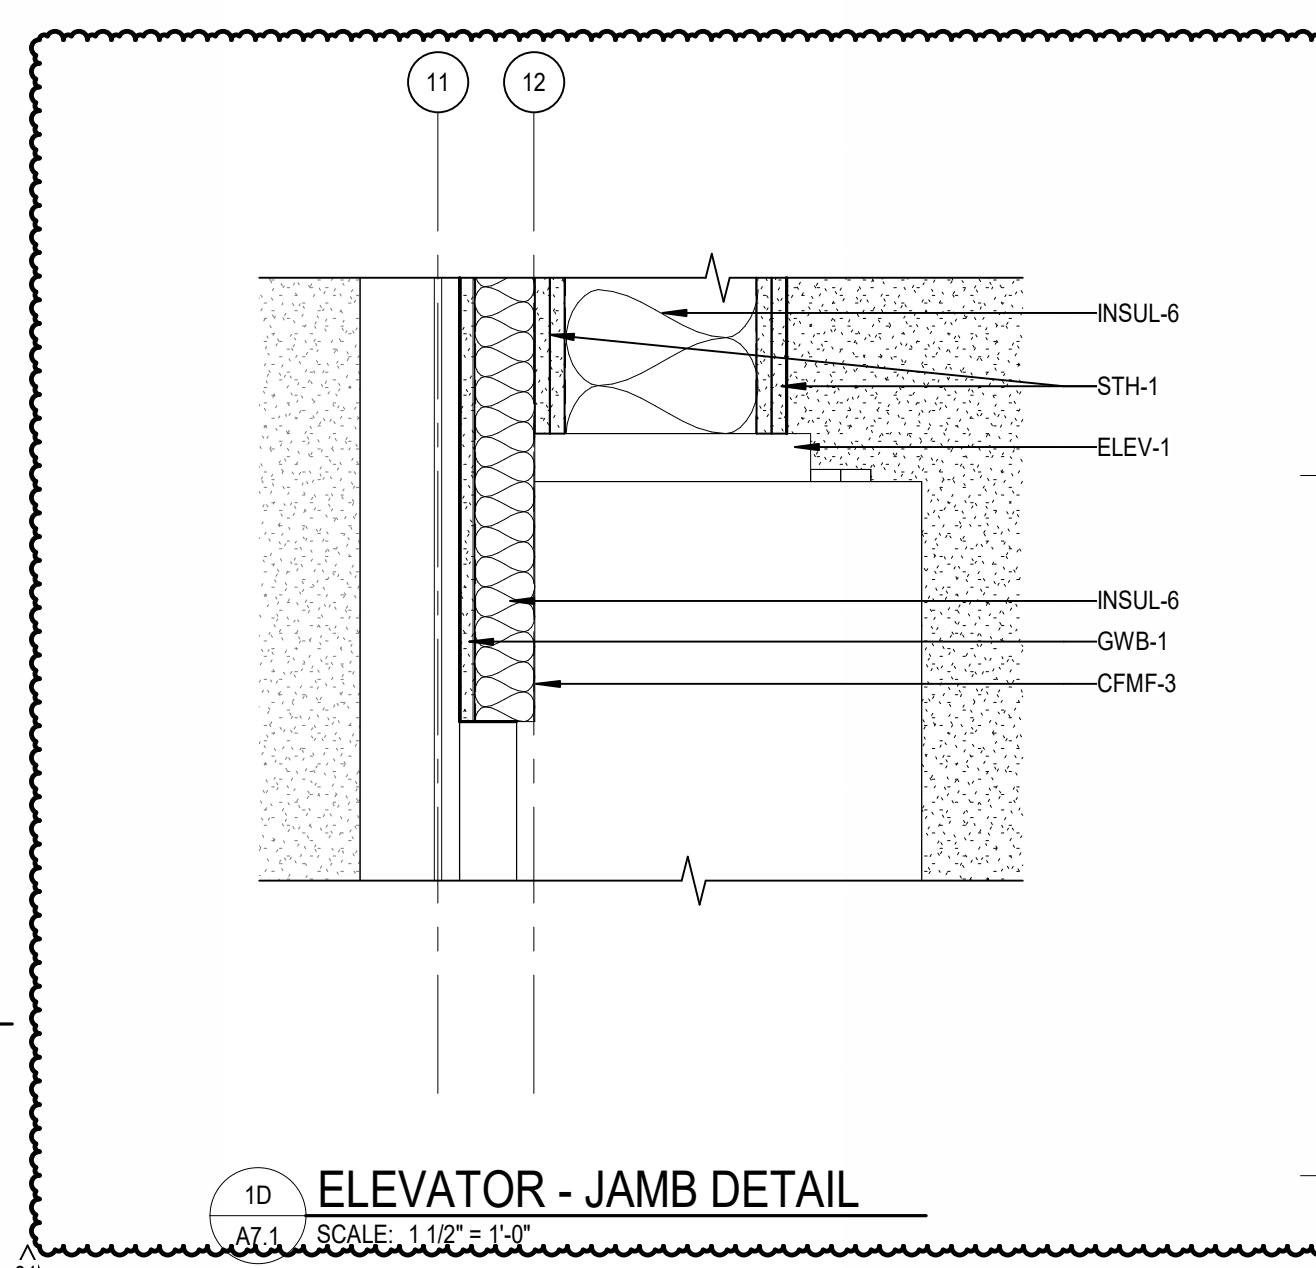


1D ELEVATOR - JAMB DETAIL
SCALE: 1/2" = 1'-0"

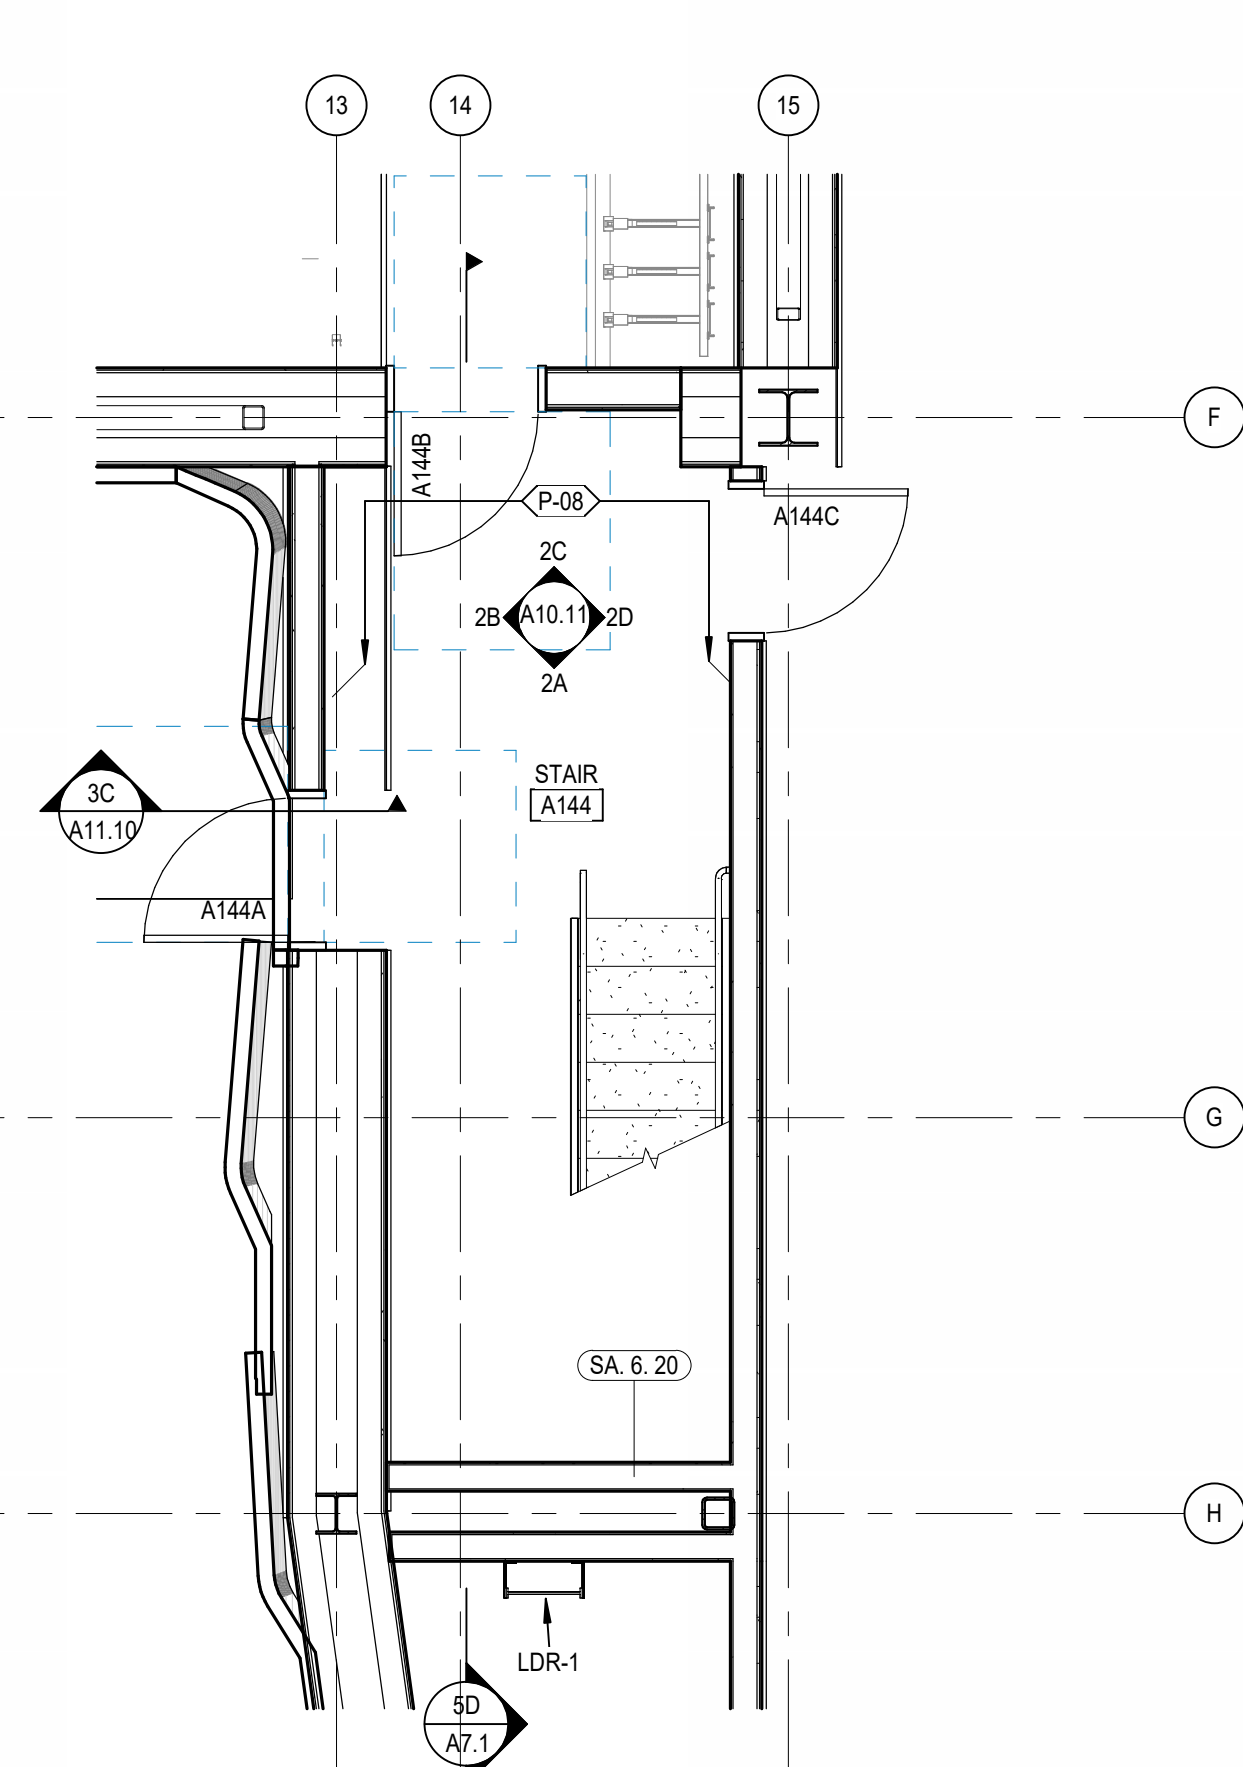


2E STAIR-LEVEL 01
SCALE: 1/4" = 1'-0"

REFERENCE KEYNOTES


- CFMF-3 CFMF INTERIOR NON-LOAD-BEARING WALL FRAMING
- ELEV-1 HYDRAULIC MACHINE ROOM LESS ELEVATOR
- GWB-1 TYPE X GYPSUM WALL BOARD
- INSUL-6 MINERAL WOOL BLANKET INSULATION, UNFACED
- LDR-1 METAL LADDER
- RLG-1 STEEL PIPE/TUBE RAIL
- RLG-10 STEEL DECORATIVE RAILING
- STH-1 GLASS-MAT GYPSUM SHEATHING

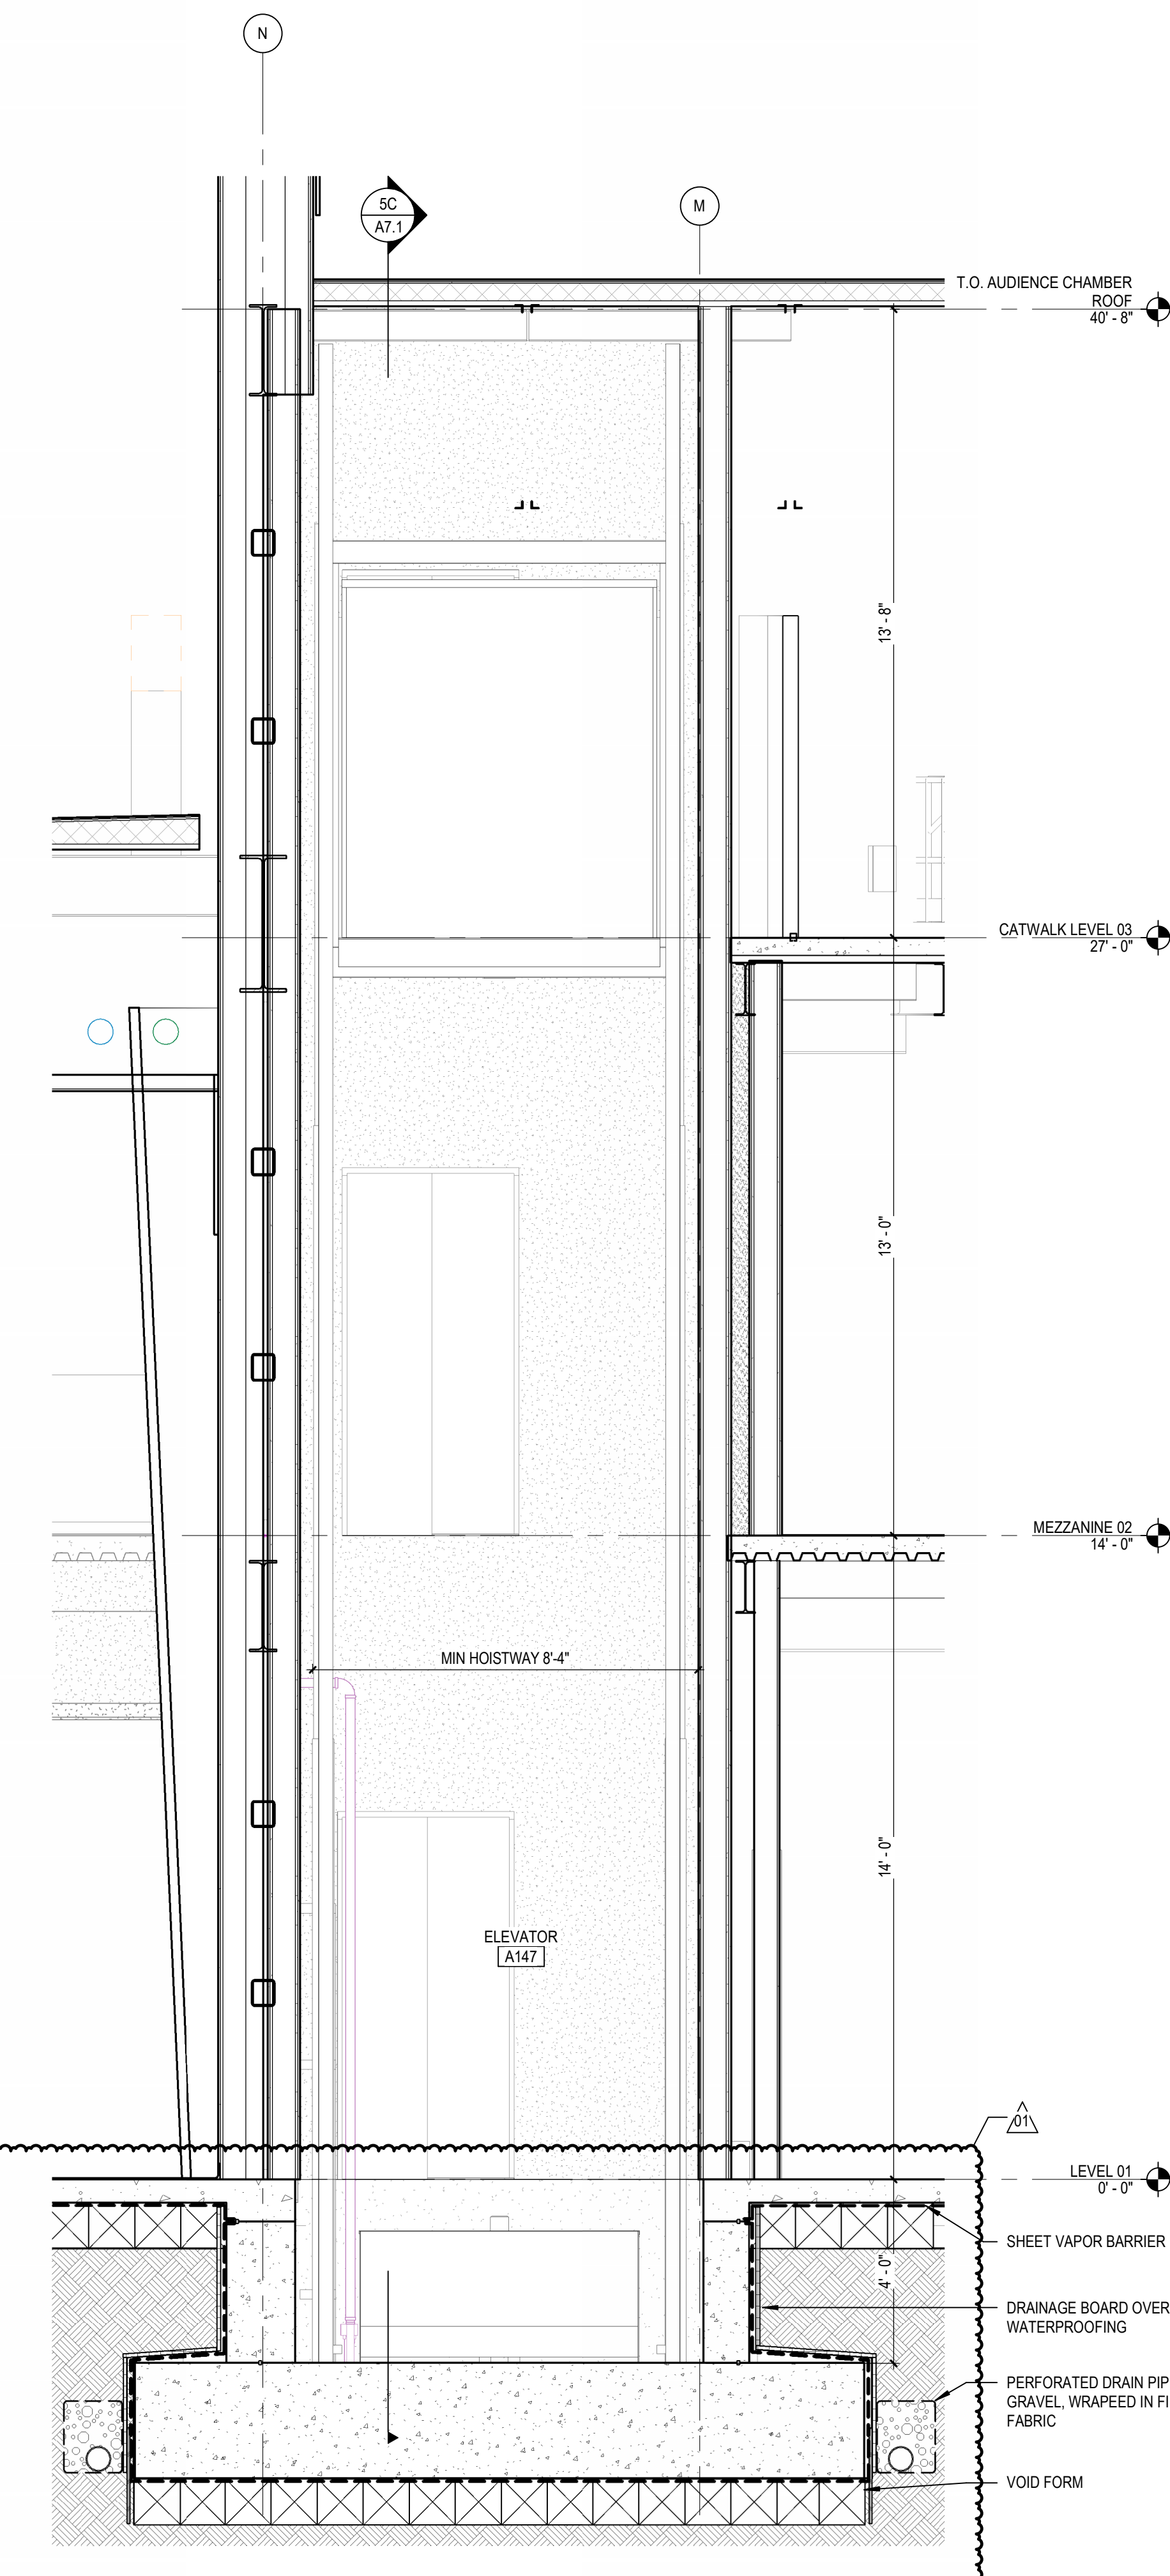


3A ELEVATOR - SECTION
SCALE: 3/8" = 1'-0"

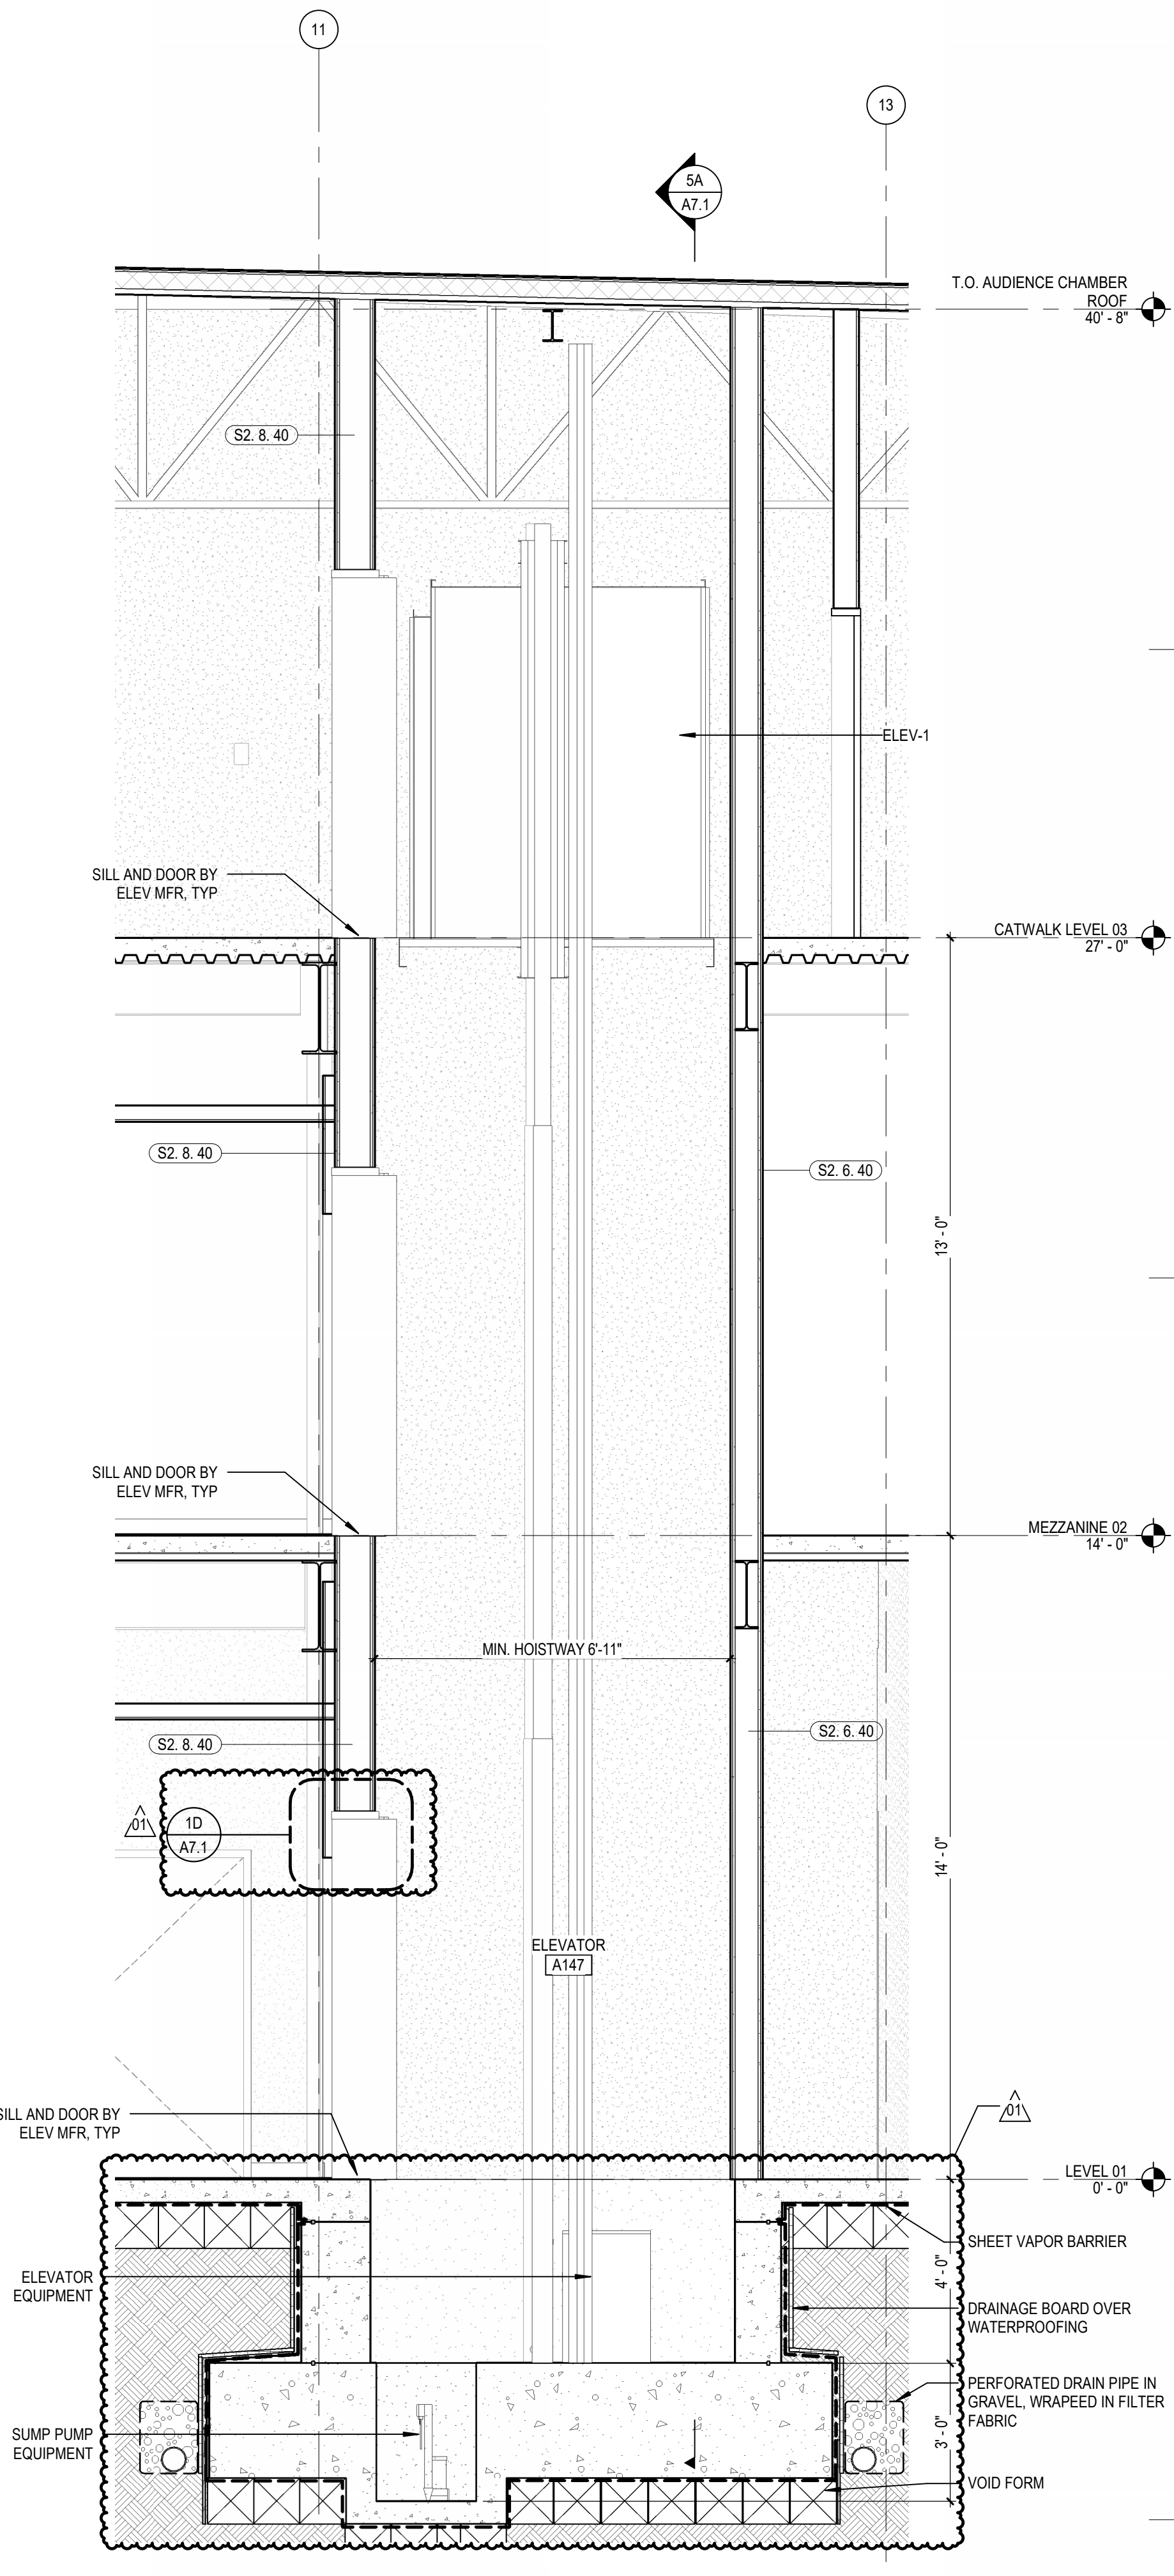

3C ELEVATOR - SECTION
SCALE: 3/8" = 1'-0"

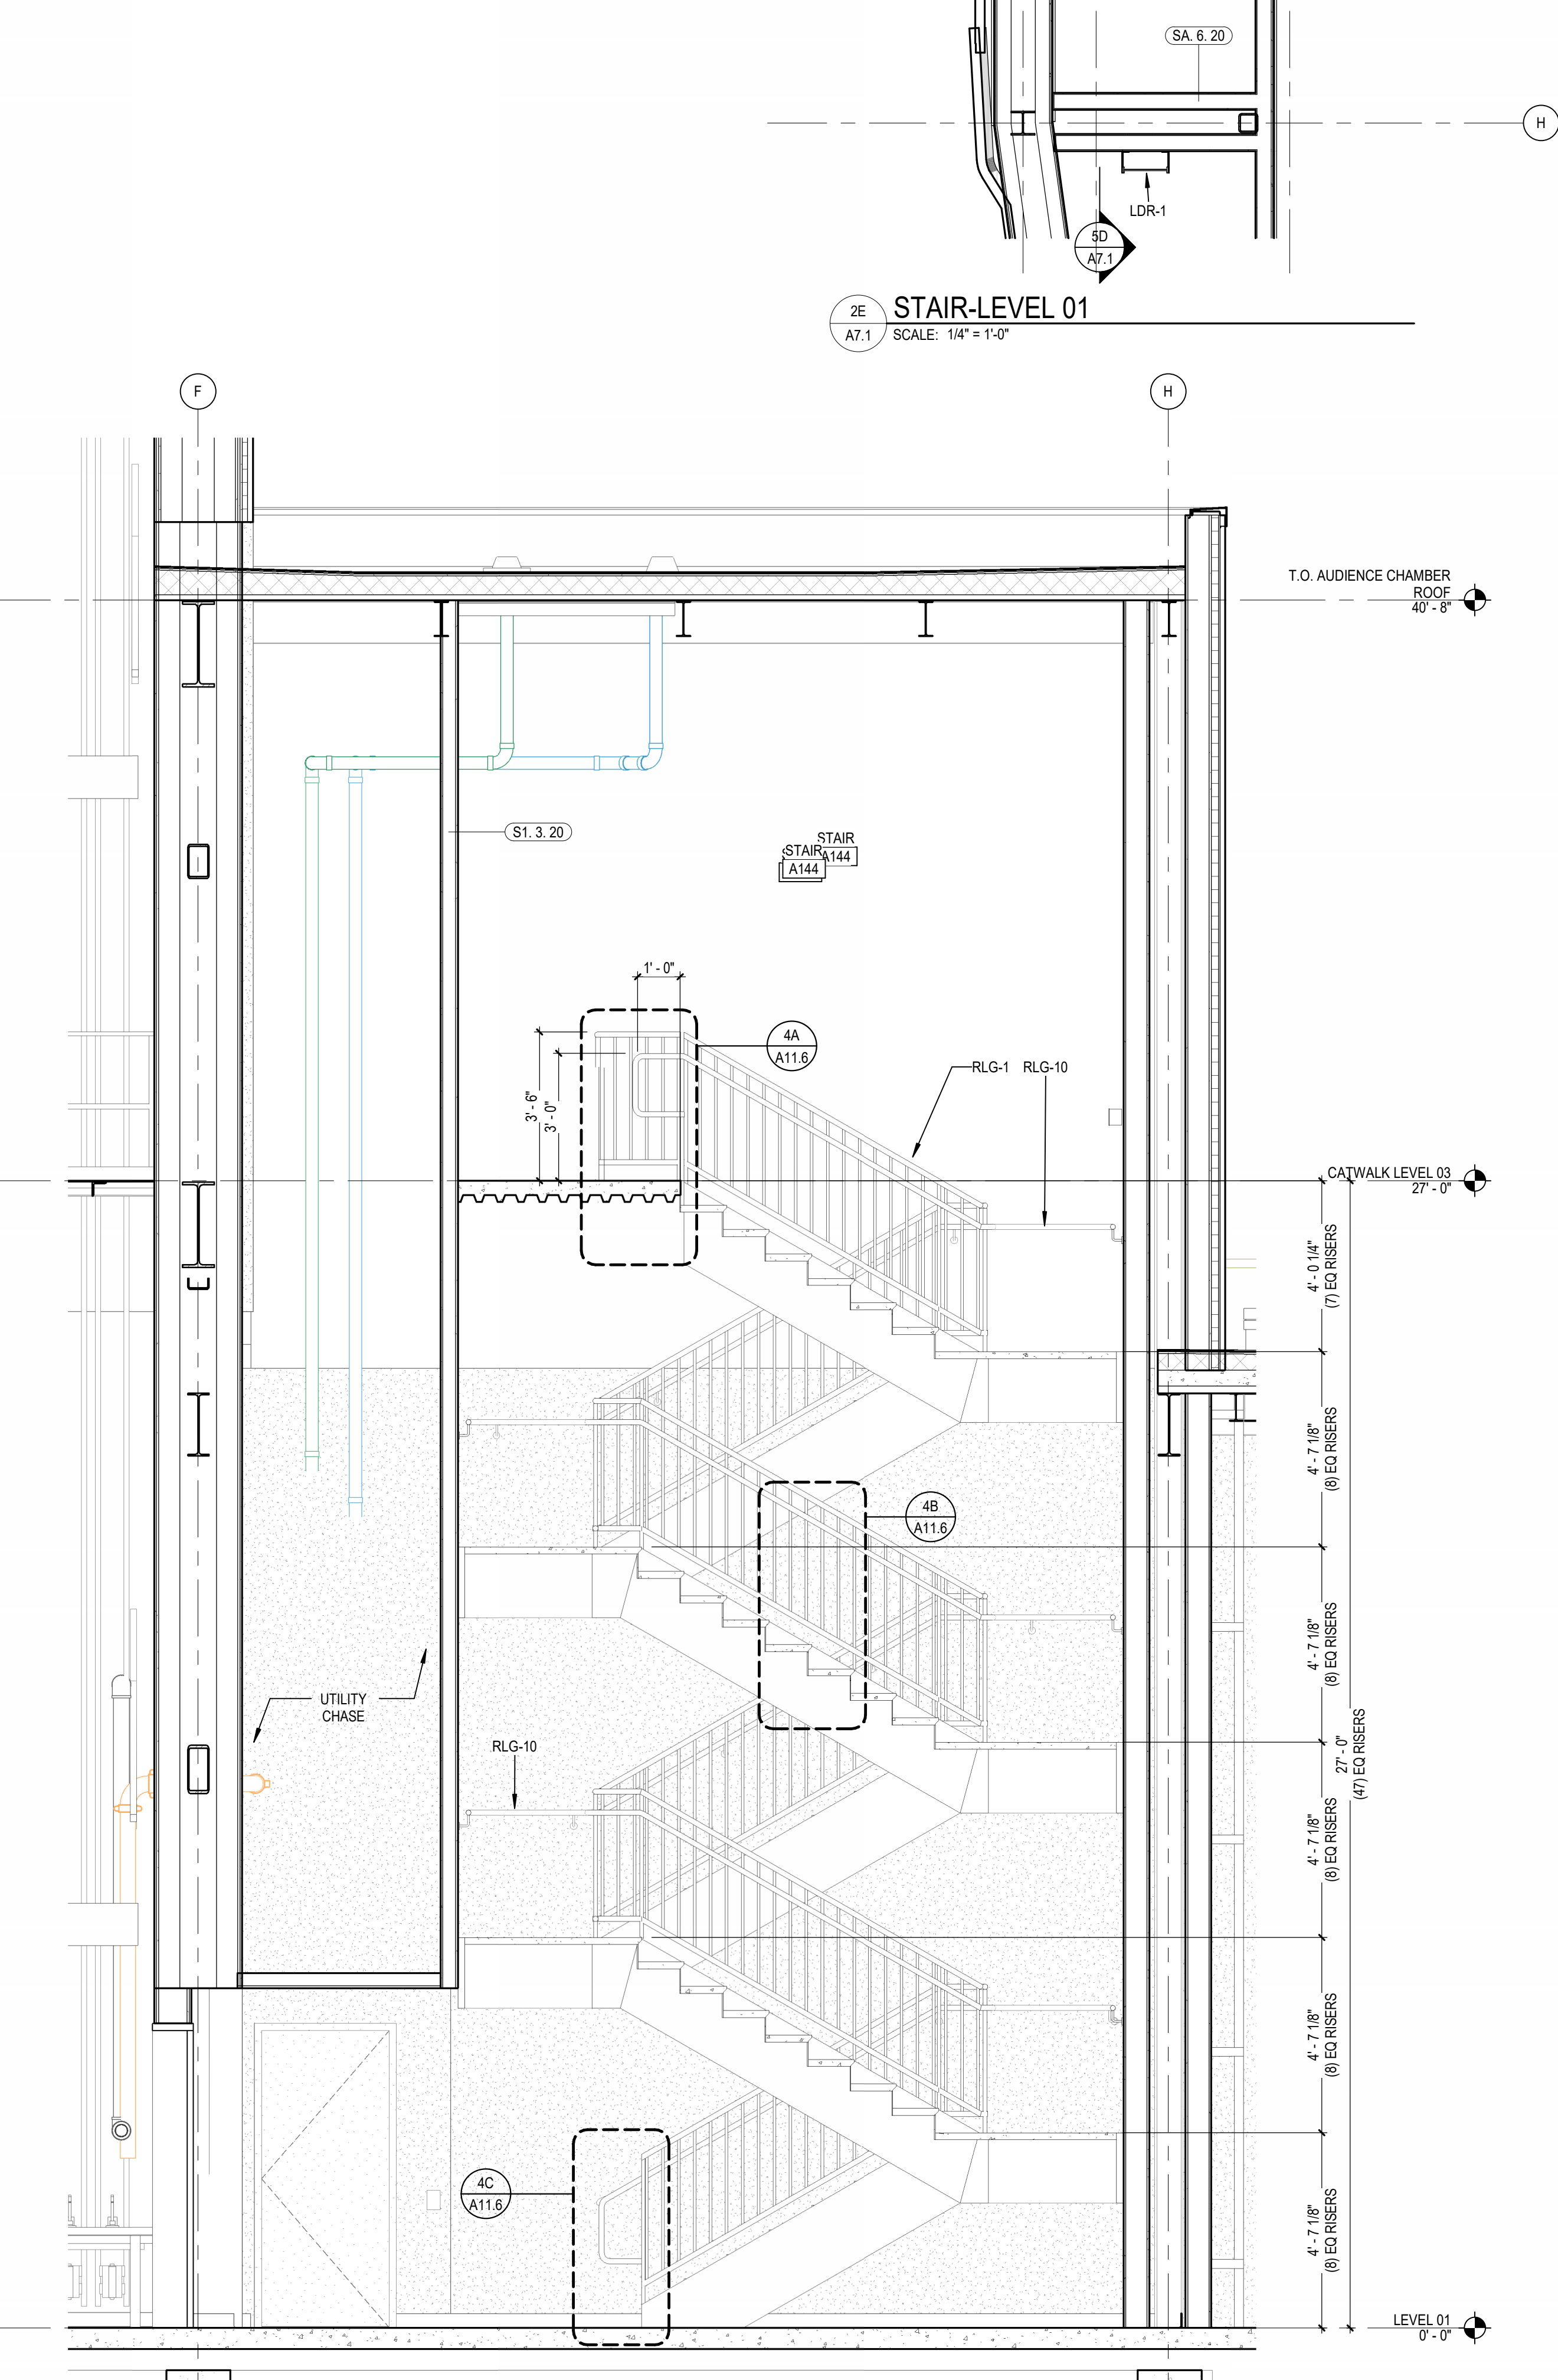

3D STAIR-SECTION
SCALE: 3/8" = 1'-0"

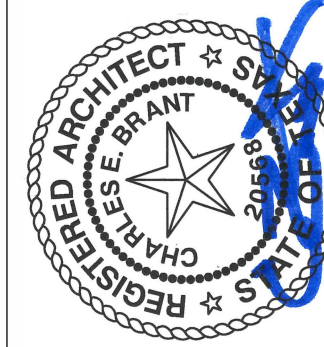

CRANDALL ISD HIGH SCHOOL
PAC ADDITION
13385 Fm 3039, Crandall, TX 75114




ISSUE FOR BID AND PERMIT
2024.07.25
REVISIONS
01 08/19/24 ADDENDUM 01

39-23712-00
STAIR VIEWS

A7.1

Autodesk Docs/199-23712-00_Crandall ISD - PAC/39-23712-00_Crandall ISD_AR_2024.rvt
8/9/2024 7:54:38 PM

A:\Autodesk Docs\199-23712-00_Crandall ISD - PAC\39-23712-00_Crandall ISD - PAC\39-23712-00_Crandall ISD - PAC_2024.rvt
8/9/2024 7:55:02 PM

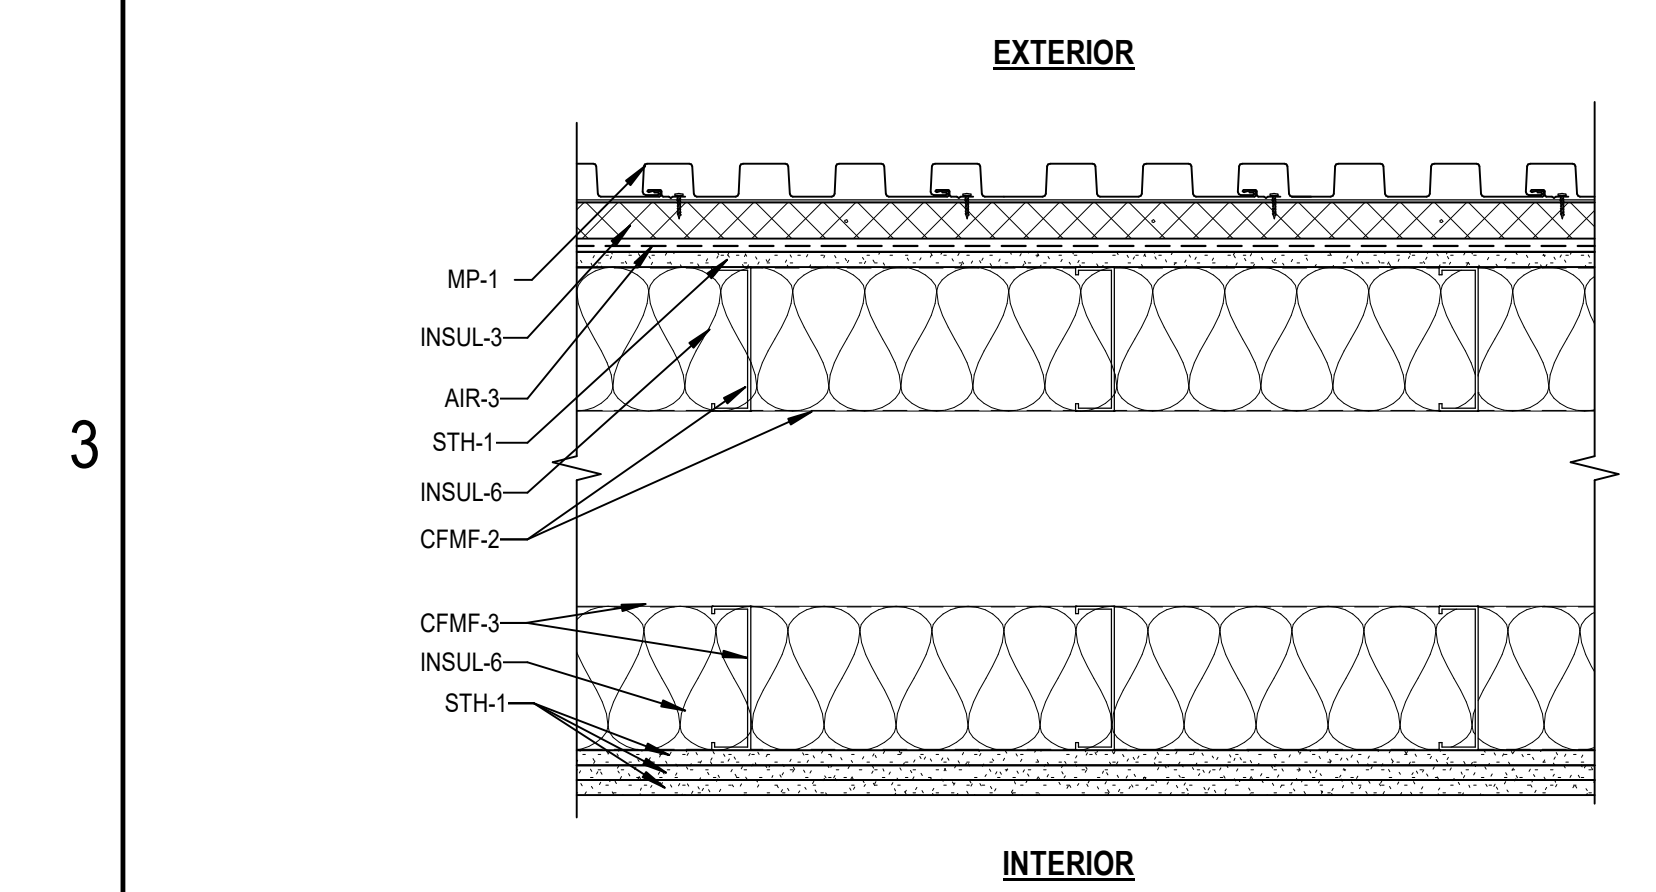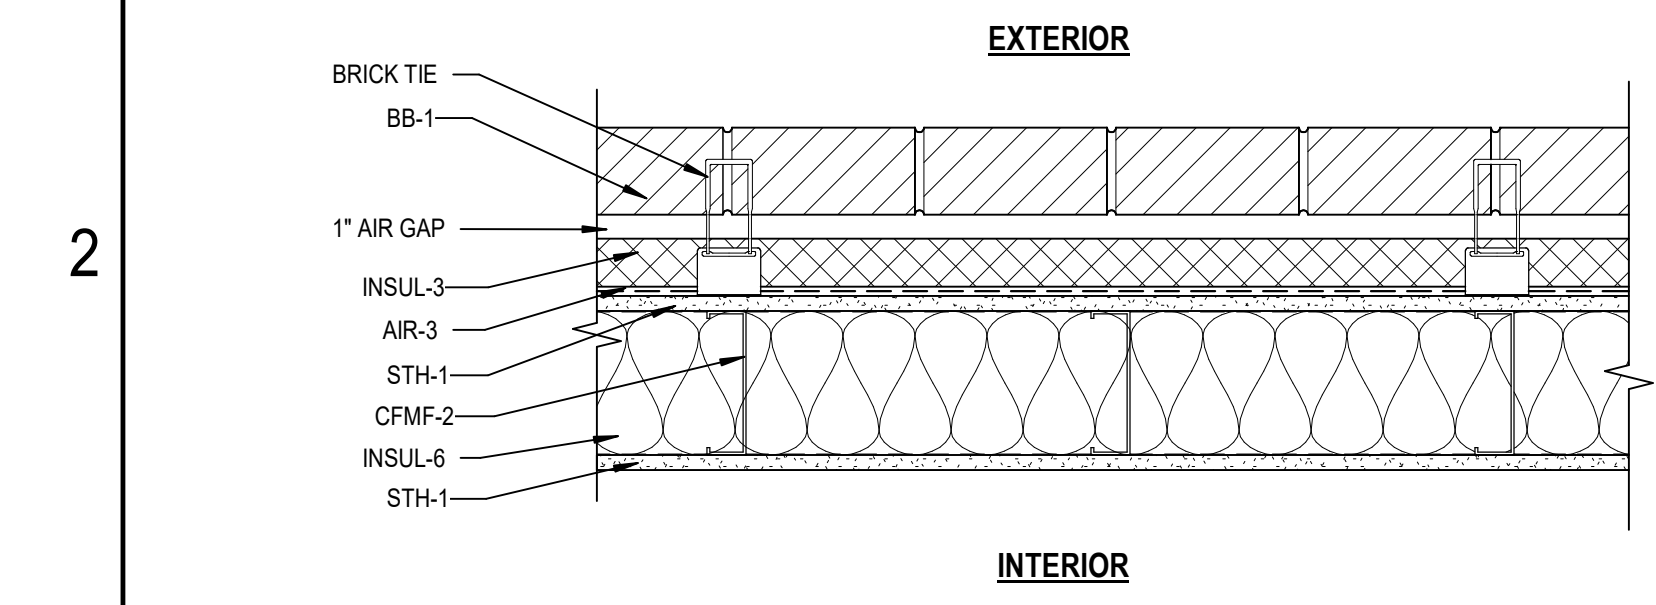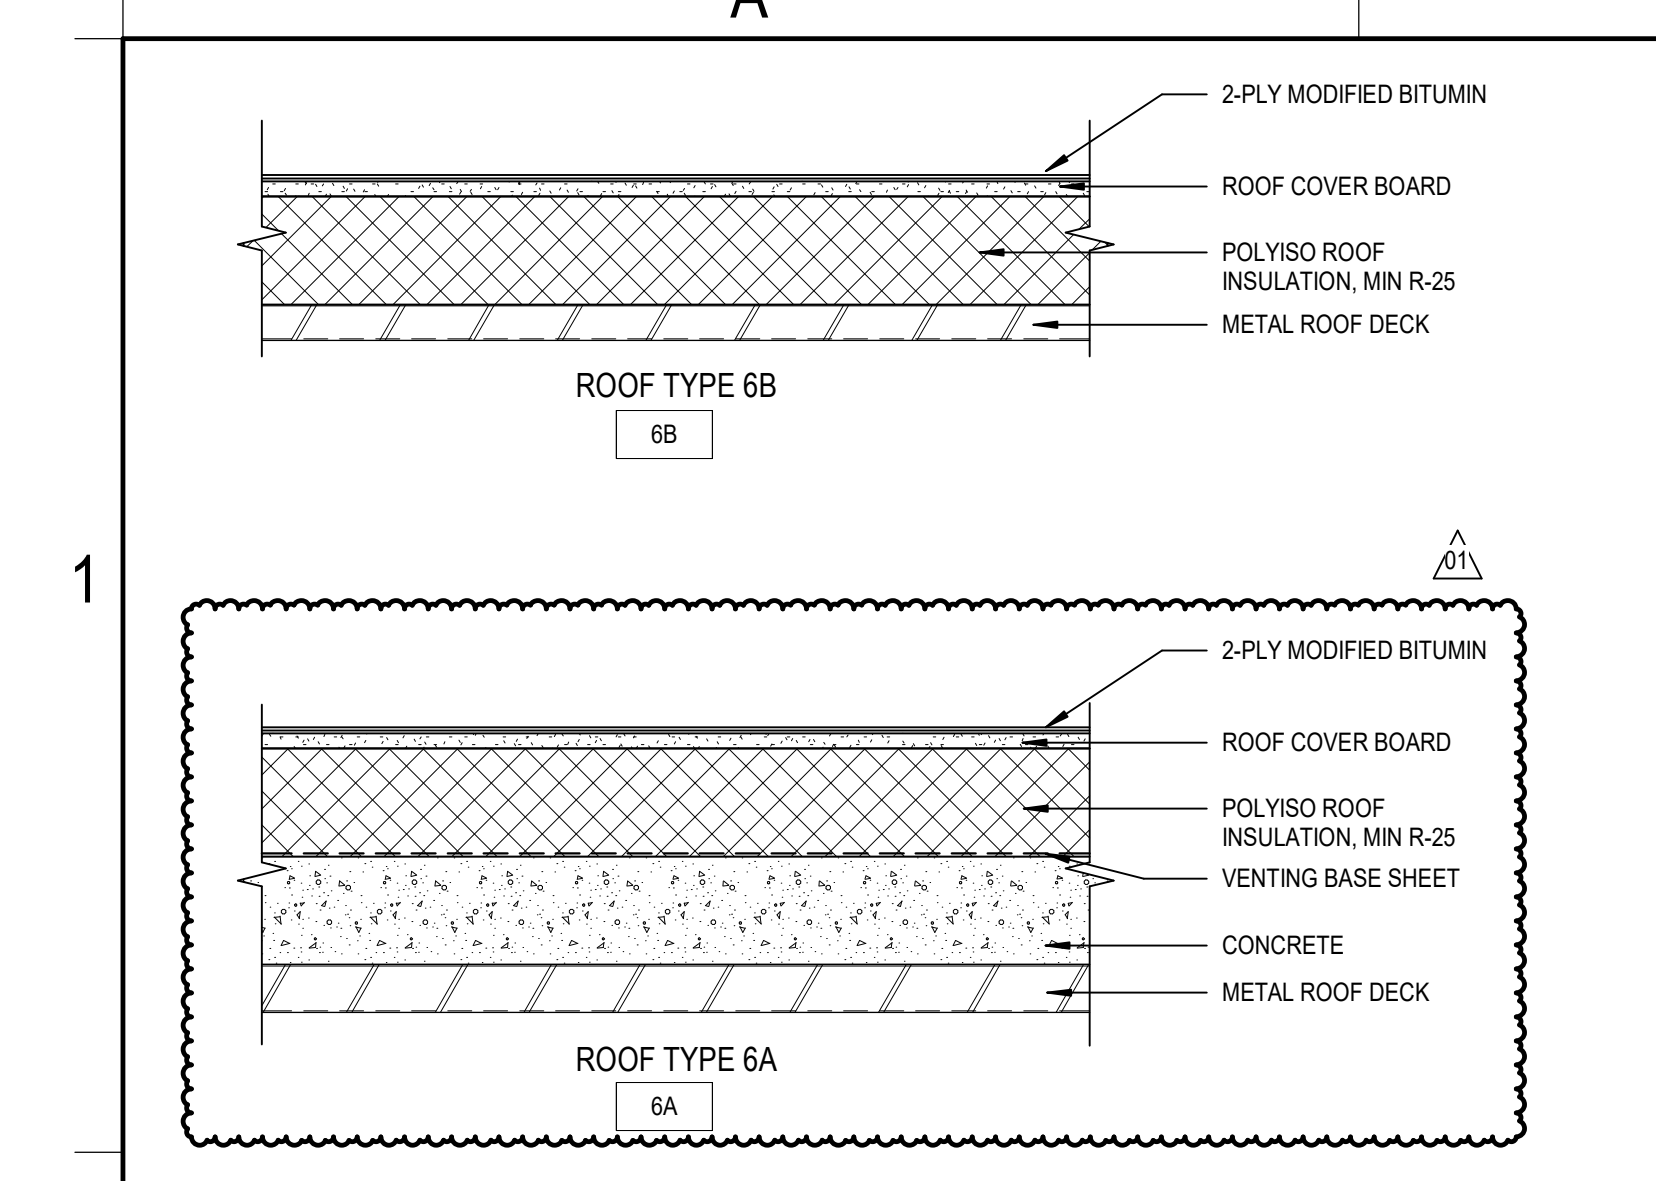

REFERENCE KEYNOTES

| | |
|---------|---|
| AIR-3 | WEATHER BARRIER |
| BB-1 | BRICK BLENDED |
| CFMF-2 | CFMF EXTERIOR NON-LOAD-BEARING WALL FRAMING |
| CFMF-3 | CFMF INTERIOR NON-LOAD-BEARING WALL FRAMING |
| INSUL-3 | POLYISOCYANURATE (POLYISO) INSULATION |
| INSUL-6 | MINERAL-WOOL BLANKET INSULATION, UNFACED |
| STH-1 | GLASS-MAT GYPSUM SHEATHING |




CRANDALL ISD HIGH SCHOOL
PAC ADDITION
13385 Fm 3038, Crandall, TX 75114


ISSUE FOR BID AND PERMIT
2024.07.25
REVISIONS
01 08/19/24 ADDENDUM 01

39-23712-00
EXTERIOR ASSEMBLIES


A9.0

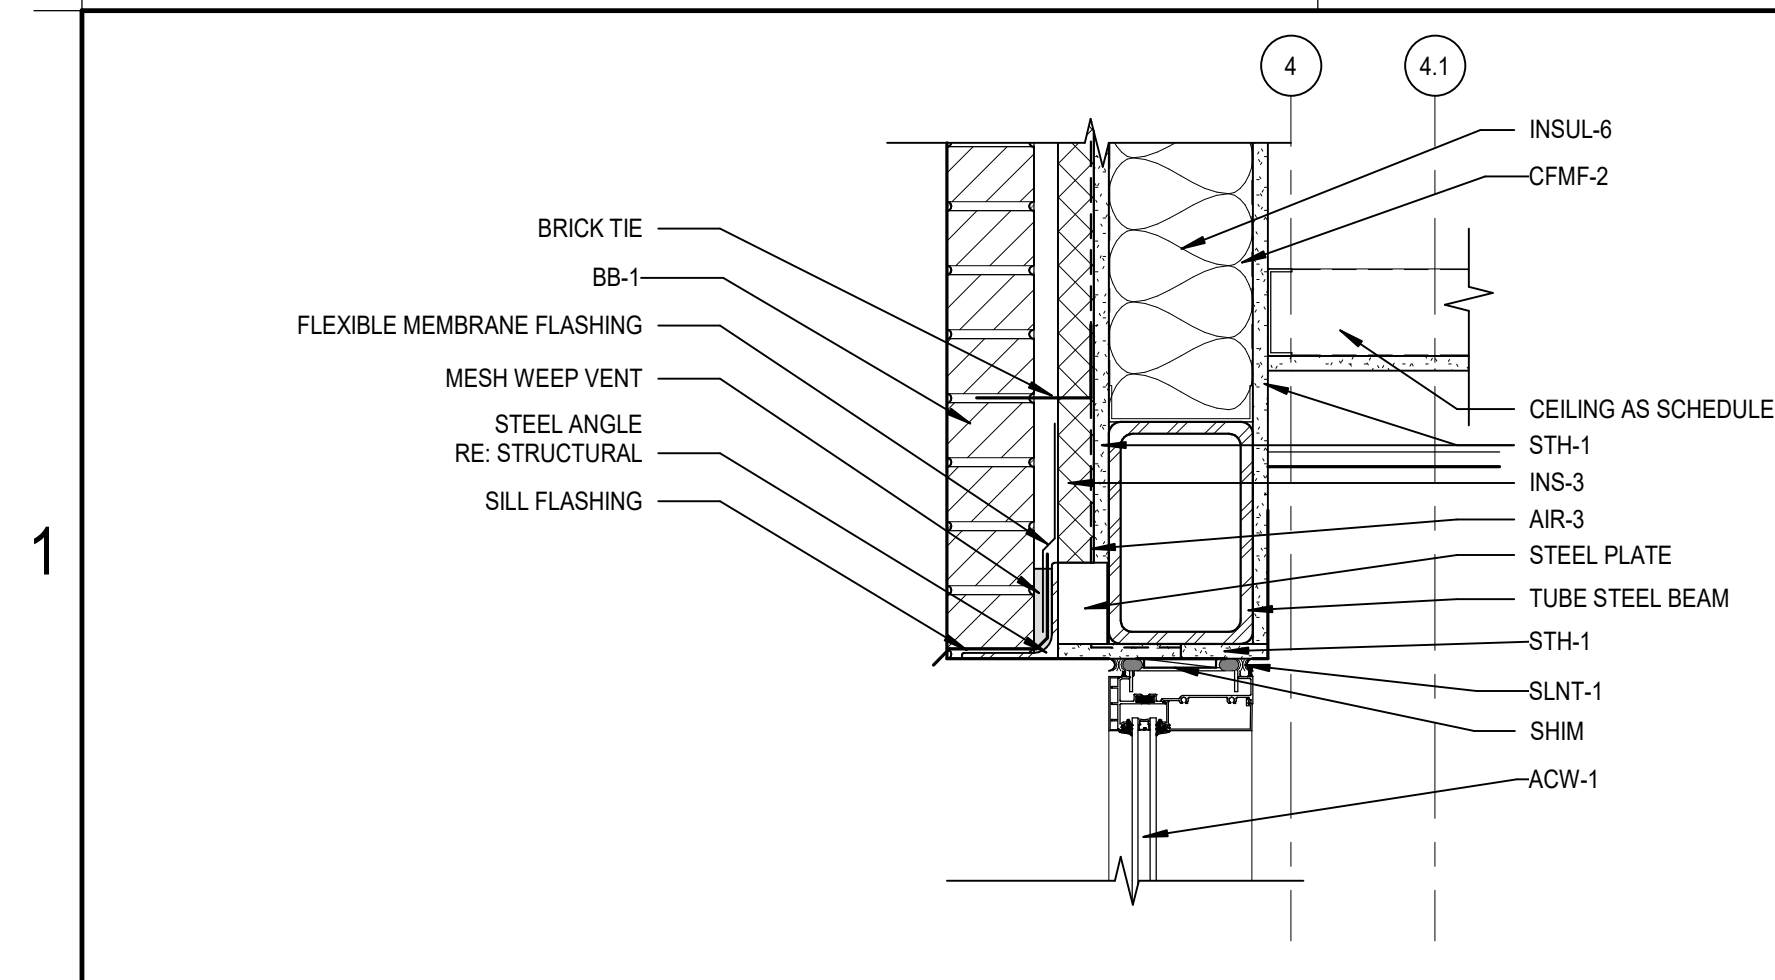


1A SECTION DETAIL AT WINDOW HEAD
A9.2 SCALE: 1 1/2" = 1'-0"

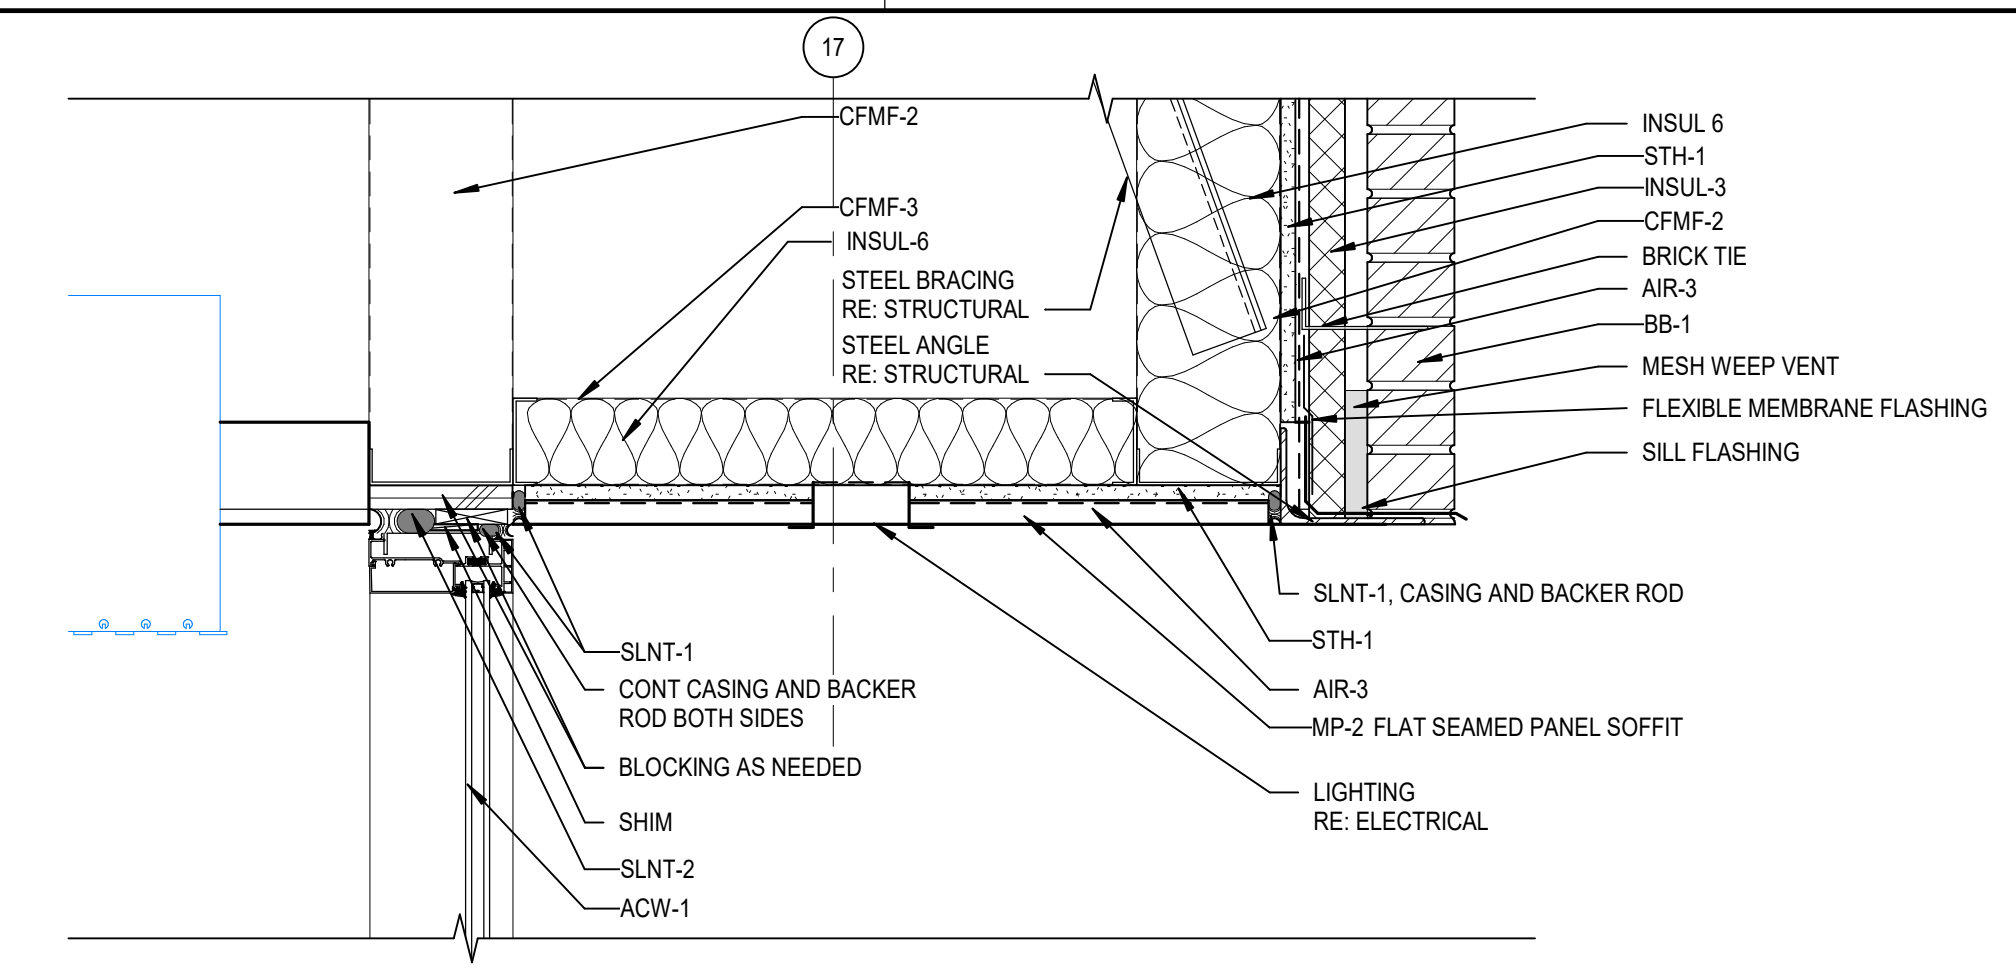


2C SECTION DETAIL AT SOFFIT
A9.2 SCALE: 1 1/2" = 1'-0"

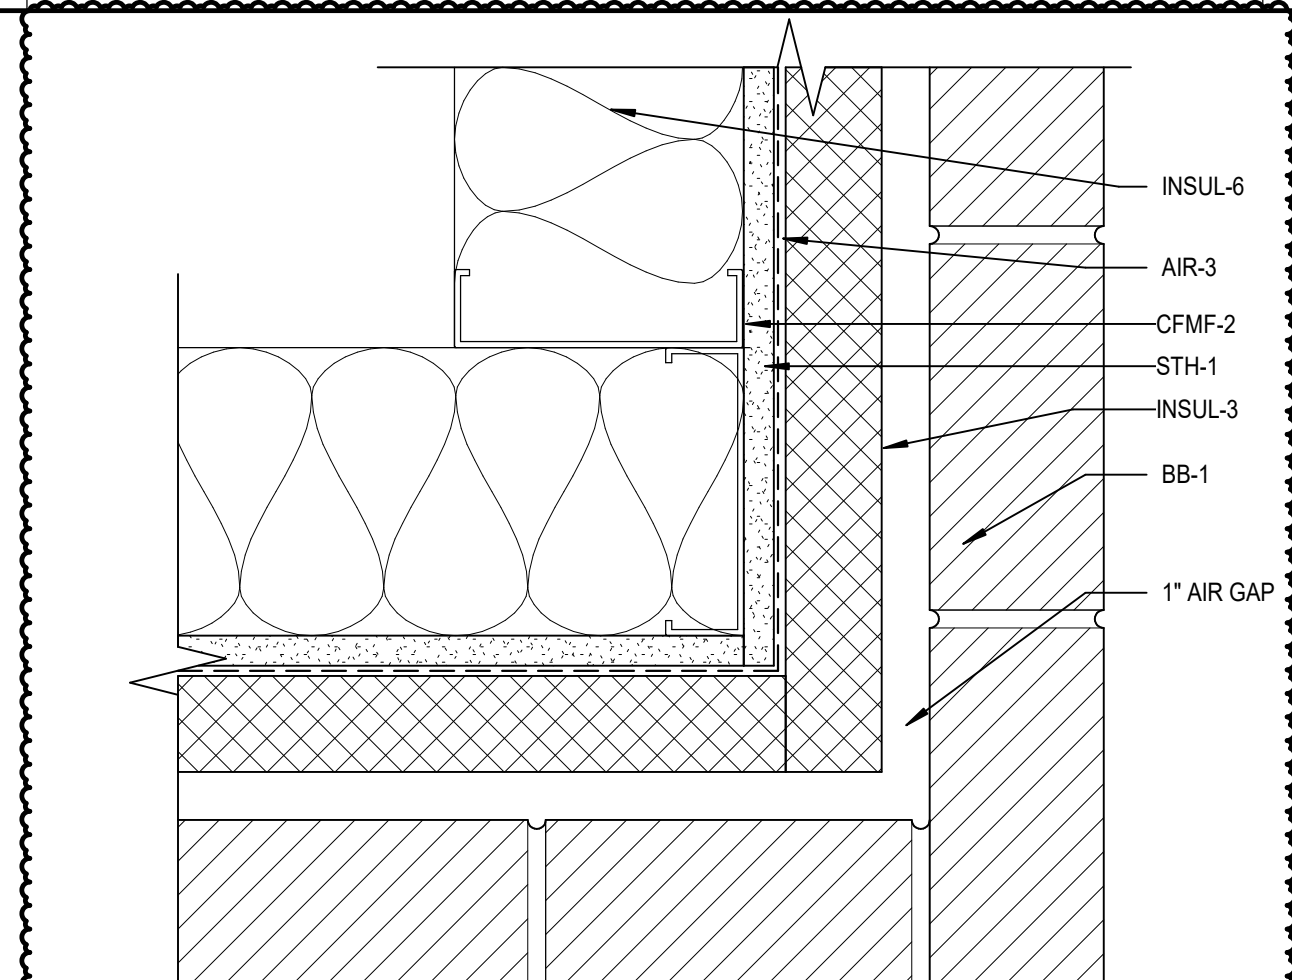


1E BRICK VENEER - OUTSIDE CORNER
A9.2 SCALE: 3" = 1'-0"

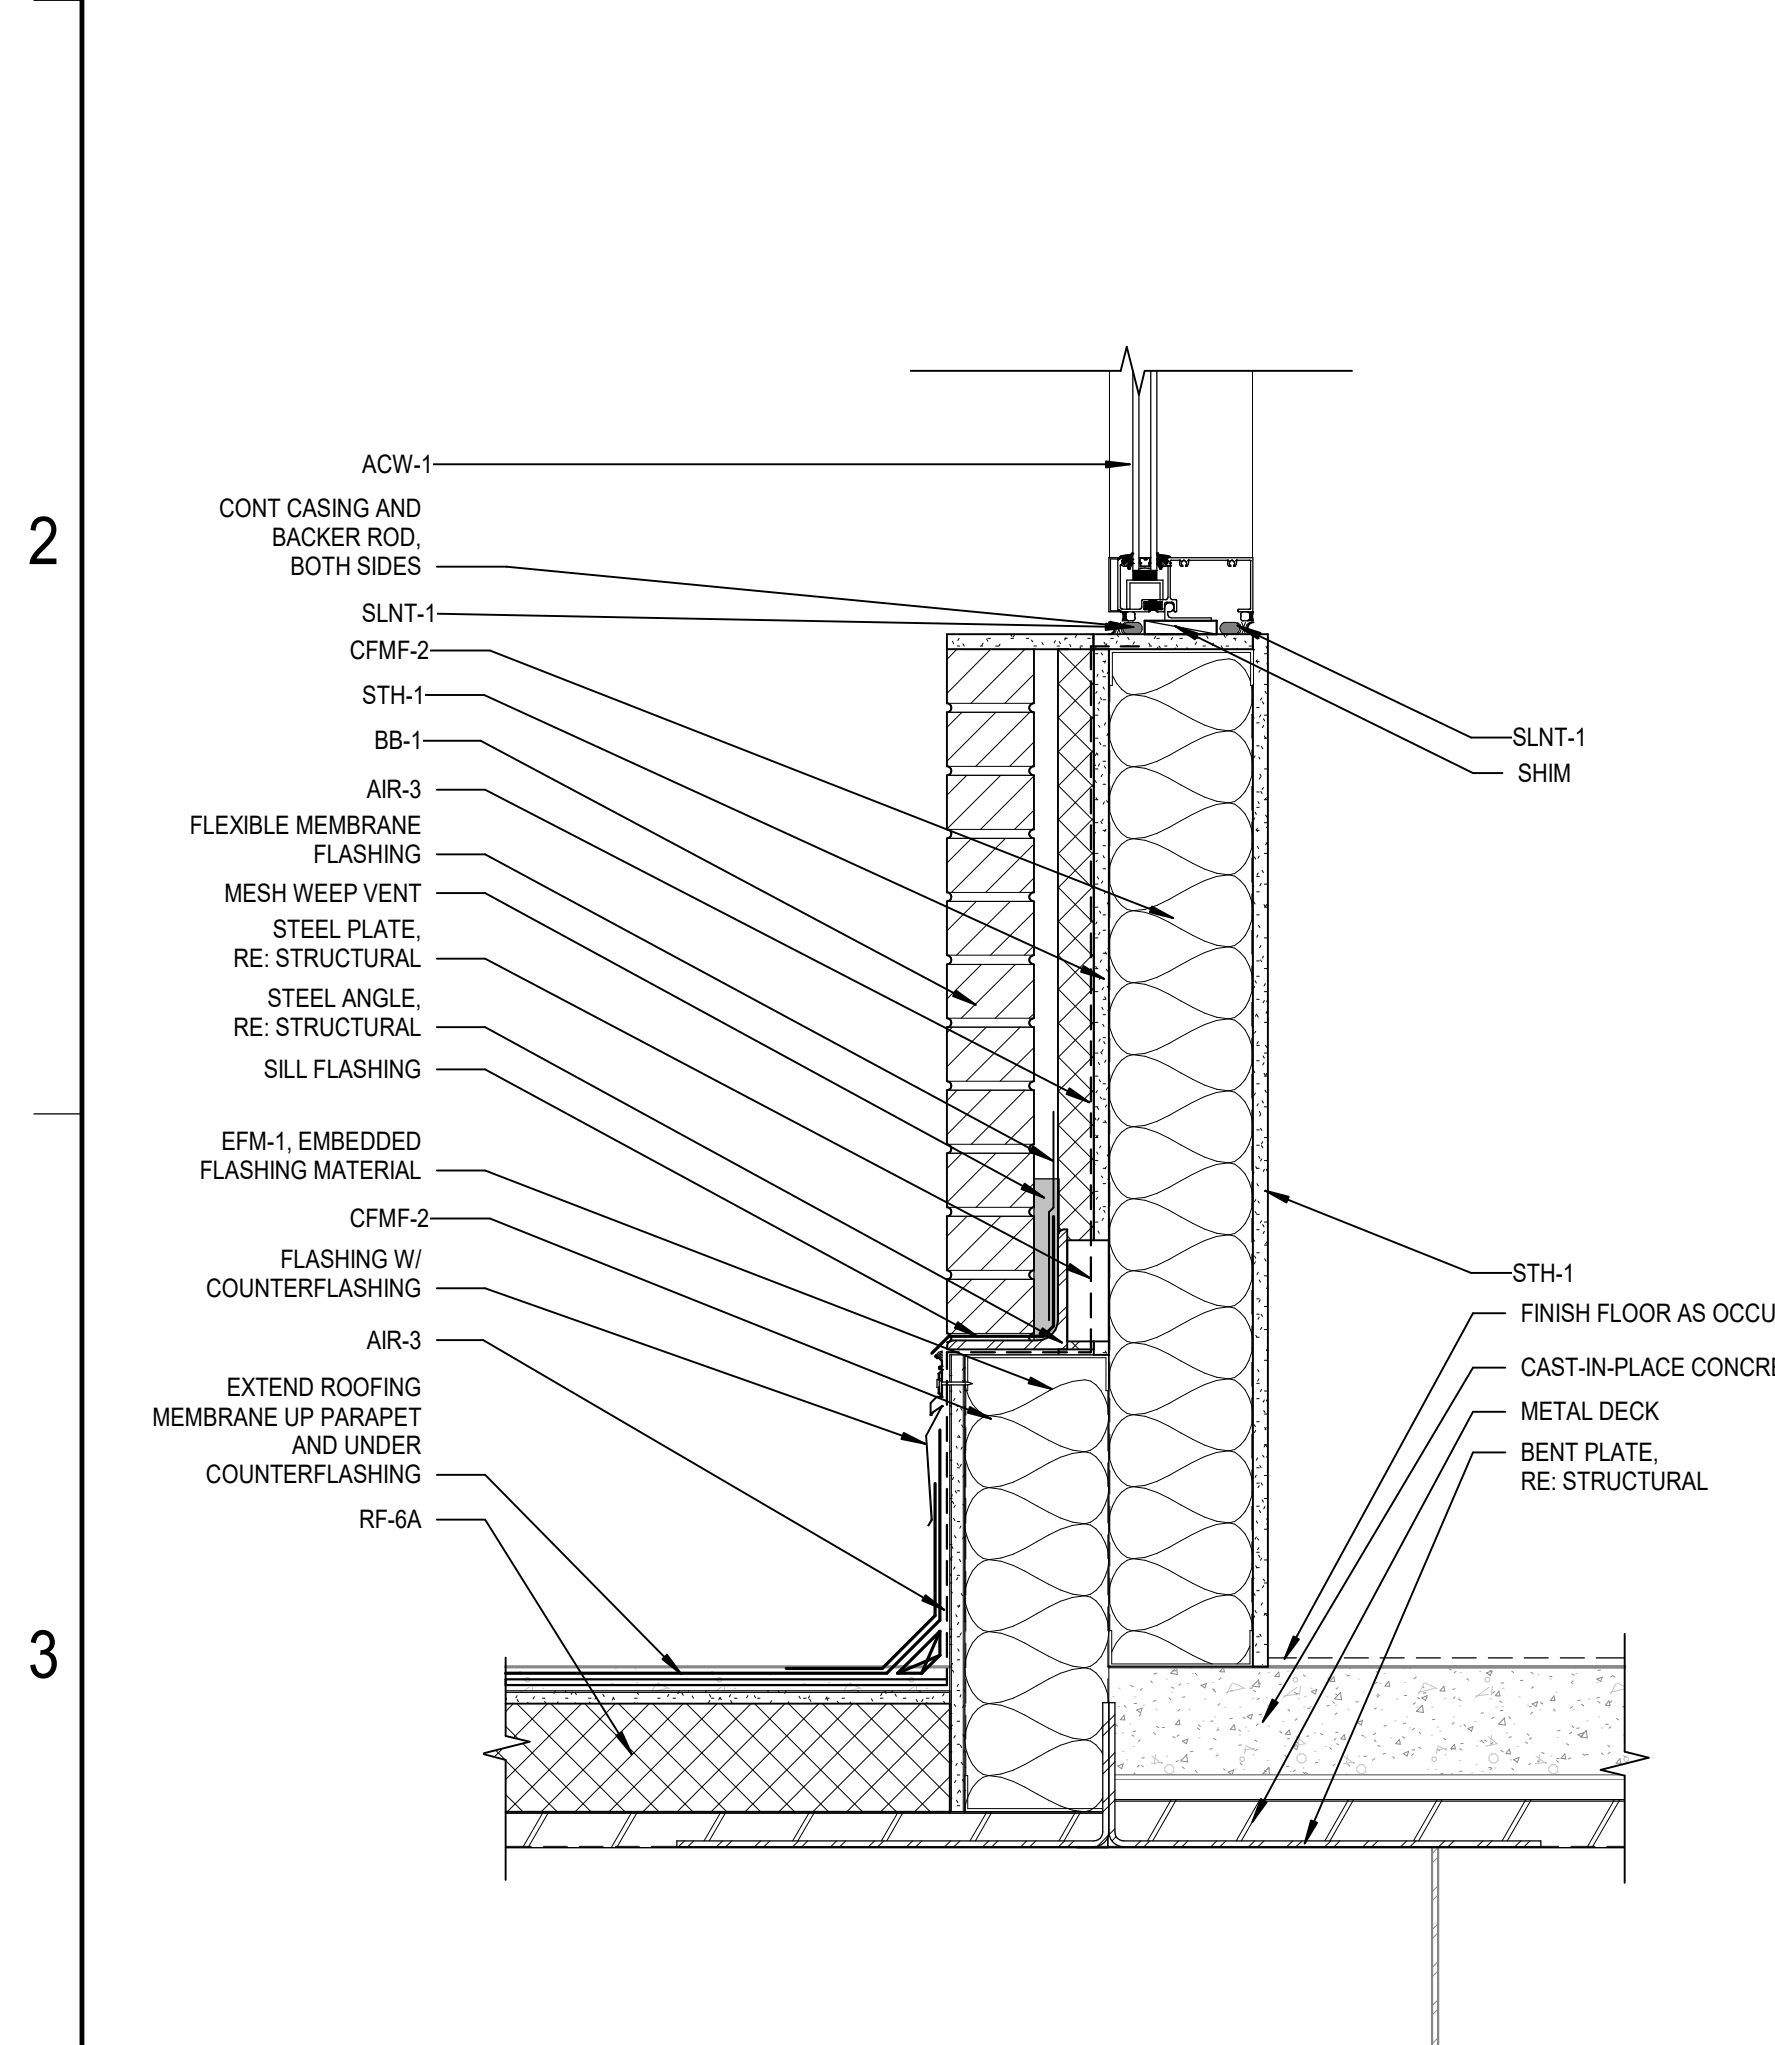


3A SECTION DETAIL AT WINDOW SILL
A9.2 SCALE: 1 1/2" = 1'-0"

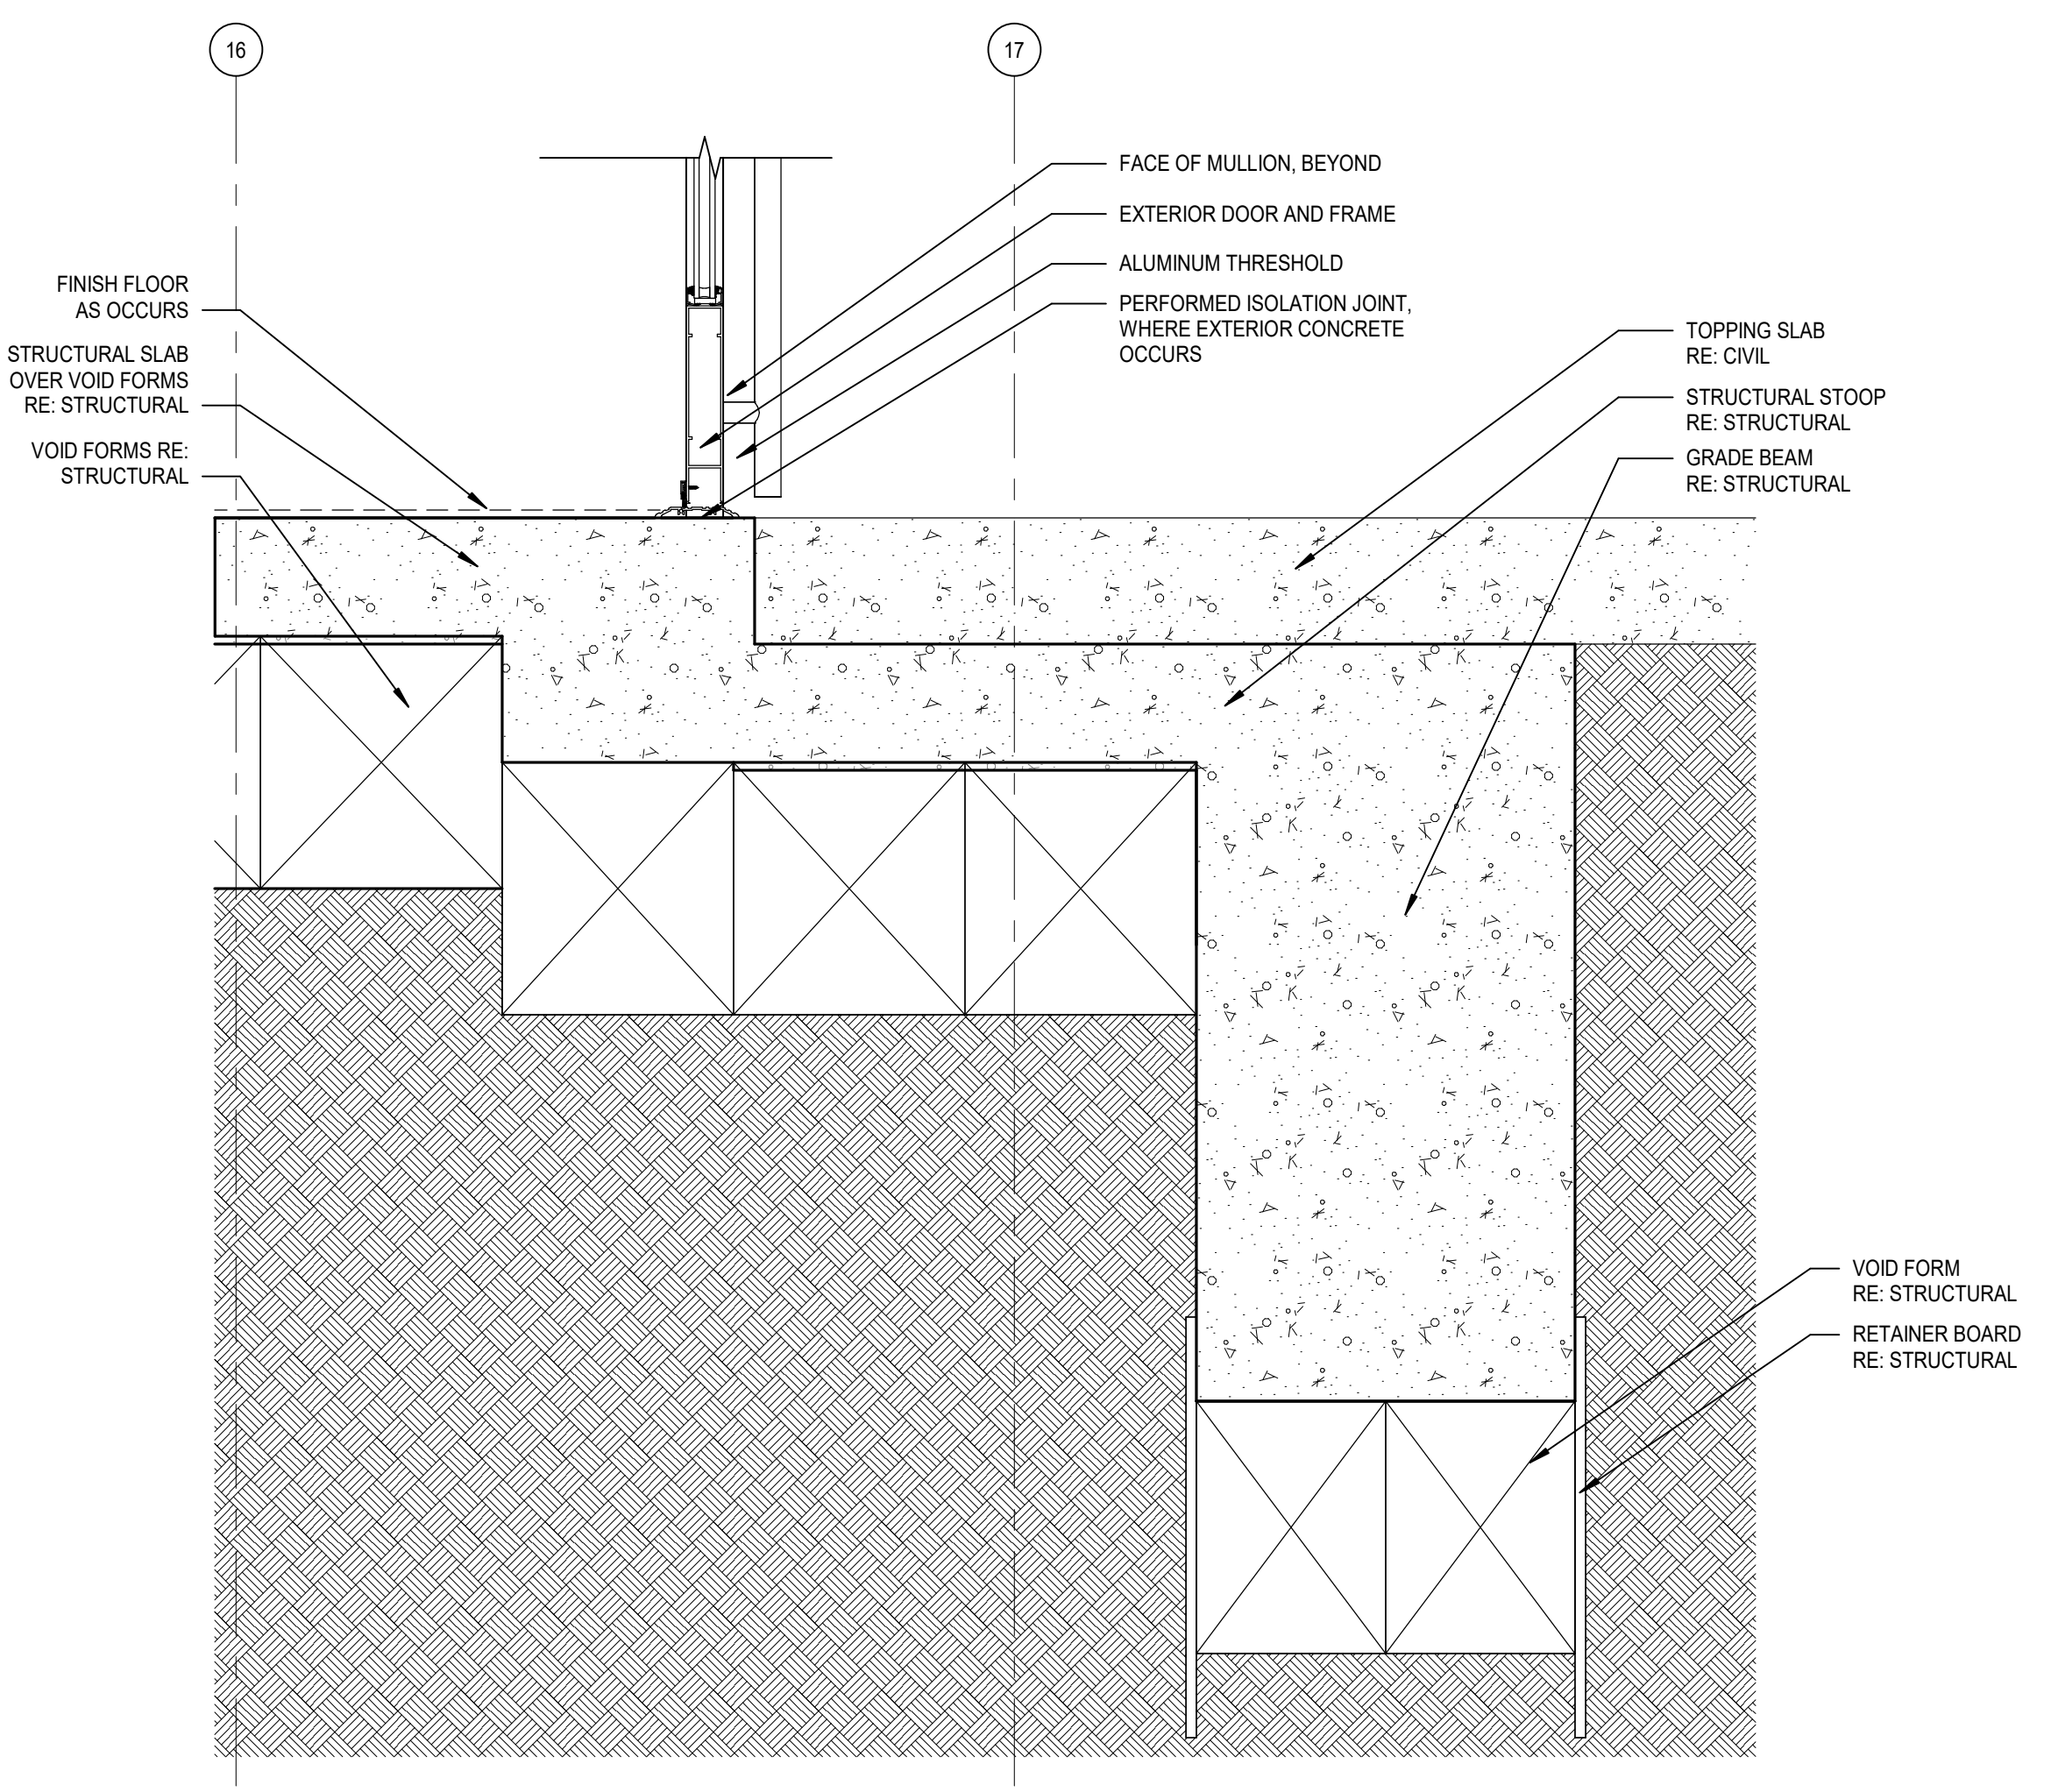


3C SECTION DETAIL AT ENTRY
A9.2 SCALE: 1 1/2" = 1'-0"

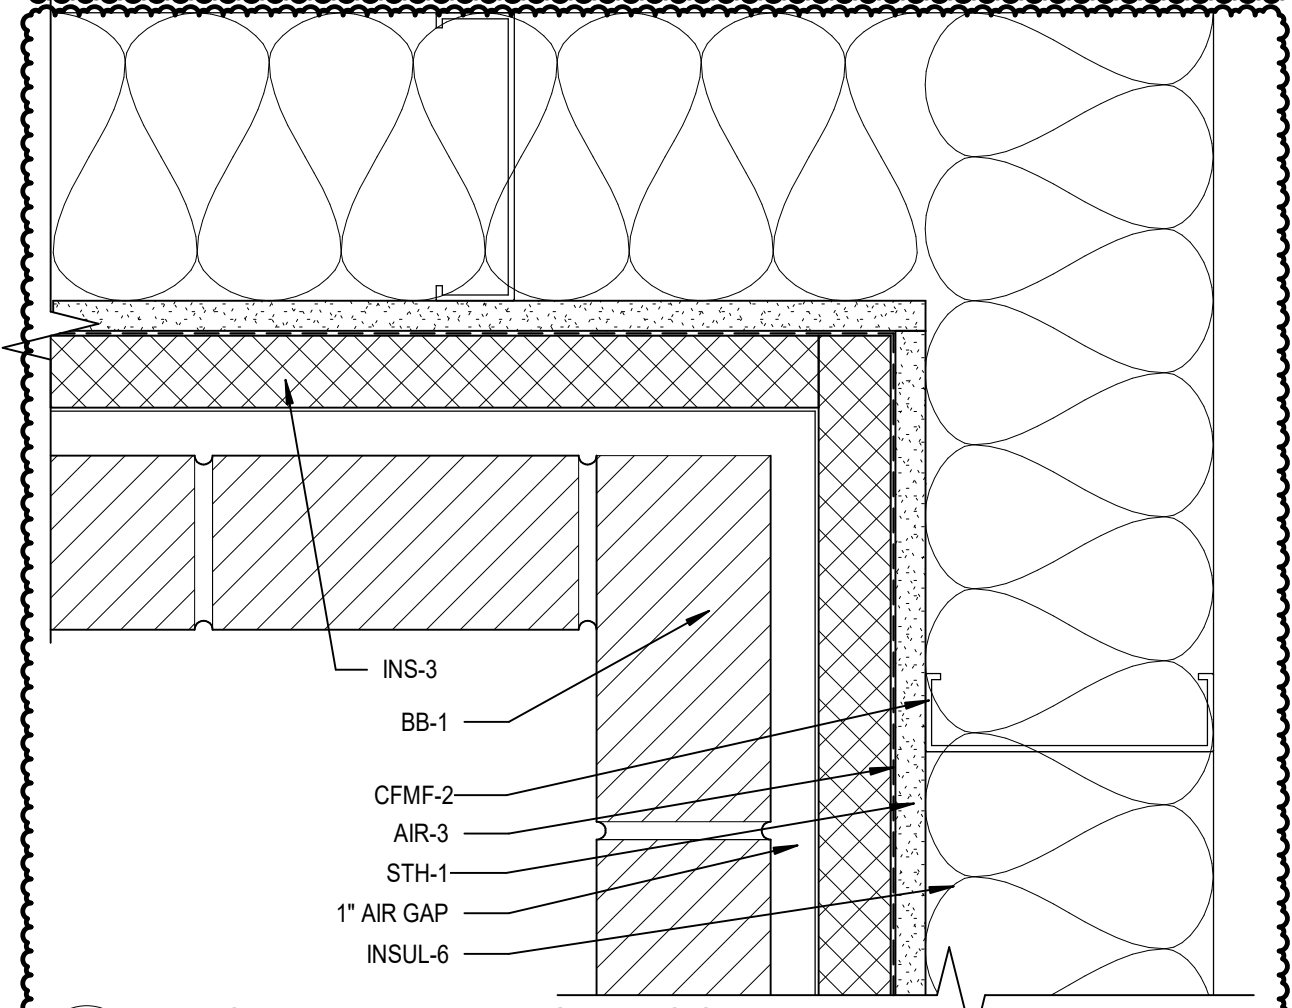


2D BRICK VENEER - INSIDE CORNER
A9.2 SCALE: 3" = 1'-0"

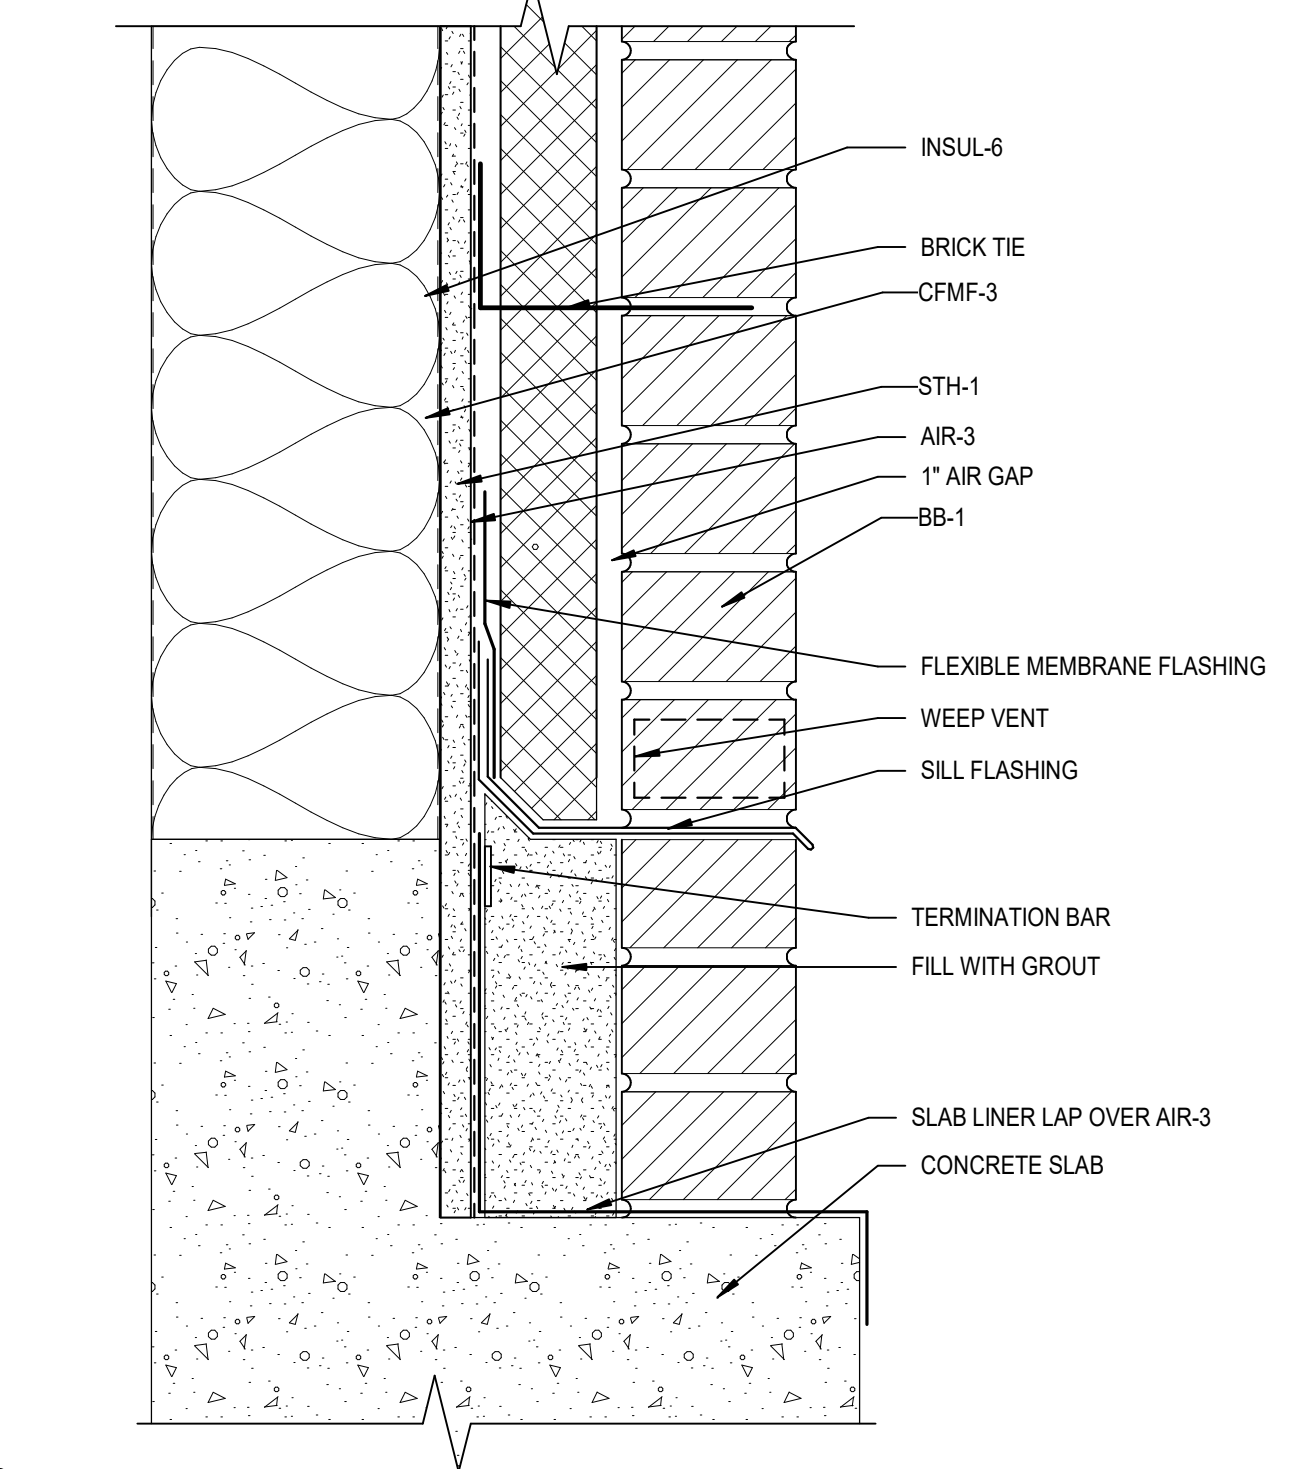


4E BRICK VENEER - SILL
A9.2 SCALE: 3" = 1'-0"

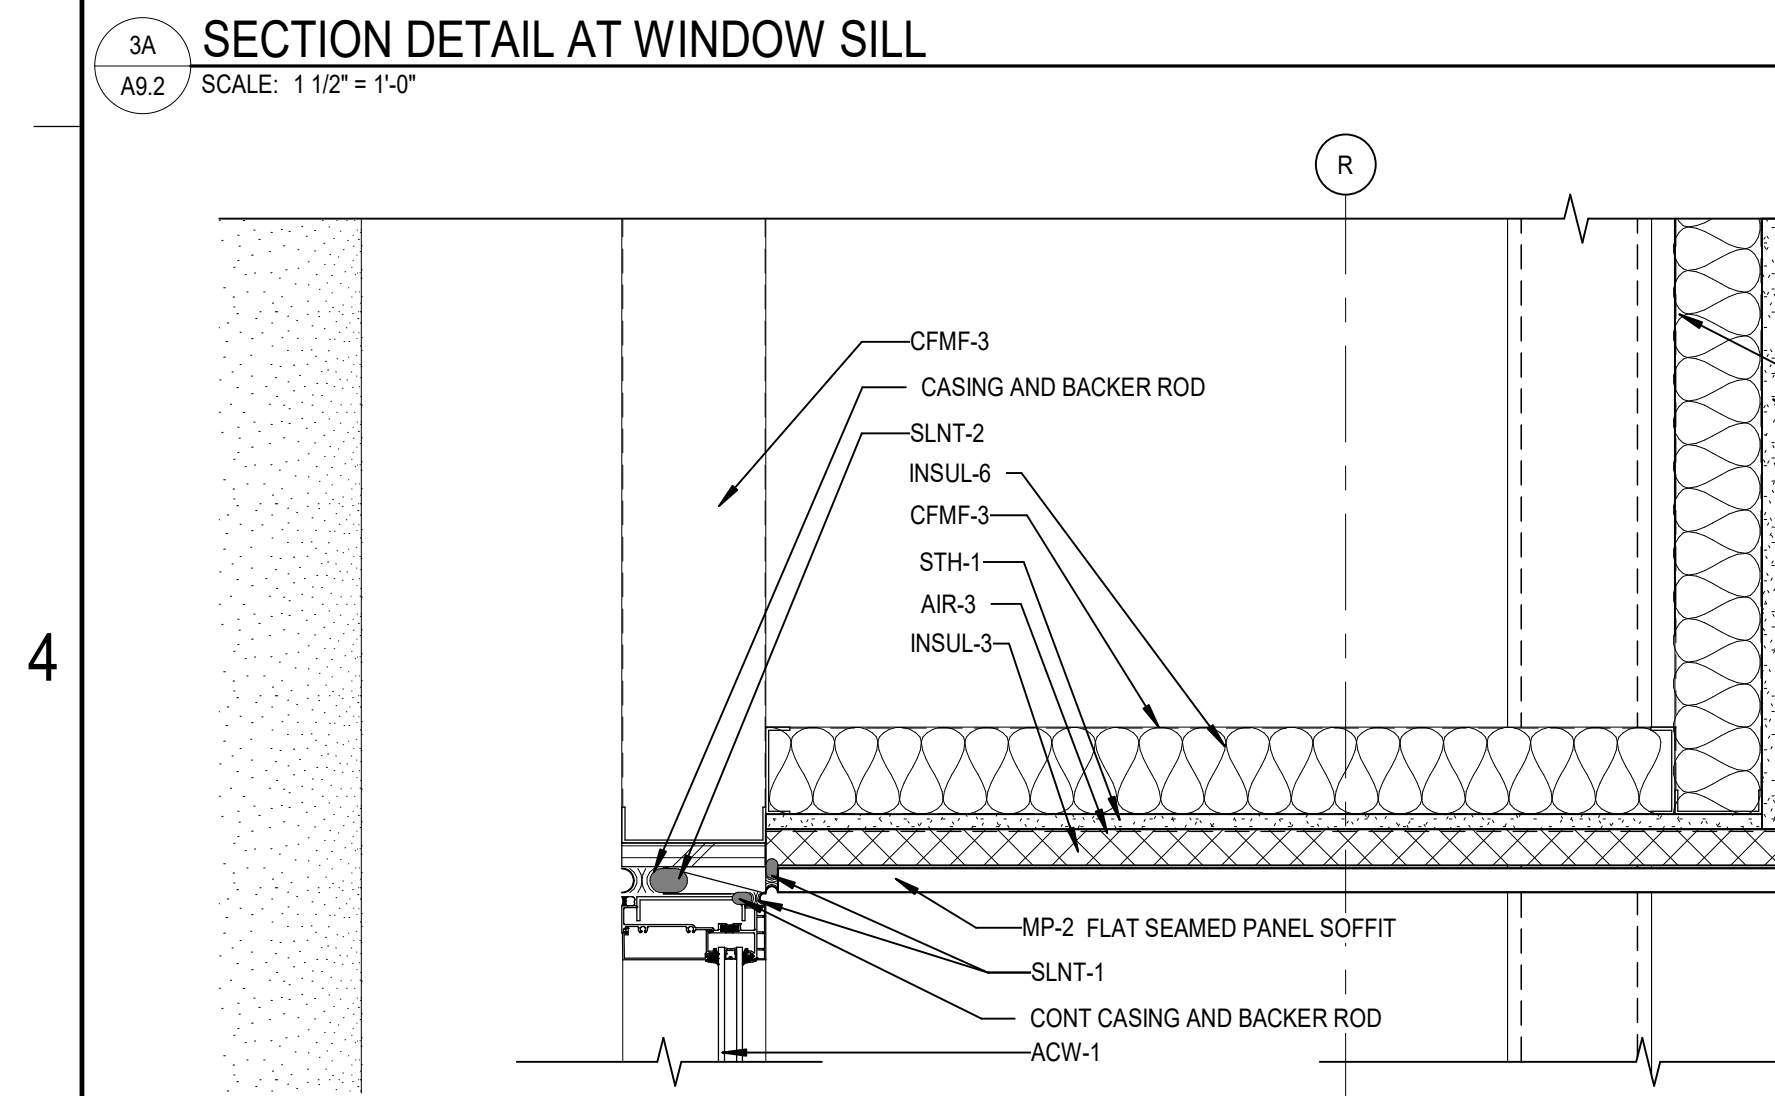

4A SECTION DETAIL AT PERFORATED BRICK SOFFIT
A9.2 SCALE: 1 1/2" = 1'-0"

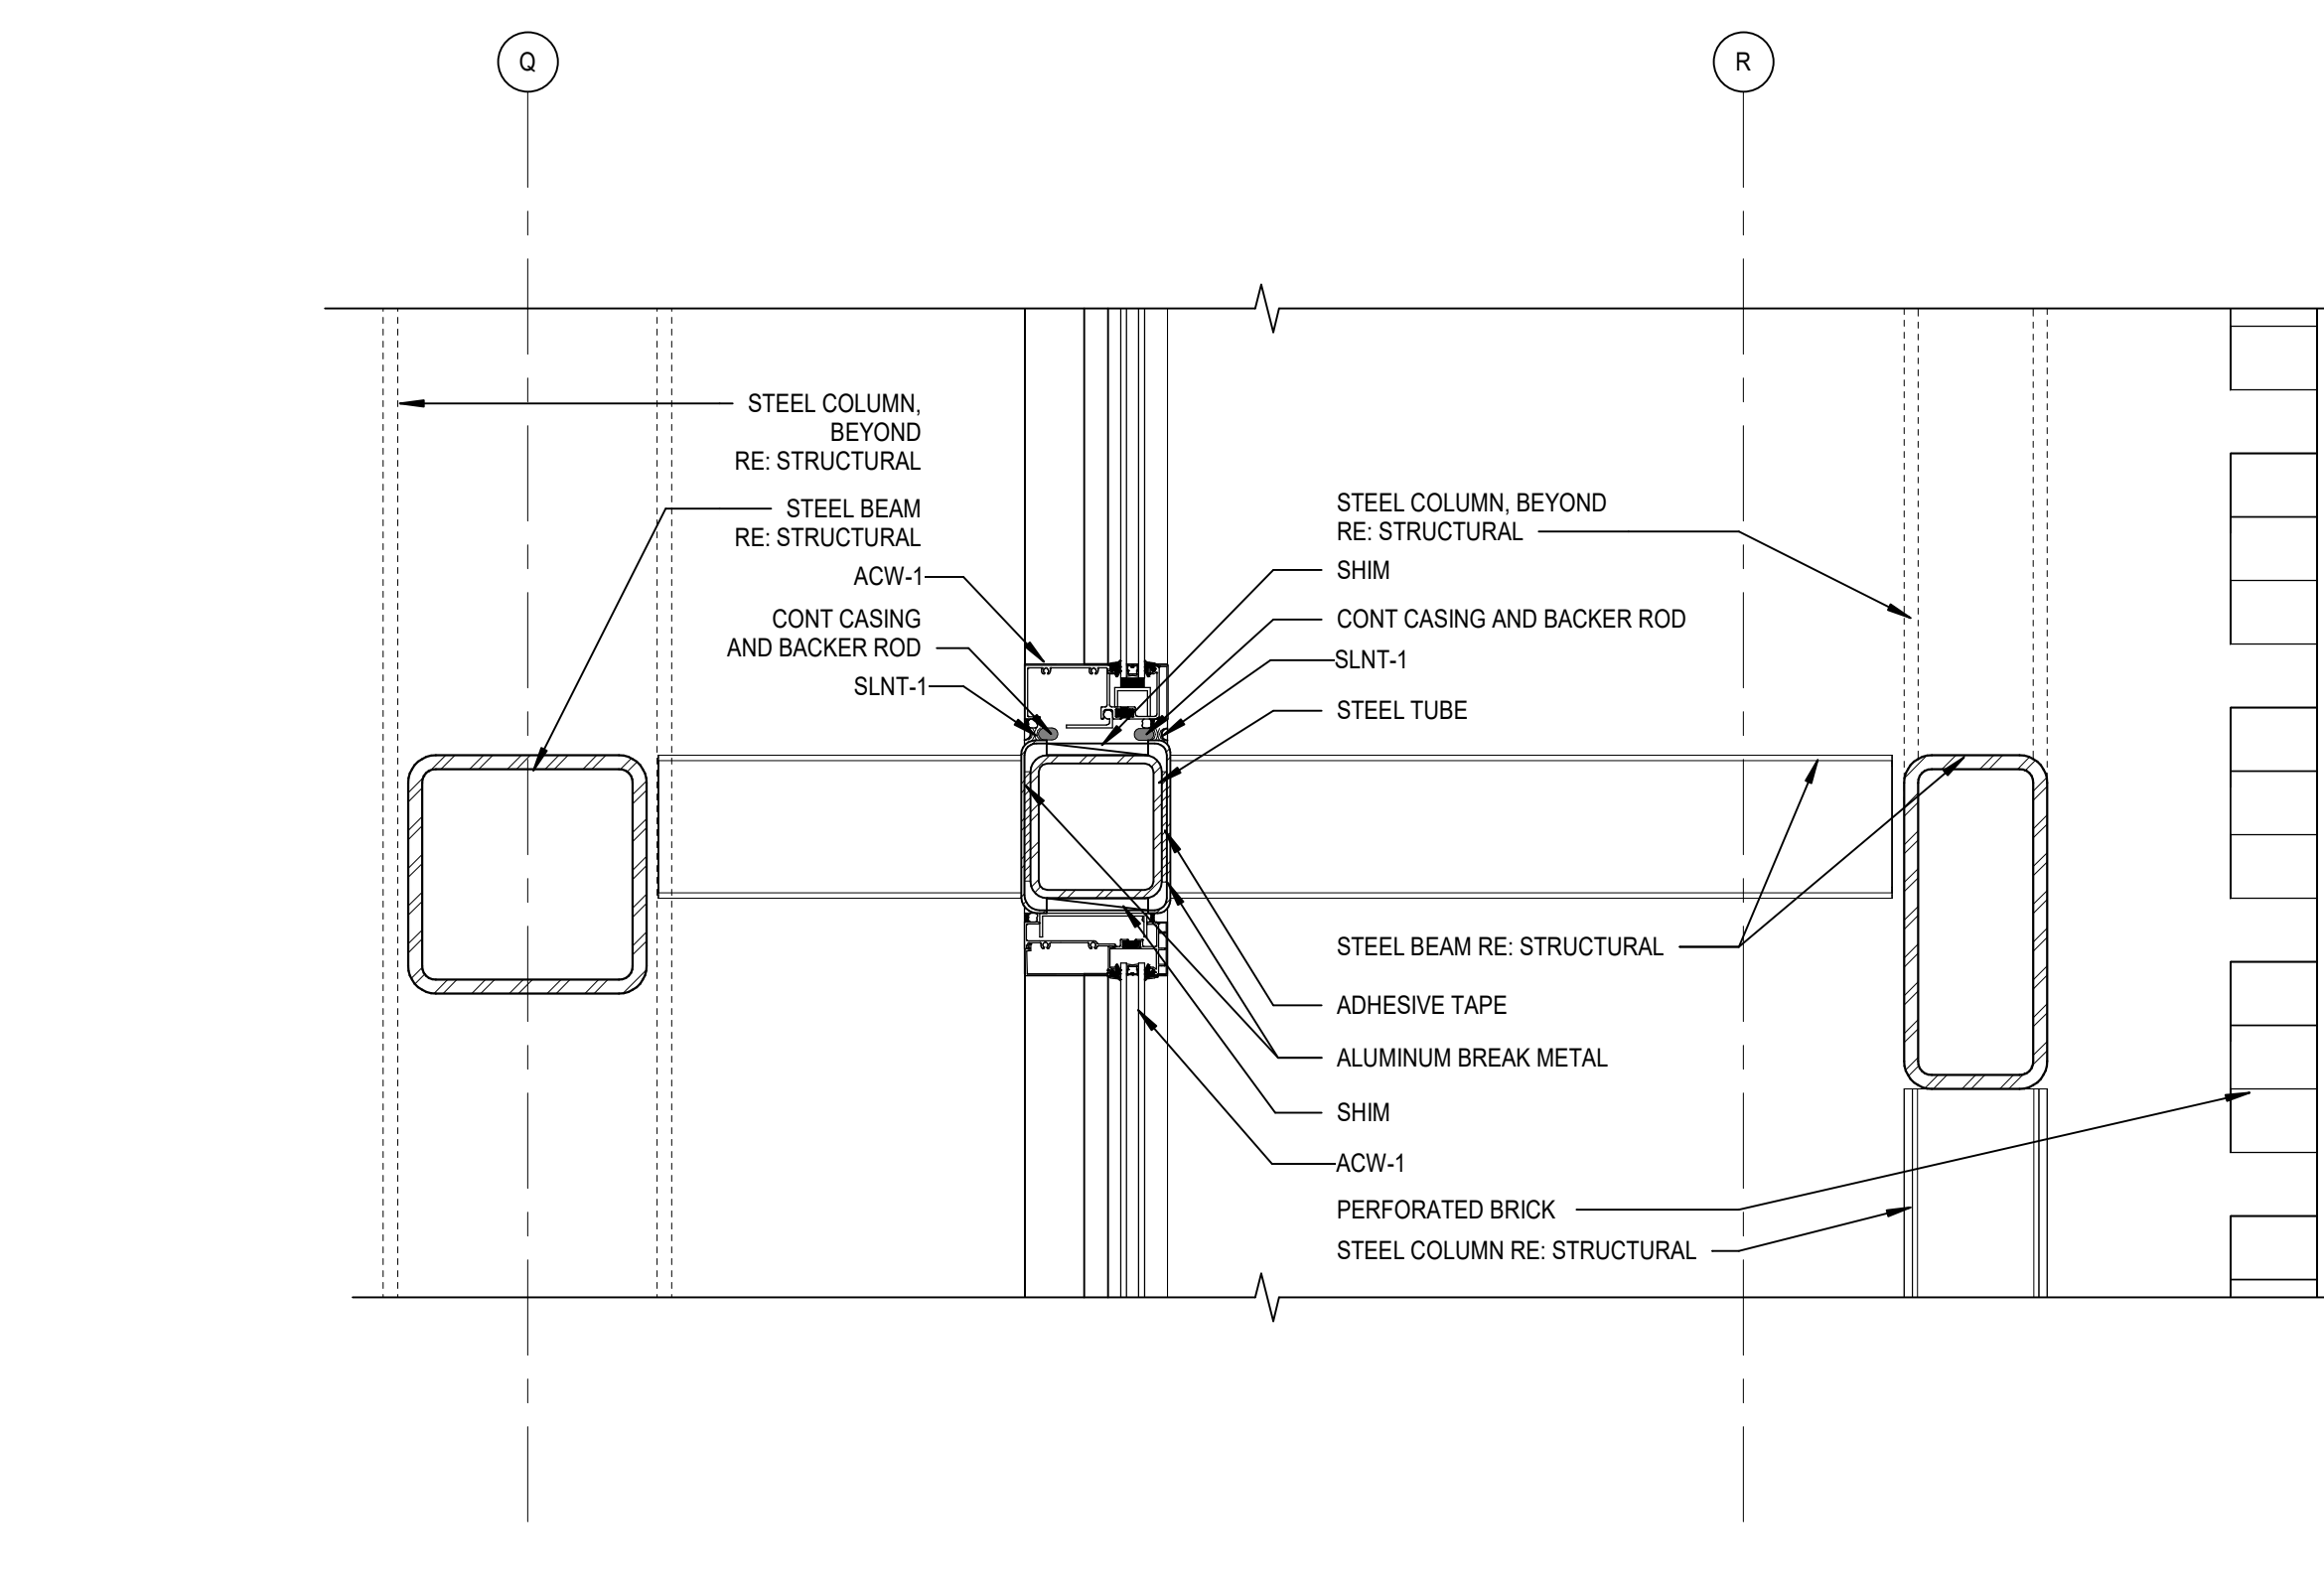


5C SECTION DETAIL AT CURTAIN WALL
A9.2 SCALE: 1 1/2" = 1'-0"

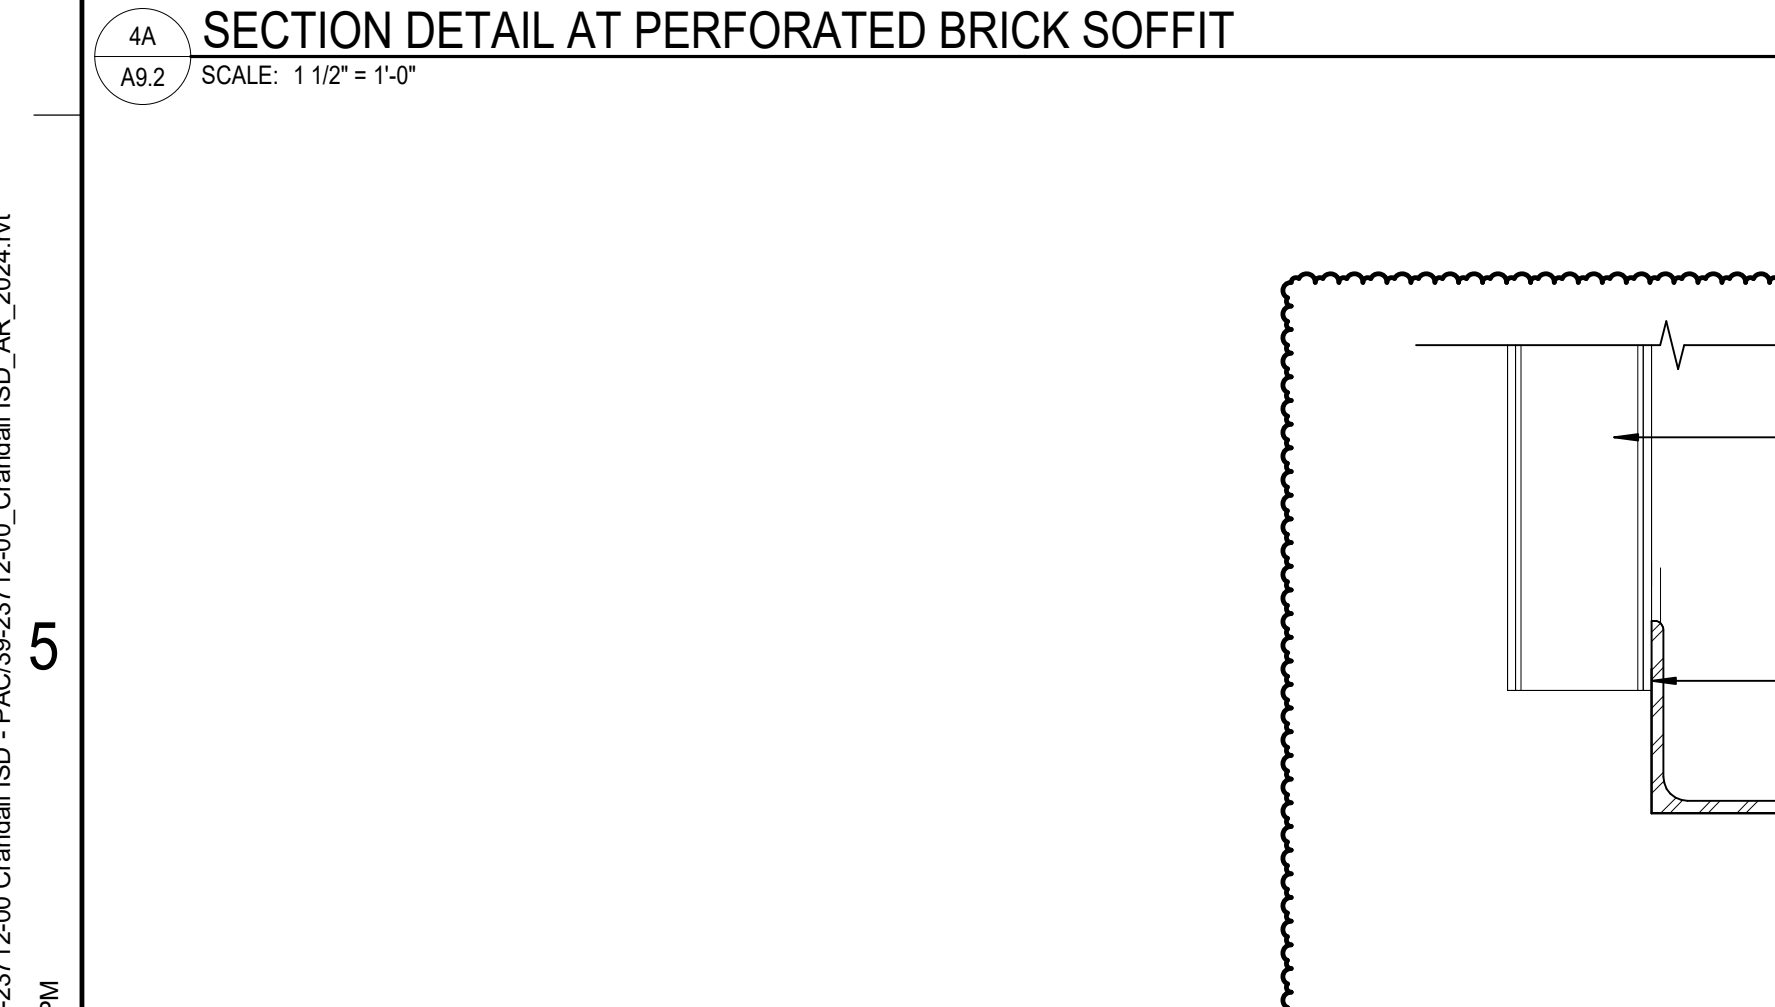

5B SECTION DETAIL AT PERFORATED BRICK LEDGE
A9.2 SCALE: 1 1/2" = 1'-0"

REFERENCE KEYNOTES

- ACW-1 ALUM CURTAIN WALL TYPE 1
- AIR-3 WEATHER BARRIER
- BB-1 BRICK BLENDED
- CFMF-2 CFMF EXTERIOR NON-LOAD-BEARING WALL FRAMING
- CFMF-3 CFMF INTERIOR NON-LOAD-BEARING WALL FRAMING
- INSUL-3 POLYISOCYANURATE (POLYISO) INSULATION
- INSUL-6 MINERAL WOOL BLANKET INSULATION, UNFACED
- MP-2 FORMED METAL WALL PANEL, FAC-CLAD FLUSH PANEL, OR SIMILAR, AT ALL PLACES WHERE ROOF TO CAP EXCEEDS 12' AS SHOWN, LAP UNDER COPING
- SLNT-1 SEALANT TYPE 1
- SLNT-2 SEALANT TYPE 2
- STH-1 GLASS-MAT GYPSUM SHEATHING

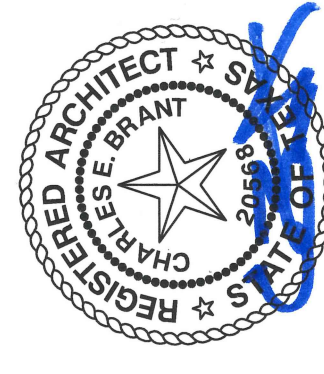


CRANDALL ISD HIGH SCHOOL
PAC ADDITION
13385 Fm 3038, Crandall, TX 75114

ISSUE FOR BID AND PERMIT
2024.07.25
REVISIONS
01 08/19/24 ADDENDUM 01





39-23712-00
EXTERIOR DETAILS


A9.2

Autodesk Docs://99-23712-00 Crandall ISD - PAC-238-23712-00_Crandall ISD_AR_2024.rvt
8/19/2024 7:55:11 PM

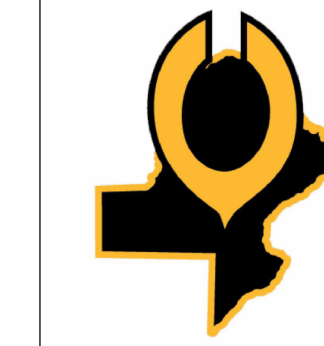

1
2
3
4
5

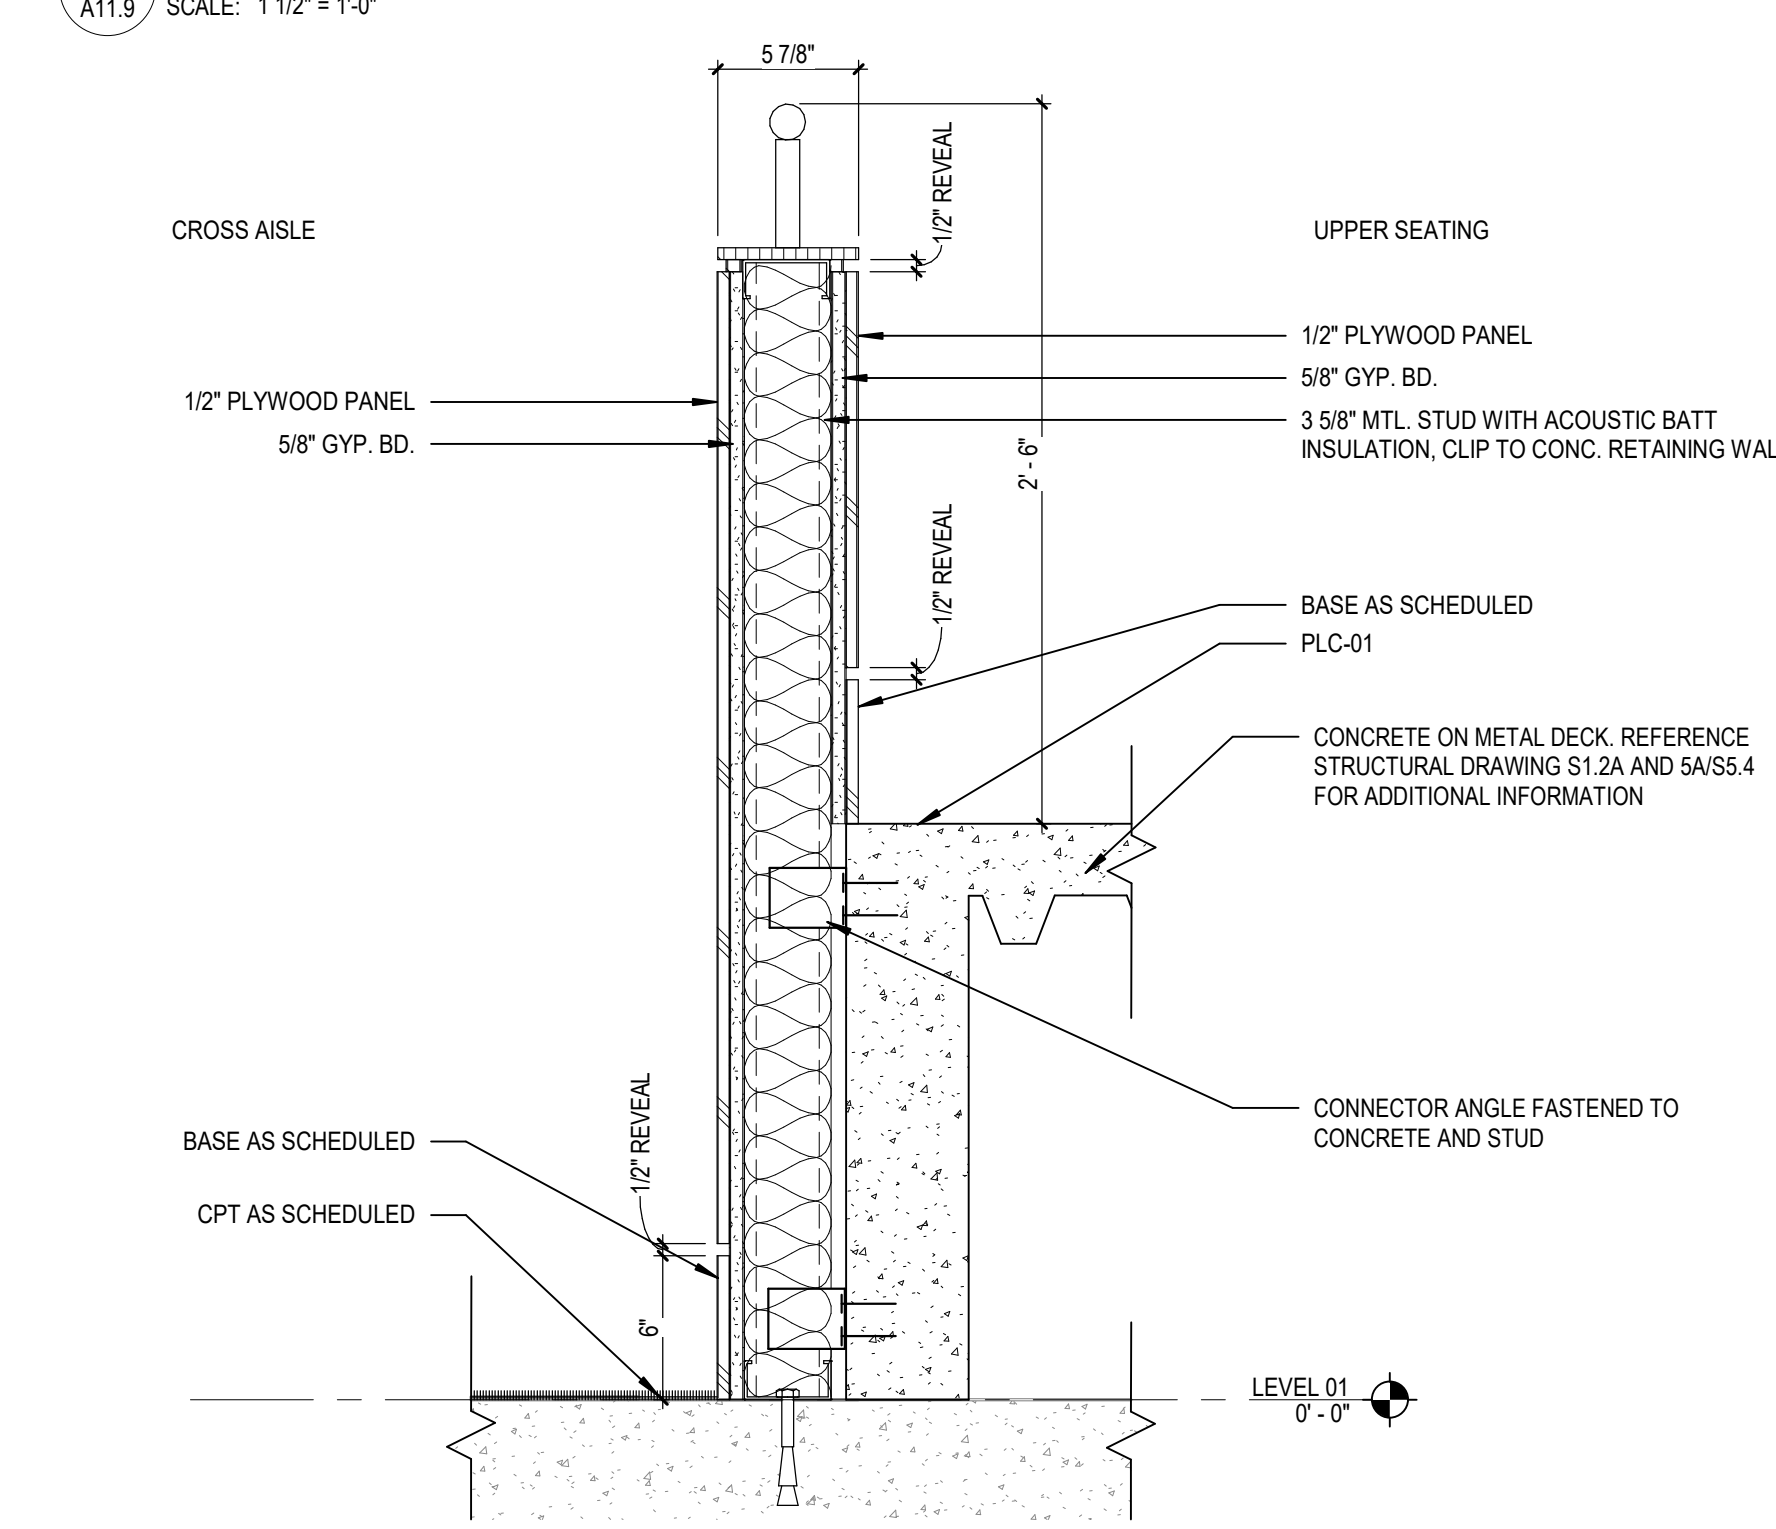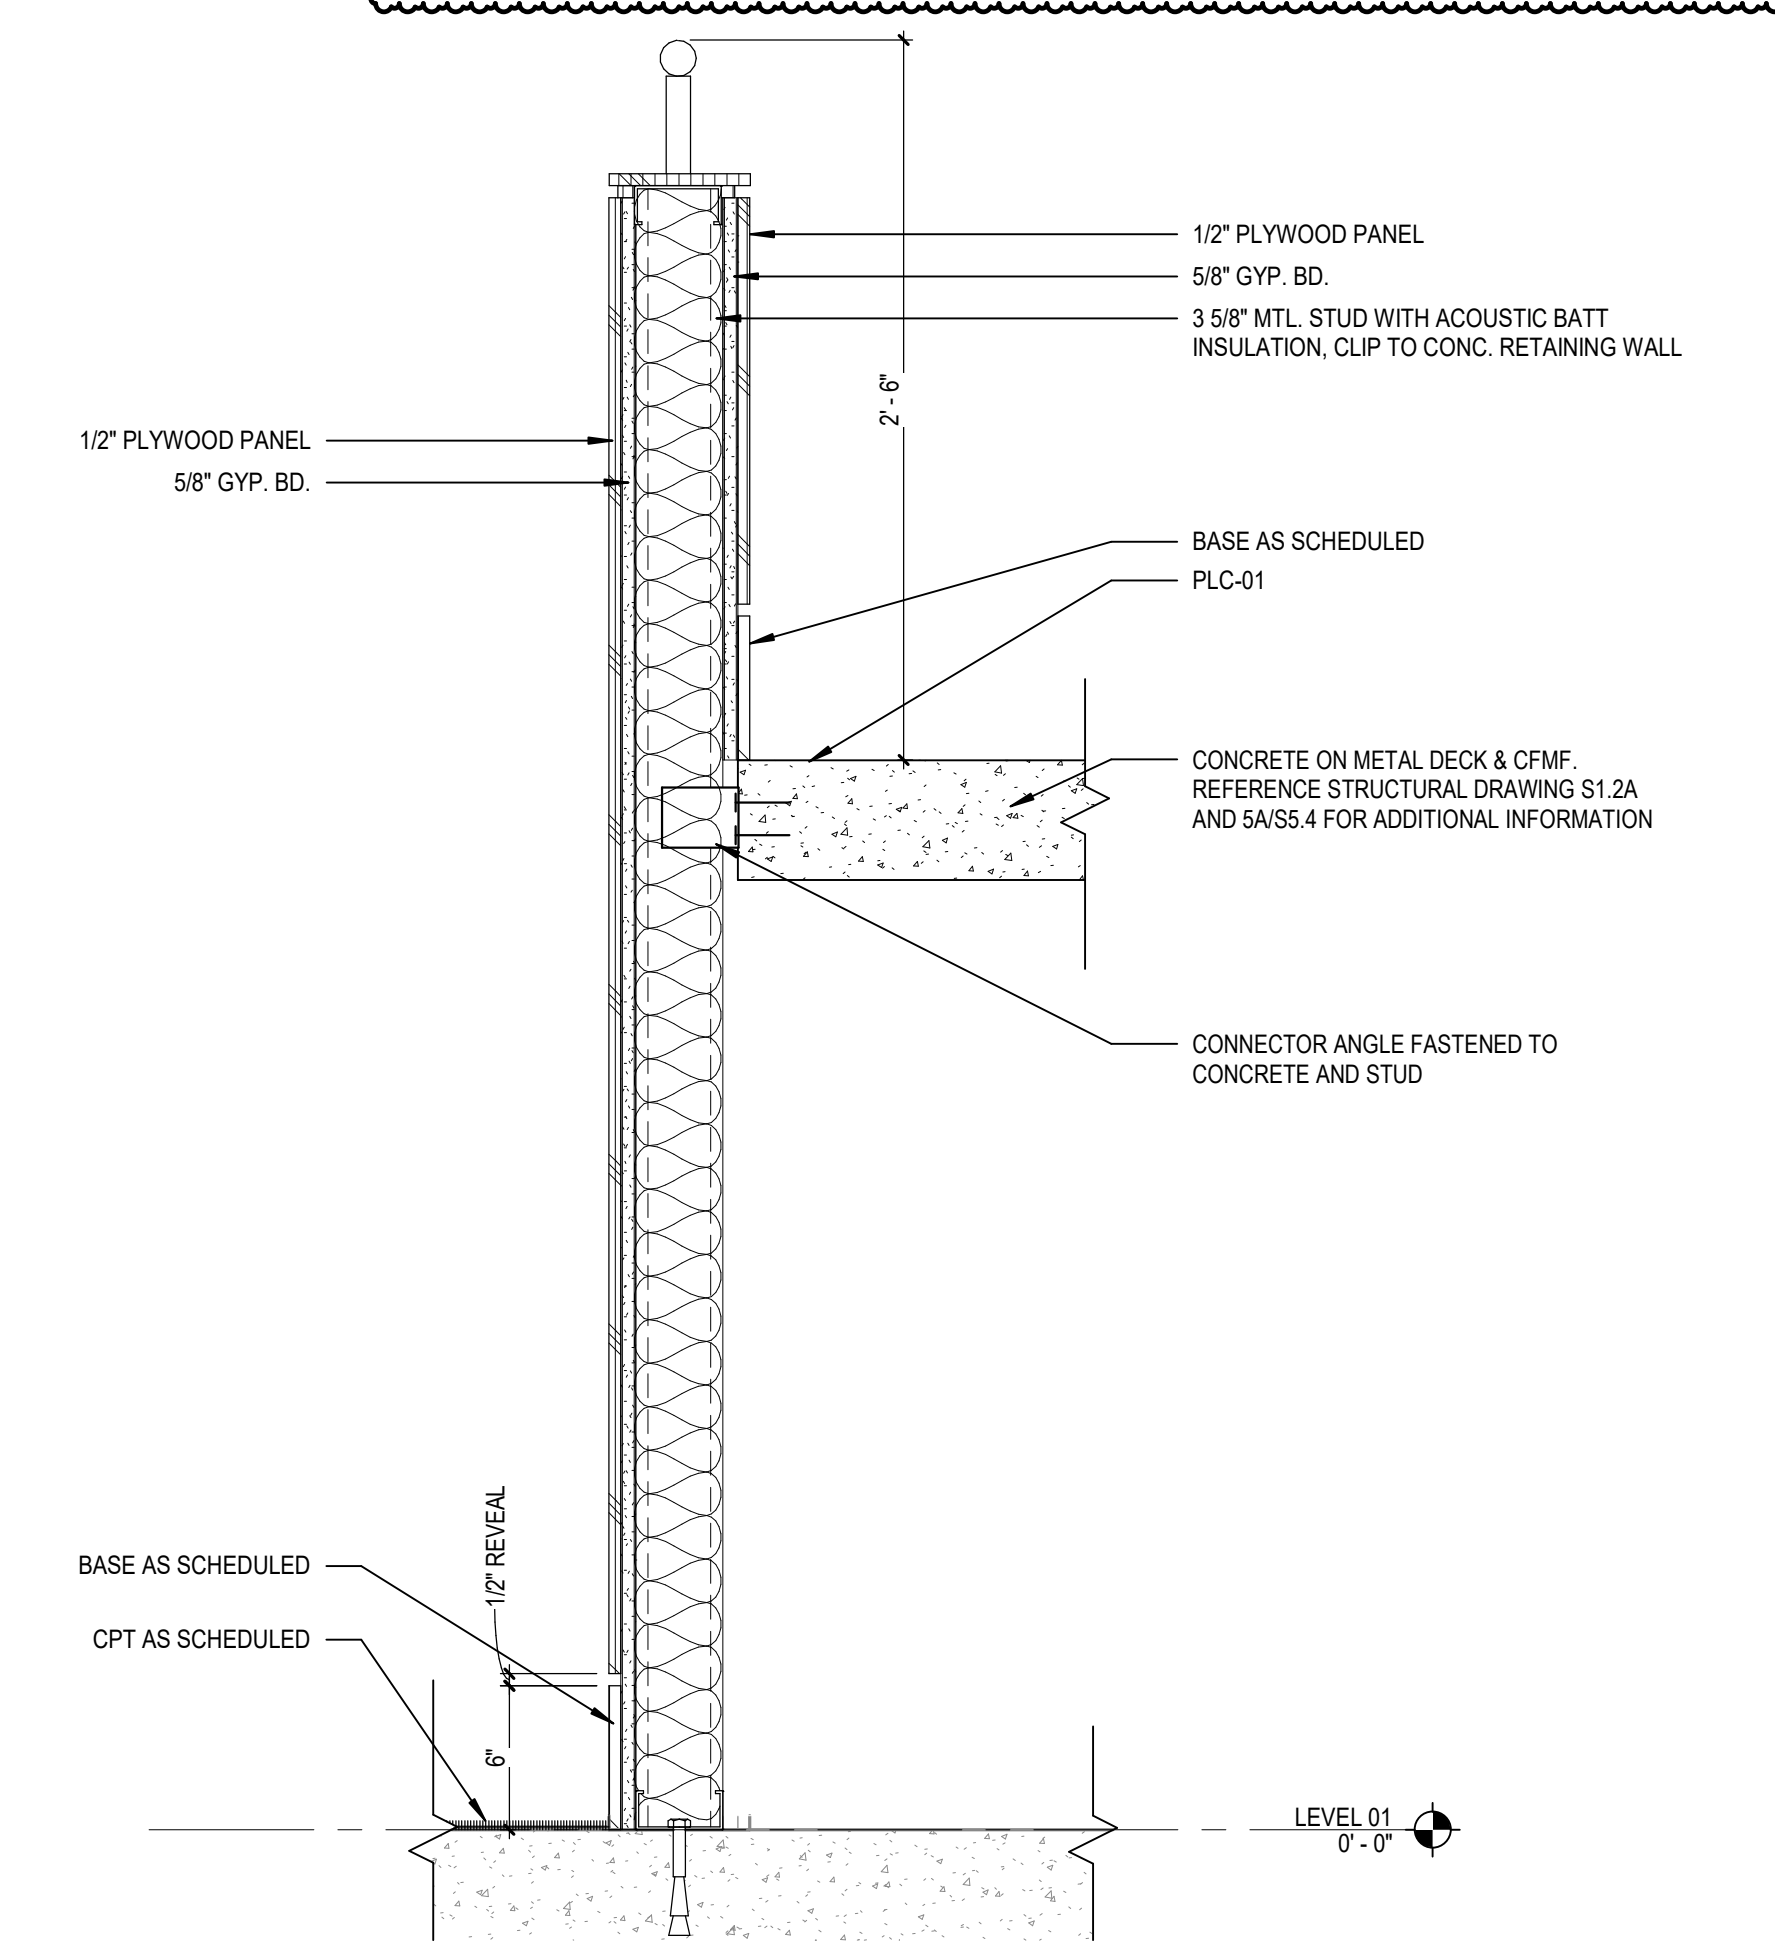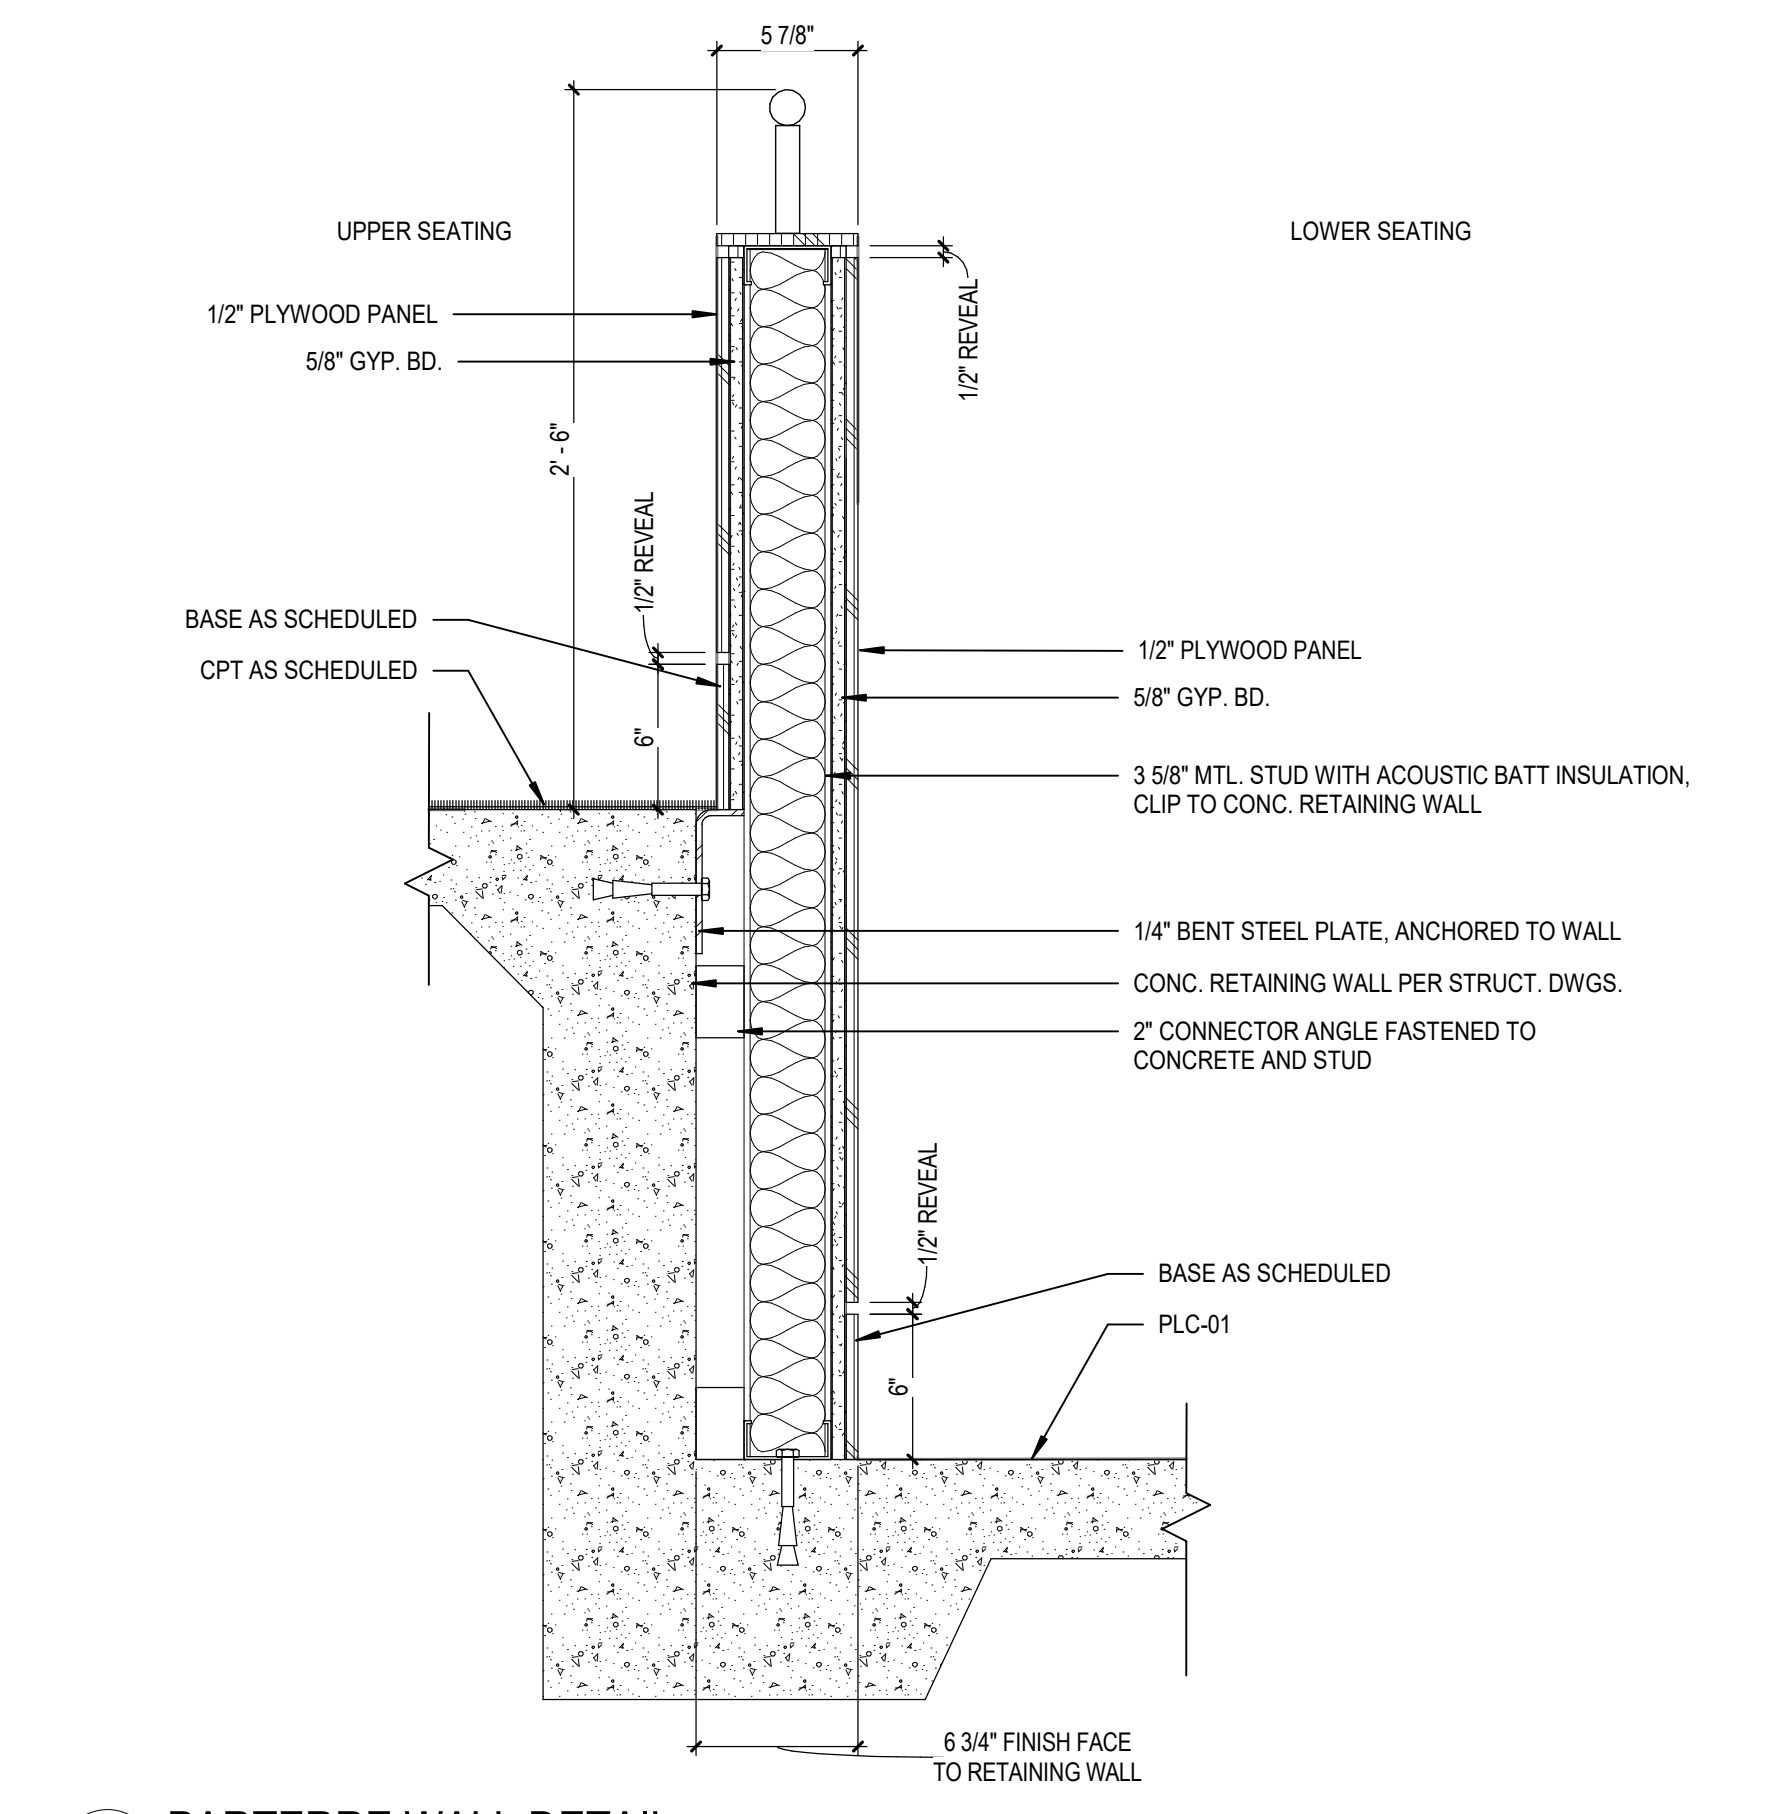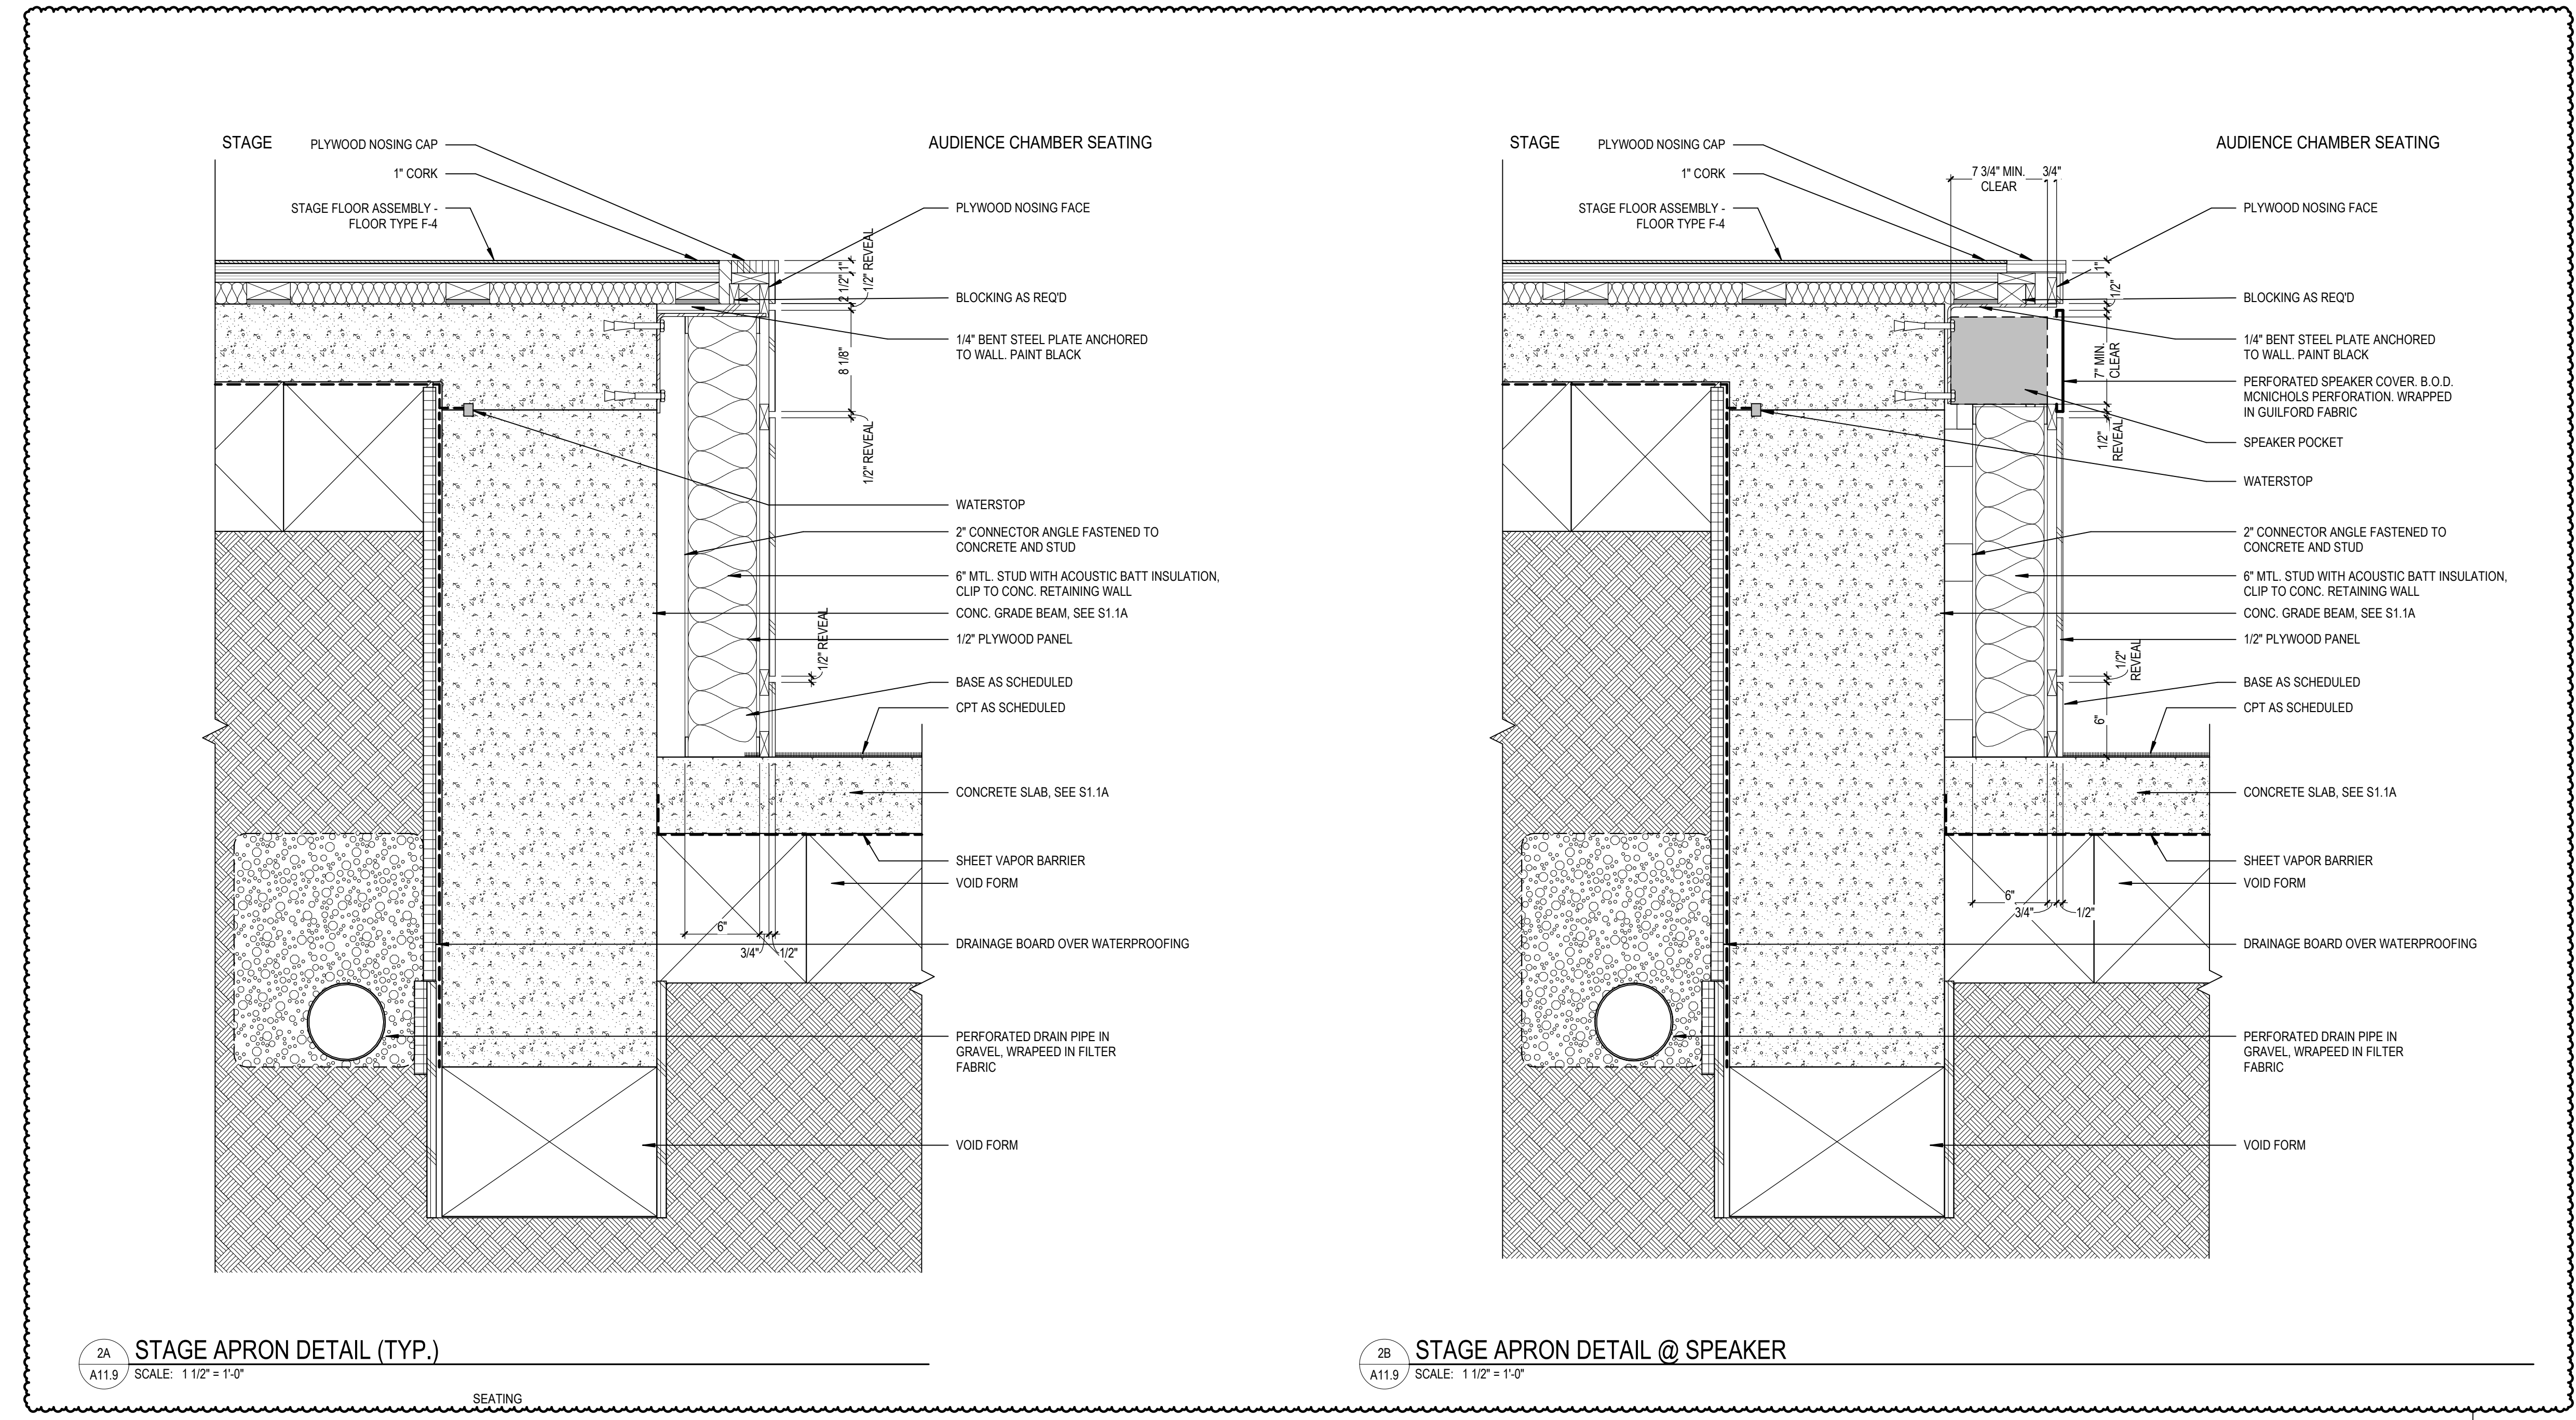

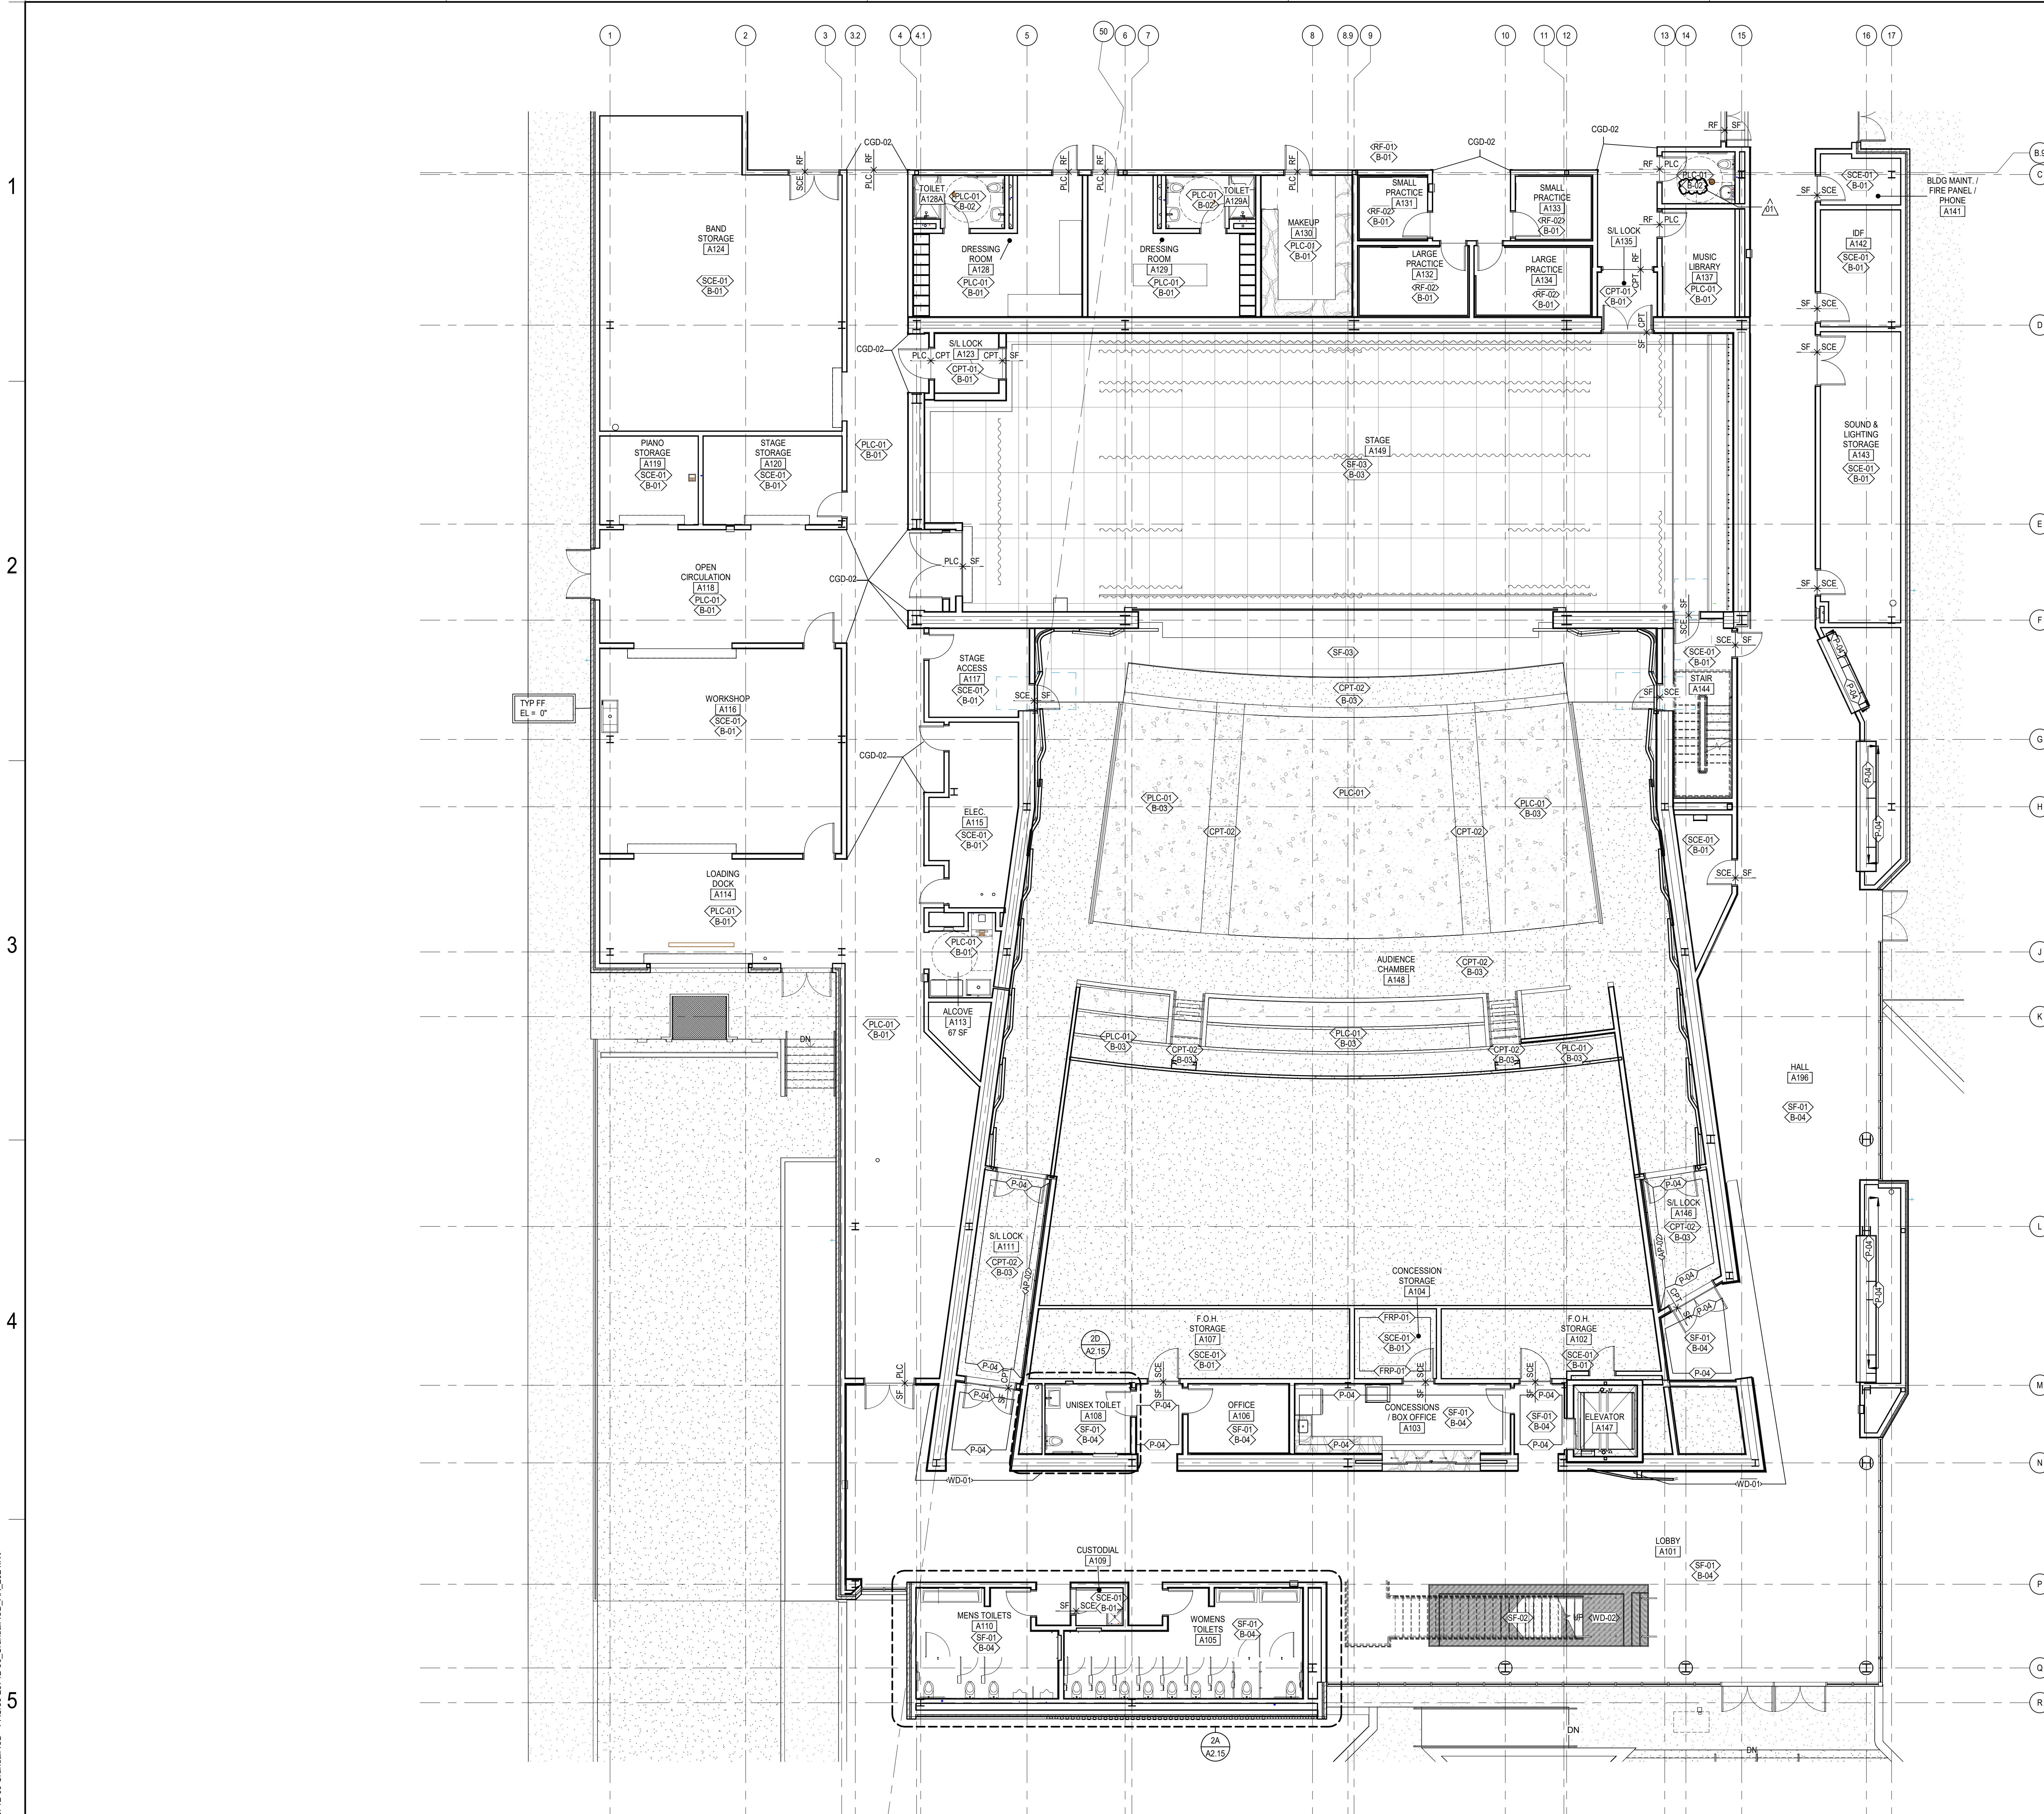

**INTERIOR FINISH PLAN
GENERAL NOTES**

- A. ROOM FINISH SCHEDULE GENERAL NOTES APPLY TO ALL ROOM FINISH SCHEDULE SHEETS.
- B. INTERIOR FINISH PLAN GENERAL NOTES APPLY TO ALL INTERIOR FINISH PLAN SHEETS.
- C. NOT ALL FLOOR AND WALL FINISHES ARE NOTED ON THE INTERIOR FINISH PLANS. SEE ROOM FINISH SCHEDULE FOR FLOOR AND WALL FINISHES NOT NOTED.
- D. FLOOR PATTERN DIMENSIONS AND LOCATIONS ARE APPROXIMATE. MINOR ADJUSTMENTS MAY BE MADE FOR LAYOUT AND TO MINIMIZE WASTE AS LONG AS THE DESIGN INTENT IS MAINTAINED.
- E. FOR FLOOR TILE PRODUCTS, ADJUST LAYOUT AS NECESSARY TO AVOID USING CUT WIDTHS THAT EQUAL LESS THEN ONE-HALF OF A TILE AT ROOM PERIMETER.



CRANDALL ISD HIGH SCHOOL
PAC ADDITION
13385 Fm 3039, Crandall, TX 75114

ISSUE FOR BID AND PERMIT
2024.07.25
REVISIONS
01 08/19/24 ADDENDUM 01

39-23712-00
LEVEL 01 - AREA A - FINISH PLAN

A12.1A

Autodesk Docs://99-23712-00 Crandall ISD - PAC/39-23712-00 Crandall ISD_AR_2024.rvt 8/19/2024 7:55:44 PM

LEVEL 01 - AREA A - FINISH PLAN
SCALE: 1/8" = 1'-0"

**INTERIOR FINISH PLAN
GENERAL NOTES**

- A. ROOM FINISH SCHEDULE GENERAL NOTES APPLY TO ALL ROOM FINISH SCHEDULE SHEETS
- B. INTERIOR FINISH PLAN GENERAL NOTES APPLY TO ALL INTERIOR FINISH PLAN SHEETS
- C. NOT ALL FLOOR AND WALL FINISHES ARE NOTED ON THE INTERIOR FINISH PLANS. SEE ROOM FINISH SCHEDULE FOR FLOOR AND WALL FINISHES NOT NOTED.
- D. FLOOR PATTERN DIMENSIONS AND LOCATIONS ARE APPROXIMATE. MINOR ADJUSTMENTS MAY BE MADE FOR LAYOUT AND TO MINIMIZE WASTE AS LONG AS THE DESIGN INTENT IS MAINTAINED.
- E. FOR FLOOR TILE PRODUCTS, ADJUST LAYOUT AS NECESSARY TO AVOID USING CUT WIDTHS THAT EQUAL LESS THEN ONE-HALF OF A TILE AT ROOM PERIMETER.




CRANDALL ISD HIGH SCHOOL
PAC ADDITION

13385 Fm 3038, Crandall, TX 75114

ISSUE FOR BID
AND PERMIT
2024.07.25
REVISIONS
01 08/19/24 ADDENDUM 01


39-23712-00
LEVEL 01 - AREA
B - FINISH PLAN

A12.1B

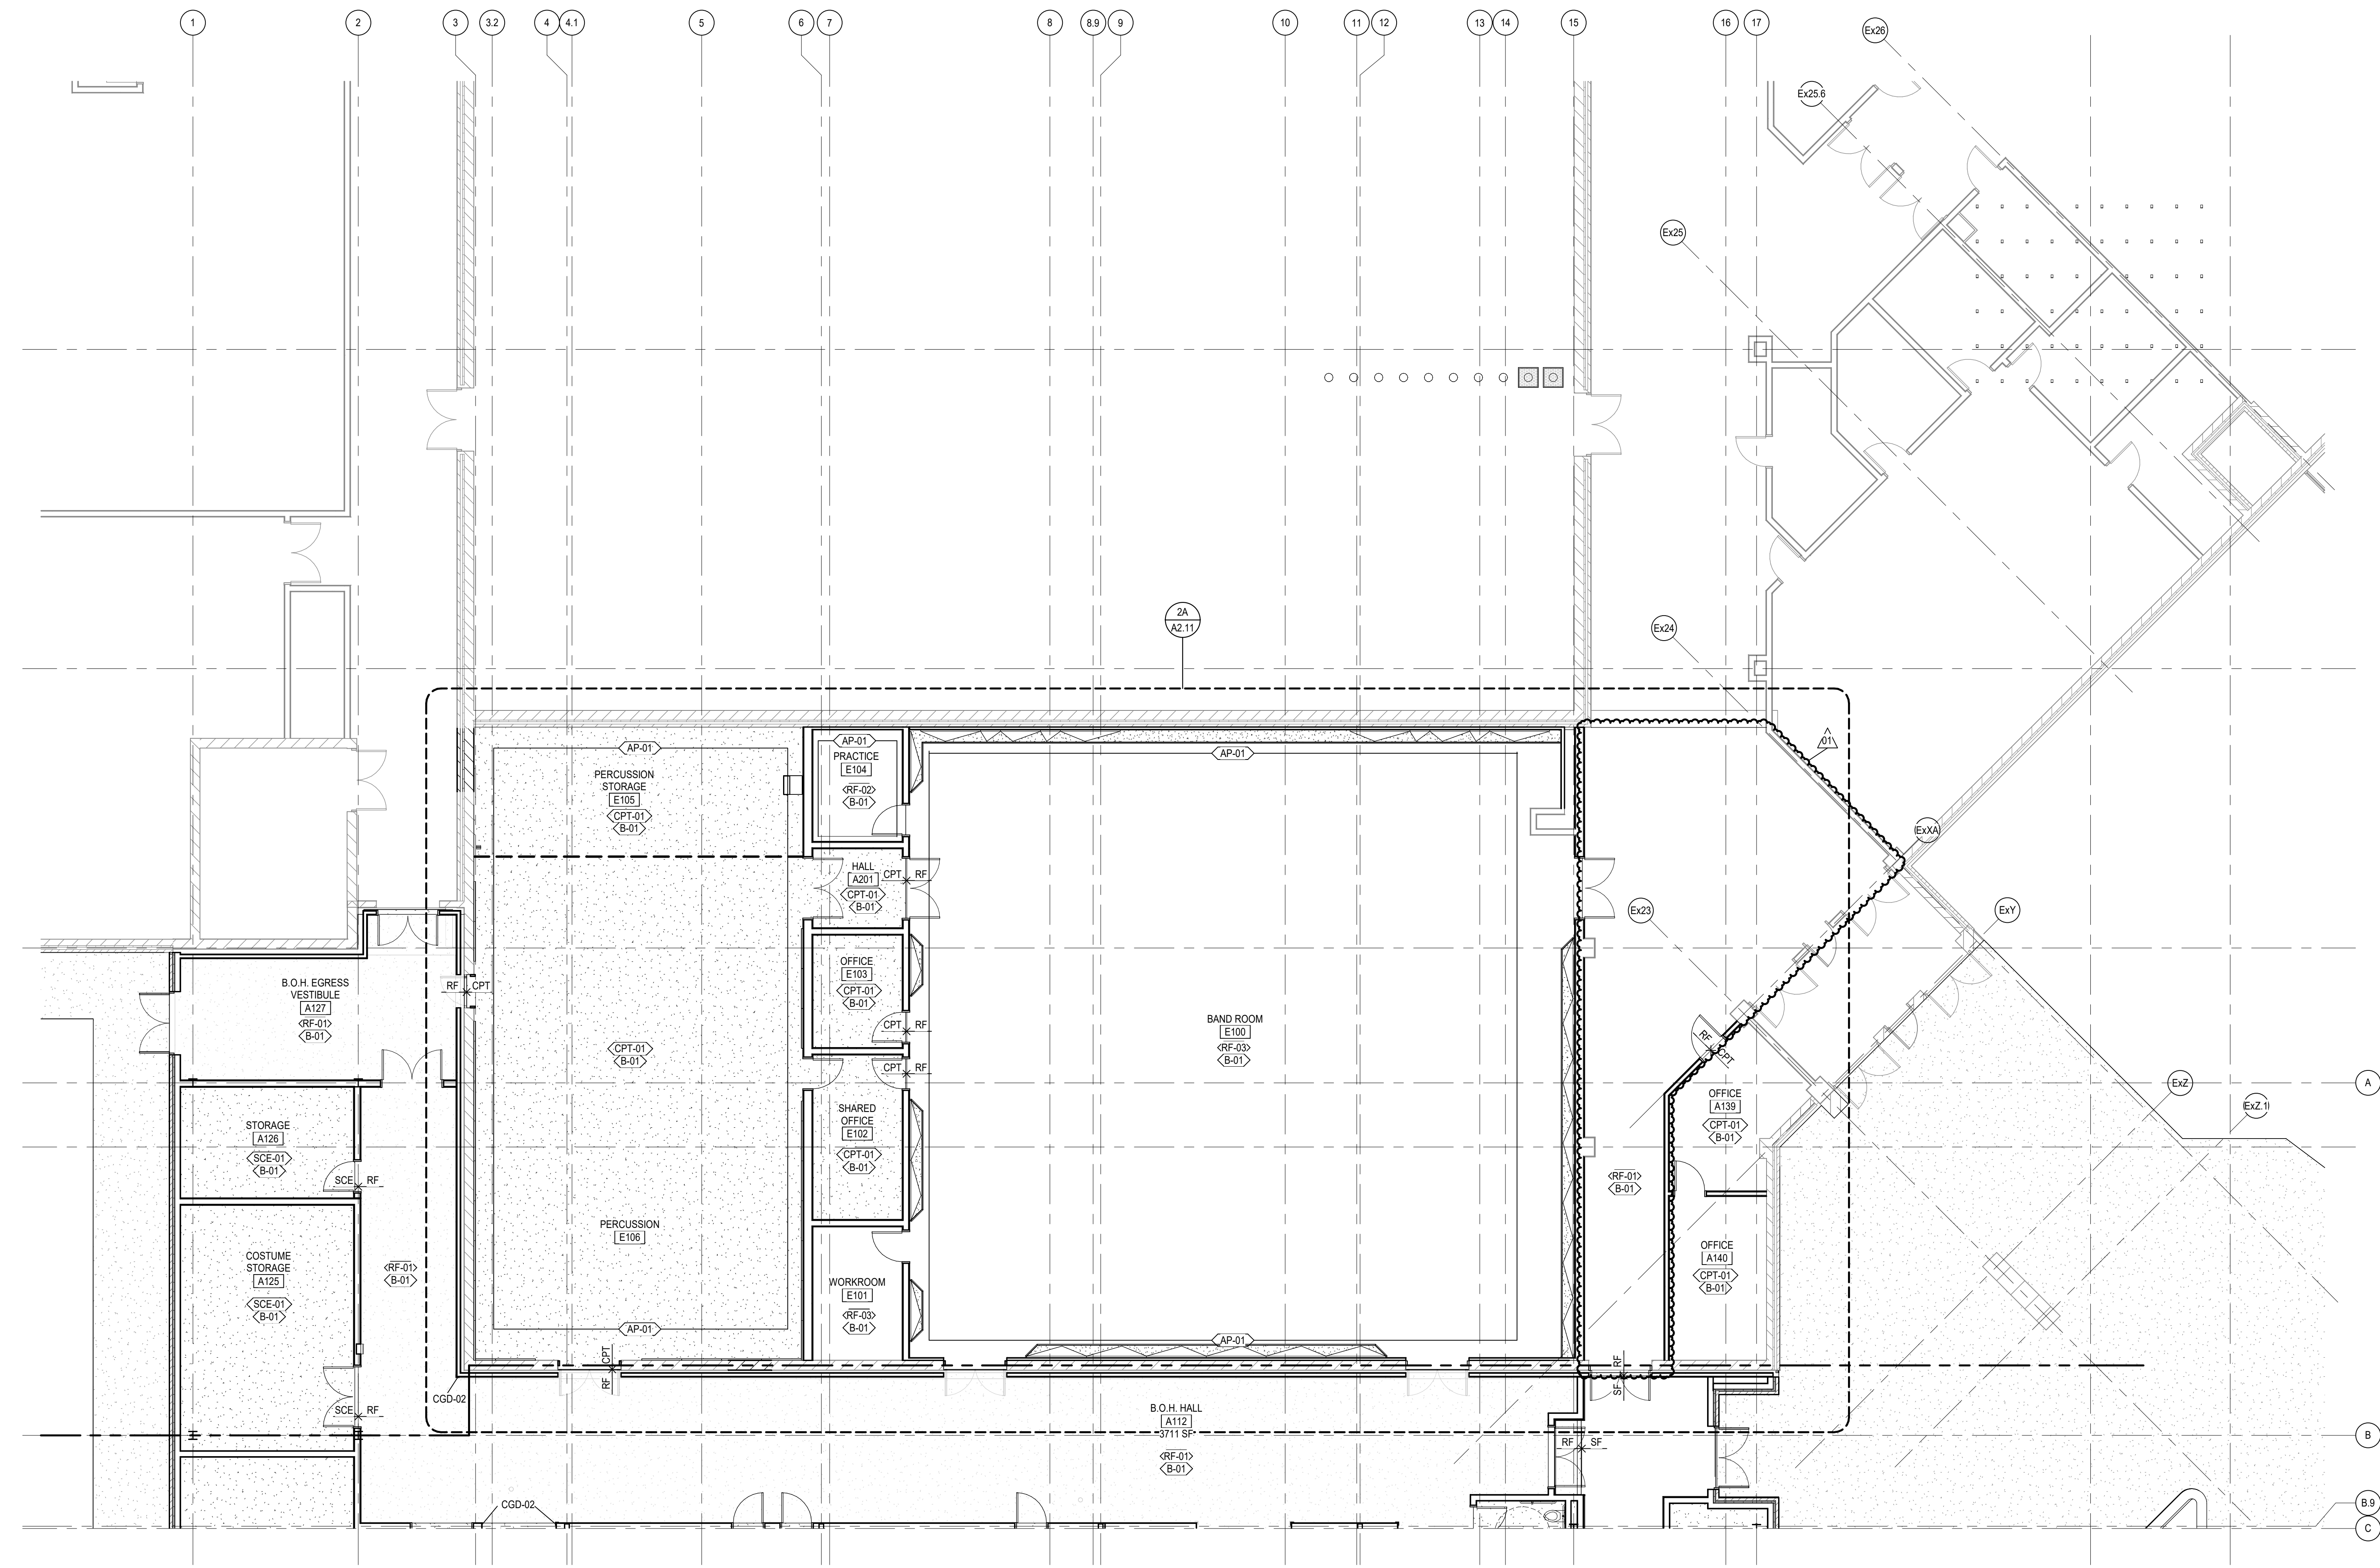

LEVEL 01 - AREA B - FINISH PLAN
SCALE: 1/8" = 1'-0"

Autodesk Docs://99-23712-00_Crandall ISD - PAC/39-23712-00_Crandall ISD_AR_2024.rvt
8/9/2024 7:55:45 PM



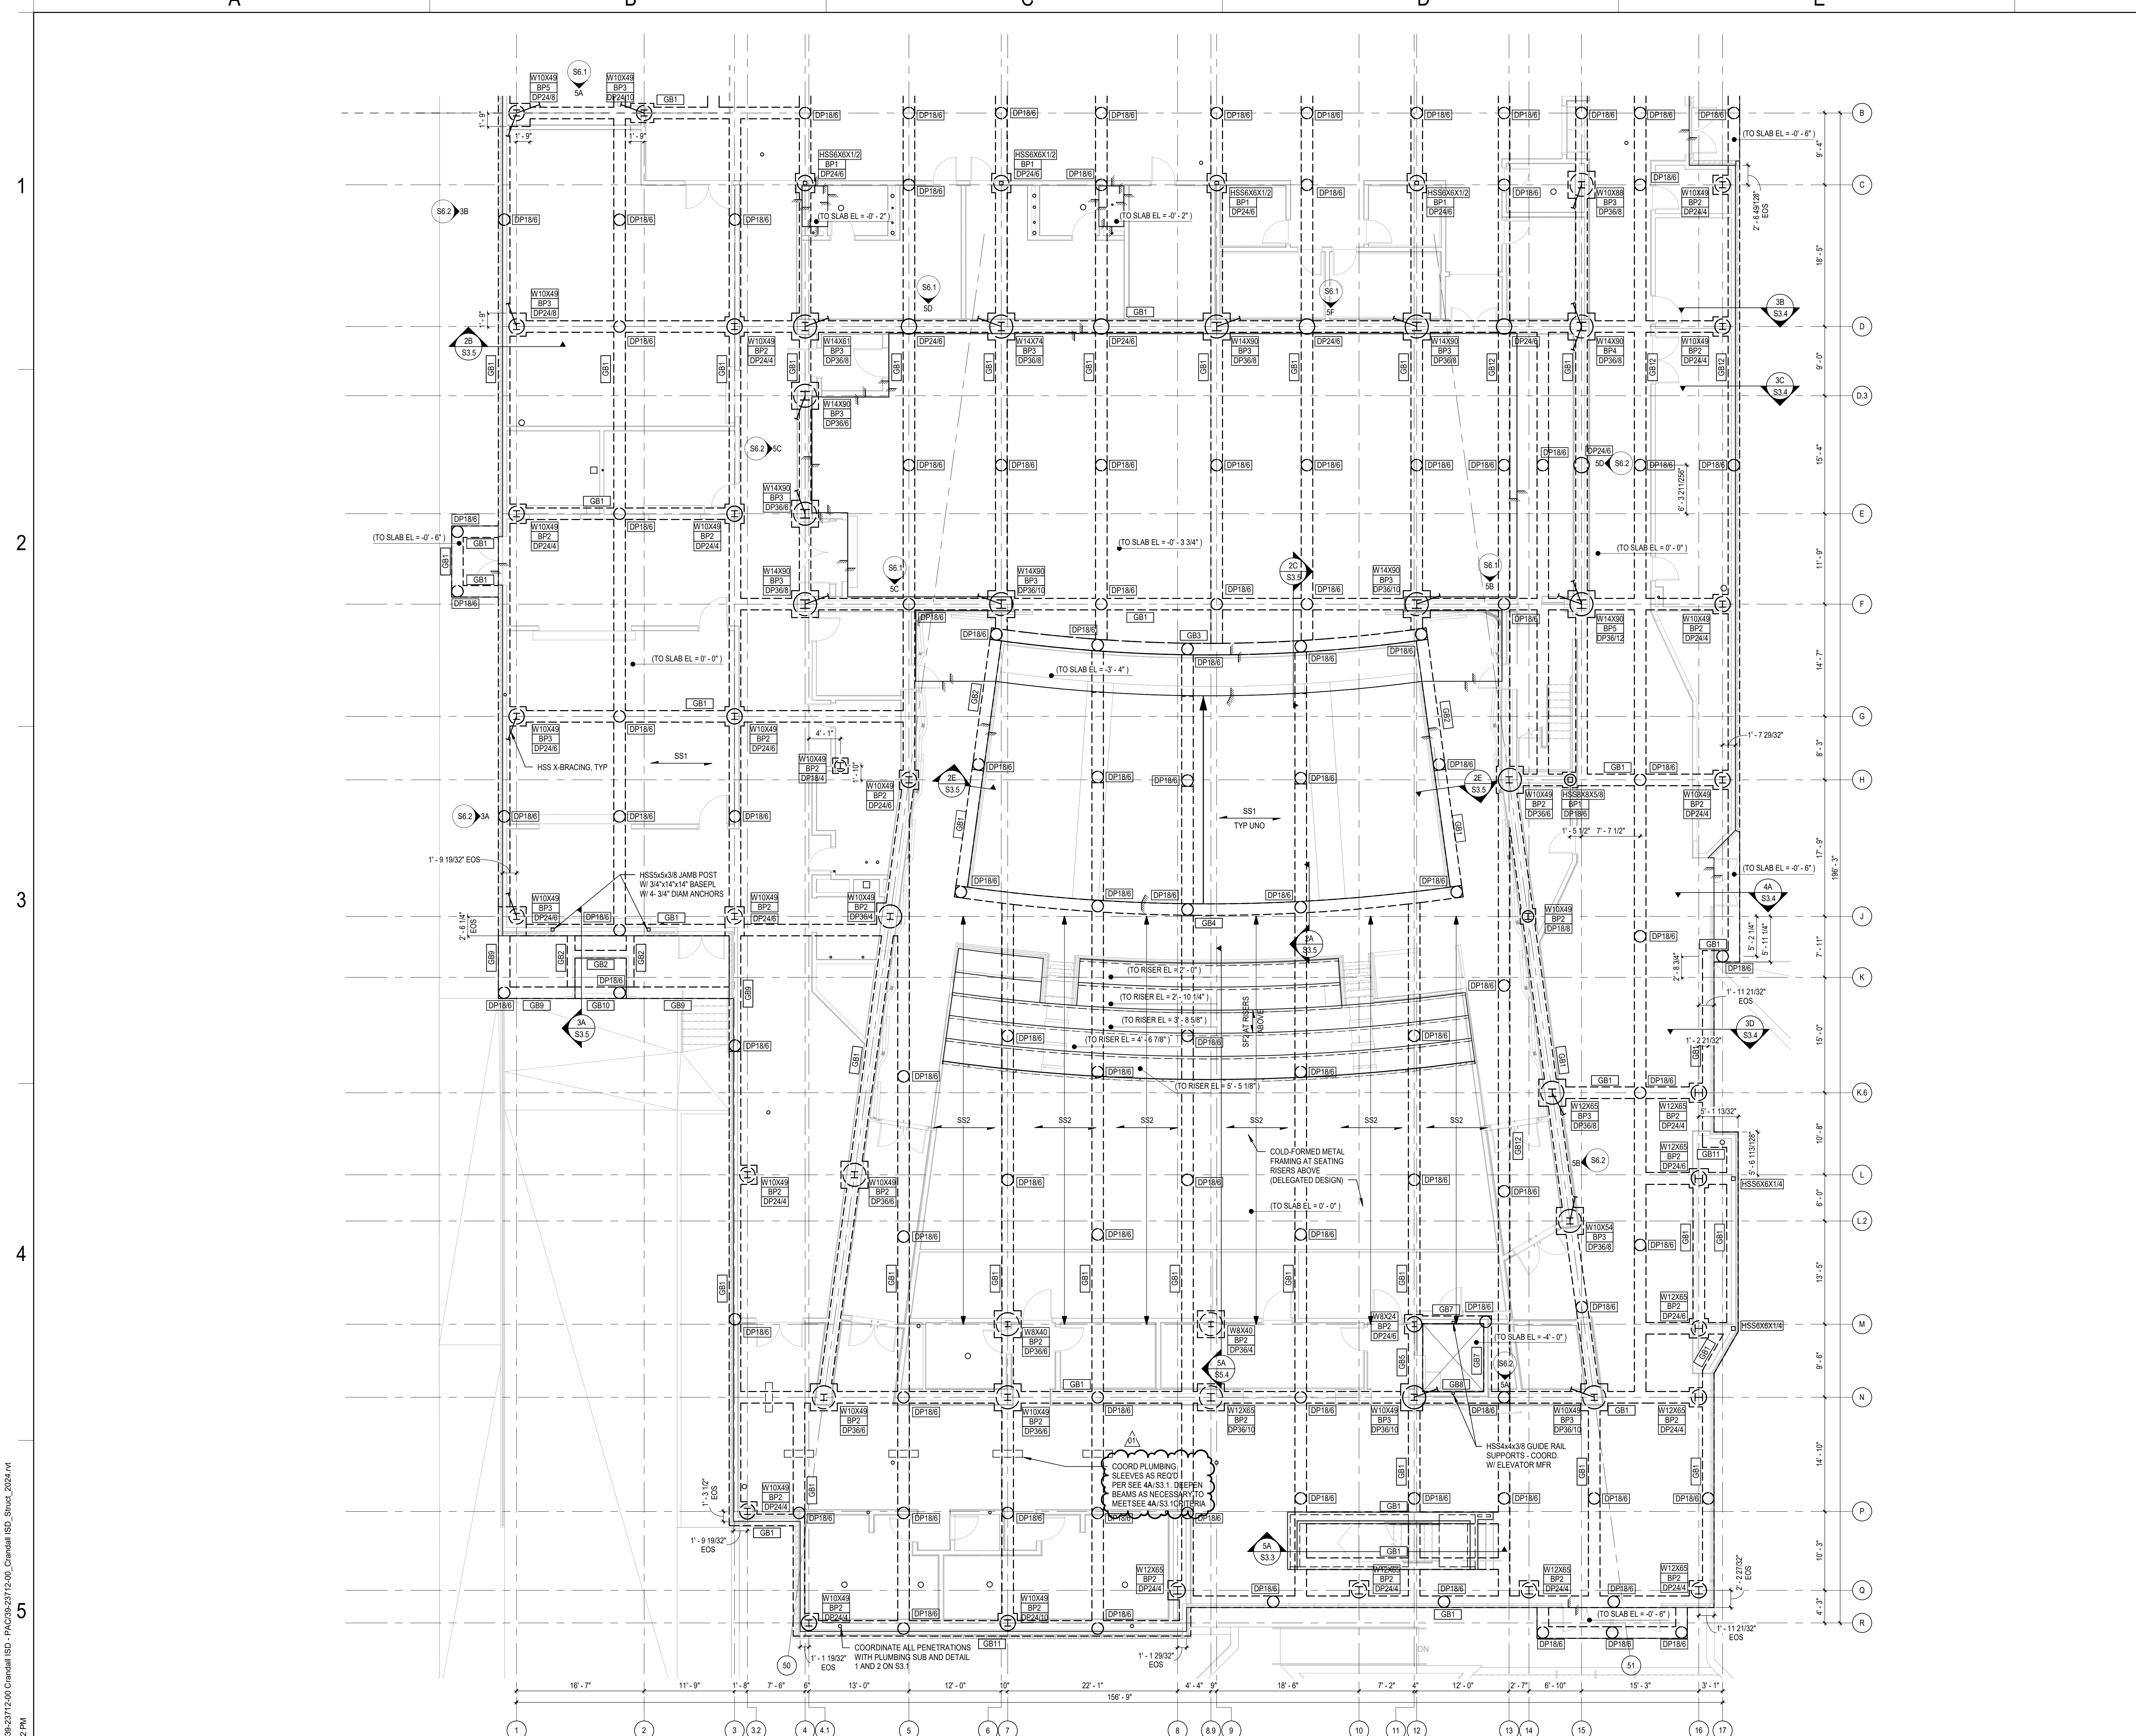


LEVEL 01 - AREA A - FOUNDATION PLAN
 SCALE: 1/8" = 1'-0"

FOUNDATION PLAN GENERAL NOTES


- A. TOP OF STRUCTURAL SLAB ELEVATION = 0'-0" UNO. COORDINATE TOP OF SLAB WITH FLOOR FINISHES. SEE ARCHITECTURAL DRAWINGS.
- B. TOP OF RIER ELEVATION (TYP) = 3'-2" UNO.
- C. S1 = 6" CONCRETE SLAB ON 12" VOID FORMS. REINF. W/ #5 AT 8" OC TOP AND BOTTOM IN DIRECTION OF SPAN (OUTER LAYER), AND #4 AT 16" OC PERPENDICULAR TO SPAN DIRECTION (INNER LAYER).
- D. S2 = 6" CONCRETE SLAB ON 12" VOID FORMS. REINF. W/ #5 AT 8" OC TOP AND BOTTOM IN DIRECTION OF SPAN (OUTER LAYER), AND #4 AT 16" OC PERPENDICULAR TO SPAN DIRECTION (INNER LAYER).
- E. S3 = 4-1/2" NORMAL-WT CONCRETE OVER 2" COMPOSITE METAL DECK (20 GA. GALV.). TOTAL SLAB THICKNESS = 6-1/2". REINF. W/ #6-W/2.9XW2.9 WWR.
- F. S2 = 3" NORMAL-WT CONCRETE OVER 2" COMPOSITE METAL DECK (20 GA. GALV.). TOTAL SLAB THICKNESS = 5". REINF. W/ #6-W/2.9XW2.9 WWR.
- G. SEE GEOTECHNICAL REPORT FOR SITE AND SUBGRADE PREPARATIONS.
- H. PROVIDE STOOPS/FROST SLABS AT ALL EXTERIOR DOORS. COORDINATE WITH CIVIL AND ARCHITECTURAL DRAWINGS.

KEY PLAN

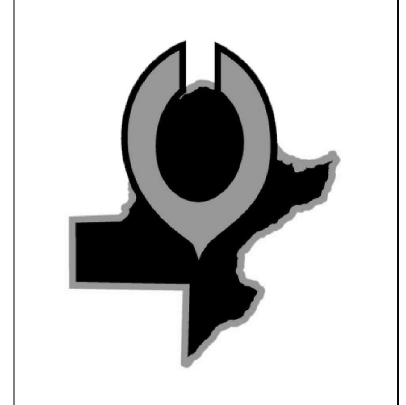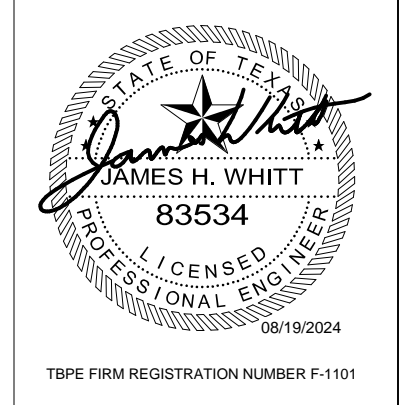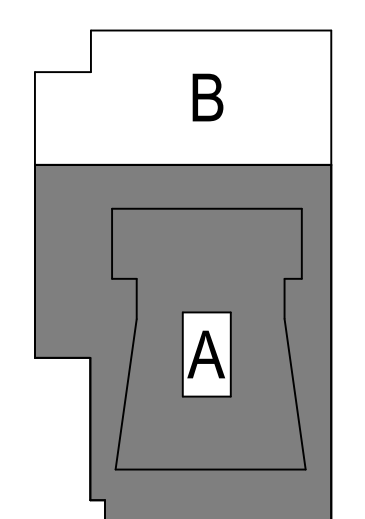



ISSUE FOR BID AND PERMIT
 2024.07.25
 REVISIONS
 01 08/19/24 ADDENDUM 01

Autodesk Docs://39-23712-00 Crandall ISD - PAC Addn ISD - Shued_2024.rvt
 8/19/2024 4:17:32 PM

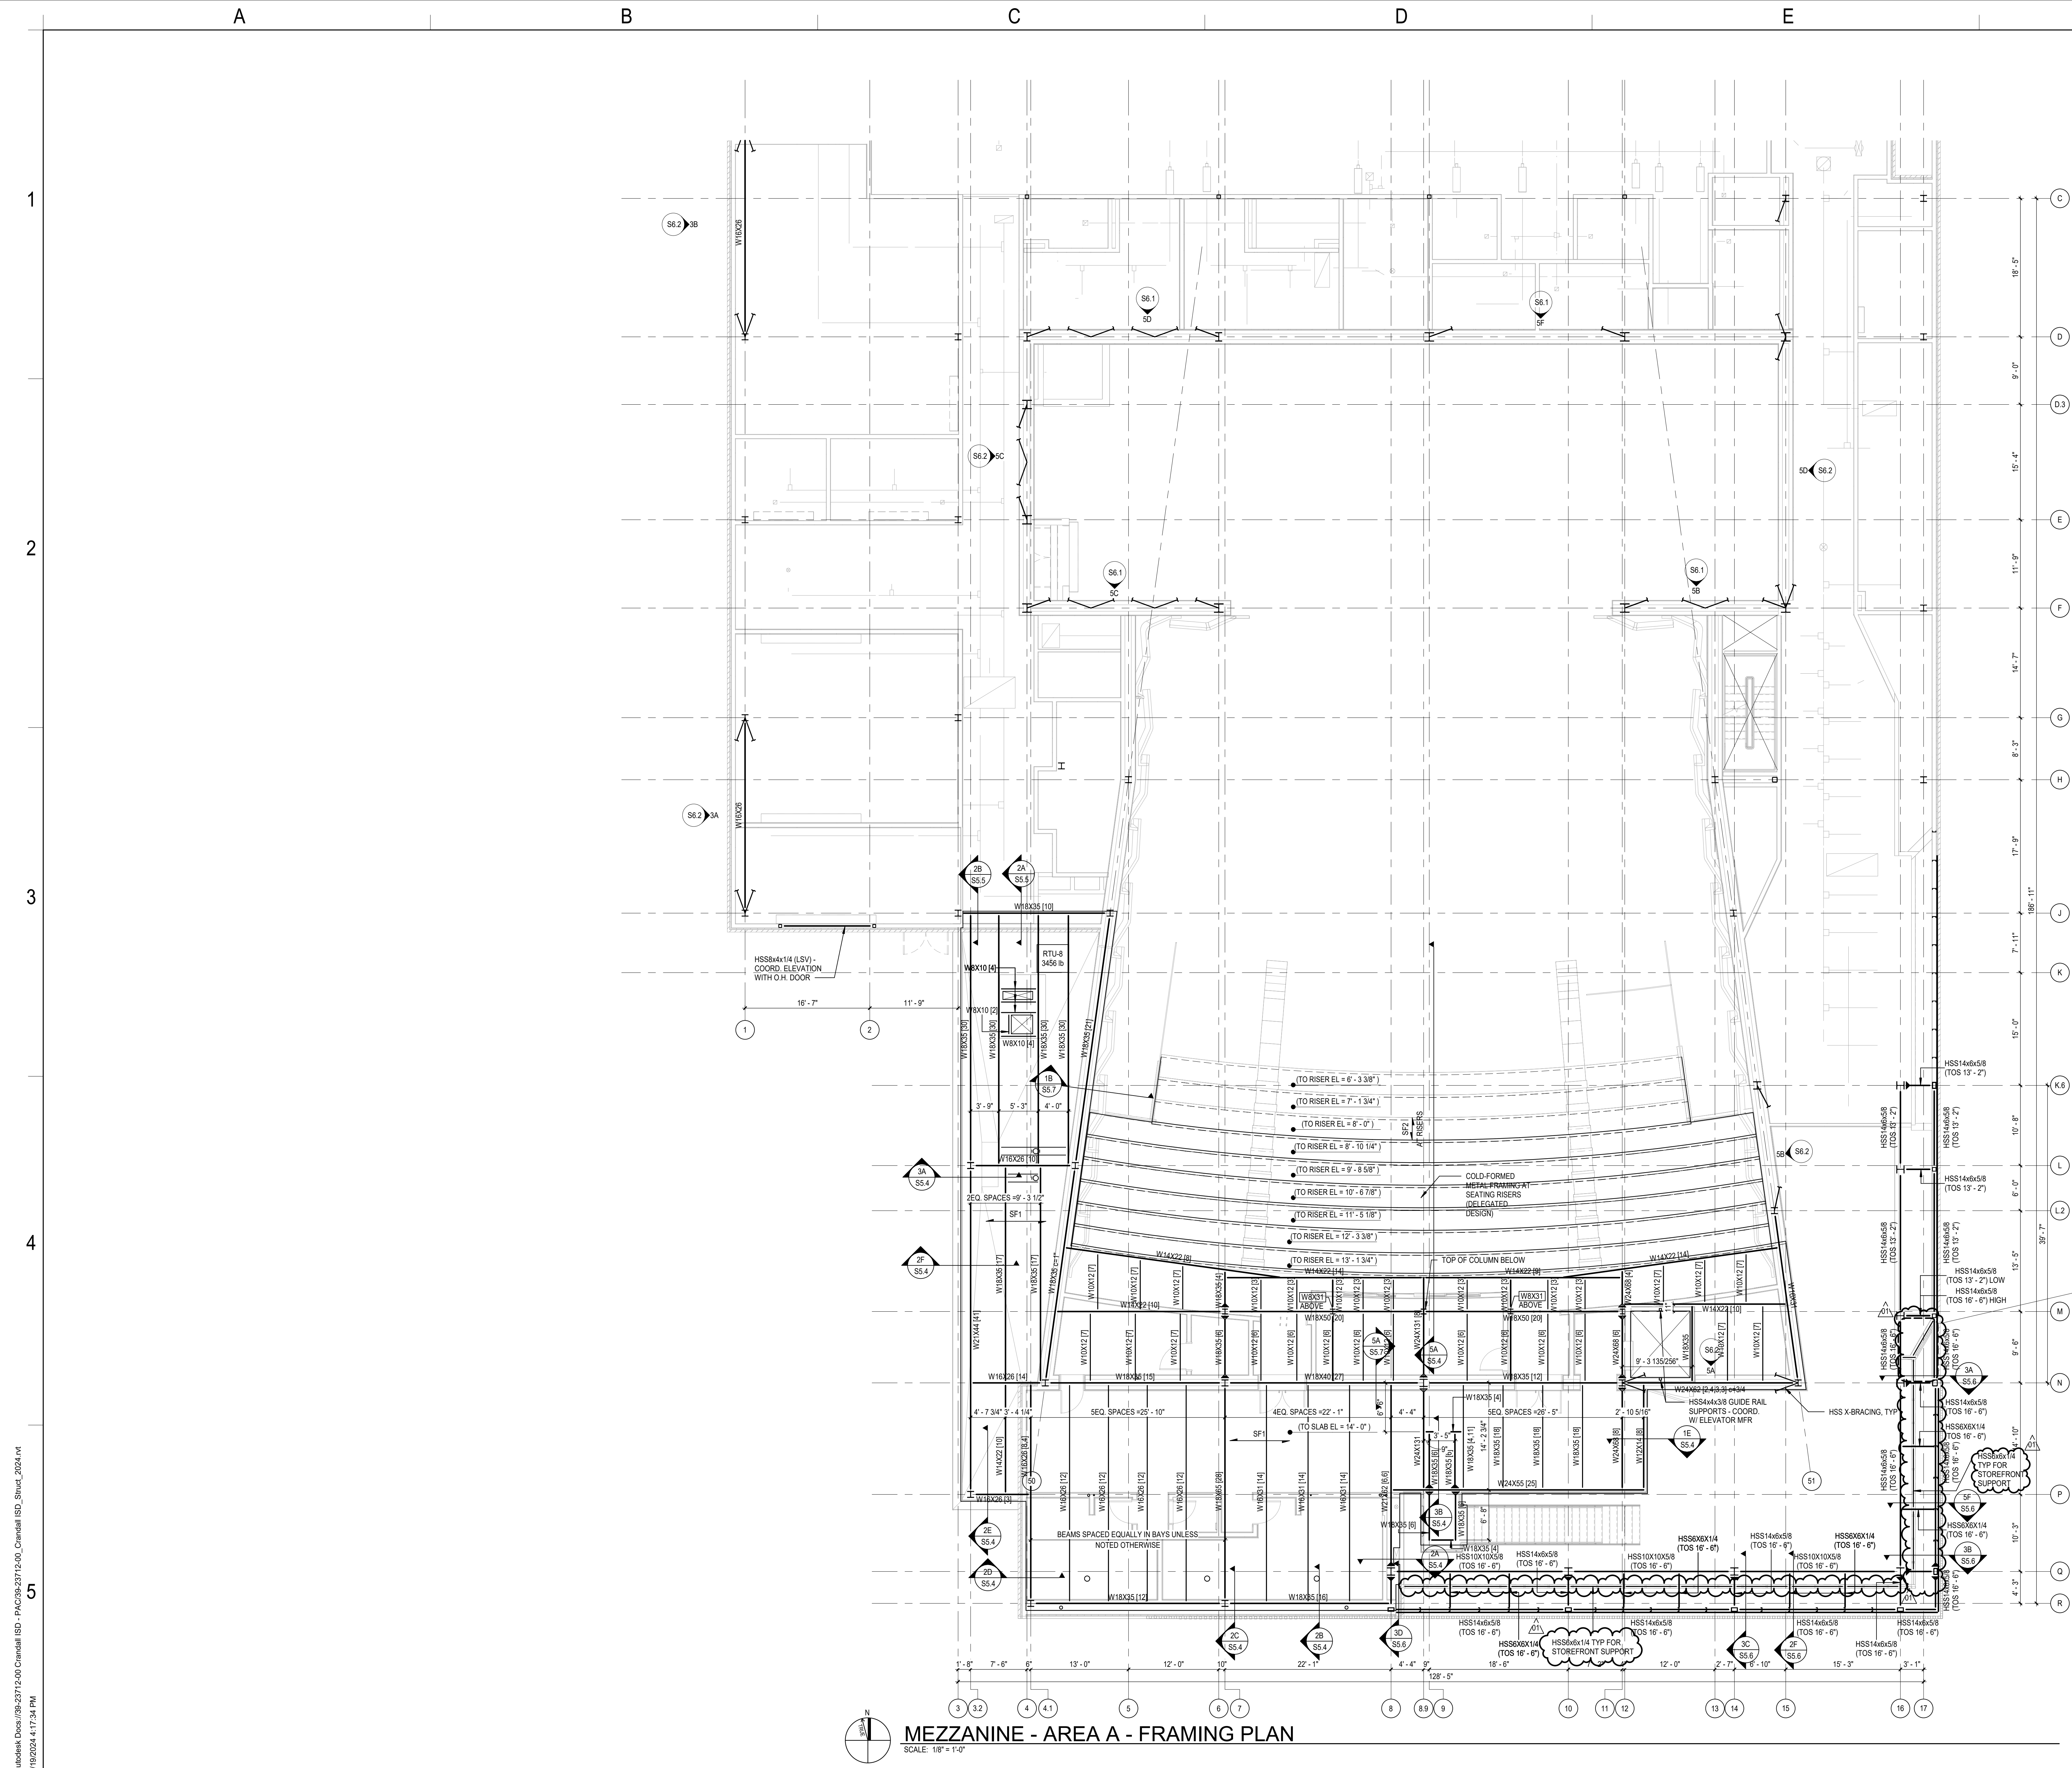


FLOOR FRAMING PLAN GENERAL NOTES

- A. SEE PLAN FOR TOP OF SLAB ELEVATIONS (TSE).
- B. TOP OF STEEL (TOS) ELEVATION EQUAL TO BOTTOM OF SLAB ON DECK ELEVATION UNLESS NOTED OTHERWISE.
- C. BEAMS/JOISTS SHALL BE SPACED EVENLY BETWEEN NEAREST COLUMN LINES AND/OR LOCATED STRUCTURAL MEMBERS (WALLS, BEAMS) UNLESS NOTED OTHERWISE.
- D. SP1 = 4-1/2" NORMAL-WT CONCRETE OVER 2" COMPOSITE METAL DECK (20 GA. GALV). TOTAL SLAB #6-1/2" REINF W/ #6-W2.9xW2.9.
- E. SP2 = 3" NORMAL-WT CONCRETE OVER 2" COMPOSITE METAL DECK (20 GA. GALV). TOTAL SLAB #4-1/2" REINF W/ #4-W2.9xW2.9.
- F. SP3 = 3/8" STEEL PLATE.
- G. SR1 = 1-1/2" METAL ROOF DECK, TYPE B, 30 GA. GALV.
- H. STEEL ANGLES OR BENT PLS ARE REQUIRED AT ALL DECK PERIMETERS, EVEN WHEN NOT INDICATED. REFERENCE TYPICAL DETAILS.
- I. STEEL MEMBERS AND CONNECTIONS EXPOSED TO THE WEATHER ARE TO BE GALVANIZED.

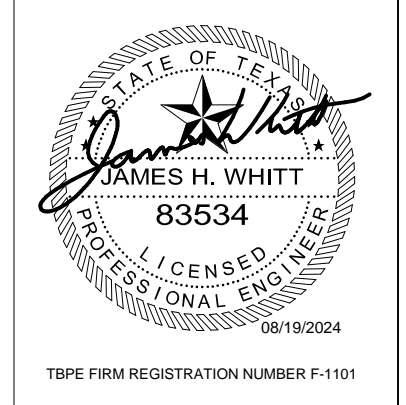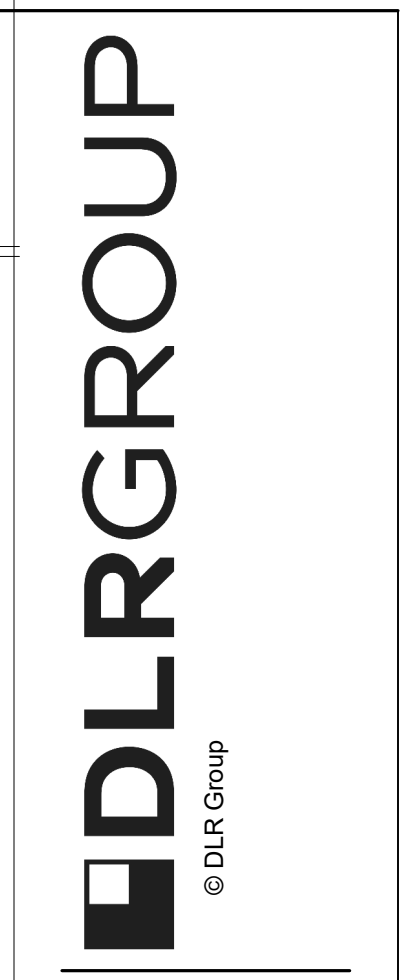


TYPE FRM REGISTRATION NUMBER F-101

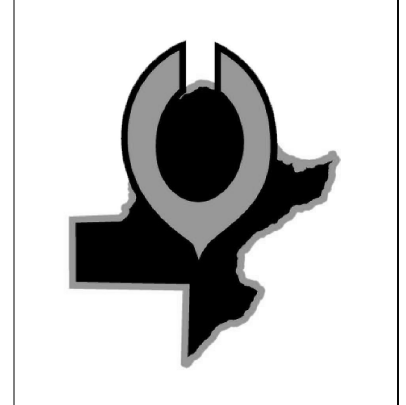

CRANDALL ISD HIGH SCHOOL
PAC ADDITION
13885 Fm 3098, Crandall, TX 75114

ISSUE FOR BID AND PERMIT
2024.07.25
REVISIONS
01 08/19/24 ADDENDUM 01


KEY PLAN

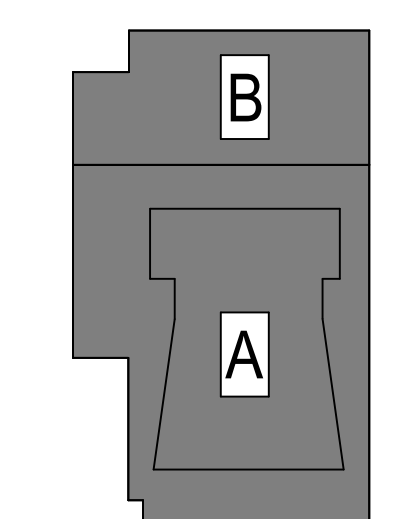

39-23712-00
LEVEL 02
MEZZANINE - AREA A - FRAMING PLAN

S1.2A




Autodesk Docs/39-23712-00 Crandall ISD - PAC/39-23712-00 Crandall ISD - Struct_2024.rvt 8/19/2024 4:17:34 PM

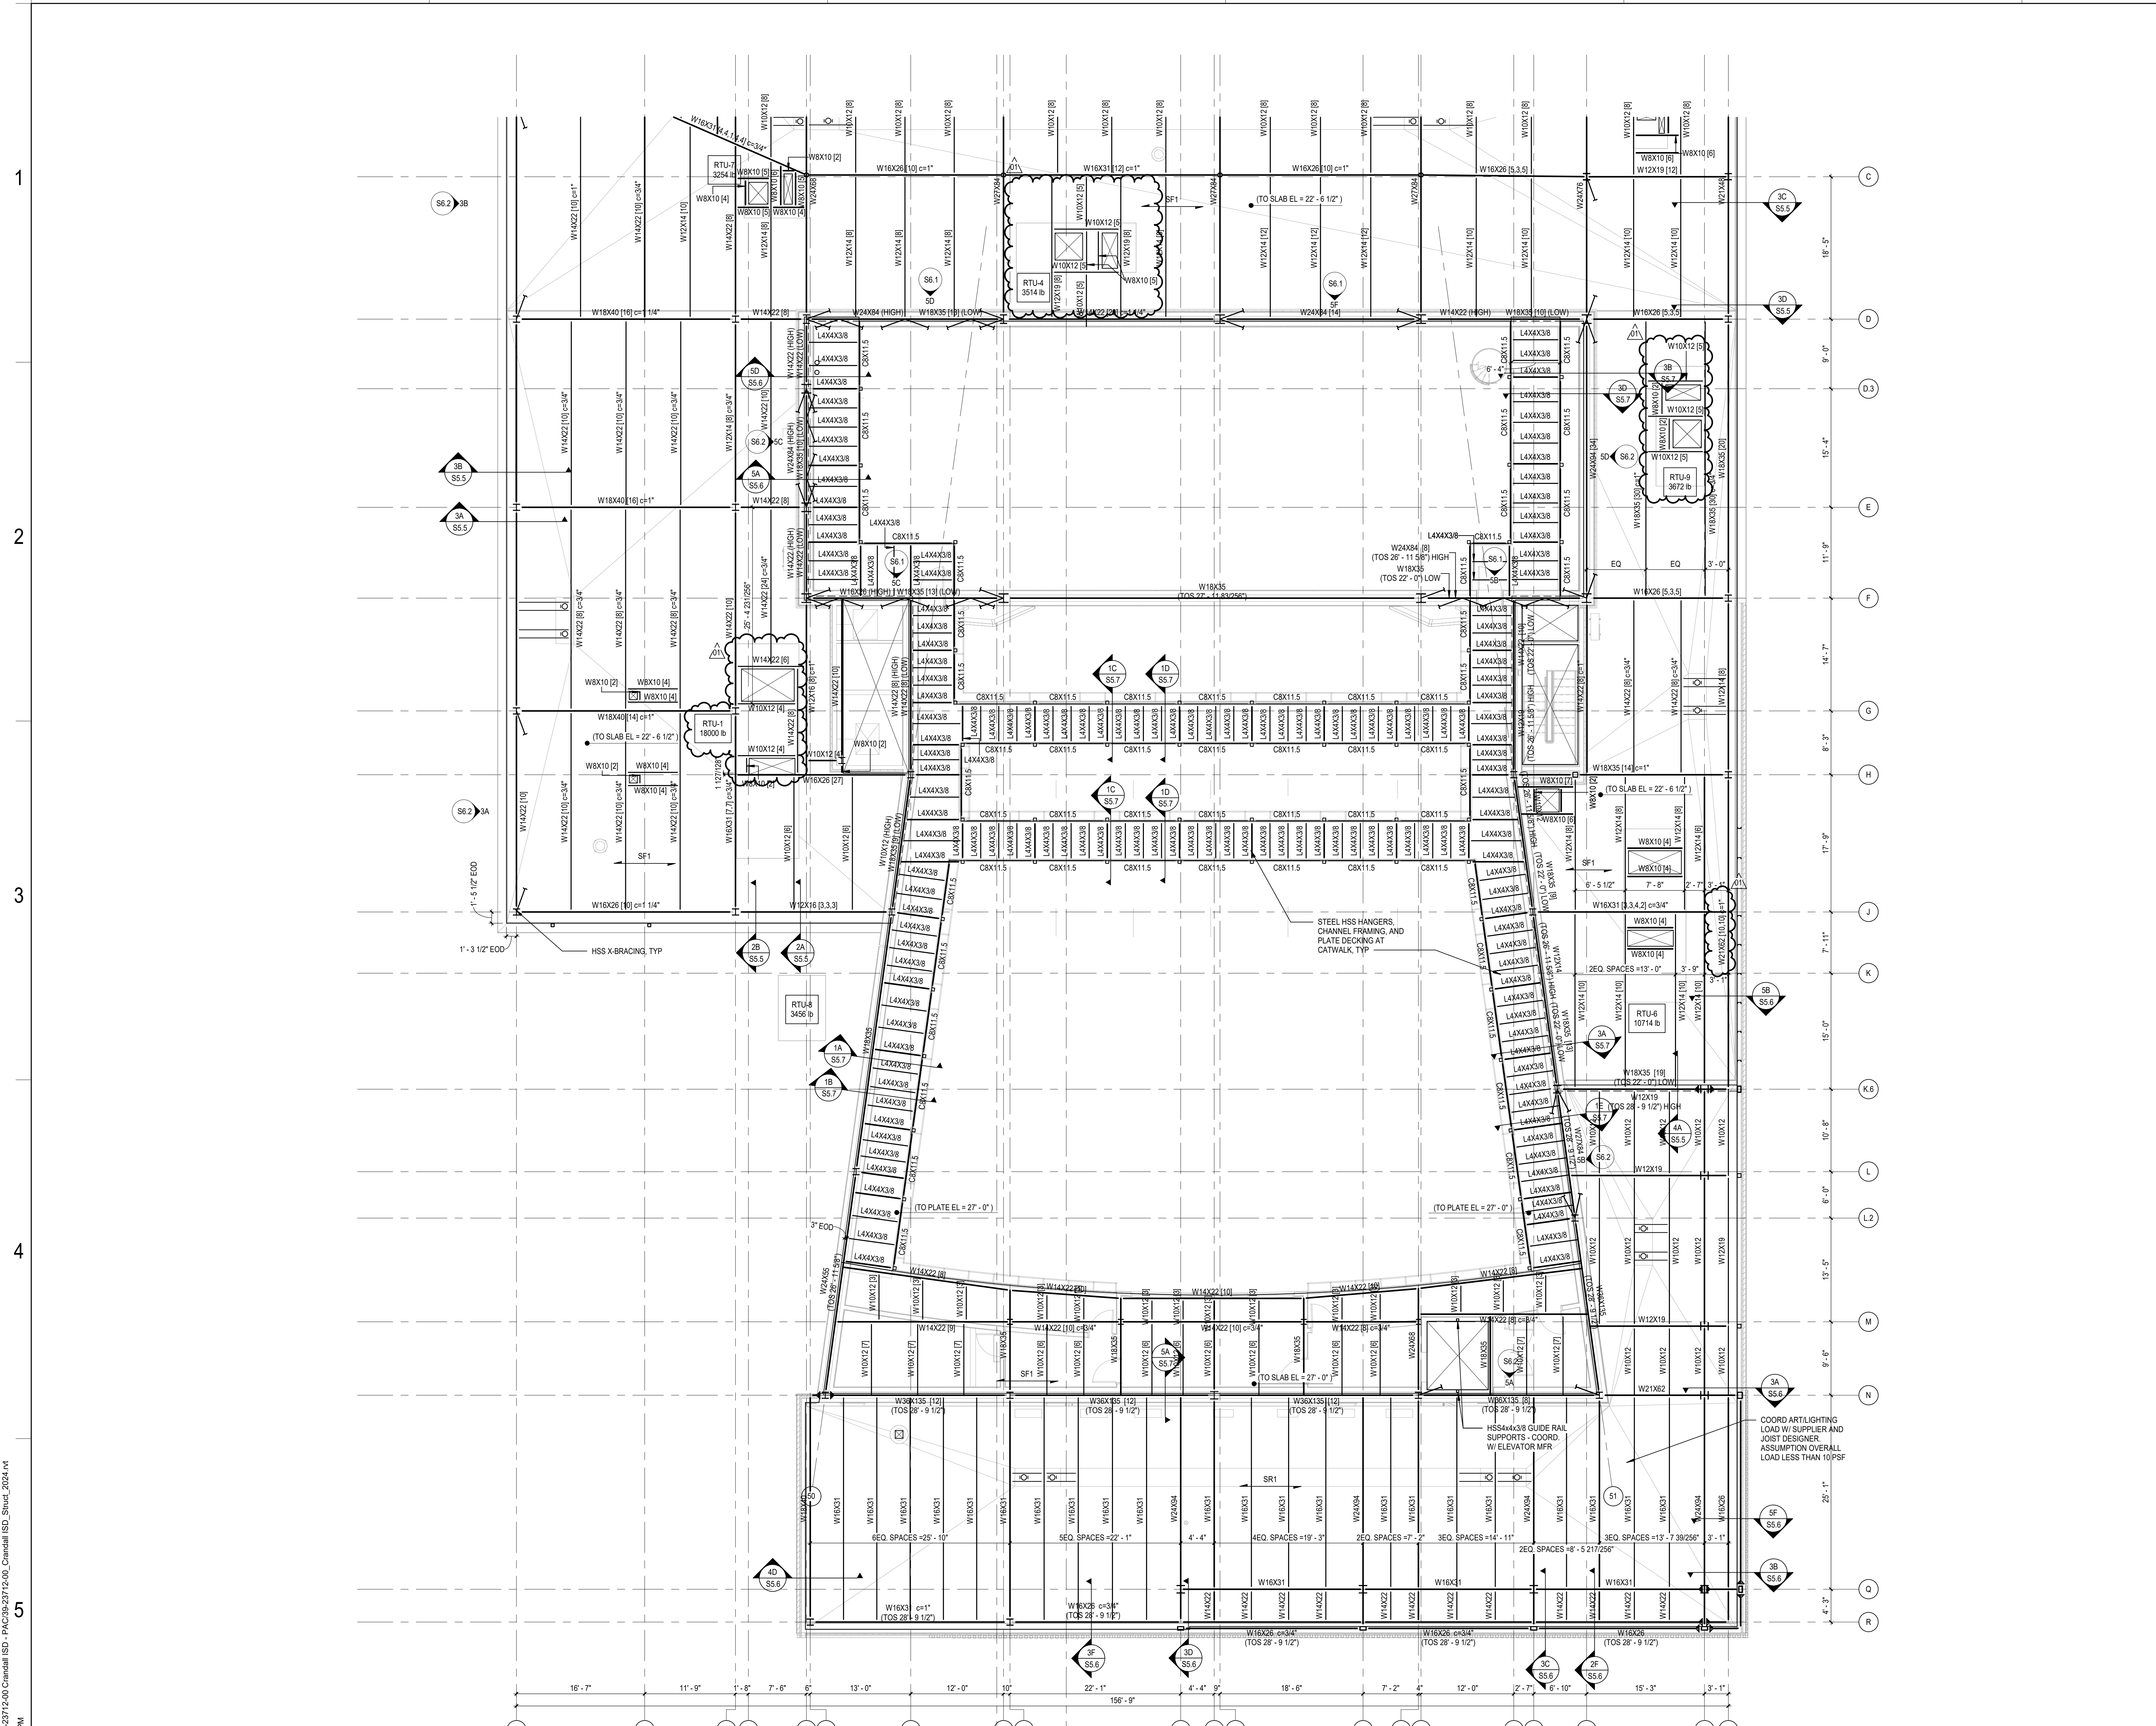

CATWALK - AREA A - FRAMING PLAN
SCALE: 1/8" = 1'-0"

FLOOR FRAMING PLAN GENERAL NOTES


- A. SEE PLAN FOR TOP OF SLAB ELEVATIONS (TSE).
- B. TOP OF STEEL (TOS) ELEVATION EQUAL TO BOTTOM OF SLAB ON DECK ELEVATION UNO.
- C. BEAMS/JOISTS SHALL BE SPACED EVENLY BETWEEN NEAREST COLUMN LINES AND/OR LOCATED STRUCTURAL MEMBERS (WALLS, BEAMS) UNO.
- D. SF1 = 4-1/2" NORMAL W/T CONCRETE OVER 2" COMPOSITE METAL DECK (20 GA. GALV). TOTAL SLAB = 6-1/2". REINF W/ 6#6-W2.9xW2.9.
- E. SF2 = 3" NORMAL W/T CONCRETE OVER 2" COMPOSITE METAL DECK (20 GA. GALV). TOTAL SLAB = 5". REINF W/ 6#6-W2.9xW2.9.
- F. SP1 = 3/8" STEEL PLATE.
- G. SR1 = 1-1/2" METAL ROOF DECK, TYPE B, 20 GA. GALV.
- H. STEEL ANGLES OR BENT PLS ARE REQUIRED AT ALL DECK PERIMETERS, EVEN WHEN NOT INDICATED. REFERENCE TYPICAL DETAILS.
- I. STEEL MEMBERS AND CONNECTIONS EXPOSED TO THE WEATHER ARE TO BE GALVANIZED.

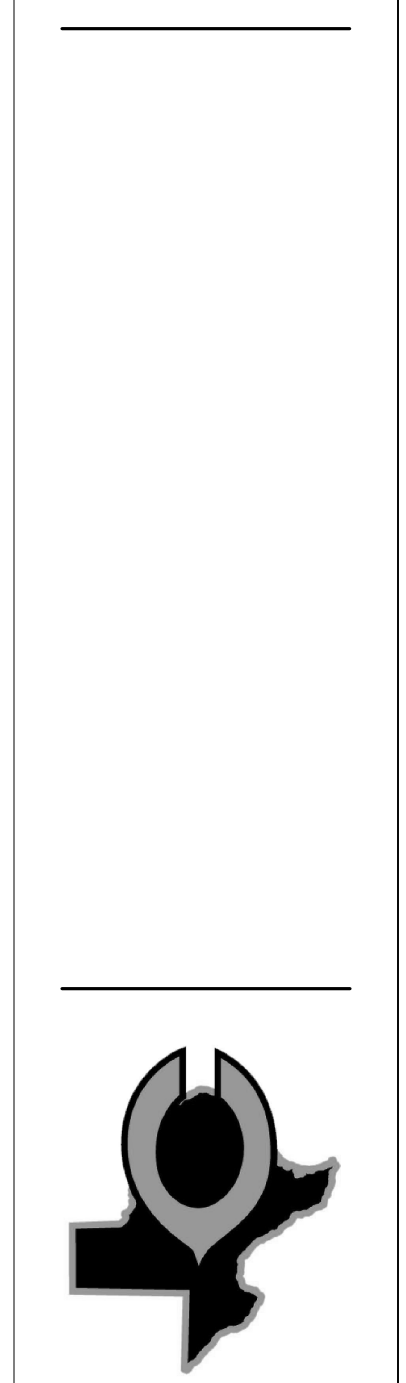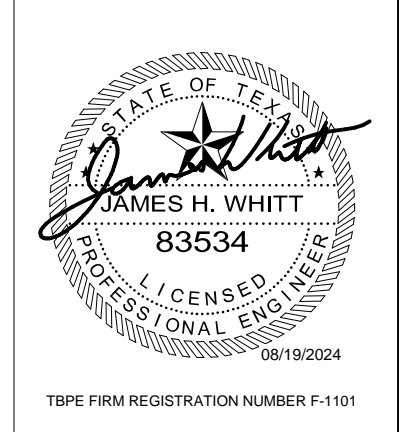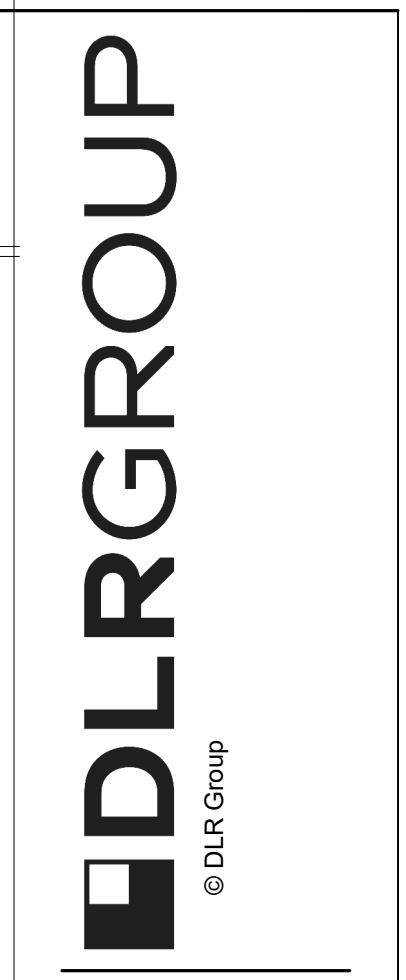

CRANDALL ISD HIGH SCHOOL
PAC ADDITION
13885 Fm 3098, Crandall, TX 75114

ISSUE FOR BID AND PERMIT
2024.07.25
REVISIONS
01 08/19/24 ADDENDUM 01

KEY PLAN

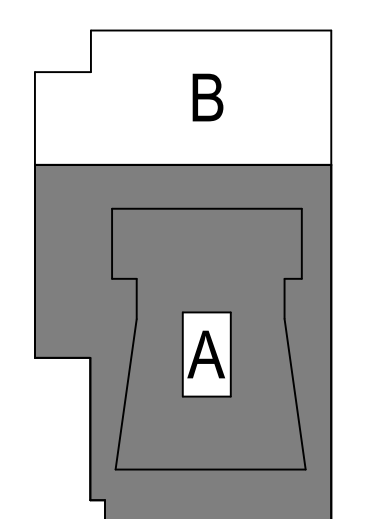

39-23712-00
LEVEL 03
CATWALK - AREA
A - FRAMING
PLAN

S2.3A


Autodesk DocuSign 2024.07.25 4:17:40 PM

A B C D E

F

FLOOR FRAMING PLAN GENERAL NOTES

- A. SEE PLAN FOR TOP OF SLAB ELEVATIONS (TSE).
- B. TOP OF STEEL (TOS) ELEVATION EQUAL TO BOTTOM OF SLAB ON DECK ELEVATION UNO.
- C. BEAMS/JOISTS SHALL BE SPACED EVENLY BETWEEN NEAREST COLUMN LINES AND/OR LOCATED STRUCTURAL MEMBERS (WALLS, BEAMS) UNO.
- D. SF1 = 4-1/2" NORMAL-WT CONCRETE OVER 2" COMPOSITE METAL DECK (20 GA. GALV). TOTAL SLAB #6-1/2" REINF-W/ #6-W2.9xw2.9
- E. SF2 = 3" NORMAL-WT CONCRETE OVER 2" COMPOSITE METAL DECK (20 GA. GALV). TOTAL SLAB #4" REINF-W/ #6-W2.9xw2.9
- F. SP1 = 3/8" STEEL PLATE
- G. SR1 = 1-1/2" METAL ROOF DECK, TYPE B, 20 GA. GALV.
- H. STEEL ANGLES OR BENT PLS ARE REQUIRED AT ALL DECK PERIMETERS, EVEN WHEN NOT INDICATED. REFERENCE TYPICAL DETAILS.
- I. STEEL MEMBERS AND CONNECTIONS EXPOSED TO THE WEATHER ARE TO BE GALVANIZED.

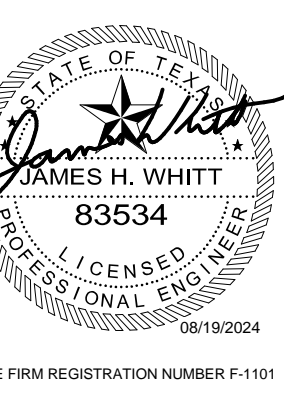

TYPE FRM REGISTRATION NUMBER F-101



CRANDALL ISD HIGH SCHOOL
PAC ADDITION

13385 Fm 3098, Crandall, TX 75114

ISSUE FOR BID AND PERMIT
2024.07.25
REVISIONS

01 08/19/24 ADDENDUM 01

39-23712-00
LEVEL 03
CATWALK - AREA
B - FRAMING
PLAN

S2.3B


1

2

3


4

5

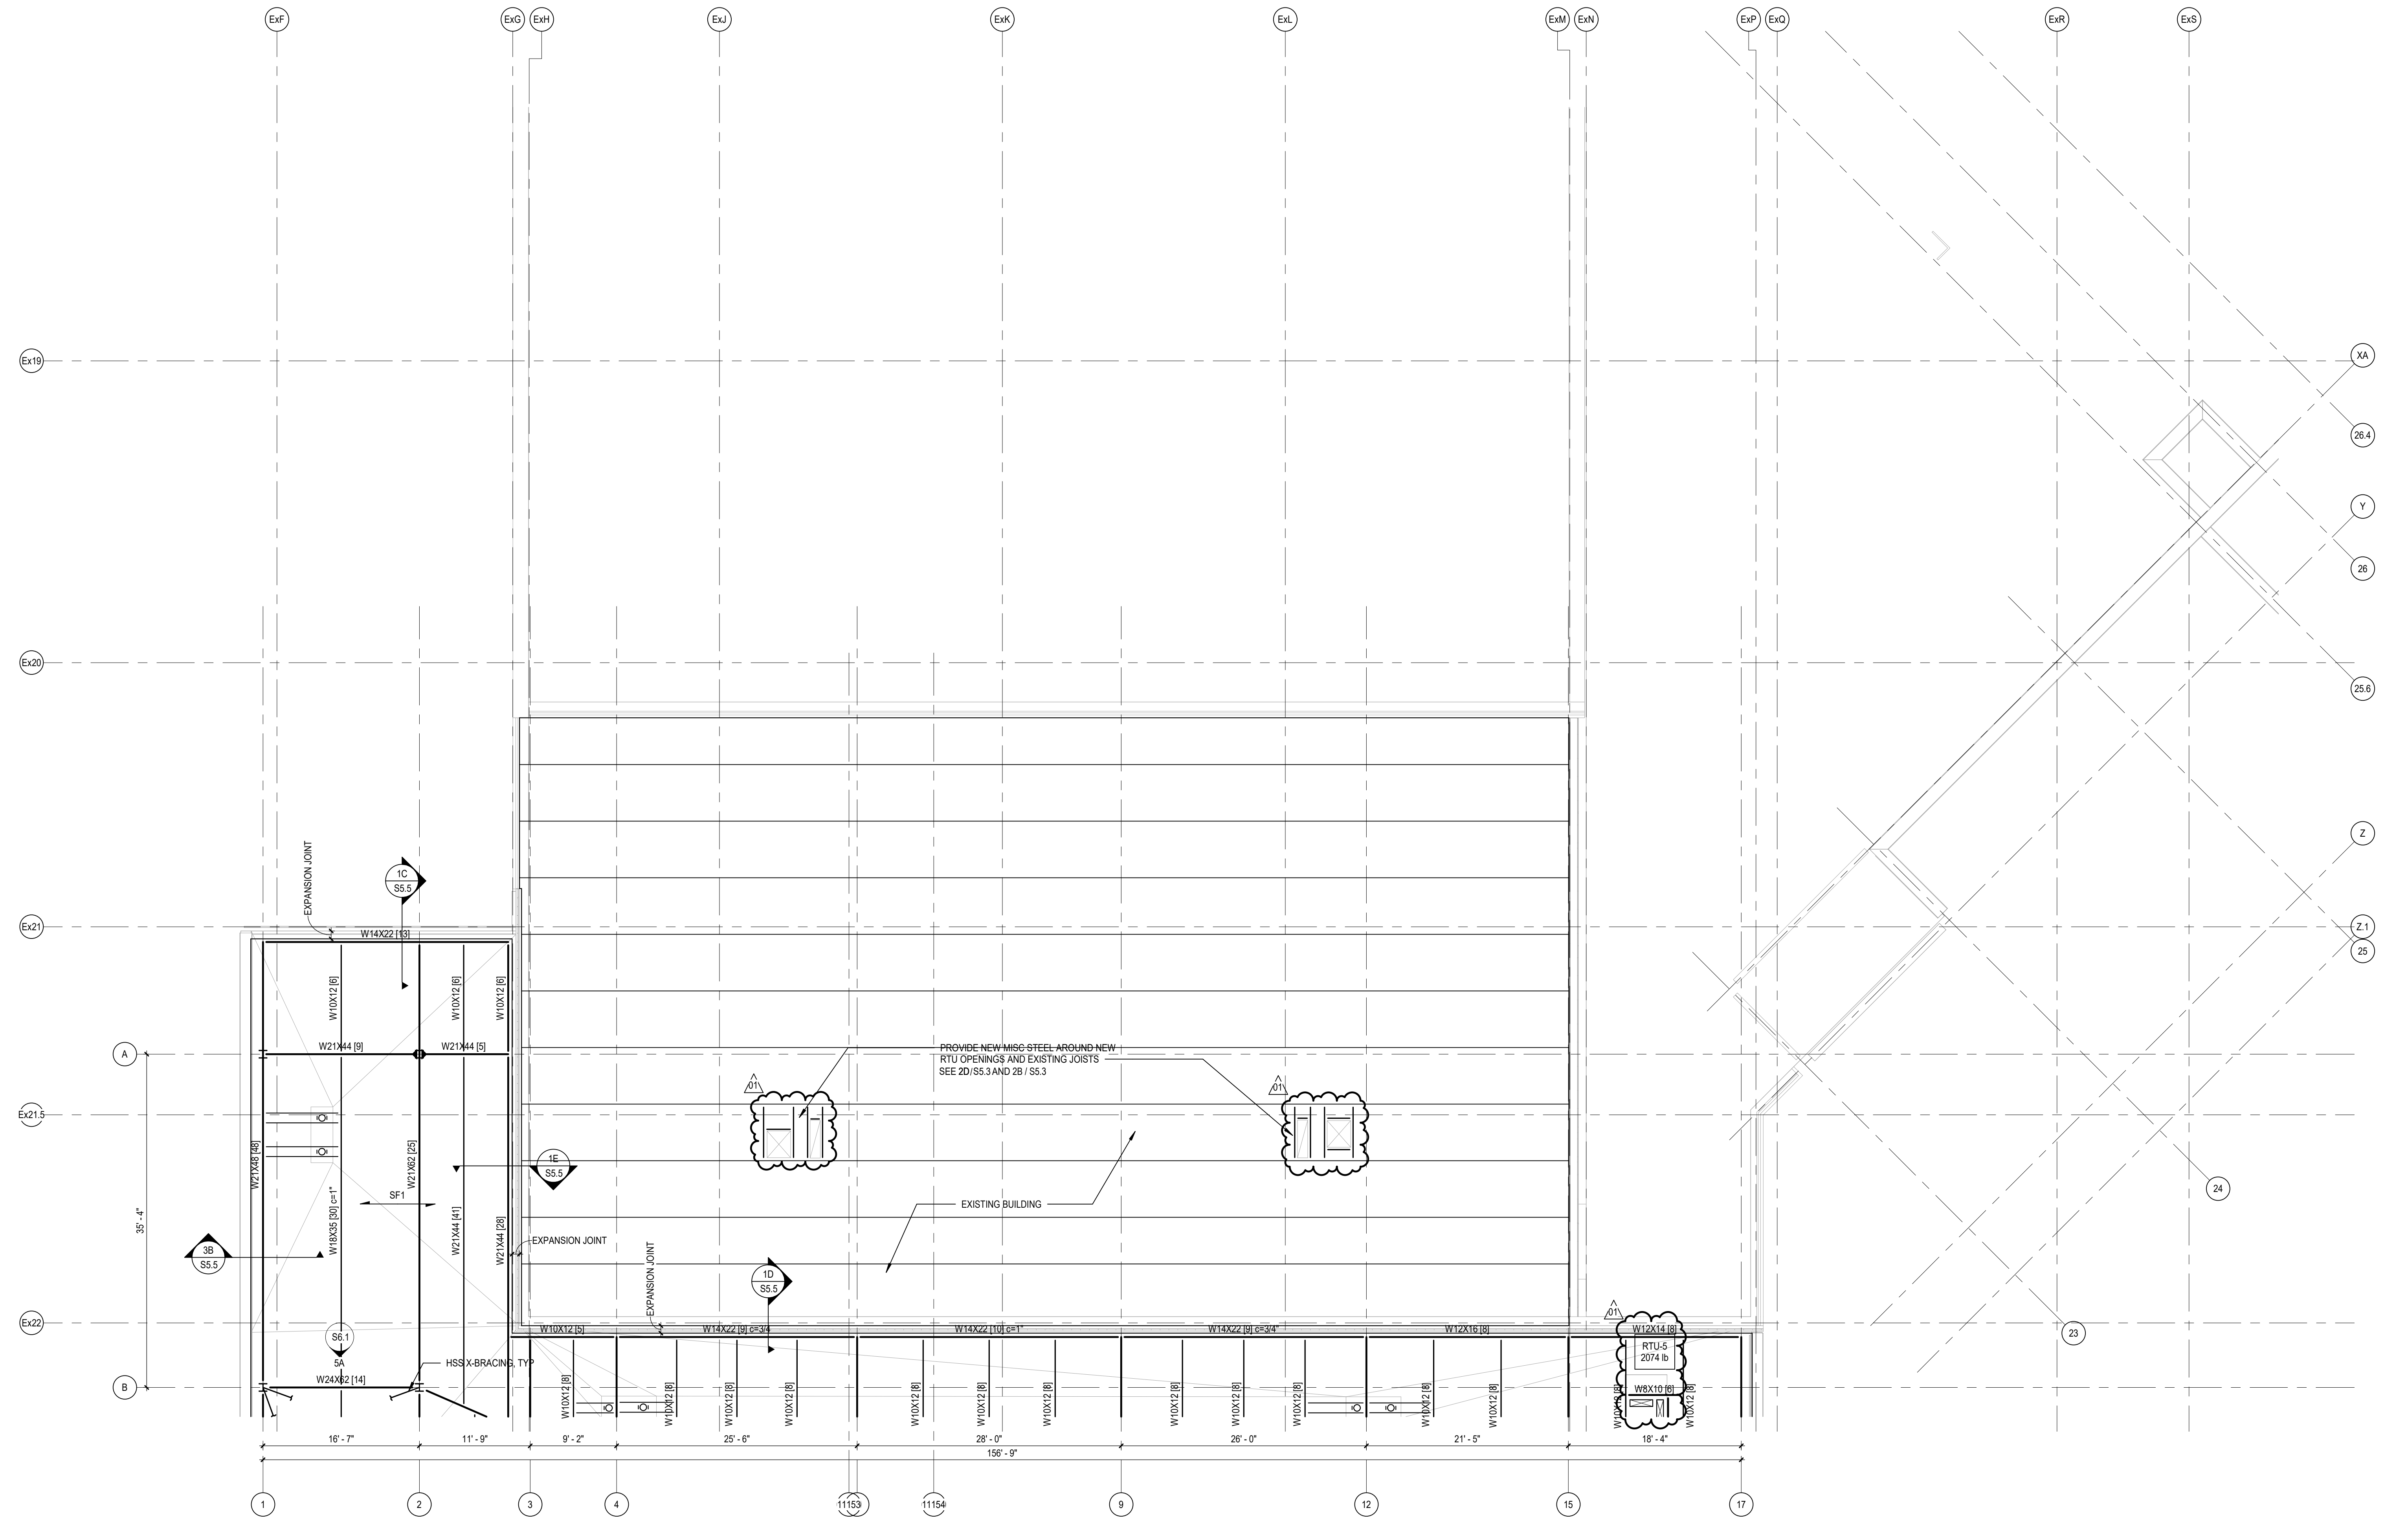


LEVEL 03 CATWALK - AREA B - FRAMING PLAN
SCALE: 1/8" = 1'-0"


KEY PLAN

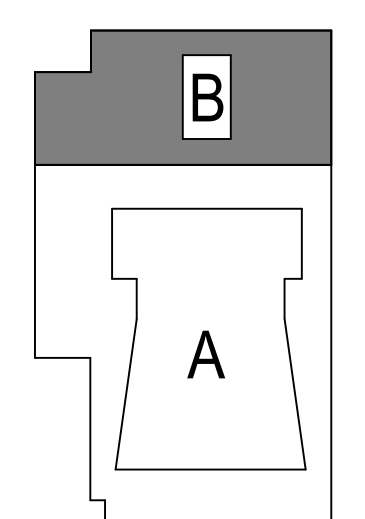

Autodesk DocuSign/39-23712-00 Crandall ISD - PAC Addn 23712-00 Crandall ISD - Shued_2024.rvt
8/10/2024 4:17:41 PM

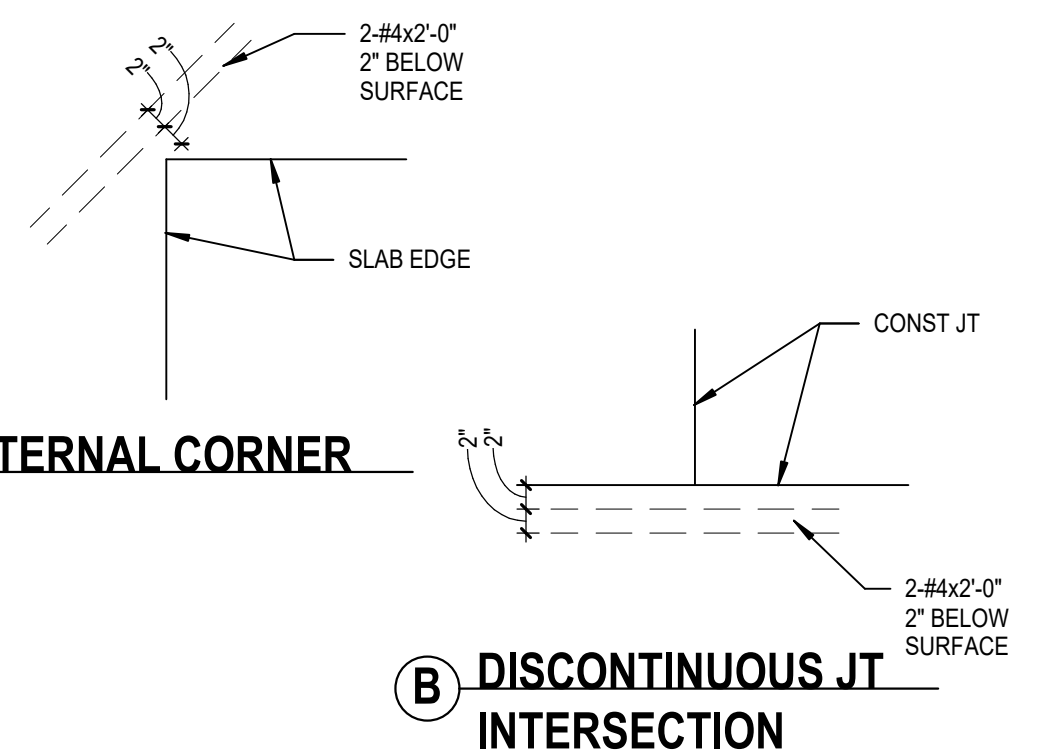


1A TYP SLAB CORNERS
S3.1 NO SCALE

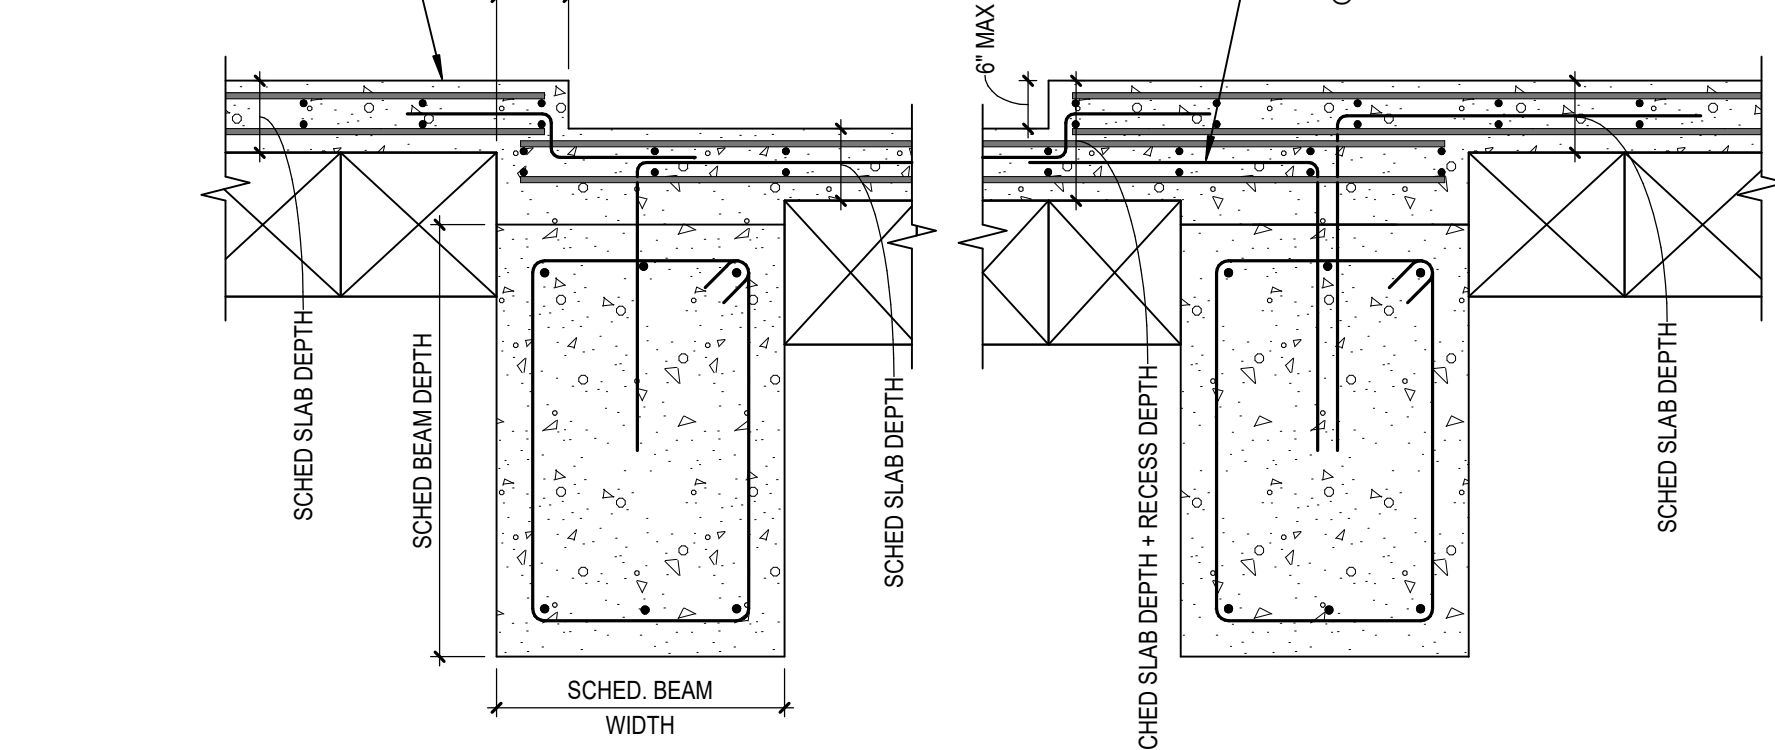


1B TYPICAL FLOOR SLAB RECESS DETAIL
S3.1 SCALE: 3/4" = 1'-0"


| GRADE BEAM SCHEDULE | | | | |
|---------------------|------------|-----------|---------------------------------------|--------------------------|
| MARK | WIDTH | THICKNESS | LONGITUDINAL REINFORCEMENT | TRANSVERSE REINFORCEMENT |
| GB1 | 1'-6" | 2'-6" | (3) #7 CONT T&B | #3 @ 12" OC |
| GB2 | 1'-6" | 4'-4" | (3) #7 CONT T&B, #4 MID BARS @ 12" OC | #3 @ 12" OC |
| GB3 | 1'-6" | 5'-10" | (3) #7 CONT T&B, #4 MID BARS @ 12" OC | #3 @ 12" OC |
| GB4 | 1'-6" | 3'-6" | (3) #7 CONT T&B, #4 MID BARS @ 12" OC | #3 @ 12" OC |
| GB5 | 1'-10 1/4" | 4'-0" | (3) #7 CONT T&B, #4 MID BARS @ 12" OC | #3 @ 12" OC |
| GB7 | 1'-0" | 4'-0" | (3) #7 CONT T&B, #4 MID BARS @ 12" OC | #3 @ 12" OC |
| GB8 | 1'-6" | 4'-0" | (3) #7 CONT T&B, #4 MID BARS @ 12" OC | #3 @ 12" OC |
| GB9 | 1'-6" | 6'-8" | (3) #7 CONT T&B, #4 MID BARS @ 12" OC | #3 @ 12" OC |
| GB10 | 1'-6" | 5'-0" | (3) #7 CONT T&B, #4 MID BARS @ 12" OC | #3 @ 12" OC |
| GB11 | 2'-0" | 2'-6" | (3) #7 CONT T&B, #4 MID BARS @ 12" OC | #3 @ 12" OC |
| GB12 | 1'-6" | 2'-6" | (4) #7 CONT T&B, #4 MID BARS @ 12" OC | #3 @ 12" OC |

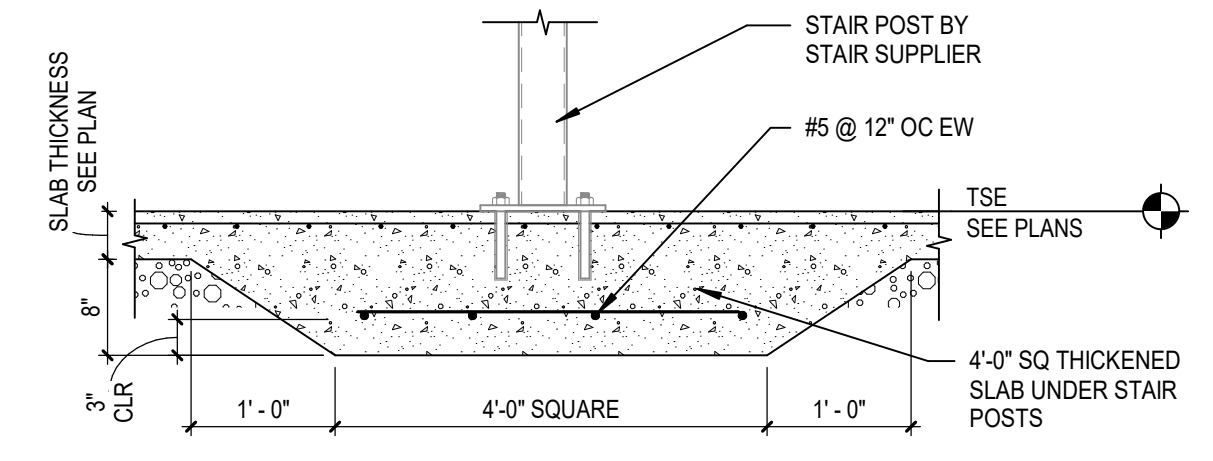


2A TYP STAIR POST BASE DETAIL
S3.1 NO SCALE

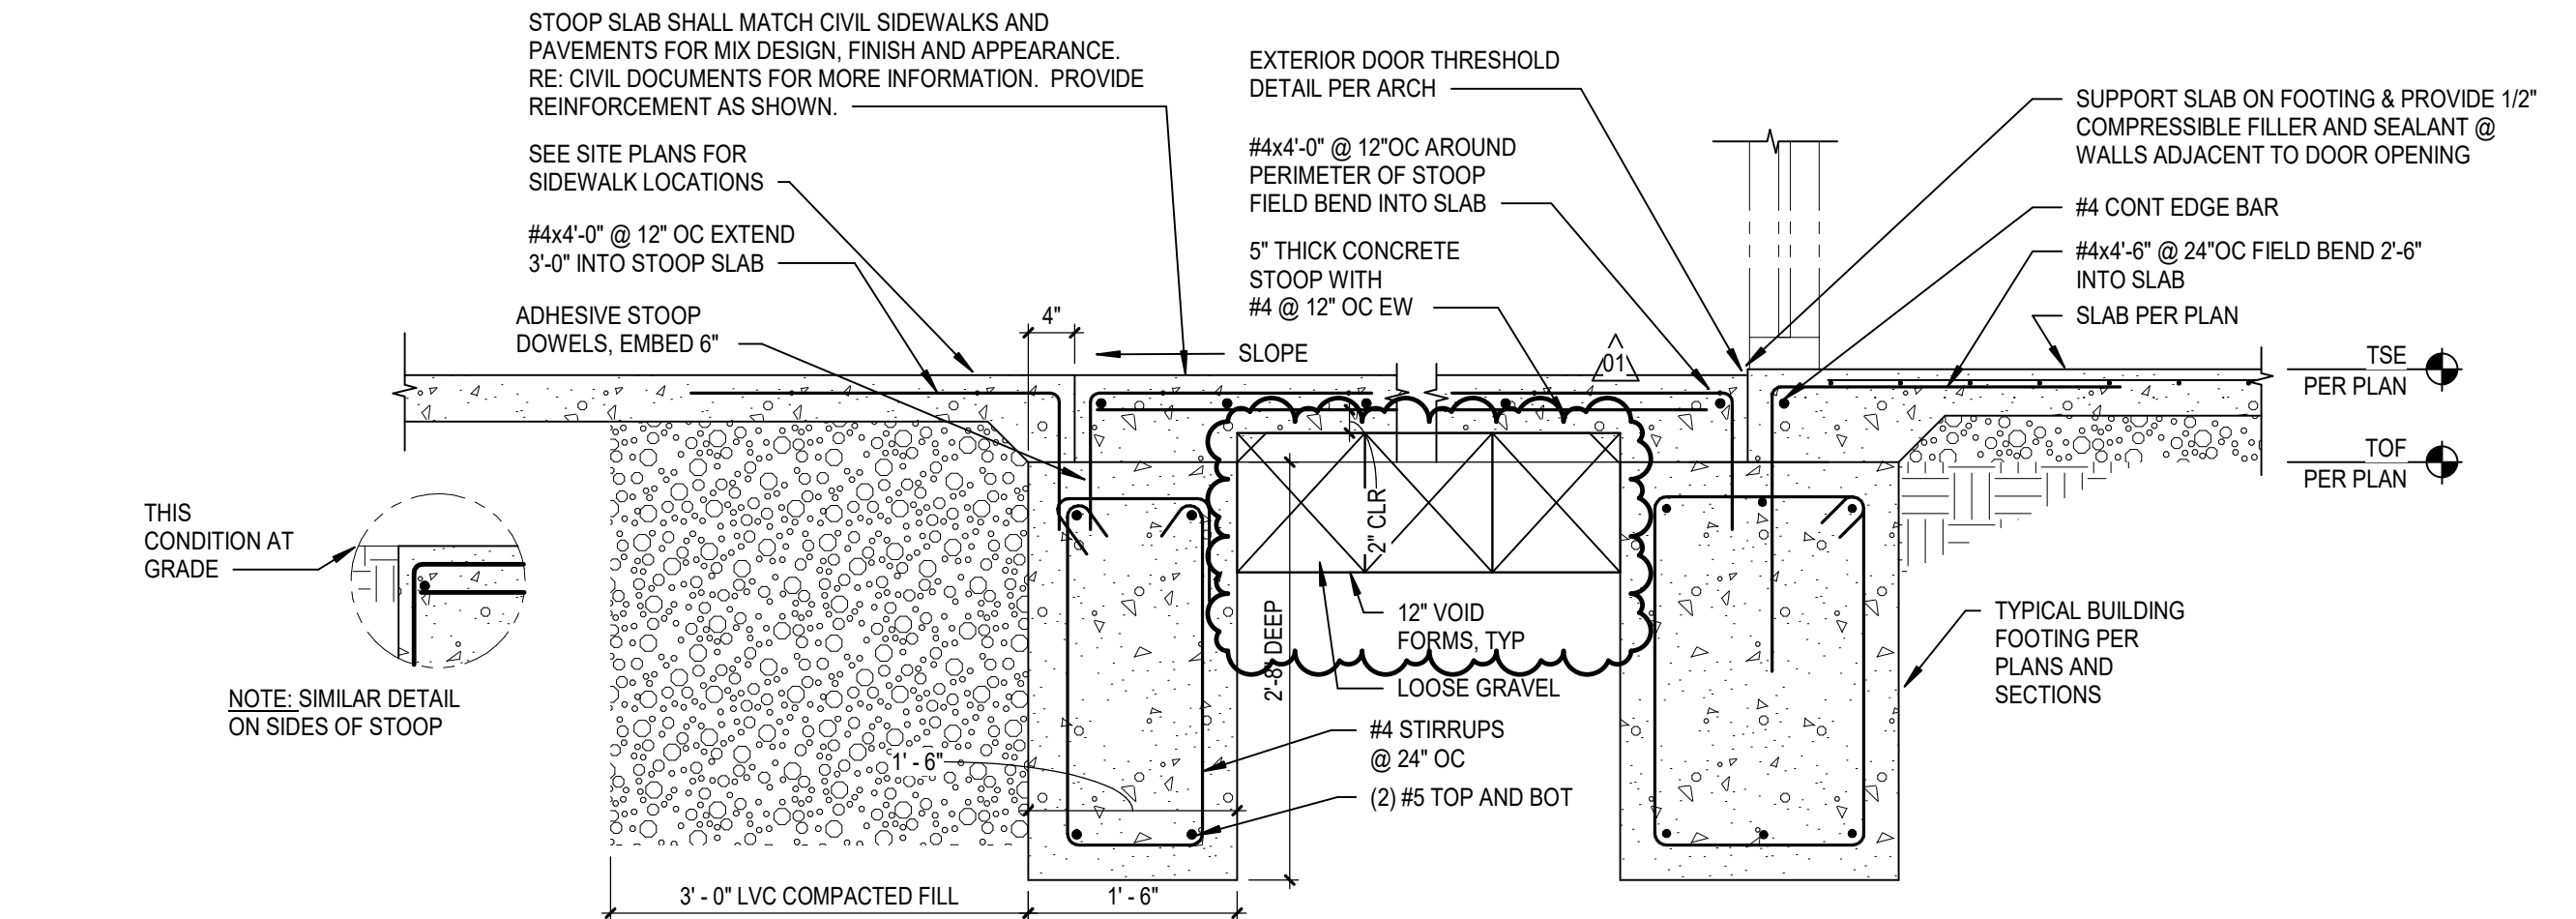


3A TYPICAL STRUCTURAL STOOP DETAIL
S3.1 NO SCALE

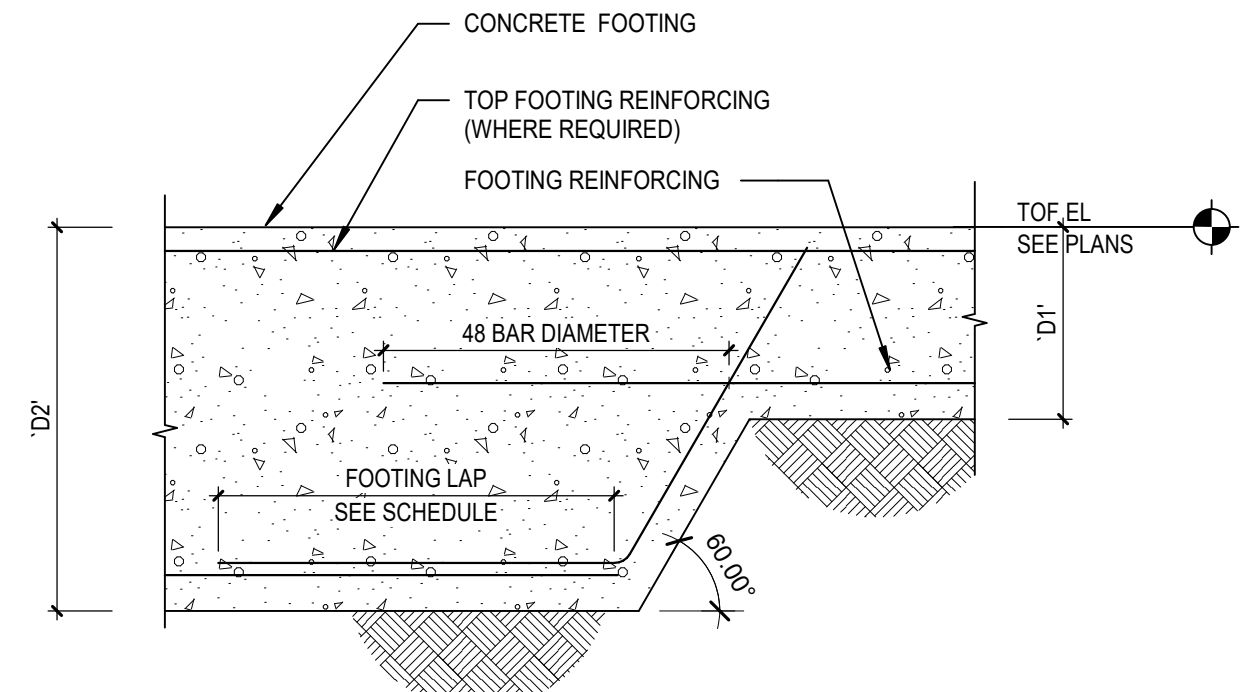


3C TYP BOT STEP FTG DETAIL
S3.1 NO SCALE

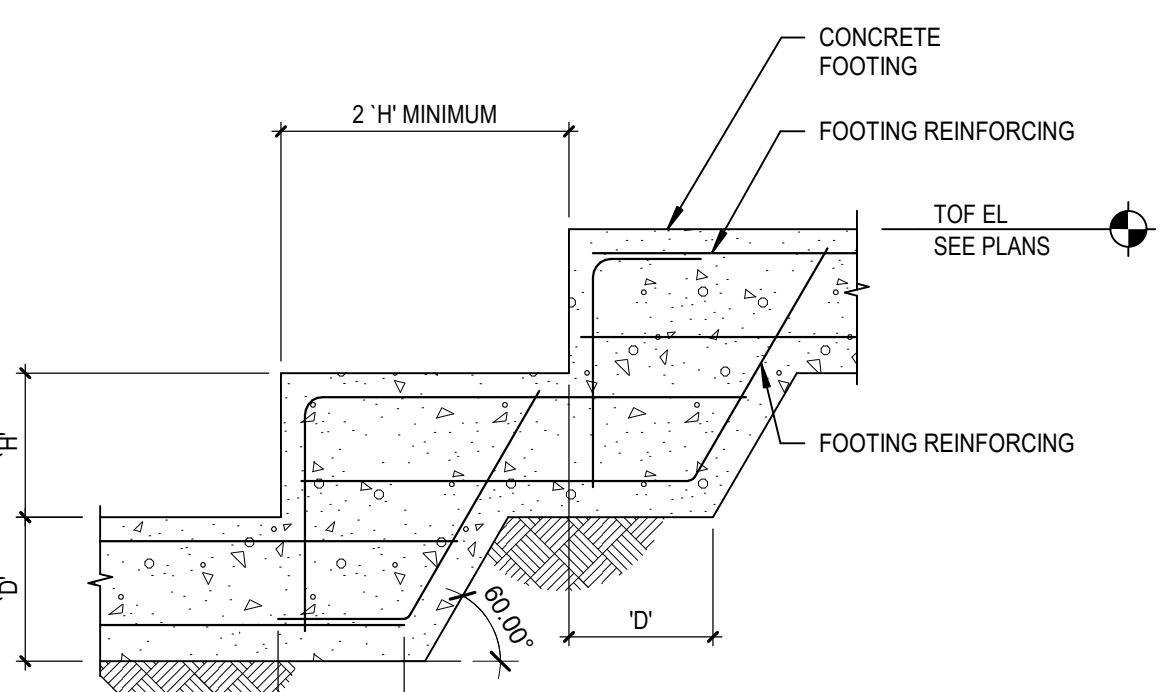

3D TYP STEP FOOTING DETAIL
S3.1 NO SCALE

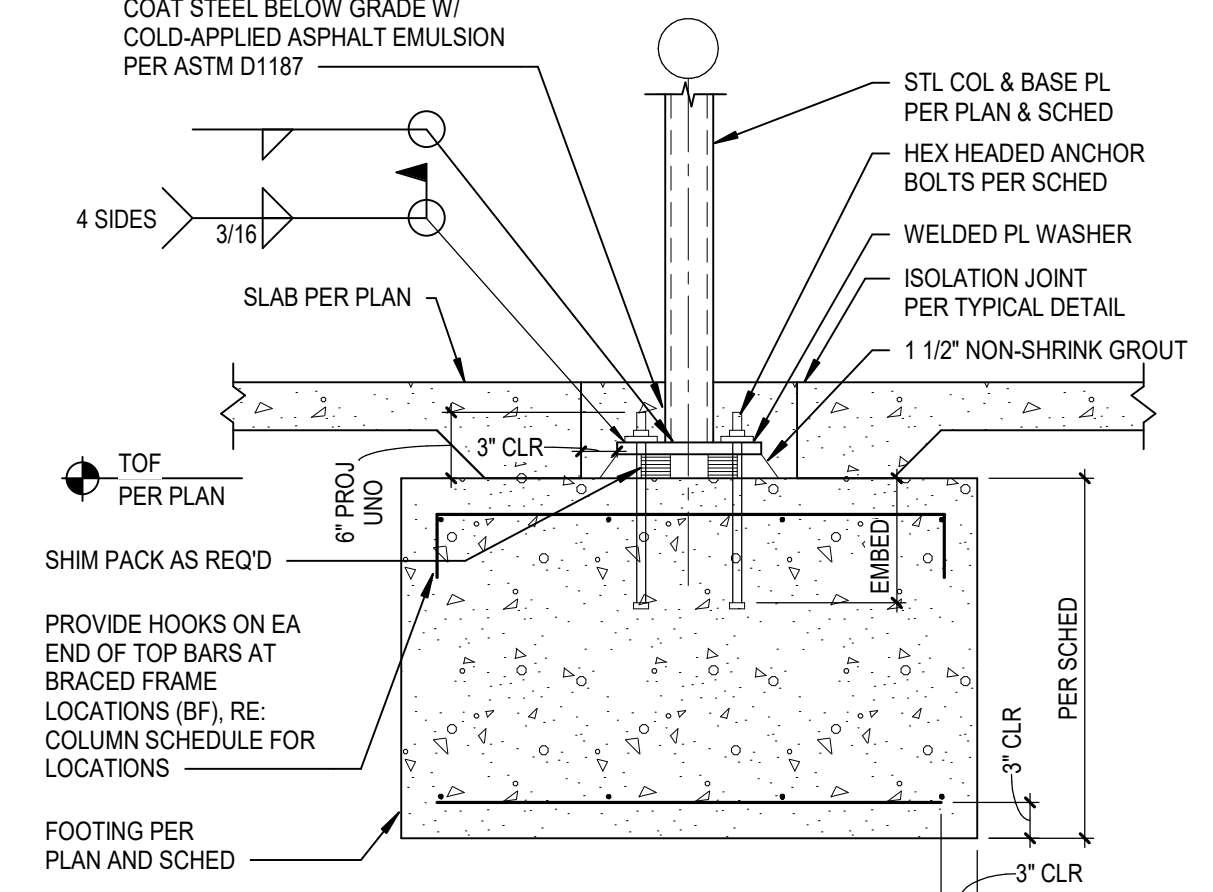


3E TYP COLUMN BASE DETAIL
S3.1 NO SCALE

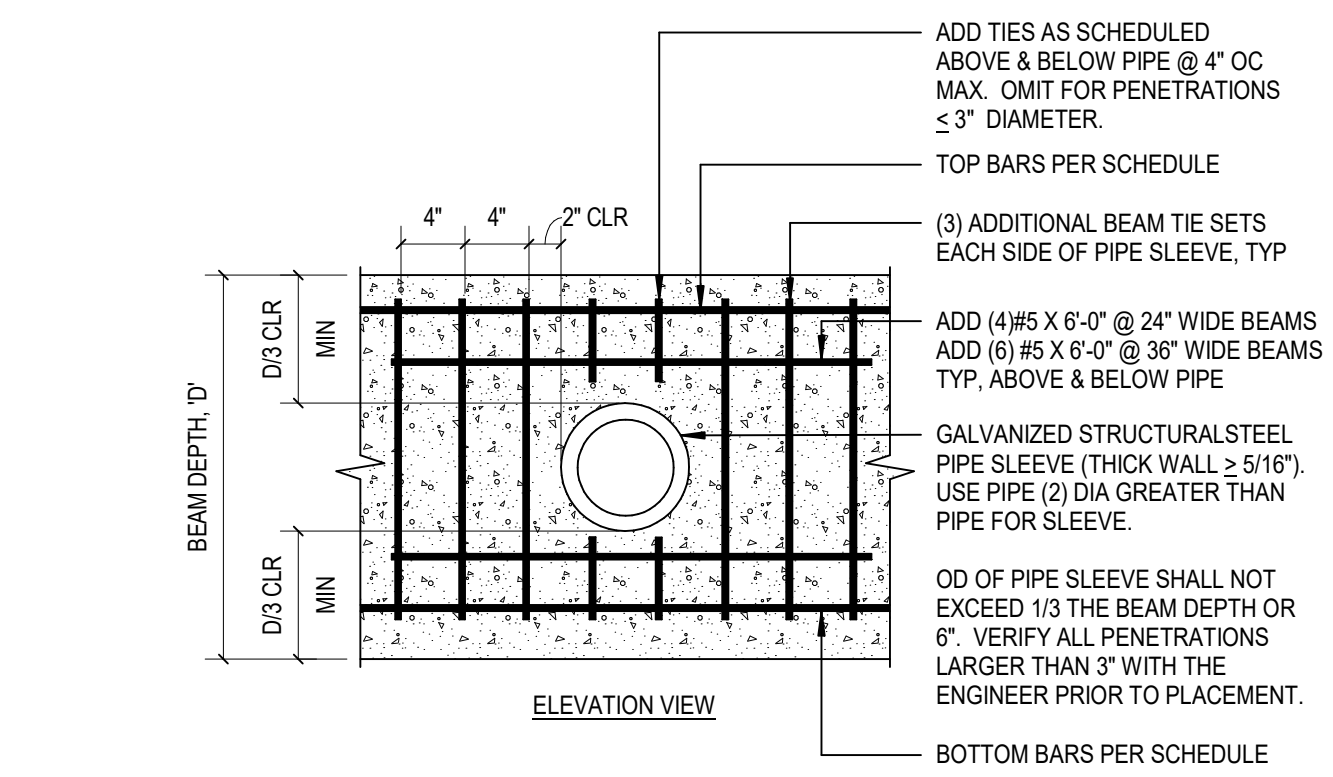


4A TYP GRADE BEAM HORIZ PIPE PENETRATION
S3.1 NO SCALE

NOTES:
 1. PRIOR TO PLACEMENT OF REINFORCING AND CONCRETE, THE CONTRACTOR SHALL COORDINATE THE LOCATION, SIZE, AND ELEVATION OF ALL REQUIRED PENETRATIONS THROUGH CONCRETE BEAMS.
 2. WHERE NOT SPECIFICALLY DETAILED ON THE STRUCTURAL DRAWINGS, THE CONTRACTOR SHALL SUBMIT DRAWINGS TO THE ENGINEER FOR REVIEW SHOWING DIMENSIONS AND LOCATIONS OF ALL REQUIRED PENETRATIONS PRIOR TO CONSTRUCTION. THIS MAY BE INCLUDED ON REINFORCING STEEL SHOP DRAWINGS.
 3. MINIMUM CLEAR SPACING BETWEEN PENETRATIONS SHALL BE 24".
 4. SCHEDULED TIES ARE NOT SHOWN FOR CLARITY.
 5. PENETRATIONS SHOWN ON PLANS WITHOUT DIMENSIONS FROM TOP OF CONCRETE SHALL BE CENTERED AT HALF THE BEAM DEPTH.

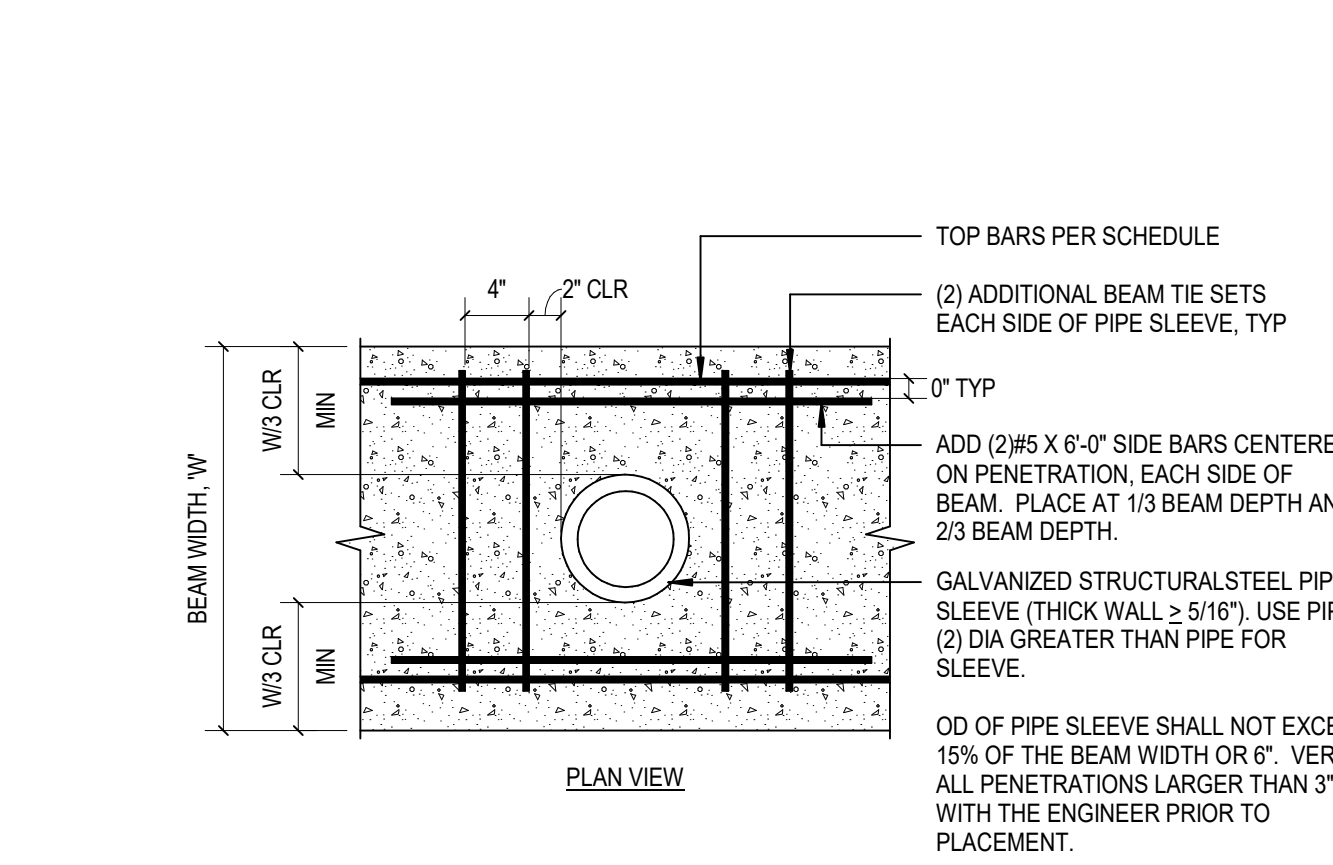


4A TYP GRADE BEAM VERTICAL PIPE PENETRATION
S3.1 NO SCALE

NOTES:
 1. PRIOR TO PLACEMENT OF REINFORCING AND CONCRETE, THE CONTRACTOR SHALL COORDINATE THE LOCATION, SIZE, AND ELEVATION OF ALL REQUIRED PENETRATIONS THROUGH CONCRETE BEAMS.
 2. WHERE NOT SPECIFICALLY DETAILED ON THE STRUCTURAL DRAWINGS, THE CONTRACTOR SHALL SUBMIT DRAWINGS TO THE ENGINEER FOR REVIEW SHOWING DIMENSIONS AND LOCATIONS OF ALL REQUIRED PENETRATIONS PRIOR TO CONSTRUCTION. THIS MAY BE INCLUDED ON REINFORCING STEEL SHOP DRAWINGS.
 3. SLEEVES MUST BE CENTERED ON BEAM CENTERLINE.
 4. MINIMUM CLEAR SPACING BETWEEN PENETRATIONS SHALL BE 24".
 5. PENETRATIONS ON EACH SIDE OF PIPE CAPS MUST ALIGN.
 6. SCHEDULED TIES ARE NOT SHOWN FOR CLARITY.
 7. CONTINUOUS BEAM REINFORCING MAY BE DISPLACED (3" MAXIMUM) OR ADJACENT BARS BUNDLED (2 BAR BUNDLES MAXIMUM) TO FACILITATE SLEEVE INSTALLATION. DO NOT CUT, OFFSET, OR BEND REINFORCING.

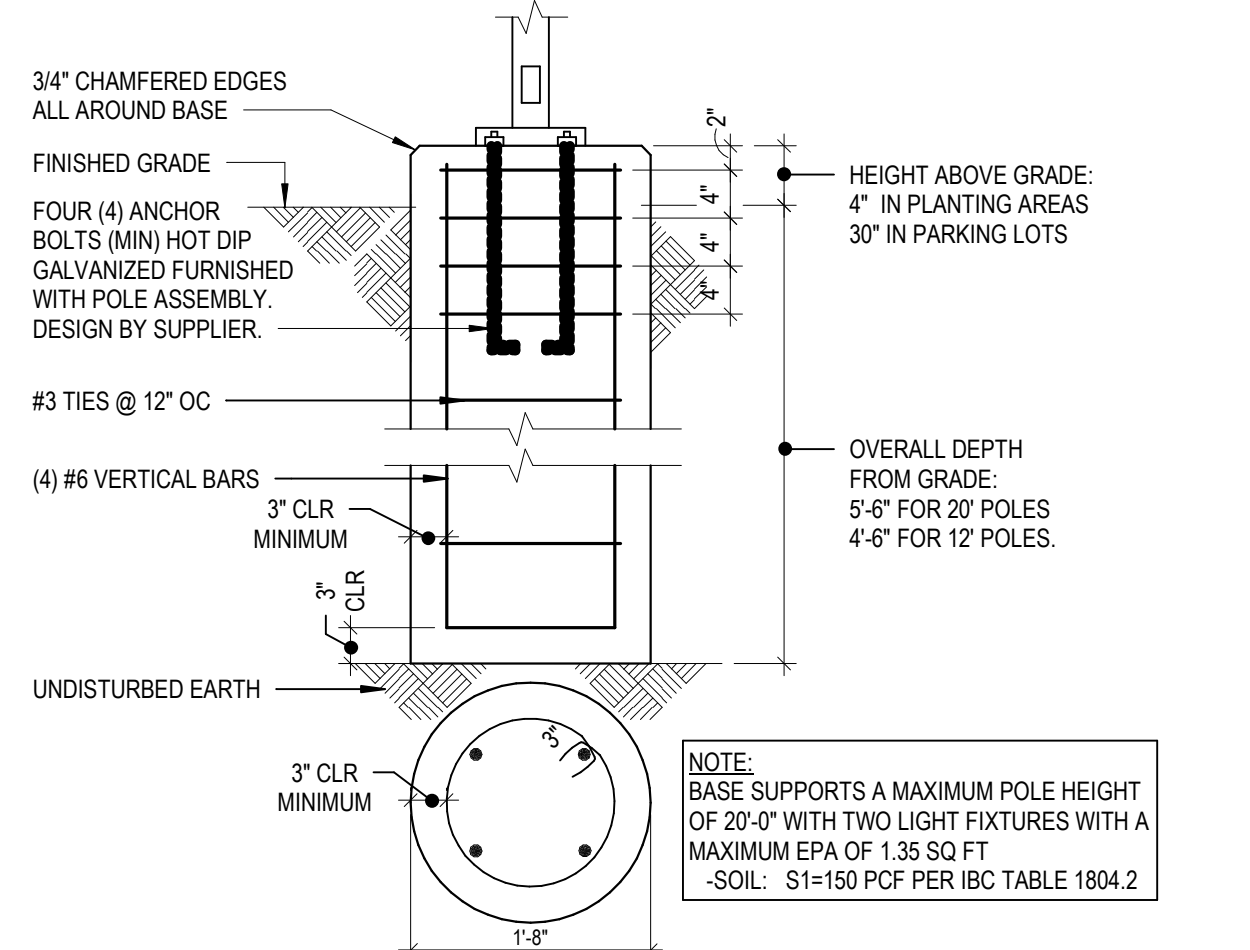

5C TYP LIGHT POLE BASE
S3.1 SCALE: 3/4" = 1'-0"



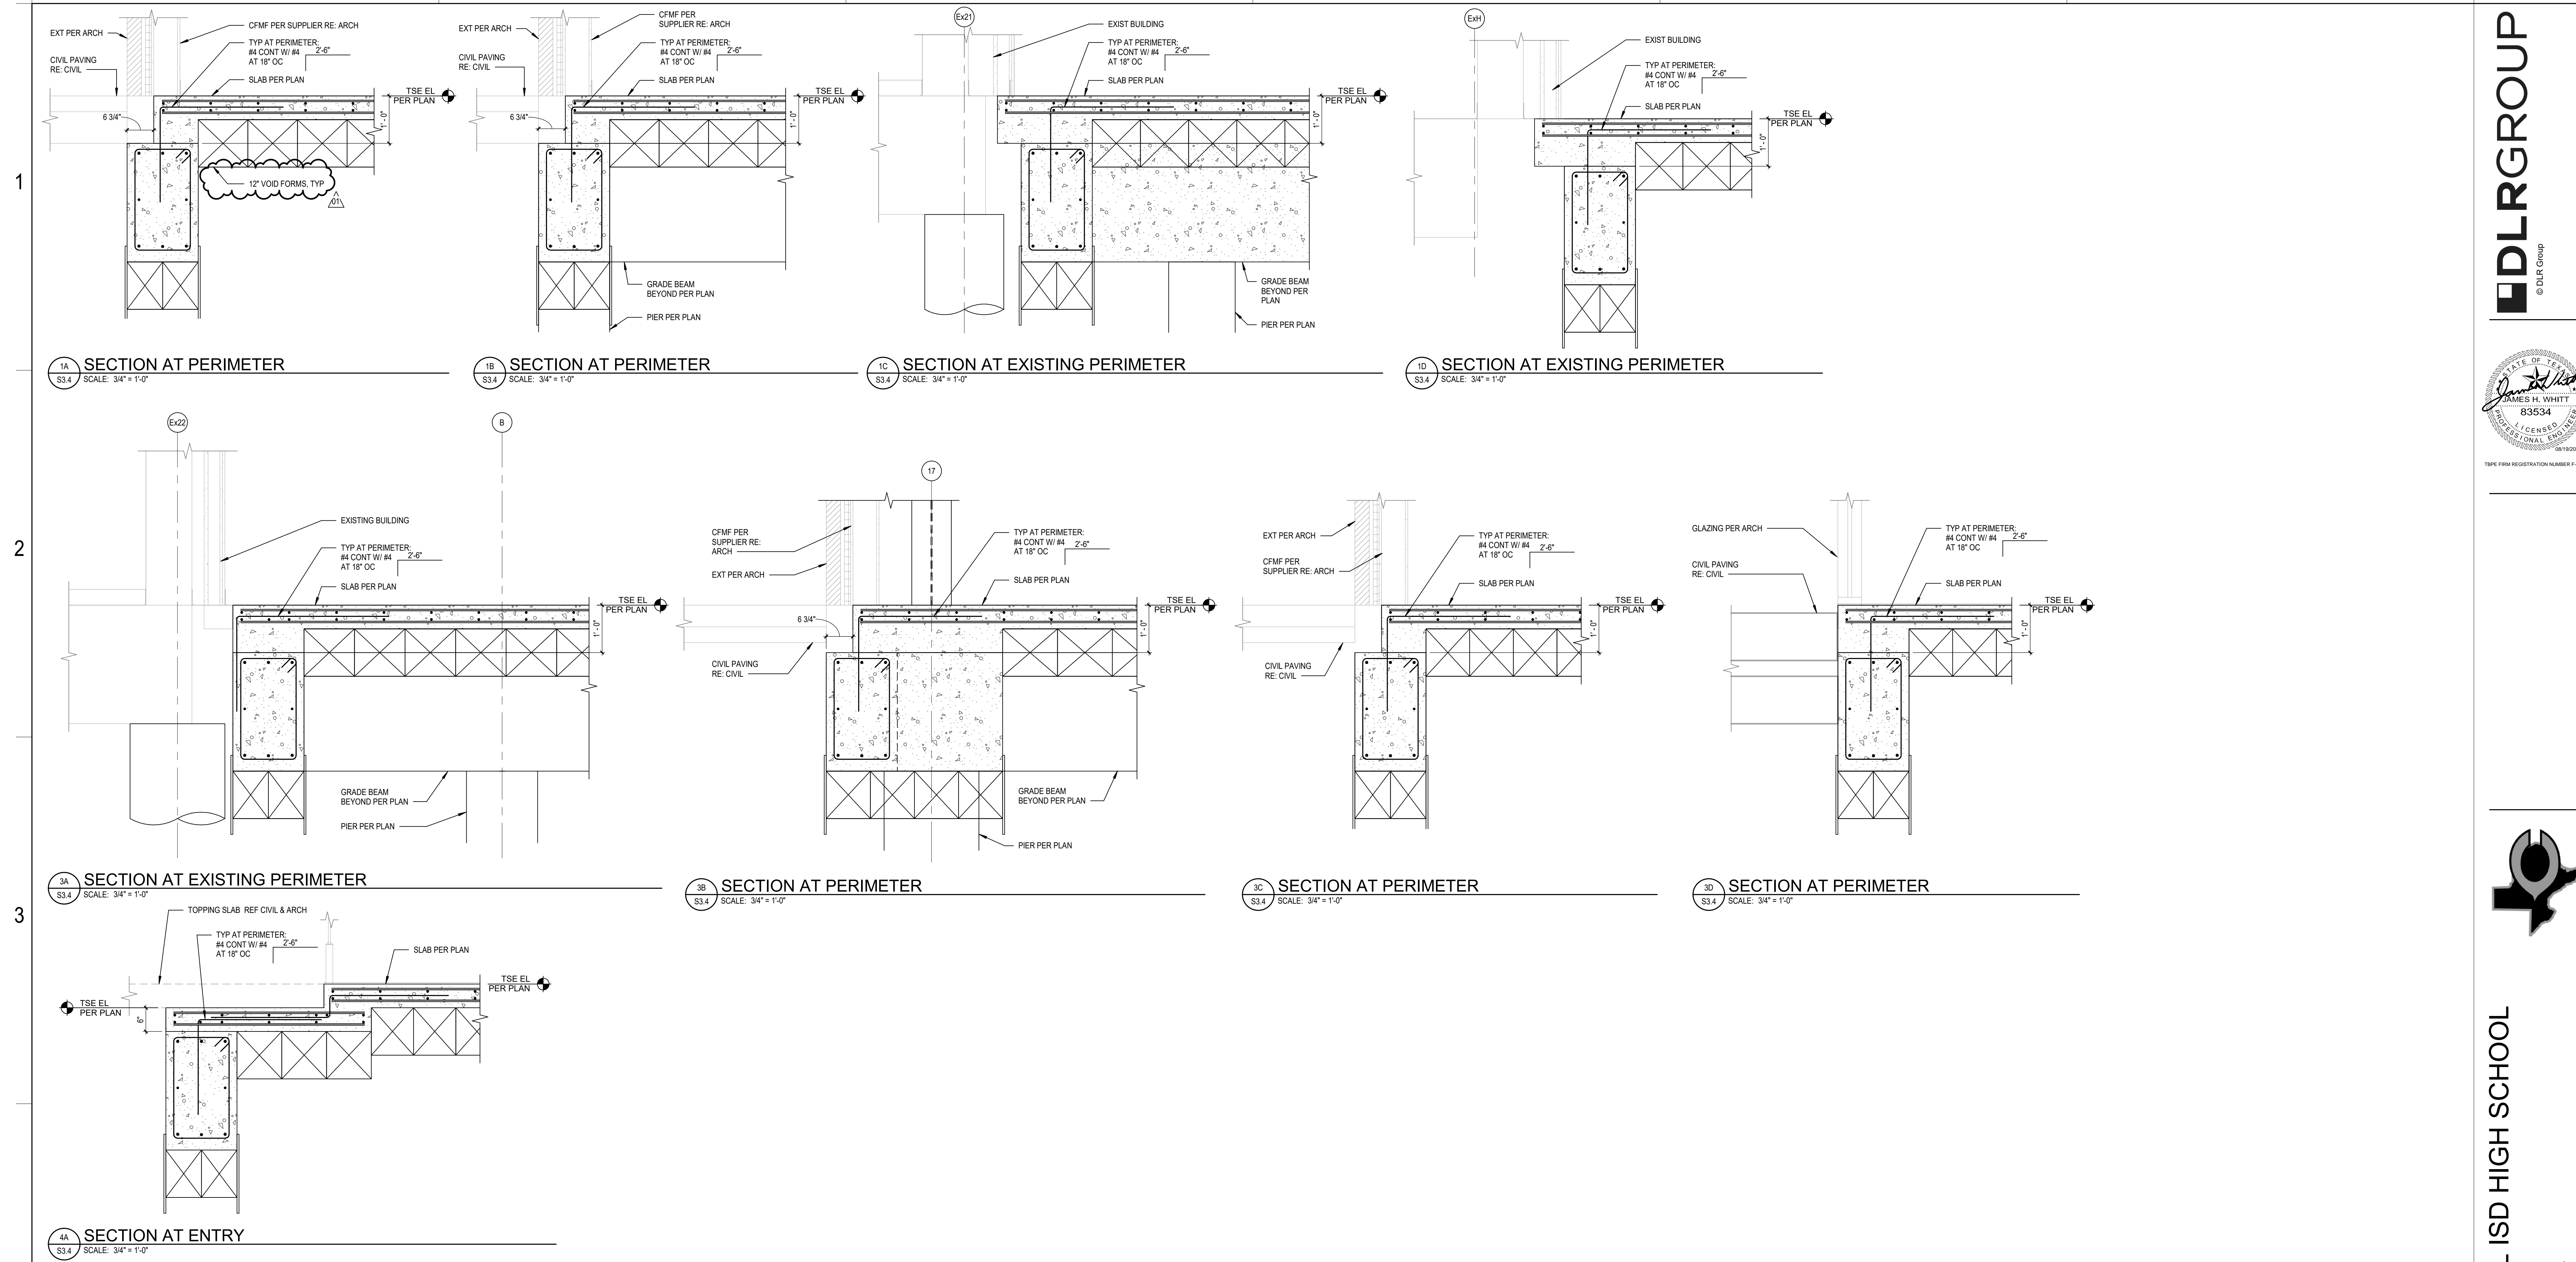


CRANDALL ISD HIGH SCHOOL
PAC ADDITION

13385 Fm 3038, Crandall, TX 75114

ISSUE FOR BID AND PERMIT
2024.07.25
REVISIONS
01 08/19/24 ADDENDUM 01

DLR GROUP
© DLR Group


STATE OF TEXAS
JAMES H. WHITT
83534
LICENSED PROFESSIONAL ENGINEER
08/19/2024
TYPE FRM REGISTRATION NUMBER F-1101




39-23712-00
STRUCTURAL DETAILS

S3.4


Autodesk Docs://39-23712-00 Crandall ISD - PAC Additions/39-23712-00 Crandall ISD - Struct_2024.rvt
 8/19/2024 4:17:44 PM

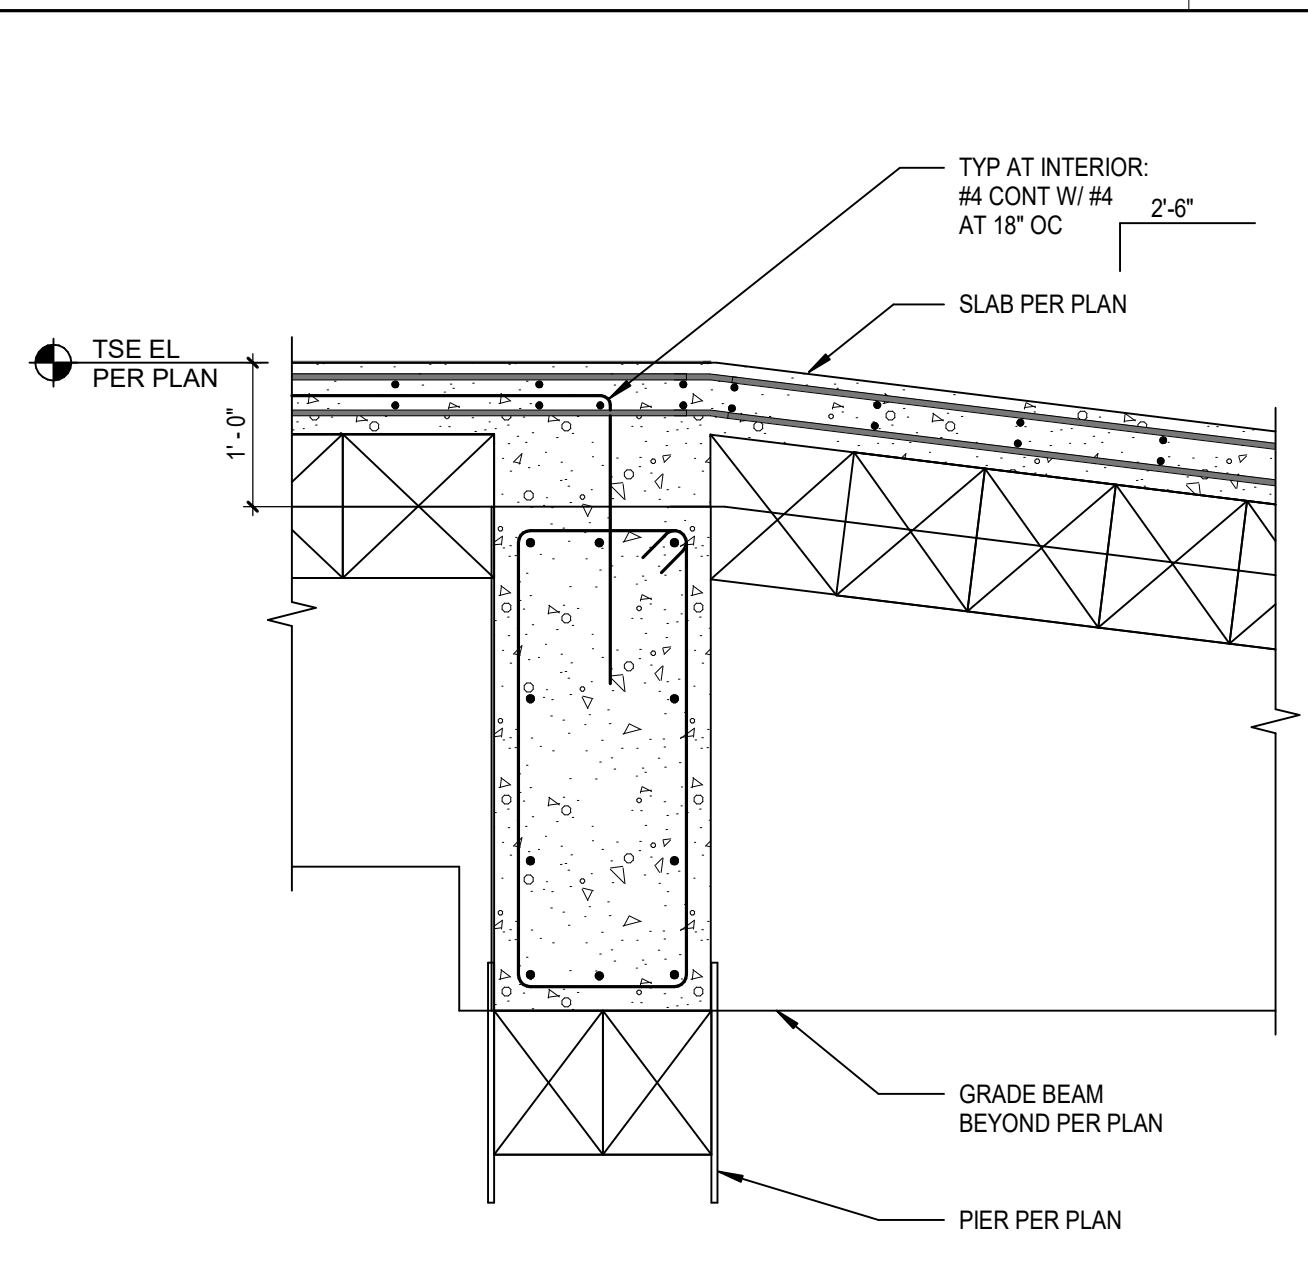


2A SECTION
S3.5 SCALE: 3/4" = 1'-0"

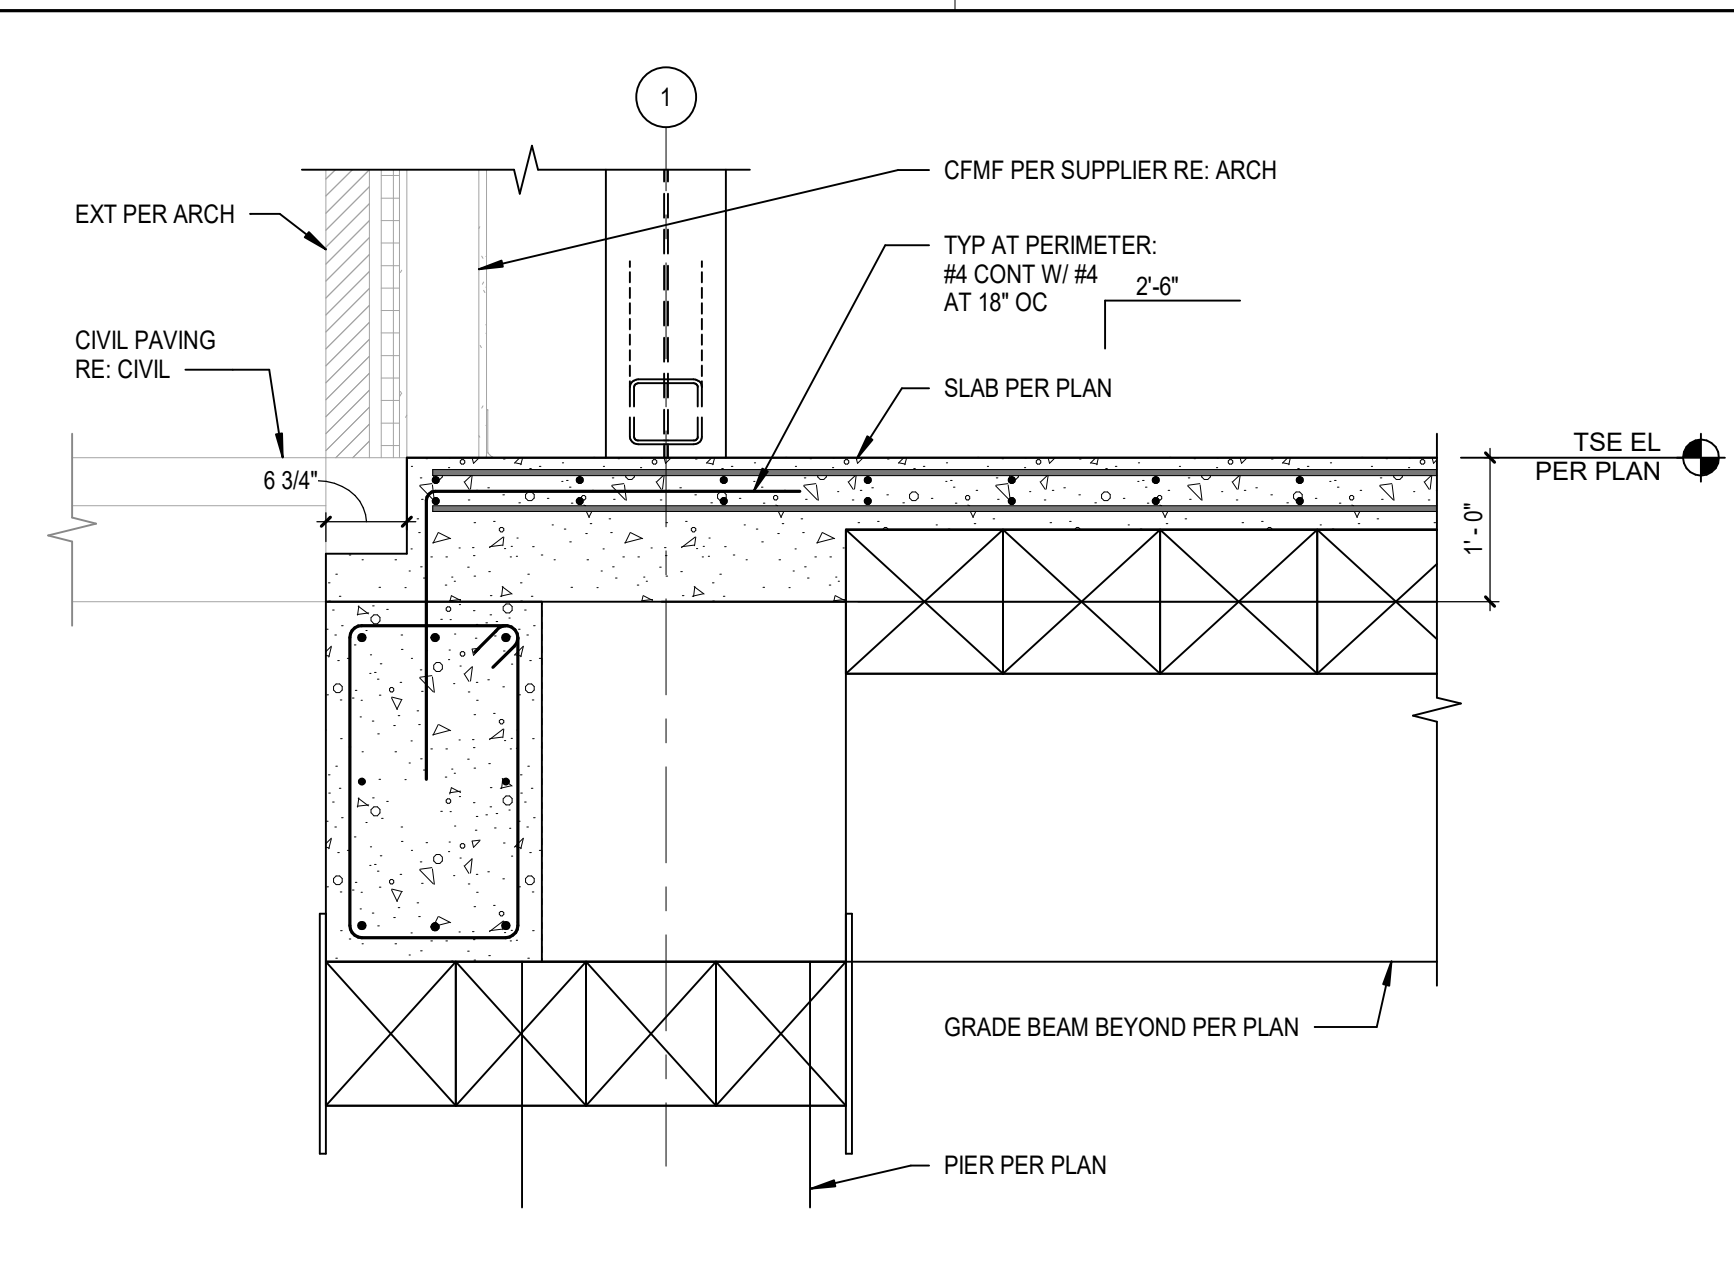


2B SECTION
S3.5 SCALE: 3/4" = 1'-0"

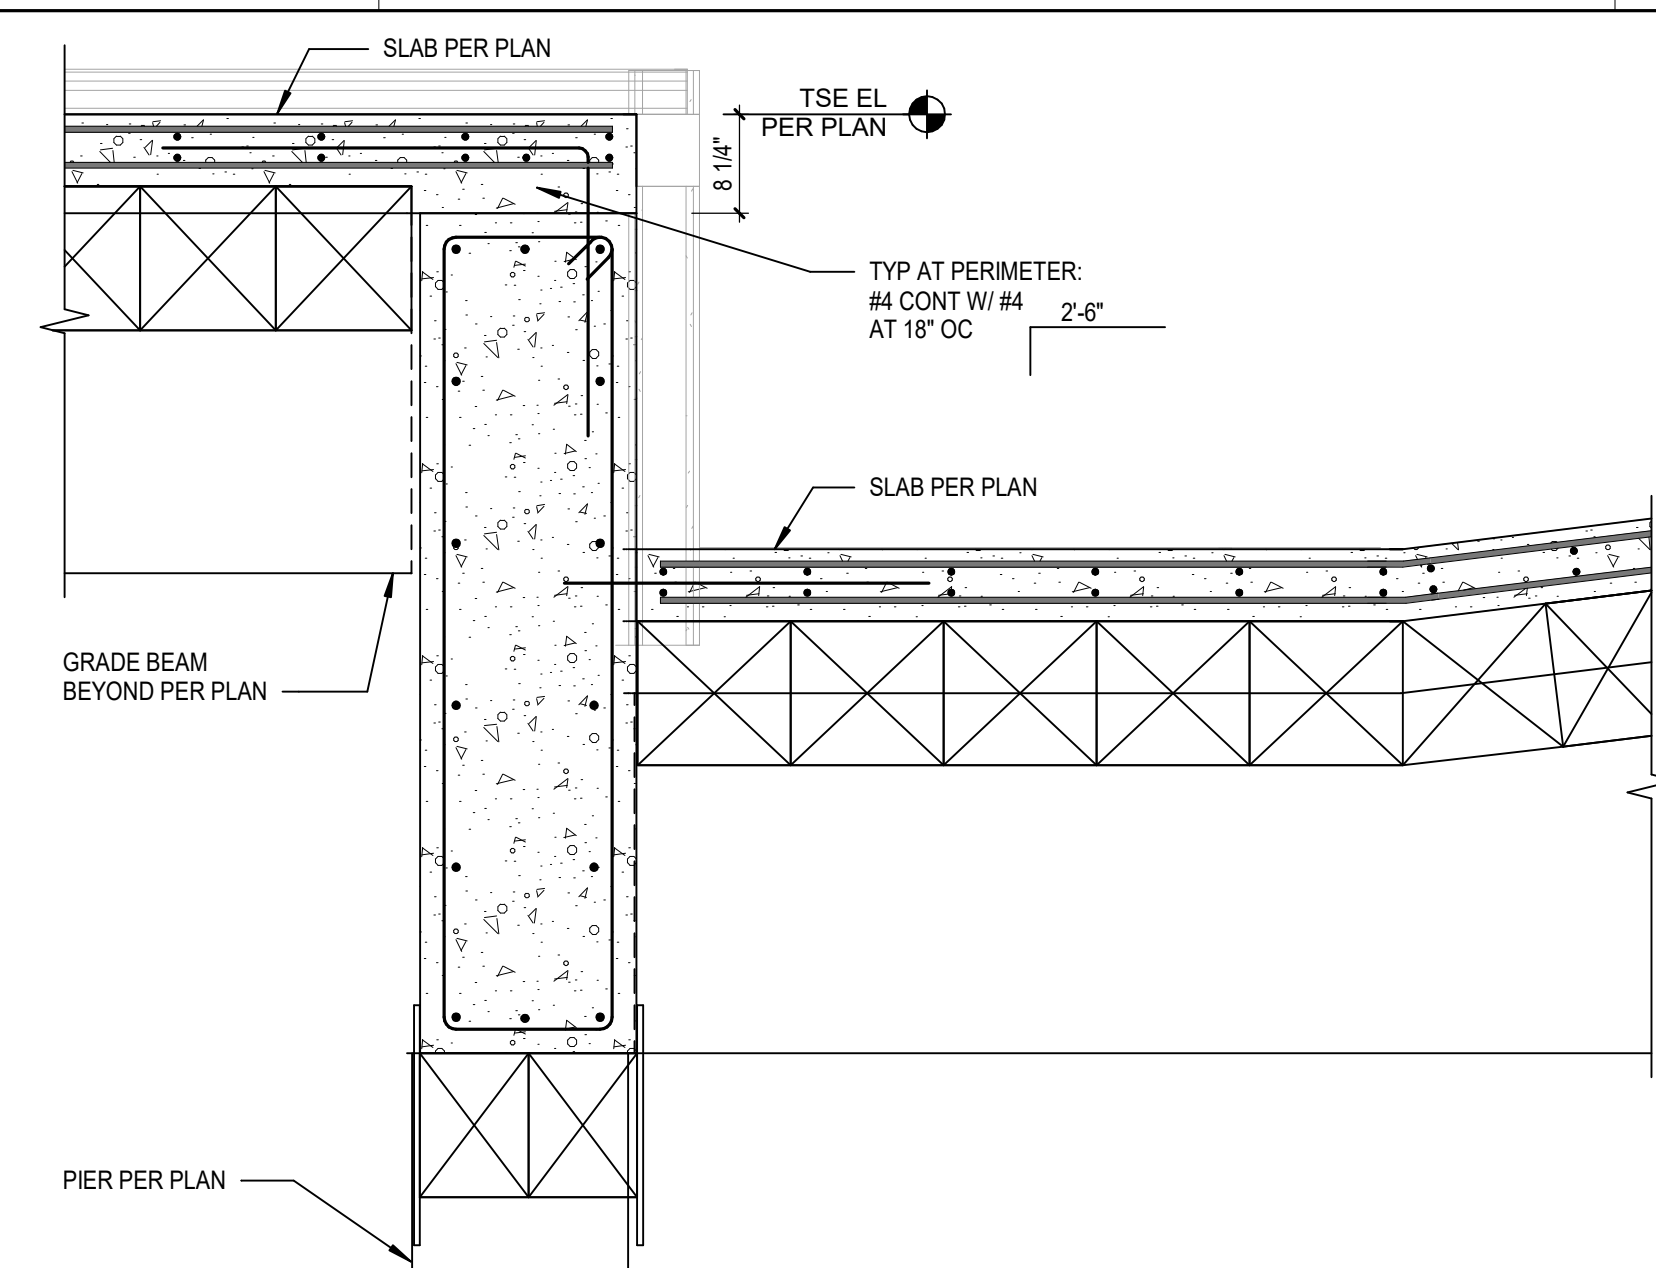

2C SECTION
S3.5 SCALE: 3/4" = 1'-0"

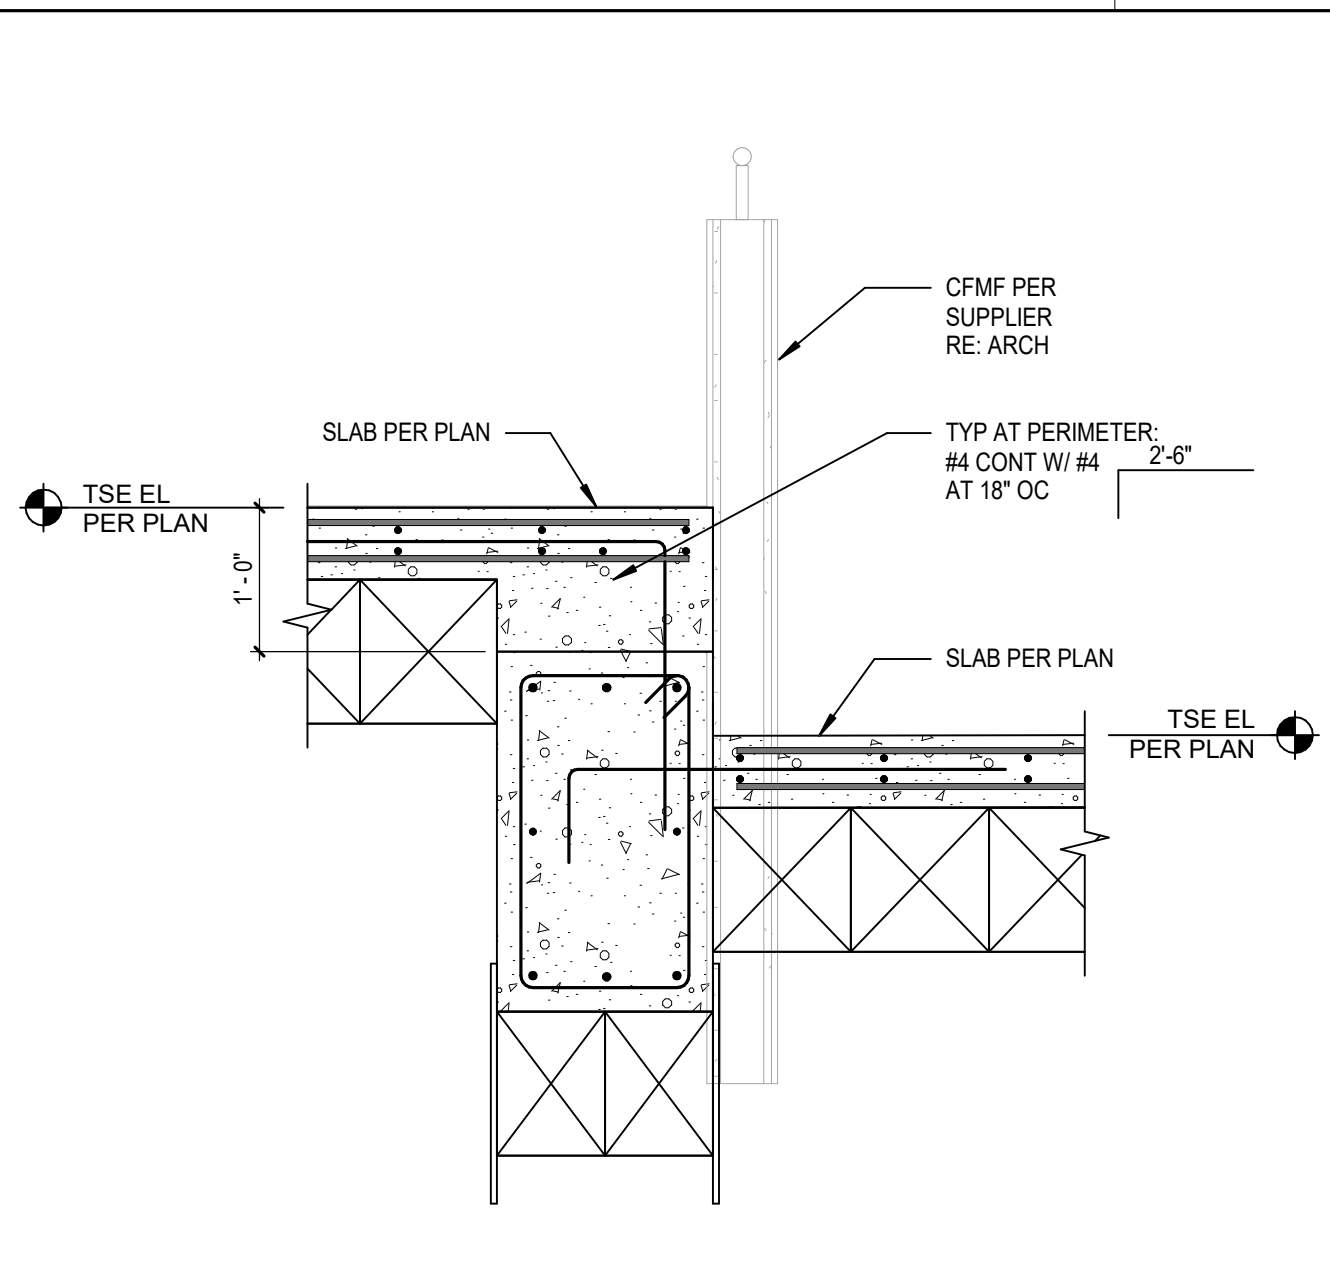


2E SECTION
S3.5 SCALE: 3/4" = 1'-0"

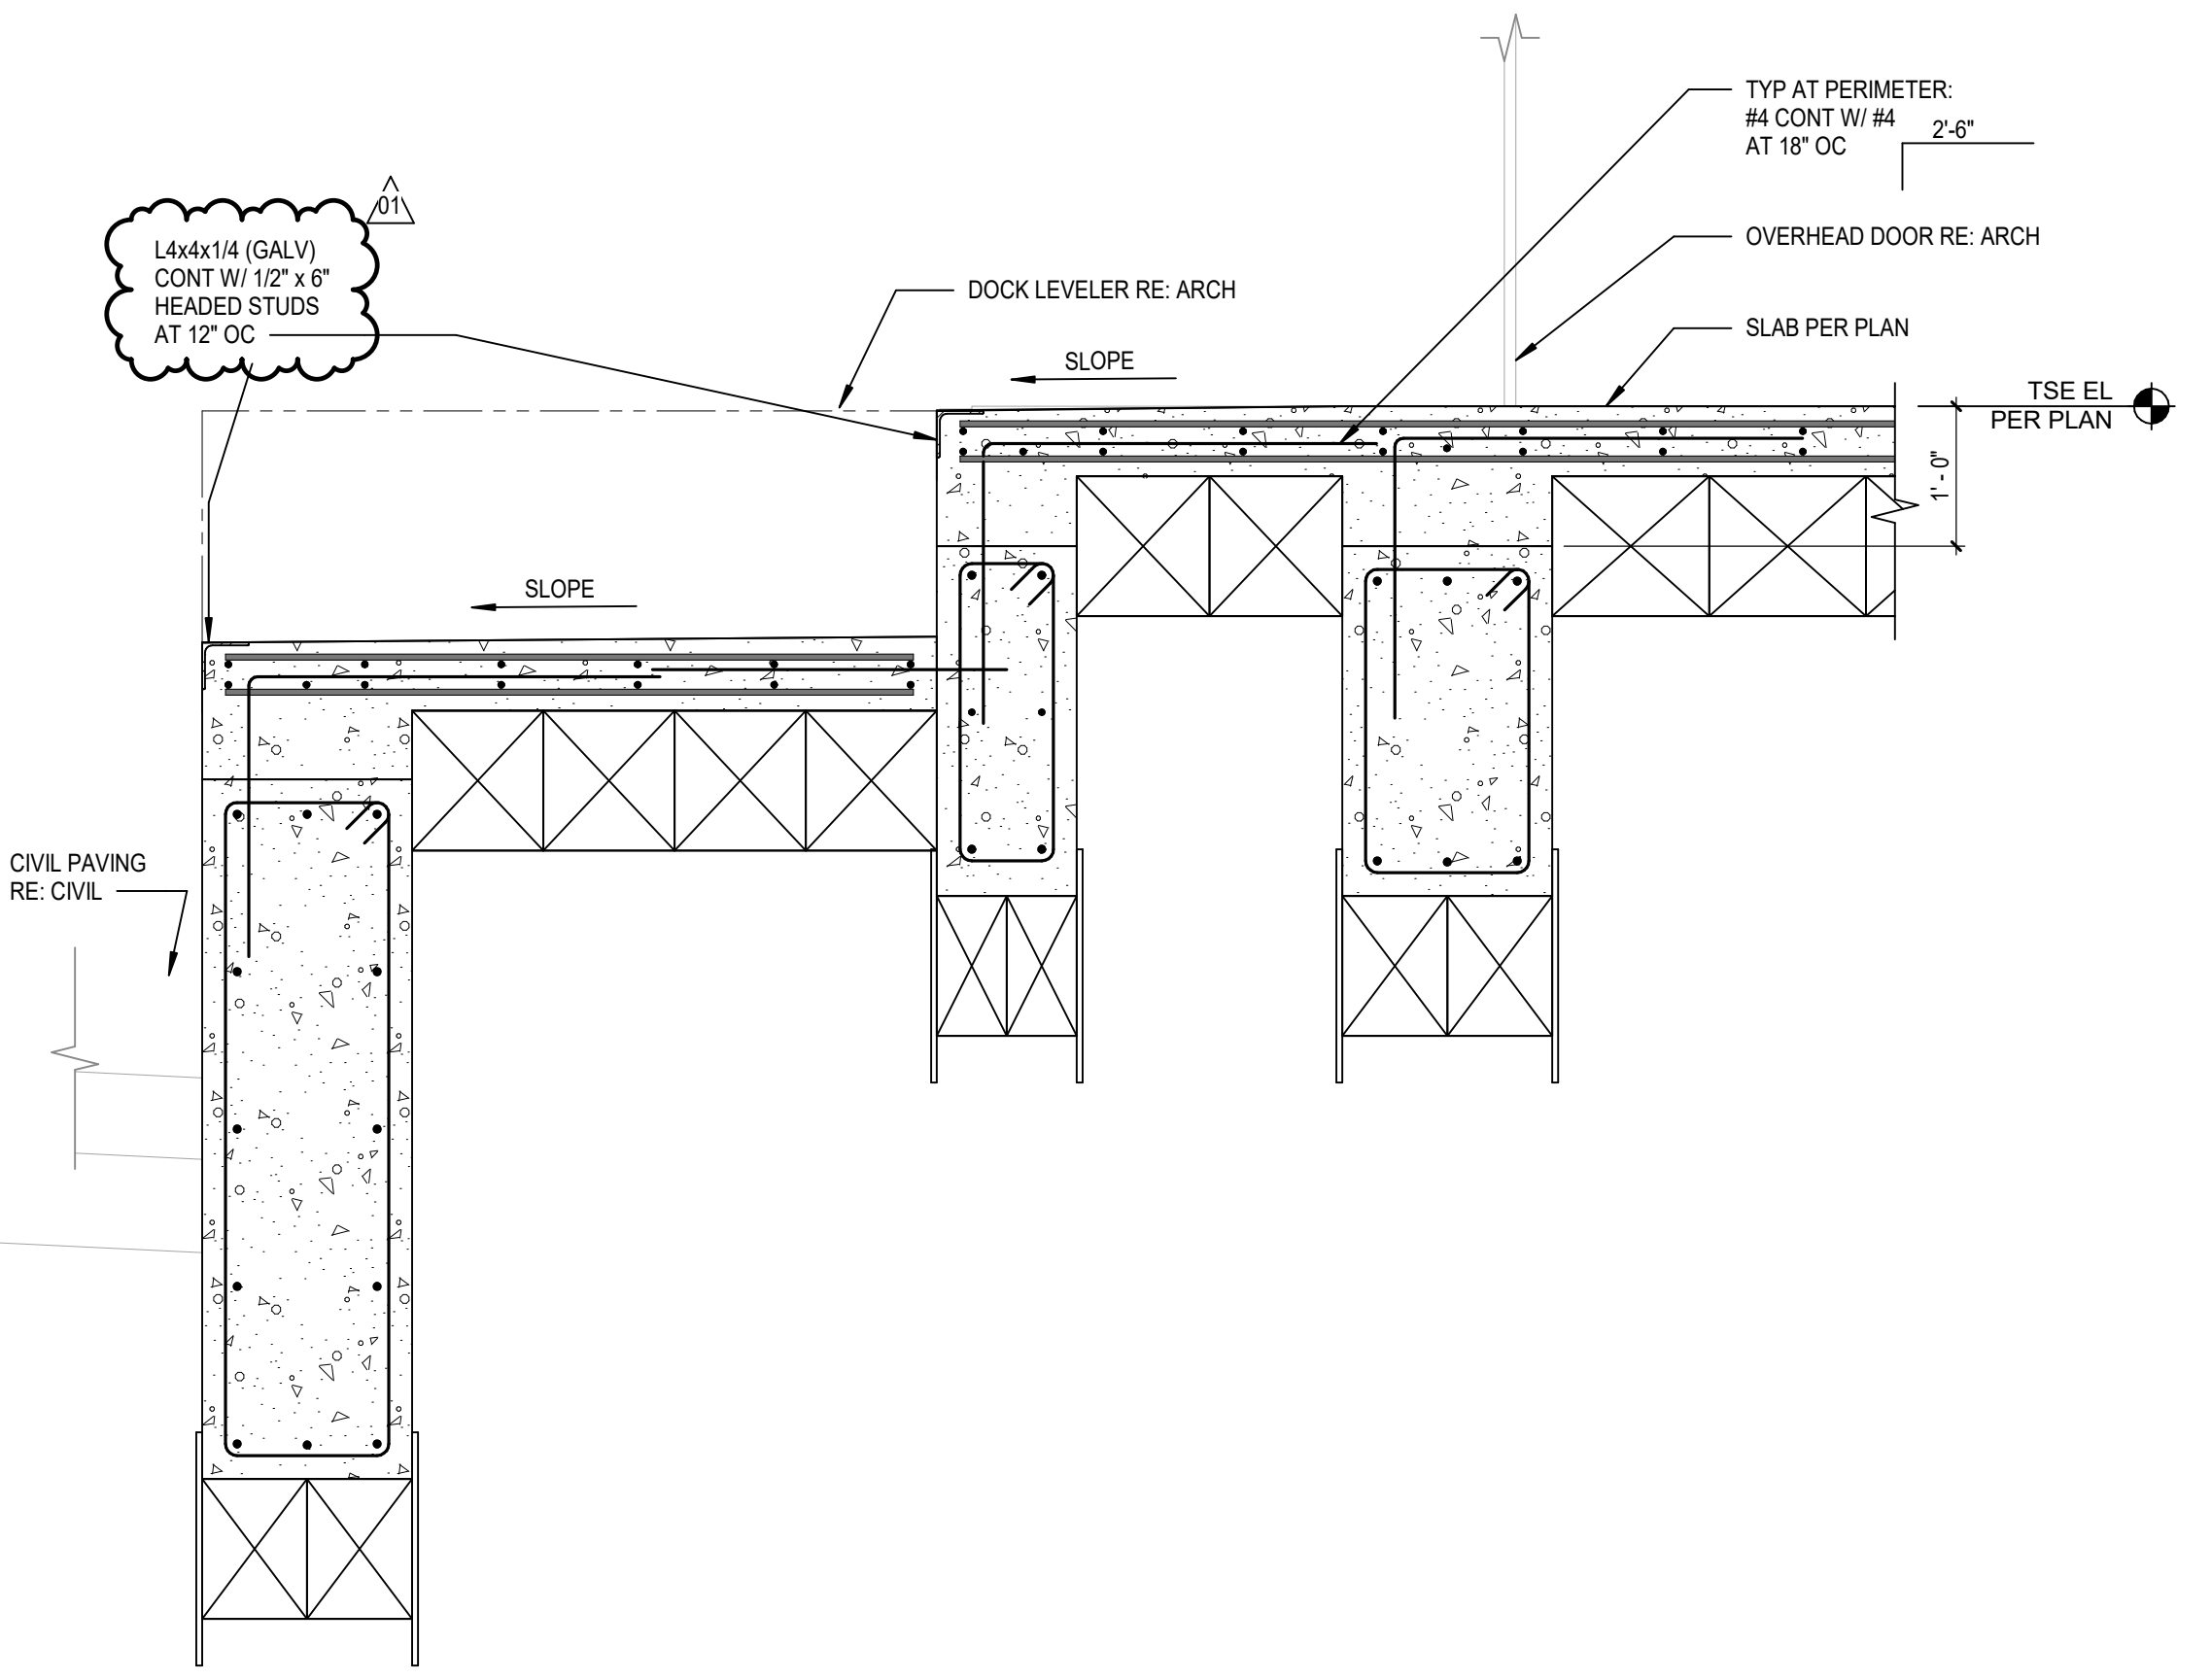

3A SECTION AT DOCK LEVEL
S3.5 SCALE: 3/4" = 1'-0"

Autodesk Docs://39-23712-00_Crandall_ISD_PAC/39-23712-00_Crandall_ISD_Sheet_2024.rvt
 8/19/2024 4:17:45 PM



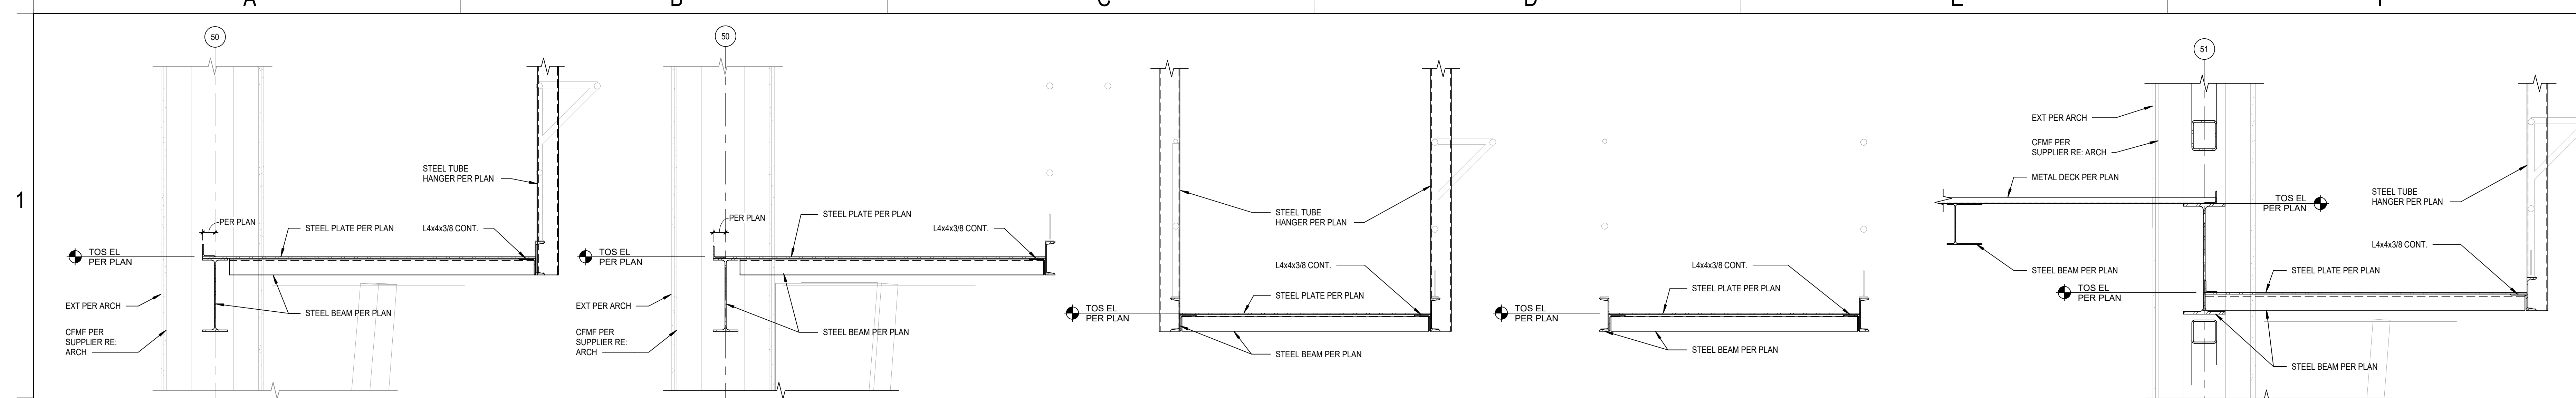


1A SECTION AT CATWALK
SCALE: 3/4" = 1'-0"

1B SECTION AT CATWALK
SCALE: 3/4" = 1'-0"

1C SECTION AT CATWALK
SCALE: 3/4" = 1'-0"

1D SECTION AT CATWALK
SCALE: 3/4" = 1'-0"


1E SECTION AT CATWALK
SCALE: 3/4" = 1'-0"

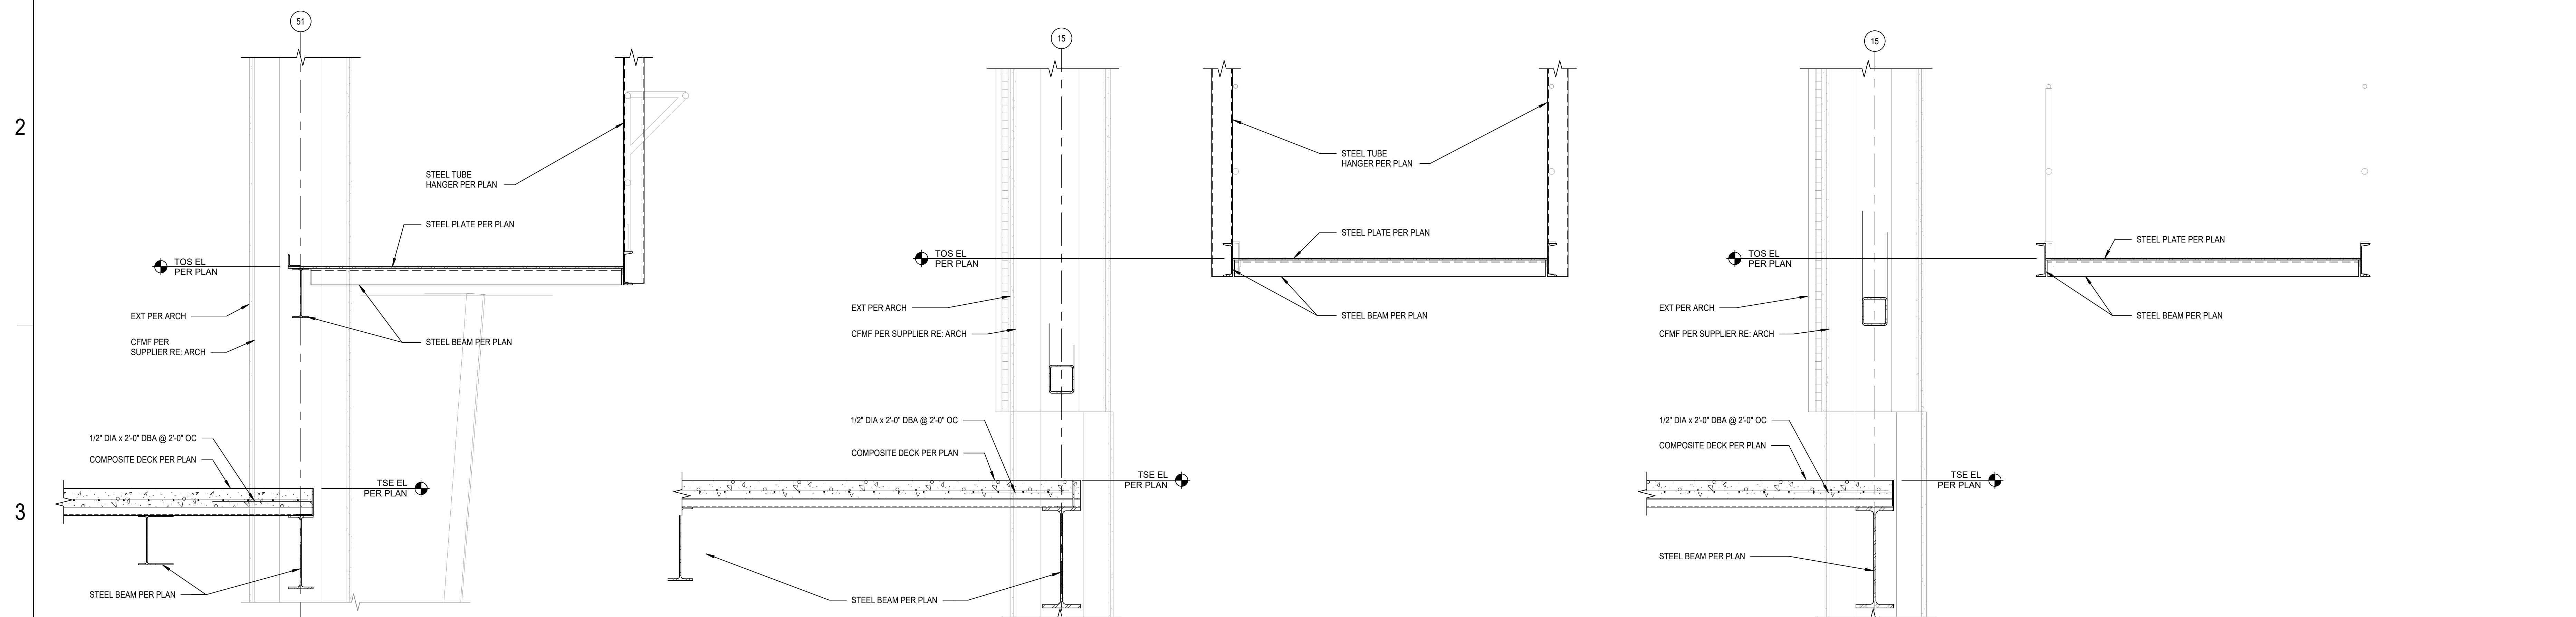


3A SECTION AT CATWALK
SCALE: 3/4" = 1'-0"

3B SECTION AT CATWALK
SCALE: 3/4" = 1'-0"


3D SECTION AT CATWALK
SCALE: 3/4" = 1'-0"

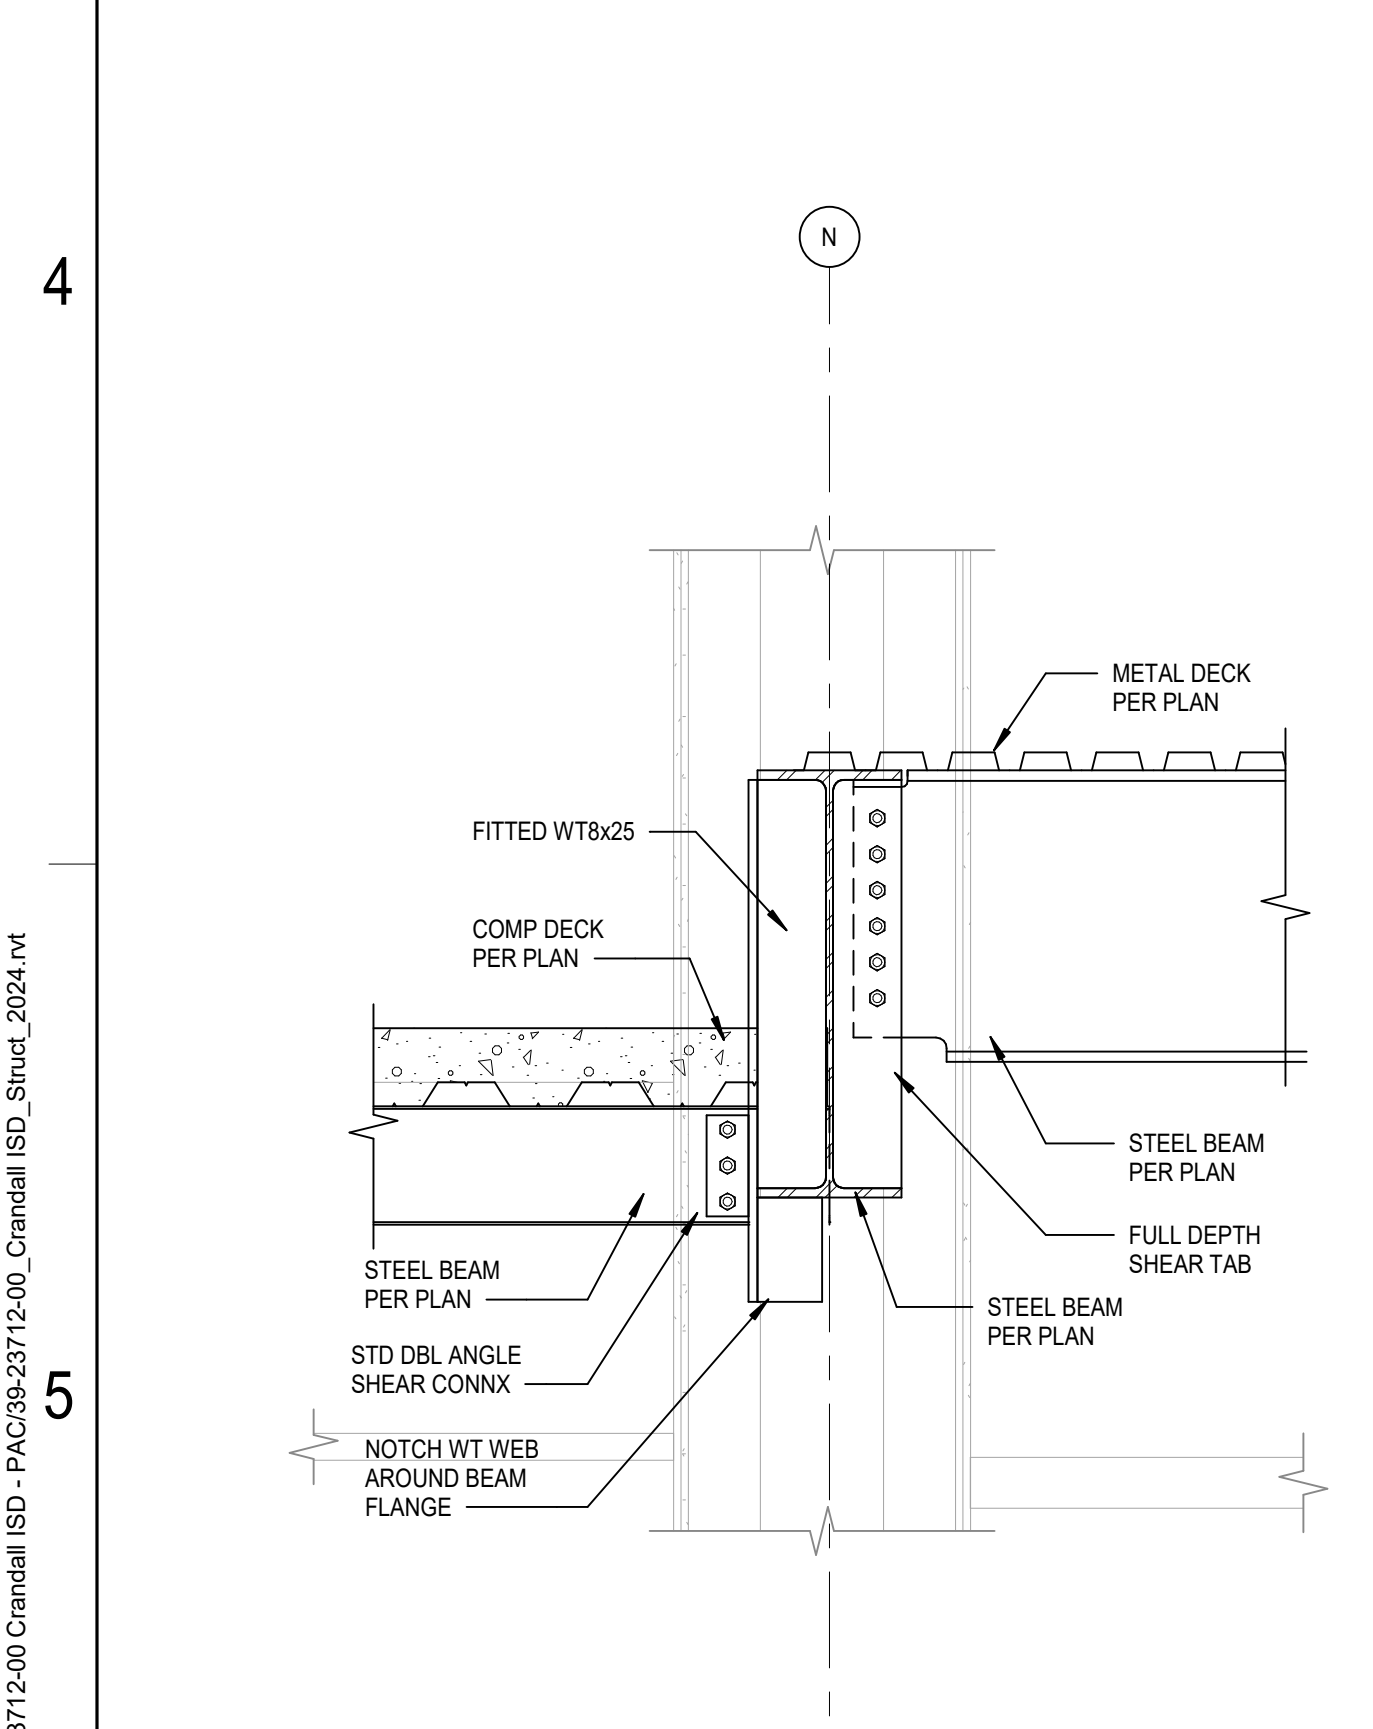


5A SECTION AT LOBBY ROOF
NO SCALE

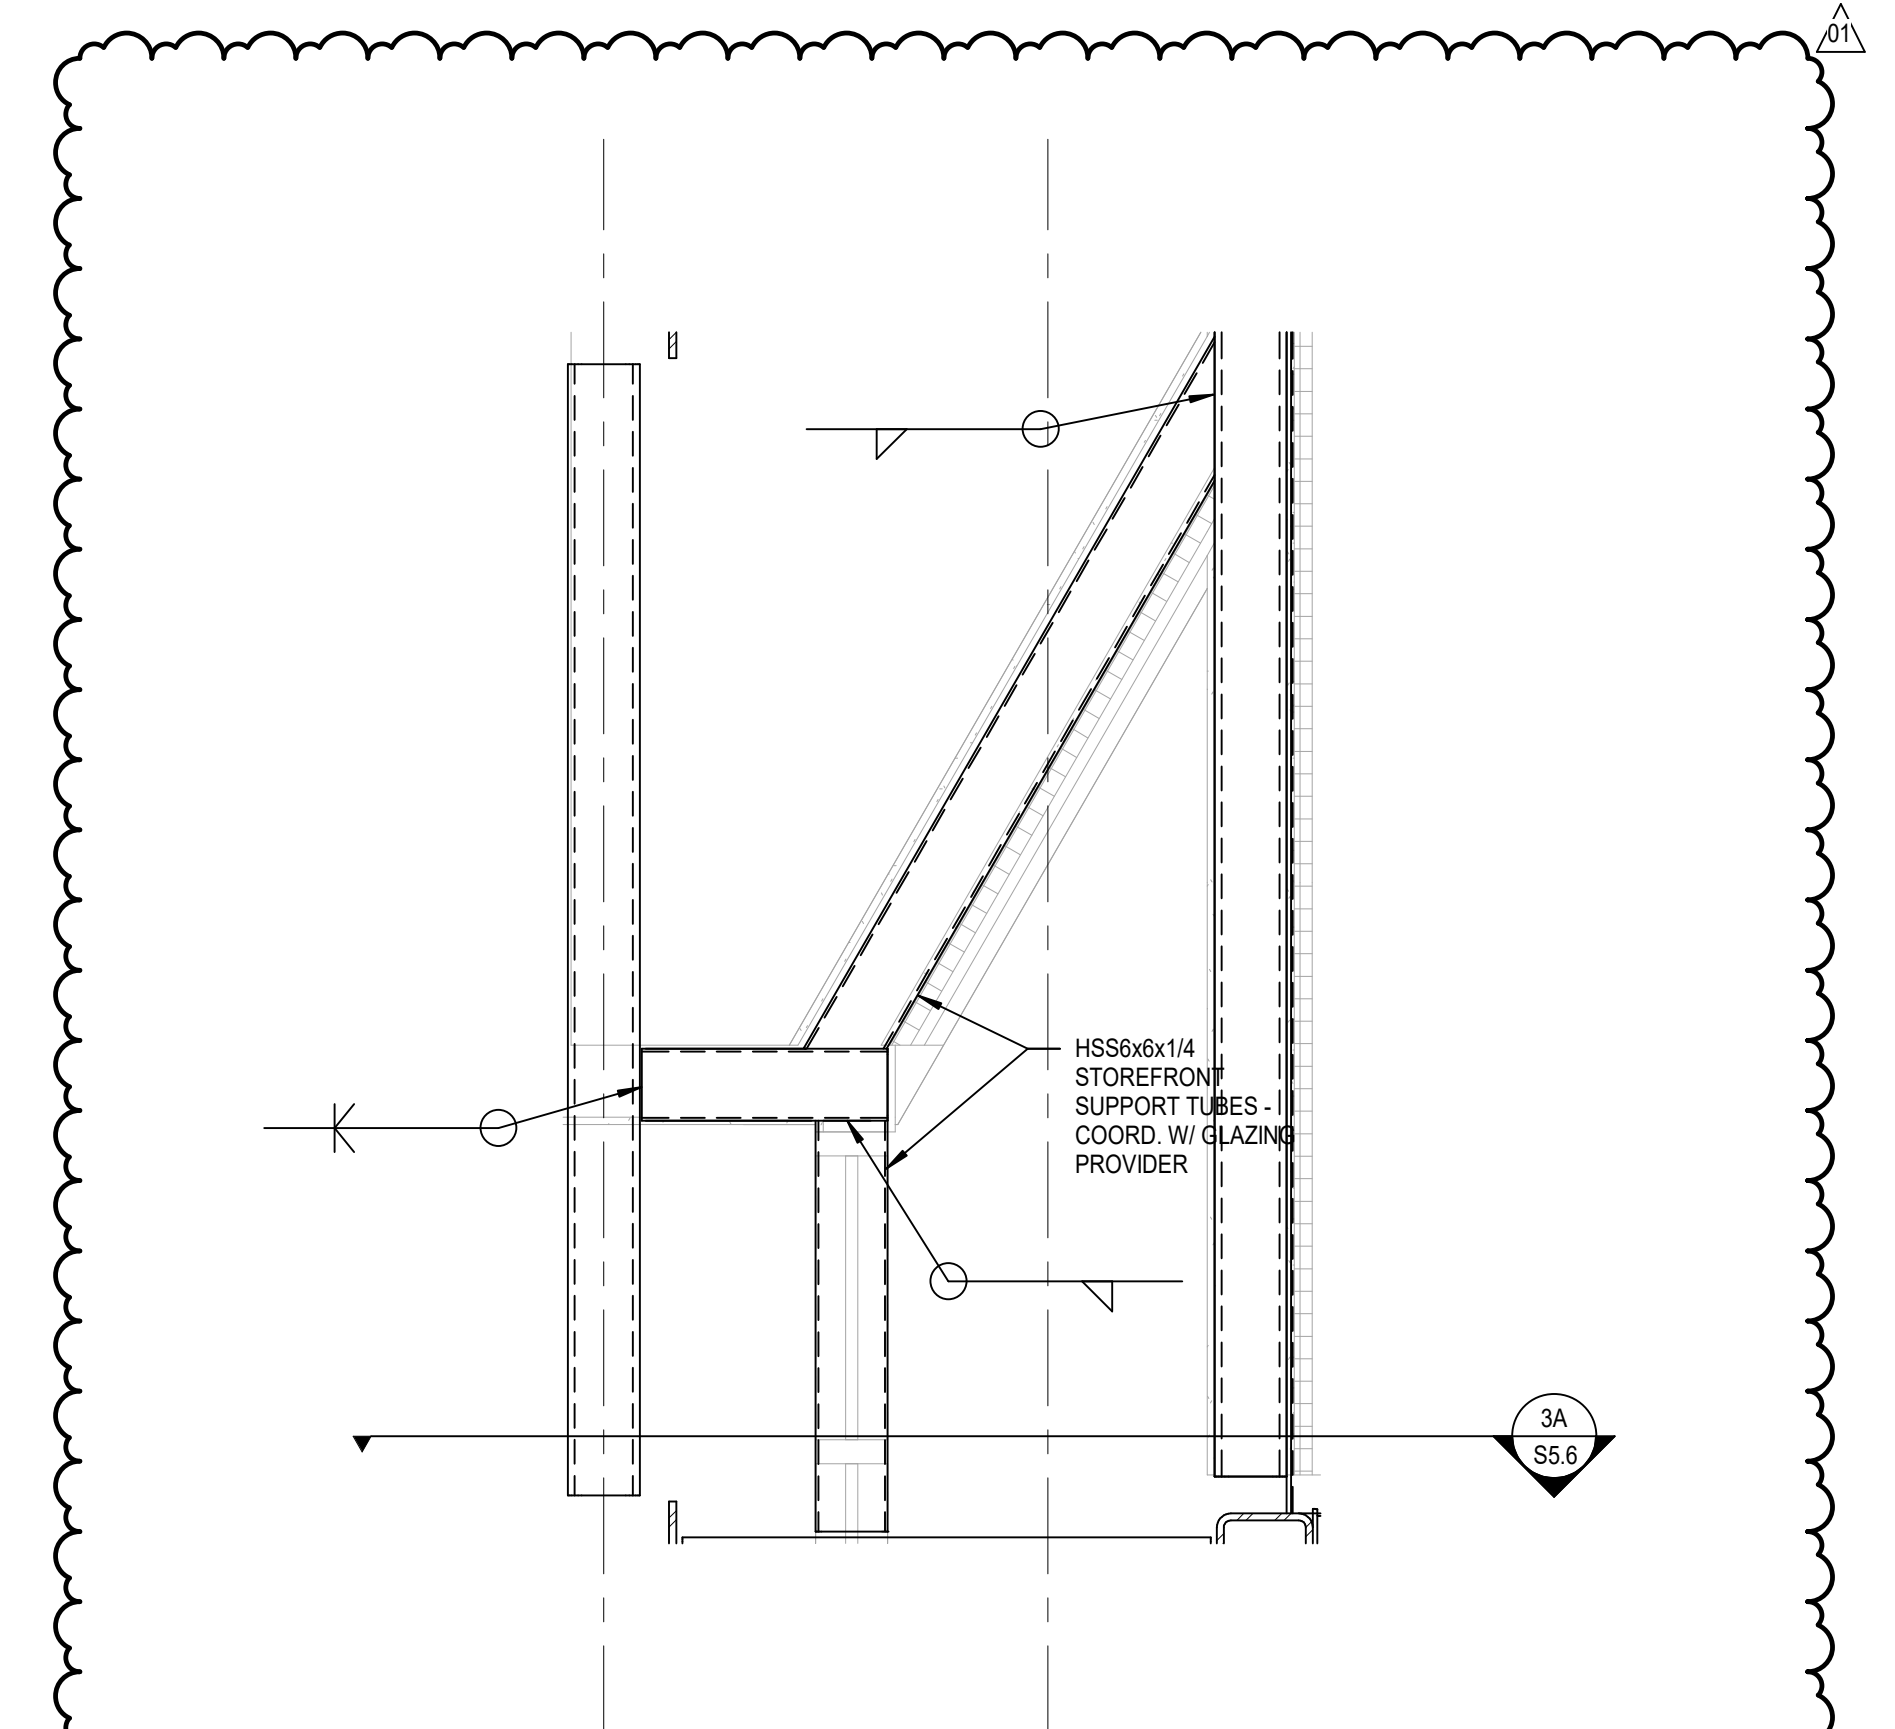


5B STOREFRONT SUPPORT - PLAN DETAIL
SCALE: 3/4" = 1'-0"

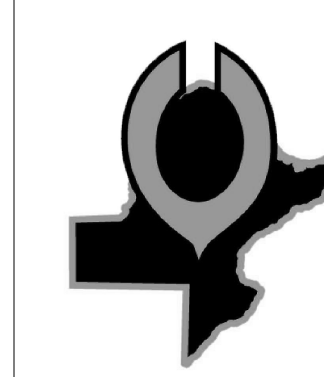


Autodesk DocuSign/25712-00 Crandall ISD - PAC Addn 23712-00 Crandall ISD - Steel_2024.rvt
8/19/2024 4:17:45 PM

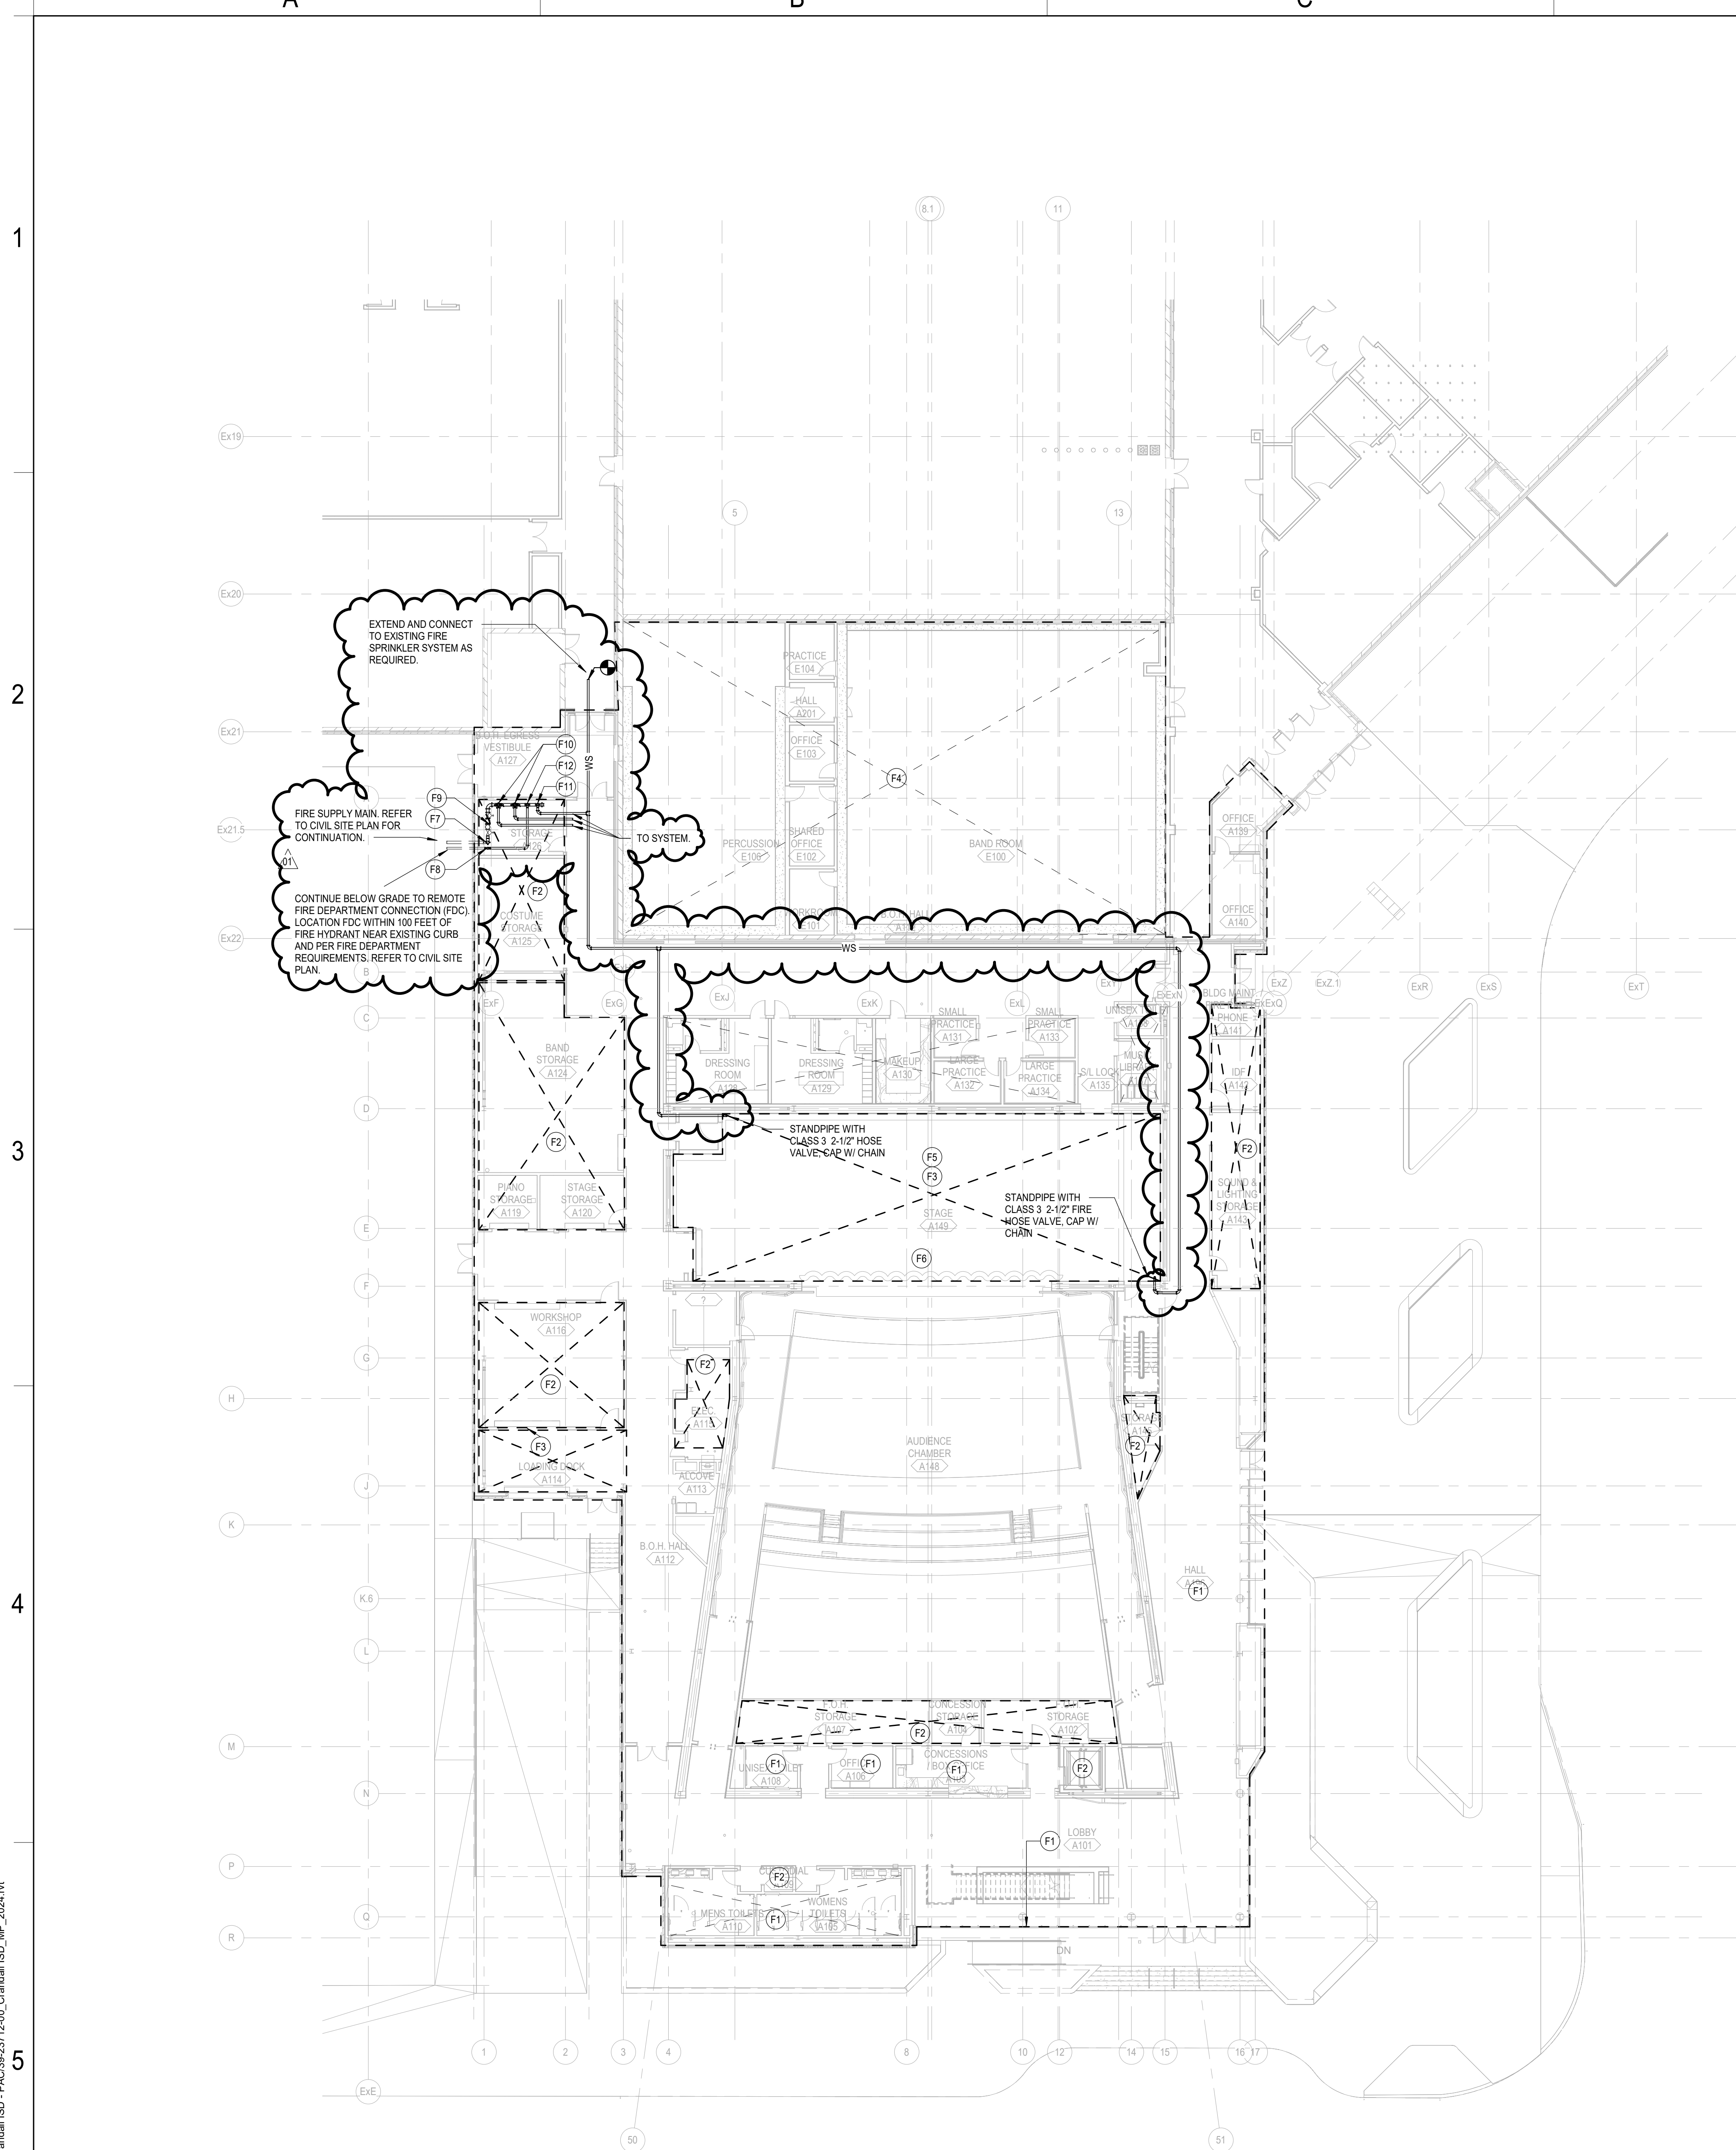

LEVEL 01 - FIRE PROTECTION PLAN
SCALE: 1/16" = 1'-0"

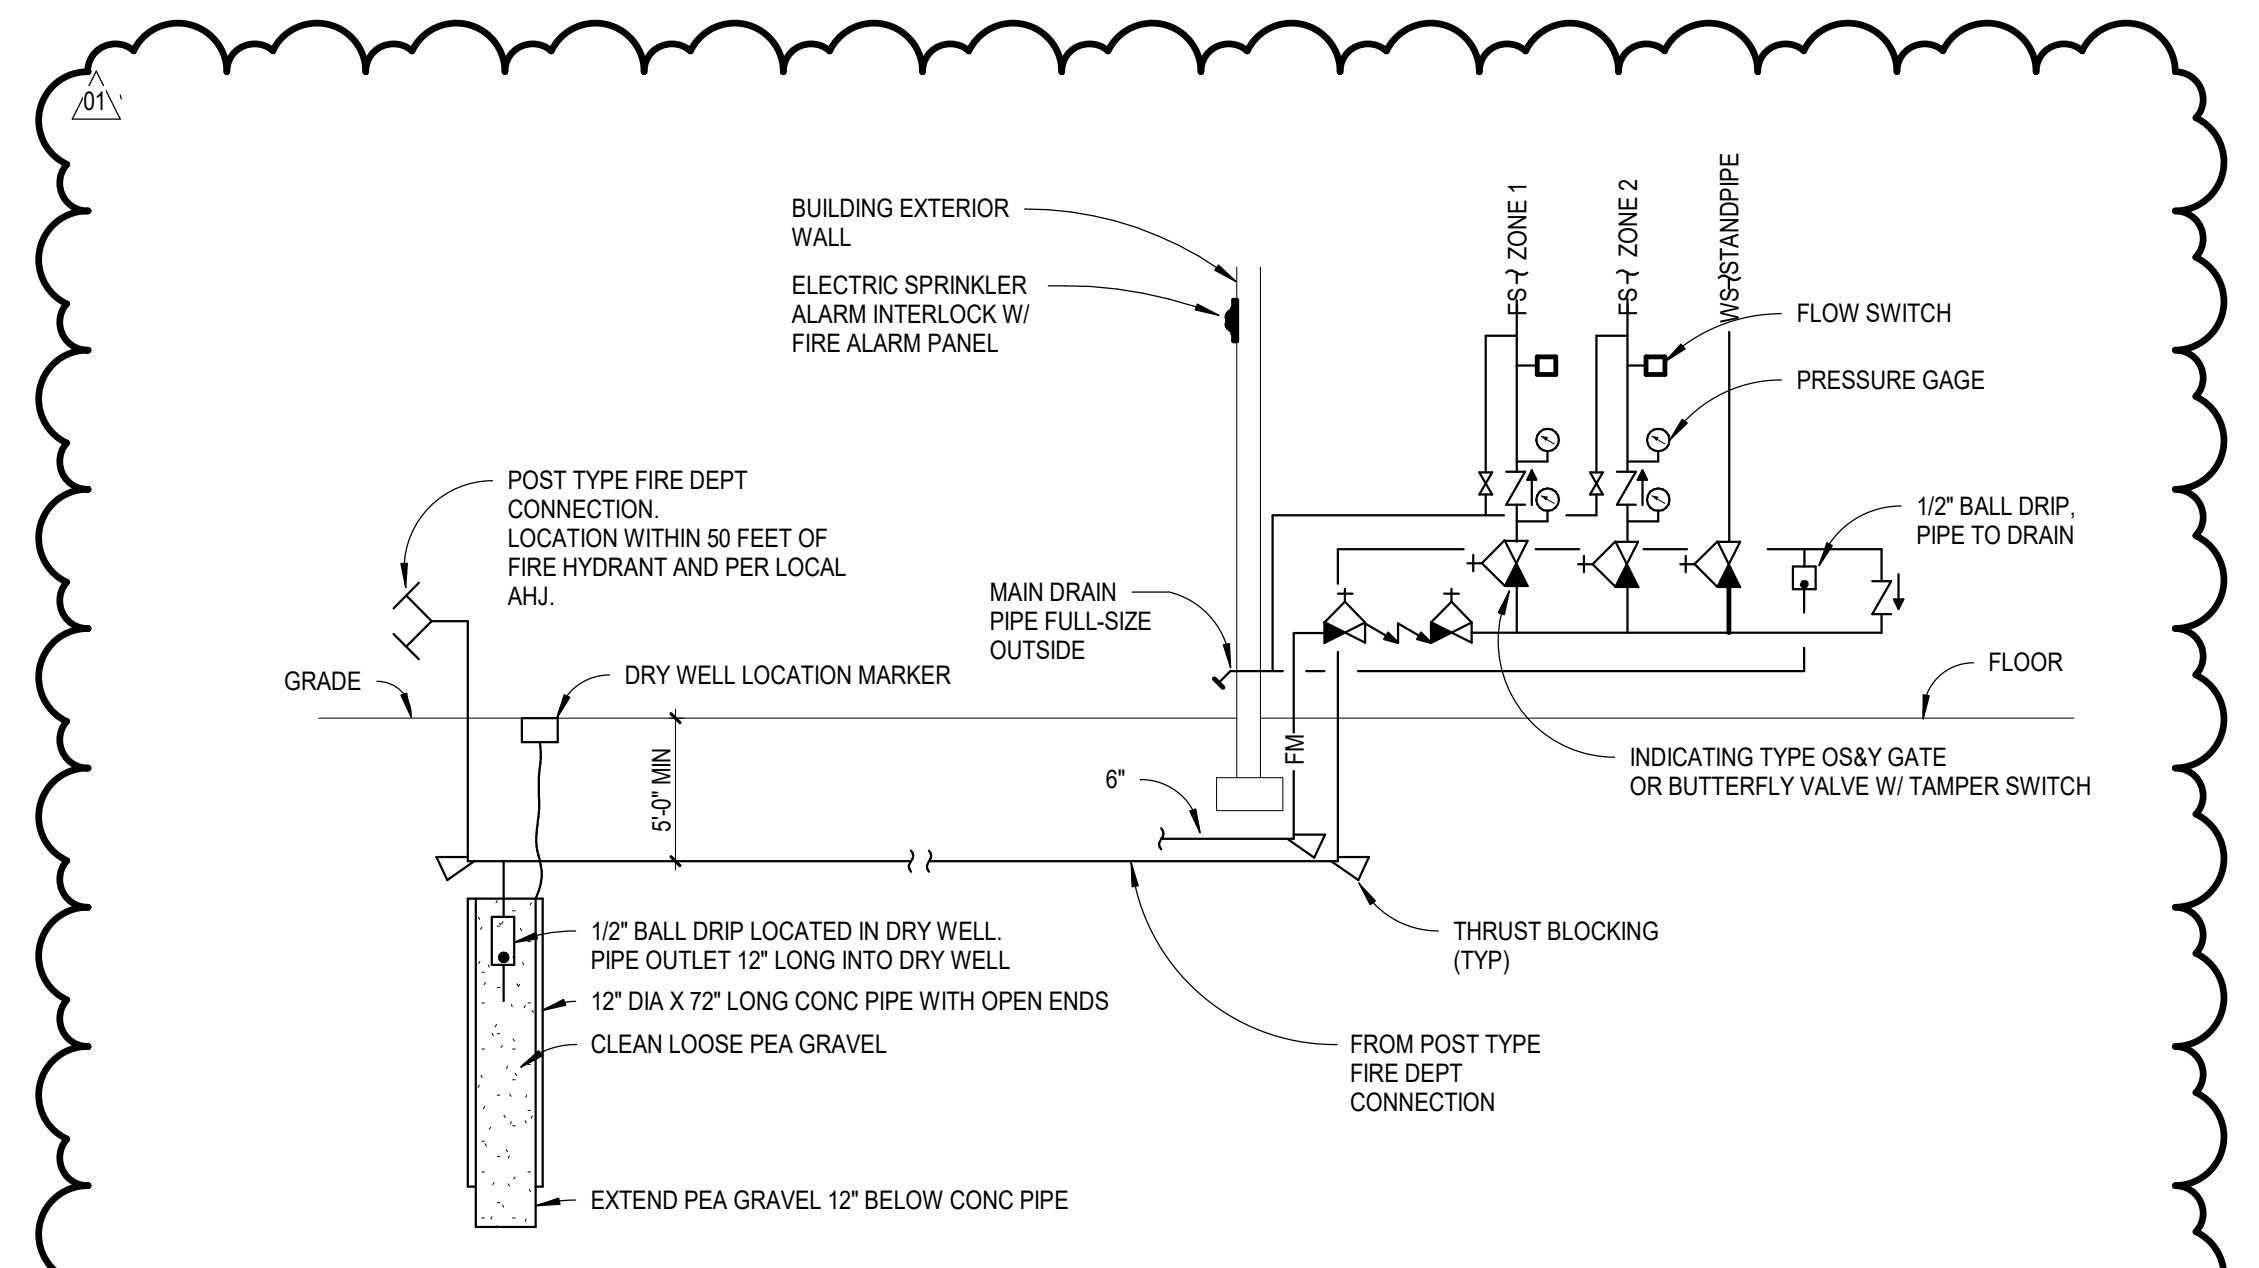


2 FIRE RISER ASSEMBLY W/ POST TYPE FDC
FP1.1 NO SCALE

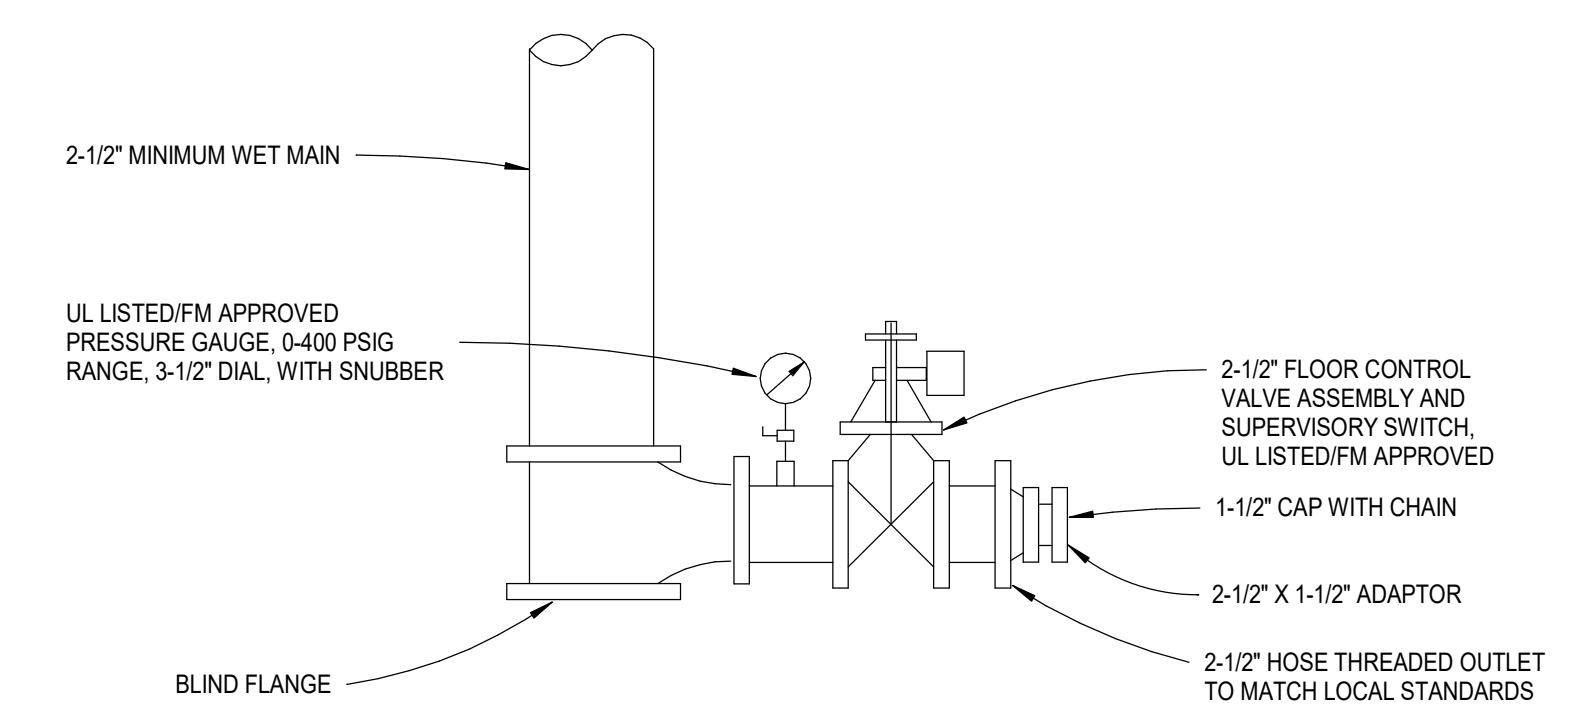

3 STAGE FIRE HOSE CONNECTION DETAIL
FP1.1 / NO SCALE

GENERAL NOTES

1. PROVIDE BUILDING I.D. ON REMOTE FIRE DEPT. CONNECTION.
2. NO TREES, BUSHES OR WALLS WITHIN 5' RADIUS OF FIRE DEPT. CONNECTION.
3. IF FIRE SPRINKLER DESIGN INDICATES DEMAND OF 1000 GPM. OR GREATER, THE UNDERGROUND FIRE DEPT. CONNECTION LINE SHALL BE INCREASED TO 6" DIAMETER WITH A THREE WAY 2-1/2" FIRE DEPT. HOSE CONNECTION.
4. 4' MIN. TO BACK OF CURB, OR 2' MIN TO BACK OF SIDEWALK, OR WHEN NO CURB, 4' MAX. OUTSIDE THE CLEAR ZONE.
5. INSTALL DRAIN VALVE AT BUILDING INLET.
6. COORDINATE HOSE CONNECTION WITH A.H.I.

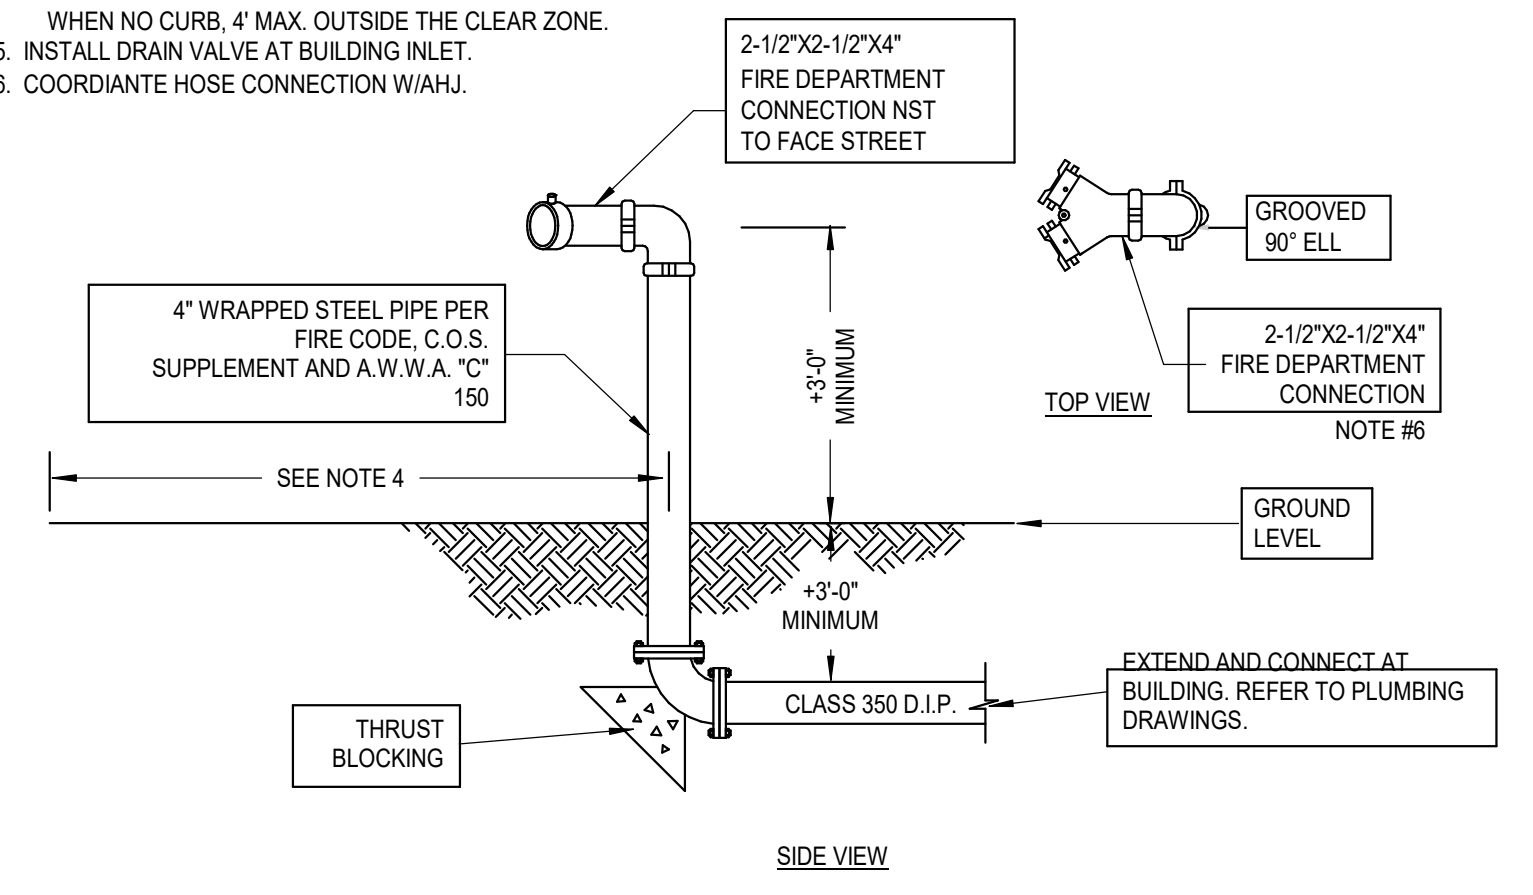

4 FIRE DEPARTMENT REMOTE SIAMESE CONNECTION
FP1.1 SCALE: 1/8" = 1'-0"


GENERAL NOTES

A. PROVIDE ALTERATIONS TO THE EXISTING FIRE PROTECTION SYSTEM AS REQUIRED TO ACCOMMODATE THE NEW ADDITION AND THE RENOVATED FLOOR PLANNING IN THE EXISTING BUILDING. PROVIDE A COMPLETE WET PIPE SYSTEM INCLUDING NEW MAINS, BRANCHES, HEADS, VALVES, AND ACCESSORIES AS REQUIRED. RE-USE EXISTING SYSTEM EQUIPMENT WHERE APPLICABLE IN THE EXISTING BUILDING. REFER TO THE ARCHITECTURAL REFLECTIVE CEILING PLAN. THE FIRE PROTECTION SYSTEM SHALL BE INSTALLED ACCORDING TO MANUFACTURER'S SPECIFICATIONS, RECOMMENDATIONS, AND PER REQUIREMENTS OF THE STATE BUILDING CODE, LOCAL FIRE DEPARTMENT, AND ALL FEDERAL, STATE, AND LOCAL AUTHORITIES, NFPA, AND FACTORY MUTUAL.

SHEET NOTES

- F1 AREA TO BE PROTECTED AS LIGHT HAZARD OCCUPANCY IN ACCORDANCE WITH NFPA 13.
- F2 AREA TO BE PROTECTED AS ORDINARY HAZARD GROUP 1 OCCUPANCY IN ACCORDANCE WITH NFPA 13.
- F3 AREA TO BE PROTECTED AS ORDINARY HAZARD GROUP 2 OCCUPANCY IN ACCORDANCE WITH NFPA 13.
- F4 MODIFY EXISTING FIRE SPRINKLER PIPING AND SPRINKLER HEAD LOCATIONS FOR NEW WALL LAYOUT.
- F5 DUE TO THE LIMITED SPACE AT CEILING LEVEL, THE CONTRACTOR AND HIS FIRE SPRINKLER SUB-CONTRACTOR ARE RESPONSIBLE TO CAREFULLY COORDINATE FIRE SPRINKLER PIPING AND HEAD LOCATION WITH CEILING MOUNTED STAGE RIGGING SYSTEM INSTALLATION. EQUIPMENT IS NOT INDICATED ON THIS SHEET. REFER TO APPROVED VENDOR FOR DETAILS.
- F6 STAGE OPENING, PROVIDE NFPA 13 APPROPRIATE FIRE SPRINKLER HEAD SPACING, STAGE RIGGING.
- F7 6" FIRE WATER SUPPLY DOWN. REFER TO CIVIL SITE PLAN FOR CONTINUATION.
- F8 4" FIRE WATER SUPPLY DOWN. CONTINUE PIPING BELOW GRADE TO REMOTE FIRE DEPARTMENT CONNECTION (FDC) LOCATION FDC WITHIN 100 FEET OF FIRE HYDRANT. REFER TO CIVIL SITE PLAN.
- F9 6" DOUBLE CHECK VALVE ASSEMBLY BACKFLOW PREVENTER.
- F10 WET VALVE ZONE RISERS, SIZE AND QUANTITY BY DESIGNER, PER FIRE CODE AND NFPA 13.
- F11 WET STANDPIPE.
- F12 FDC WATER SUPPLY.

KEY PLAN

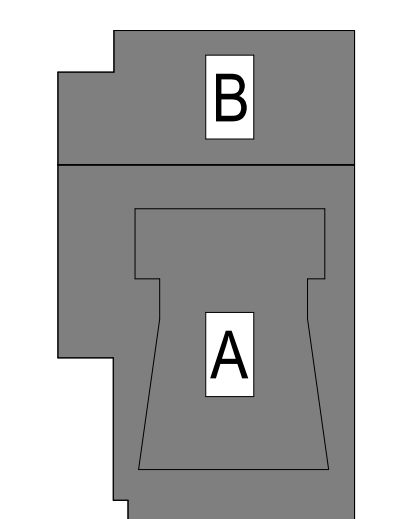

CRANDALL ISD HIGH SCHOOL
PAC ADDITION
13385 Fm 3039, Crandall, TX 75114

ISSUE FOR BID AND PERMIT
2024.07.25
REVISIONS
01 08/19/2024 ADDENDUM 01

39-23712-00

LEVEL 01 - FIRE PROTECTION PLAN

FP1.1

Autodesk Docs/192-23712-00 Crandall ISD - PAC/39-23712-00 Crandall ISD_MP_2024.rvt
8/19/2024 5:10:11 PM

GENERAL PLUMBING NOTES

- GENERAL PLUMBING NOTES
- THESE NOTES SHALL BE GENERALLY APPLIED TO ALL PLUMBING DRAWINGS, AS THEY ARE GENERAL IN NATURE. THEY MAY NOT BE SPECIFICALLY CALLED OUT ON THE PLANS. REFERENCE THE INDIVIDUAL DRAWINGS AS WELL AS SPECIFICATIONS FOR ADDITIONAL CONTRACTUAL REQUIREMENTS.
- SHOULD ANY CONFLICT OCCUR BETWEEN ANY PORTIONS OF THE CONTRACT DOCUMENTS (DRAWINGS AND SPECIFICATIONS) THE CONTRACTOR IS DEEMED TO HAVE ELECTED THEIR BID PRICE ON THE MORE EXPENSIVE MATERIAL, EQUIPMENT, PRODUCT OR WORK, UNLESS THEY HAVE REQUESTED AND OBTAINED A WRITTEN CLARIFICATION OR DECISION IN REGARD TO THE CONFLICT FROM THE ARCHITECT/ENGINEER.
- DRAWINGS AND MEASUREMENTS
 - THE DRAWINGS ARE DIAGRAMMATIC AND INDICATE THE GENERAL SCOPE OF THE WORK. I.E., ARRANGEMENT OF SYSTEMS AND EQUIPMENT, EXCEPT WHEN THEY HAVE BEEN SPECIFICALLY DIMENSIONED OR DETAILED.
 - PLUMBING PLANS ARE INTENDED TO SHOW SIZE, CAPACITY, APPROXIMATE LOCATION, DIRECTION, AND GENERAL RELATIONSHIP OF ONE WORK TRADE TO ANOTHER.
 - COORDINATION: THE PLUMBING DESIGN SHALL BE COORDINATED WITH ALL OTHER ASPECTS OF THE BUILDING. TO THAT END, THE PLUMBING CONTRACTOR IS RESPONSIBLE FOR REVIEWING THE ARCHITECTURAL, STRUCTURAL, MECHANICAL, ELECTRICAL AND CIVIL DRAWINGS WHERE AVAILABLE, AS WELL AS PHYSICALLY OBSERVING FIELD CONDITIONS BEFORE PERFORMING ANY WORK. ERRORS WILL NOT BE FOUND TO MOVE PIPING DUE TO CONFLICTS ARISING FROM LACK OF COORDINATION.
 - REFER TO THE ARCHITECTURAL DRAWINGS FOR BUILDING ELEVATIONS, CEILING DETAILS, PARTITIONS, AND OCCUPANCIES.
 - REFER TO STRUCTURAL DRAWINGS TO COORDINATE PIPING LAYOUT WITH STRUCTURAL ELEMENTS OF THE BUILDING.
 - REFER TO THE FIRE PROTECTION DRAWINGS AND MECHANICAL DRAWINGS TO ASSESS THE CONGESTION ABOVE CEILING. THE PLUMBING CONTRACTOR SHALL BE CONSCIOUS OF ANY HORIZONTAL MECHANICAL EQUIPMENT LOCATIONS AS WELL AS THEIR CLEARANCE REQUIREMENTS IN ADDITION TO ANY DUCTWORK OR HYDRONIC PIPING.
 - CONTRACT DRAWINGS SHALL ONLY SERVE TO SHOW THE GENERAL ARRANGEMENT OF EQUIPMENT AND STRUCTURE. SUCH DRAWINGS SHALL NOT BE CONSIDERED A SUBSTITUTE FOR FIELD VERIFICATION OF CONDITIONS. COORDINATION SHALL OCCUR PRIOR TO FABRICATION, PURCHASE, AND/OR INSTALLATION OF ALL WORK. DESIGN, COORDINATE AND COOPERATE WITH OTHER TRADES AND COORDINATE THE WORK WITH THEIRS. COORDINATE CEILING CAVITY SPACE CAREFULLY WITH OTHER TRADES. BRING ANY CONFLICTS TO THE ATTENTION OF THE ARCHITECT/ENGINEER.
 - AS THE DRAWINGS ARE OF SMALL SCALE, IT IS NOT POSSIBLE TO SHOW ALL NECESSARY OFFSETS, FITTINGS, AND ACCESSORIES. OBTAIN EXACT LOCATIONS, FIELD MEASUREMENTS, ETC. AT THE SITE PRIOR TO THE FABRICATION OF ANY MATERIAL OR ORDERING OF EQUIPMENT.
 - THE DESIGN DRAWINGS AND SPECIFICATIONS ARE BASED ON THE CHARACTERISTICS OF THE EQUIPMENT (SCHEDULE) SPECIFIED. ALL CHANGES REQUIRED BY THE USE OF OTHER MANUFACTURERS (INCLUDING MANUFACTURERS THAT ARE LISTED IN THE SPECIFICATIONS) SHALL BE MADE BY THE CONTRACTOR AT NO ADDITIONAL COST TO THE OWNER.
 - THESE CHANGES SHALL INCLUDE, BUT NOT BE LIMITED TO REVISIONS TO FOUNDATIONS, ELECTRICAL CHANGES, SPACE REQUIRED FOR PLACEMENT OF EQUIPMENT, EQUIPMENT BASES, PIPING, CONTROLS, WIRING, WALL OR BUILDING OPENINGS, SERVICE ACCESS REQUIREMENTS, PIPING AND STRUCTURAL MODIFICATIONS.
- REFER TO THE CODE PLANS FOR FIRE AND/OR SMOKE CONSTRUCTION RATINGS. MAINTAIN INDICATED FIRE AND/OR SMOKE RATINGS OF WALLS, PARTITIONS, CEILING, AND FLOORS AT PIPE PENETRATIONS. SEAL PIPE PENETRATIONS WITH FIRESTOP MATERIALS. REFER TO DIVISION 07 SECTIONS PENETRATION FIRESTOPPING AND JOINT FIRESTOPPING FOR THROUGH-PENETRATION FIRESTOP ASSEMBLY PRODUCT SPECIFICATIONS. INSTALLATION OF FIRESTOP MATERIALS IS SPECIFIED AS WORK OF DIVISION 22.
- WORK SHALL BE FURNISHED AND INSTALLED IN ACCORDANCE WITH THE 2018 INTERNATIONAL PLUMBING CODE, LOCAL AMENDMENTS, LAWS AND GOVERNING BODIES. WHERE THE PLANS AND/OR SPECIFICATIONS EXCEED THE GOVERNING CODE REQUIREMENTS, THE PLANS AND SPECIFICATIONS WILL GOVERN.
- EXTERIOR EXPOSED GAS PIPING SHALL BE PAINTED IN ACCORDANCE WITH DIVISION 09, PAINT TYPE AND COLOR SHALL BE AS SPECIFIED IN DIVISION 09.
- PROVIDE COORDINATION DRAWINGS WHERE REQUIRED BY THE SPECIFICATIONS. RFIs RELATED TO COORDINATION ITEMS WILL NOT BE REVIEWED UNLESS COORDINATION DRAWINGS HAVE BEEN SUBMITTED.
- REFER TO THE PLUMBING FIXTURE SCHEDULE FOR NON-ACCESSIBLE PLUMBING FIXTURE MOUNTING HEIGHTS. COORDINATE WITH THE ARCHITECTURAL PLANS FOR THE MOUNTING HEIGHT OF ACCESSIBLE PLUMBING FIXTURES.
- COORDINATE ALL UNDERGROUND PIPING (SANITARY, WASTE, VENT & STORM DRAINAGE) WITH STRUCTURAL FOUNDATIONS, SITE UTILITIES SERVICES, AND BUILDING SERVICES PIPING. OFFSET UNDERGROUND PIPING TO AVOID FOUNDATION PENETRATIONS. WHERE IT IS IMPOSSIBLE TO AVOID FOUNDATIONS, SLEEVE PIPE PENETRATIONS AS INDICATED IN STRUCTURAL DRAWINGS AND SPECIFICATIONS WHEN APPLICABLE. CONTACT THE ENGINEER WHEN NO SLEEVE INFORMATION IS PROVIDED OR CONDITIONS DIFFER FROM STRUCTURAL DRAWINGS.
- ALL MATERIALS EXPOSED WITHIN AN AIR PLENUM SHALL BE NONCOMBUSTIBLE OR HAVE A FLAME SPREAD INDEX OF NOT MORE THAN 25 AND A SMOKE DEVELOPMENT INDEX OF NOT MORE THAN 50.
- WHERE LOCATIONS OF ANY EXISTING UTILITY SERVICES ARE SHOWN, THEY SHALL BE CONSIDERED AS "APPROXIMATE" EXACT LOCATIONS OF ANY EXISTING UTILITY SERVICES SHALL BE CONFIRMED BY THE CONTRACTOR PRIOR TO BEGINNING ANY CONSTRUCTION OR EXCAVATION. COORDINATE UTILITY SERVICE CONNECTION POINTS WITH EXTERIOR UNDERGROUND AND OVERHEAD UTILITIES AND SERVICES. COMPLY WITH REQUIREMENTS OF GOVERNING REGULATIONS, FRANCHISED SERVICE COMPANIES, AND CONTROLLING AGENCIES. THE CONTRACTOR IS RESPONSIBLE FOR AND SHALL BEAR ALL COSTS ASSOCIATED WITH DAMAGE TO ANY EXISTING UTILITIES DURING CONSTRUCTION.
- EQUIPMENT LOCATION AND ACCESS
 - LOCATE EQUIPMENT WHICH MUST BE SERVICED, OPERATED, OR MAINTAINED IN ACCESSIBLE LOCATIONS. EQUIPMENT SHALL INCLUDE BUT NOT BE LIMITED TO WATER HEATERS, WATER CONDITIONING EQUIPMENT, VALVES, TRAPS, CLEANOUTS, MOTORS, CONTROLLERS, AND LOW POINT DRAIN LOCATIONS. MINOR DEVIATIONS FROM THE CONTRACT DRAWINGS MAY BE ALLOWED TO PROVIDE BETTER ACCESSIBILITY UNDER THE CONDITION THE CHANGES ARE REVIEWED & APPROVED BY THE ARCHITECT/ENGINEER PRIOR TO MAKING THE CHANGE.
 - INACCESSIBLE INSTALLATION: WHERE THE ENGINEER DETERMINES THAT THE CONTRACTOR HAS INSTALLED EQUIPMENT SUCH THAT IT IS NOT CONVENIENTLY ACCESSIBLE FOR OPERATION AND/OR MAINTENANCE, THE EQUIPMENT WILL BE REMOVED AND REINSTALLED OR REMEDIAL ACTION SHALL BE PERFORMED AS SO AS TO MAKE THE INSTALLATION CONVENIENTLY ACCESSIBLE AT NO ADDITIONAL COST TO THE OWNER. THE TERM "CONVENIENTLY ACCESSIBLE" IS DEFINED AS CAPABLE OF BEING REACHED WITHOUT THE USE OF LADDERS, OR WITHOUT CLIMBING OR CRAWLING UNDER OR OVER OBSTACLES SUCH AS ELECTRICAL CONDUIT, MOTORS, FANS, PUMPS, BELT GUARDS, TRANSFORMERS, HIGH VOLTAGE LINES, PIPING, AND DUCTWORK.
 - EXCEPTION: ACCESSING VALVES FROM A LADDER IS ACCEPTABLE WHEN INSTALLED AS OUTLINED IN OTHER PARAGRAPHS OF THESE NOTES. ACCESSING POINT OR USE WATER HEATER(S) THAT ARE LOCATED ABOVE A CEILING WHERE INDICATED AND DETAILED ON THE DRAWINGS.
- PIPE RUNS SHALL BE INSTALLED TO AVOID INTERFERENCE WITH OTHER WORK/TRADES. INSTALL PIPING AT RIGHT ANGLES TO OR PARALLEL WITH BUILDING WALLS OR COLUMN CENTER LINES. DIAGONAL PIPING RUNS ARE PROHIBITED UNLESS SPECIFICALLY INDICATED OTHERWISE. LOCATE GROUPS OF PIPES PARALLEL TO EACH OTHER. SPACE PIPING INCLUDING ANY INSULATION TO PROVIDE A 1-INCH MINIMUM CLEARANCE BETWEEN ADJACENT PIPING OR OTHER SURFACES. SPACE PIPING TO PERMIT VALVE SERVICING OR REPLACEMENT.
- IN AREAS WHERE PIPING IS INSTALLED ABOVE A CEILING AND THERE IS CONGESTED CEILING SPACE, INSTALL THE PIPING AS HIGH AS POSSIBLE WHILE GIVING CONSIDERATION OF OTHER TRADES AND THE SERVICABILITY OF THE SYSTEMS. WHERE VALVES ARE SHOWN, THEY SHALL BE INSTALLED NO MORE THAN 18-INCHES ABOVE THE CEILING. IF IT IS NECESSARY TO INSTALL OFFSETS IN THE PIPING SO THE VALVES ARE INSTALLED NO MORE THAN 18-INCHES ABOVE THE CEILING, INSTALL A DRAIN VALVE WITH HOSE END CONNECTION FOR EACH SYSTEM ADJACENT TO THE ISOLATION VALVE(S). IF THERE IS AN OFFSET UP ON THE OUTLET SIDE OF THE ISOLATION VALVE(S), THEN PROVIDE A SECOND DRAIN VALVE AT THAT LOCATION.
- IN AREAS WHERE PIPING IS EXPOSED, INSTALL THE PIPING AS HIGH AS POSSIBLE IF PRACTICABLE. INSTALL PIPING TIGHT TO STRUCTURE (AND/OR STACKS) ALONG AND TIGHT TO WALLS. IF VALVES ARE SHOWN IN THE EXPOSED PIPING, INSTALL AN OFFSET(S) IN THE PIPING SO THE VALVES ARE INSTALLED NO MORE THAN 10'-00" AFF. INSTALL A DRAIN VALVE WITH HOSE END CONNECTION FOR EACH SYSTEM ADJACENT TO THE ISOLATION VALVE(S). IF THERE IS AN OFFSET UP ON THE OUTLET SIDE OF THE ISOLATION VALVE(S), THEN PROVIDE A SECOND DRAIN VALVE AT THAT LOCATION.
- PLUMBING EQUIPMENT, PIPING, OR ACCESSORIES SHOULD NOT BE LOCATED WITHIN ELECTRICAL EQUIPMENT ROOMS UNLESS INDICATED ON THE DRAWINGS. WHERE PIPING AND EQUIPMENT ARE INDICATED TO BE INSTALLED WITHIN ELECTRICAL EQUIPMENT ROOMS, MAINTAIN THE ELECTRICAL CODE REQUIRED WORKING AND DEDICATED SPACES.
- PLUMBING EQUIPMENT, PIPING, OR ACCESSORIES NOT USED IN CONNECTION WITH THE OPERATION OF THE ELEVATOR SHALL NOT BE INSTALLED IN ANY HOSTWAY, MACHINERY SPACE, MACHINE ROOM, CONTROL SPACE OR CONTROL ROOM.
- PLUMBING EQUIPMENT, PIPING, OR ACCESSORIES SHALL NOT PASS THRU OR OVER ANY SERVER (COMM / IT) ROOMS.
- RUN OV, HW AND HWC LINES FULL SIZE THE ENTIRE LENGTH OF THE PLUMBING CHASE. BRANCH OFF TO INDIVIDUAL PLUMBING FIXTURES WITH PIPE SIZES AS SHOWN ON THE PLUMBING FIXTURE CONNECTION SCHEDULE. REFER TO PLUMBING RISER / ISOMETRIC DIAGRAMS FOR PIPE SIZES NOT SHOWN ON THE PLANS OR PLUMBING FIXTURE CONNECTION SCHEDULE.
- INSTALL HANGERS FOR METALLIC PIPE AND TUBING NOT TO EXCEED THE MAXIMUM HORIZONTAL AND VERTICAL SPACING AND MINIMUM HANGER ROD DIAMETERS TO COMPLY WITH THE INTERNATIONAL PLUMBING CODE (IPC), MSS SP-58 STANDARD PRACTICE FOR PIPE HANGERS AND SUPPORTS, LOCALLY ENFORCED CODES AND AHJ REQUIREMENTS, WHICHEVER ARE MOST STRINGENT. WHERE CONFLICTS ARISE BETWEEN THE PLUMBING CODE REQUIREMENTS, MSS SP-58 AND THE PROJECT SPECIFICATIONS, THE MOST RESTRICTIVE OR THE REQUIREMENT THAT SPECIFIES SUPPORTS WITH HIGHEST LOAD RATING OR SHORTEST HANGER SPACING SHALL APPLY. WHERE HANGER SPACING DOES NOT CORRESPOND WITH JOIST OR RIB SPACING, USE STRUCTURAL STEEL CHANNELS SECURED DIRECTLY TO JOIST AND RIB STRUCTURE TO MEET THE REQUIRED HANGER SPACING. THEN, SUSPEND THE EQUIPMENT AND PIPING FROM THE CHANNELS. HOLES WILL NOT BE DRILLED OR BURNED IN STRUCTURAL STEEL WITHOUT PRIOR WRITTEN APPROVAL OF THE STRUCTURAL ENGINEER OF RECORD.
- PROVIDE ADDITIONAL SUPPORTS AT VALVES, STRAINERS, INLINE PUMPS AND OTHER HEAVY COMPONENTS. PROVIDE SUPPORT WITHIN ONE FOOT OF EACH PIPE ELBOW.
- INSTALL HANGERS FOR PLASTIC, FRP OR GLASS PIPING WITH THE MAXIMUM HORIZONTAL SPACING AND MINIMUM ROD DIAMETERS, TO COMPLY WITH THE MANUFACTURER'S WRITTEN INSTRUCTIONS, LOCALLY ENFORCED CODES, AND AUTHORITIES HAVING JURISDICTION REQUIREMENTS, WHICHEVER ARE MOST STRINGENT.
- SUPPORT VERTICAL RUNS OF PLASTIC, FRP OR GLASS PIPING TO COMPLY WITH THE MANUFACTURER'S WRITTEN INSTRUCTIONS, LOCALLY ENFORCED CODES, AND AUTHORITIES HAVING JURISDICTION REQUIREMENTS, WHICHEVER ARE MOST STRINGENT.
- THE USE OF CHAINS, WIRE, CABLE OR STRAP HANGERS ARE NOT ALLOWED FOR PIPE SUPPORTS.
- REFER TO GENERAL SEISMIC NOTES FOR ADDITIONAL REQUIREMENTS FOR PROJECTS SUBJECTED TO SEISMIC DESIGN REQUIREMENTS.


- PROVIDE SHUT OFF VALVES FOR ALL BRANCH WATER PIPING WHERE THE BRANCH CONNECTS TO THE MAIN. LOCATE / ORIENT THE VALVES TO PERMIT PROPER OPERATION AND ACCESS FOR MAINTENANCE. GENERALLY, LOCATE VALVE STEMS IN OVERHEAD PIPING IN HORIZONTAL POSITION. PROVIDE A UNION ADJACENT TO ONE END OF ALL THREADED END VALVES. AS A RULE, THE VALVES SHALL BE INSTALLED NO MORE THAN 18-INCHES ABOVE AN ACCESSIBLE CEILING. IF THE CEILING IS NOT ACCESSIBLE, PROVIDE A MINIMUM 18" X 18" SIZE LOCKABLE ACCESS PANEL TO ACCESS TO SERVICE AND/OR REPLACE THE VALVES.
 - ANY BRANCH PIPING FROM MAIN SERVING MORE THAN ONE PLUMBING FIXTURE SHALL HAVE SHUT-OFF VALVES.
- SANITARY DRAINAGE PIPING SHALL SLOPE IN ACCORDANCE WITH THE TABLE BELOW FROM THE 2018 INTERNATIONAL PLUMBING CODE.

| PIPE SIZE (IN) | IPC 2018 MINIMUM SLOPE (INCH PER FOOT) |
|----------------|--|
| <= 2.5 | 1/4 |
| 3 TO 6 | 1/8 |
| > 8 | 1/16 |
- GREASE WASTE DRAINAGE PIPING UPSTREAM OF A GREASE INTERCEPTOR SHALL SLOPE AT NOT LESS THAN 1/4 INCH PER FOOT.
- CONDENSATE SHALL NOT DISCHARGE INTO A STREET, ALLEY OR ONTO GRADE. CONDENSATE DRAINS FROM ALL COOLING COILS AND EVAPORATORS SHALL BE CONVEYED FROM THE DRAIN PAN OUTLET TO A DRYWELL AS SHOWN ON THE PLANS.
- EACH PLUMBING VENT SHALL TERMINATE NOT LESS THAN 10 FEET FROM, OR NOT LESS THAN 3- FEET ABOVE, AN OPENABLE WINDOW, DOOR, OPENING, AIR INTAKE, OR VENT SHAFT, OR NOT LESS THAN 3- FEET IN EVERY DIRECTION FROM A LOT LINE, ALLEY AND STREET EXCEPTED, WHEN INSTALLED ABOVE THE ROOF, THE PLUMBING VENTS SHALL BE LOCATED 18-INCHES ABOVE THE ROOF LEVEL. FOR HOSPITAL APPLICATIONS, PLUMBING VENT PIPING SHALL TERMINATE NOT LESS THAN TWENTY-FIVE (25) FEET FROM ANY AIR INTAKE OR VENT SHAFT.
- CLEANOUTS SHALL NOT BE LOCATED ABOVE CEILING FOR WASTE SYSTEMS. IN AREAS REQUIRING WASTE DRAIN PIPING UNDER SUPPORTED STRUCTURAL FLOOR SLABS, THE CLEANOUTS SHALL BE ACCESSIBLE AT LEAST 6-INCHES ABOVE THE FLOOD LEVEL OF THE HIGHEST FIXTURE SERVED. CLEANOUT RISER(S) SHALL BE PROPERLY PLUGGED AND PAINTED TO MATCH THE ADJACENT SURFACE.
- PROVIDE A BARRIER TYPE FLOOR DRAIN TRAP SEAL PROTECTION DEVICE (AS DEFINED BY THE ASSE 1072 STANDARD) EQUAL TO 'SURESEAL' BRAND.
- WATER HAMMER ARRESTORS WILL BE INSTALLED IN WATER PIPING ACCORDING TO PD4WH 201. WATER HAMMER ARRESTORS SHALL BE INSTALLED WITH INLET ISOLATION VALVES TO ALLOW FOR MAINTENANCE.
- THE DETAILS SHOWN ON THE DETAIL SHEETS APPLY TO ALL PLUMBING PLAN SHEETS. THE DETAILS ARE TO BE FOLLOWED FOR THE INSTALLATION OF ALL COMPONENTS AND EQUIPMENT SHOWN.
 - PROVIDE VOIDFORM, PLUMBING VOID SYSTEM TO SUPPORT PLUMBING PIPE SUPPORT BELOW STRUCTURAL SLABS ON GRADE WHERE GEOTECHNICAL REPORT INDICATES AND RECOMMENDS EXPANSIVE SOIL MOVEMENT UNDER THE PROJECT BUILDING.
 - SYSTEM STRUCTURE
 - PROVIDES A DIMENSIONALLY STABLE UNDERGROUND VOID SPACE THAT IS INDEPENDENT FROM THE OVERHEAD STRUCTURAL SLAB. THE SUBTERRANEAN SYSTEM SHALL SUPPORT THE WEIGHT OF SUSPENDED LATERAL PIPES AND TYPICAL BACKFILL MATERIAL THROUGHOUT THE CONSTRUCTION PROCESS.
 - THE SYSTEM SHALL BE DESIGNED TO TEMPORARILY POSITION AND SUSPEND THE LATERAL PIPES AT THE SPECIFIED HEIGHT AND SLOPE UNTIL PIPES ARE PERMANENTLY ANCHORED TO THE OVERHEAD STRUCTURAL SLAB BY THE SECURING HANGER (CLEVIS) SYSTEM. THE OPEN UNDERGROUND SYSTEM WILL THEN REMAIN INDEPENDENT FROM THE SECURING HANGERS.
 - THE OPEN SPACE OF THE SYSTEM BENEATH THE STRUCTURAL SLAB IS DESIGNED TO RECEIVE THE INFILL OF VERTICAL EXPANSION FROM THE UNDERLYING SOILS. IF VERTICAL PRESSURE IS APPLIED TO THE EDGES OF THE SYSTEM IN CONTACT WITH THE SOIL, THE UPLIFTING SOIL PRESSURE WILL APPLY EXCLUSIVELY TO THE SYSTEM AND NOT THE PIPES. THEREFORE, THE SYSTEM SHALL BE DESIGNED TO MOVE SEPARATELY AND INDEPENDENTLY OF THE LATERAL PIPES.


SHEET INDEX

| | |
|--------|---|
| P0.1 | PLUMBING GENERAL NOTES & SYMBOLS |
| P0.2 | PLUMBING ABBREVIATIONS |
| PD2.1B | LEVEL 01 - AREA B - DEMOLITION PLAN |
| P2.1 | OVERALL UNDERGROUND PLUMBING PLAN |
| P2.1A | LEVEL 01 - AREA A - PLUMBING PLAN |
| P2.1B | LEVEL 01 - AREA B - PLUMBING PLAN |
| P2.2MA | LEVEL 02 MEZZANINE - AREA A - PLUMBING PLAN |
| P2.3 | OVERALL ROOF PLUMBING PLAN |
| P3.1 | ENLARGED PLUMBING PLANS |
| P4.1 | WASTE & VENT RISER DIAGRAMS |
| P4.2 | DOMESTIC RISER DIAGRAM |
| P4.3 | STORM RISER DIAGRAM |
| P5.1 | PLUMBING DETAILS |
| P6.1 | PLUMBING SCHEDULES |


GENERAL SYMBOLS

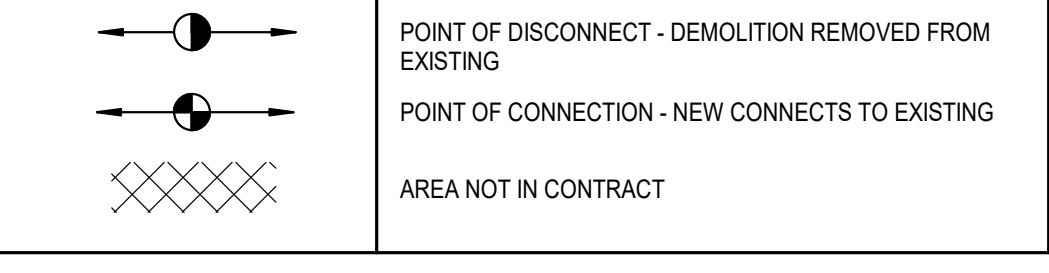


PIPING ANNOTATIONS

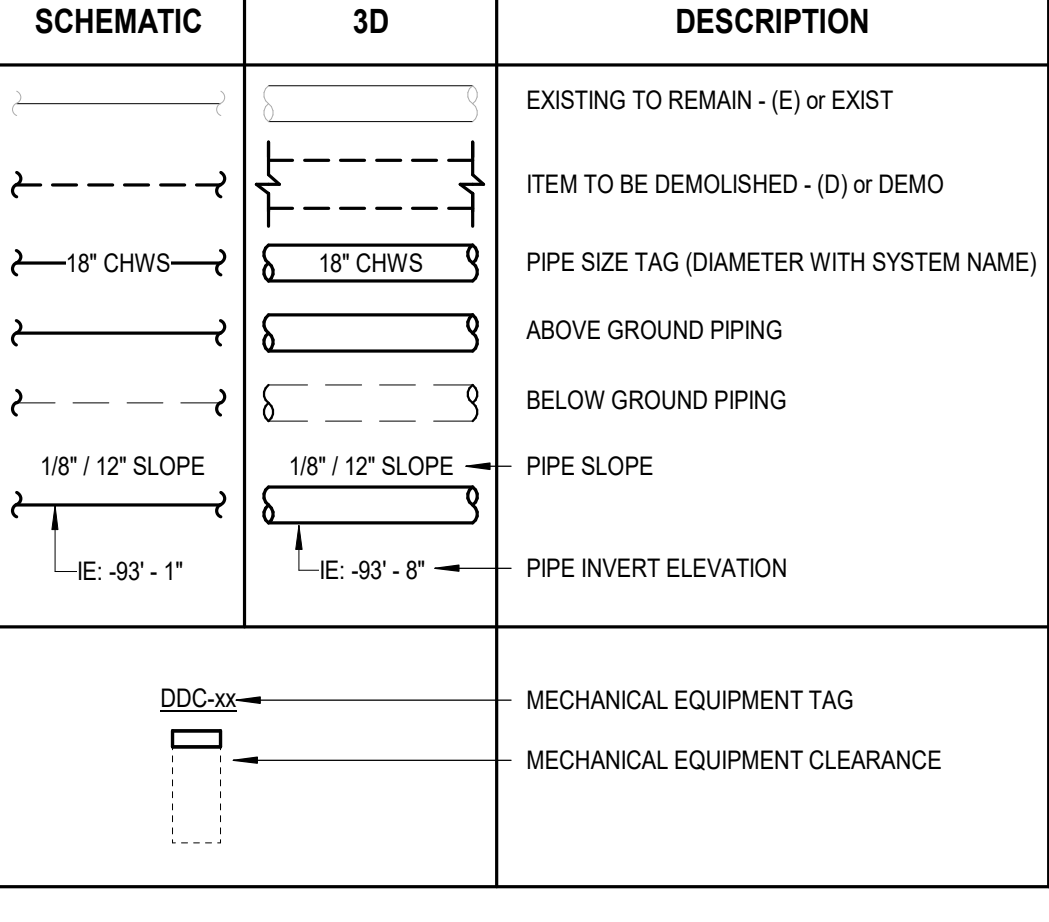


PLUMBING SYMBOLS

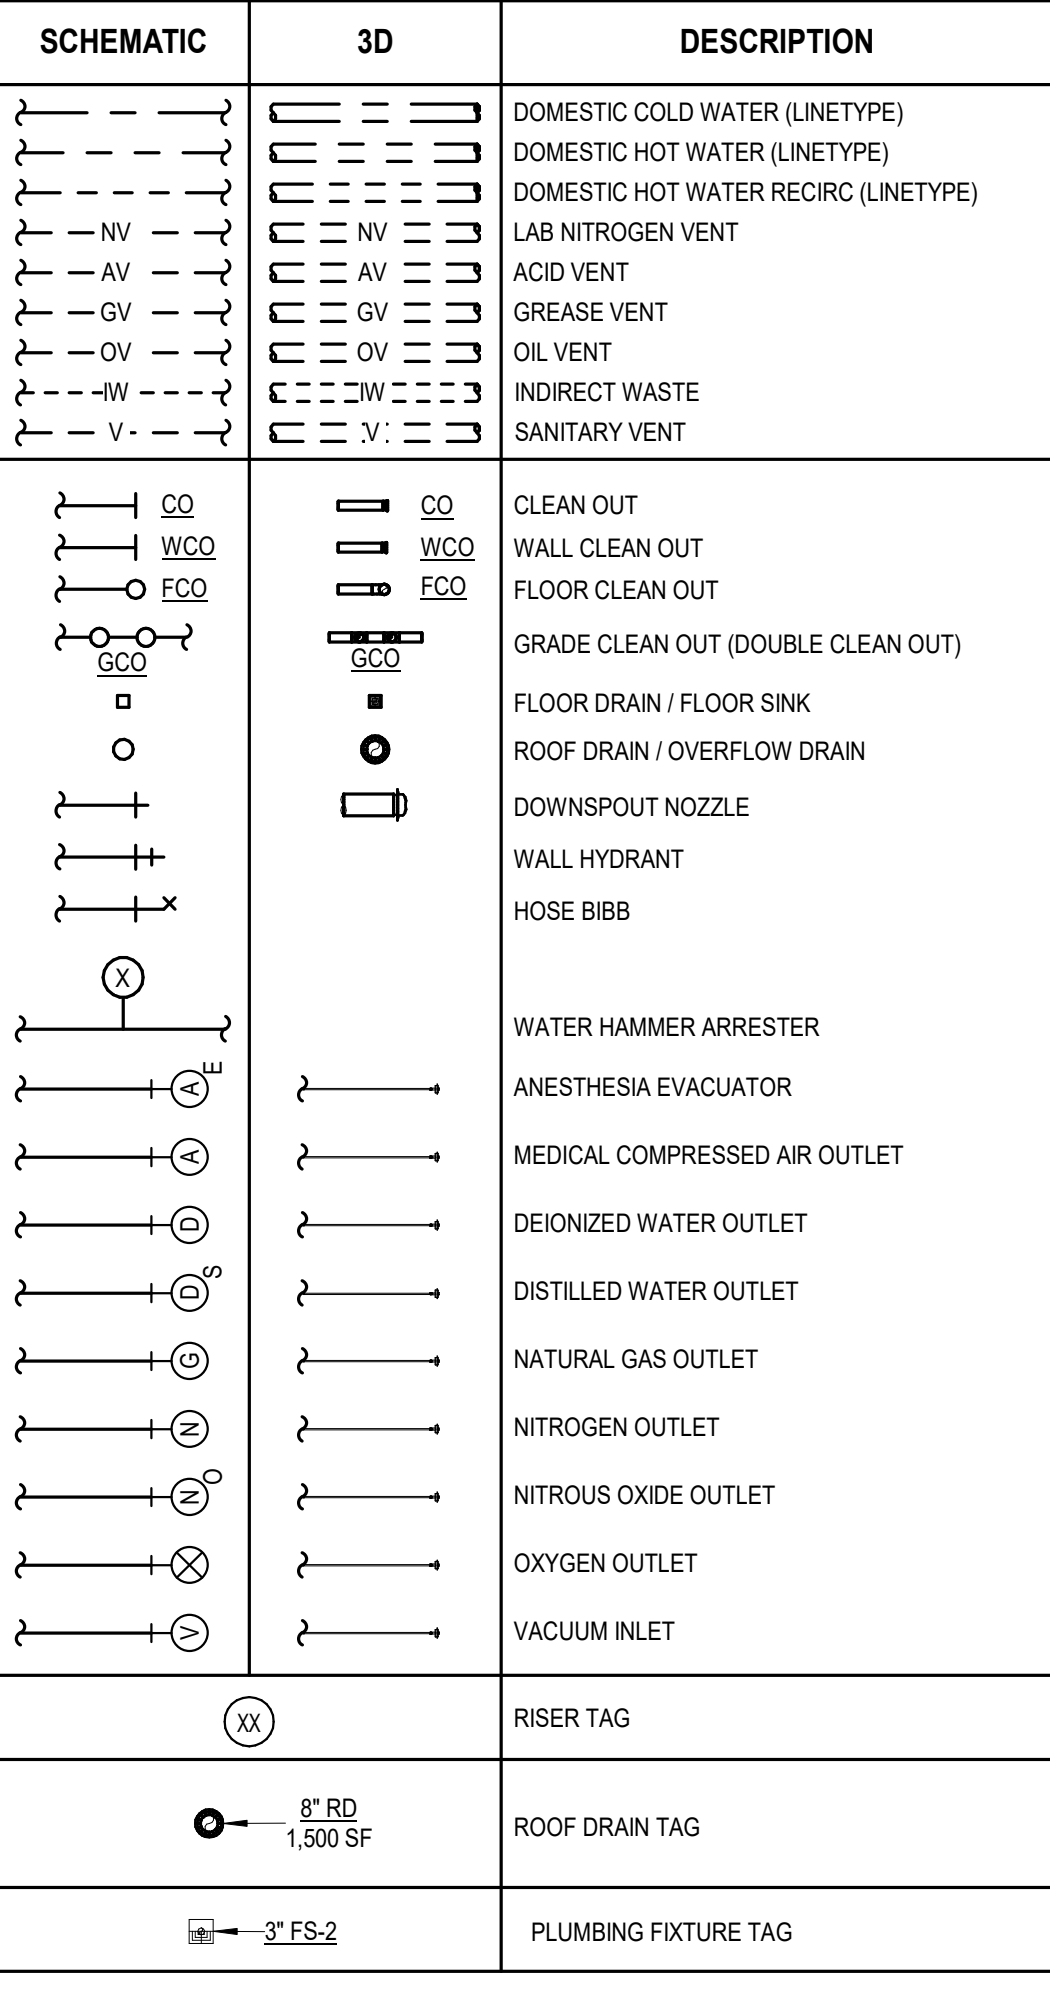

PIPING VALVES AND FITTINGS

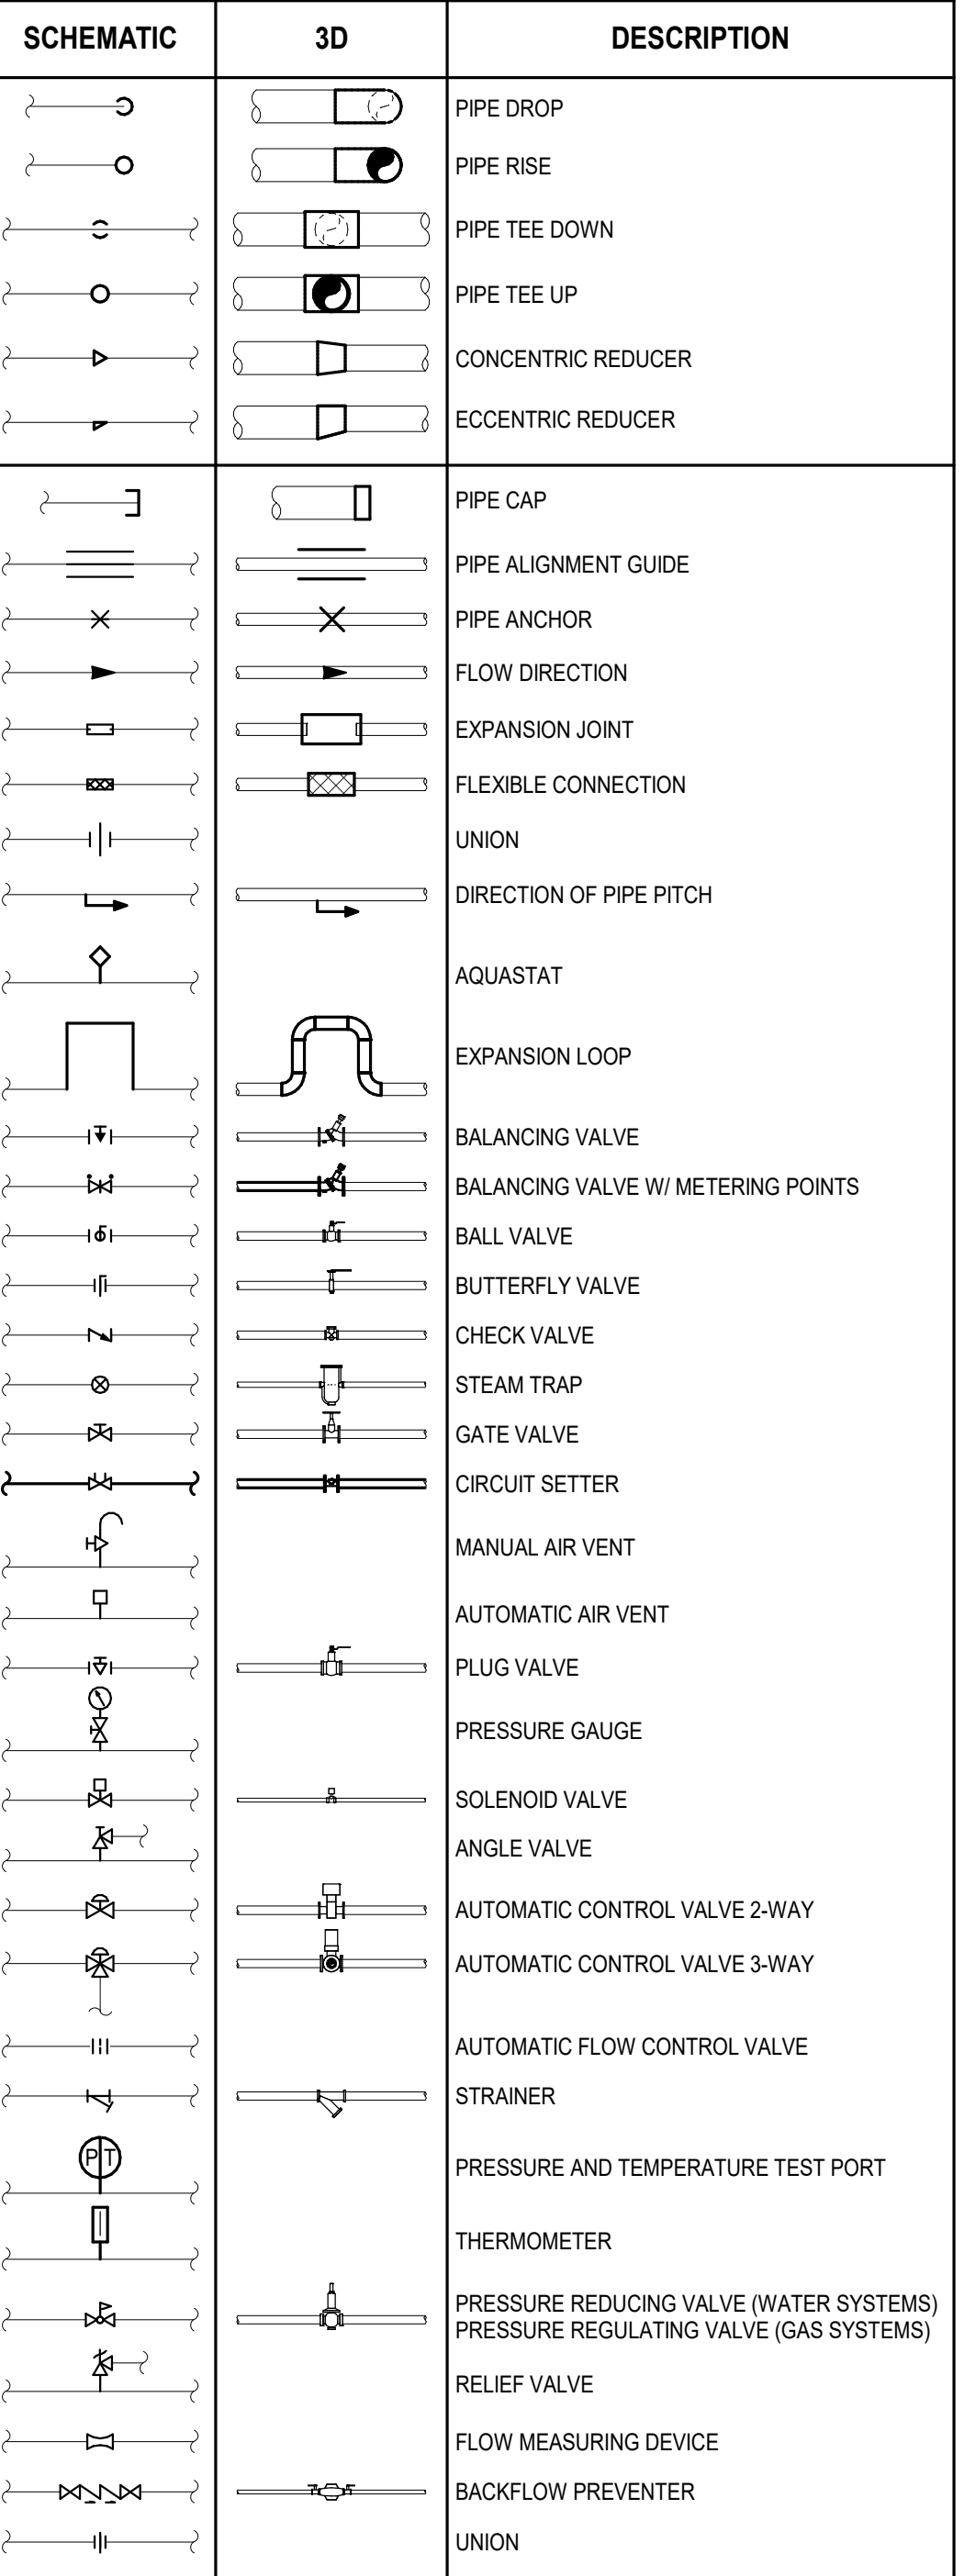

Autodesk Docs:039-23712-00 Crandall ISD - PAC Add-39-23712-00_Crandall ISD_MP_2024.rvt
8/19/2024 5:10:12 PM

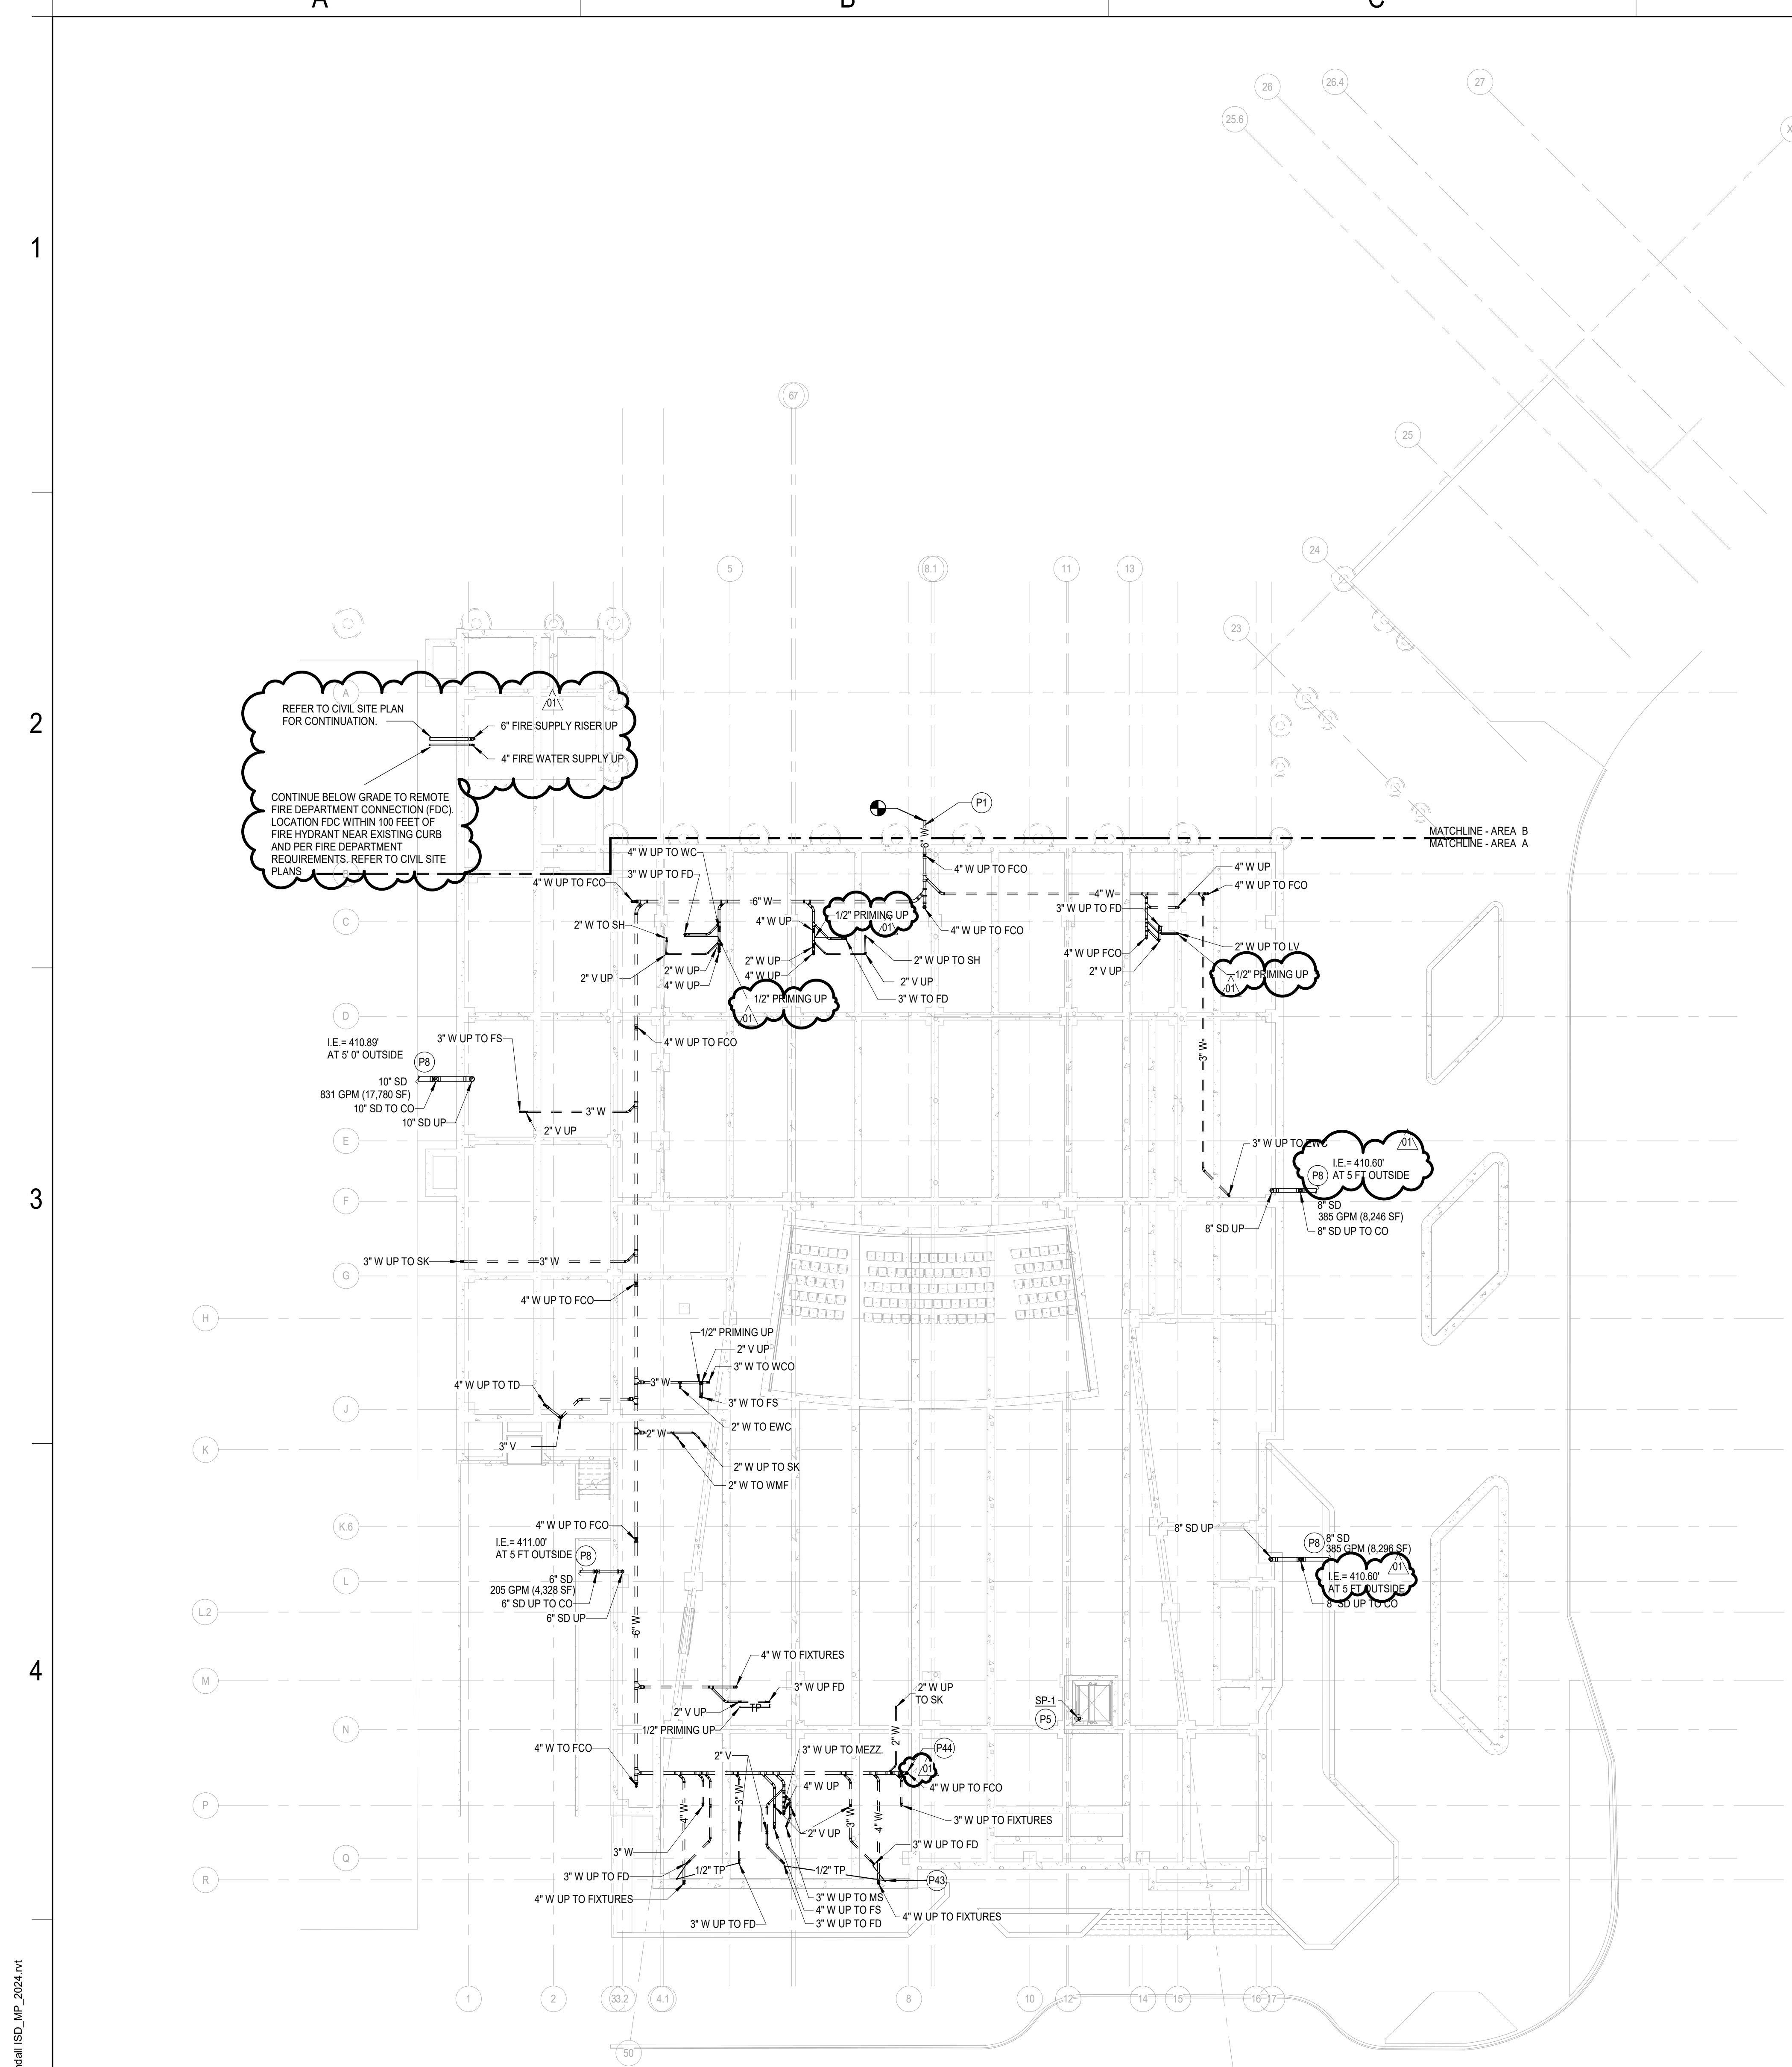

OVERALL UNDERGROUND PLUMBING PLAN
SCALE: 1/16" = 1'-0"



PLUMBING GENERAL NOTES

- A FOR SYMBOLS AND ABBREVIATIONS SEE DRAWINGS P0.1 & P.02.
- B BEFORE COMMENCEMENT OF WORK, THE CONTRACTOR SHALL VERIFY THE EXACT LOCATIONS, ELEVATIONS AND CHARACTERISTICS OF ALL UTILITIES AND PIPING BY PHYSICAL EXCAVATION AND SHALL IMMEDIATELY NOTIFY THE ARCHITECT OF ANY DISCREPANCIES.
- C THE CONTRACTOR SHALL FIELD VERIFY ALL EXISTING UTILITIES AND POINTS OF CONNECTION PRIOR TO BIDDING PROJECT.
- D ALL UNDERGROUND SANITARY AND STORM PIPING SHALL BE SUPPORTED BY AN APPROVED SUSPENSION SYSTEM DESIGNED FOR VERTICAL EXPANSION FOR THE UNDERLYING SOIL.

SHEET NOTES

- P1 CONNECT TO EXISTING 6" SANITARY LINE. INVERT AT 410.13'. BASED ON CIVIL FINISHED FLOOR ELEVATION OF 416.18' FIELD VERIFY.
- P5 PROVIDE SUMP PUMP FOR ELEVATOR SHAFT PIT AND DISCHARGE INTO FLOOR SINK.
- P6 SEE CIVIL SHEETS FOR CONTINUATION.
- P43 TWO (2) 1/2" PRIMING TURNING UP TO DEVICE.
- P44 START INVERT ELEVATION OF 6" SANITARY LINE. INVERT AT 413.27'. BASED ON CIVIL FINISHED FLOOR ELEVATION OF 416.18'. FIELD VERIFY ALL INVERT PRIOR TO PERFORM ANY WORK.

KEY PLAN

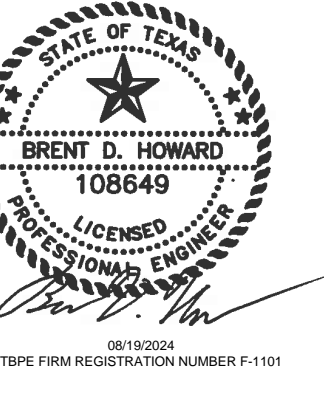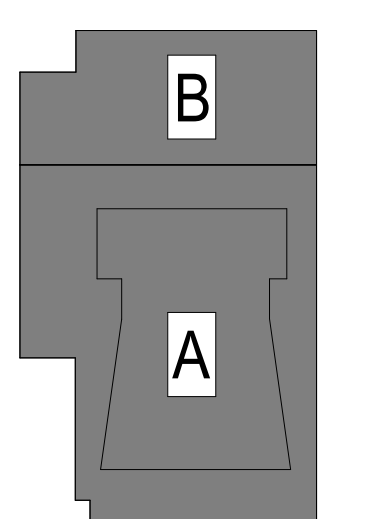

CRANDALL ISD HIGH SCHOOL
PAC ADDITION
13385 Fm 3038, Crandall, TX 75114

ISSUE FOR BID AND PERMIT
2024.07.25
REVISIONS
01 08/19/2024 ADDENDUM 01


39-23712-00
OVERALL UNDERGROUND PLUMBING PLAN

P2.1

Autodesk Docs/199-23712-00 Crandall ISD - PAC/39-23712-00 Crandall ISD_MP_2024.rvt
8/19/2024 5:10:14 PM

8/19/2024 5:10:24 PM Autodesk Docs://99-23712-00_Crandall ISD - PAC/99-23712-00_Crandall ISD - PAC/99-23712-00_Crandall ISD_MP_2024.rvt

MATCHLINE - AREA B
MATCHLINE - AREA A

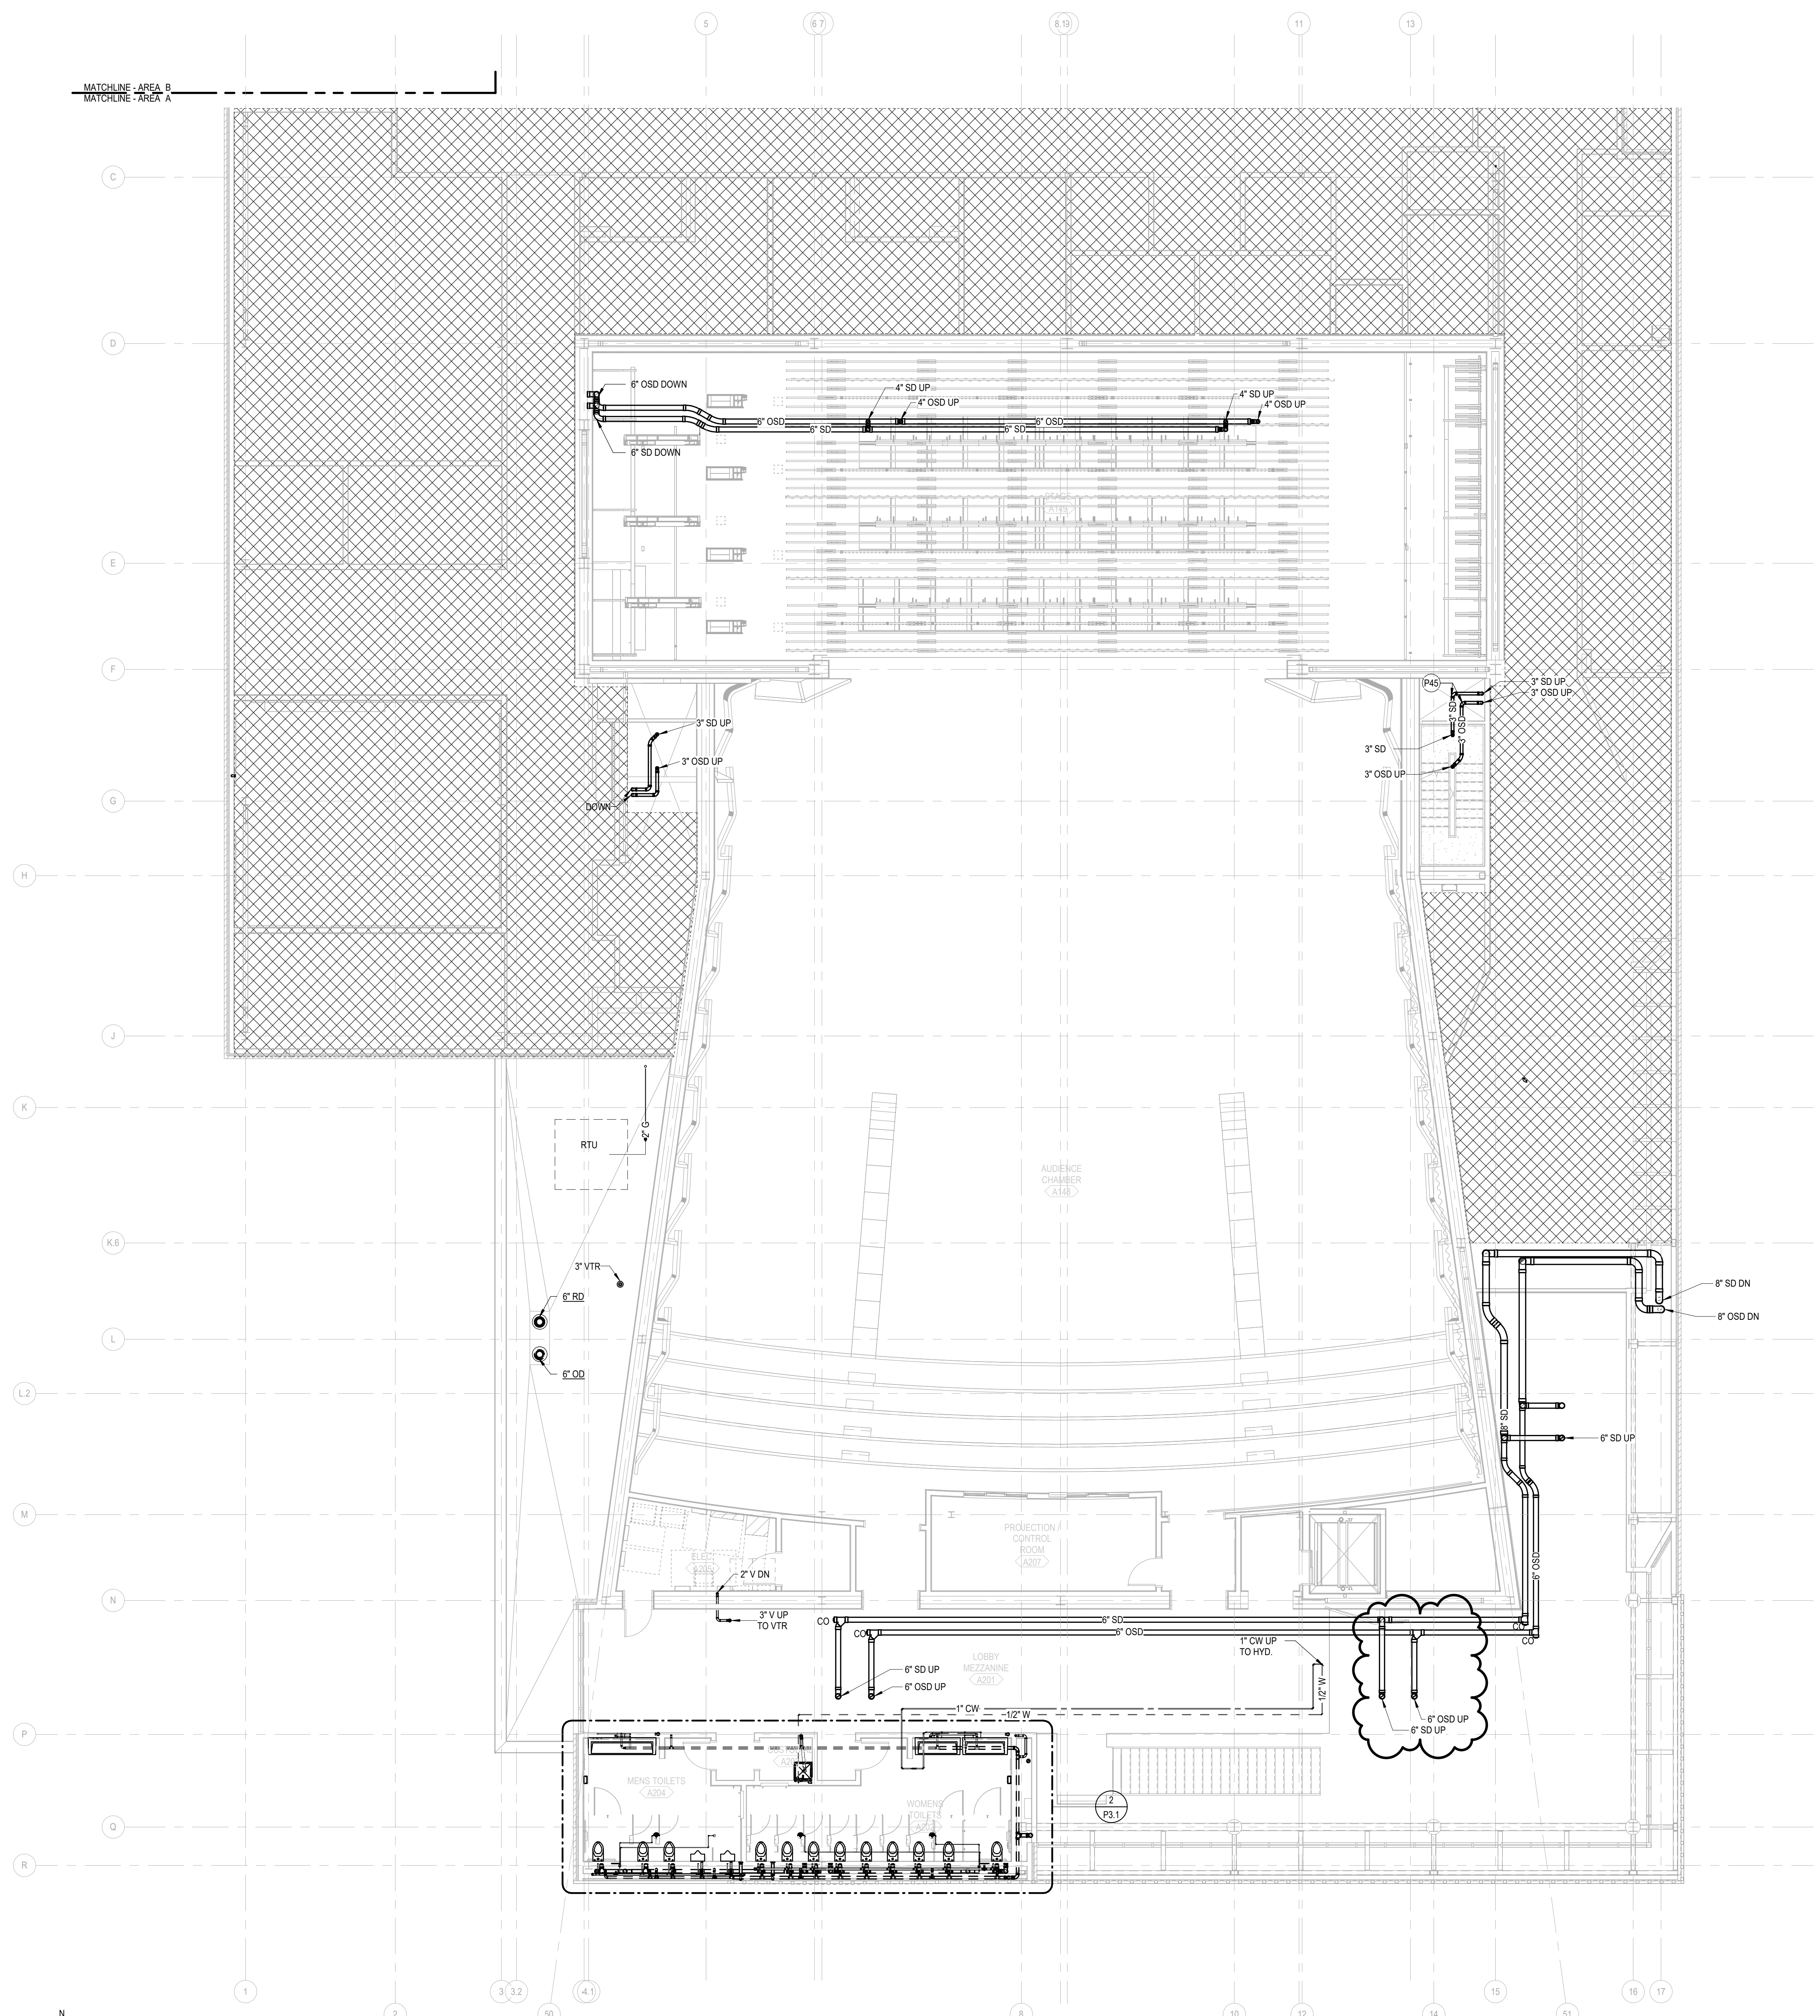

LEVEL 02 MEZZANINE - AREA A - PLUMBING PLAN
SCALE: 1/8" = 1'-0"



PLUMBING GENERAL NOTES

- A FOR SYMBOLS AND ABBREVIATIONS SEE DRAWINGS P0.1 & P.02.
- B BEFORE COMMENCEMENT OF WORK, THE CONTRACTOR SHALL VERIFY THE EXACT LOCATIONS, ELEVATIONS AND CHARACTERISTICS OF ALL UTILITIES AND PIPING BY PHYSICAL EXCAVATION AND SHALL IMMEDIATELY NOTIFY THE ARCHITECT OF ANY DISCREPANCIES.
- C THE CONTRACTOR SHALL FIELD VERIFY ALL EXISTING UTILITIES AND POINTS OF CONNECTION PRIOR TO BIDDING PROJECT.
- D ALL UNDERGROUND SANITARY AND STORM PIPING SHALL BE SUPPORTED BY AN APPROVED SUSPENSION SYSTEM DESIGNED FOR VERTICAL EXPANSION FOR THE UNDERLYING SOIL.

SHEET NOTES

P45 PROVIDE CAST IRON PIPING IN RETURN AIR PLENUM.


KEY PLAN

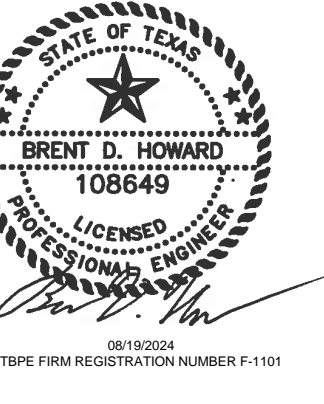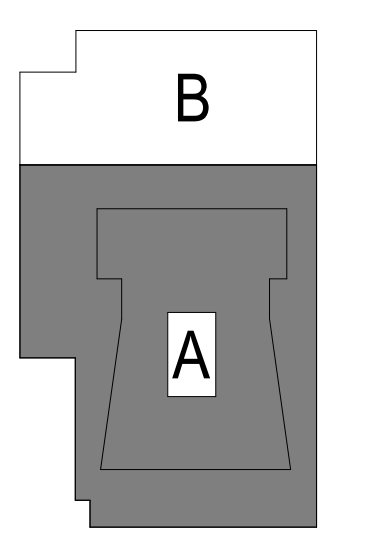

CRANDALL ISD HIGH SCHOOL
PAC ADDITION
13385 Fm 3038, Crandall, TX 75114

ISSUE FOR BID AND PERMIT
2024.07.25
REVISIONS
01 08/19/2024 ADDENDUM 01

39-23712-00
LEVEL 02
MEZZANINE -
AREA A -
PLUMBING PLAN
P2.2MA

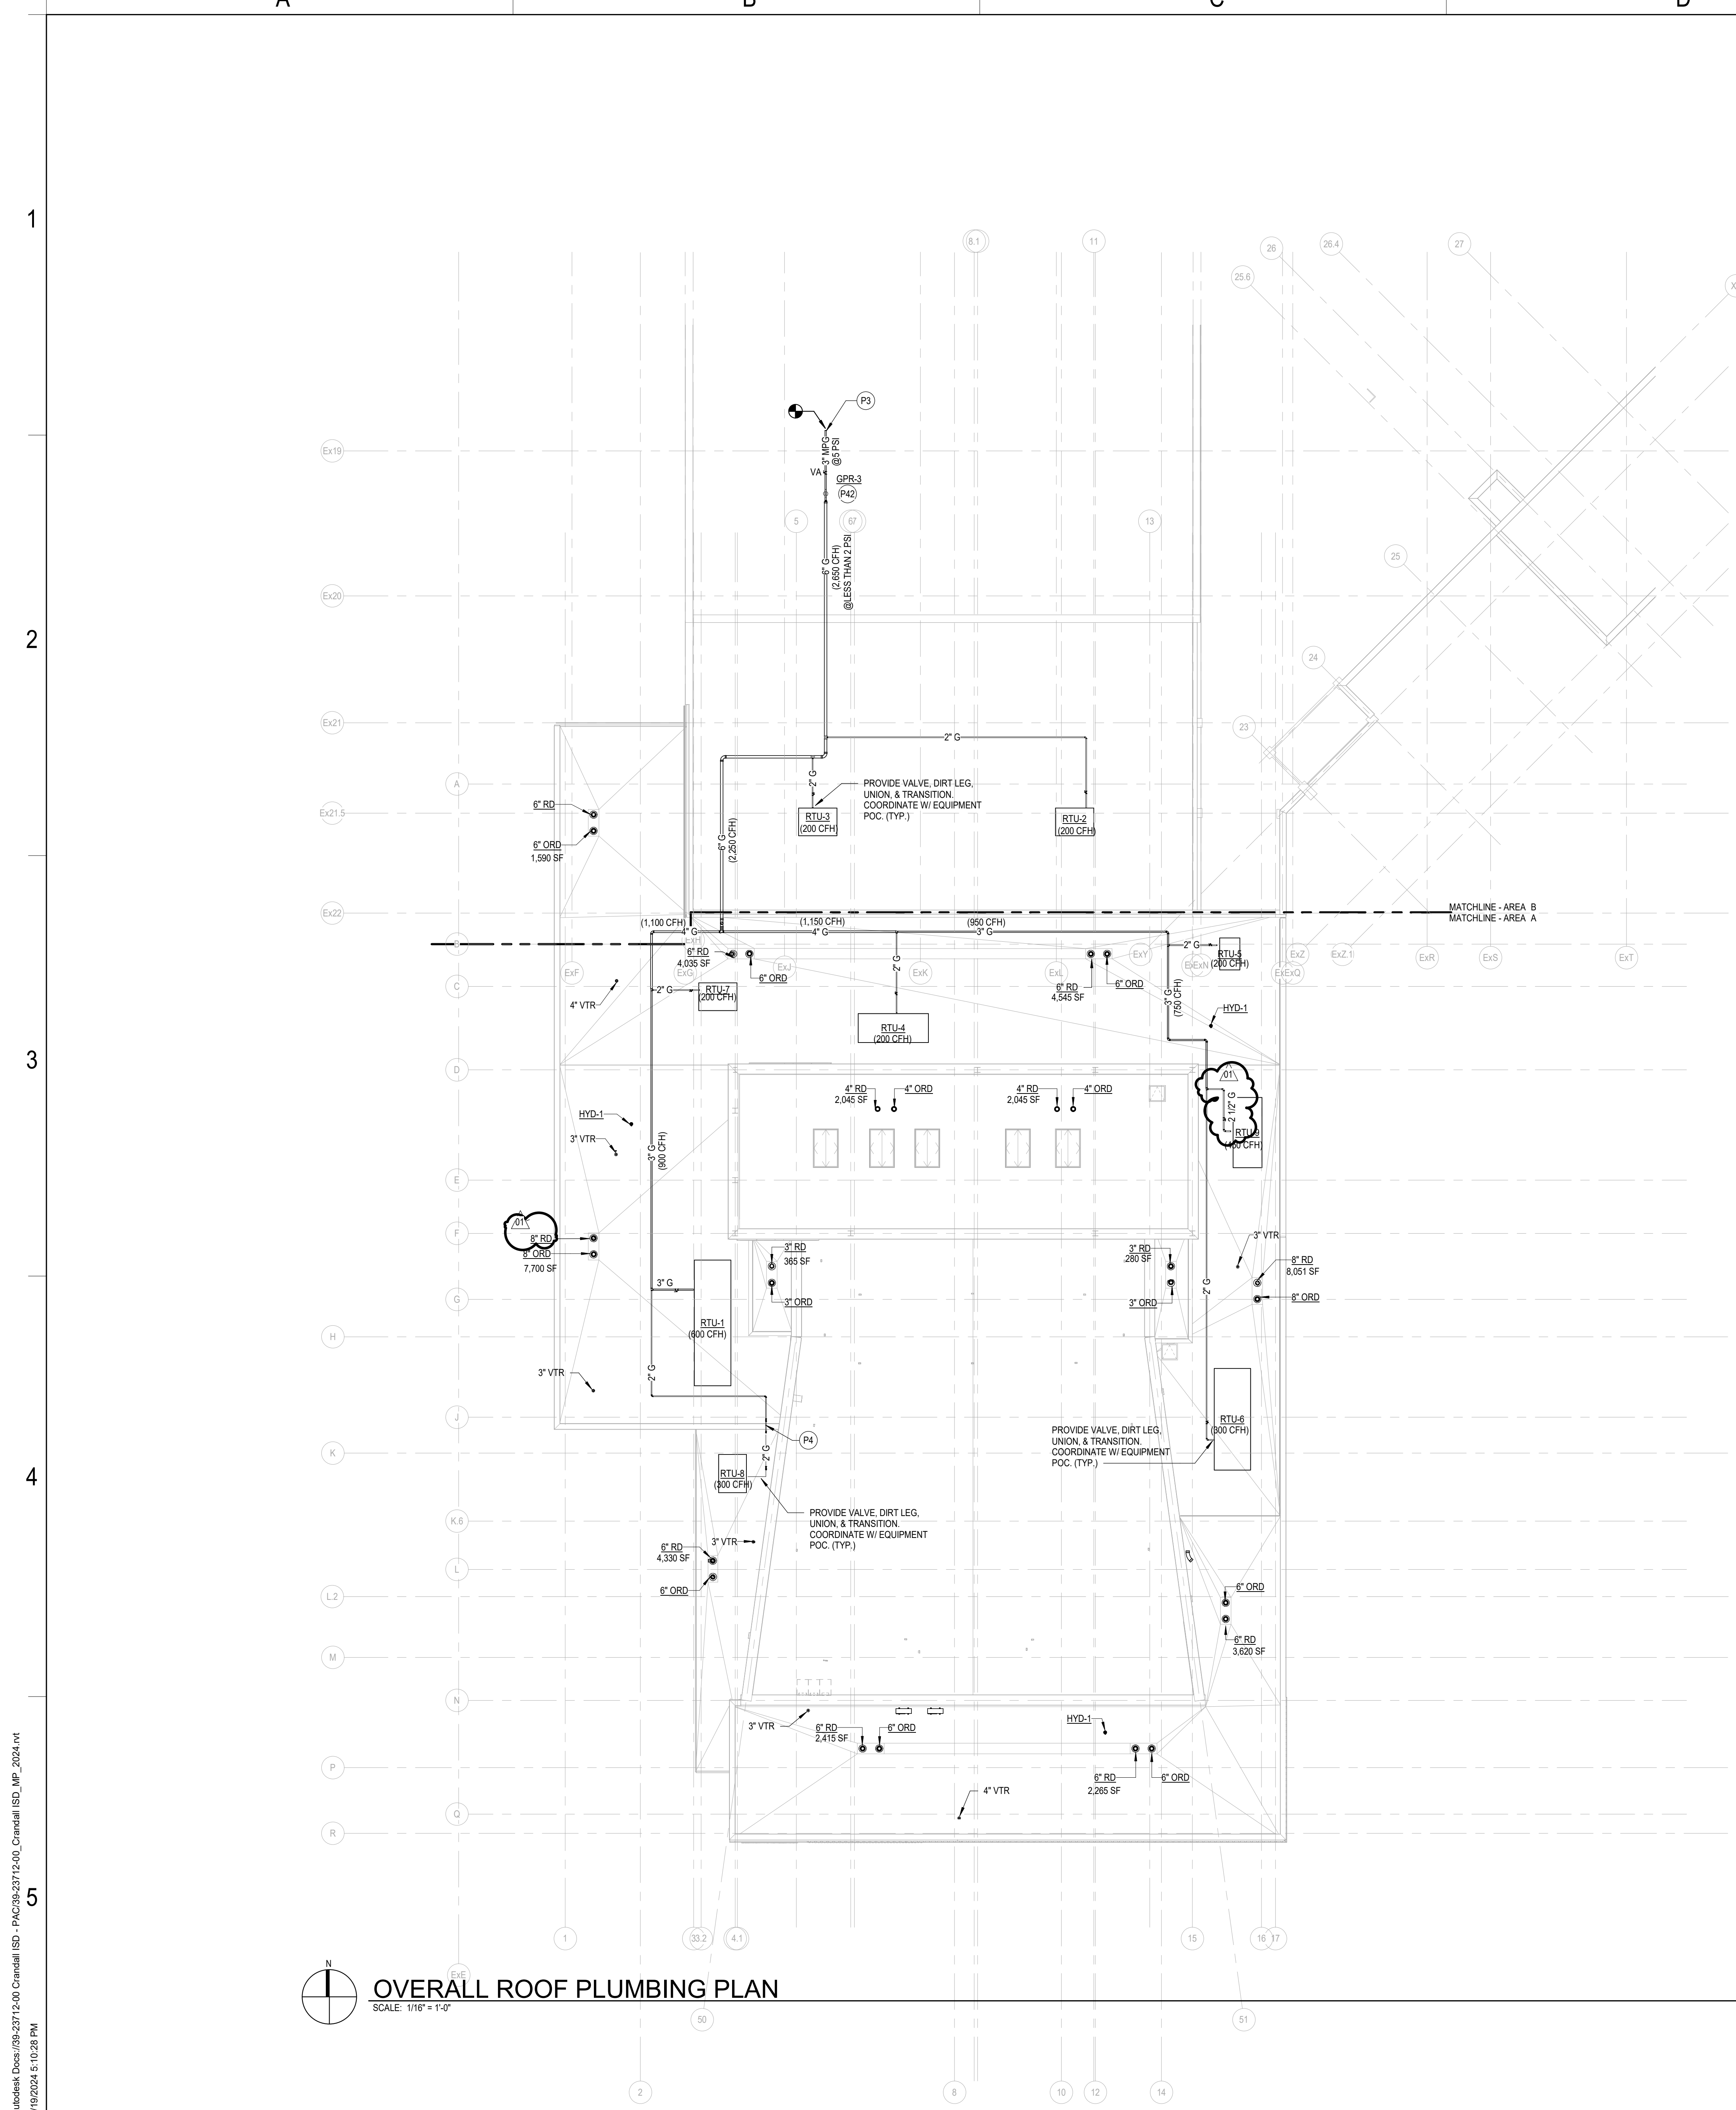

OVERALL ROOF PLUMBING PLAN
SCALE: 1/16" = 1'-0"


PLUMBING GENERAL NOTES

- A FOR SYMBOLS AND ABBREVIATIONS SEE DRAWINGS P0.1 & P.02.
- B BEFORE COMMENCEMENT OF WORK, THE CONTRACTOR SHALL VERIFY THE EXACT LOCATIONS, ELEVATIONS AND CHARACTERISTICS OF ALL UTILITIES AND PIPING BY PHYSICAL EXCAVATION AND SHALL IMMEDIATELY NOTIFY THE ARCHITECT OF ANY DISCREPANCIES.
- C THE CONTRACTOR SHALL FIELD VERIFY ALL EXISTING UTILITIES AND POINTS OF CONNECTION PRIOR TO BIDDING PROJECT.
- D ALL UNDERGROUND SANITARY AND STORM PIPING SHALL BE SUPPORTED BY AN APPROVED SUSPENSION SYSTEM DESIGNED FOR VERTICAL EXPANSION FOR THE UNDERLYING SOIL.

SHEET NOTES

- P3 P.O.C. NEW 6" G. LINE WITH SHUT-OFF VALVE AND GAS PRESSURE REGULATOR TO EXISTING MFG LINE ON EXISTING ROOF. VERIFY DOWNSTREAM EQUIPMENT PRESSURE REQUIREMENT WITH MANUFACTURER PRIOR SETTING REGULATOR MAXIMUM PRESSURE. FIELD VERIFY POINTS OF CONNECTION PRIOR TO INSTALLATION OF ANY PIPING.
- P4 GAS PIPING UP AND OVER PARAPET. TYPICAL.
- P42 SET OUTLET PSI TO EQUIPMENT'S MANUFACTURER'S RECOMMENDED PSI.

KEY PLAN

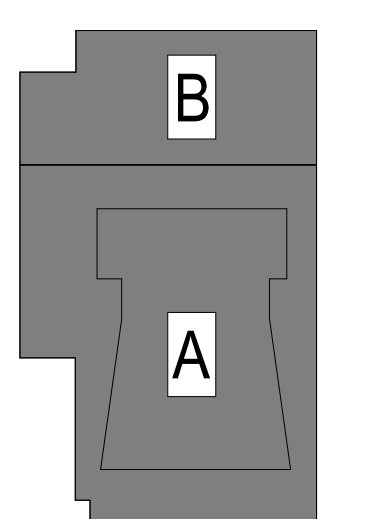


CRANDALL ISD HIGH SCHOOL
PAC ADDITION
13385 Fm 3038, Crandall, TX 75114

ISSUE FOR BID AND PERMIT
2024.07.25
REVISIONS
01 08/19/2024 ADDENDUM 01


39-23712-00
OVERALL ROOF PLUMBING PLAN

P2.3

Autodesk Docs://99-23712-00_Crandall ISD - PAC-39-23712-00_Crandall ISD_MP_2024.rvt
8/19/2024 5:10:28 PM

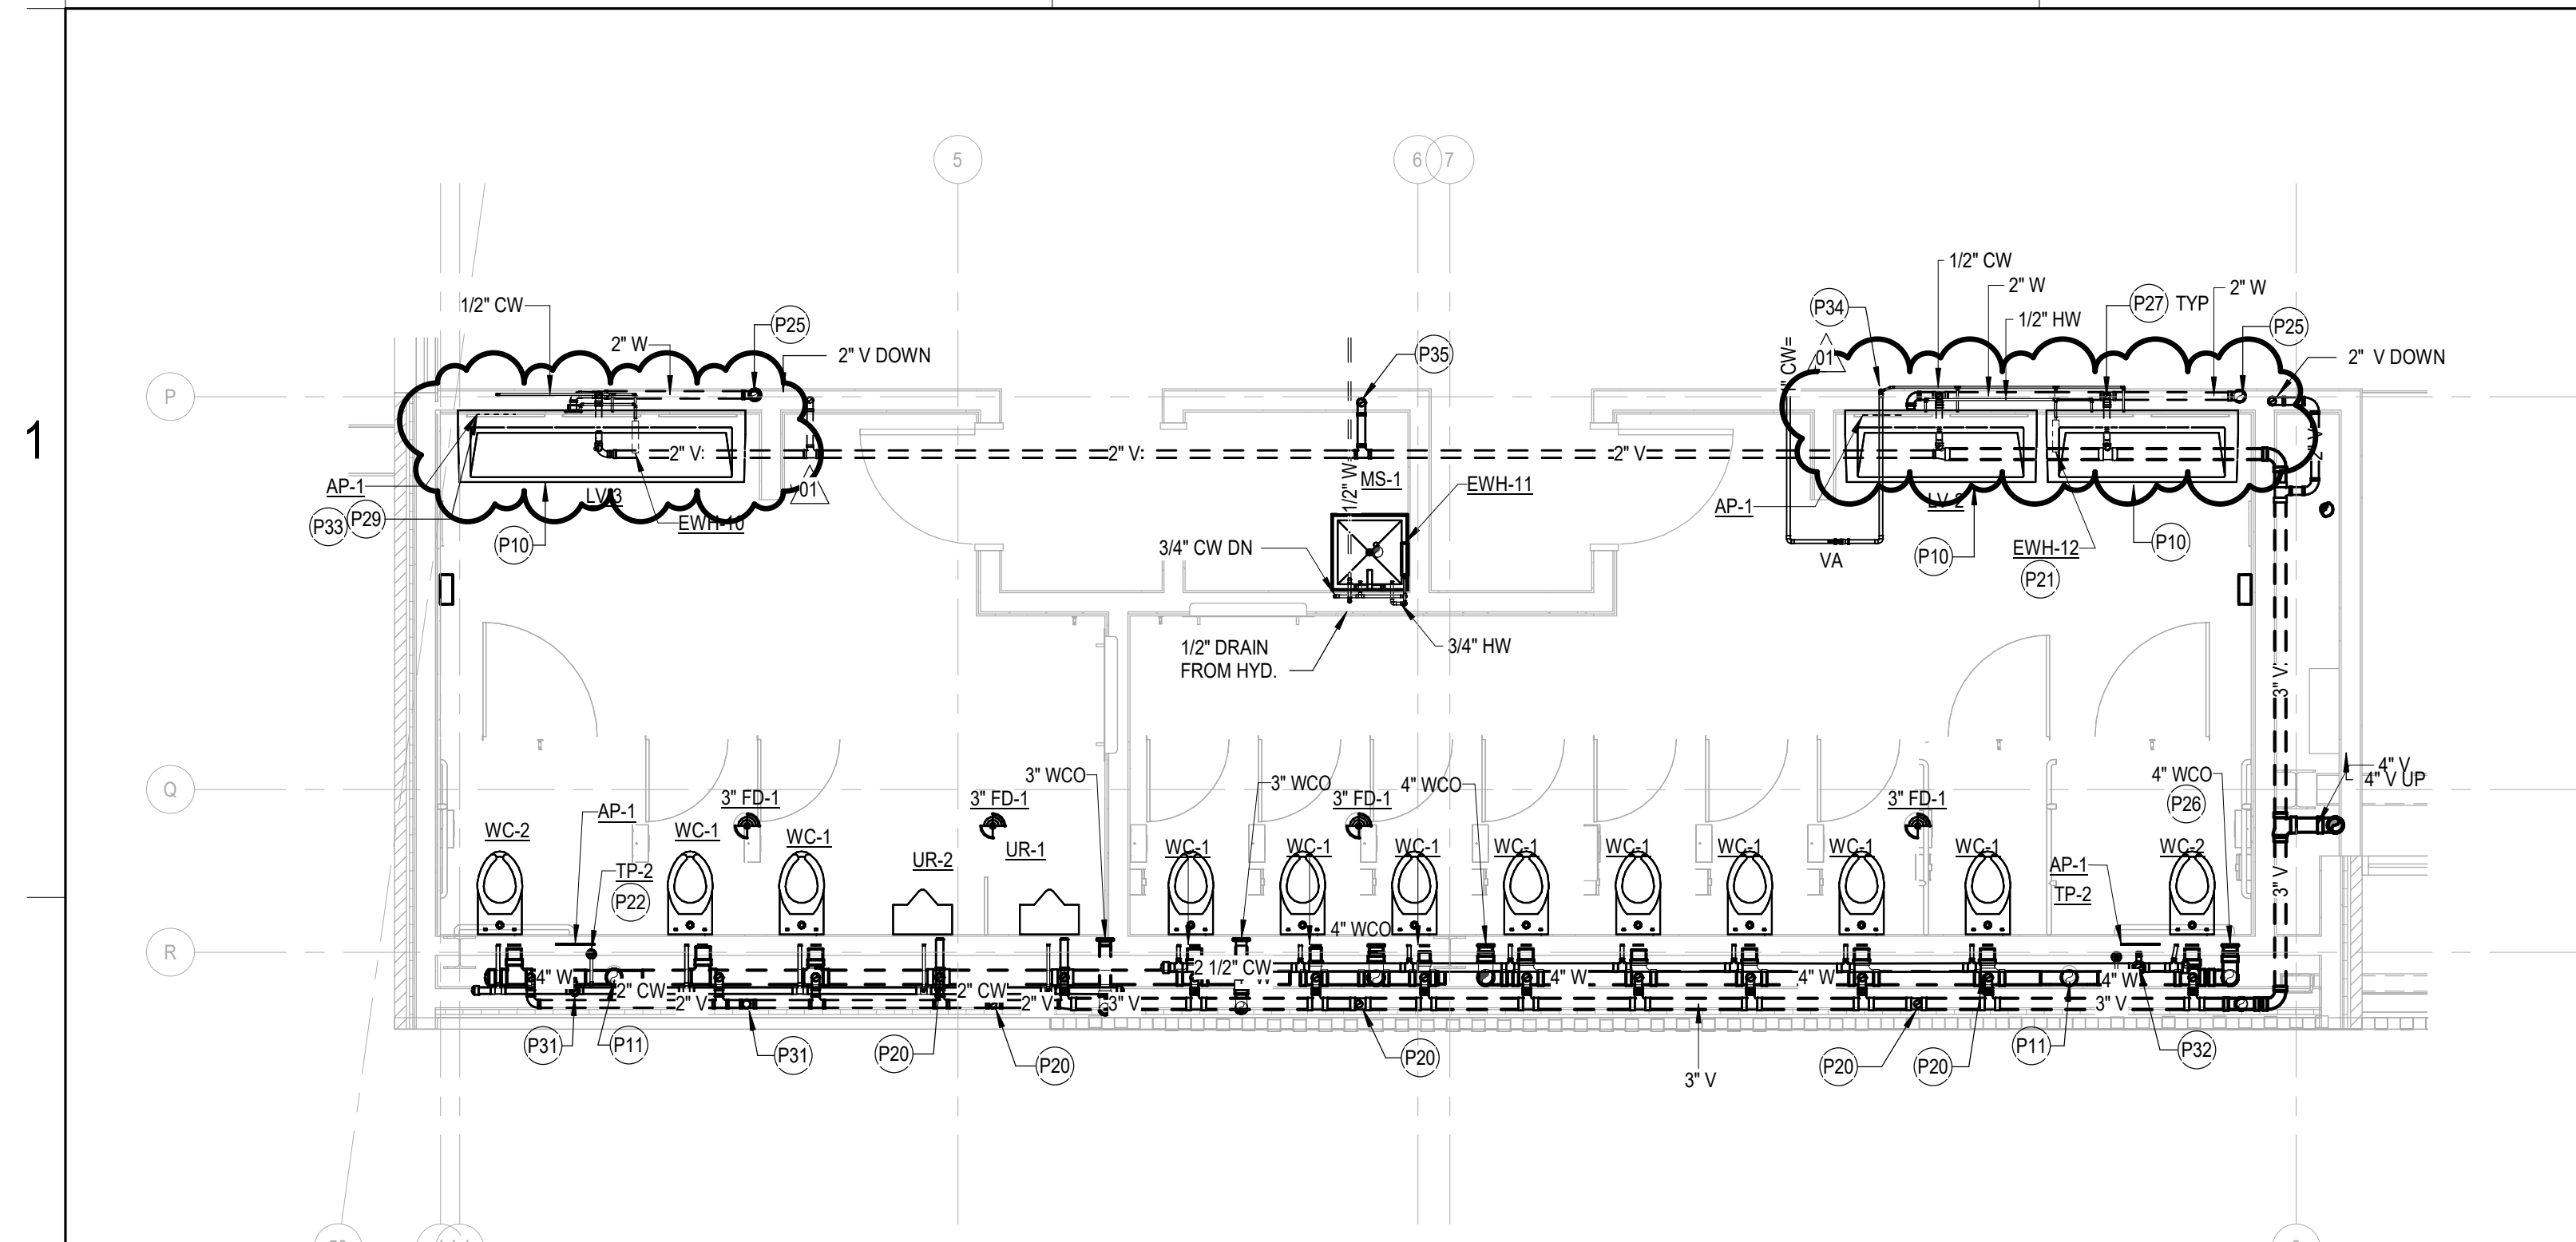

2 LEVEL 2 - MEN & WOMENS TOILETS
SCALE: 1/4" = 1'-0"

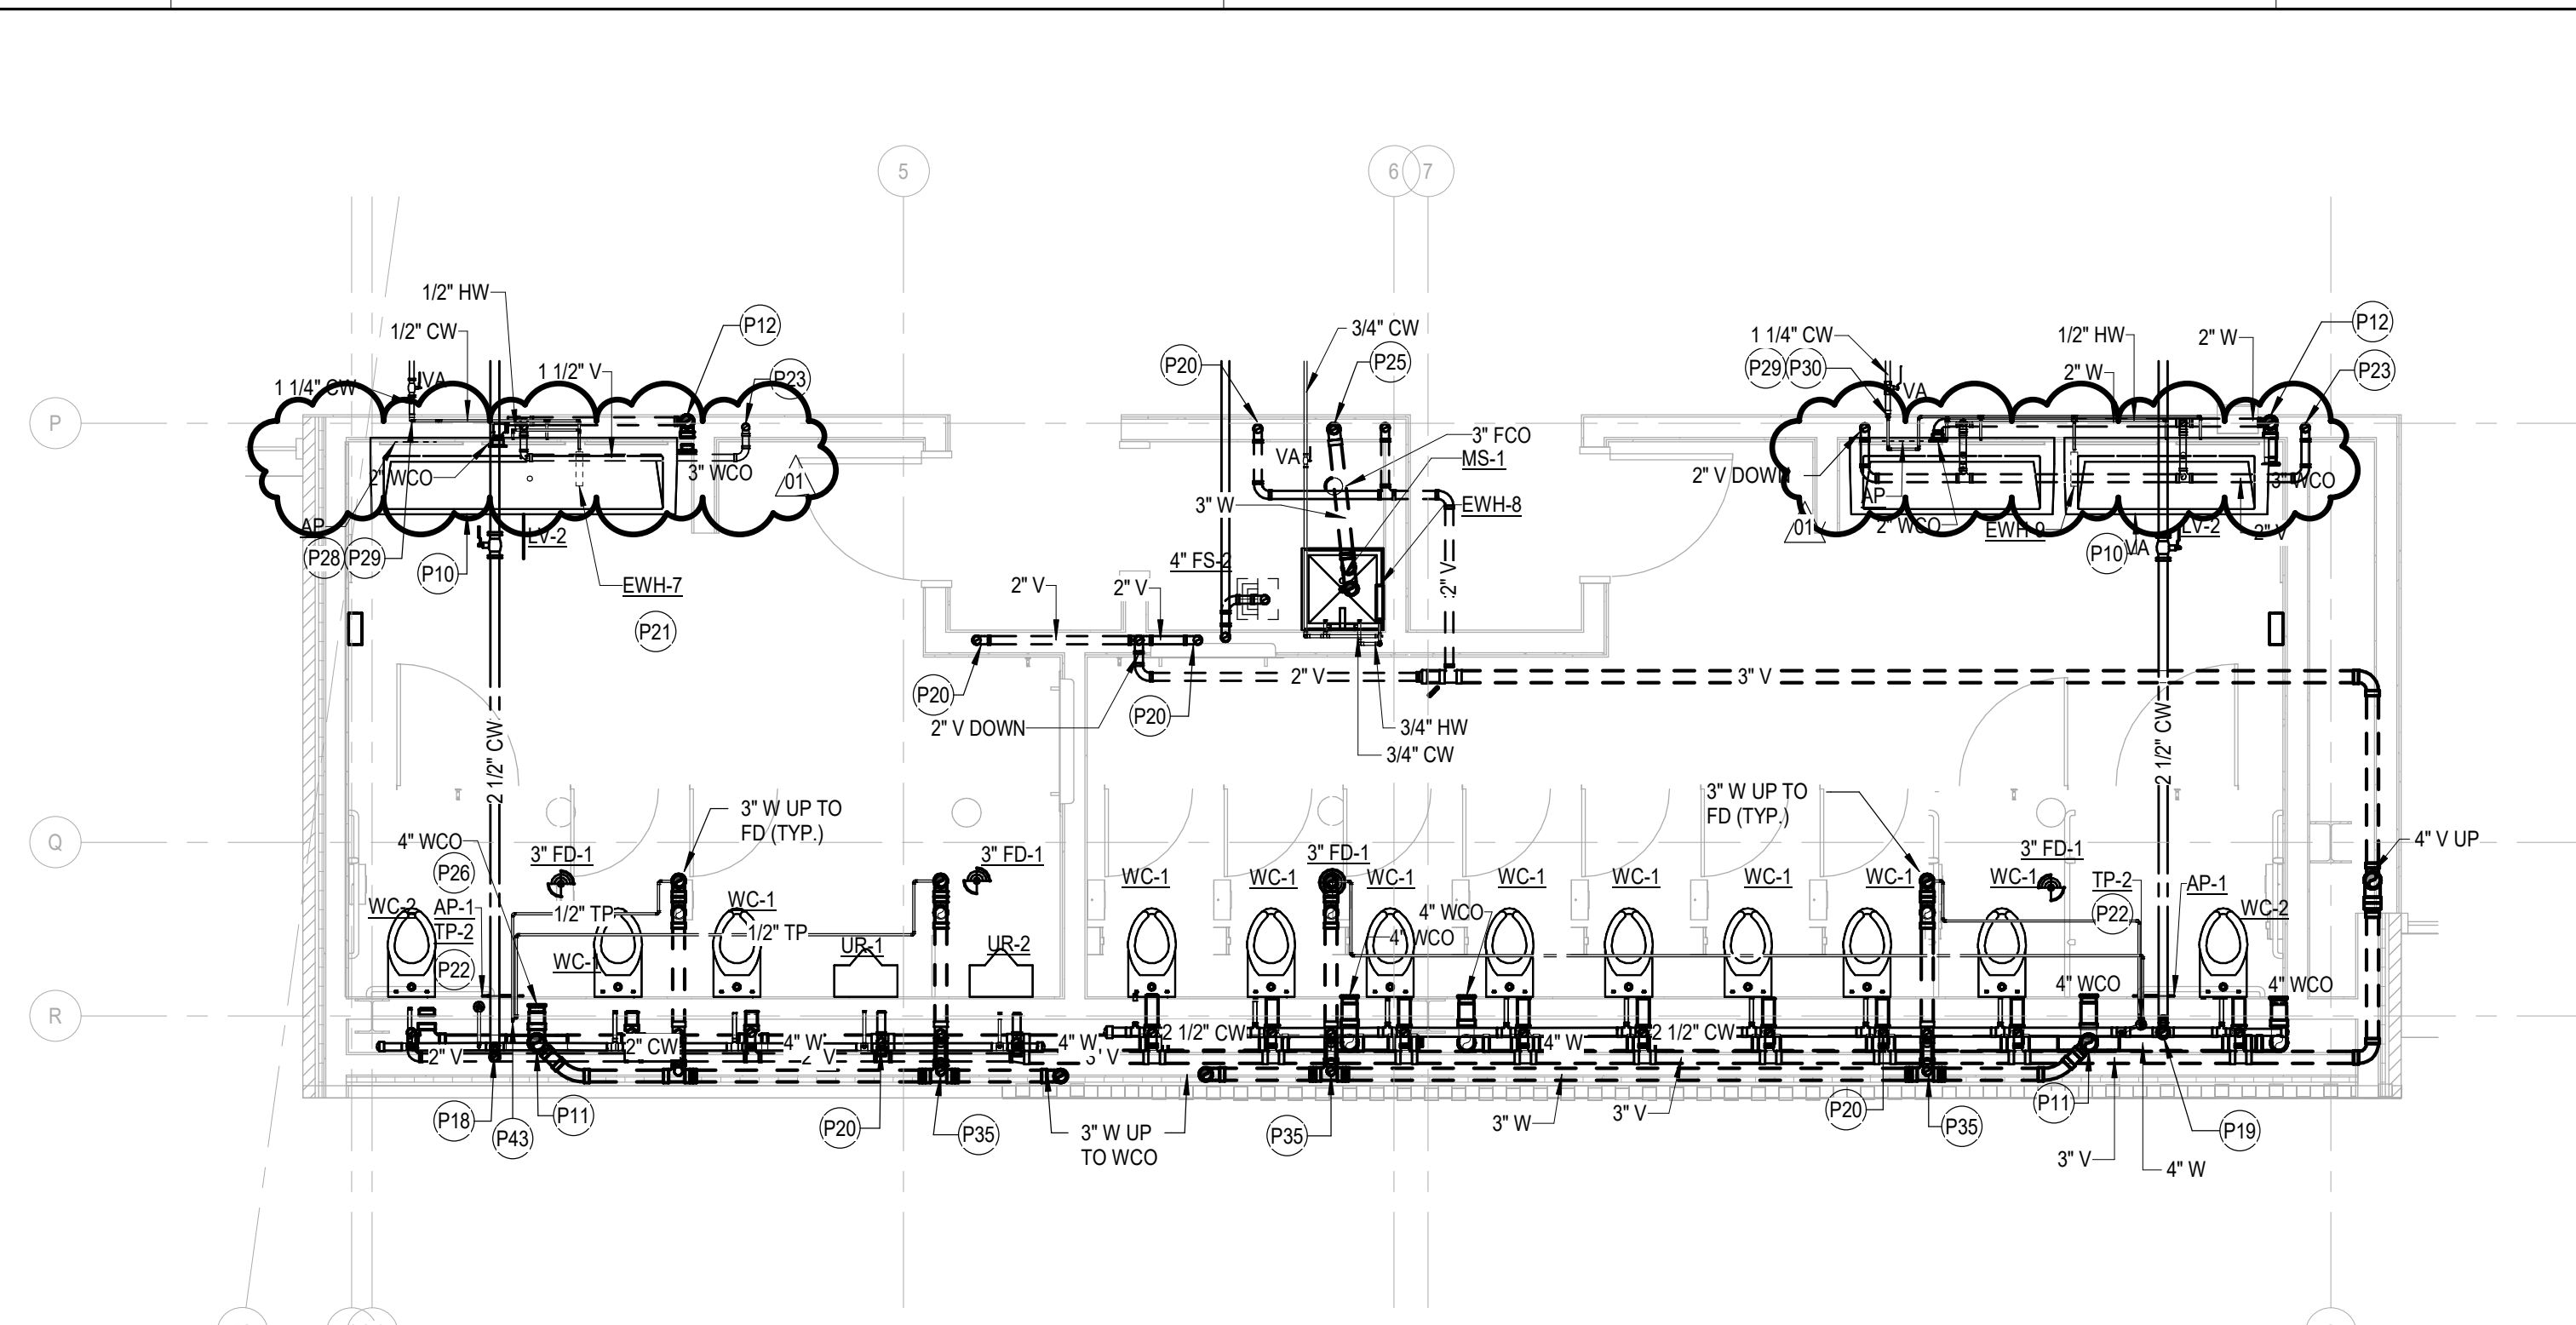


1 LEVEL 1 - MEN & WOMENS TOILETS
SCALE: 1/4" = 1'-0"

PLUMBING GENERAL NOTES

- A FOR SYMBOLS AND ABBREVIATIONS SEE DRAWINGS P0.1 & P.02.
- B BEFORE COMMENCEMENT OF WORK, THE CONTRACTOR SHALL VERIFY THE EXACT LOCATIONS, ELEVATIONS AND CHARACTERISTICS OF ALL UTILITIES AND PIPING BY PHYSICAL EXCAVATION AND SHALL IMMEDIATELY NOTIFY THE ARCHITECT OF ANY DISCREPANCIES.
- C THE CONTRACTOR SHALL FIELD VERIFY ALL EXISTING UTILITIES AND POINTS OF CONNECTION PRIOR TO BIDDING PROJECT.
- D ALL UNDERGROUND SANITARY AND STORM PIPING SHALL BE SUPPORTED BY AN APPROVED SUSPENSION SYSTEM DESIGNED FOR VERTICAL EXPANSION FOR THE UNDERLYING SOIL.

SHEET NOTES

- P10 1/2" CW, 1/2" HW, 2" V EACH DRAIN AND FAUCET LOCATION.
- P11 4" W UP.
- P12 3" W UP.
- P18 2" CW DOWN TO SHUTOFF VALVE BEHIND ACCESS PANEL. CONTINUE FULL-SIZED HORIZONTAL IN WALL.
- P19 2-1/2" CW DOWN TO SHUTOFF VALVE BEHIND ACCESS PANEL. CONTINUE FULL-SIZED HORIZONTAL IN WALL.
- P20 2" VENT DOWN. TYPICAL.
- P21 ELECTRIC WATER HEATER. INSTALL CONCEALED BEHIND LAVATORY APRON. ROUTE HW PIPING IN THE WALL. TYPICAL.
- P22 TRAP PRIMER DEVICE ACCESSIBLE BEHIND ACCESS PANEL. CONTINUE 1/2" SUPPLY TUBING BELOW FLOOR DRAIN PRIMING CONNECTION. VALVED 3/4" CW.
- P23 2" VENT UP.
- P25 3" W DOWN.
- P26 4" WCO ABOVE WATER CLOSET RIM. TYPICAL.
- P27 1-1/2" VENT DOWN. TYPICAL.
- P28 3/4" UP AND DOWN.
- P29 3/4" VALVE BEHIND ACCESS PANEL BELOW FIXTURE. TYPICAL.
- P30 3/4" DOWN AND 1" UP.
- P31 2" CW UP TO SHUTOFF VALVE BEHIND ACCESS PANEL.
- P32 2-1/2" CW UP TO SHUTOFF VALVE BEHIND ACCESS PANEL.
- P33 3/4" UP TO SHUTOFF VALVE BEHIND ACCESS PANEL. 1" CW UP. BRANCH 3/4" TO SHUTOFF VALVE BEHIND ACCESS PANEL. CONTINUE 1" CW UP TO ROOF HYDRANT.
- P34 1" CW UP. BRANCH 3/4" TO SHUTOFF VALVE BEHIND ACCESS PANEL. CONTINUE 1" CW UP TO ROOF HYDRANT.
- P35 2" VENT DOWN.
- P43 TWO (2) 1/2" PRIMING TUBING UP TO DEVICE.

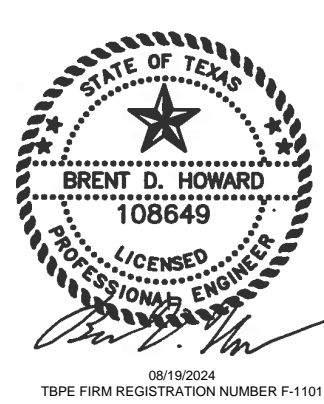

CRANDALL ISD HIGH SCHOOL
PAC ADDITION
13385 Fm 3038, Crandall, TX 75114








ISSUE FOR BID AND PERMIT
2024.07.25
REVISIONS
01 08/19/2024 ADDENDUM 01

39-23712-00
ENLARGED PLUMBING PLANS

P3.1

Autodesk Docs://99-23712-00 Crandall ISD - PAC/39-23712-00 Crandall ISD_MP_2024.rvt
8/9/2024 5:10:31 PM

1
2
3
4
5

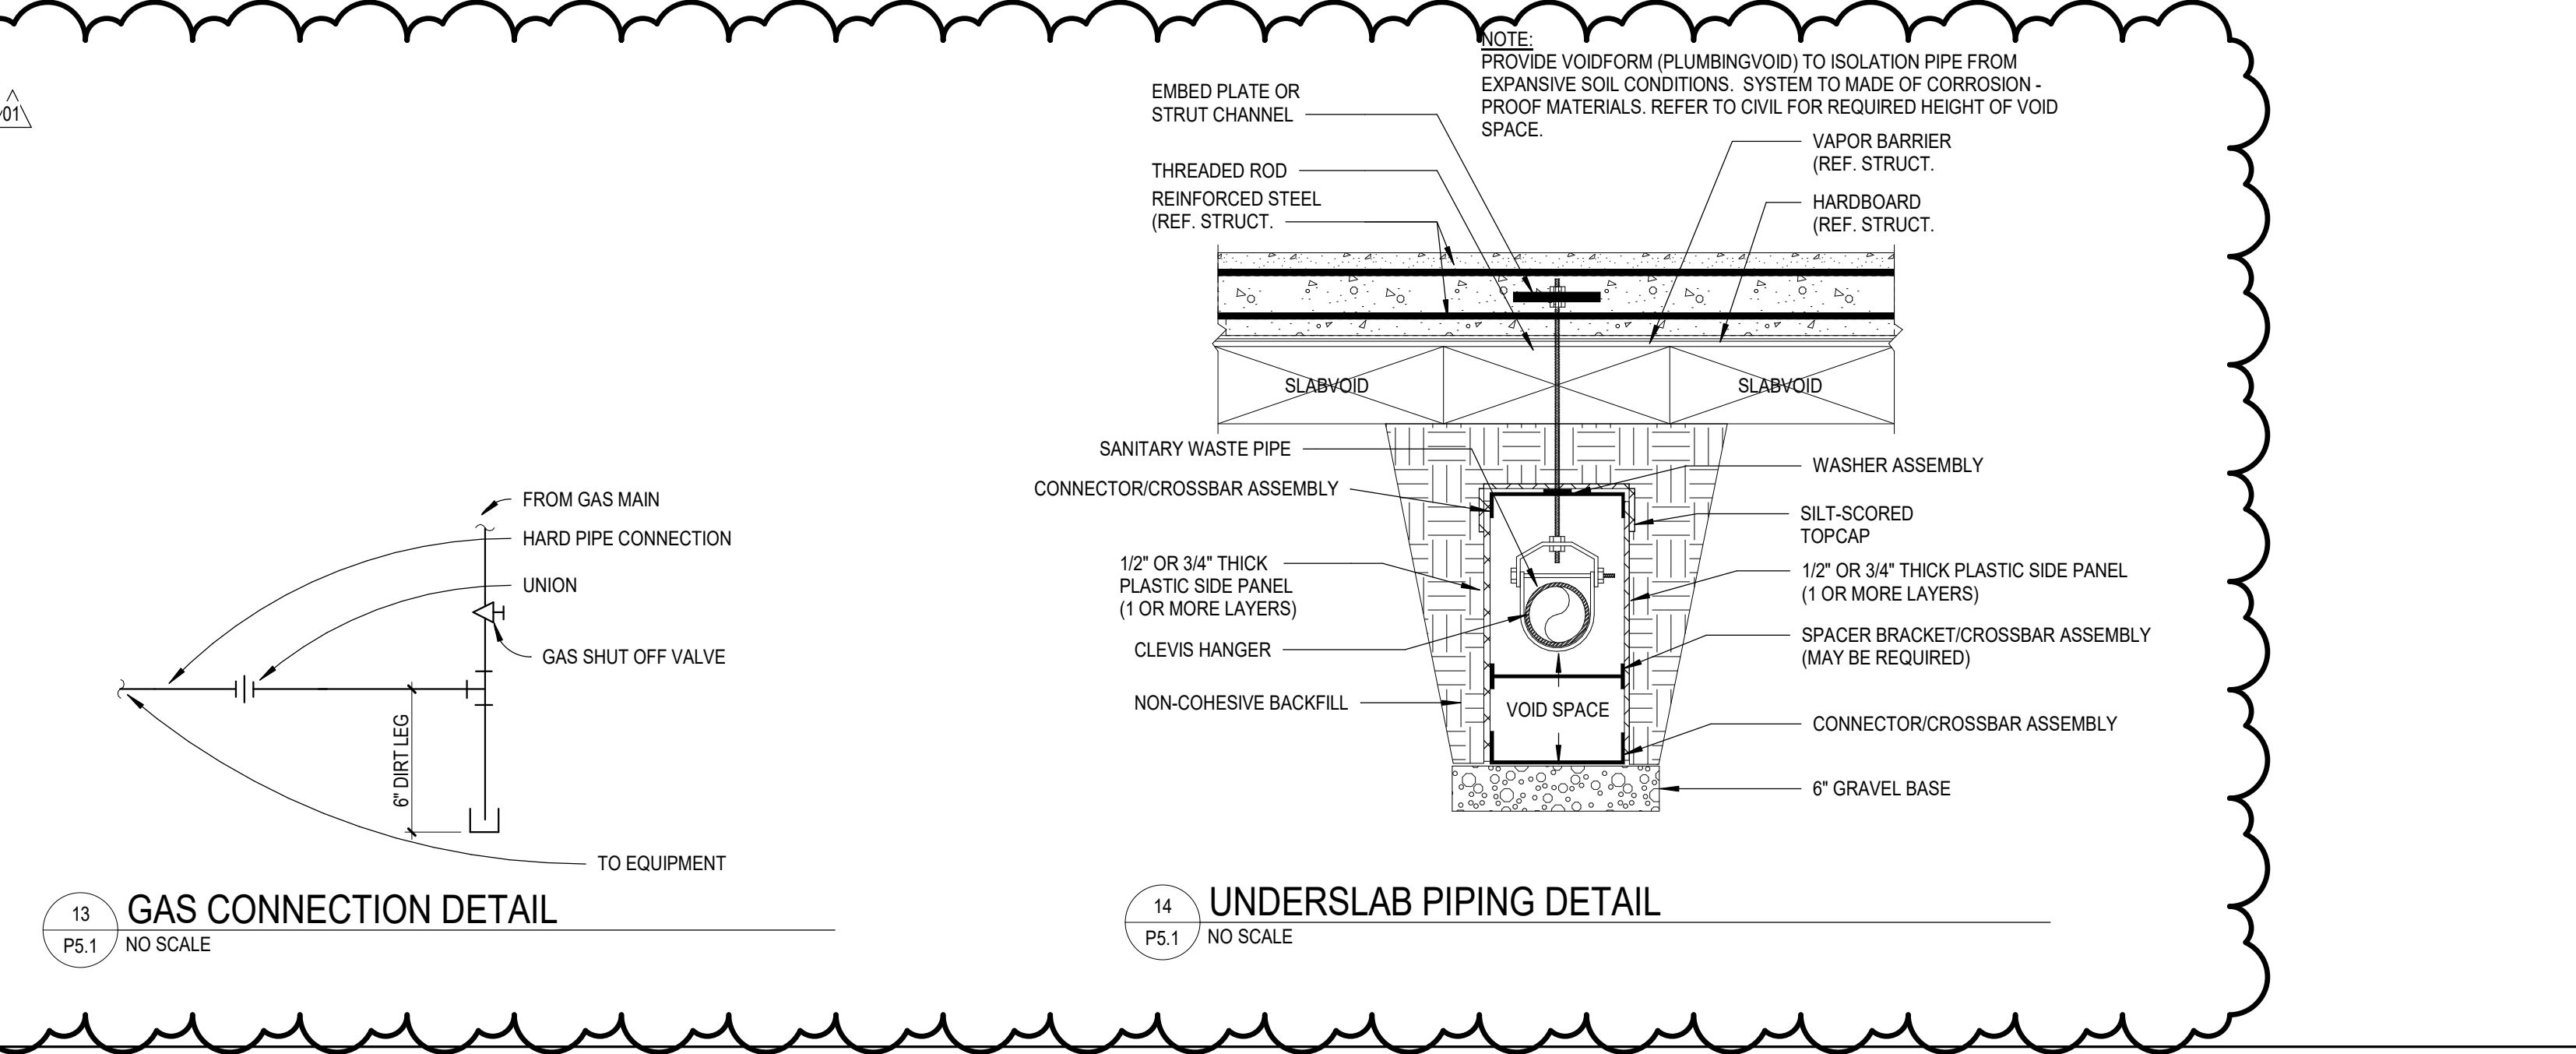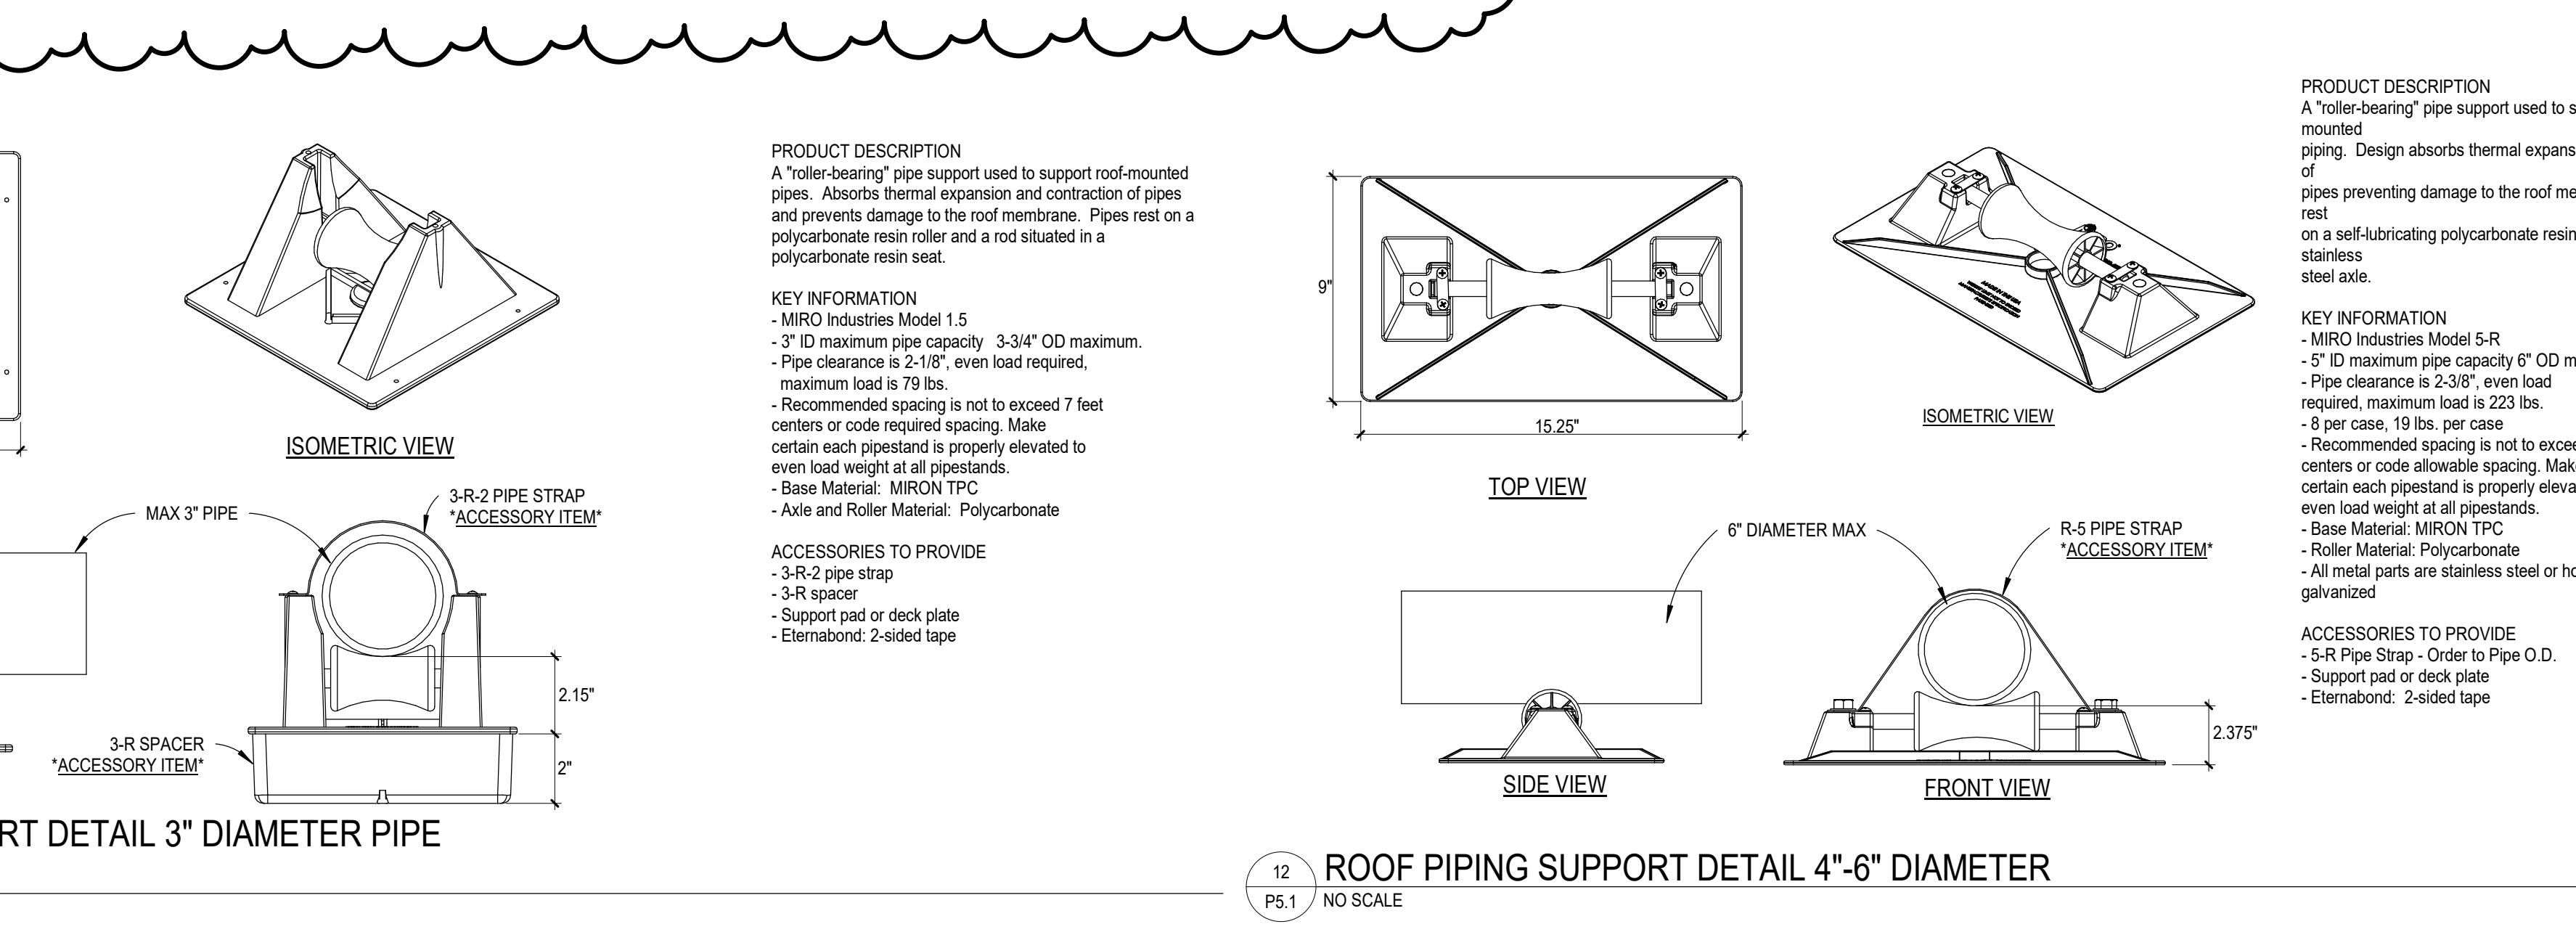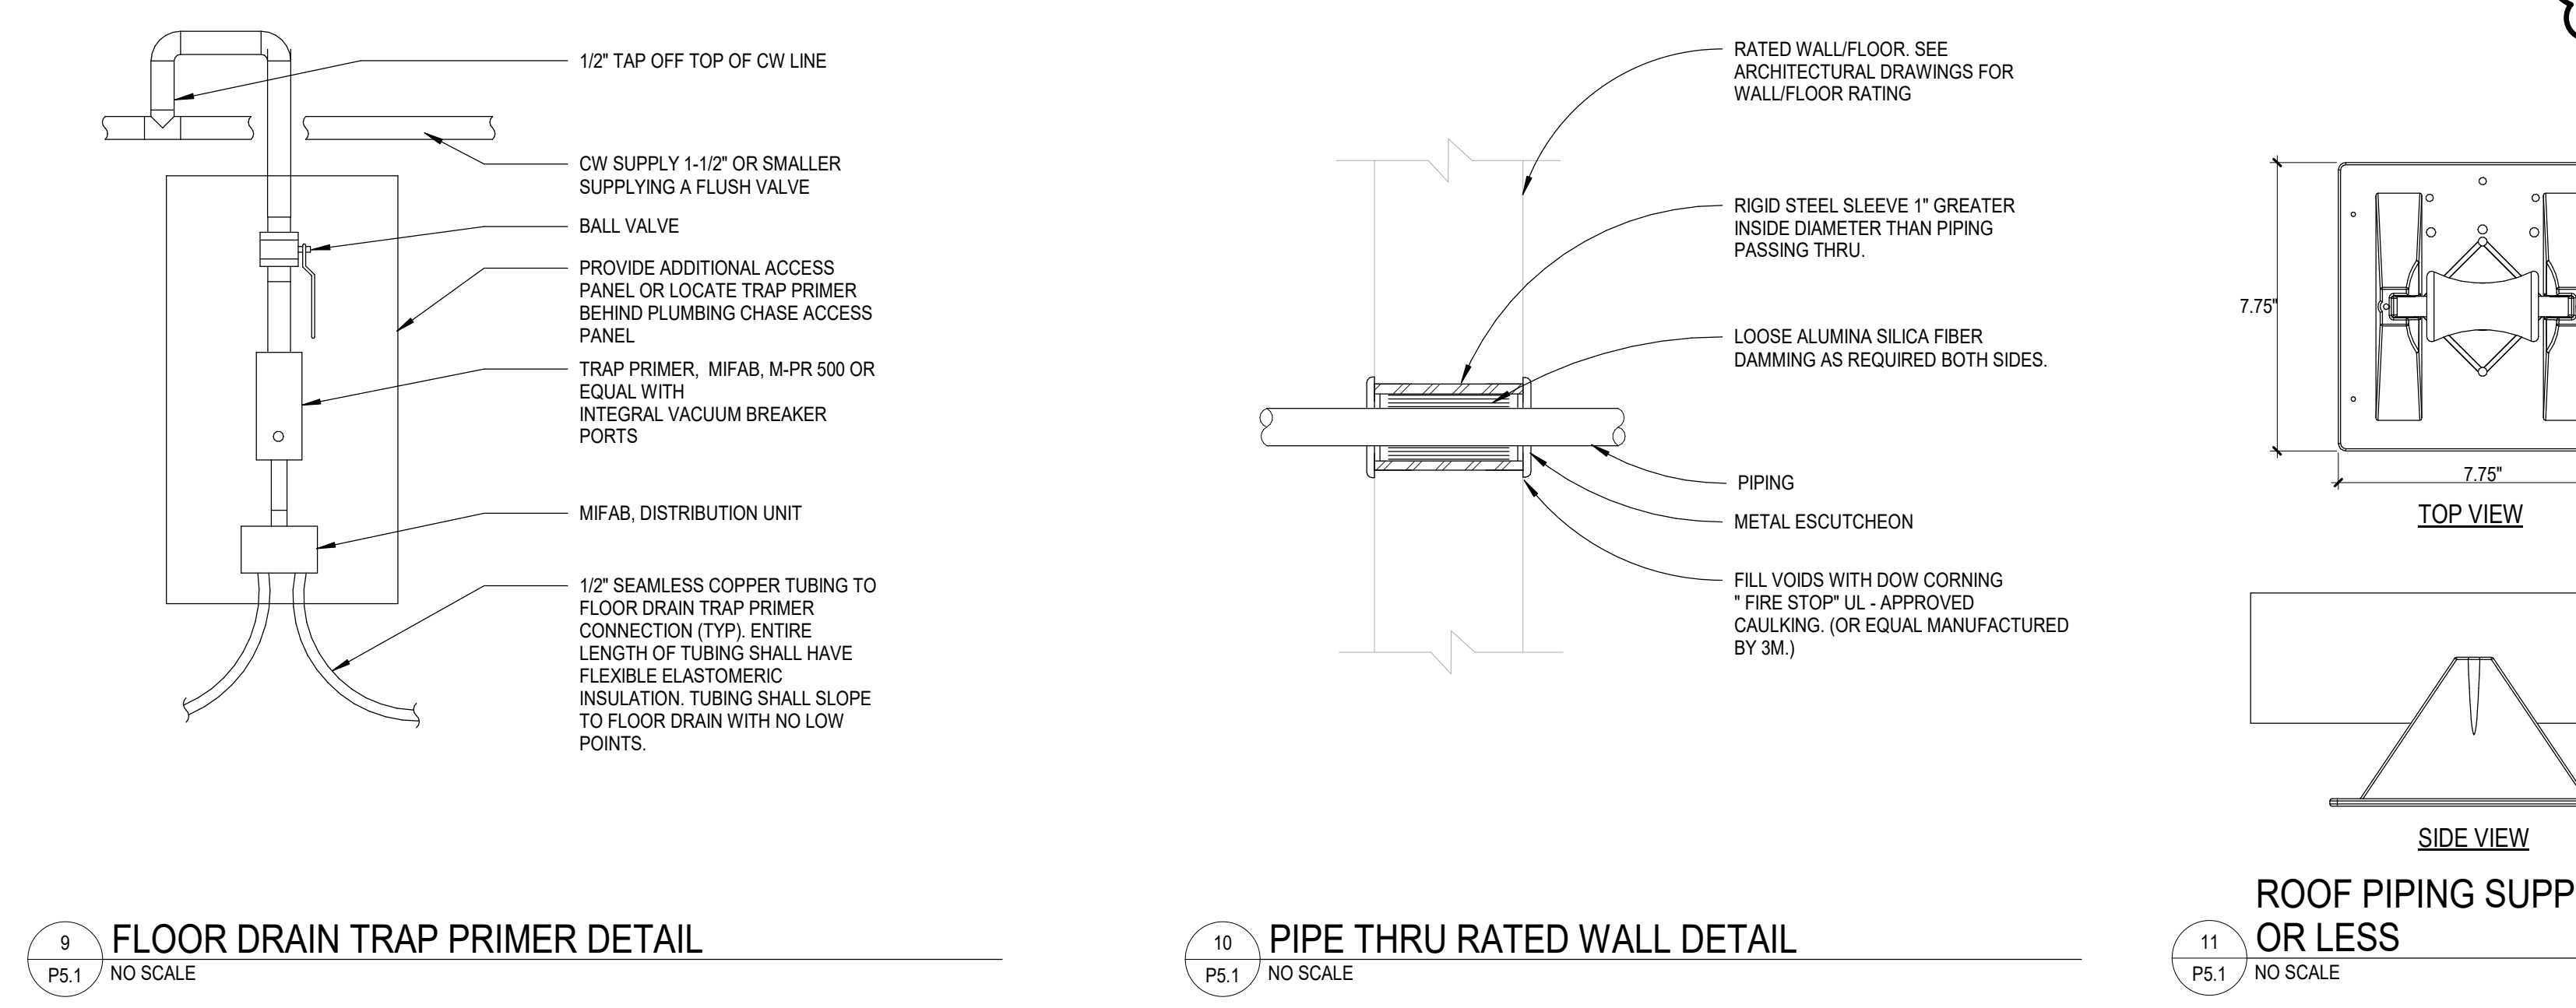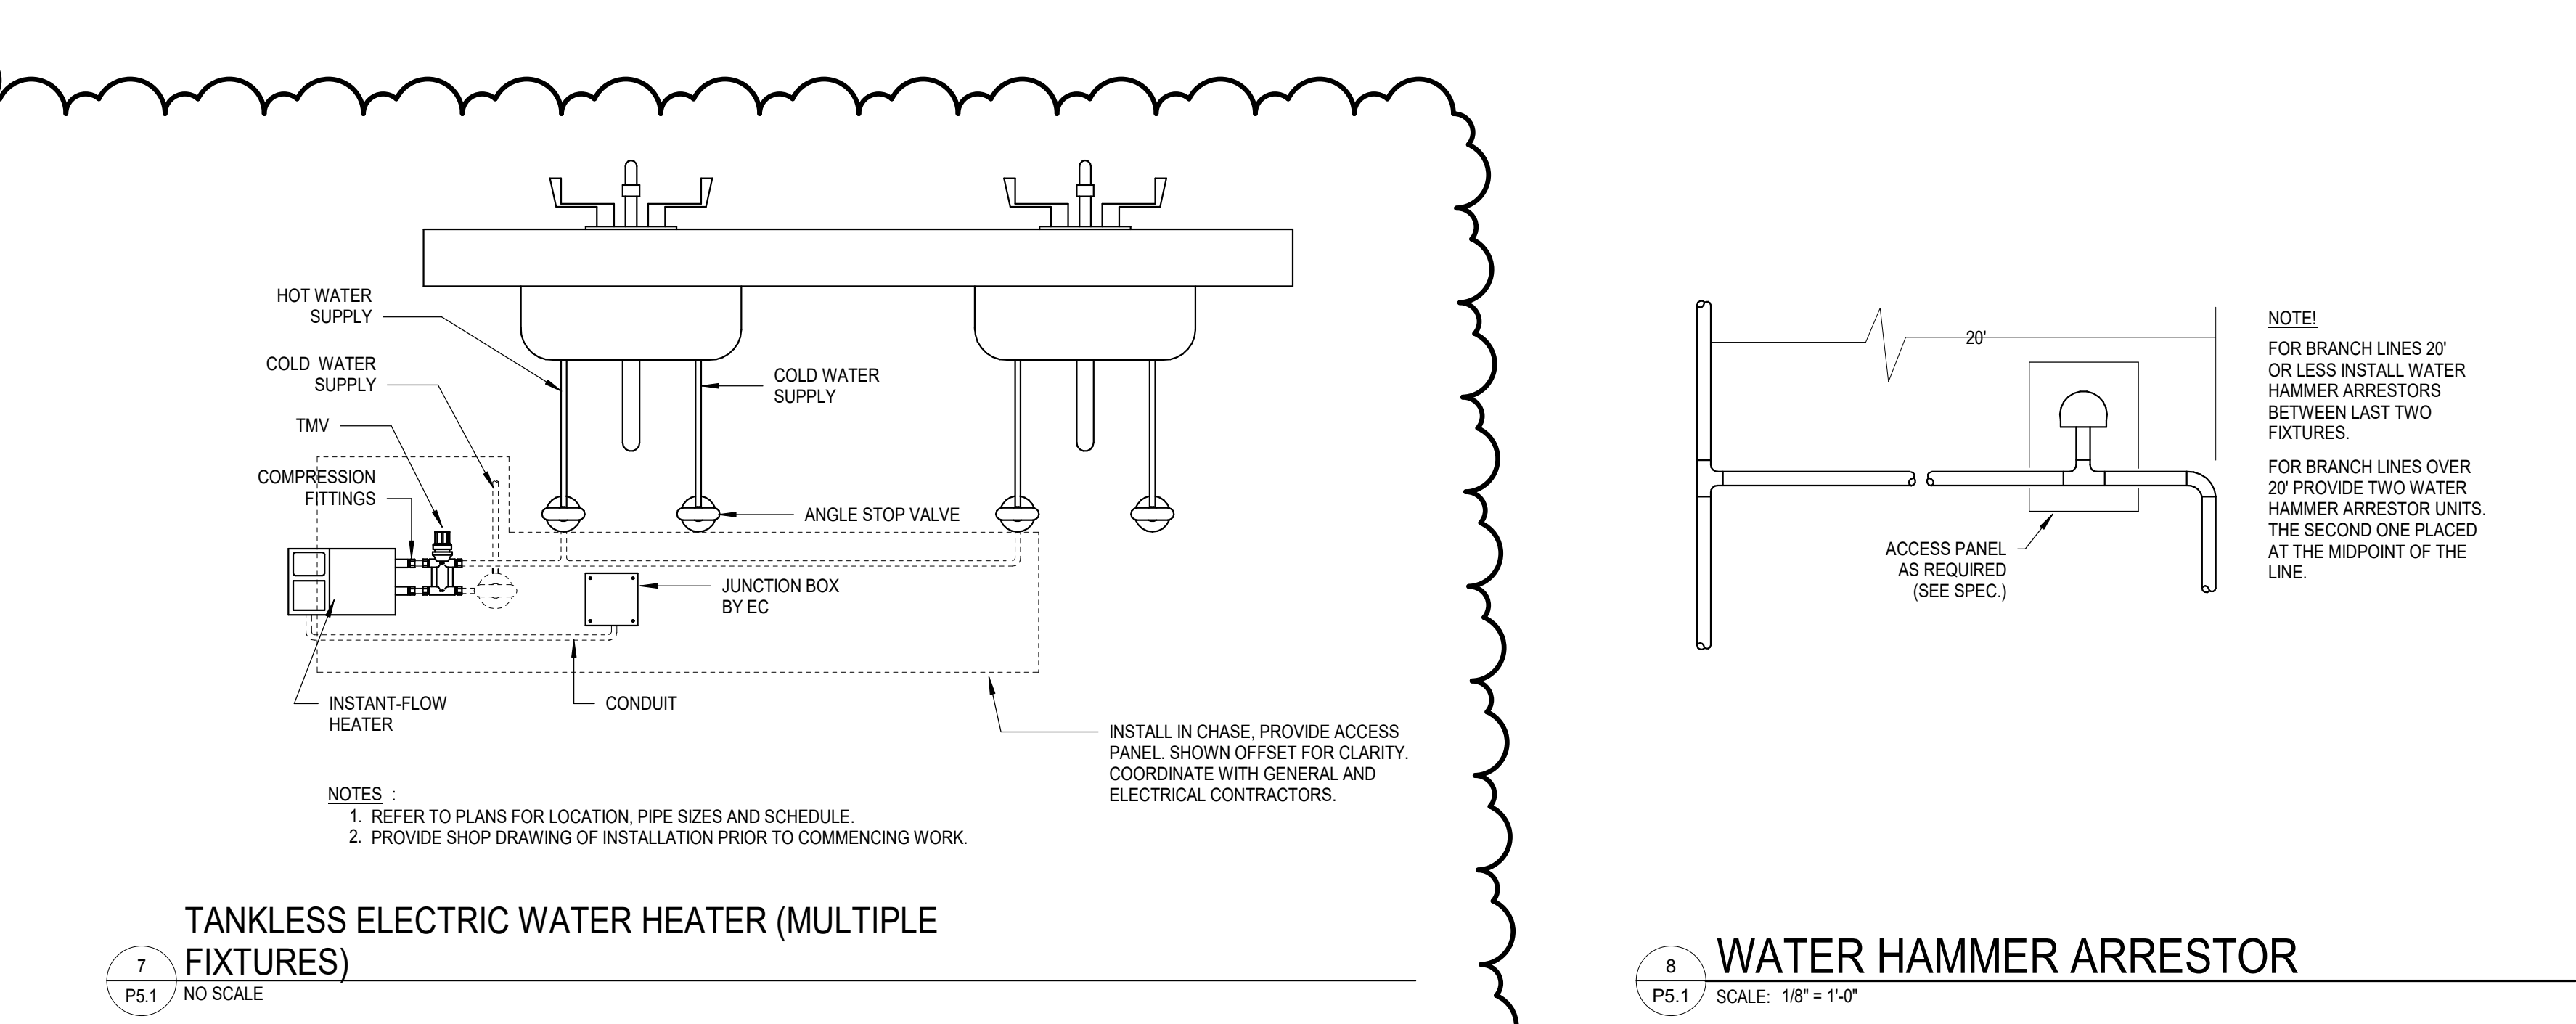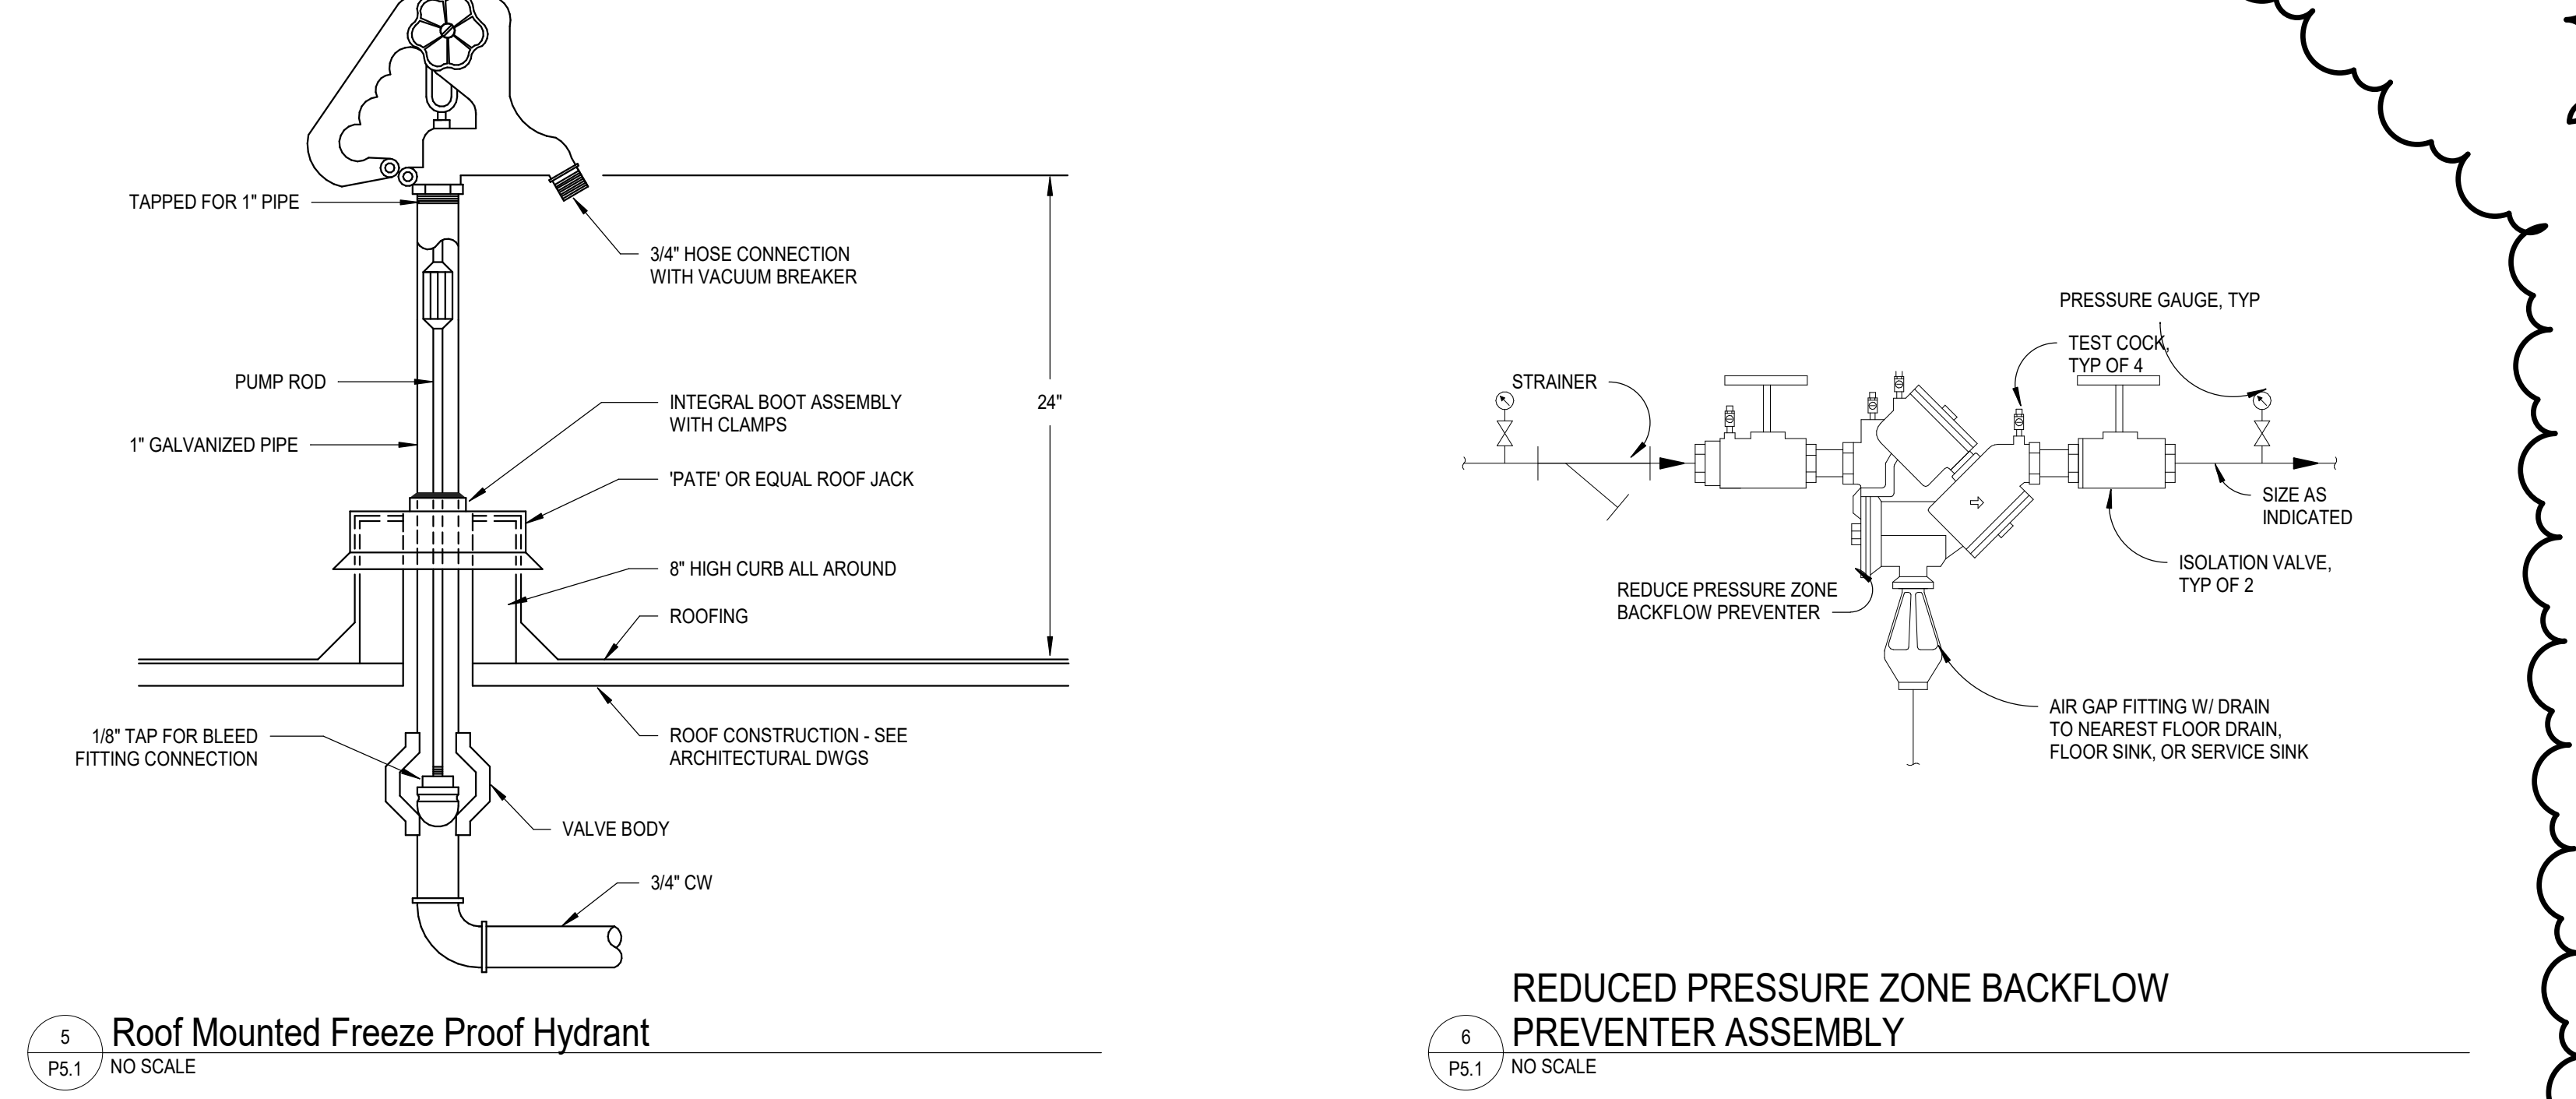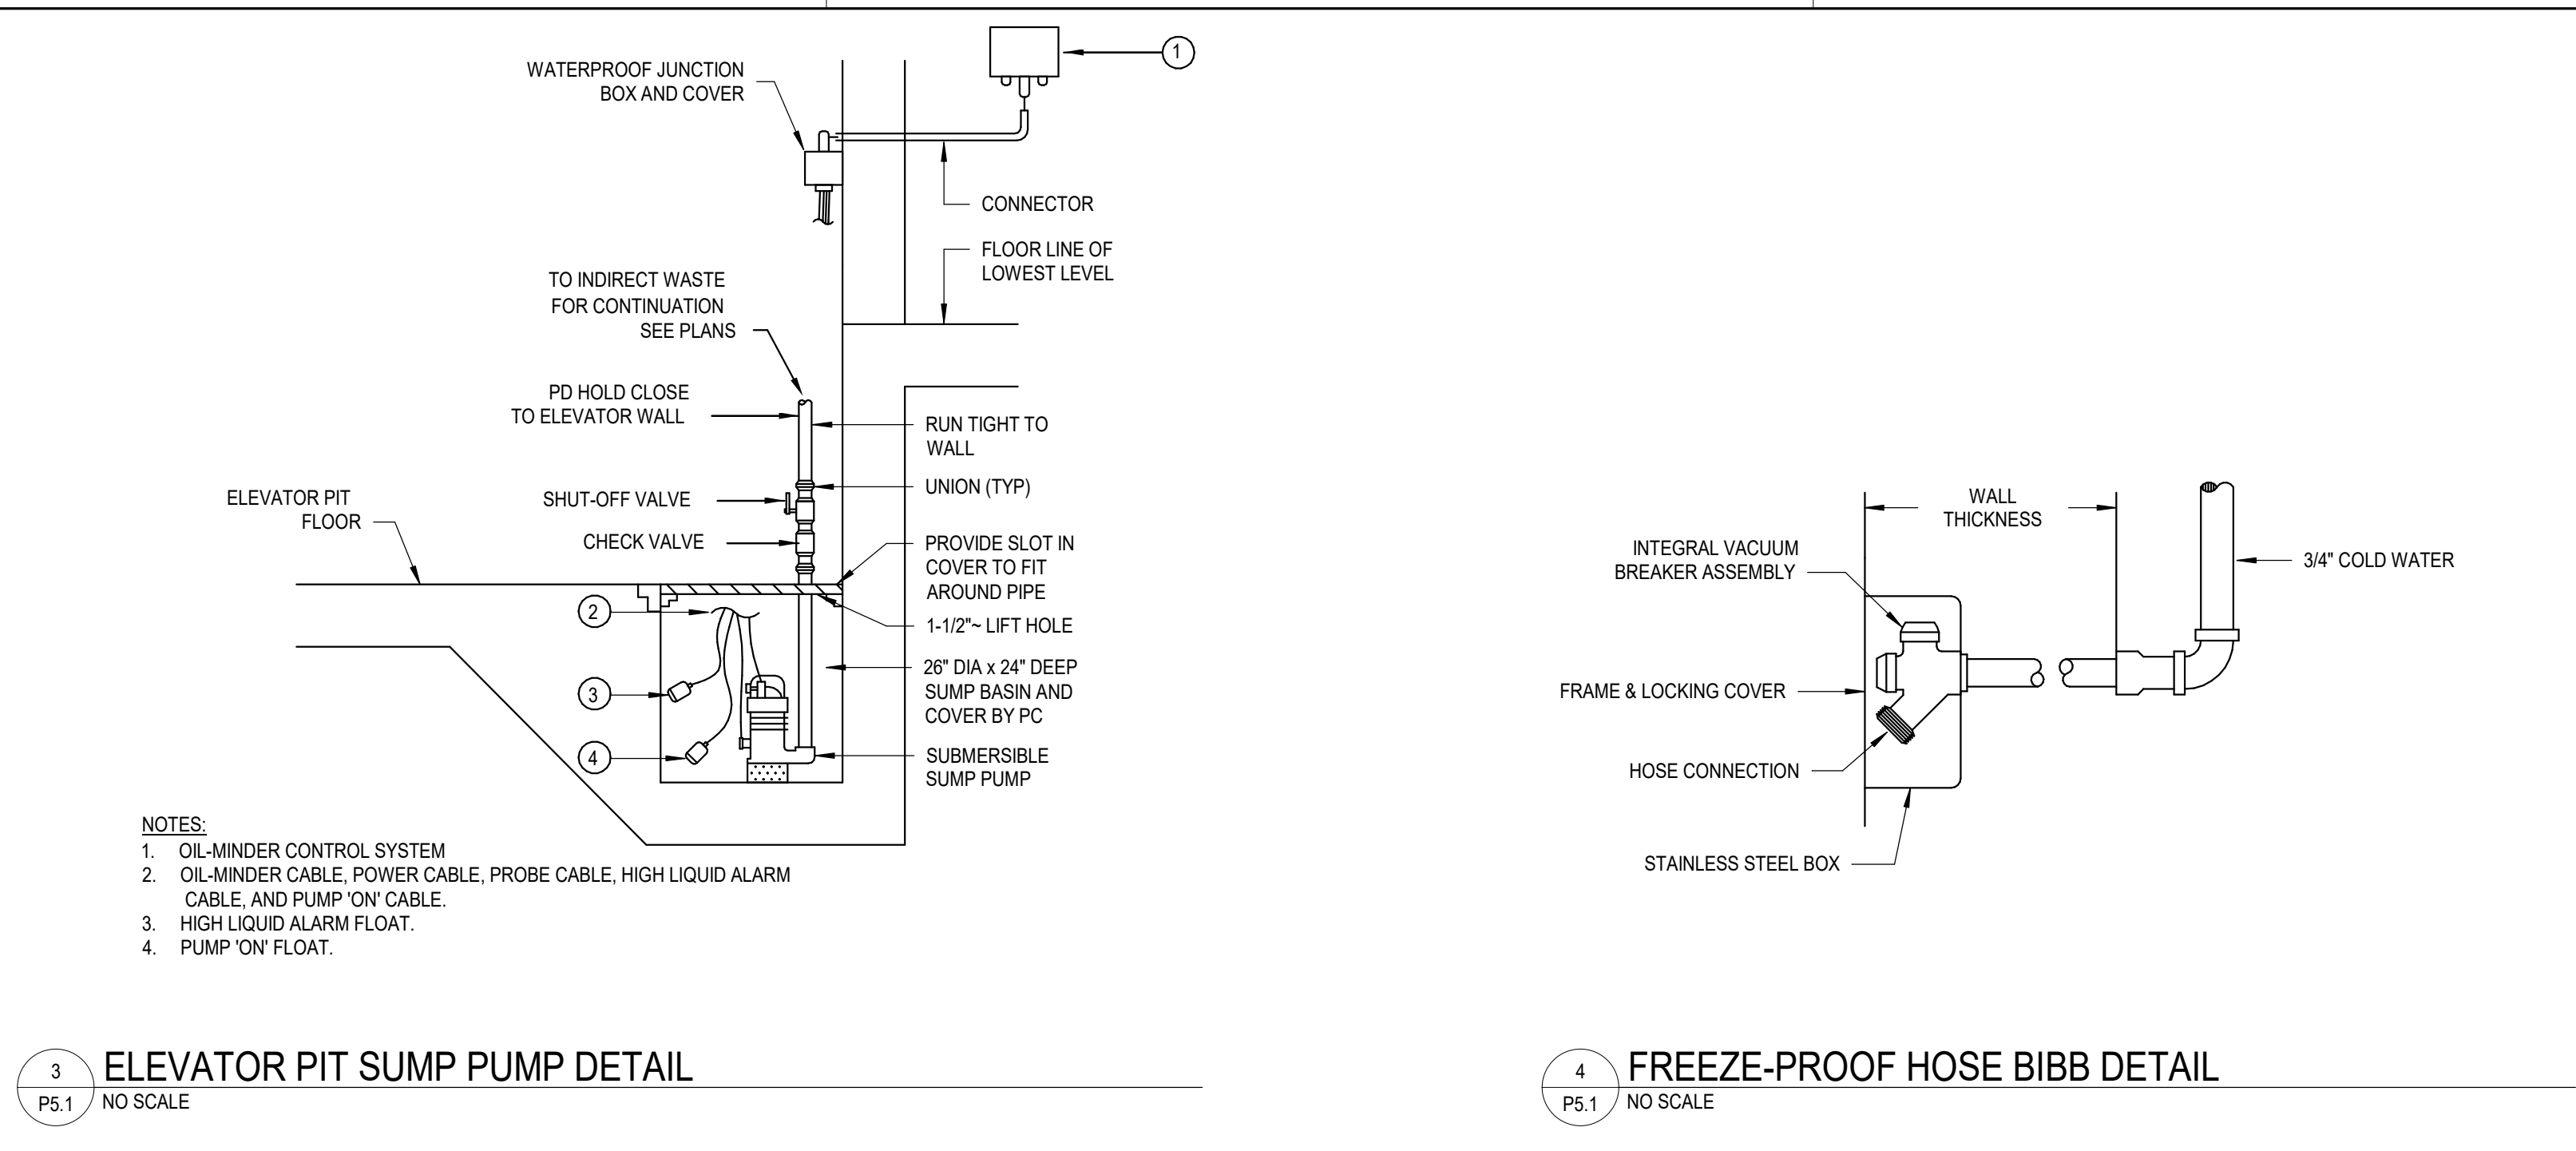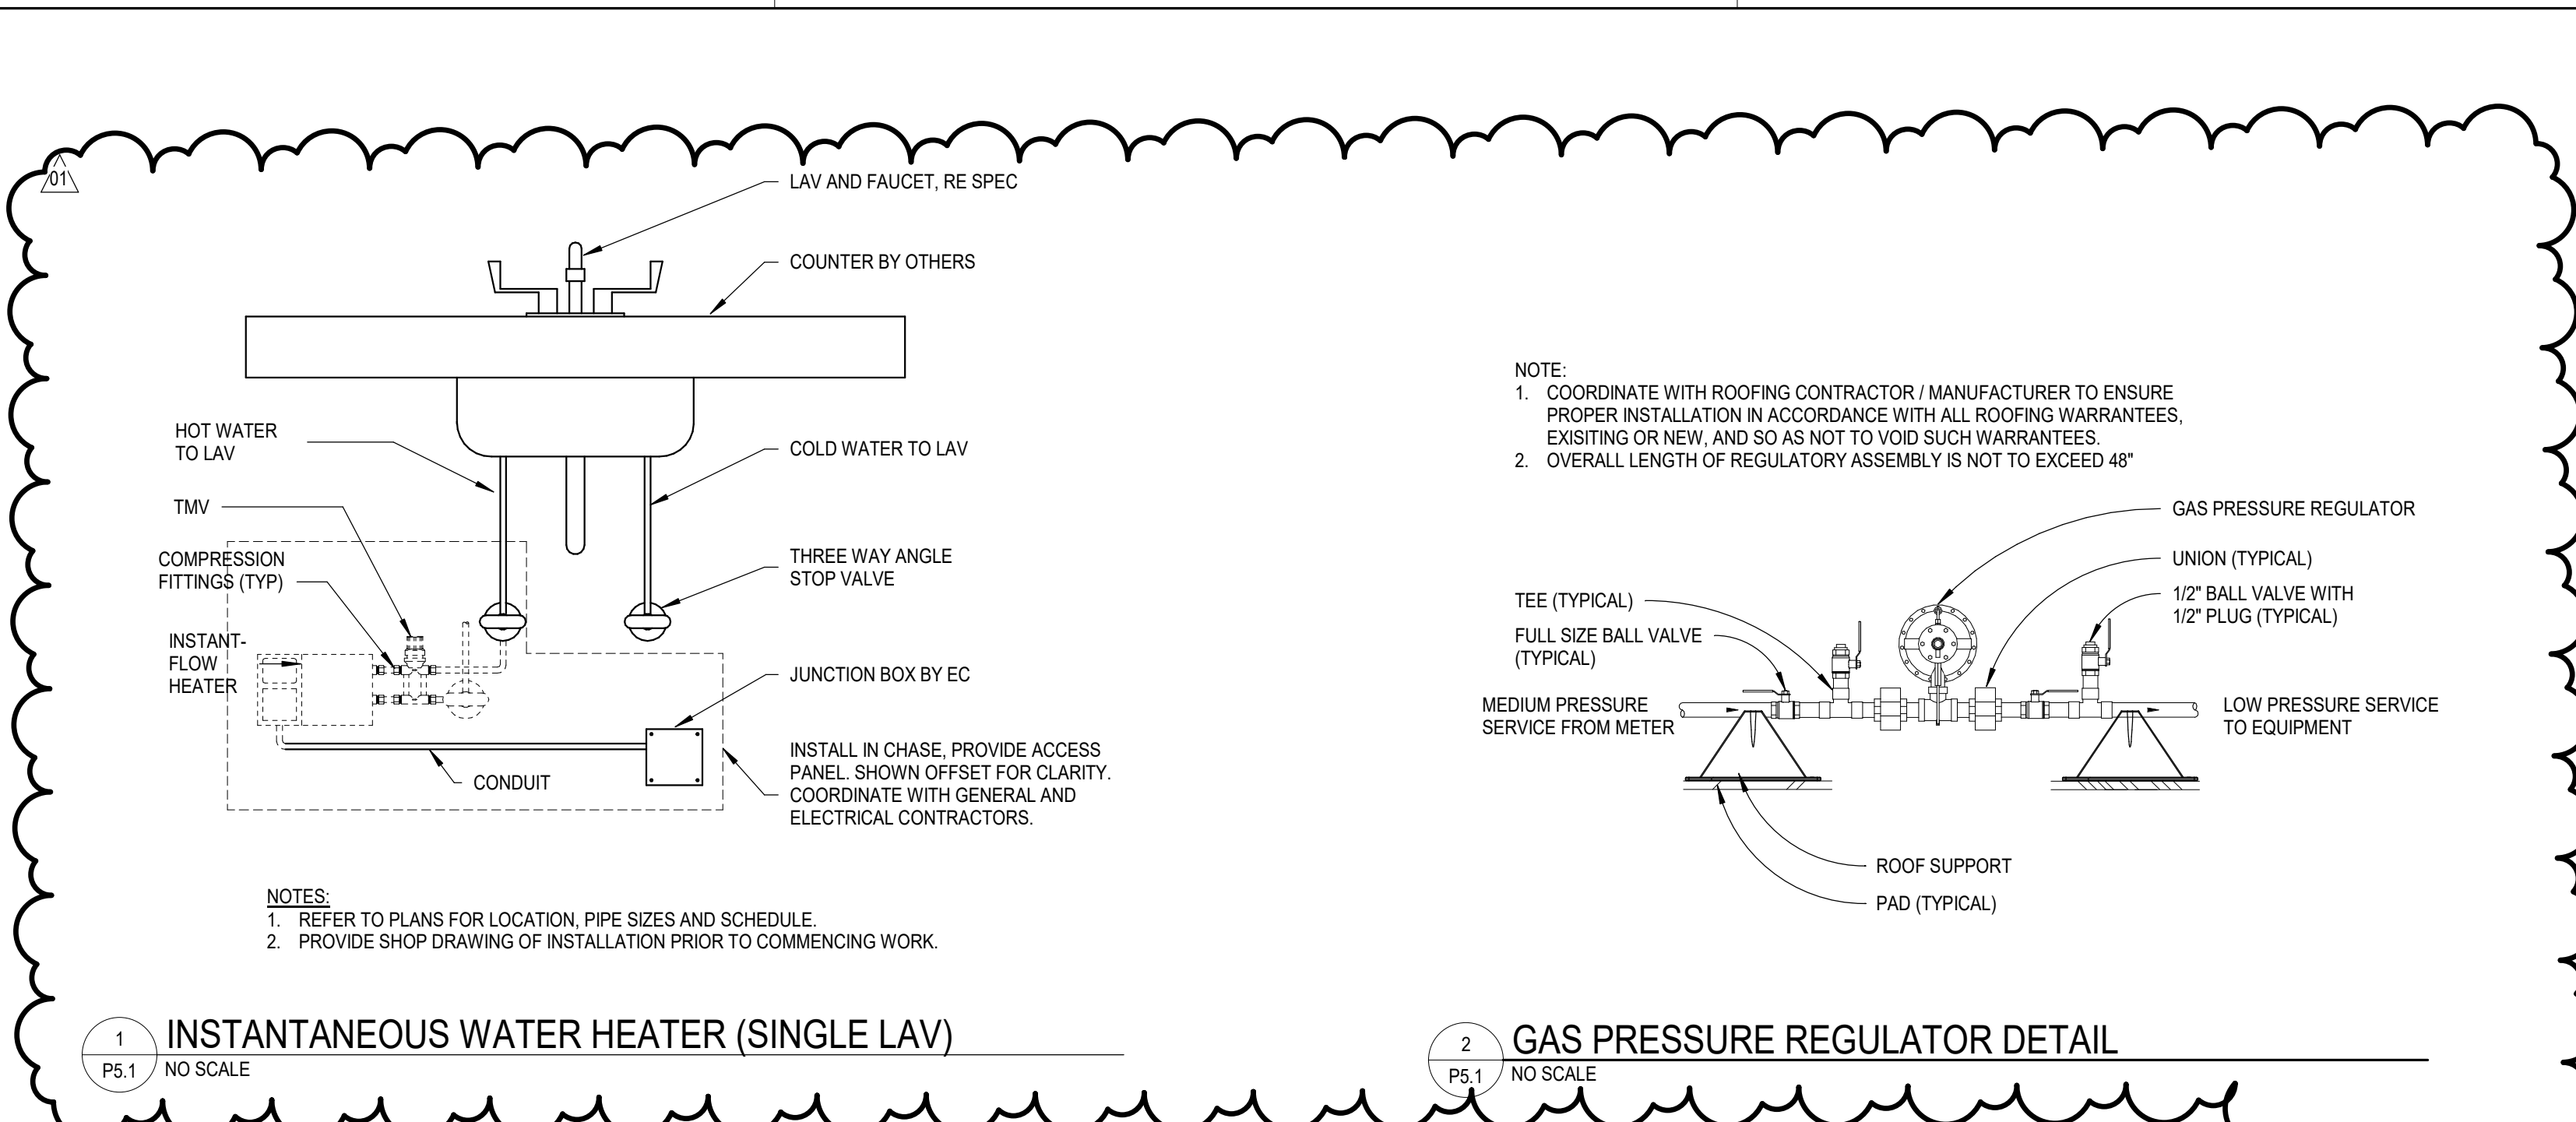

CRANDALL ISD HIGH SCHOOL
PAC ADDITION
13385 Fm 3038, Crandall, TX 75114

ISSUE FOR BID AND PERMIT
2024.07.25
REVISIONS
01 08/19/2024 ADDENDUM 01

39-23712-00
PLUMBING DETAILS

P5.1

Autodesk Docs://99-23712-00 Crandall ISD - PAC/39-23712-00_Crandall ISD_MP_2024.rvt 8/19/2024 5:10:31 PM

DOMESTIC FIXTURE SCHEDULE

NOTES:
1. PROVIDE KEYED ACCESS PANELS FOR VALVES, WATER HEATER, AND TRAP PRIMER DEVICES IN TOILET ROOMS. ACCESS PANELS (AP-1) SHALL BE EQUAL TO WILLIAMS BROTHERS M# MW DWAL 414 SERIES FOR TILE WALLS. DRYWALL ACCESS PANELS TO BE EQUAL TO WILLIAMS BROTHERS M# MW DWAL 415 SERIES.
2. PROVIDE TRAP PRIMER DEVICES WITH SUPPLY DISTRIBUTION ON ALL FLOOR DRAINS, FLOOR SINKS, AND TRENCH DRAINS. TRAP PRIMER TO BE EQUAL TO WATTS LF TP300-DI-DR. INSTALL DISTRIBUTION UNIT AS REQUIRED. CAP OFF ALL UN-USED SUPPLY CONNECTIONS.
4. ALL PUBLIC LAVATORY SINK AND HANDWASH SINK TO BE PROVIDE WITH TEMPER VALVE EQUAL TO LEONARD MODEL # LF-170 SERIES FOR SINGLE LAVATORY AND MODEL # LF-270 SERIES FOR MULTIPLE LAVATORIES.
5.

Table with columns: ID, DESCRIPTION, MATERIAL DESCRIPTION, FINISH, MANUFACTURER, MODEL, TYPE, MOTION SENSOR CONTROL, FLOW FIXTURE (WATER FLOW (GPM), COLD, HOT), PIPE CONNECTION SIZE (IN) (PRIMARY, AUX, INDIRECT), MINIMUM VENT, WATER (COLD, HOT), SPECIFICATION, BASIS OF DESIGN (MANUFACTURER, MODEL), NOTES.

ELECTRIC WATER HEATER SCHEDULE

NOTES:
1. EWH-1 AND EWH-2 REQUIRES TWO (2) 40 AMP CONNECTIONS FOR THE MODEL SELECTED. COORDINATE WITH ELECTRICAL CONTRACTOR.
2. WATER HEATER TO FACTORY SET TO 109 DEGREE F MAXIMUM.
3. WATER HEATER TO FACTORY SET TO 115 DEGREE F MAXIMUM.
4. WATER HEATER TO FACTORY SET TO 120 DEGREE F MAXIMUM.
5. PROVIDE TEMPERATURE LIMITING DEVICE ON HOT WATER SUPPLY TO LAVATORY(IES) SINKS. COMPLY WITH ASSE 1017 AND ASSE 1070.
6. PROVIDE THERMOSTAT MIXING VALVE ON WATER HEATER HOT WATER SUPPLY PIPING. COMPLY WITH ASSE 1017 AND ASSE 1070.

Table with columns: ID, TYPE, HEATING CAPACITY (KW), WATER SIDE DATA (FLOW (GPM), DESIGN, MIN, MAX TEMP RISE), HEATING ELEMENT DATA (KW, SCR), ELECTRICAL DATA (FLA (A), MCA (A), MOCP (A), VOLT (V), PH), BASIS OF DESIGN (MANUFACTURER, MODEL), NOTES.

FLOOR DRAIN SCHEDULE

NOTES:
1. FLOOR DRAINS AND FLOOR SINKS, AND TRENCH DRAINS TO BE PROVIDE WITH 1/2" TRAP PRIMER CONNECTION OR TRAP PRIMER ADAPTER. TRAP PRIMER DEVICE WITH DISTRIBUTION EQUAL TO WATTS MODEL # LF TP300-DR.
2. TRAP BARRIER SEAL DEVICE TO BE EQUAL TO ZURN MODEL # Z1072.

Table with columns: ID, DESCRIPTION, MATERIAL DESCRIPTION (DRAIN BODY, STRAINER), PRIMER CONNECTION, WASTE PIPE SIZE, VENT PIPE SIZE, SPECIFICATION, BASIS OF DESIGN (MANUFACTURER, MODEL), NOTES.

SUMP PUMP SCHEDULE


NOTES:
1. INCLUDES CONTROL PANEL, ASSEE16010 WITH OIL SMART SWITCH, LIQUID SMART SENSOR, AND ALARMS.
2. FURNISH ALL WIRING, CONDUITS, SUPPORTS, AND ASSOCIATED APPURTENANCES FOR COMPLETE INSTALLATION.
3. POWER CORD TYPE. COORDINATE ELECTRICAL OUTLETS WITH ELECTRICAL CONTRACTOR.
4.

Table with columns: ID, SYSTEM NAME, TYPE, PUMP DATA (FLOW (GPM), HEAD (FT), HP, RPM, ECM), BASIN DIMENSIONS (DEPTH (FT-IN), DIA (IN)), ELECTRICAL DATA (FLA (A), MCA (A), MOCP (A), VOLT (V), PH), WEIGHT (LBS), BASIS OF DESIGN (MANUFACTURER, MODEL), NOTES.

STORM DRAIN SCHEDULE

NOTES:
1. ROOF DRAINS TO SHALL CONFORM TO ASME A112.6.4 OR ASME A112.3.1.
2. INSTALL PER MANUFACTURER INSTRUCTIONS.
3.
4.
5.

Table with columns: DESCRIPTION, MATERIAL DESCRIPTION (BODY, STRAINER), SPECIFICATION, BASIS OF DESIGN (MANUFACTURER, MODEL), NOTES.

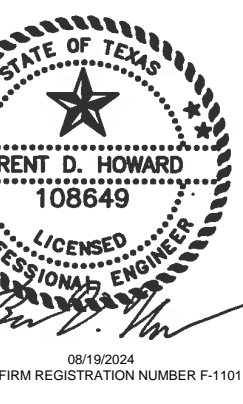

Autodesk Docs://93-23712-00_Crandall ISD - PAC/39-23712-00_Crandall ISD_MP_2024.rvt
8/19/2024 5:10:31 PM

Autodesk Docs://99-23712-00_Crandall_ISD - PAC/39-23712-00_Crandall_ISD_MP_2024.rvt
8/9/2024 4:40:59 PM


1

2

3

4

5

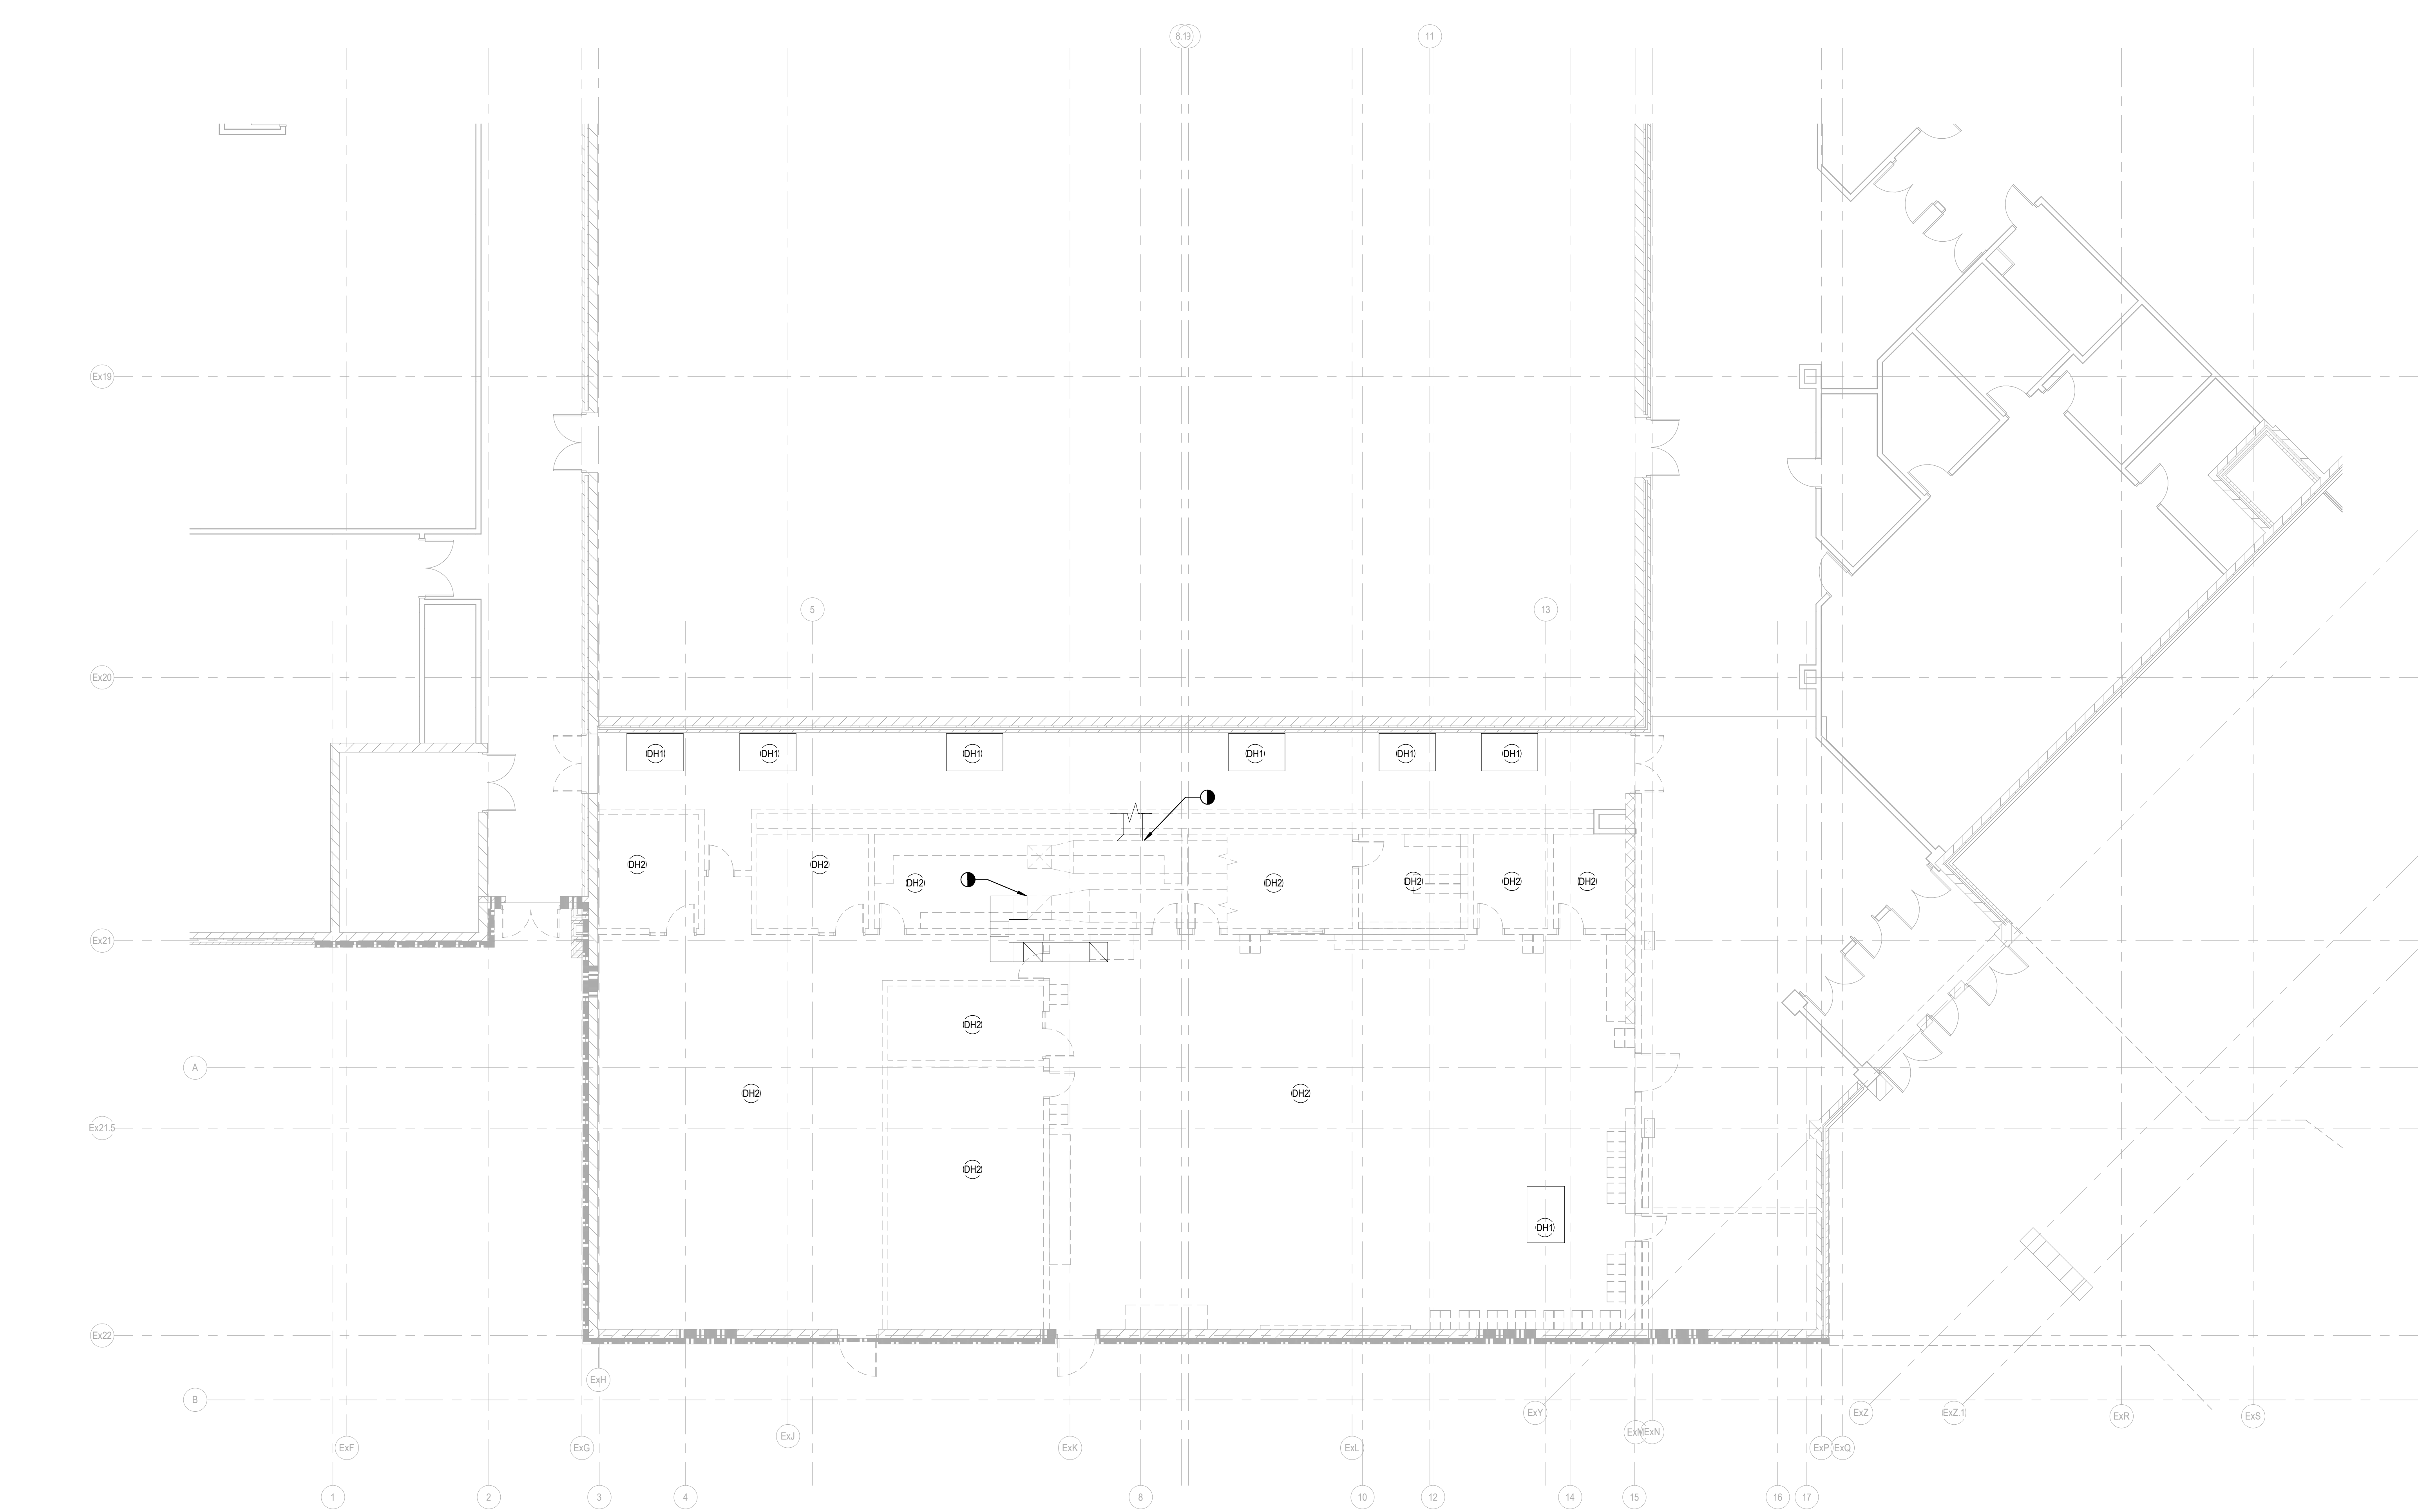

LEVEL 01 - AREA B - HVAC DEMOLITION PLAN
SCALE: 1/8" = 1'-0"



GENERAL NOTES

- A. FULL-TONED EQUIPMENT AND/OR PIPING AND DUCTWORK SHALL BE REMOVED. ALL EQUIPMENT AND/OR PIPING AND DUCTWORK DRAWN HALF-TONED IS EXISTING TO REMAIN AND SHALL BE PROTECTED FROM DAMAGE DURING CONSTRUCTION.
- B. LEAVE ALL SPACES, INCLUDING ALL STRUCTURAL SYSTEMS, ROOM FINISHED, FIXTURES, AND EQUIPMENT (WHETHER BUILT IN OR MOVEABLE) IN THE SAME GENERAL CONDITION AS IT IS FOUND AT THE START OF THE WORK. ALL FIXTURES AND EQUIPMENT MOVED OR DISTURBED IN CONNECTION WITH THE WORK SHALL BE PROPERLY INSTALLED IN THE MANNER CORRESPONDING TO THE ORIGINAL METHOD, AND ALL DAMAGE TO EXISTING FIXTURES, INSULATING MATERIALS, AND EQUIPMENT SHALL BE FULLY REPAIRED.
- C. LOCATION OF EXISTING MECHANICAL SYSTEMS TAKEN FROM COMBINATION OF A FIELD SURVEY AND ORIGINAL DRAWINGS. THE ACTUAL LOCATIONS OF THE DUCTWORK OR PIPING MAY VARY SLIGHTLY DUE TO AS-BUILT CONDITIONS. THE CONTRACTOR SHALL VERIFY THE EXISTING CONDITIONS IN THE FIELD PRIOR TO ORDERING ANY MATERIALS FOR CONSTRUCTION. ANY DUCTWORK OR PIPING TO BE REMOVED SHALL BE REMOVED IN ITS ENTIRETY. NO DUCTWORK OR PIPING SHALL BE ABANDONED IN PLACE UNLESS IT HAS BEEN SPECIFICALLY CALLED OUT TO BE ABANDONED IN PLACE. IF UNEXPECTED CONDITIONS ARE ENCOUNTERED, NOTIFY THE OWNER'S REPRESENTATIVE. THE CONTRACTOR SHALL BEAR THE COSTS OF DAMAGE RESULTING FROM FAILURE TO EXERCISE REASONABLE CARE FOR CONTINUING OPERATIONS WITHOUT NOTIFYING THE OWNER.

SHEET NOTES

- DH1 REMOVE AND DISPOSE OF EXISTING HEAT PUMP UNIT INCLUDING ALL ASSOCIATED PIPING AND CONTROLS.
- DH2 REMOVE AND DISPOSE OF ALL EXISTING DUCTWORK, PIPING, AND AIR DEVICES ASSOCIATED WITH EXISTING HEAT PUMP IN THIS AREA.

KEY PLAN

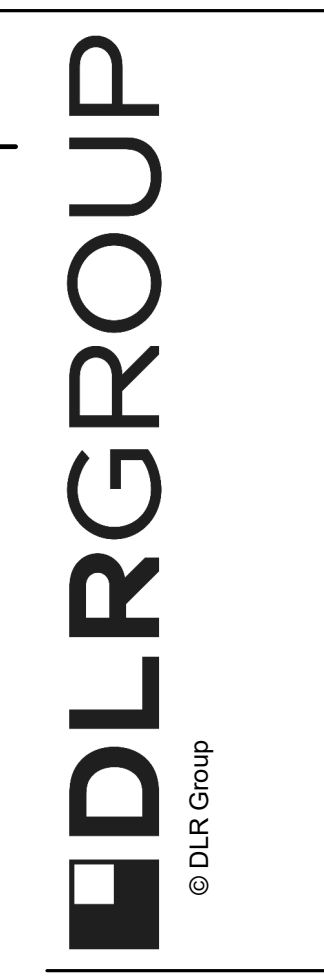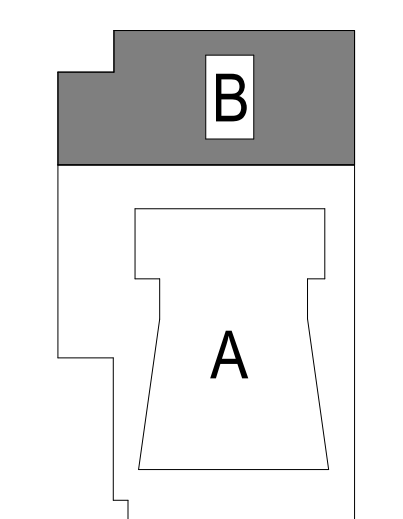

CRANDALL ISD HIGH SCHOOL
PAC ADDITION
13385 Fm 3039, Crandall, TX 75114


ISSUE FOR BID AND PERMIT
2024.07.25
REVISIONS
01 08/20/2024

39-23712-00
LEVEL 01 - AREA B - HVAC DEMOLITION PLAN

MD1.1B

1
2
3
4
5

Autodesk Docs/199-23712-00_Crandall ISD - PAC/39-23712-00_Crandall ISD - M1.1A
8/9/2024 4:40:41 PM

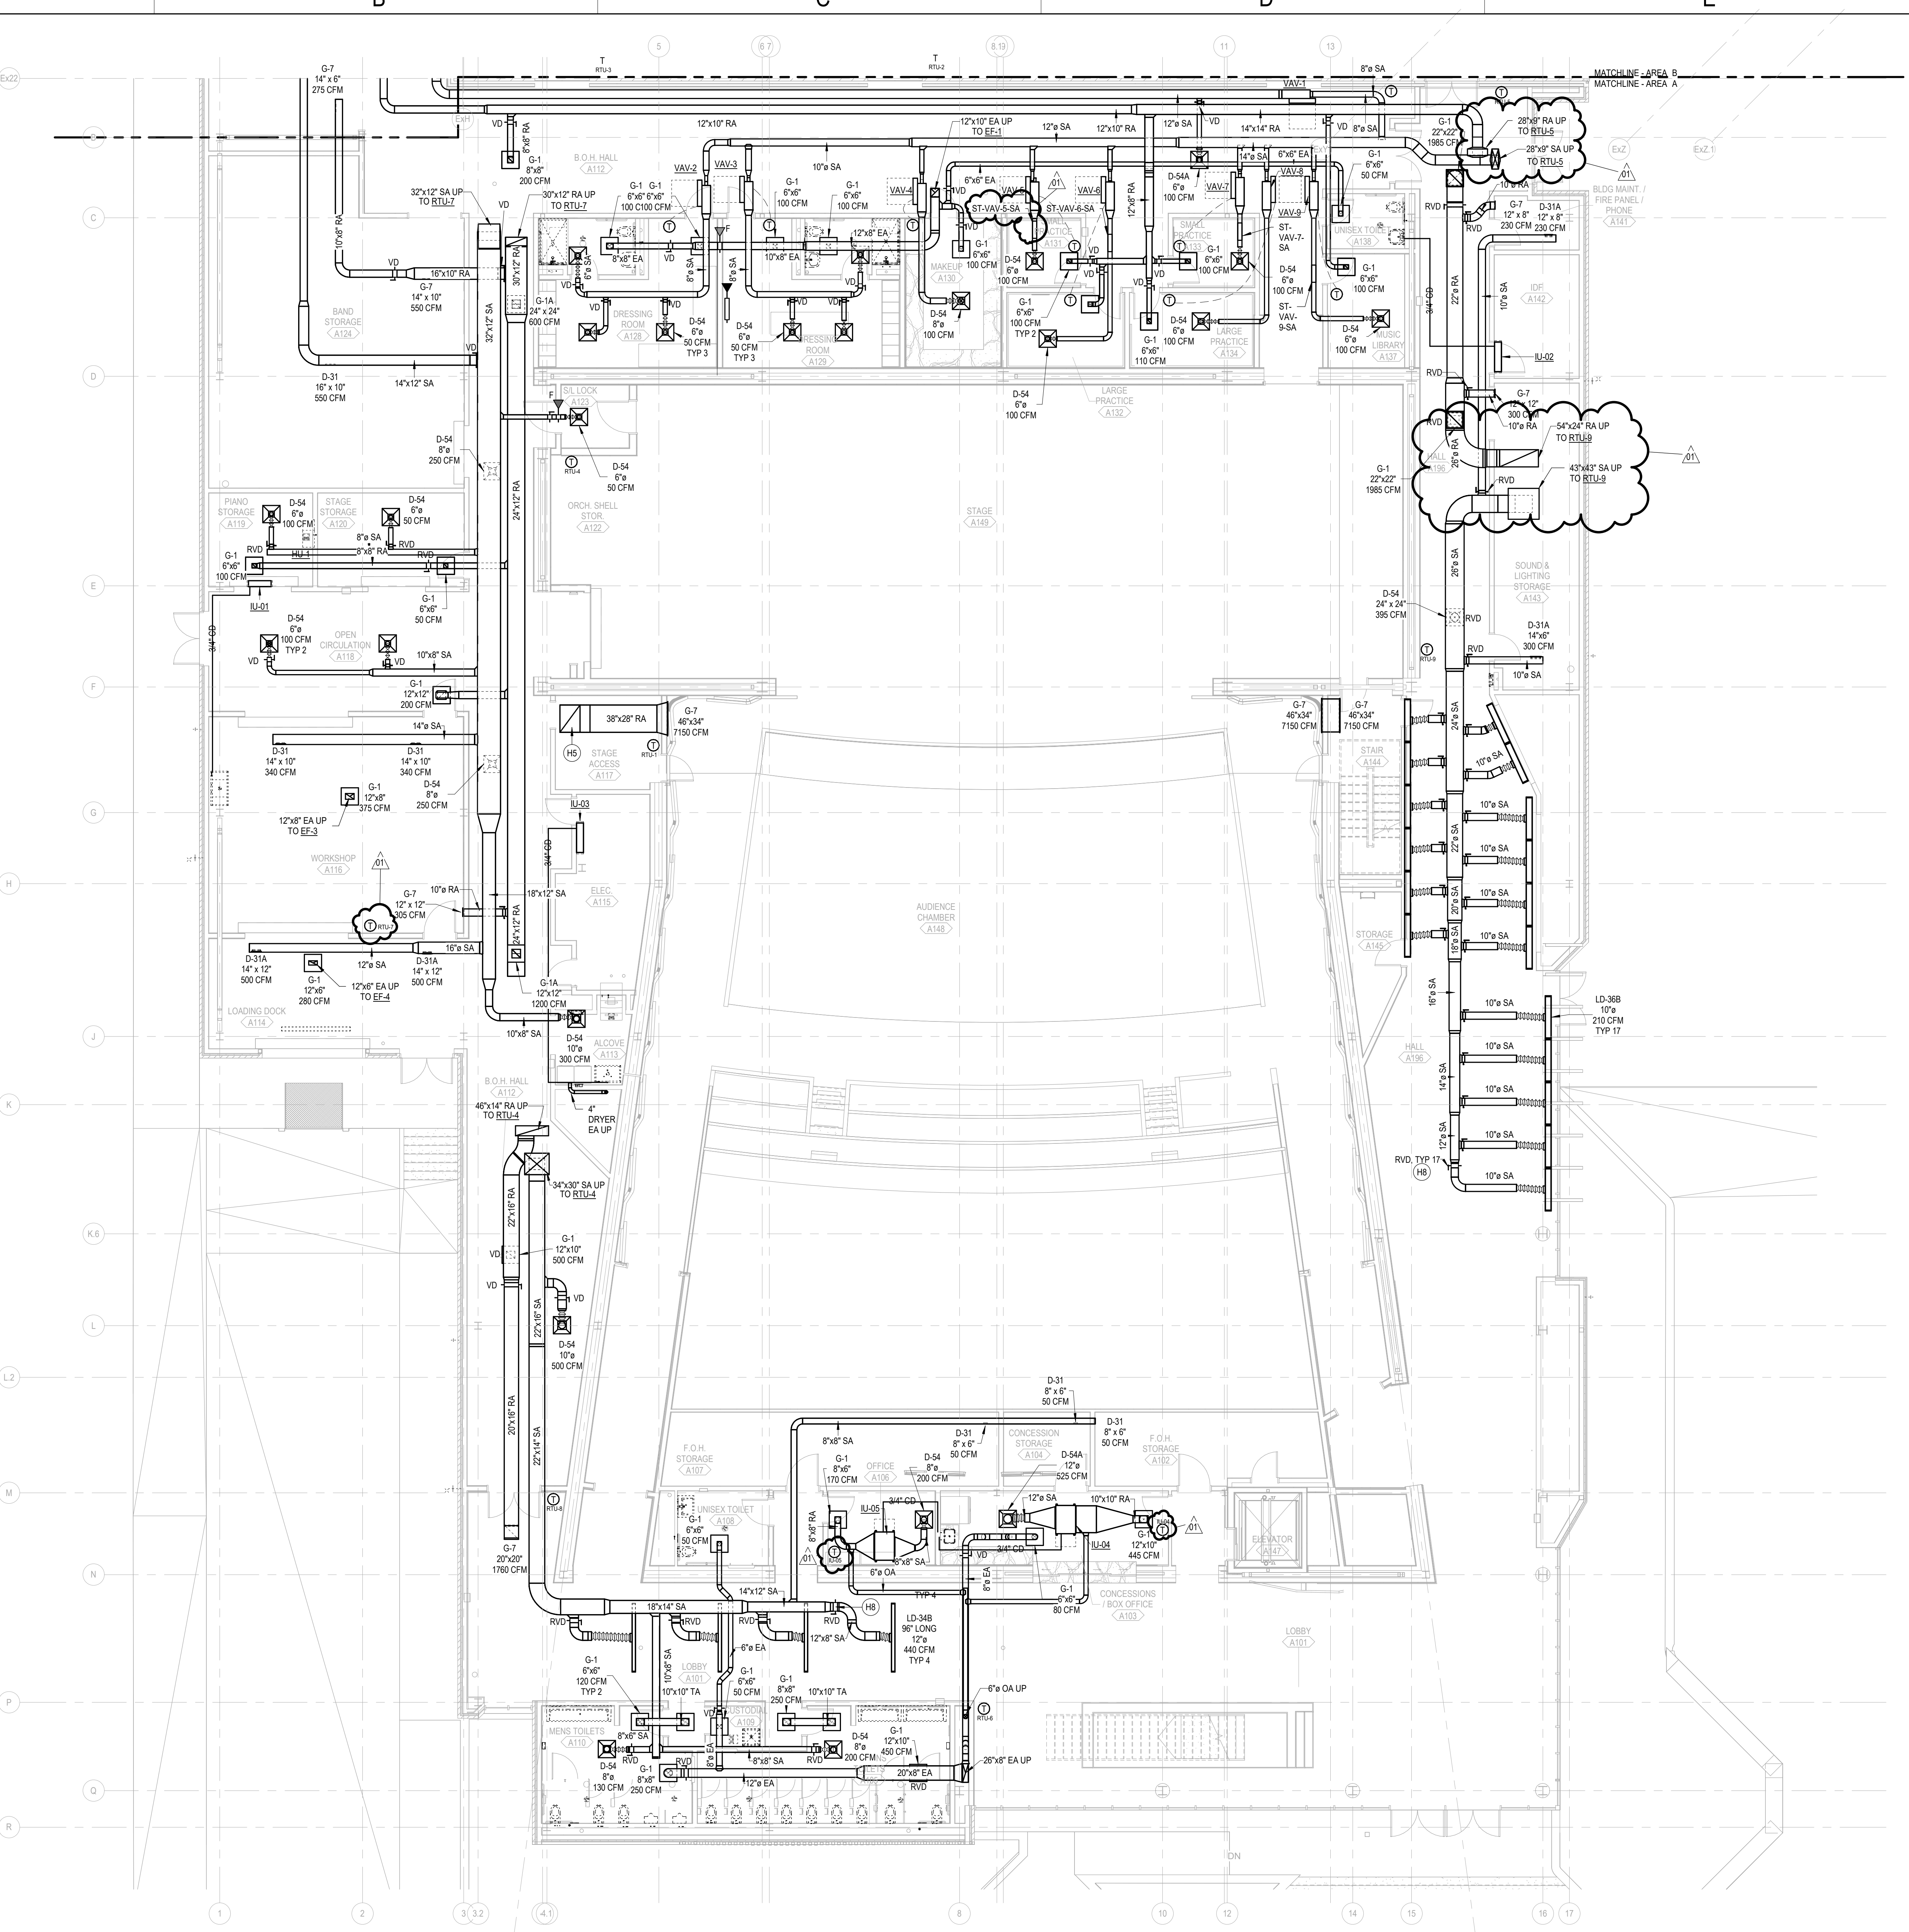

LEVEL 01 - AREA A - HVAC PLAN
SCALE: 1/8" = 1'-0"


GENERAL NOTES

- A. FOR SYMBOLS AND ABBREVIATIONS SEE SHEETS M0.1 AND M0.2.
- B. COORDINATE SPACE TEMPERATURE SENSORS AND THERMOSTAT LOCATIONS TO ALIGN VERTICALLY WITH LIGHT SWITCHES. MOUNT A MINIMUM OF 8" FROM LIGHT SWITCH.
- C. FINAL LOCATIONS OF ALL AIR DEVICES SHALL BE COORDINATED WITH ARCHITECTURAL CEILING FINISHES.
- D. ALL DUCT SIZE NOTES REFER TO CLEAR INSIDE DIMENSION OF DUCT.
- E. FLEXIBLE DUCT SHALL NOT BE LONGER THAN 6'-0".
- F. PROVIDE VOLUME DAMPERS FOR ALL SUPPLY, RETURN, AND EXHAUST.
- G. FIRE SEAL AROUND DUCT AND PIPING PENETRATIONS OF FIRE RATED WALLS.
- H. FOR DIFFUSERS OR GRILLES IN IN-ACCESSIBLE CEILINGS, PROVIDE BALANCE DAMPERS WITH ABILITY TO BE REMOTELY ADJUSTED.
- I. EXPOSED ROUND DUCTS OF DIAMETER 10 INCHES OR LARGER TO BE SPIRAL WOUND.
- J. PROVIDE ALL NEW CONTROLS CAPABLE OF TOTAL INTEGRATION WITH EXISTING BUILDING AUTOMATION SYSTEM THROUGH CLIMATEON. THE NEW SYSTEM SHALL PROVIDE USER ACCESS TO ALL SYSTEM DATA BOTH LOCALLY OVER A SECURE INTRANET WITHIN THE BUILDING AND BY REMOTE ACCESS BY A STANDARD WEB BROWSER OVER THE INTERNET. THIS WILL INCLUDE HVAC CONTROLS, ENERGY MANAGEMENT, ALARM MONITORING, AND ALL TRENDRPORTING FUNCTIONS RELATED TO NORMAL BUILDING OPERATIONS.
- K. ROUTE REFRIGERANT PIPING FROM OUTDOOR UNITS TO ASSOCIATED INDOOR UNITS. REFER TO MANUFACTURER'S INSTRUCTIONS FOR SIZES AND MAX LENGTHS.

SHEET NOTES

- H5 38"x28" RA UP, CONNECTING TO 46"x34" RA. SEE M1.2A FOR CONTINUATION.
- H8 REMOTE ACTUATED VOLUME DAMPER. PROVIDE YOUNG REGULATOR 270-275 OR APPROVED EQUIVALENT. MOUNT ACTUATOR IN PLENUM OF CORRESPONDING LINEAR DIFFUSER.

KEY PLAN

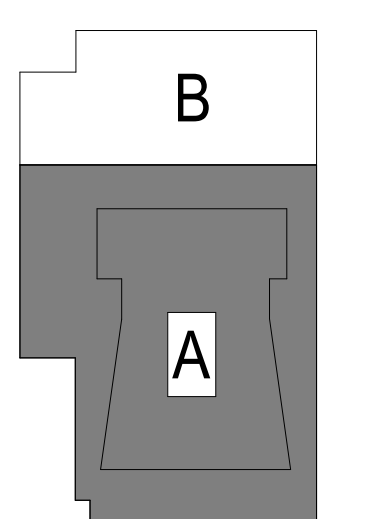

CRANDALL ISD HIGH SCHOOL
PAC ADDITION
13385 Fm 3039, Crandall, TX 75114


ISSUE FOR BID AND PERMIT
2024.07.25
REVISIONS
01 08/20/2024

39-23712-00
LEVEL 01 - AREA A - HVAC PLAN

M1.1A

1
2
3
4
5

Autodesk Docs://99-23712-00_Crandall ISD - PAC/39-23712-00_Crandall ISD - M1.2MA
8/19/2024 4:40:44 PM

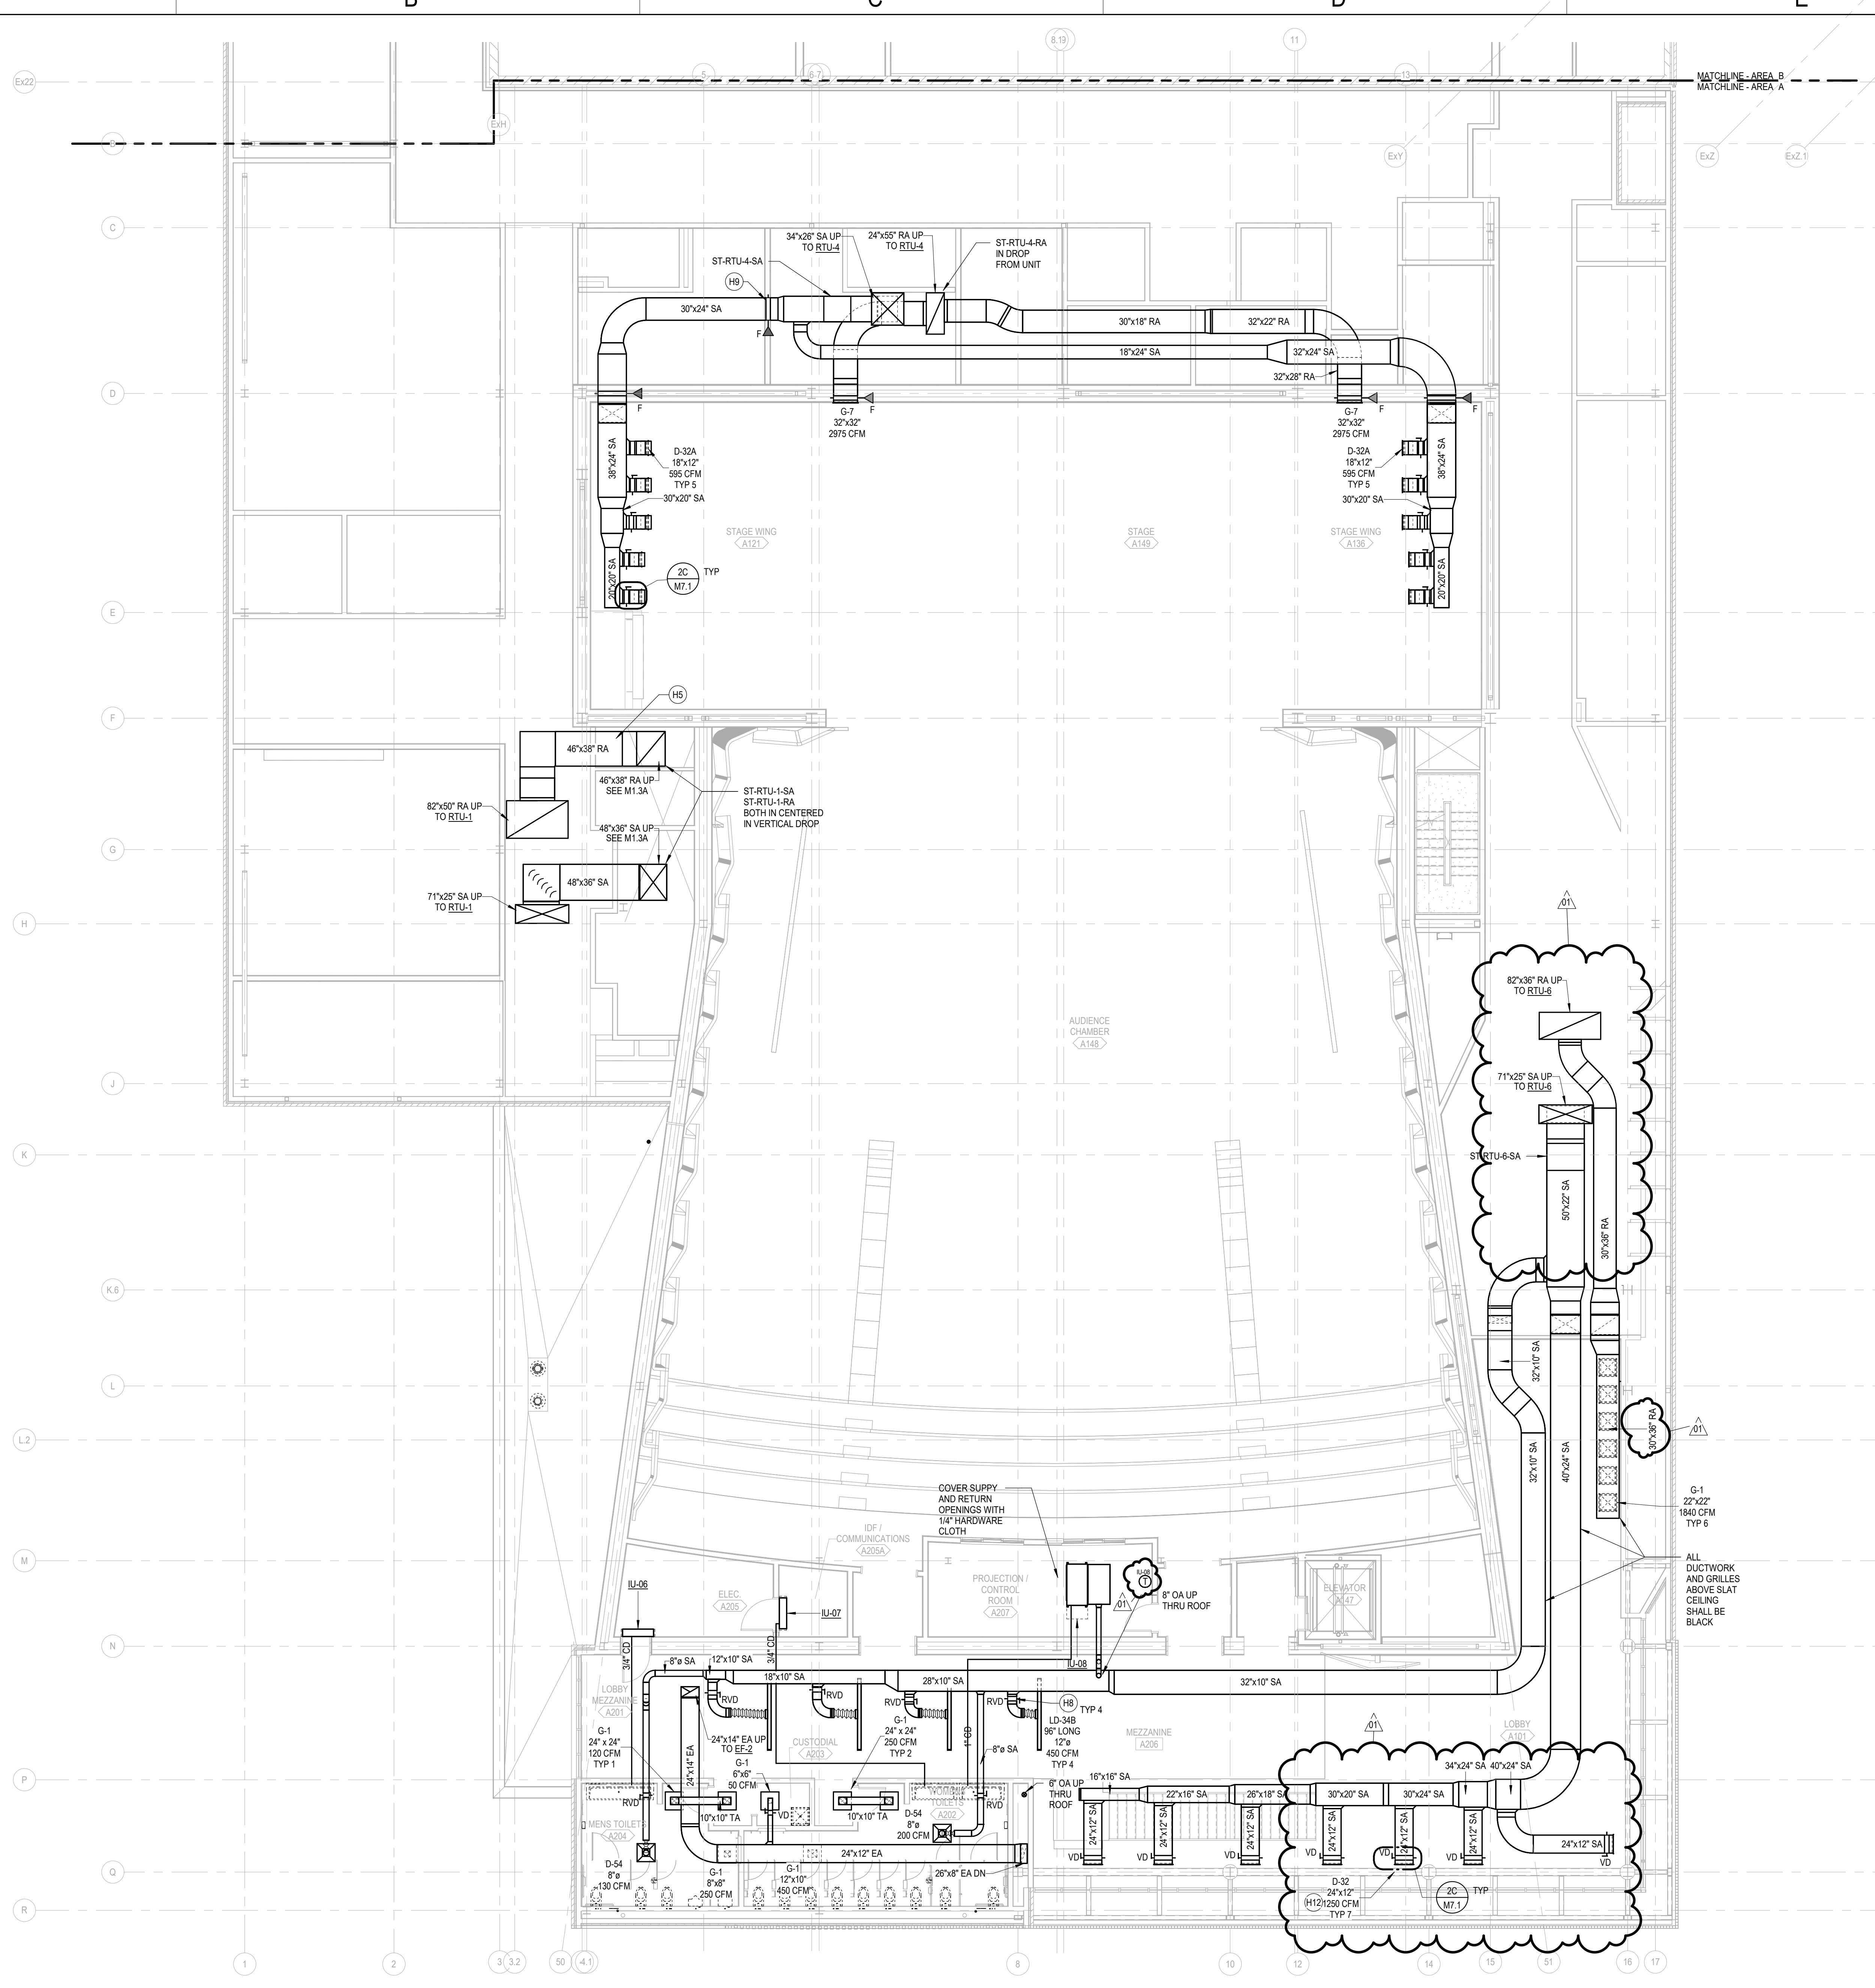

LEVEL 02 MEZZANINE - AREA A - HVAC PLAN
SCALE: 1/8" = 1'-0"



GENERAL NOTES

- A. FOR SYMBOLS AND ABBREVIATIONS SEE SHEETS M0.1 AND M0.2.
- B. COORDINATE SPACE TEMPERATURE SENSORS AND THERMOSTAT LOCATIONS TO ALIGN VERTICALLY WITH LIGHT SWITCHES. MOUNT A MINIMUM OF 8" FROM LIGHT SWITCH.
- C. FINAL LOCATIONS OF ALL AIR DEVICES SHALL BE COORDINATED WITH ARCHITECTURAL CEILING FINISHES.
- D. ALL DUCT SIZE NOTES REFER TO CLEAR INSIDE DIMENSION OF DUCT.
- E. FLEXIBLE DUCT SHALL NOT BE LONGER THAN 6'-0".
- F. PROVIDE VOLUME DAMPERS FOR ALL SUPPLY, RETURN, AND EXHAUST.
- G. FIRE SEAL AROUND DUCT AND PIPING PENETRATIONS OF FIRE RATED WALLS.
- H. FOR DIFFUSERS OR GRILLES IN IN-ACCESSIBLE CEILINGS, PROVIDE BALANCE DAMPERS WITH ABILITY TO BE REMOTELY ADJUSTED.
- I. EXPOSED ROUND DUCTS OF DIAMETER 10 INCHES OR LARGER TO BE SPIRAL WOUND.
- J. PROVIDE ALL NEW CONTROLS CAPABLE OF TOTAL INTEGRATION WITH EXISTING BUILDING AUTOMATION SYSTEM THROUGH CLIMATECH. THE NEW SYSTEM SHALL PROVIDE USER ACCESS TO ALL SYSTEM DATA BOTH LOCALLY OVER A SECURE INTRANET WITHIN THE BUILDING AND BY REMOTE ACCESS BY A STANDARD WEB BROWSER OVER THE INTERNET. THIS WILL INCLUDE HVAC CONTROLS, ENERGY MANAGEMENT, ALARM MONITORING, AND ALL TRENDRPT/REPORTING FUNCTIONS RELATED TO NORMAL BUILDING OPERATIONS.
- K. ROUTE REFRIGERANT PIPING FROM OUTDOOR UNITS TO ASSOCIATED INDOOR UNITS REFER TO MANUFACTURER'S INSTRUCTIONS FOR SIZES AND MAX LENGTHS.

SHEET NOTES

- H5 38"x28" RA UP, CONNECTING TO 46"x38" RA. SEE M1.2A FOR CONTINUATION.
- H8 REMOTE ACTUATED VOLUME DAMPER. PROVIDE YOUNG REGULATOR 270-275 OR APPROVED EQUIVALENT. MOUNT ACTUATOR IN PLENUM OF CORRESPONDING LINEAR DIFFUSER.
- H9 PROVIDE FIRE DAMPER FOR BOTH SUPPLY AND RETURN PENETRATION THROUGH WALL.
- H12 ADJUST GRILLE TO THROW DOWN AT 30 DEGREES.

KEY PLAN

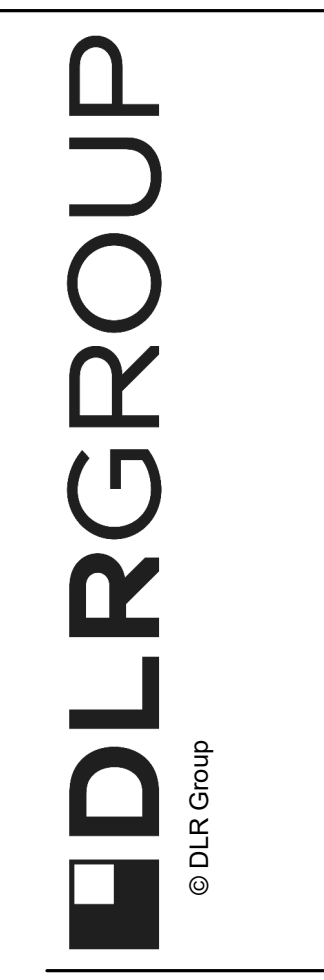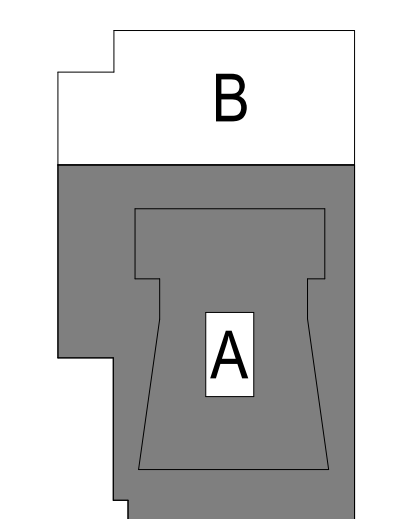

CRANDALL ISD HIGH SCHOOL
PAC ADDITION
13385 Fm 3038, Crandall, TX 75114


ISSUE FOR BID AND PERMIT
2024.07.25
REVISIONS
01 08/20/2024

39-23712-00
LEVEL 02
MEZZANINE -
AREA A - HVAC
PLAN

M1.2MA

1
2
3
4
5

Autodesk Docs/159-23712-00_Crandall ISD - PAC/39-23712-00_Crandall ISD_MP_2024.rvt
8/9/2024 4:40:50 PM

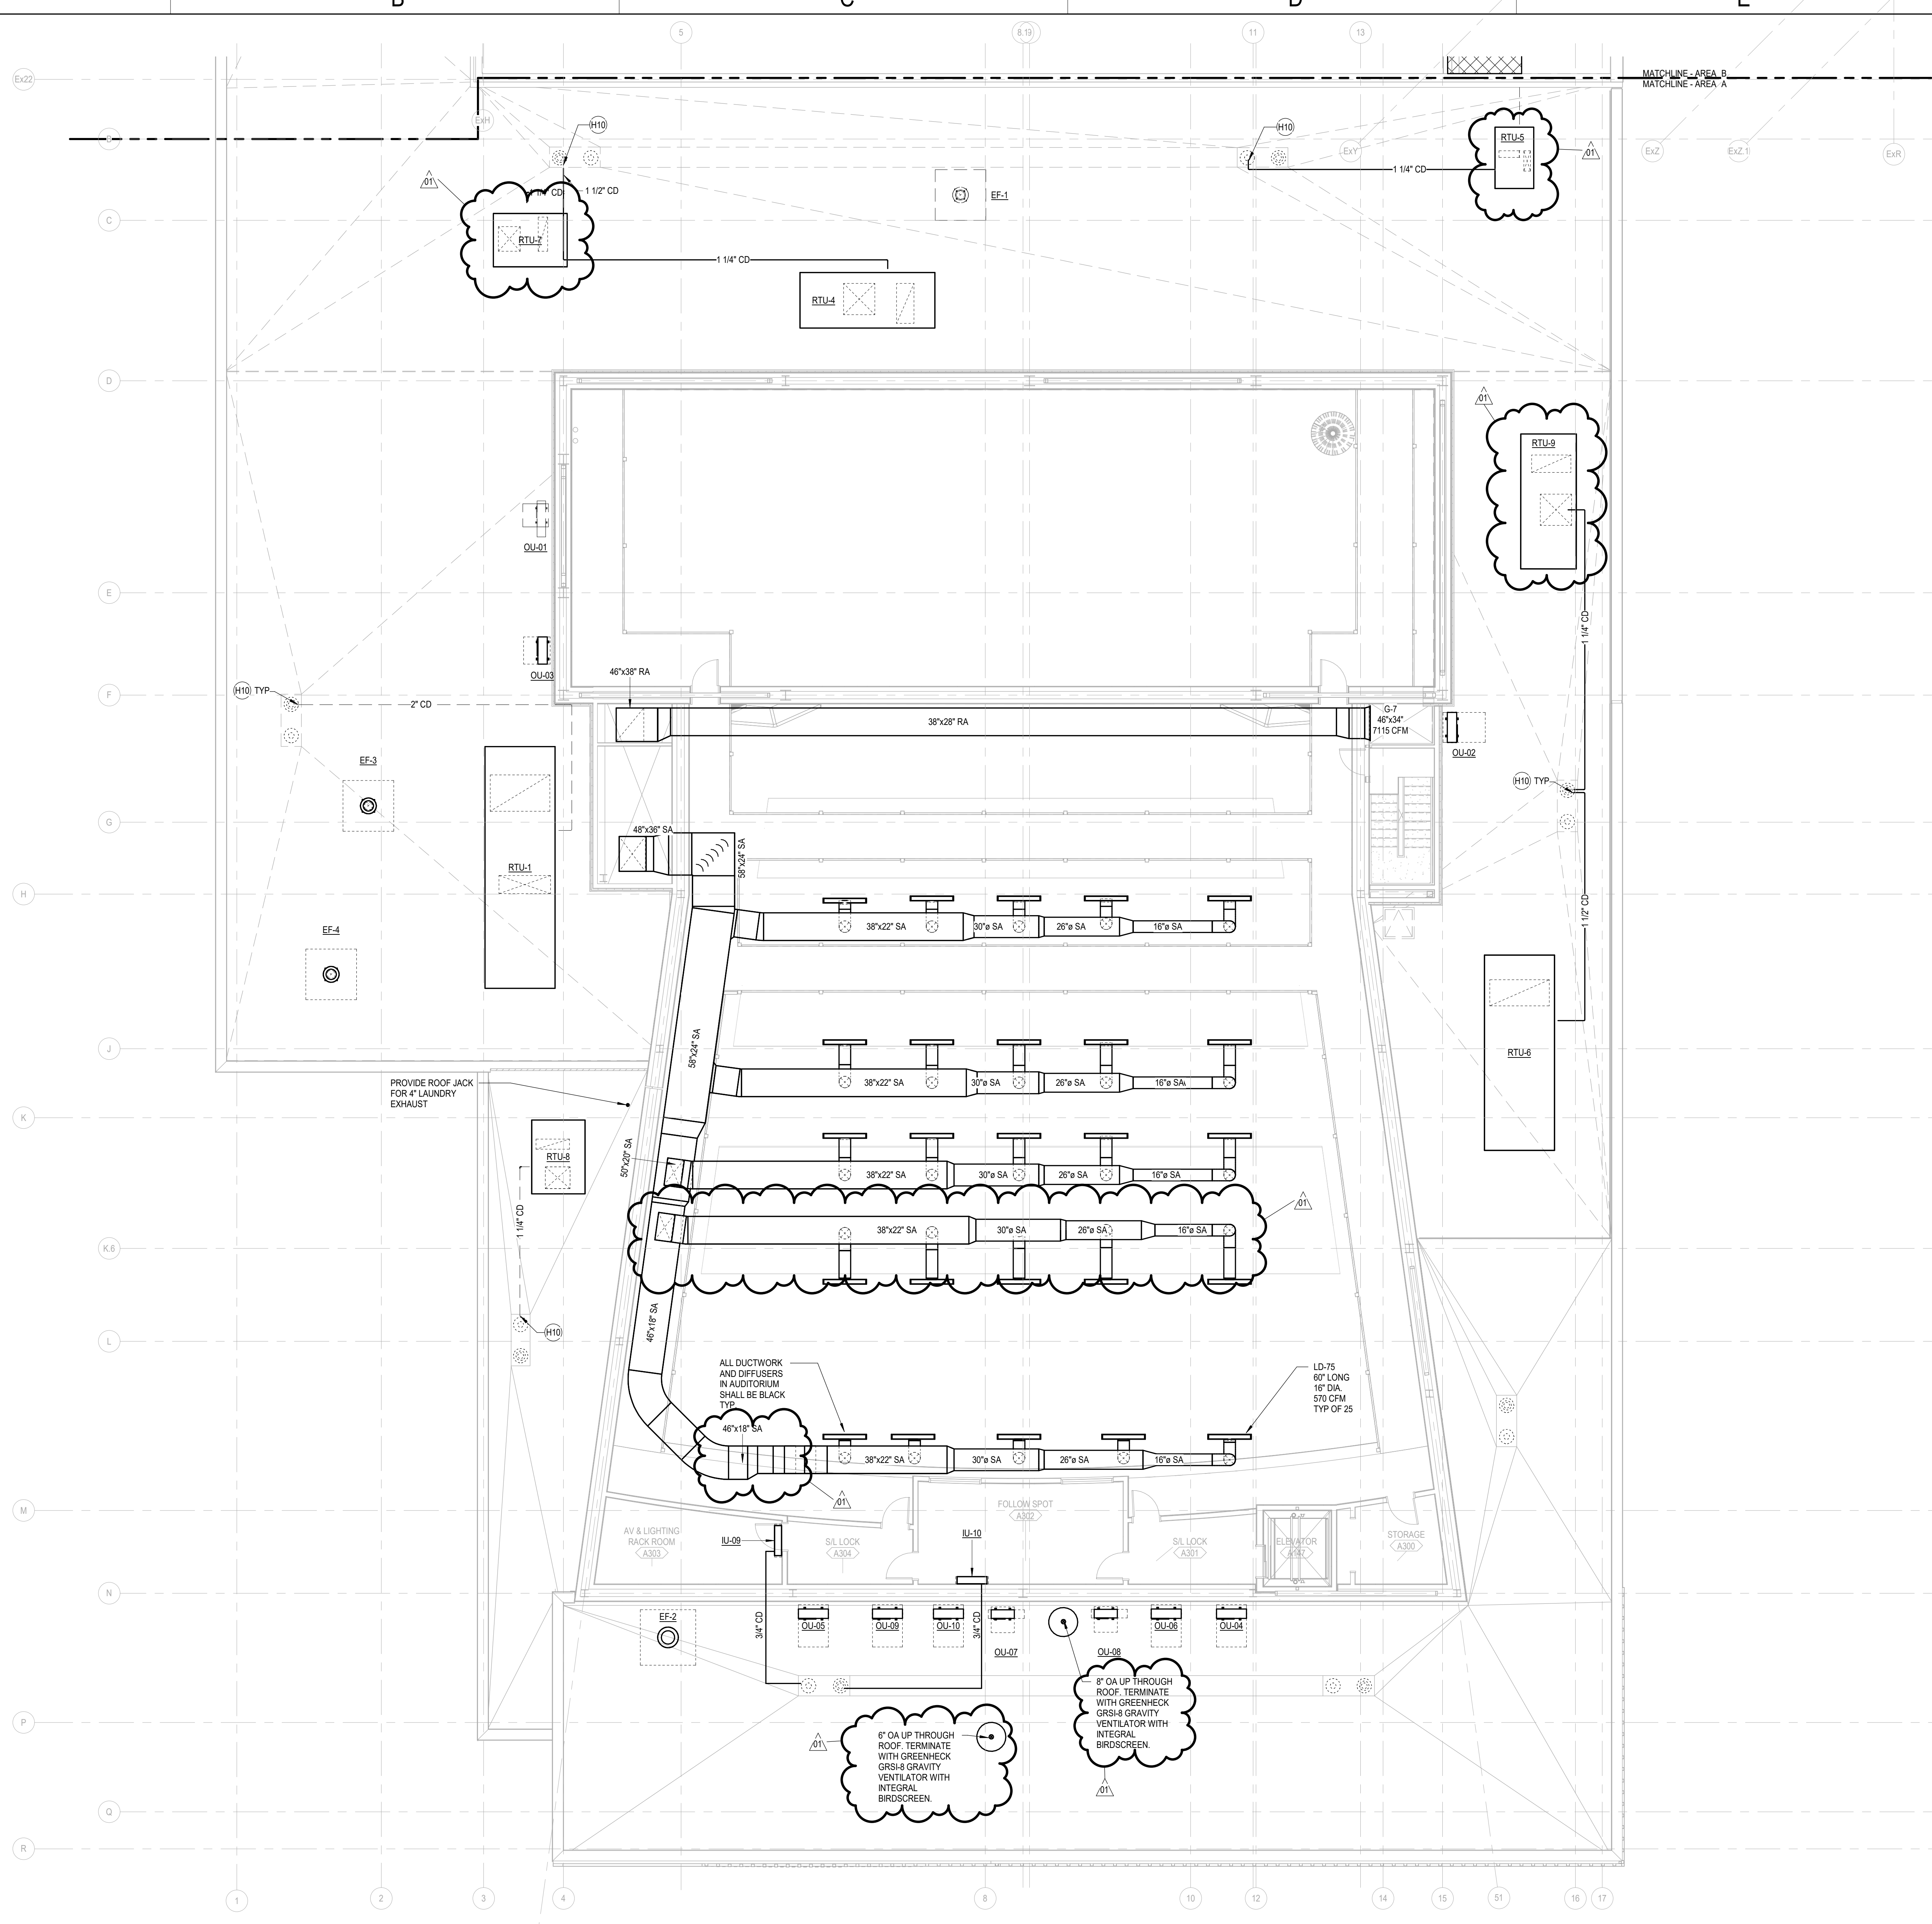

LEVEL 03 - AREA A - ROOF MECHANICAL PLAN
SCALE: 1/8" = 1'-0"




GENERAL NOTES

- A. FOR SYMBOLS AND ABBREVIATIONS SEE SHEETS M0.1 AND M0.2.
- B. COORDINATE SPACE TEMPERATURE SENSORS AND THERMOSTAT LOCATIONS TO ALIGN VERTICALLY WITH LIGHT SWITCHES. MOUNT A MINIMUM OF 8" FROM LIGHT SWITCH.
- C. FINAL LOCATIONS OF ALL AIR DEVICES SHALL BE COORDINATED WITH ARCHITECTURAL CEILING FINISHES.
- D. ALL DUCT SIZE NOTES REFER TO CLEAR INSIDE DIMENSION OF DUCT.
- E. FLEXIBLE DUCT SHALL NOT BE LONGER THAN 6'-0".
- F. PROVIDE VOLUME DAMPERS FOR ALL SUPPLY, RETURN, AND EXHAUST.
- G. FIRE SEAL AROUND DUCT AND PIPING PENETRATIONS OF FIRE RATED WALLS.
- H. FOR DIFFUSERS OR GRILLES IN IN-ACCESSIBLE CEILINGS, PROVIDE BALANCE DAMPERS WITH ABILITY TO BE REMOTELY ADJUSTED.
- I. EXPOSED ROUND DUCTS OF DIAMETER 10 INCHES OR LARGER TO BE SPIRAL WOUND.
- J. PROVIDE ALL NEW CONTROLS CAPABLE OF TOTAL INTEGRATION WITH EXISTING BUILDING AUTOMATION SYSTEM THROUGH CLIMATECH. THE NEW SYSTEM SHALL PROVIDE USER ACCESS TO ALL SYSTEM DATA BOTH LOCALLY OVER A SECURE INTRANET WITHIN THE BUILDING AND BY REMOTE ACCESS BY A STANDARD WEB BROWSER OVER THE INTERNET. THIS WILL INCLUDE HVAC CONTROLS, ENERGY MANAGEMENT, ALARM MONITORING, AND ALL TRENDRPT/REPORTING FUNCTIONS RELATED TO NORMAL BUILDING OPERATIONS.
- K. ROUTE REFRIGERANT PIPING FROM OUTDOOR UNITS TO ASSOCIATED INDOOR UNITS. REFER TO MANUFACTURER'S INSTRUCTIONS FOR SIZES AND MAX LENGTHS.

SHEET NOTES

- H10 ROUTE CONDENSATE LINE TO NEAREST ROOF DRAIN AND TERMINATE WITH 1" AIR GAP.

KEY PLAN

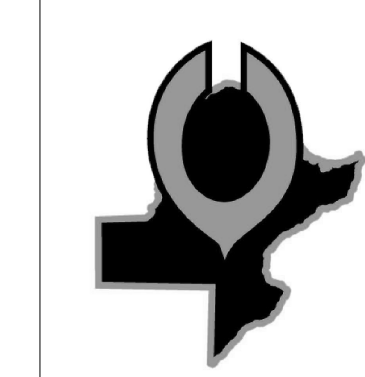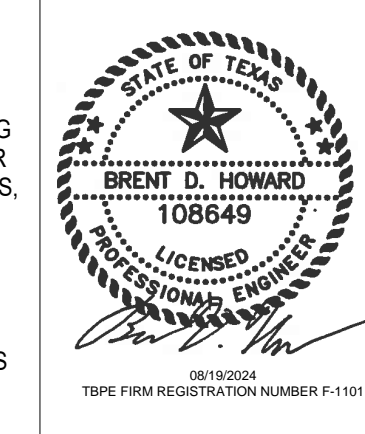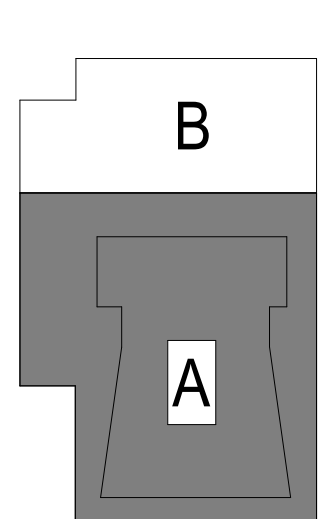


CRANDALL ISD HIGH SCHOOL
PAC ADDITION
13385 Fm 3038, Crandall, TX 75114

ISSUE FOR BID AND PERMIT
2024.07.25
REVISIONS
01 08/20/2024

39-23712-00
LEVEL 03 - AREA A - ROOF MECHANICAL PLAN

M1.3A


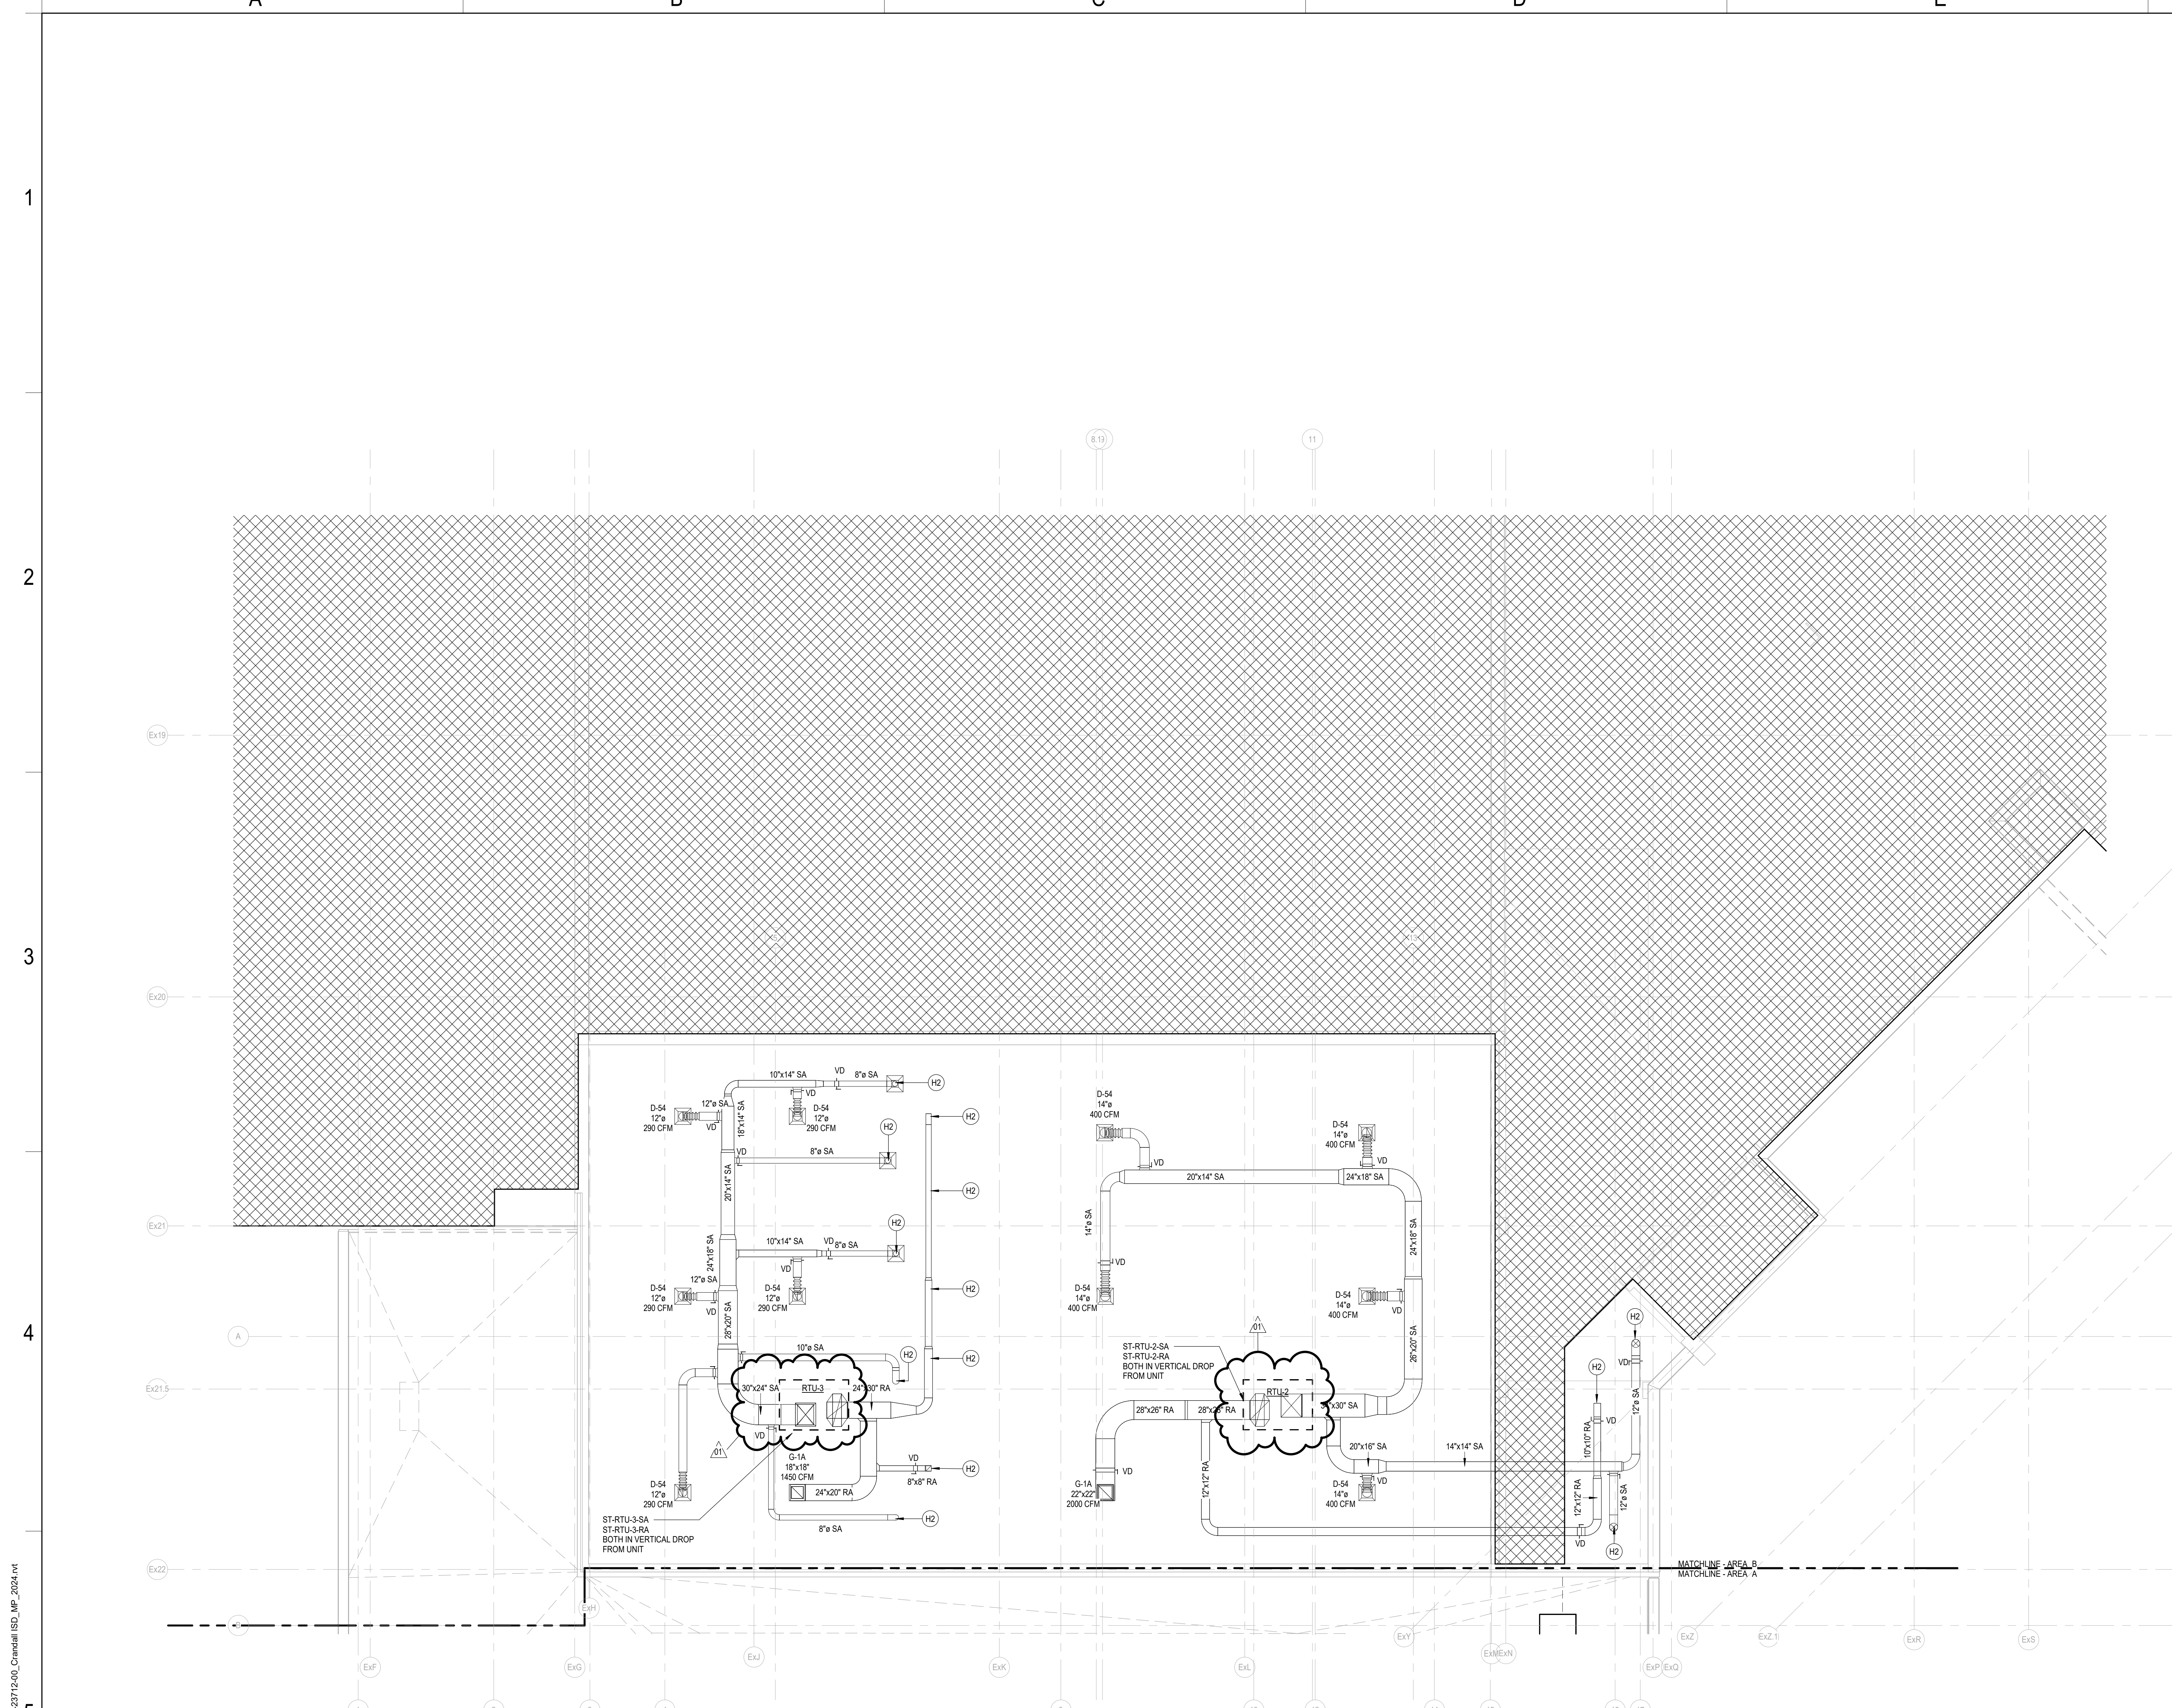


GENERAL NOTES

- A. FOR SYMBOLS AND ABBREVIATIONS SEE SHEETS M0.1 AND M0.2.
- B. COORDINATE SPACE TEMPERATURE SENSORS AND THERMOSTAT LOCATIONS TO ALIGN VERTICALLY WITH LIGHT SWITCHES. MOUNT A MINIMUM OF 8" FROM LIGHT SWITCH.
- C. FINAL LOCATIONS OF ALL AIR DEVICES SHALL BE COORDINATED WITH ARCHITECTURAL CEILING FINISHES.
- D. ALL DUCT SIZE NOTES REFER TO CLEAR INSIDE DIMENSION OF DUCT.
- E. FLEXIBLE DUCT SHALL NOT BE LONGER THAN 6'-0".
- F. PROVIDE VOLUME DAMPERS FOR ALL SUPPLY, RETURN, AND EXHAUST.
- G. FIRE SEAL AROUND DUCT AND PIPING PENETRATIONS OF FIRE RATED WALLS.
- H. FOR DIFFUSERS OR GRILLES IN INACCESSIBLE CEILINGS, PROVIDE BALANCE DAMPERS WITH ABILITY TO BE REMOTELY ADJUSTED.
- I. EXPOSED ROUND DUCTS OF DIAMETER 10 INCHES OR LARGER TO BE SPIRAL WOUND.
- J. PROVIDE ALL NEW CONTROLS CAPABLE OF TOTAL INTEGRATION WITH EXISTING BUILDING AUTOMATION SYSTEM THROUGH CLIMATECH. THE NEW SYSTEM SHALL PROVIDE USER ACCESS TO ALL SYSTEM DATA BOTH LOCALLY OVER A SECURE INTRANET WITHIN THE BUILDING AND BY REMOTE ACCESS BY A STANDARD WEB BROWSER OVER THE INTERNET. THIS WILL INCLUDE HVAC CONTROLS, ENERGY MANAGEMENT, ALARM MONITORING, AND ALL TRENDRPT/REPORTING FUNCTIONS RELATED TO NORMAL BUILDING OPERATIONS.
- K. ROUTE REFRIGERANT PIPING FROM OUTDOOR UNITS TO ASSOCIATED INDOOR UNITS. REFER TO MANUFACTURER'S INSTRUCTIONS FOR SIZES AND MAX LENGTHS.

SHEET NOTES


- H2 DUCTWORK DOWN THROUGH TO NEXT LEVEL.

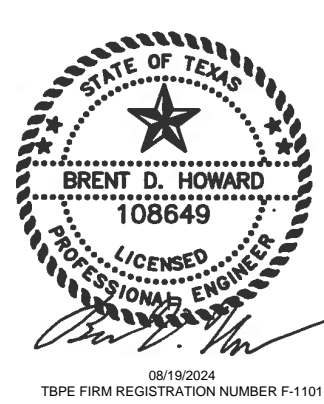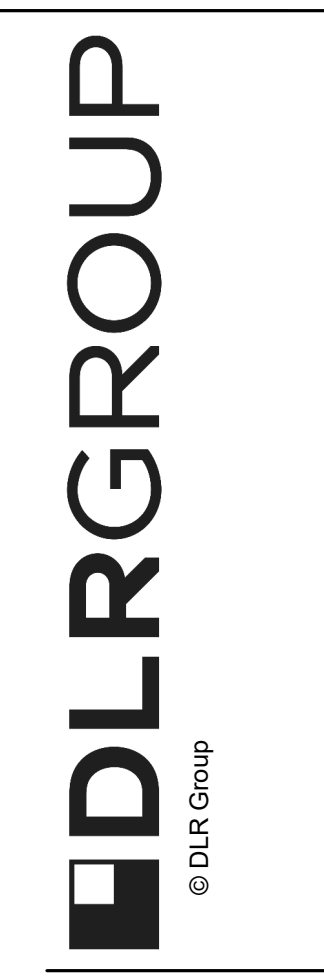

CRANDALL ISD HIGH SCHOOL
 PAC ADDITION
 13385 Fm 3038, Crandall, TX 75114

ISSUE FOR BID AND PERMIT
 2024.07.25
 REVISIONS
 01 08/20/2024

KEY PLAN

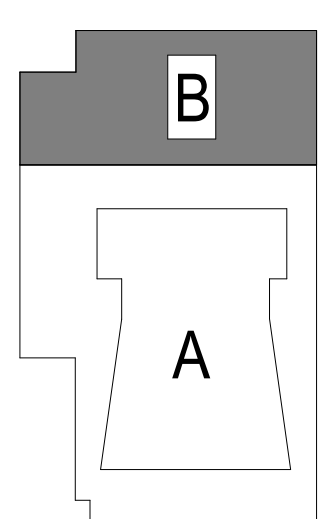


LEVEL 03 - AREA B - ROOF MECHANICAL PLAN
 SCALE: 1/8" = 1'-0"

Autodesk Docs://99-23712-00_Crandall ISD - PAC/39-23712-00_Crandall ISD_MP_2024.rvt
 8/9/2024 4:40:52 PM

39-23712-00
 LEVEL 03 - AREA B - MECHANICAL PLAN
M1.3B

Autodesk Docs://99-23712-00_Crandall_ISD - PAC/39-23712-00_Crandall_ISD_MP_2024.rvt
 8/19/2024 4:40:52 PM

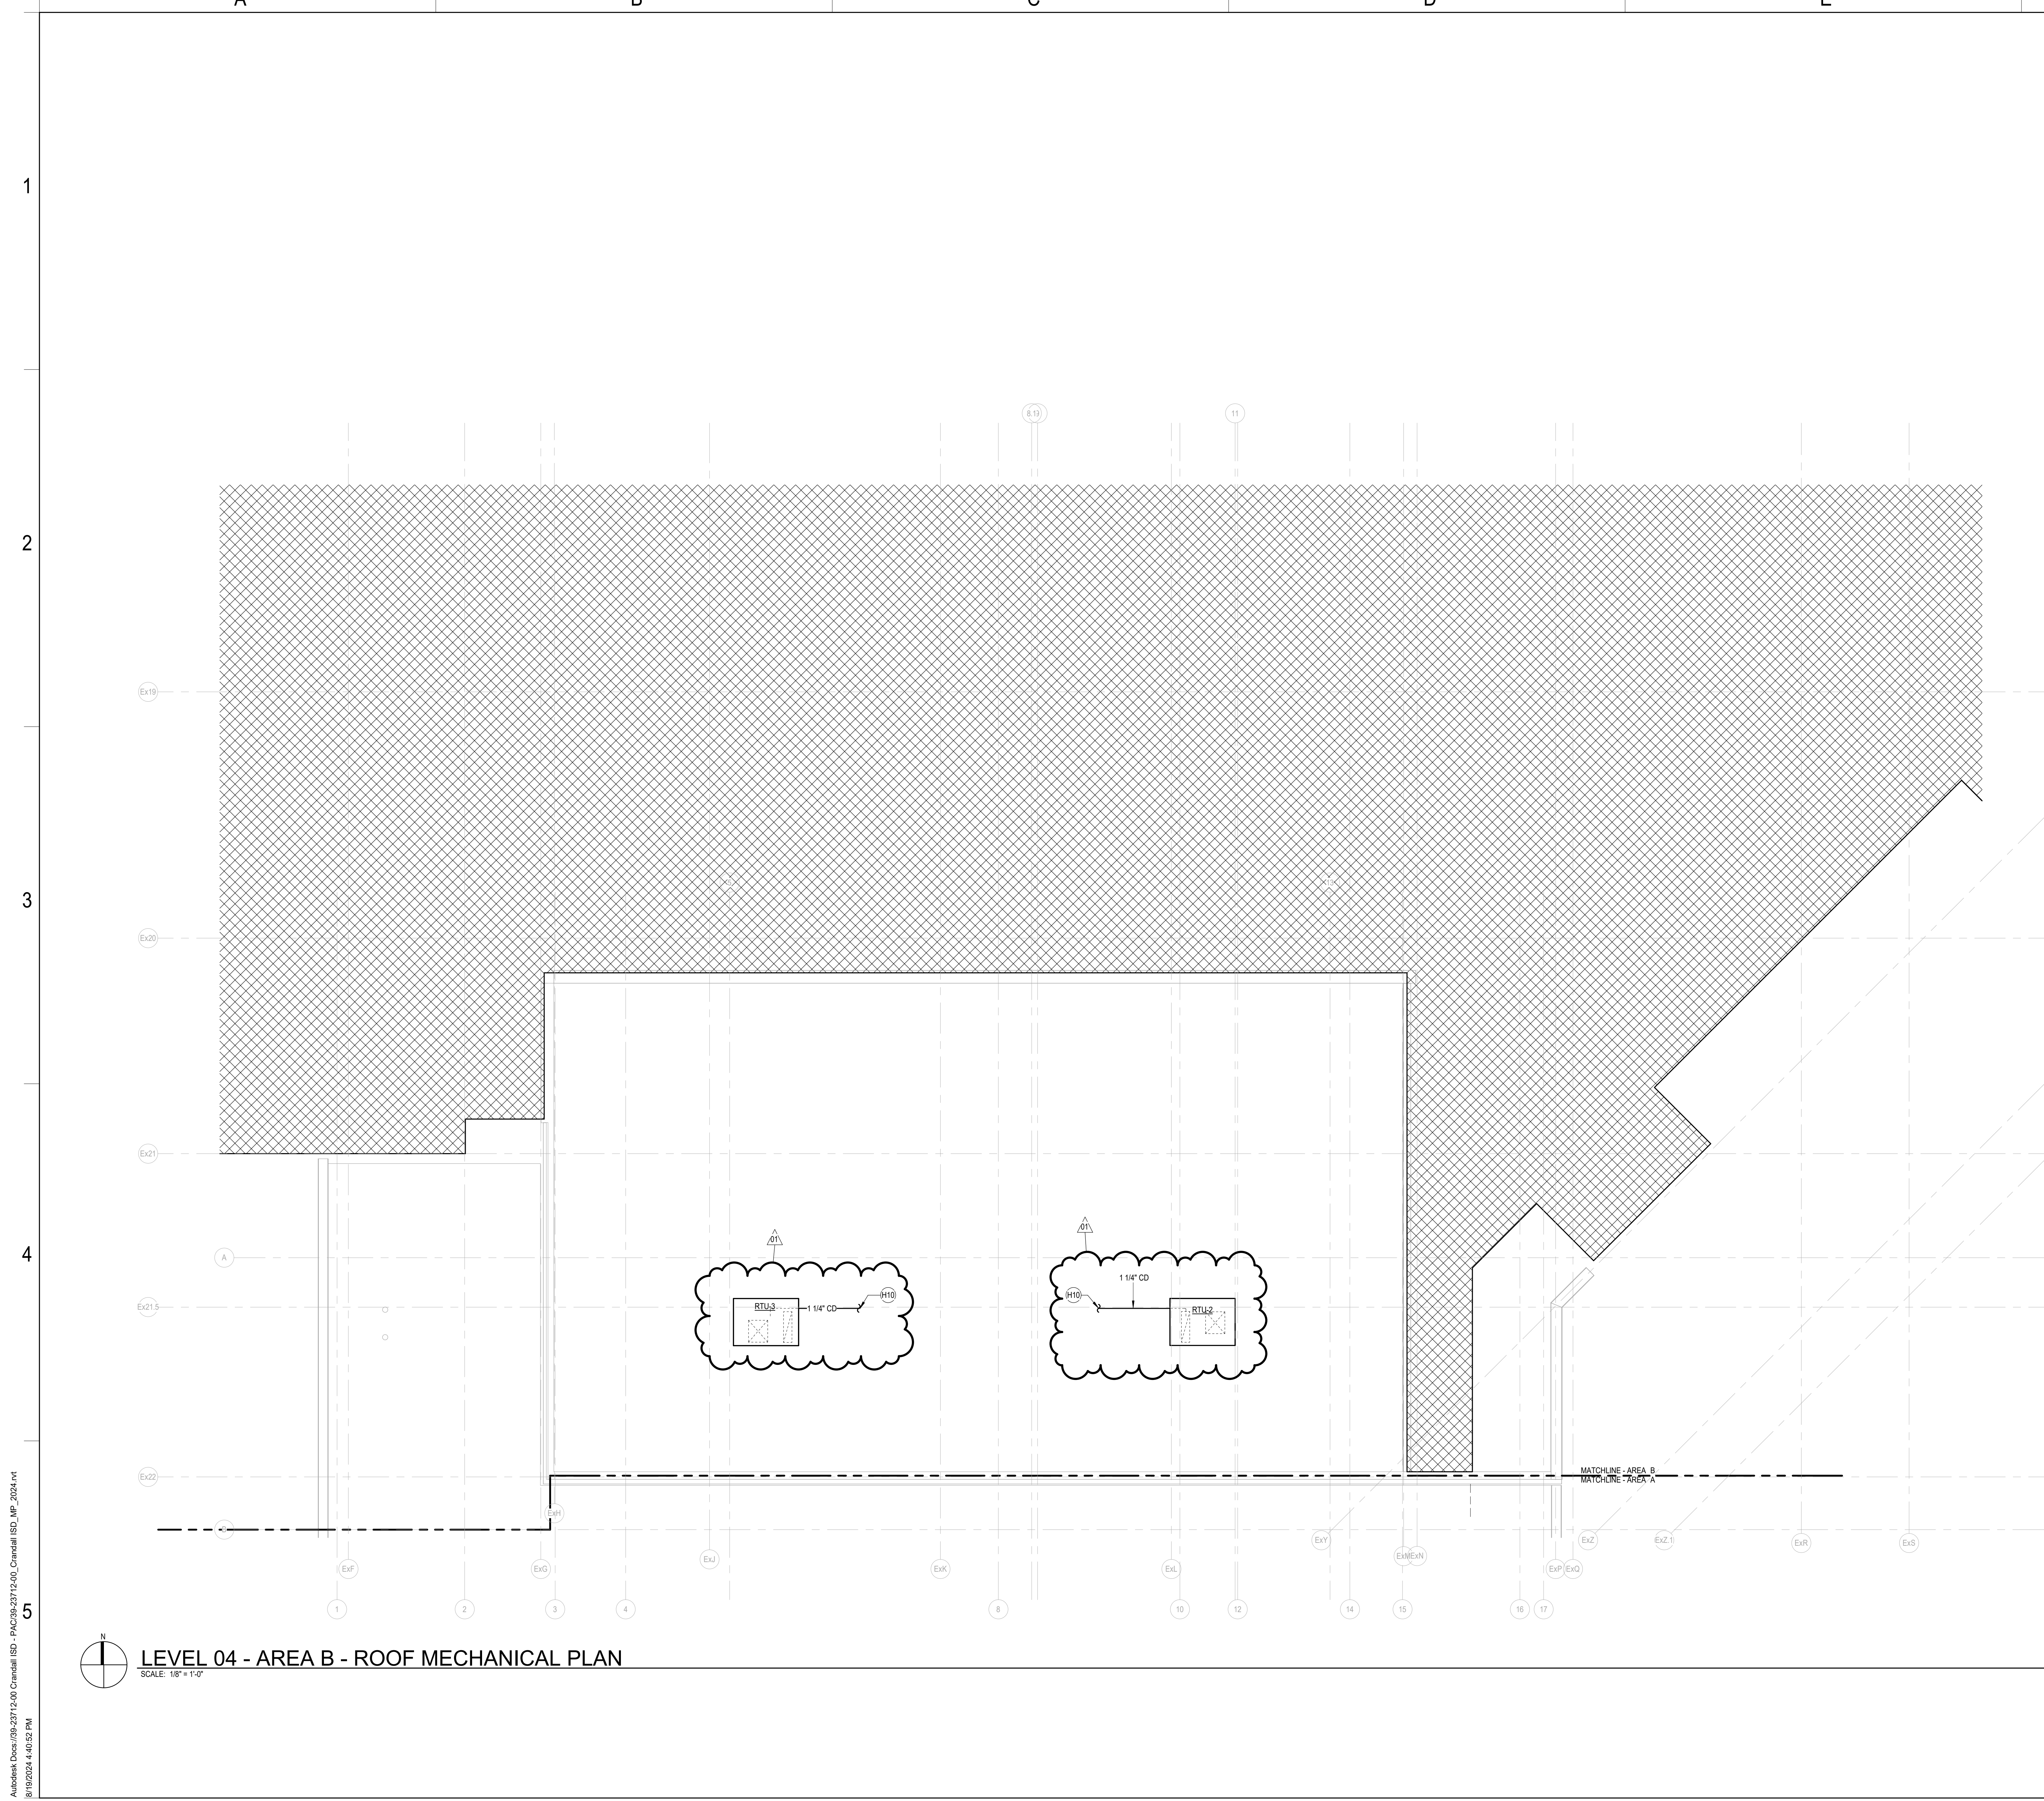

LEVEL 04 - AREA B - ROOF MECHANICAL PLAN
 SCALE: 1/8" = 1'-0"



GENERAL NOTES

- A. FOR SYMBOLS AND ABBREVIATIONS SEE SHEETS M0.1 AND M0.2.
- B. COORDINATE SPACE TEMPERATURE SENSORS AND THERMOSTAT LOCATIONS TO ALIGN VERTICALLY WITH LIGHT SWITCHES. MOUNT A MINIMUM OF 8" FROM LIGHT SWITCH.
- C. FINAL LOCATIONS OF ALL AIR DEVICES SHALL BE COORDINATED WITH ARCHITECTURAL CEILING FINISHES.
- D. ALL DUCT SIZE NOTES REFER TO CLEAR INSIDE DIMENSION OF DUCT.
- E. FLEXIBLE DUCT SHALL NOT BE LONGER THAN 6'-0".
- F. PROVIDE VOLUME DAMPERS FOR ALL SUPPLY, RETURN, AND EXHAUST.
- G. FIRE SEAL AROUND DUCT AND PIPING PENETRATIONS OF FIRE RATED WALLS.
- H. FOR DIFFUSERS OR GRILLES IN INACCESSIBLE CEILINGS, PROVIDE BALANCE DAMPERS WITH ABILITY TO BE REMOTELY ADJUSTED.
- I. EXPOSED ROUND DUCTS OF DIAMETER 10 INCHES OR LARGER TO BE SPIRAL WOUND.
- J. PROVIDE ALL NEW CONTROLS CAPABLE OF TOTAL INTEGRATION WITH EXISTING BUILDING AUTOMATION SYSTEM THROUGH CLIMATECH. THE NEW SYSTEM SHALL PROVIDE USER ACCESS TO ALL SYSTEM DATA BOTH LOCALLY OVER A SECURE INTRANET WITHIN THE BUILDING AND BY REMOTE ACCESS BY A STANDARD WEB BROWSER OVER THE INTERNET. THIS WILL INCLUDE HVAC CONTROLS, ENERGY MANAGEMENT, ALARM MONITORING, AND ALL TRENDRPT/REPORTING FUNCTIONS RELATED TO NORMAL BUILDING OPERATIONS.
- K. ROUTE REFRIGERANT PIPING FROM OUTDOOR UNITS TO ASSOCIATED INDOOR UNITS. REFER TO MANUFACTURER'S INSTRUCTIONS FOR SIZES AND MAX LENGTHS.

SHEET NOTES

- H10 ROUTE CONDENSATE LINE TO NEAREST ROOF DRAIN AND TERMINATE WITH 1" AIR GAP.

KEY PLAN

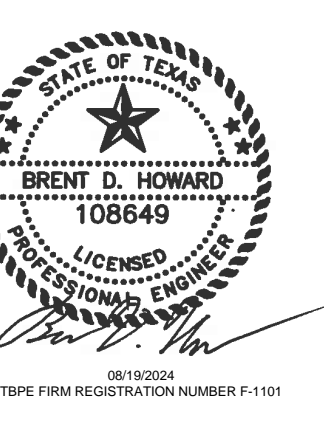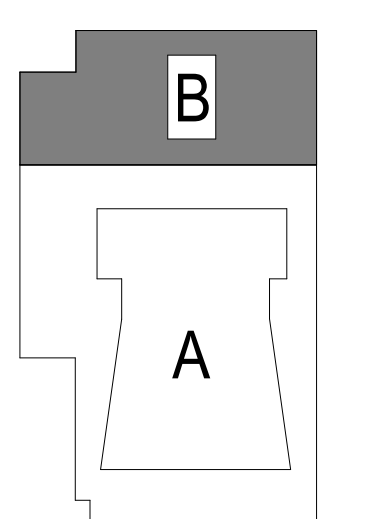


CRANDALL ISD HIGH SCHOOL
 PAC ADDITION
 13385 Fm 3038, Crandall, TX 75114

ISSUE FOR BID AND PERMIT
 2024.07.25
 REVISIONS
 01 08/20/2024

39-23712-00
 LEVEL 04 - AREA B - ROOF MECHANICAL PLAN

M1.4B

RTU-1,
RTU-2,
RTU-3,
RTU-4,
RTU-6,
RTU-7,
RTU-8,
RTU-9

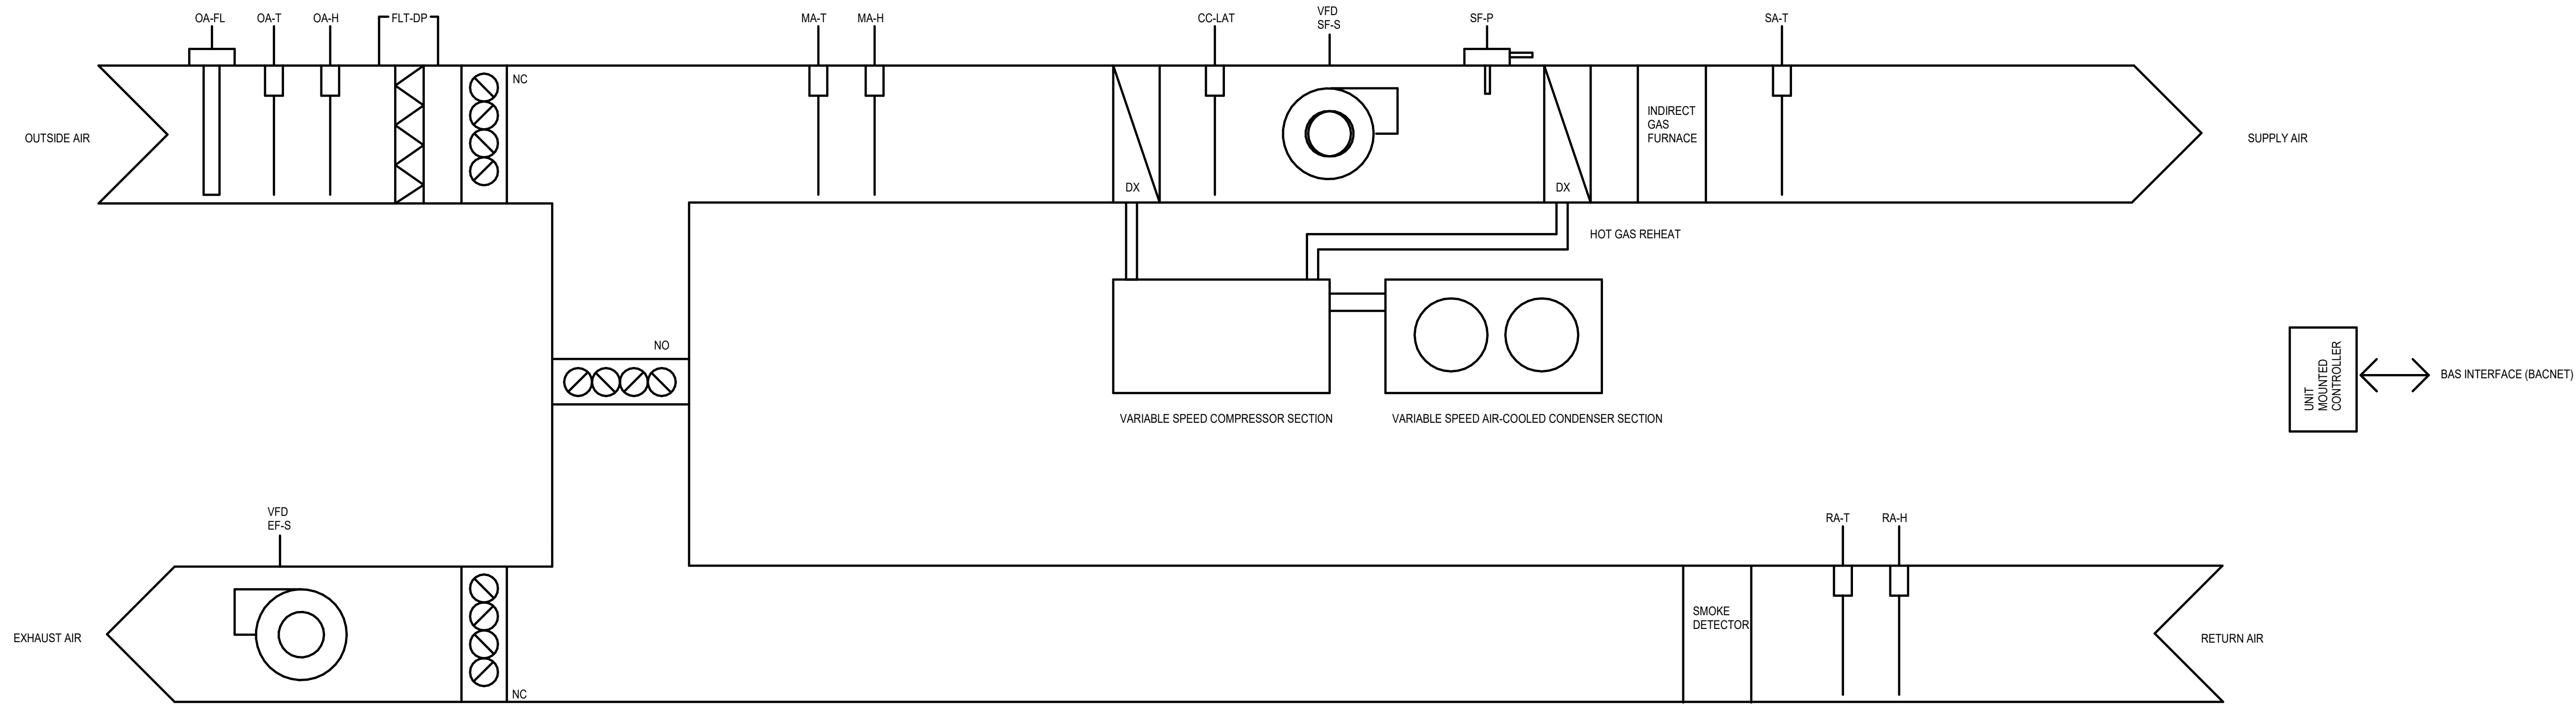

SEQUENCE OF OPERATIONS

GENERAL

1. THIS CONTROL SEQUENCE APPLIES TO THE FOLLOWING UNITS: RTU-1, RTU-2, RTU-3, RTU-4, RTU-6, RTU-7, RTU-8, RTU-9
- 1.2. DURING OPTIMAL START THE OUTSIDE AIR AND EXHAUST AIR DAMPERS SHALL REMAIN CLOSED WITH THE RETURN AIR DAMPER OPEN.
2. ALL CONTROLS DESCRIBED HEREIN SHALL BE PERFORMED BY THE UNIT MOUNTED CONTROLLER. PROVIDE BAS BACNET INTERFACE, REMOTE SENSORS, AND REQUIRED PROGRAMMING FOR COMPLETE INTEGRATION INTO THE BAS.
3. ALL CONTROLS DESCRIBED HEREIN ARE SUBJECT TO THE SAFETIES INTEGRAL TO THE UNIT MOUNTED CONTROLLER AND SHALL NOT OVERRIDE THOSE SAFETIES.
4. PROVIDE WIRING, RELAYS, CONTROLS, PROGRAMMING AND STARTUP AS REQUIRED TO PROVIDE DESCRIBED INTERLOCKS TO OTHER MECHANICAL EQUIPMENT (FANS, COILS, ETC.)
5. WHEN THE UNIT IS OFF-LINE VIA THE START/STOP COMMAND OR VIA THE SERVICE DISCONNECT(S) OR ANY OF THE SAFETIES, COMPONENTS SHALL GO TO THEIR FAIL-SAFE POSITIONS. THE ASSOCIATED EXHAUST FANS SHALL BE DISABLED.
6. FILTER STATUS SHALL BE MONITORED BY FILTER DIFFERENTIAL PRESSURE SWITCH (FLT-DP) ACROSS THE FILTERS.
7. FAN STATUS SHALL BE MONITORED BY THE UNIT CONTROLLER.
8. ALL SET POINTS SHALL BE ADJUSTABLE THROUGH THE BAS WITHOUT SOFTWARE OR HARDWARE REVISIONS.

OCCUPIED MODE OF OPERATION

1. OPTIMAL START:

1.1. THE UNIT SHALL USE AN OPTIMAL START ALGORITHM FOR MORNING START-UP. THIS ALGORITHM SHALL MINIMIZE THE UNOCCUPIED WARM-UP OR COOL-DOWN PERIOD WHILE STILL ACHIEVING COMFORT CONDITIONS BY THE START OF THE SCHEDULED OCCUPIED PERIOD.

2. BASIC OPERATION:

2.1. THE UNIT CONTROLLER SHALL MODULATE THE SUPPLY FAN SPEED TO MAINTAIN THE ADJUSTABLE SPACE TEMPERATURE SET POINT. THE FAN SPEED SHALL INCREASE AS THE ZONE TEMPERATURE RISES ABOVE COOLING SET POINT, OR AS THE ZONE TEMPERATURE DROPS BELOW HEATING SET POINT. THE SUPPLY FAN SPEED SHALL NOT DROP BELOW 25% (ADJ.).

2.1.1. OCCUPIED COOLING SET POINT: 75°F (ADJ.)

2.1.2. OCCUPIED HEATING SET POINT: 70°F (ADJ.)

3. COOLING MODE:

3.1. COOLING SHALL BE ENABLED WHENEVER:

- 3.1.1. OUTSIDE AIR TEMPERATURE IS GREATER THAN 50°F (ADJ.).
- 3.1.2. AND THE ECONOMIZER IS DISABLED OR FULLY OPEN.
- 3.1.3. AND HEATING IS NOT ACTIVE.
- 3.1.4. AND THE SUPPLY FAN STATUS IS ON.

3.2. THE UNIT CONTROLLER SHALL MODULATE THE COOLING SYSTEM TO MAINTAIN THE COOLING COIL DISCHARGE AIR TEMPERATURE SET POINT OF 52°F (ADJ.).

3.3. IF THE SUPPLY FAN IS AT MINIMUM SPEED AND THE SPACE TEMPERATURE FALLS BELOW THE COOLING SET POINT, MODULATE THE HOT GAS REHEAT COIL TO MAINTAIN SPACE TEMPERATURE AT 1°F (ADJ.) LESS THAN COOLING SET POINT.

3.4. WHENEVER THE SUPPLY FAN STATUS IS ON THE CONTROLLER SHALL MEASURE THE RETURN AIR HUMIDITY. WHEN THE RETURN AIR HUMIDITY LEVEL RISES ABOVE 60% RH (ADJ.) AND THE ZONE TEMPERATURE IS SATISFIED (NOT IN COOLING MODE) DEHUMIDIFICATION MODE SHALL BE ENABLED. WHEN IN DEHUMIDIFICATION MODE:

- 3.4.1. THE SUPPLY FAN SHALL OPERATE AT MINIMUM SPEED.
- 3.4.2. MODULATE COOLING TO MAINTAIN A 55 DEGF (ADJ) COOLING COIL LEAVING TEMPERATURE.
- 3.4.3. MODULATE THE HOT GAS REHEAT TO MAINTAIN THE SUPPLY AIR TEMPERATURE AT THE ZONE SETPOINT 70°-76° F.

3.4.4. ALARMS SHALL BE PROVIDED AS FOLLOWS:

3.4.4.1. HIGH RETURN AIR HUMIDITY: IF THE RETURN AIR HUMIDITY IS GREATER THAN 70%(ADJ.).

4. HEATING MODE:

4.1. HEATING SHALL BE ENABLED WHENEVER:

- 4.1.1. OUTSIDE AIR TEMPERATURE IS LESS THAN 65°F (ADJ.).
- 4.1.2. AND THE SPACE TEMPERATURE IS BELOW HEATING SET POINT.
- 4.1.3. AND COOLING IS NOT ACTIVE.
- 4.1.4. AND THE SUPPLY FAN STATUS IS ON.

4.2. THE UNIT CONTROLLER SHALL MODULATE THE INDIRECT GAS FURNACE TO MAINTAIN THE DISCHARGE AIR TEMPERATURE SET POINT OF 85°F (ADJ.).

4.3. FOR UNITS WITH RADIATORS WITHIN THE ZONE SERVED, INTERLOCK RTU OPERATION WITH RADIATORS AND ENABLE RADIATORS DURING HEATING MODE.

5. OUTSIDE AIR CONTROL:

5.1. WHEN IN THE OCCUPIED MODE, MODULATE OUTSIDE AIR AND RETURN AIR DAMPERS TO MAINTAIN THE OUTSIDE AIR FLOW SET POINT (ADJ.). SEE SCHEDULE FOR AIRFLOW VALUES

5.2. DEMAND CONTROL VENTILATION:

5.2.1. WHEN THE SPACE IS BELOW 600 PPM (ADJ) CO2 THE MINIMUM OUTSIDE AIRFLOW SETPOINT SHALL BE REDUCED BY 10% (ADJ) EVERY 5 MINUTES (ADJ) UNTIL THE SPACE CO2 LEVEL RISES TO 850 PPM (ADJ). THE OUTSIDE AIRFLOW SHALL HOLD AT THIS VALUE UNTIL THE SPACE CO2 LEVEL RISES TO 950 PPM (ADJ), WHICH SHALL RESET THE MINIMUM OUTSIDE AIRFLOW SETPOINT UP BY 10% (ADJ) EVERY 5 MINUTES (ADJ) UNTIL THE INITIAL SETPOINT AS INDICATED IN THE EQUIPMENT SCHEDULE IS REACHED.

6. DEMAND CONTROL VENTILATION:

6.1. THE BAS SHALL MONITOR SPACE CO2 CONCENTRATION.

6.2. IF SPACE CO2 CONCENTRATION IS LESS THAN 1000 PPM (ADJ.), THEN RESET OUTSIDE AIR FLOW SET POINT INCREMENTALLY TO THE SCHEDULED MINIMUM. UPON A RISE IN RETURN AIR CO2 ABOVE 1000 PPM (ADJ.), THE RESET SHALL BE DISABLED.

7. EXHAUST FAN

7.1. THE EXHAUST FAN SHALL RUN IN THE OCCUPIED MODE WHENEVER THE SUPPLY FAN RUNS AND THE BUILDING PRESSURE IS LESS THAN 0.05 IN W.G (ADJ.) TO THE OUTSIDE. THE EXHAUST FAN SHALL MODULATE SPEED TO MAINTAIN 0.05 IN W.G (ADJ.) POSITIVE BUILDING PRESSURE.

7.2. ALARMS SHALL BE PROVIDED AS FOLLOWS:

7.2.1. EXHAUST FAN FAILURE: COMMANDED ON, BUT THE STATUS IS OFF.

7.2.2. EXHAUST FAN IN HAND: COMMANDED OFF, BUT THE STATUS IS ON.

7.2.3. EXHAUST FAN FAULT.

8. AIR-SIDE ECONOMIZER:

8.1. WHEN THE OUTSIDE AIR ENTHALPY IS LESS THAN 28 BTU/LB (ADJ.), THE AIR-SIDE ECONOMIZER SHALL BE ENGAGED.

8.2. THE RETURN AIR DAMPER SHALL MODULATE CLOSED AND THE OUTSIDE AIR DAMPER SHALL MODULATE OPEN TO MAINTAIN DISCHARGE SET POINTS.

UNOCCUPIED MODE OF OPERATION

1. DURING THE UNOCCUPIED PERIOD (ADJUSTABLE PER SCHEDULE), THE UNIT CONTROLLER SHALL OPERATE THE UNIT IN A RECIRCULATION MODE TO MAINTAIN THE UNOCCUPIED SPACE TEMPERATURE SET POINTS. THE OUTSIDE AIR AND EXHAUST DAMPERS SHALL REMAIN CLOSED AND THE FANS SHALL CYCLE WITH A CALL FOR HEATING OR COOLING.

- 1.1. UNOCCUPIED COOLING SET POINT: 85°F (ADJ.)
- 1.2. UNOCCUPIED HEATING SET POINT: 55°F (ADJ.)

2. A TIMED LOCAL OVERRIDE CONTROL SHALL ALLOW AN OCCUPANT TO OVERRIDE THE SCHEDULE AND PLACE THE UNIT INTO AN OCCUPIED MODE FOR AN ADJUSTABLE PERIOD OF TIME. AT THE EXPIRATION OF THIS TIME, CONTROL OF THE UNIT SHALL AUTOMATICALLY RETURN TO THE SCHEDULE.

SAFETIES AND ALARMS


1. THE FOLLOWING SAFETIES SHALL SHUT DOWN ITS RESPECTIVE UNIT, AND INITIATE AN ALARM THROUGH THE BAS AFTER APPROPRIATE TIME DELAYS WHERE SPECIFIED:


- 1.1. UNIT CONTROLLER OR INTERNAL SAFETIES INDICATE A "FAULT." -DELAY: NONE.
- 1.2. DUCT SMOKE DETECTORS (SEE FIRE ALARM) INDICATE SMOKE -DELAY: NONE. CONTACTS FROM FIRE ALARM SYSTEM INITIATES THE SHUTDOWN OF THE RTU.
- 1.3. SUPPLY AIR HIGH LIMIT: SUPPLY AIR DIFFERENTIAL PRESSURE EXCEEDS 4 IN. W.C. (ADJ.) -DELAY: NONE.

2. ALARMS SHALL BE PROVIDED AS FOLLOWS:


- 2.1. SUPPLY OR EXHAUST FAN FAILURE: COMMANDED ON, BUT STATUS IS OFF.
- 2.2. AIRFLOW MEASURING STATION INDICATES OUTSIDE AIR OFF SET POINT BY MORE THAN 10% FLOW - DELAY: 15 MIN.

| SINGLE-ZONE VARIABLE VOLUME RTU POINTS SCHEDULE | | |
|---|--------------------------------|---------------|
| POINT | DESCRIPTION | ANALOG INPUT |
| SA-T | SUPPLY AIR TEMP | DIGITAL INPUT |
| SF-S | SUPPLY FAN STATUS | ANALOG INPUT |
| CC-LAT | COOLING COIL LEAVING AIR TEMP | DIGITAL INPUT |
| FLT-DP | FILTER DIFFERENTIAL PRESSURE | ANALOG INPUT |
| OA-T | OUTSIDE AIR TEMPERATURE | ANALOG INPUT |
| OA-H | OUTSIDE AIR HUMIDITY | ANALOG INPUT |
| OA-FL | OUTSIDE AIR FLOW RATE | ANALOG INPUT |
| RA-T | RETURN AIR TEMP | ANALOG INPUT |
| RA-H | RETURN AIR HUMIDITY | ANALOG INPUT |
| EF-S | EXHAUST FAN STATUS | DIGITAL INPUT |
| SP-T | SPACE TEMP | ANALOG INPUT |
| SP-SPT | SPACE TEMP SET POINT | ANALOG INPUT |
| SP-OVD | SPACE TEMP UNOCCUPIED OVERRIDE | DIGITAL INPUT |
| SP-H | SPACE HUMIDITY | ANALOG INPUT |
| SP-CO2 | SPACE CO2 CONCENTRATION | ANALOG INPUT |
| B-DP | BUILDING STATIC PRESSURE | ANALOG INPUT |
| MA-T | MIXED AIR TEMP | ANALOG INPUT |
| MA-H | MIXED AIR HUMIDITY | ANALOG INPUT |
| SF-P | SUPPLY FAN DISCHARGE PRESSURE | ANALOG INPUT |

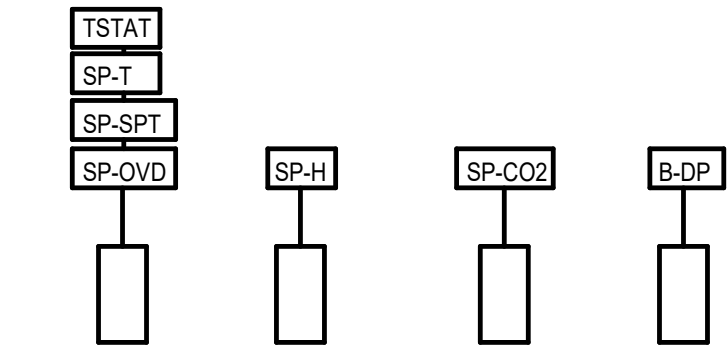


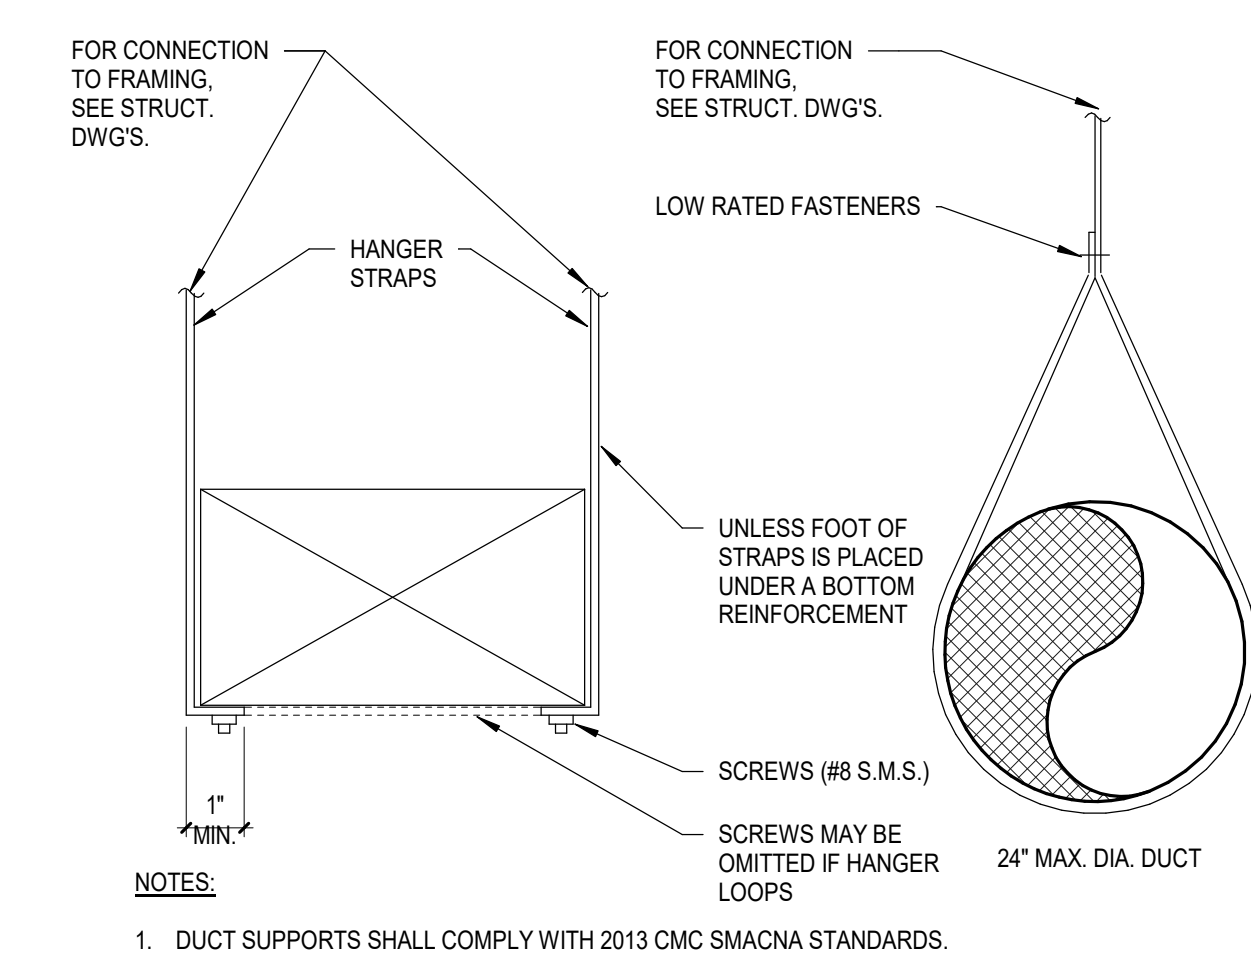


1A DUCT HANGER DETAIL
M7.1 NO SCALE

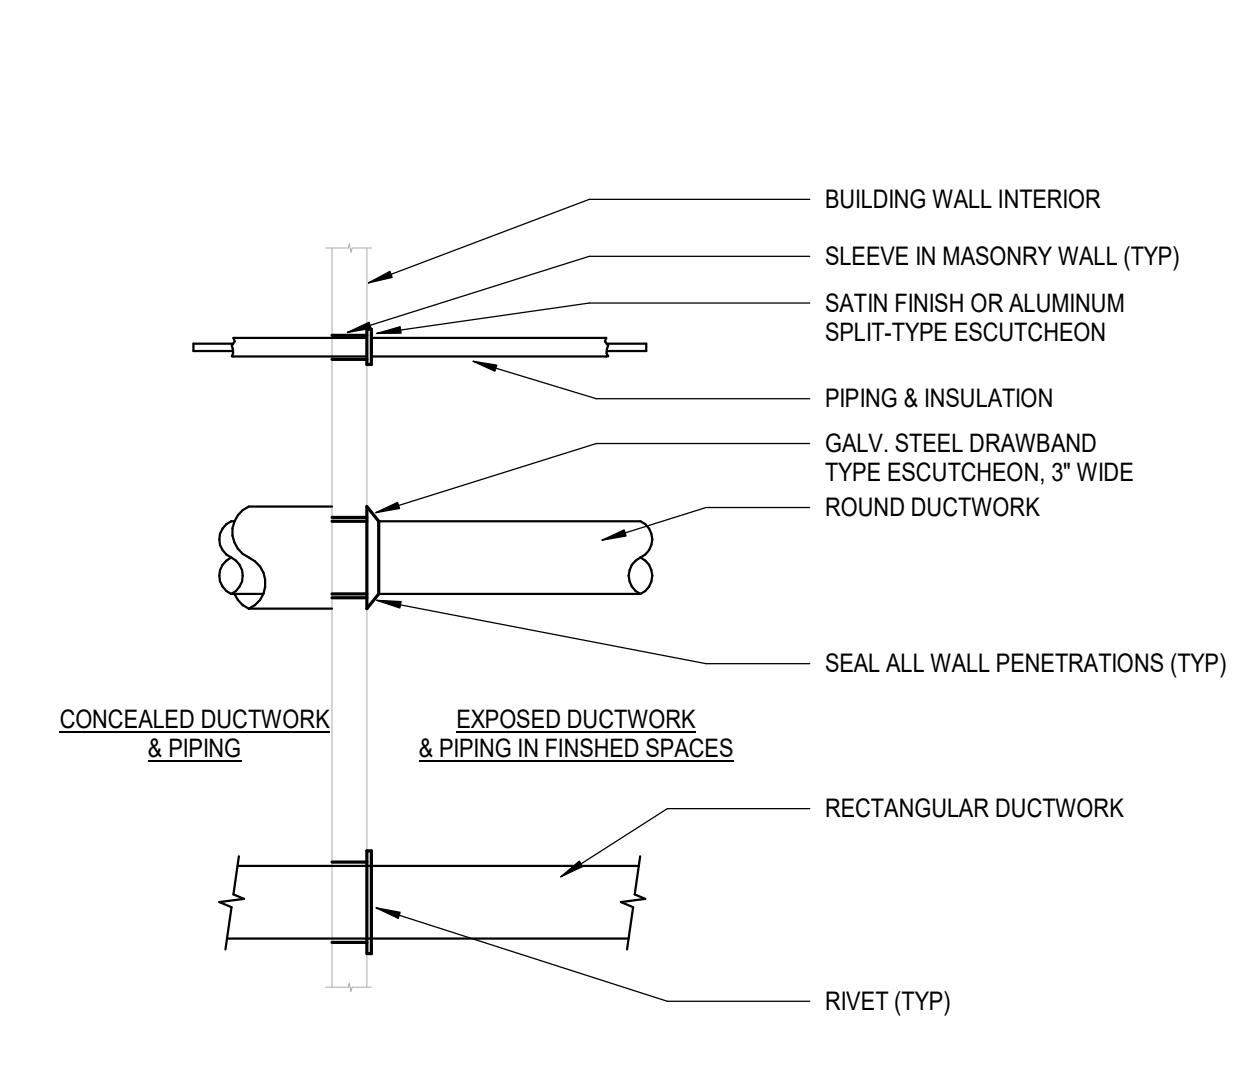


1B DUCT/PIPE WALL PENETRATION DETAIL
M7.1 NO SCALE

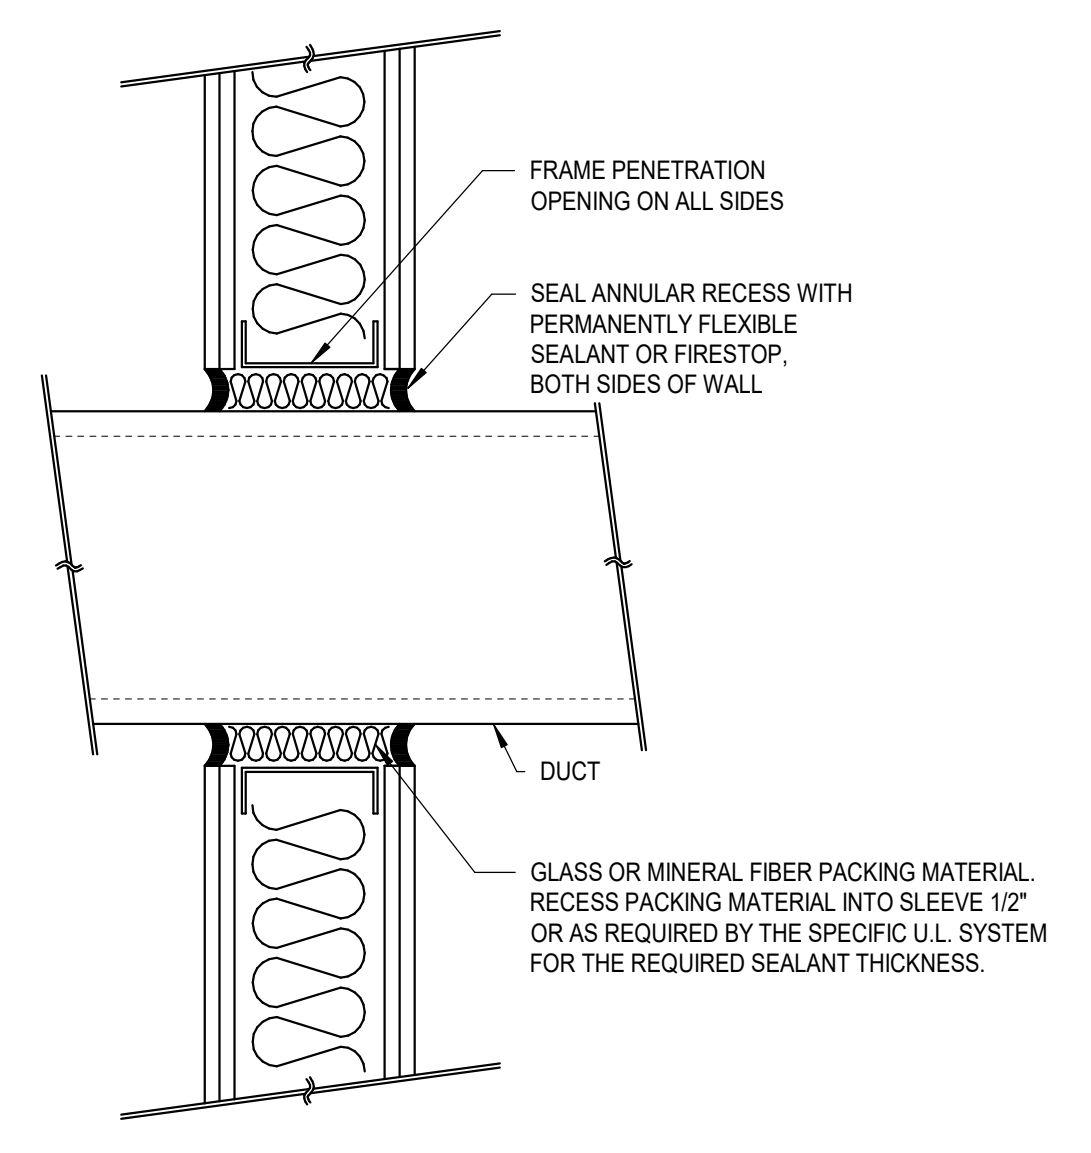


1C DUCT PENETRATION THROUGH FRAMED WALL
M7.1 NO SCALE

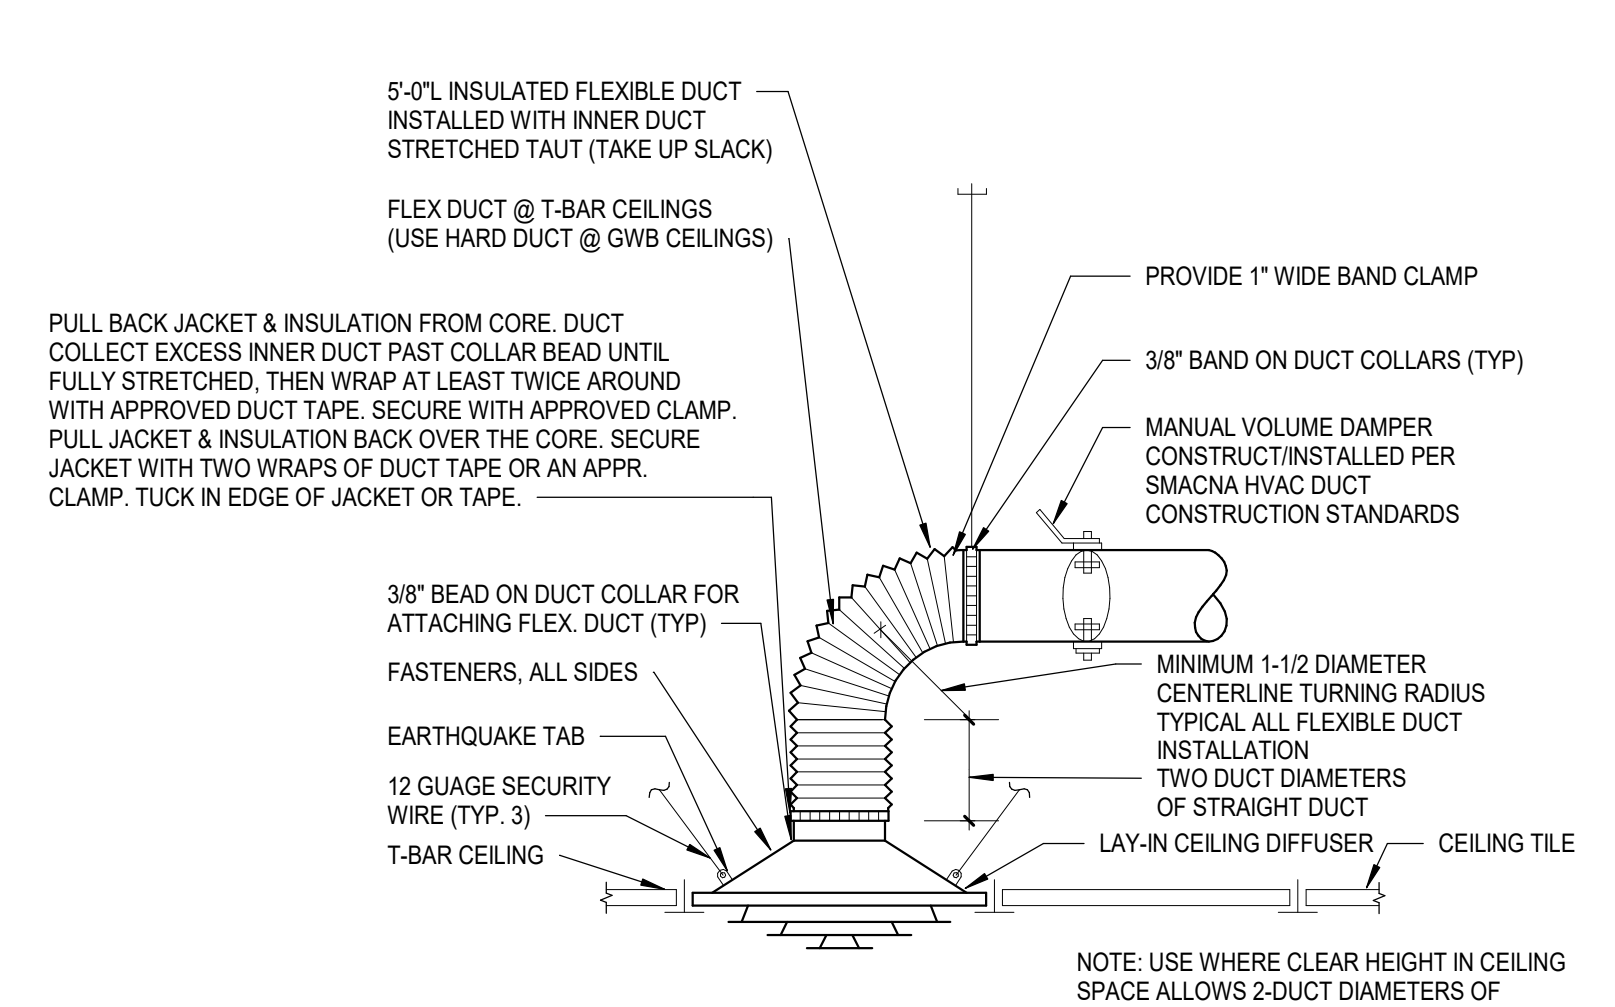


1D CEILING SUPPLY DIFFUSER CONNECTION DETAIL
M7.1 NO SCALE

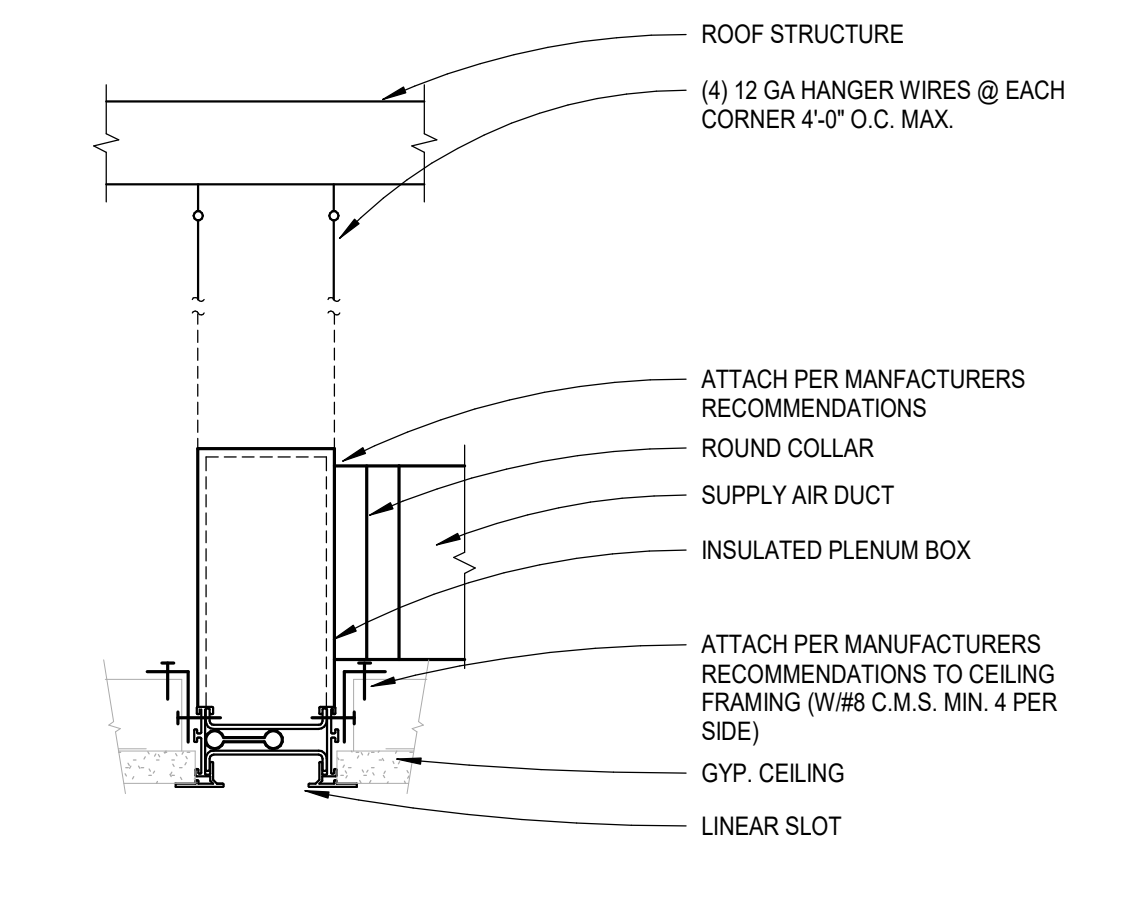


1E LINEAR SLOT IN GYP CEILING DETAIL
M7.1 NO SCALE

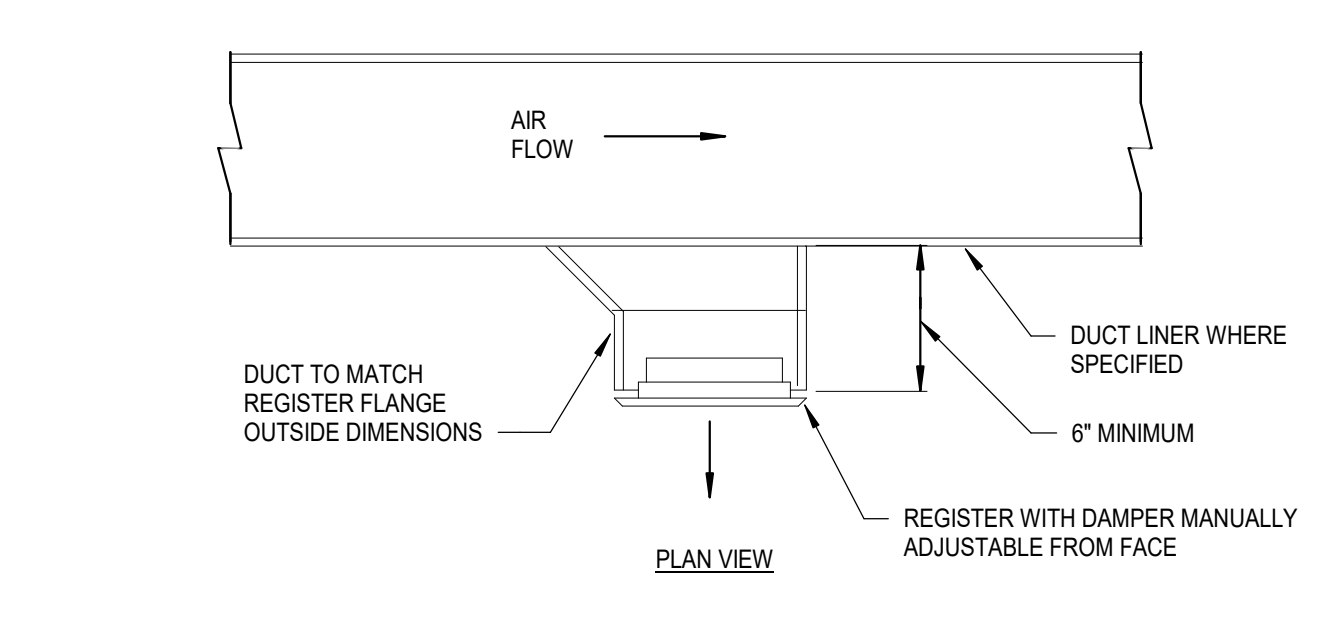


2A TYPICAL DUCT MOUNTED REGISTER
M7.1 NO SCALE

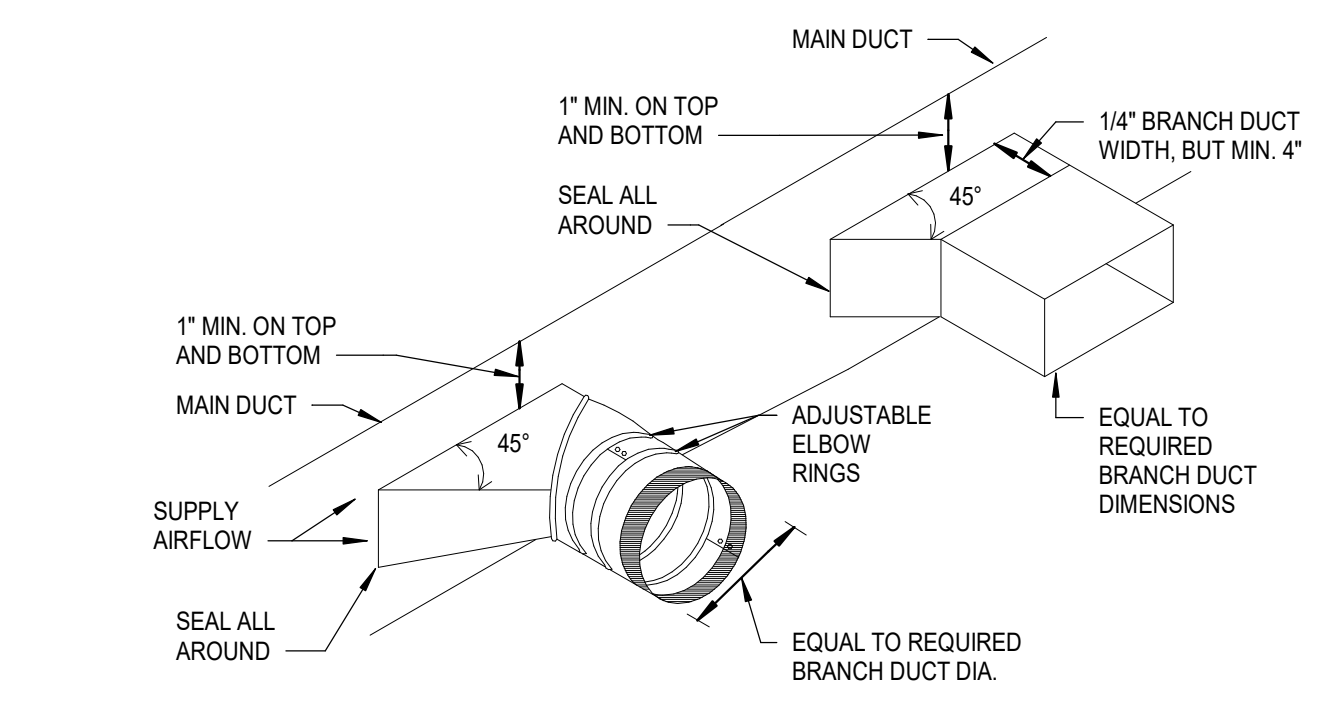


2B TYPICAL BRANCH TAKEOFF FITTING DETAIL
M7.1 NO SCALE

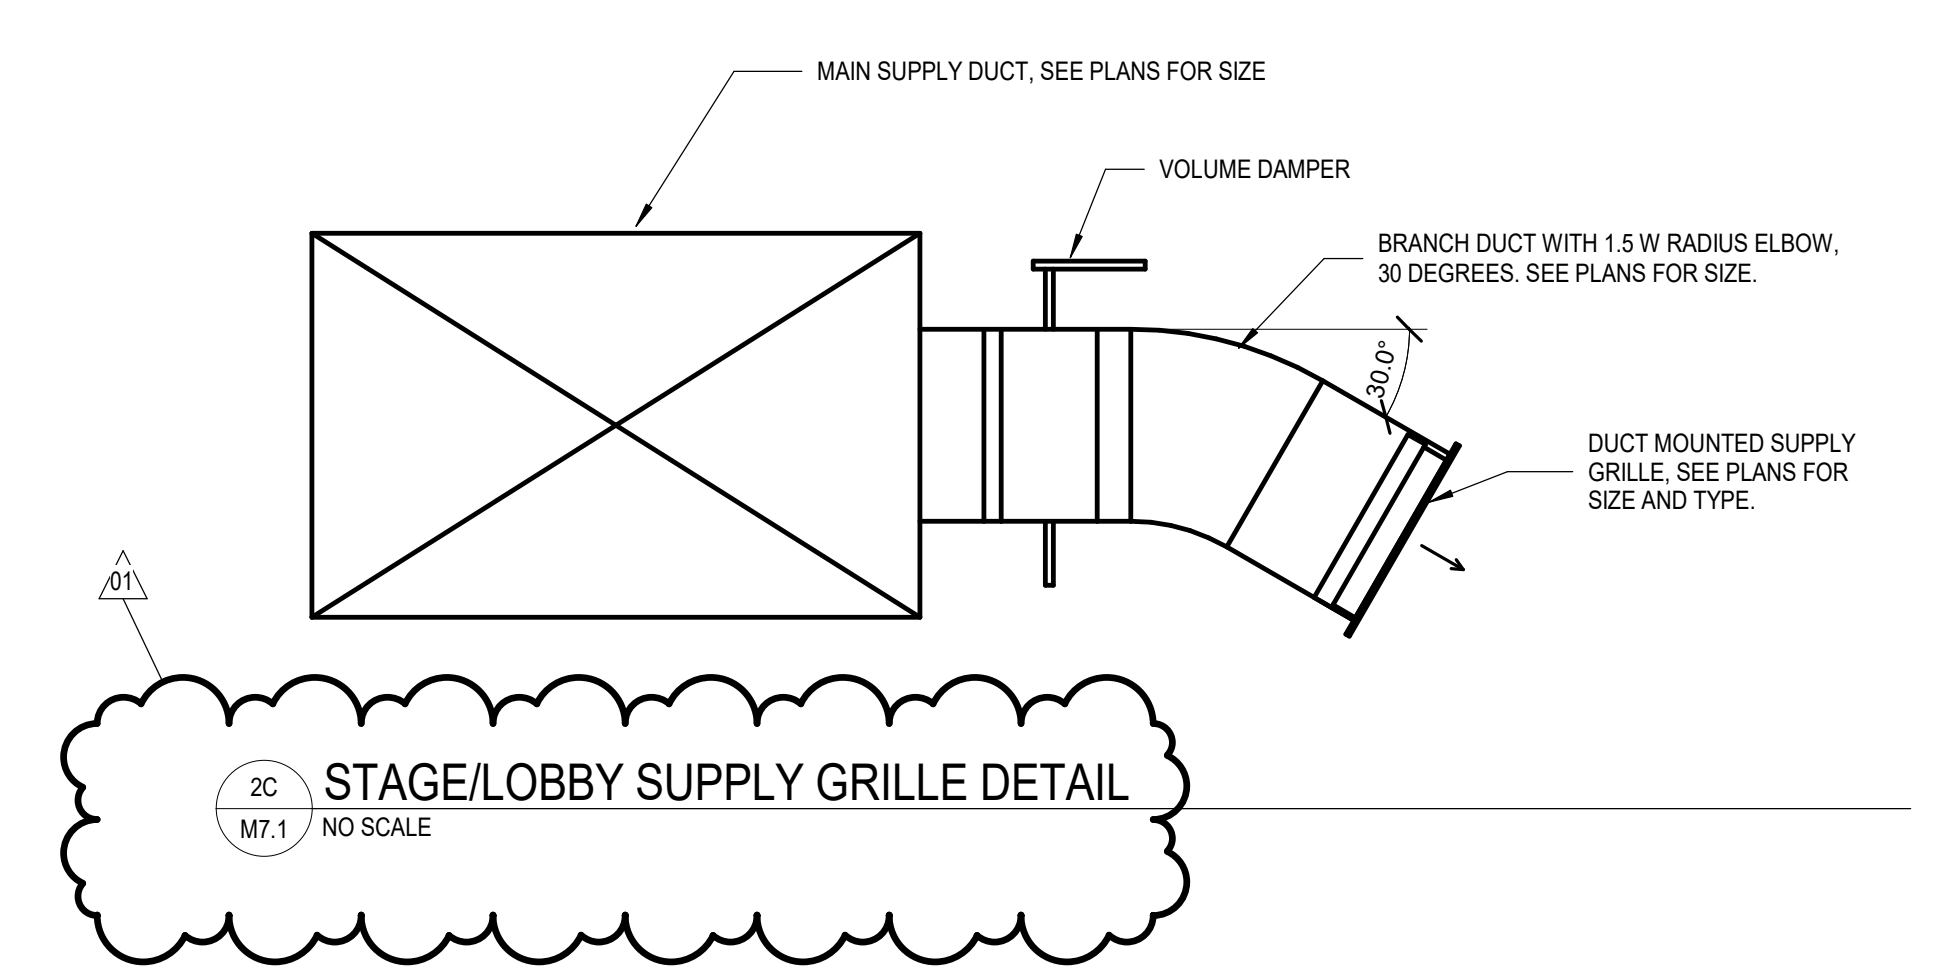

2C STAGE/LOBBY SUPPLY GRILLE DETAIL
M7.1 NO SCALE

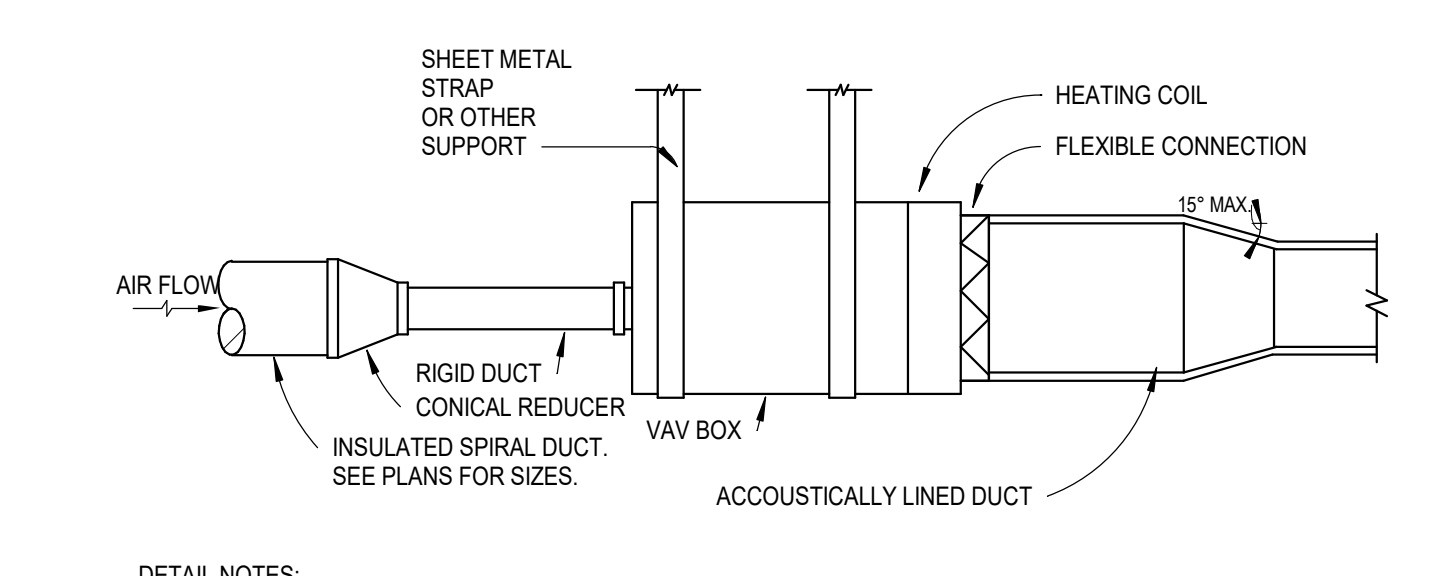

2D VAV BOX DETAIL
M7.1 NO SCALE

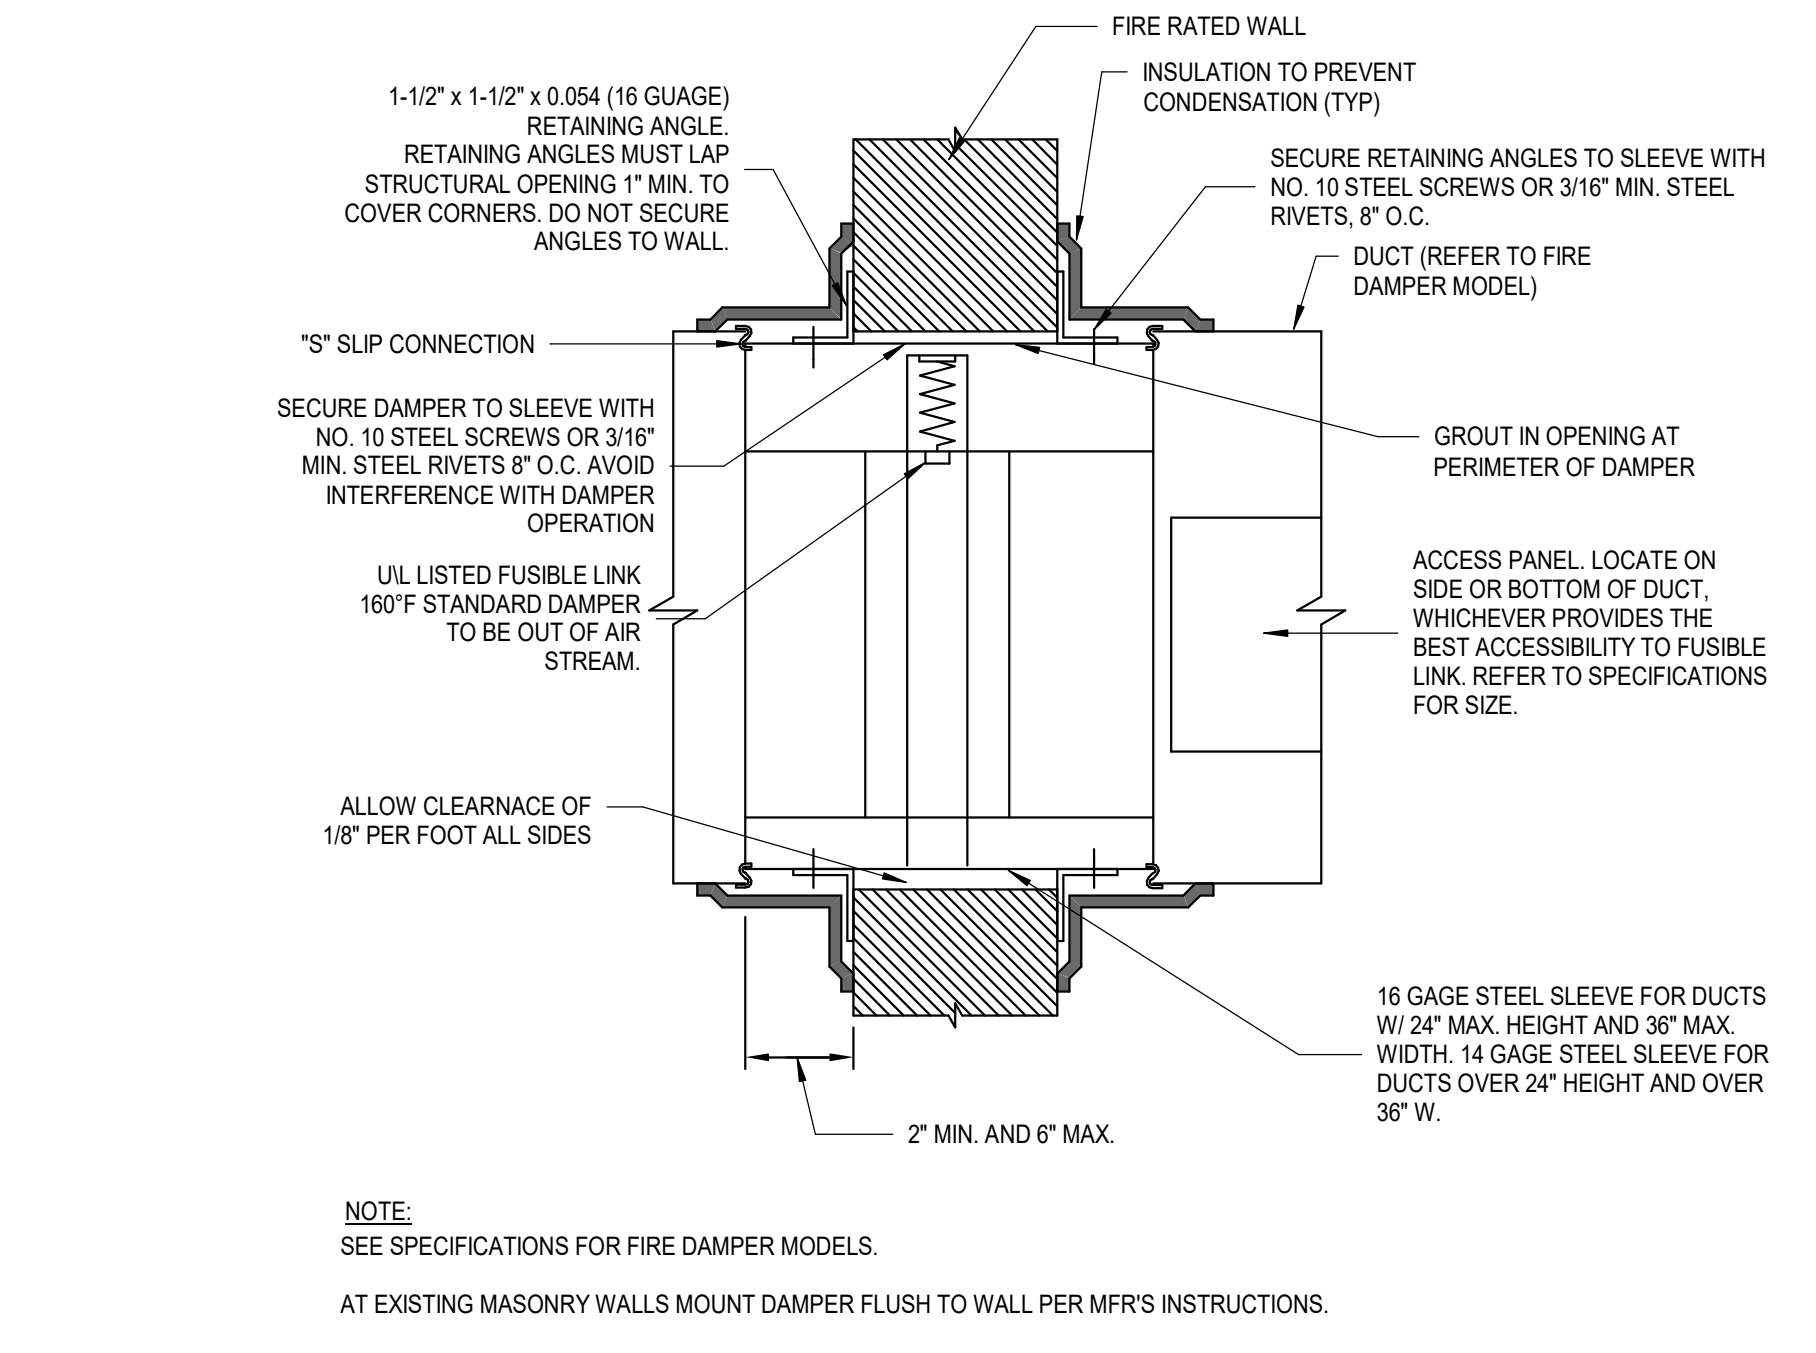


3A FIRE DAMPER DETAIL
M7.1 NO SCALE


| MAX DOOR SIZE | NUMBER OF HINGES | NUMBER OF HANDLES | SHEET METAL GAUGE THICKNESS | | |
|---------------|------------------|-------------------|-----------------------------|------|-------|
| | | | DOOR | BACK | FRAME |
| 12\"/> | | | | | |




3B DUCT ACCESS DOOR DETAIL
M7.1 NO SCALE

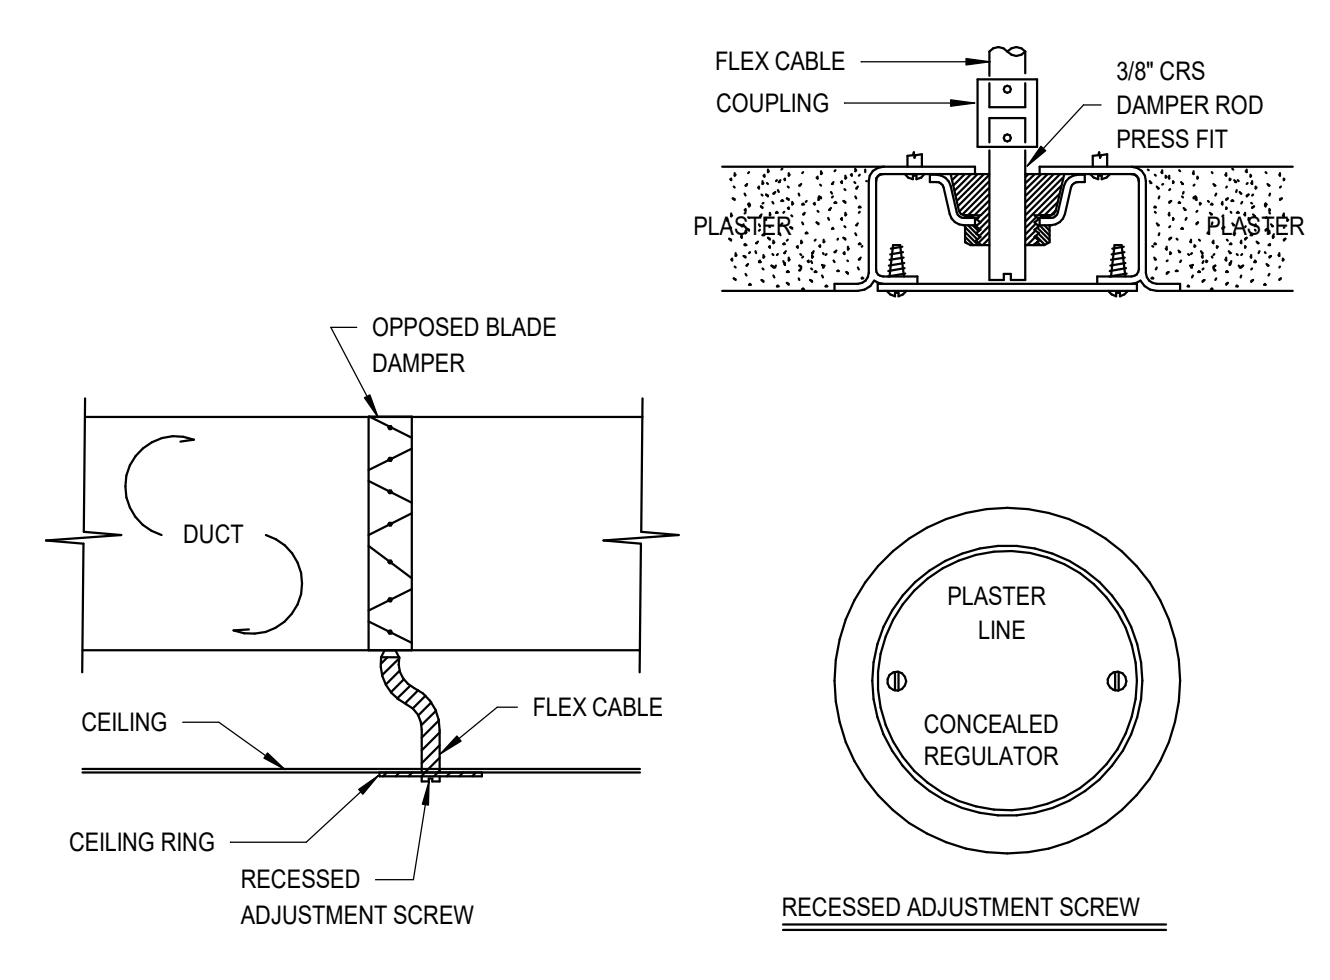


3C REMOTE VOLUME DAMPER DETAIL
M7.1 NO SCALE

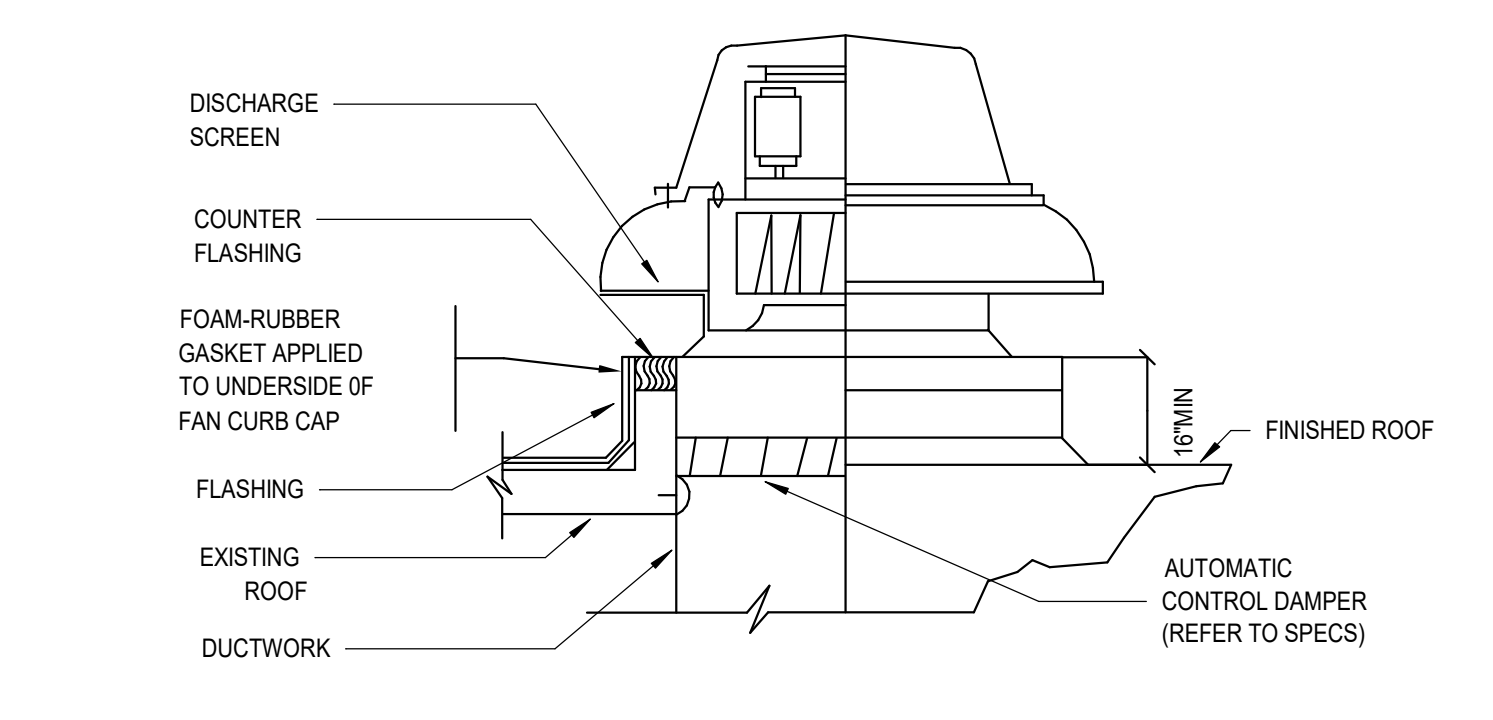


3D ROOF MOUNTED EXHAUST FAN DETAIL
M7.1 NO SCALE

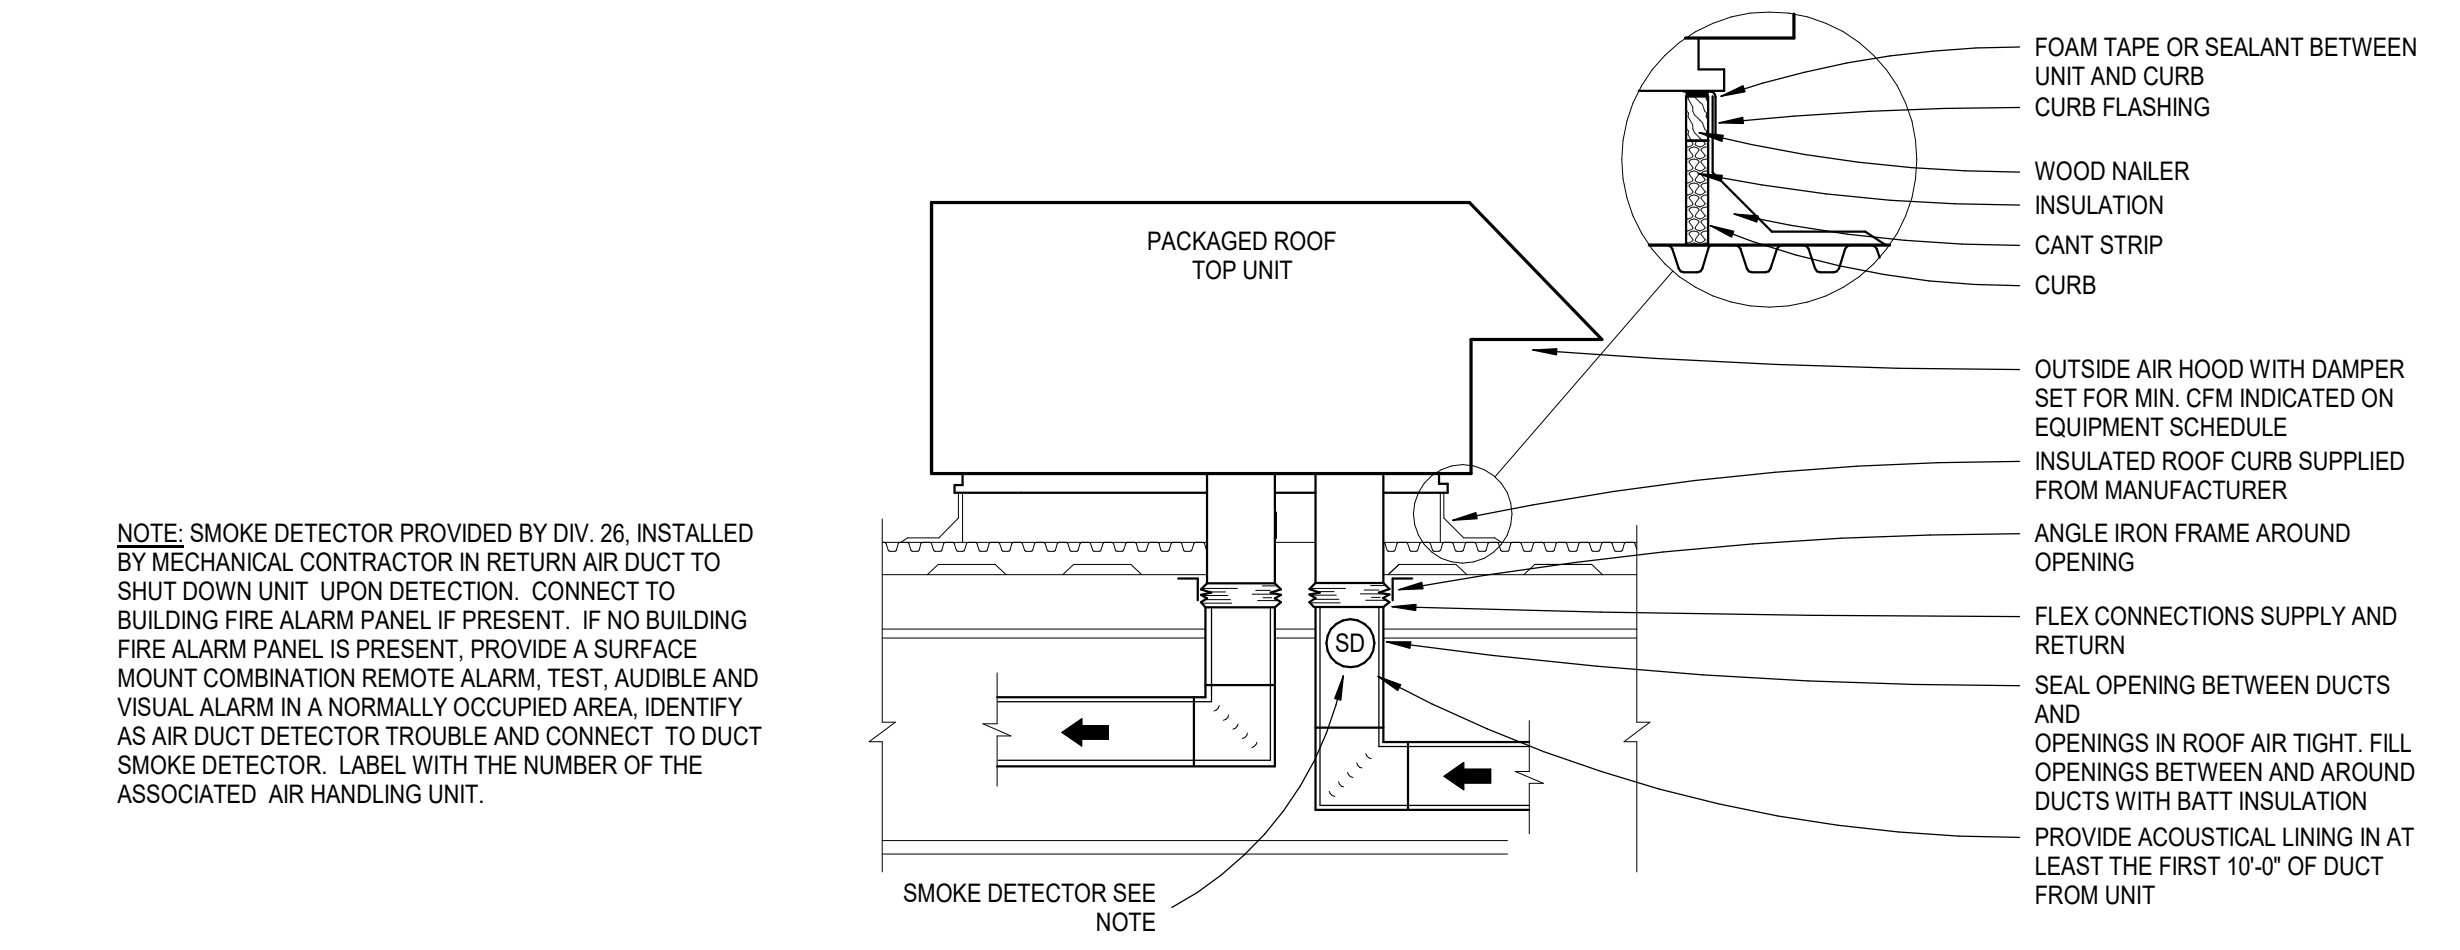

4A ROOFTOP UNIT MOUNTING
M7.1 NO SCALE

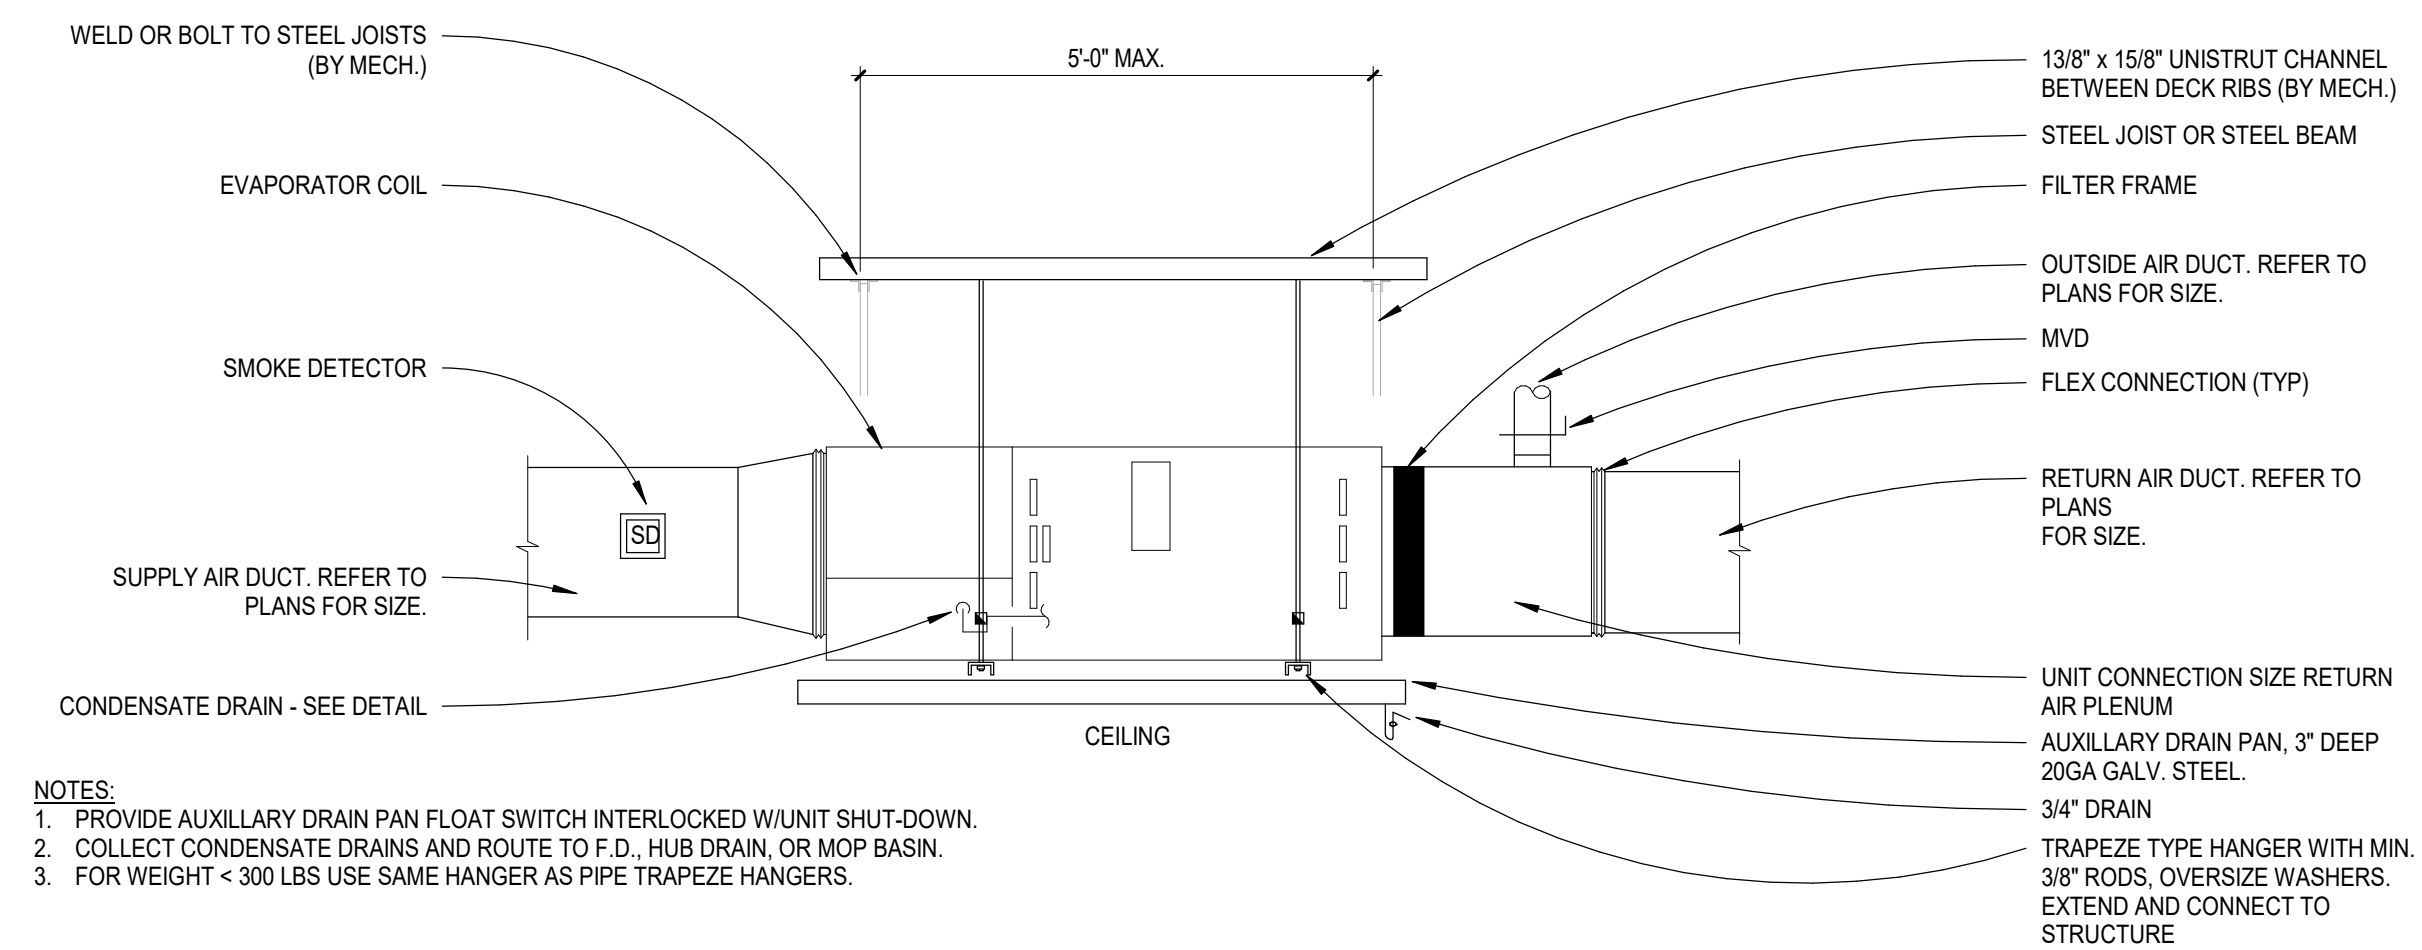

4B HORIZONTAL MECHANICAL UNIT DETAIL
M7.1 NO SCALE

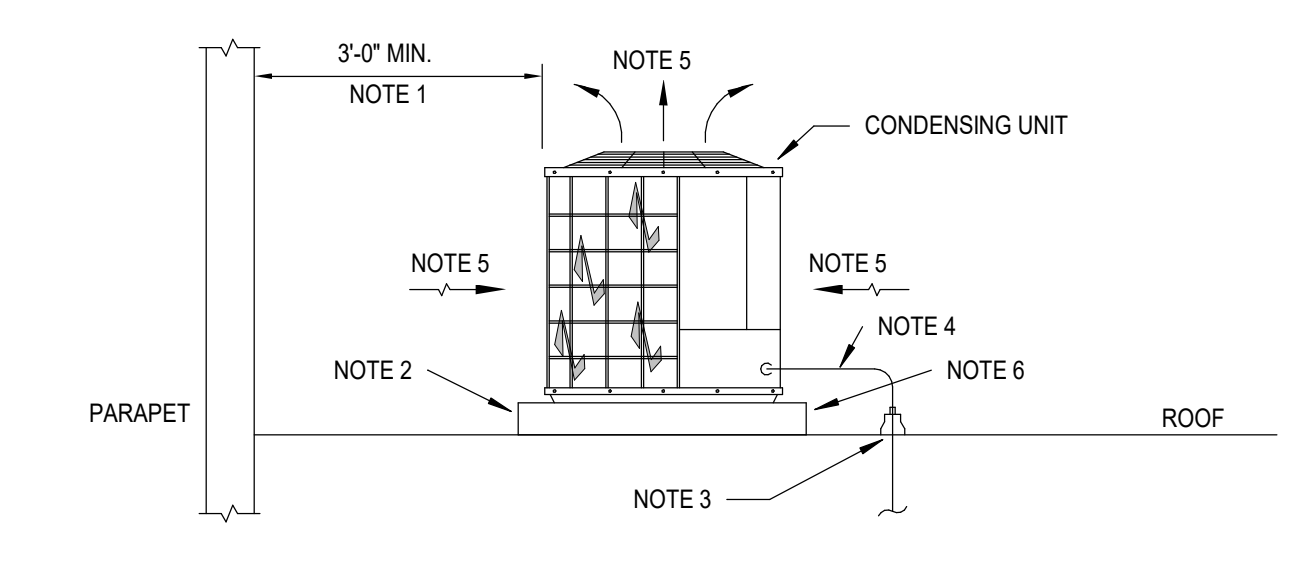

4C CONDENSING UNIT DETAIL
M7.1 NO SCALE

Autodesk Docs://99-23712-00_Crandall ISD - PAC/39-23712-00_Crandall ISD_MP_2024.rvt
8/19/2024 4:40:55 PM

LINEAR SLOT DIFFUSERS SCHEDULE

NOTES:
 1. SEE PLANS FOR NECK SIZES.
 2. ALL SLOT DIFFUSERS AND PLENUMS SHALL BE INSULATED.
 3. FLEX AND HARD DUCT RUNOUT TO DIFFUSER SHALL MATCH NECK SIZE UNLESS NOTED OTHERWISE.
 4. CUSTOM FIELD BUILT INSULATED PLENUM WITH 16" INLET.

| ID | SLOT WIDTH (IN) | SLOT QTY | LINEAR FACE DIMS (N) | INCLUDED (Y/N) | PLENUM DATA | | MODEL | FRAME TYPE | MATERIAL | FINISH | BASIS OF DESIGN | | | NOTES |
|--------|-----------------|----------|----------------------|----------------|-------------|--------------|-------|------------|----------|--------------|-----------------|----------|-------|-------|
| | | | | | LENGTH (IN) | AREA (SQ FT) | | | | | MANUFACTURER | MODEL | NOTES | |
| LD-34B | 1 | 2 | 96 x 4 | Y | 96 | MP-39 | | SURFACE | ALUMINUM | WHITE ENAMEL | TITUS | ML-39 | | 1-3 |
| LD-36B | 1 | 4 | 60 x 6 | Y | 60 | MP-39 | | SURFACE | ALUMINUM | WHITE ENAMEL | TITUS | ML-39 | | 1-3 |
| LD-75A | 2.5 | 1 | 60 x 6 | Y | 60 | FT-25 | | SURFACE | ALUMINUM | BLACK | TITUS | FL-25-JT | | 1-4 |
| LD-75B | 2.5 | 1 | 60 x 6 | Y | 60 | FT-25 | | SURFACE | ALUMINUM | BLACK | TITUS | FL-25-JT | | 1-4 |

GRILLES, REGISTERS AND DIFFUSERS SCHEDULE

NOTES:
 1. SEE PLANS FOR NECK SIZE.
 2. FLEX AND HARD DUCT RUNOUT TO REG UNIT SHALL MATCH NECK SIZE UNLESS NOTED OTHERWISE.

| ID | DESCRIPTION | INCLUDED (Y/N) | DAMPER DESCRIPTION | FRAME TYPE | PANEL SIZE | FACE (W x H) | MATERIAL | FINISH | BASIS OF DESIGN | | | NOTES |
|------|-----------------------------------|----------------|--------------------|--------------|------------|--------------|----------|------------------------|-----------------|--------|-------|-------|
| | | | | | | | | | MANUFACTURER | MODEL | NOTES | |
| D-31 | LOUVERED DOUBLE DEFLECTION GRILLE | N | --- | SURFACE | --- | SEE PLANS | ALUMINUM | WHITE ENAMEL | TITUS | 30FL | | 1, 2 |
| D-32 | LOUVERED DOUBLE DEFLECTION GRILLE | N | --- | DUCT MOUNTED | --- | SEE PLANS | ALUMINUM | WHITE (BLACK IN LOBBY) | TITUS | 30FL | | 1, 2 |
| D-54 | 3-CONE DIFFUSER | N | --- | LAY-IN | 24 x 24 | SEE PLANS | ALUMINUM | WHITE ENAMEL | TITUS | TMS-AA | | 1, 2 |
| G-1 | EGGCRATE RETURN GRILLE | N | --- | LAY-IN | 24 x 24 | SEE PLANS | ALUMINUM | WHITE (BLACK IN LOBBY) | TITUS | 50F | | 1, 2 |
| G-7 | LOUVERED GRILLE | N | --- | SURFACE | --- | SEE PLANS | ALUMINUM | WHITE ENAMEL | TITUS | 35FL | | 1, 2 |

ROOFTOP UNIT SCHEDULE

| MARK | RTU-1 | RTU-2 | RTU-3 | RTU-4 | RTU-5 | RTU-6 | RTU-7 | RTU-8 | RTU-9 |
|-------------------------|------------------------|---------------------|---------------------|----------------------|--------------------|-------------------|---------------------|---------------------|----------------------|
| SERVICE | AUDITORIUM | BAND ROOM | PERCUSSION RMS | STAGE | DRESSING RMS | MAIN LOBBY | WORKSHOP | CONCESSIONS | EAST CORRIDOR |
| EER / EER | 10.2 / 16.5 | 11.0 / 18.0 | 12.0 / 20.0 | 11.0 / 20.0 | 11.0 / 20.0 | 11.0 / 21.0 | 12.0 / 20.0 | 11.0 / 20.0 | 11.0 / 20.0 |
| CONFIGURATION | SINGLE ZONE VAV | SINGLE ZONE VAV | SINGLE ZONE VAV | SINGLE ZONE VAV | MULTI ZONE VAV | SINGLE ZONE VAV | SINGLE ZONE VAV | SINGLE ZONE VAV | SINGLE ZONE VAV |
| DISCHARGE | VERTICAL | VERTICAL | VERTICAL | VERTICAL | VERTICAL | VERTICAL | VERTICAL | VERTICAL | VERTICAL |
| NOMINAL CAPACITY (TONS) | 68 | 12 | 10 | 25 | 6 | 35 | 10 | 13.5 | 16 |
| AIRFLOW | 14,230 | 2,530 | 2,085 | 5,930 | 1,490 | 11,425 | 2,750 | 2,590 | 5,000 |
| OUTSIDE AIR | 1,190 | 1,190 | 1,190 | 1,890 | 615 | 2,600 | 700 | 1,000 | 900 |
| FAN TYPE | SWISAF (ECM) | SWISAF (ECM) | SWISAF (ECM) | SWISAF (ECM) | SWISAF (ECM) | SWISAF (ECM) | SWISAF (ECM) | SWISAF (ECM) | SWISAF (ECM) |
| QUANTITY OF FANS | 4 | 1 | 1 | 1 | 1 | 4 | 1 | 1 | 1 |
| MOTOR BHP | TOTAL 13.59 | 0.86 | 0.73 | 2.43 | 0.56 | 7.97 | 0.97 | 0.95 | 2.53 |
| MOTOR HP | EACH 5.50 | 2.40 | 2.4 | 5 | 1.7 | 17.60 | 7 | 2.40 | 5.00 |
| E.S.P. | IN W.C. 2.00 | 1.00 | 1.00 | 1.00 | 1.00 | 1.50 | 1.00 | 1.00 | 1.00 |
| T.S.P. | IN W.C. 3.30 | 1.30 | 1.37 | 1.71 | 1.39 | 2.36 | 1.44 | 1.49 | 1.67 |
| AIRFLOW | CFM 14,230 | 2,530 | 2,085 | 5,930 | 1,490 | 11,425 | 2,750 | 2,590 | 5,000 |
| FAN TYPE | SWISAF (ECM) | SWISAF (ECM) | SWISAF (ECM) | SWISAF (ECM) | SWISAF (ECM) | SWISAF (ECM) | SWISAF (ECM) | SWISAF (ECM) | SWISAF (ECM) |
| QUANTITY OF FANS | 2 | 1 | 1 | 1 | 1 | 2 | 1 | 1 | 1 |
| MOTOR BHP | TOTAL 2.68 | 0.48 | 0.32 | 1.51 | 0.28 | 3.88 | 0.54 | 0.46 | 1.02 |
| MOTOR HP | EACH 0.5 | 0.5 | 0.5 | 0.5 | 0.5 | 0.5 | 0.5 | 0.5 | 0.5 |
| E.S.P. | IN W.C. 0.5 | 0.5 | 0.5 | 0.5 | 0.5 | 0.5 | 0.5 | 0.5 | 0.5 |
| TOTAL CAPACITY | MBH 740.0 | 139.2 | 123 | 278.7 | 68 | 409 | 119.5 | 93.3 | 183.6 |
| SENSIBLE CAPACITY | MBH 400 | 74.2 | 61.6 | 128.5 | 37 | 211 | 75.8 | 63.4 | 135 |
| MAX FACE VELOCITY | FFM 500 | 500 | 500 | 500 | 500 | 500 | 500 | 500 | 500 |
| EAT (MIXED AIR) | DB / WB °F 78 / 69 | 81 / 71 | 81 / 72 | 76 / 69 | 79 / 69 | 76 / 66 | 77 / 66 | 77 / 66 | 80 / 67 |
| LAT | DB / WB °F 52.3 / 52.3 | 52.6 / 53.0 | 52.4 / 52.8 | 53.2 / 53.6 | 55.2 / 54.0 | 54.3 / 54.3 | 50.6 / 50.8 | 53.6 / 53.7 | 53.2 / 53.2 |
| REFRIGERANT | R-32 | R-32 | R-32 | R-32 | R-32 | R-32 | R-32 | R-32 | R-32 |
| TOTAL CAPACITY | MBH 273.0 | 47.8 | 39.9 | 109 | 28.3 | 209 | 57.8 | 48.1 | 90.4 |
| CONTROL | STAGES | MODULATING | MODULATING | MODULATING | MODULATING | MODULATING | MODULATING | MODULATING | MODULATING |
| MAX FACE VELOCITY | FFM 500 | 500 | 500 | 500 | 500 | 500 | 500 | 500 | 500 |
| LAT | DB / WB °F 70 / 59.5 | 70 / 59.2 | 70 / 59.1 | 70 / 59.5 | 70 / 59.5 | 70 / 59.5 | 70 / 59.5 | 70 / 59.5 | 70 / 59.5 |
| TYPE | NATURAL GAS | NATURAL GAS | NATURAL GAS | NATURAL GAS | NATURAL GAS | NATURAL GAS | NATURAL GAS | NATURAL GAS | NATURAL GAS |
| STAGES | MODULATING | MODULATING | MODULATING | MODULATING | MODULATING | MODULATING | MODULATING | MODULATING | MODULATING |
| CAPACITY INPUT / OUTPUT | MBH 600 / 486 | 200 / 160 | 200 / 160 | 300 / 240 | 200 / 160 | 400 / 324 | 200 / 160 | 300 / 240 | 450 / 360 |
| MAX FACE VELOCITY | FFM 500 | 500 | 500 | 500 | 500 | 500 | 500 | 500 | 500 |
| EAT / LAT | °F 20 / 120 | 20 / 120 | 20 / 120 | 20 / 120 | 20 / 120 | 20 / 120 | 20 / 120 | 20 / 120 | 20 / 120 |
| PRE-FILTERS | MERV 8 | 8 | 8 | 8 | 8 | 8 | 8 | 8 | 8 |
| FINAL FILTERS | MERV 13 | 13 | 13 | 13 | 13 | 13 | 13 | 13 | 13 |
| VOLTAGE | 3 | 3 | 3 | 3 | 3 | 3 | 3 | 3 | 3 |
| MCA | A 150.0 | 39.9 | 32.4 | 68.0 | 20.4 | 111.6 | 36.5 | 24.9 | 49.0 |
| MCOCP | A 175.0 | 60 | 50 | 90 | 30 | 125.0 | 50 | 35 | 70.0 |
| IN | 333 x 96.5 x 102 | 101.6 x 85.9 x 73.4 | 101.6 x 85.9 x 73.4 | 202.5 x 121.1 x 76.5 | 84.5 x 69.5 x 53.3 | 269 x 96.5 x 77.6 | 101.6 x 85.9 x 73.4 | 101.6 x 85.9 x 73.4 | 202.5 x 121.1 x 76.5 |
| WEIGHT | 1260 | 2675 | 2675 | 4100 | 1420 | 9156 | 2675 | 2675 | 4132 |
| MANUFACTURER | DAIKIN | DAIKIN | DAIKIN | DAIKIN | DAIKIN | DAIKIN | DAIKIN | DAIKIN | DAIKIN |
| MODEL | DRSCL18 | DRSCL18 | DRSCL18 | DRSCL26 | DRSCL26 | DRSCL26 | DRSCL18 | DRSCL18 | DRSCL18 |
| REMARKS | 1-4 | 1-4 | 1-4 | 1-4 | 1-4 | 1-4 | 1-4 | 1-4 | 1-4 |

- REMARKS:
 1. PROVIDE 8-100% MODULATING AIRSIDE ECONOMIZER WITH EXHAUST FAN.
 2. PROVIDE MERV 13 FILTER KIT.
 3. PROVIDE DAIKIN DACA-CPS-1 CONDENSATE PUMP.
 4. INTEGRAL TEMPERATURE SENSOR.

SPLIT SYSTEM INDOOR UNIT SCHEDULE

NOTES:
 1. INDOOR UNIT POWERED FROM OUTDOOR UNIT.
 2. PROVIDE MERV 13 FILTER KIT.
 3. PROVIDE DAIKIN DACA-CPS-1 CONDENSATE PUMP.
 4. INTEGRAL TEMPERATURE SENSOR.

| ID | LOCATION | NAME | COOLING CAPACITY (TONS) | REFRIGERANT | HEATING CAPACITY (BTUH) | AMBIENT TEMP DB (°F) | SEER | EER | ELECTRICAL DATA | | | OUTDOOR UNIT ID | WEIGHT | BASIS OF DESIGN | | NOTES | | |
|-------|----------|---------------|-------------------------|-------------|-------------------------|----------------------|------|------|-----------------|---------|-----------|-----------------|--------|-----------------|--------|--------|--------------|--------|
| | | | | | | | | | RLA (A) | MCA (A) | MCOCP (A) | | | VOLT (V) | PH | | MANUFACTURER | MODEL |
| IU-1 | A119 | PIANO STORAGE | 1 | R-32 | 13,600 | 100 | 25.2 | 13.2 | 12 | 12.3 | 15 | 208 | 1 | IU-01 | 132 | DAIKIN | FTXM | 1.3, 4 |
| IU-2 | A142 | OFF | 2 | R-32 | 24,000 | 100 | 22 | 12 | 16.25 | 19.8 | 20 | 208 | 1 | IU-02 | 132 | DAIKIN | FTXM | 1.3, 4 |
| IU-3 | A115 | ELECTRICAL | 2 | R-32 | 24,000 | 100 | 22 | 12 | 18.25 | 19.8 | 20 | 208 | 1 | IU-03 | 132 | DAIKIN | FTXM | 1.3, 4 |
| IU-4 | A109 | CONCESSIONS | 2 | R-32 | 24,000 | 100 | 22 | 12 | 12.3 | 15 | 208 | 1 | IU-04 | 132 | DAIKIN | FTXM | 1.3, 4 | |
| IU-5 | A108 | OFFICE | 1 | R-32 | 10,900 | 100 | 14.3 | 8.5 | 7.5 | 8 | 15 | 208 | 1 | IU-05 | 82 | DAIKIN | FTXM | 1.3, 4 |
| IU-6 | A205 | ELECTRICAL | 2 | R-32 | 24,000 | 100 | 22 | 12 | 18.25 | 19.8 | 20 | 208 | 1 | IU-06 | 132 | DAIKIN | FTXM | 1.3, 4 |
| IU-7 | A256A | OFF | 2 | R-32 | 24,000 | 100 | 22 | 12 | 18.25 | 19.8 | 20 | 208 | 1 | IU-07 | 132 | DAIKIN | FTXM | 1.3, 4 |
| IU-8 | A207 | PROJECTION RM | 2 | R-32 | 24,000 | 100 | 25.2 | 13.2 | 12 | 12.3 | 15 | 208 | 1 | IU-08 | 82 | DAIKIN | FTXM | 1.3, 4 |
| IU-9 | A303 | AV | 2 | R-32 | 24,000 | 100 | 22 | 12 | 18.25 | 19.8 | 20 | 208 | 1 | IU-09 | 132 | DAIKIN | FTXM | 1.3, 4 |
| IU-10 | A302 | FOLLOW SPOT | 2 | R-32 | 24,000 | 100 | 22 | 12 | 18.25 | 19.8 | 20 | 208 | 1 | IU-10 | 132 | DAIKIN | FTXM | 1.3, 4 |

SPLIT SYSTEM CONDENSING UNIT SCHEDULE

NOTES:
 1. PROVIDE WITH WIND BAFFLES FOR LOW AMBIENT COOLING.
 2. PROVIDE 14" CONDENSING UNIT STAND.

| ID | LOCATION | NAME | COOLING CAPACITY (TONS) | REFRIGERANT | HEATING CAPACITY (BTUH) | AMBIENT TEMP DB (°F) | SEER | EER | ELECTRICAL DATA | | | INDOOR UNIT ID | WEIGHT | BASIS OF DESIGN | | NOTES | |
|-------|----------|------|-------------------------|-------------|-------------------------|----------------------|------|-------|-----------------|---------|-----------|----------------|--------|-----------------|--------|-------|--------------|
| | | | | | | | | | RLA (A) | MCA (A) | MCOCP (A) | | | VOLT (V) | PH | | MANUFACTURER |
| OU-1 | ROOF | 1 | R-32 | 13,600 | 100 | 25.2 | 13.2 | 12 | 12.3 | 15 | 208 | 1 | IU-01 | 132 | DAIKIN | RXM | 1.2 |
| OU-2 | ROOF | 2 | R-32 | 24,000 | 100 | 22 | 12 | 16.25 | 19.8 | 20 | 208 | 1 | IU-02 | 132 | DAIKIN | RXM | 1.2 |
| OU-3 | ROOF | 2 | R-32 | 24,000 | 100 | 22 | 12 | 16.25 | 19.8 | 20 | 208 | 1 | IU-03 | 132 | DAIKIN | RXM | 1.2 |
| OU-4 | ROOF | 2 | R-32 | 24,000 | 100 | 25.2 | 13.2 | 12 | 12.3 | 15 | 208 | 1 | IU-04 | 132 | DAIKIN | RXM | 1.2 |
| OU-5 | ROOF | 1 | R-32 | 10,900 | 100 | 14.3 | 8.5 | 7.5 | 8 | 15 | 208 | 1 | IU-05 | 82 | DAIKIN | RXM | 1.2 |
| OU-6 | ROOF | 2 | R-32 | 24,000 | 100 | 22 | 12 | 18.25 | 19.8 | 20 | 208 | 1 | IU-06 | 132 | DAIKIN | RXM | 1.2 |
| OU-7 | ROOF | 2 | R-32 | 24,000 | 100 | 22 | 12 | 18.25 | 19.8 | 20 | 208 | 1 | IU-07 | 132 | DAIKIN | RXM | 1.2 |
| OU-8 | ROOF | 4 | R-32 | 24,000 | 100 | 25.2 | 13.2 | 12 | 12.3 | 15 | 208 | 1 | IU-08 | 132 | DAIKIN | RXM | 1.2 |
| OU-9 | ROOF | 2 | R-32 | 24,000 | 100 | 22 | 12 | 18.25 | 19.8 | 20 | 208 | 1 | IU-09 | 132 | DAIKIN | RXM | 1.2 |
| OU-10 | ROOF | 2 | R-32 | 24,000 | 100 | 22 | 12 | 18.25 | 19.8 | 20 | 208 | 1 | IU-10 | 132 | DAIKIN | RXM | 1.2 |

VARIABLE AIR VOLUME TERMINAL UNIT SCHEDULE

NOTES:
 1. ALL PERFORMANCE BASED ON TESTS CONDUCTED IN ACCORDANCE WITH ASHRAE 130-2008 AND AHRI 880-2011.
 2. ALL AIRFLOW, PRESSURE LOSSES AND HEATING PERFORMANCE VALUES HAVE BEEN CORRECTED FOR THE PROJECT SITE ALTITUDE.
 3. COIL AIR PRESSURE DROP SHOWN IS FOR COOLING CFM.
 4. ALL NC LEVELS DETERMINED USING AHRI 885-2008 APPENDIX E.
 5. IN THE "STEPS" COLUMN, CODE "S" DENOTES A MODULATING SCR HEATER.
 6. ELECTRIC HEATING COILS SHALL BE HOUSED IN AN ATTENUATOR SECTION THAT IS INTEGRAL TO THE TERMINAL UNIT.
 7. THE MINIMUM SUPPLY CIRCUIT AMPCY (MCA) AND MAXIMUM OVERCURRENT PROTECTION (MOP) RATINGS WERE CALCULATED IN ACCORDANCE WITH UL STANDARDS BASED ON MOTOR AND ELECTRIC COIL FULL LOAD CURRENT RATINGS.

| ID | NO. | LOCATION | NAME | TYPE | AIRFLOW (CFM) | | STATIC PRESS (IN WG) | ELECTRIC HEATING COIL DATA | | | MAX NOISE CRITERIA (NC) | | ELECTRICAL DATA | | | BASIS OF DESIGN | | NOTES | | | | |
|-------|------|---------------|-------------|------|---------------|-----|----------------------|----------------------------|-----------------------|------------------|-------------------------|-------|-----------------|-------|---------|-----------------|----------|-------|-----|--------------|-------|-----|
| | | | | | MAX | MIN | | CAPACITY (BTUH) | HEATING AIRFLOW (CFM) | TEMP DB (°F) ENT | HTG ELEMENT KW | STEPS | RAD | DISCH | MCA (A) | MCOCP (A) | VOLT (V) | | PH | MANUFACTURER | MODEL | |
| VAV-1 | A112 | BOH HALL | SINGLE DUCT | 560 | 170 | 0.5 | 9,490 | 220 | 55 | 95 | 3 | S | 19 | 25 | 13.5 | 15 | 277 | 1 | Yes | TITUS | DESV | 1-7 |
| VAV-2 | A128 | DRESSING ROOM | SINGLE DUCT | 150 | 45 | 0.5 | 3,451 | 80 | 55 | 95 | 1.5 | S | 10 | 14 | 6.8 | 15 | 277 | 1 | Yes | | | |

| | |
|-----------|---|
| (R) | RELOCATED PHASE |
| Ø | |
| A | AMPERE |
| AC | ABOVE COUNTER |
| AF | AMP FRAME (CIRCUIT BREAKER) |
| AC | AMPERE INTERRUPTING CAPACITY |
| AL | ALUMINUM |
| AMP | AMPERE |
| AP | WIRELESS ACCESS POINT |
| AT | ATP TRIP (CIRCUIT BREAKER OR FUSE) |
| ATS | AUTOMATIC TRANSFER SWITCH |
| AV | AUDIO-VISUAL AUDIO-VISUAL |
| AWG | AMERICAN WIRE GAUGE |
| BAS | BUILDING AUTOMATION SYSTEM |
| BJ | BONDING JUMPER |
| BKR | BREAKER |
| BMS | BUILDING MANAGEMENT SYSTEM |
| C | CONDUIT |
| CAS | CASING |
| CATV | CABLE TELEVISION |
| CB | CIRCUIT BREAKER |
| CCTV | CLOSED CIRCUIT TELEVISION |
| CE | COVER ELEVATION |
| CEM | CEMENT |
| CFCI | CONTRACTOR FURNISHED CONTRACTOR INSTALLED |
| CG | CORNER GUARD |
| CH | CHANNEL |
| CJ | CONSTRUCTION JOINT |
| CKT | CIRCUIT |
| CKT BK | CIRCUIT BREAKER |
| CL | CIRCUIT LINE |
| CM | CEILING MOUNTED |
| CMP | CORRUGATED METAL PIPE |
| CO | CONDUIT ONLY |
| COMP | COMPOSITE |
| COORD | COORDINATE |
| COORD | COORDINATE |
| CSK | COUNTERSUNK |
| CT | CURRENT TRANSFORMER |
| CTL | CUT CONTROL |
| CU | COPPER |
| CVW | COMBINATION WASTE AND VENT |
| DB | DECIBEL |
| DC | DIRECT CURRENT |
| DISC | DISCONNECT |
| DIST | DISTRIBUTION PANELBOARD |
| DW | DISHWASHER |
| ECS | EMERGENCY COMMUNICATION SYSTEM |
| EGB | ELECTRICAL GROUNDING BUSBAR |
| EMD | ESTIMATED MAXIMUM DEMAND |
| EMGB | ELECTRICAL MAIN GROUNDING BUSBAR |
| EPP | EXPLOSION PROOF |
| ERMS | ENERGY REDUCTION MAINTENANCE SWITCH |
| EW | ELECTRIC WATER COOLER |
| FA | FIRE ALARM |
| FAA | FIRE ALARM ANNUCIATOR |
| FACP | FIRE ALARM CONTROL PANEL |
| FC | FOOT CANDLE |
| FLA | FULL LOAD AMPS |
| FS | FLOW SWITCH |
| FSD | FIRE SMOKE DAMPER |
| G | EQUIPMENT GROUNDING CONDUCTOR |
| GEN | GENERATOR |
| GFI, GFCI | GROUND FAULT CIRCUIT INTERRUPTER |
| GFPE | GROUND FAULT PROTECTION OF EQUIPMENT |
| GND | EQUIPMENT GROUNDING CONDUCTOR |
| HH | HANDHOLE |
| HOA | HAND-OFF-AUTOMATIC |
| HP | HORSE POWER |
| IG | INTERCOM |
| IC | ISOLATED GROUND |
| JB | JUNCTION BOX |
| KAIC | THOUSAND AMPERE INTERRUPTING CIRCUIT |
| KV | KILOVOLT |
| kVA | KILOVOLT AMPERES |
| KW | KILOWATT |
| LT | LIGHT |
| LTG | LIGHTING |
| MCA | MINIMUM CIRCUIT AMPACITY |
| MCB | MAIN CIRCUIT BREAKER |
| MCC | MOTOR CONTROL CENTER |
| MH | MANHOLE |
| MLO | MAIN LUGS ONLY |
| MOCF | MAXIMUM OVERCURRENT PROTECTION |
| MRTS | MOTOR RATED TOGGLE SWITCH |
| MSB | MAIN SWITCHBOARD |
| MTD | MOUNTED |
| MTG | MOUNTING |
| MTS | MAIN TRANSFER SWITCH |
| N | NEUTRAL |
| NC | NORMALLY CLOSED |
| NF | NON-FUSED |
| NIGHT | NIGHT LIGHT |
| NO | NORMALLY OPEN |
| OFCI | OWNER FURNISHED CONTRACTOR INSTALLED |
| OSBY | OUTSIDE SCREW AND YOKE |
| P | POLE(S) |
| PA | PUBLIC ADDRESS |
| PB | PULL BOX |
| PH | PHASE |
| PV | POST INDICATOR VALVE |
| PNL | PANEL |
| PWR | POWER |
| RCF | REFLECTED CEILING PLAN |
| RECP | RECEPTACLE |
| REF | REFERENCE |
| RESP | RESPONSIVE |
| SCCR | SHORT CIRCUIT CURRENT RATING |
| SD | SMOKE DAMPER |
| SEC | SECONDARY |
| SPD | SURGE PROTECTION DEVICE |
| SWBD | SWITCHBOARD |
| TBB | TELECOMMUNICATIONS BONDING BACKBONE |
| TC | TIME CLOCK |
| TGB | TELECOMMUNICATIONS GROUNDING BUSBAR |
| TMSB | TELECOMMUNICATIONS MAIN GROUNDING BUSBAR |
| TO | TELECOMMUNICATIONS OUTLET |
| TR | TELECOMMUNICATIONS ROOM |
| TS | TAMPER SWITCH |
| TV | TELEVISION |
| UG | UNDERGROUND |
| UPS | UNINTERRUPTIBLE POWER SUPPLY |
| V | VOLT |
| VA | VOLT-AMPERE |
| VFD | VARIABLE FREQUENCY DRIVE |
| W | WIRE |
| WA | TELECOMMUNICATIONS WORK AREA |
| WG | WIRE GUARD |
| WPD | WEATHER-PROOF (NEMA 3R) |
| XFMR | TRANSFORMER |

NOTE
ALL NOTES ON THIS SHEET ARE APPLICABLE TO ALL OTHER SHEETS IN THIS SET.
THE SYMBOLS AND ABBREVIATIONS SHOWN ON THIS SHEET MAY OR MAY NOT BE APPLICABLE IN THIS SET OF DRAWINGS.

NOTES

GENERAL NOTES

- MODIFICATIONS TO EXISTING POWER DISTRIBUTION EQUIPMENT: MATCH EXISTING MANUFACTURER, SWITCH TYPE, FUSE TYPE, BREAKER TYPE AND KAC RATING FOR ALL INSTALLED DEVICES.
- EXISTING PANEL DIRECTORIES AT PANELS AFFECTED BY WORK: PROVIDE UPDATED TYPED PANEL DIRECTORY. CONSULT OWNER FOR INPUT ON LABELING OF ALL EXISTING CIRCUITS.
- DEVICES AND LIGHT FIXTURES DENOTED 'ER' ARE EXISTING TO BE RELOCATED. NOTIFY AE IF DEVICES OR FIXTURES ARE DAMAGED.

GENERAL DEMOLITION NOTES

- ITEMS INDICATED ON DEMOLITION PLANS ARE BASED ON AS-BUILT DRAWINGS AND FIELD OBSERVATIONS AND ARE INTENDED TO GIVE THE BIDDER A GENERAL REPRESENTATION OF EXISTING CONDITIONS.
- REMOVE ALL ITEMS SHOWN FULL-TONE OR NOTED ELSEWHERE IN THE DOCUMENTS TO BE REMOVED OR DEMOLISHED. DEMOLISH ADDITIONAL ITEMS NOT SHOWN ON DRAWINGS, BUT WHICH MUST BE REMOVED TO COMPLETE THE PROJECT.
- ITEMS SHOWN HALF-TONE ARE EXISTING TO REMAIN.
- RELOCATE ITEMS DENOTED 'ER'. SEE LIGHTING, POWER AND/OR SPECIAL SYSTEM SHEETS FOR NEW LOCATIONS. 'ER' IS DEFINED AS EXISTING TO BE RELOCATED.
- EXISTING CONDUIT MAY REMAIN IF ALL THE FOLLOWING ARE TRUE:
A. IT CAN BE REUSED TO FEED DEVICES INSTALLED UNDER THIS CONTRACT.
B. IT DOES NOT INTERFERE WITH OTHER TRADES.
C. IT WAS ORIGINALLY INSTALLED MEETING SPECIFICATIONS RELATED TO THIS PROJECT. IT WILL NOT BE EXPOSED IN A FINISHED AREA (UNLESS NOTED OTHERWISE).
- PROVIDE ELECTRICAL DEMOLITION ASSOCIATED WITH MECHANICAL EQUIPMENT TO BE REMOVED. IN ADDITION TO DEVICES SHOWN, REFER TO MECHANICAL AND ARCHITECTURAL DEMOLITION SHEETS TO DETERMINE EQUIPMENT TO BE REMOVED.
- MAINTAIN FUNCTIONALITY OF ALL EXISTING LOW VOLTAGE SYSTEMS INCLUDING, BUT NOT LIMITED TO, TELECOM CABLING NETWORKS, INTERCOM, CLOCKS, FIRE ALARM, SAFETY AND SECURITY DURING ALL PHASES OF CONSTRUCTION. PROVIDE TEMPORARY INTERCONNECTIONS AS REQUIRED TO ACCOMMODATE CONSTRUCTION SCHEDULE.

GENERAL SITE PLAN NOTES

- ALL LIGHTING AND POWER CONDUCTORS SHALL BE INSTALLED BETWEEN 24" (MINIMUM) AND 36" (MAXIMUM) BELOW FINISHED GRADE.
- ALL COMMUNICATIONS CONDUIT AND CABLES SHALL BE INSTALLED 36" (MINIMUM) BELOW FINISHED GRADE.
- ALL CONDUCTORS FOR EXTERIOR LIGHTING AND POWER CIRCUITS SHALL BE #10 AWG MINIMUM.
- POLE BASE HEIGHTS:
A. PEDESTRAIN POLES IN SIDEWALKS OR PLAZAS - CONCRETE BASE WITH RUBBED FINISH TOP OF FOOTINGS TO BE SHOWN ON FINISH SHEETS.
B. PEDESTRAIN POLES IN LAWN - CONCRETE BASE WITH ROUNDED EDGES AND RUBBED FINISH. BASE EXTENDS 4" ABOVE FINISHED GRADE.
C. PARKING LOT POLES BEHIND CURBS - CONCRETE BASE WITH ROUNDED EDGES AND RUBBED FINISH. BASE 2'-4" ABOVE FINISHED GRADE.

GENERAL POWER NOTES

- VERIFY ANY NEUTRAL WIRES REQUIRED ON 1Ø OR 3Ø MECHANICAL UNITS FURNISHED UNDER DIVISION 23. IF REQUIRED, PROVIDE NEUTRAL.
- PROVIDE DEDICATED 120-VOLT CIRCUITS TO ALL HVAC BAS CONTROL DEVICES AND PANELS. COORDINATE QUANTITY WITH DIVISION 23. UTILIZE NEAREST AVAILABLE SPARE 120-VOLT, 2Ø/1 BREAKER. LABEL TYPED PANEL DIRECTORY ACCORDING TO LOAD BEING SERVED.
- IN ADDITION TO DEVICES SHOWN, SEE SCHEDULE SHEETS FOR CONNECTIONS TO ALL MECHANICAL EQUIPMENT.
- LOCATE SWITCHES FOR CONTROL OF FANS IN TWO-GANG BOX WITH LIGHTS SWITCH WHERE APPLICABLE.
- PROVIDE WIRING CONDUCTORS FOR ALL WARM AIR DRYER CIRCUITS. PROVIDE LOCKOUT DEVICES AT ALL BREAKERS SERVING WARM AIR DRYERS.

GENERAL DEVICE BOX NOTES

- SEE SYMBOLS LEGEND THIS SHEET FOR MOUNTING HEIGHTS UNLESS NOTED OTHERWISE ON DRAWINGS.
- ALL MOUNTING HEIGHTS ARE TO CENTERLINE OF BOXES UNLESS NOTED OTHERWISE.
- PROVIDE BOX EXTENDER FOR FLUSH INSTALLATION OF DEVICES LOCATED IN ARCHITECTURAL CASEWORK THAT IS FLUSH WITH ADJACENT WALL, SUCH AS RECEPTACLES FOR GARBAGE DISPOSERS.
- FLOOR BOXES: OBTAIN OWNER APPROVAL OF ALL BOX LOCATIONS PRIOR TO ROUGH IN. PROVIDE DEVICE PLATES AT DEVICES AND BLANK PLATES AT ALL UNUSED COMPARTMENTS.
- COORDINATE LOCATION OF DEVICE BOXES FOR SWITCHES, RECEPTACLES, AND SYSTEMS DEVICES WITH MARKERBOARDS. ADJUST BOX LOCATIONS TO AVOID MARKERBOARDS.
- COORDINATE LOCATION OF DEVICE BOXES FOR SWITCHES, RECEPTACLES, AND SYSTEMS DEVICES WITH TACKBOARDS. ADJUST BOX LOCATIONS TO AVOID TACKBOARDS. PROVIDE BOX EXTENDER FOR FLUSH INSTALLATION WHERE DEVICES MUST BE MOUNTED AT TACKBOARD/TACKWALL.
- CEILING MOUNTED RECEPTACLES: AT SUSPENDED CEILING, ROUTE POWER TO RECEPTACLE VIA FLEXIBLE METALLIC CONDUIT WITH 6-FOOT SERVICE LOOP. FEED FMC FROM A J-BOX RIGIDLY SUPPORTED A MAXIMUM OF 24-INCHES ABOVE SUSPENDED CEILING OR AT BOTTOM OF STRUCTURE ABOVE, WHICHEVER IS LOWER. LOCATE J-BOX DIRECTLY ABOVE RECEPTACLE AND SUPPORT VIA STRUCTURE, OR VIA THREAD ROD AND UNISTRUT HUNG FROM STRUCTURE ABOVE IN HIGH STRUCTURE APPLICATIONS.
- DEVICES RECESSED IN MILLIONS: BACK BOXES TO BE RECESSED FOR FLUSH INSTALLATION OF DEVICE AND WALLPLATE. EXTEND CONCEALED CONDUIT IN MILLION UP TO WALL ABOVE AND STUB OUT ABOVE ACCESSIBLE CEILING. IN AREAS WITH NO CEILING, EXTEND CONDUIT TOWARDS CABLING SOURCE TO ABOVE NEAREST ACCESSIBLE CEILING.

GENERAL LIGHTNING PROTECTION AND GROUNDING NOTES


- ELECTRICAL CONTRACTOR SHALL BE RESPONSIBLE FOR WIRING ALL ELECTRICAL ITEMS SHOWN ON THE DRAWINGS.
- ALL UNDERGROUND CONNECTIONS OF GROUNDING CONDUCTORS AND LIGHTNING PROTECTION SHALL BE BY EXOTHERMIC WELD. ALL BUILDING CONNECTIONS TO STRUCTURAL STEEL SHALL BE BY EXOTHERMIC WELD.
- PROVIDE GROUND RING ELECTRODE AROUND ENTIRE BUILDING. 17 GAUGE 32 STRAND COPPER. BURIAL DEPTH SHALL BE 30". LOCATE BETWEEN 3'-0" AND 8'-0" FROM BUILDING FOUNDATION. CONNECT TO GROUND RODS AT EACH CORNER OF BUILDING.
- UNDER SLAB STATIC GROUND CONDUCTORS SHALL BE BARE 17 GAUGE 32 STRAND COPPER.
- ALL DOWN CONDUCTORS AND MAIN CONDUCTORS OF LIGHTNING PROTECTION SYSTEM SHALL BE 17 GAUGE 32 STRAND COPPER.
- FURNISH AND INSTALL 1" PVC SLEEVE THRU FOUNDATION WALLS FOR ALL FOUNDATION PENETRATIONS.
- NO BEND OF A CONDUCTOR SHALL FORM AN INCLUDED ANGLE OF LESS THAN 90°, NOR SHALL IT HAVE A RADIUS OF BEND LESS THAN 6".
- ALL MAIN CONDUCTORS SHALL BE COPPER, EXCEPT WHERE ALUMINUM IS REQUIRED AT MECHANICAL EQUIPMENT. PROVIDE BIMETAL PARALLEL SPLICER AT TRANSITION TO ALUMINUM.
- PROVIDE TYPE "P" AIR TERMINALS ON PARAPET. SPACED AT NO GREATER THAN 20'-0" APART, AND LOCATED WITHIN 2'-0" OF CORNERS OF STRUCTURE.

GENERAL SYSTEMS NOTES

- TELECOMMUNICATIONS OUTLETS: PROVIDE TWO-GANG BOX (2.25-INCH DEEP MINIMUM) WITH SINGLE-GANG STRAP MOUNT PLASTER RING AND 1-INCH CONDUIT STUBBED INTO ACCESSIBLE SPACE ABOVE FINISHED CEILING (EXCEPTION: VOICE-ONLY OR VIDEO-ONLY OUTLETS PER NOTE BELOW).
- TELECOMMUNICATIONS OUTLET LOCATED AS ROUGH ONLY (NO SUBSCRIPTS): INSTALL PER NOTE ABOVE, WITH BLANK 3ØSS SINGLE-GANG WALLPLATE.
- VOICE-ONLY OR VIDEO-ONLY TELECOMMUNICATIONS OUTLET: PROVIDE SINGLE-GANG BOX WITH 1-INCH CONDUIT STUBBED INTO ACCESSIBLE SPACE ABOVE FINISHED CEILING.
- MISCELLANEOUS LOW VOLTAGE OUTLETS (CALL STATIONS, HANDSETS, VOLUME CONTROL, MICROPHONE OUTLETS, SURFACE-MOUNT WALL SPEAKERS AND FIRE ALARM DEVICES): PROVIDE SINGLE-GANG BOX WITH 3/4-INCH CONDUIT STUBBED INTO ACCESSIBLE SPACE ABOVE FINISHED CEILING.
- INSULATED BUSINGS: PROVIDE BUSINGS ON ALL CONDUIT STUB UPS INCLUDING BUT NOT LIMITED TO, OUTLETS FOR TELECOMMUNICATIONS, FIRE ALARM, SECURITY, ACCESS CONTROL, MASS NOTIFICATION, PUBLIC ADDRESS, ALL OTHER LOW VOLTAGE INTERCOMMUNICATIONS AND UNUSED STUB-UPS OR STUB-UPS INDICATED FOR FUTURE USE.
- FLOOR BOXES CONTAINING TELECOMMUNICATIONS OUTLETS: FOR EACH LOW-VOLTAGE COMPARTMENT, ROUTE 1-INCH CONDUIT WITH PULL STRING UNDER FLOOR UP NEAREST WALL, AND STUB INTO ACCESSIBLE SPACE ABOVE FINISHED CEILING. LABEL CONDUIT END 'FLOOR BOX'.
- SLEEVES FOR LOW VOLTAGE CABLES: PROVIDE 2-INCH SLEEVES UNLESS NOTED OTHERWISE. COORDINATE WITH PATH OF DUCTWORK AND GIBS CEILING TO ENSURE ACCESSIBILITY. EXTEND SLEEVES AS REQUIRED. INSTALL ALL SLEEVES 4-INCHES ABOVE HIGHER CEILING OF TWO ADJACENT SPACES. REFER TO ROOM FINISH SCHEDULES AND REFLECTED CEILING HEIGHTS. STUB SLEEVES INTO JOIST SPACE OF FINISHED ROOMS WITH EXPOSED STRUCTURE. PROVIDE INSULATED BUSINGS ON BOTH ENDS OF ALL SLEEVES, INCLUDING UNUSED SLEEVES. PROVIDE GROUT OR ESCRETS TO SECURE SLEEVES TO WALL. PROVIDE FIRE-RATED SLEEVES AT ALL FIRE-RATED WALLS.
- PROVIDE ADDITIONAL CONDUIT, BOXES, CONDUCTORS AND OVERCURRENT PROTECTION FOR 120-VOLT BRANCH CIRCUITS NOT SPECIFICALLY COVERED UNDER DIVISION 26 WORK, BUT REQUIRED TO COMPLETE DIVISION 18 AND 26 WORK. DEVICES SHALL INCLUDE, BUT NOT BE LIMITED TO, POWER SUPPLIES FOR DOOR HARDWARE, ACCESS CONTROL, FIRE ALARM AND VIDEO SURVEILLANCE.
- CARD READERS: PROVIDE RECESSED SINGLE-GANG BOX WITH GASKETED BLANK COVERPLATE AND EMPTY 1-INCH CONDUIT STUBBED INTO NEAREST ACCESSIBLE SPACE ABOVE FINISHED CEILING OR JOIST SPACE OF ADJACENT EXPOSED STRUCTURE. LABEL CONDUIT END 'CARD READER'. COORDINATE FINAL CARD READER LOCATIONS WITH OWNERS ACCESS CONTROL CONTRACTOR.
- PROVIDE WATERFALL DROPOUTS AT ALL CABLE TRAY LOCATIONS ABOVE RUNWAYS, WALL/FLOOR MOUNTED RACKS, AND EQUIPMENT ENCLOSURES.
- AUDIO VISUAL (AV) SYSTEMS: PROVIDE RECESSED BOXES, CONDUIT AND PULL STRINGS FOR ALL SYSTEM COMPONENTS. SEE TA SERIES SHEETS.


- ALL SPEAKERS AND HORN-TYPE SPEAKERS ARE PART OF THE INTERCOM SYSTEM UNLESS NOTED OTHERWISE.
- PROVIDE SURFACE MOUNT ENCLOSURE AND Baffle FOR ALL SPEAKERS IN FINISHED SPACES WITH NO CEILING (EXPOSED STRUCTURE).
- WIRELESS ACCESS POINTS: INSTALL ONE HORIZONTAL DATA CABLE, PER SPECIFICATIONS, TO EACH MAP SHOWN ON TA SERIES SHEETS. TERMINATE EACH CABLE IN SURFACE BOX AND COIL A 6" SLACK LOOP.
- UTILIZE SLEEVES AND FIRE RATED SLEEVES AT RATED WALLS PROVIDED UNDER DIVISION 26 FOR INSTALLATION OF ALL LOW VOLTAGE CABLING. FOLLOW INDUSTRY STANDARDS TO MAINTAIN 40% FILL REQUIREMENTS IN ALL SLEEVES (SUPERSEDES NEC - DO NOT FILL SLEEVES TO CAPACITY). PROVIDE ADDITIONAL SLEEVES MEETING DIVISION 26 REQUIREMENTS AS REQUIRED.
- SYSTEM PANEL LOCATIONS: AUXILIARY SYSTEM PANELS, POWER SUPPLIES OR OTHER EQUIPMENT ENCLOSURES SHALL NOT BE LOCATED IN TELECOM ROOMS UNLESS NOTED OTHERWISE. IF DRAWINGS DO NOT DEPICT LOCATIONS FOR AUXILIARY COMPONENTS, CONSULT OWNER OR AE FOR APPROVED LOCATIONS PRIOR TO EQUIPMENT INSTALL.

- PROVIDE MINIMUM CANDELA RATINGS FOR ROOMS WITH WALL MOUNTED VISUAL NOTIFICATION APPLIANCES AS FOLLOWS:
• $20 \times 20' = 15cd$
• $28 \times 28' = 30cd$
• $42 \times 42' = 60cd$
• $40 \times 40' = 110cd$
- PROVIDE MINIMUM CANDELA RATINGS FOR ROOMS WITH CEILING MOUNTED VISUAL NOTIFICATION APPLIANCES AS FOLLOWS:
• $20 \times 20' = 15cd$
• $28 \times 28' = 30cd$
• $42 \times 42' = 60cd$
• $40 \times 40' = 110cd$
- INCREASE DEVICE RATINGS/SETTINGS WHEN LOCATED OFF-CENTER IN ROOMS TO MAINTAIN NPFA COVERAGE.
- VISUAL DEVICES IN CORRIDORS SHALL BE 15cd. VISUAL DEVICES LOCATED IN OTHER AREAS SHALL BE 110cd UNLESS NOTED OTHERWISE.
- IN ADDITION TO DEVICES SHOWN, SEE SCHEDULE SHEETS FOR FIRE ALARM SYSTEM DEVICES CONNECTIONS TO MECHANICAL EQUIPMENT.
- PROVIDE FIRE ALARM MONITORING OF ALL FLOW AND TAMPER SWITCHES. CONFIRM QUANTITIES AND LOCATION WITH DIVISION 21.
- UTILIZE SLEEVES AND FIRE RATED SLEEVES AT RATED WALLS PROVIDED UNDER DIVISION 26 FOR INSTALLATION OF ALL LOW VOLTAGE CABLING. FOLLOW INDUSTRY STANDARDS TO MAINTAIN 40% FILL REQUIREMENTS IN ALL SLEEVES (SUPERSEDES NEC - DO NOT FILL SLEEVES TO CAPACITY). PROVIDE ADDITIONAL SLEEVES MEETING DIVISION 26 REQUIREMENTS AS REQUIRED.
- SYSTEM PANEL LOCATIONS: AUXILIARY SYSTEM PANELS, POWER SUPPLIES OR OTHER EQUIPMENT ENCLOSURES SHALL NOT BE LOCATED IN TELECOM ROOMS UNLESS NOTED OTHERWISE. IF DRAWINGS DO NOT DEPICT LOCATIONS FOR AUXILIARY COMPONENTS, CONSULT OWNER OR AE PRIOR TO EQUIPMENT INSTALLATION.
- DUCT SMOKE DETECTION: DETERMINE QUANTITY AND PLACEMENT OF DETECTORS REQUIRED FOR COVERAGE OF DUCT WORK BASED ON NFPA REQUIREMENTS. PROVIDE MECHANICAL EQUIPMENT FAN SHUTDOWN RELAY AT ALL DUCT DETECTORS. SEE HVAC PLANS FOR EQUIPMENT LOCATIONS. COORDINATE SHUTDOWN CONTROL WITH DIVISION 28.
- SMOKE DAMPERS AND FIRE-SMOKE DAMPERS: PROVIDE FIRE ALARM CONNECTION AND 120-VOLT POWER TO EACH FIRE-SMOKE DAMPER SHOWN ON HVAC PLANS. PROVIDE DEDICATED CIRCUIT TO DAMPERS, ROUTED THROUGH NORMALLY CLOSED FIRE ALARM RELAY, MOUNTED ON WALL IN NEAREST ELECTRICAL ROOM. COORDINATE WITH DAMPER MANUFACTURER FOR SPECIFIC DAMPER LOAD REQUIREMENTS. RELAY SHALL BE CONTROLLED BY FACP, SUCH THAT, ON GENERAL ALARM DAMPERS CLOSE. FIRE ALARM CONNECTION TO DAMPER SHALL BE A SUPERVISORY CIRCUIT MONITORING STATUS OF INTEGRAL SMOKE DETECTOR, AND SHALL PROVIDE REMOTE FIRE-SMOKE DAMPER RESET. FACP SHALL INITIATE A SUPERVISORY SIGNAL WHEN INTEGRAL DETECTOR GOES INTO ALARM. FIRE-SMOKE DAMPERS MAY BE GROUPED TOGETHER ON SUPERVISORY CIRCUITS TO SIMPLY WIRING. COORDINATE REQUIREMENTS WITH FIRE-SMOKE DAMPER MANUFACTURER. UTILIZE SPARE 2Ø/1 BREAKERS. LABEL TYPED PANEL DIRECTORY 'FIRE-SMOKE DAMPERS - (INDICATE AREA SERVED)'.
- PROVIDE ONE HORIZONTAL DATA CABLE, PER SPECIFICATIONS, TO EACH CCTV CAMERA SHOWN ON E3 SERIES SHEETS. TERMINATE EACH INTERIOR AND BUILDING MOUNT CABLE IN SURFACE BOX AND COIL A 6" SLACK LOOP. DO NOT MAKE PENETRATIONS ON EXTERIOR OF BUILDING.

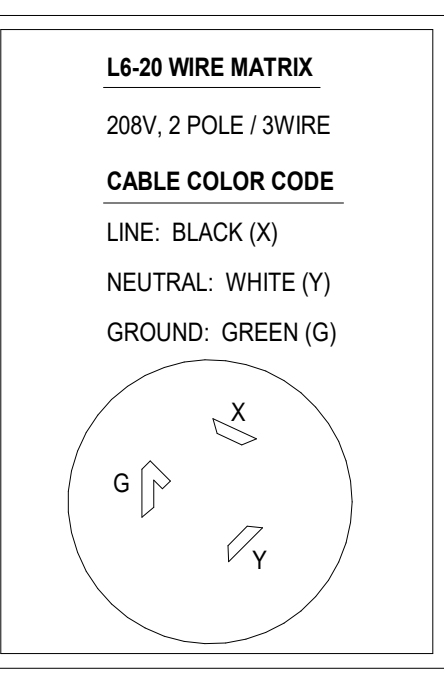


ELECTRICAL SYMBOLS


LIGHTING

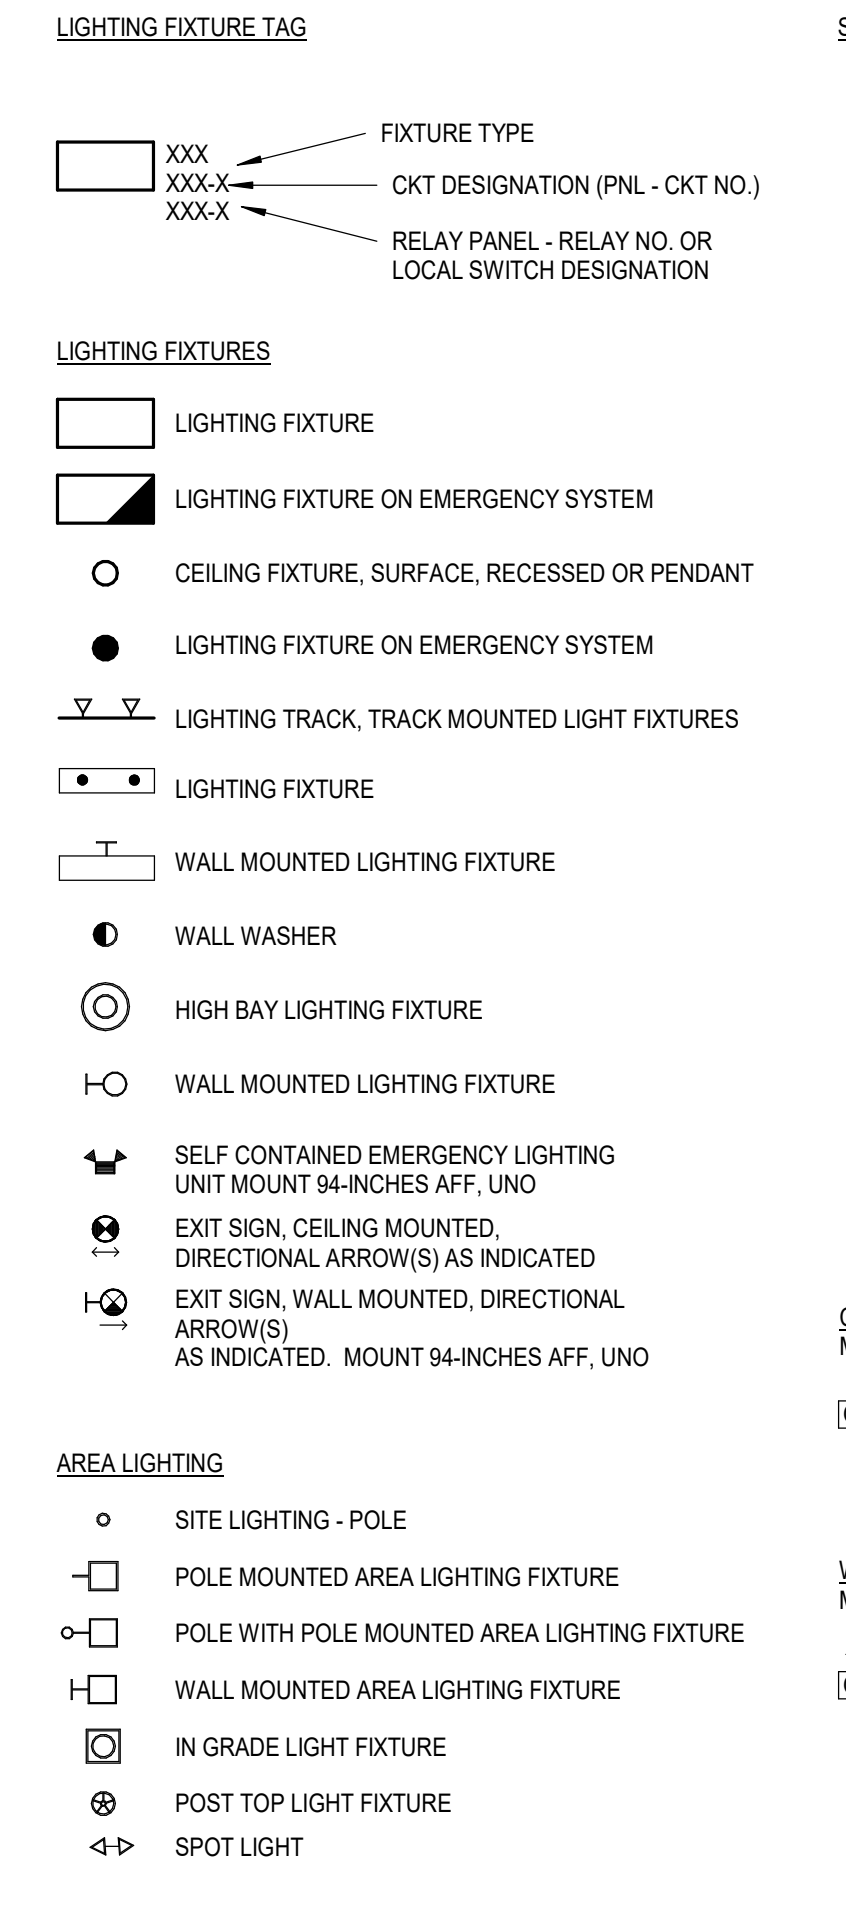


SWITCHES AND WALL-BOX CONTROLS

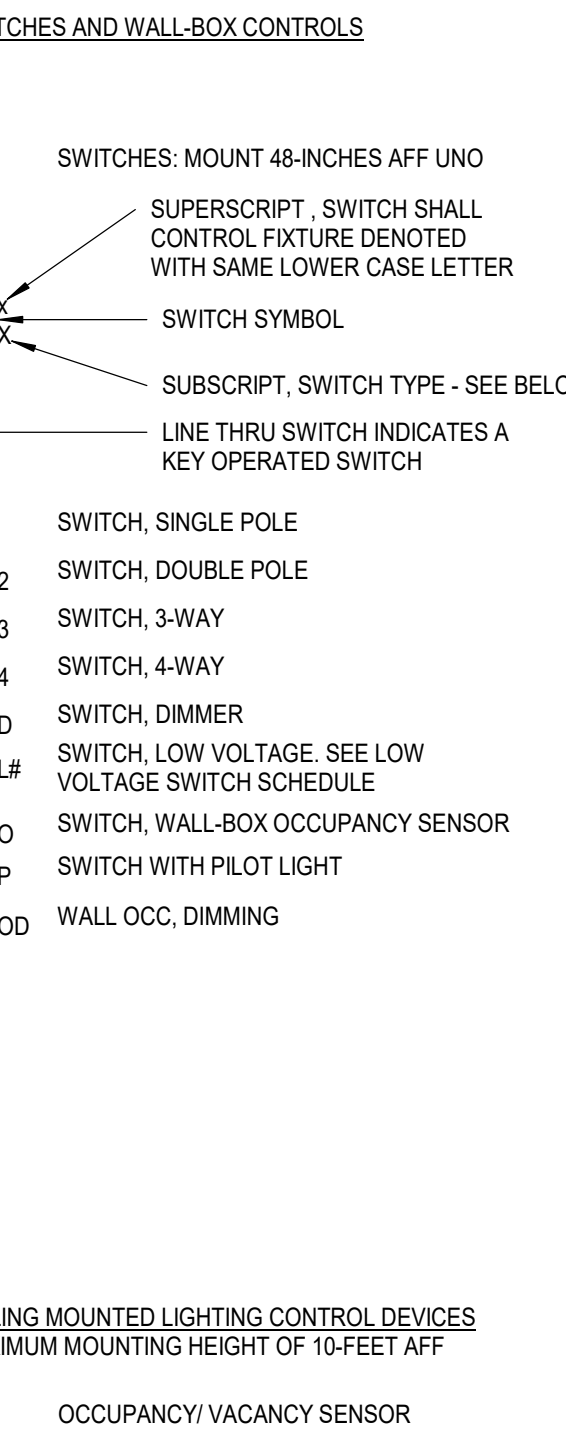


CEILING MOUNTED LIGHTING CONTROL DEVICES

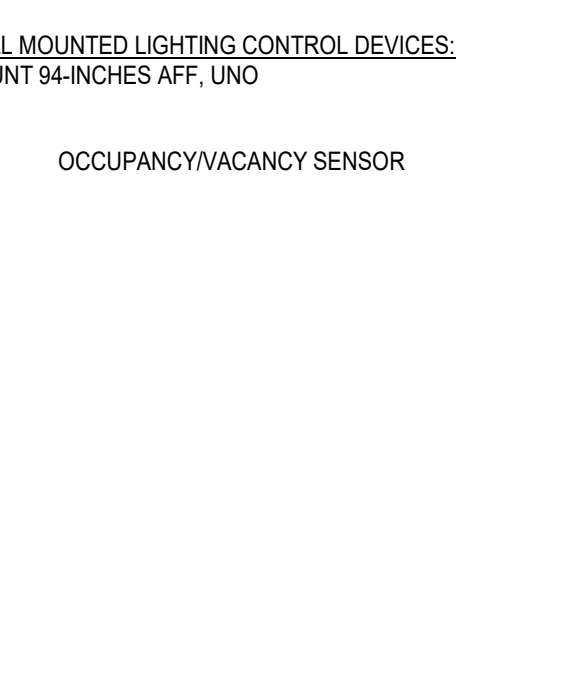


POWER

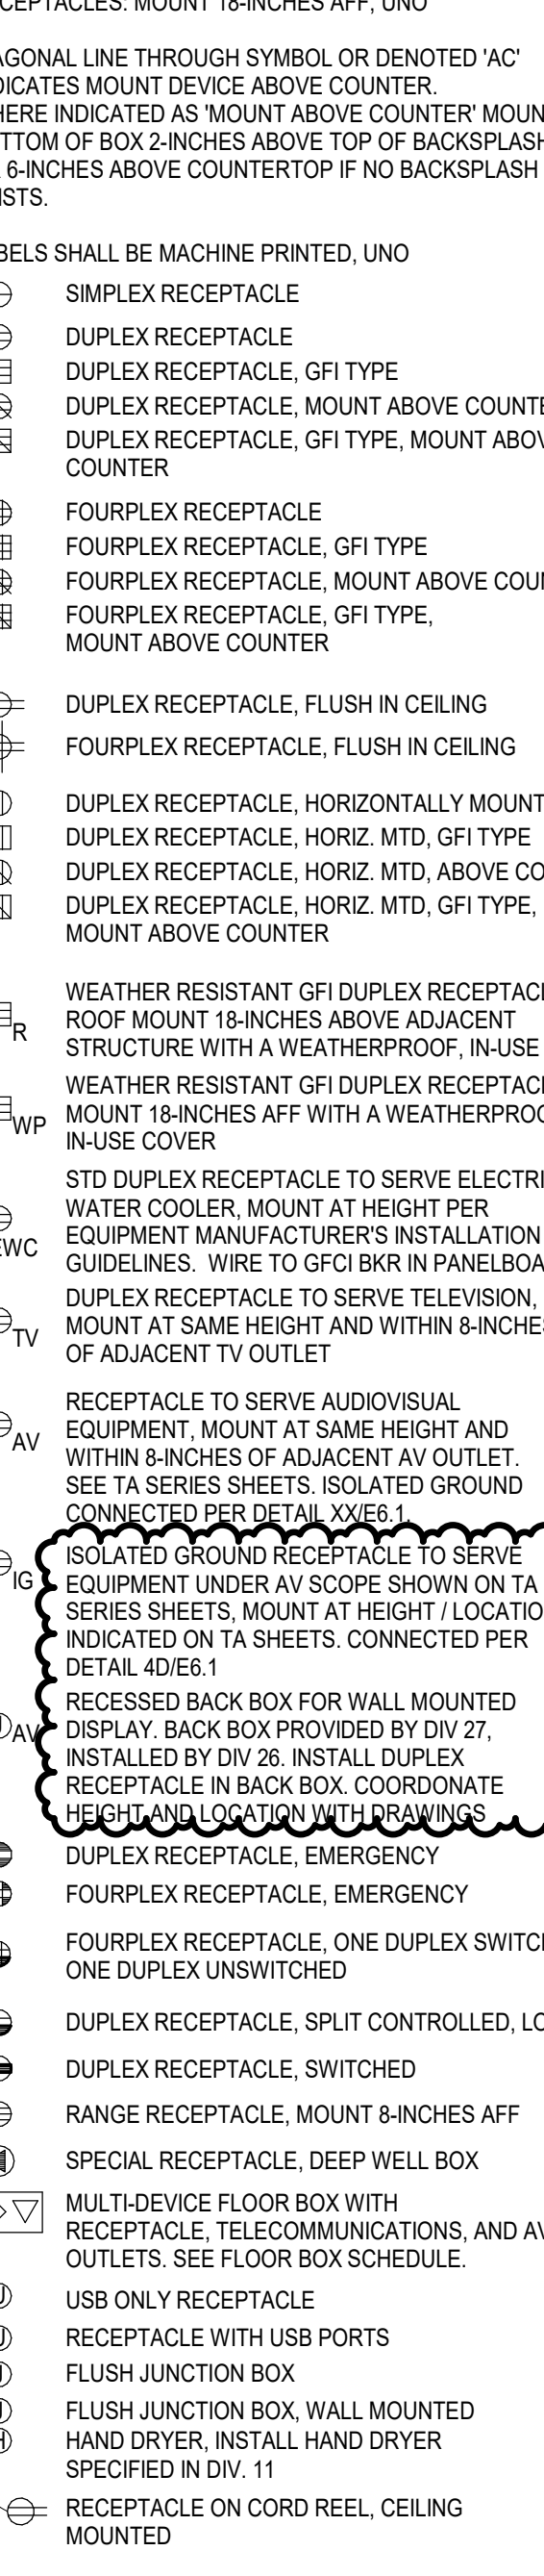


COMMUNICATIONS

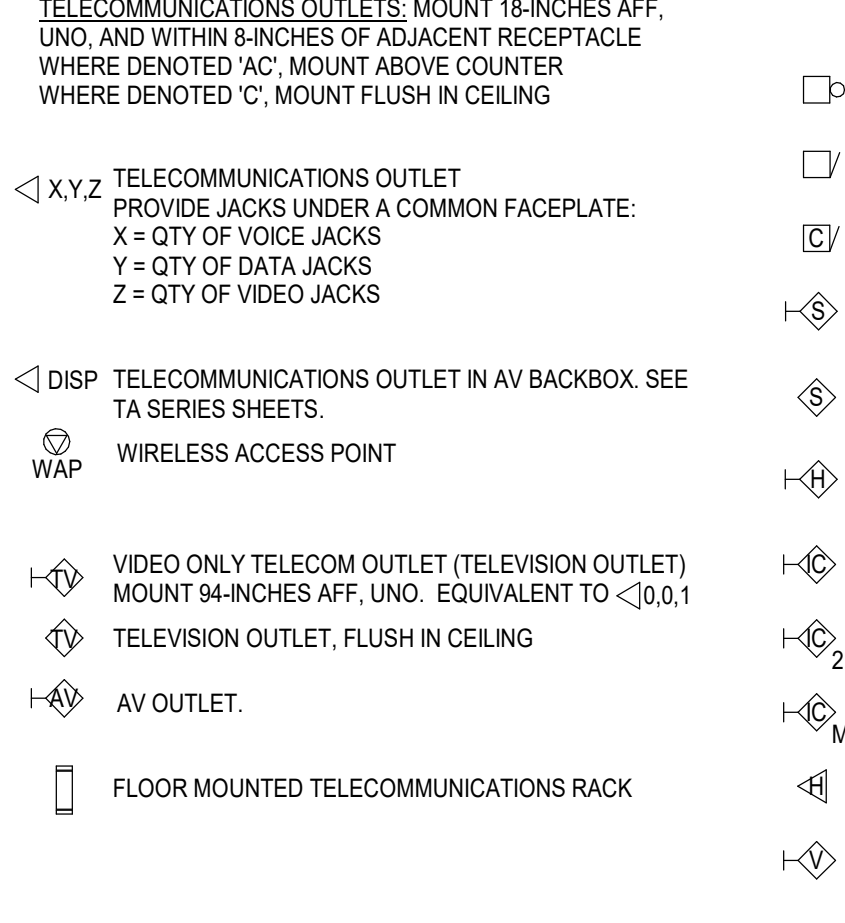


SAFETY

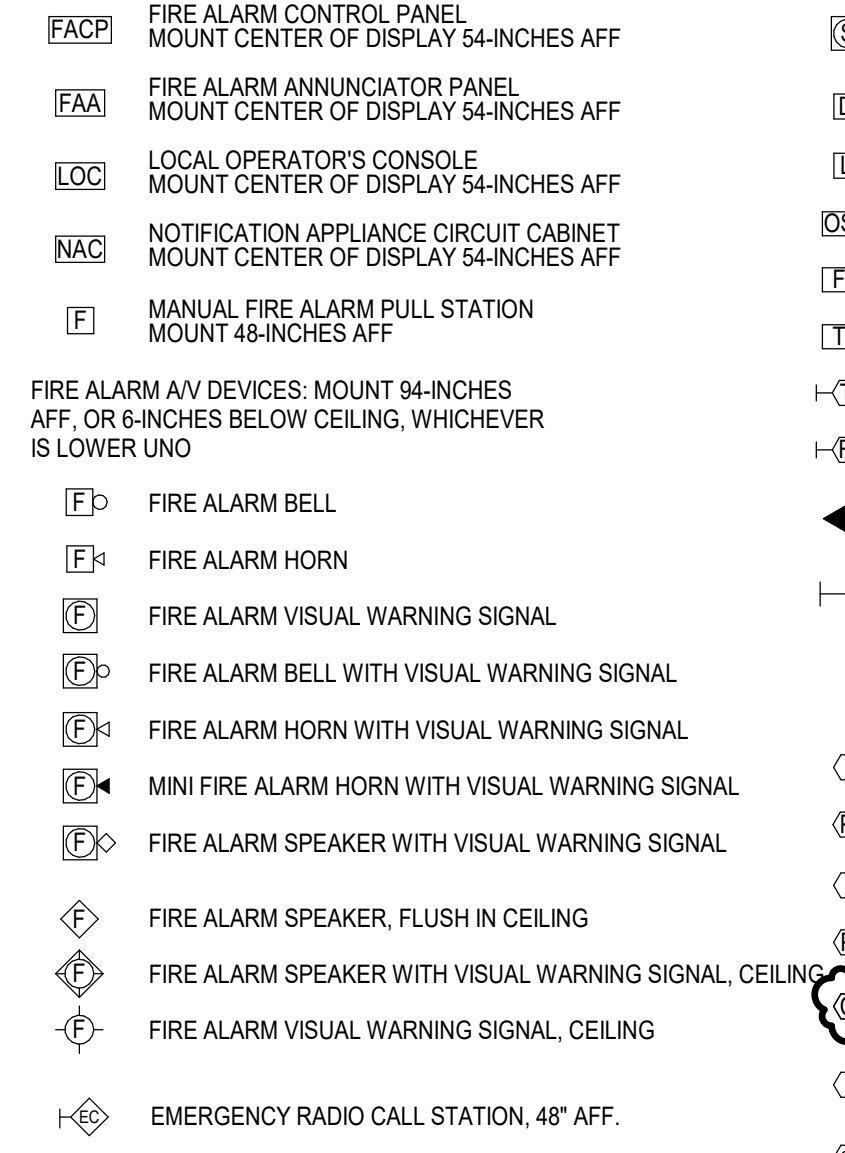


SECURITY

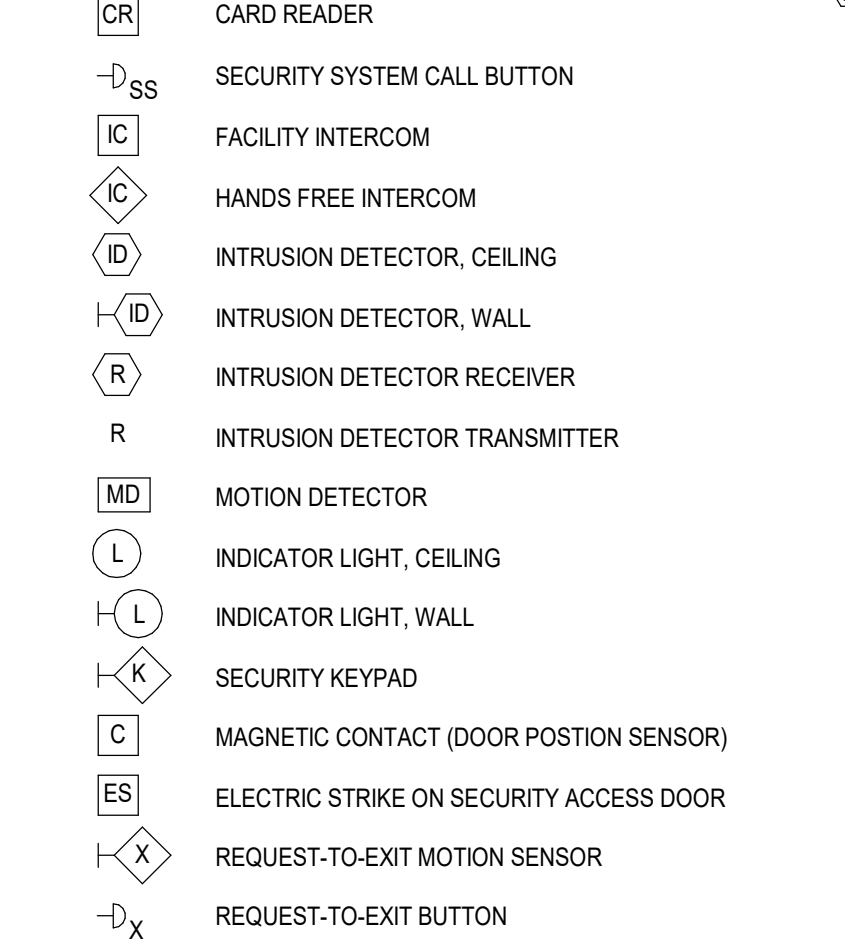


BELLS, BUZZERS, CHIMES AND WALL SPEAKERS

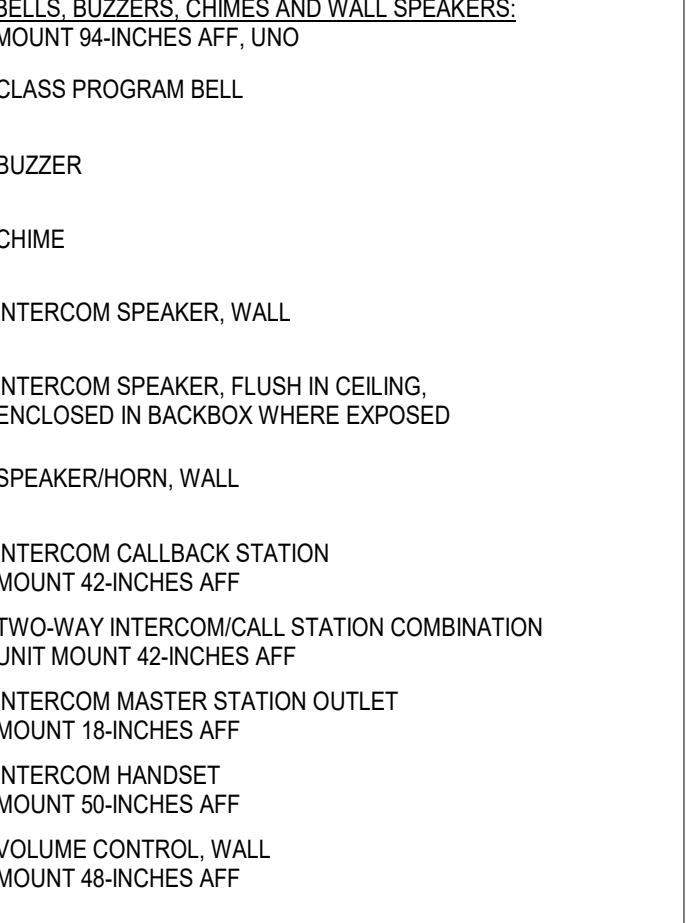


SMOKE DETECTOR - IONIZATION TYPE (D = DUCT)

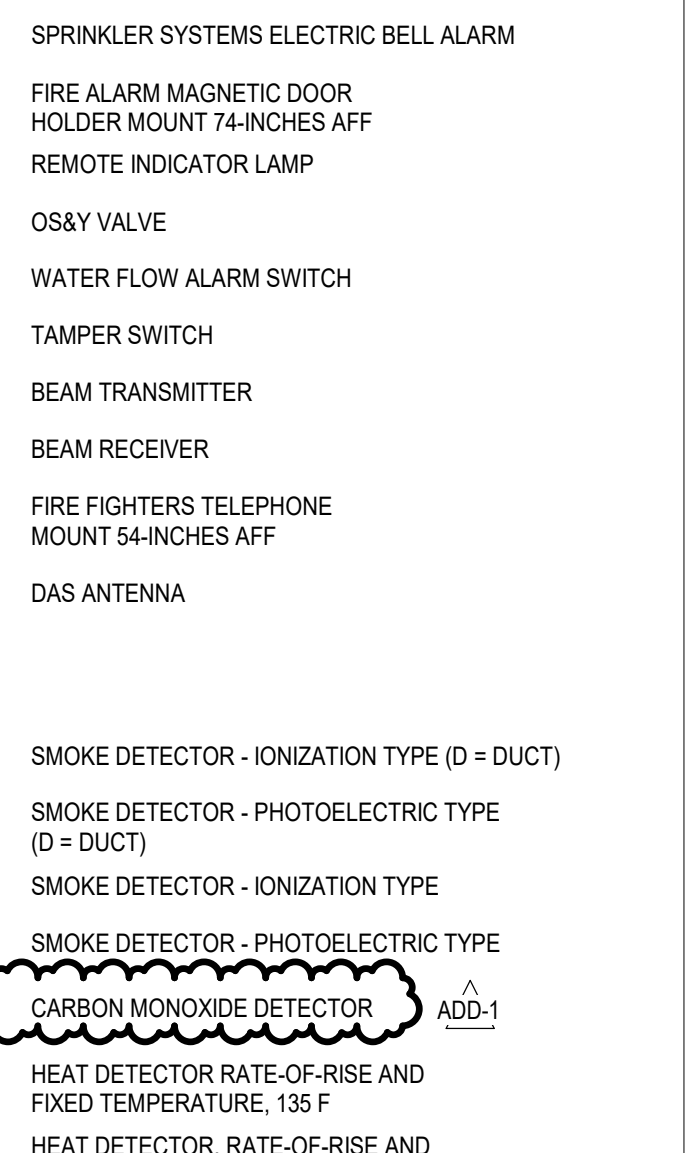

ONE-LINE DIAGRAM

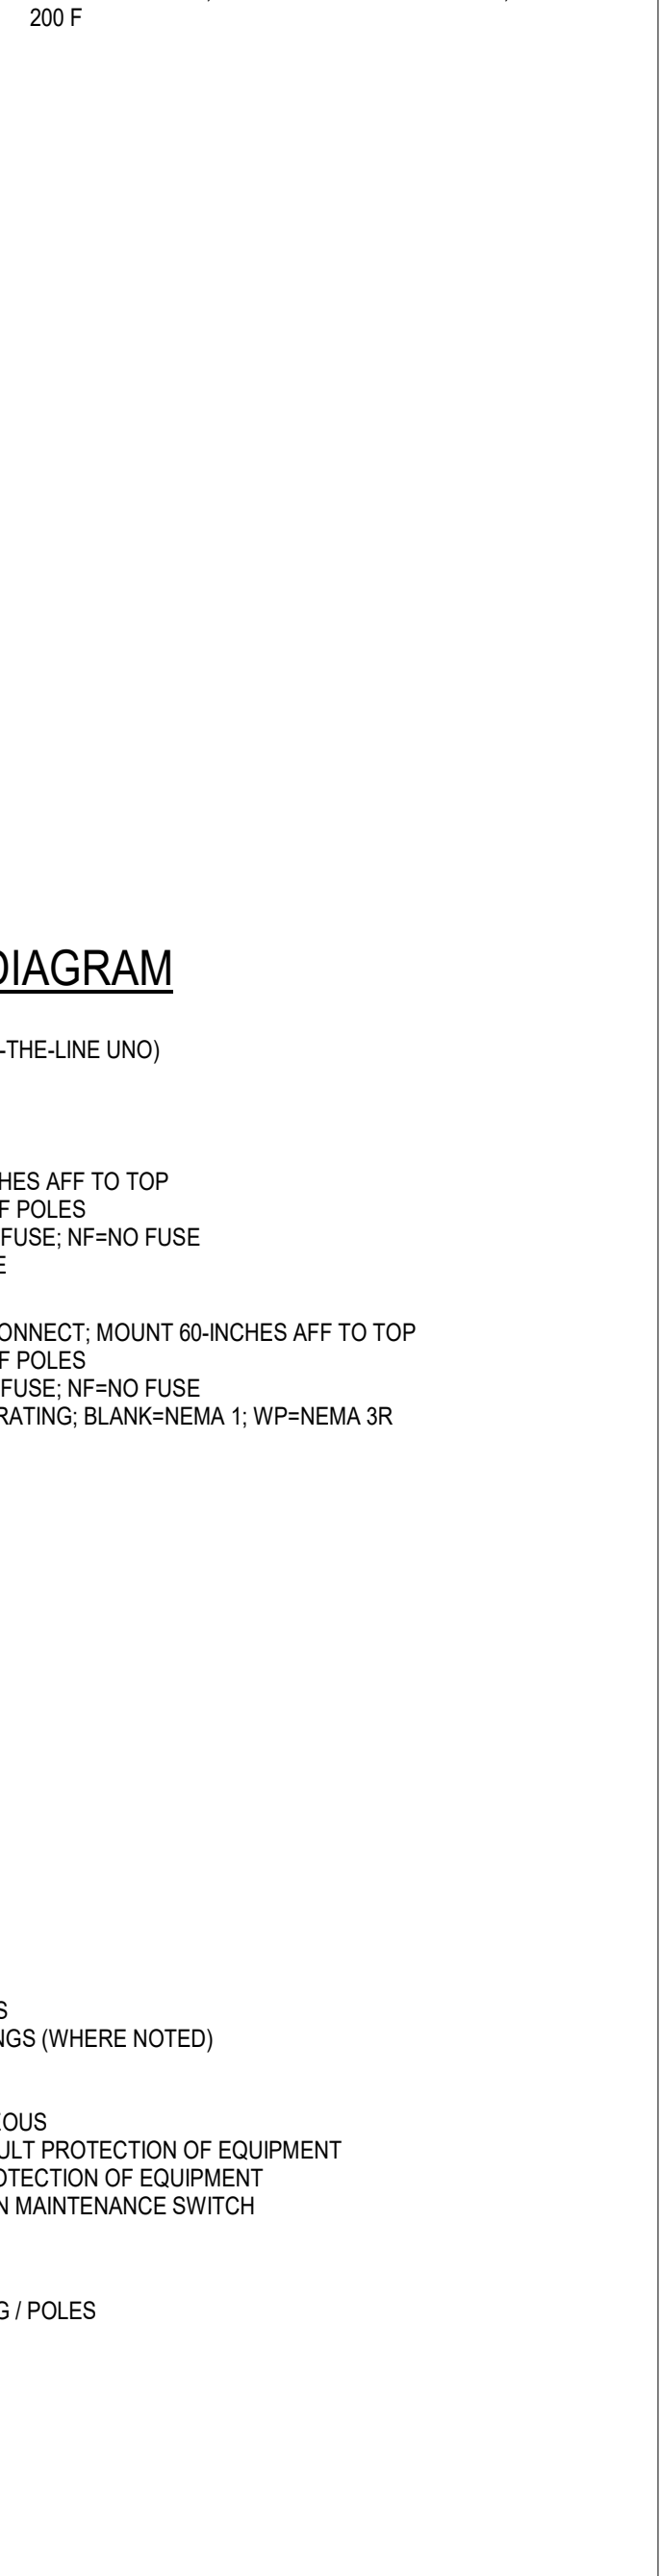


1
2
3
4
5

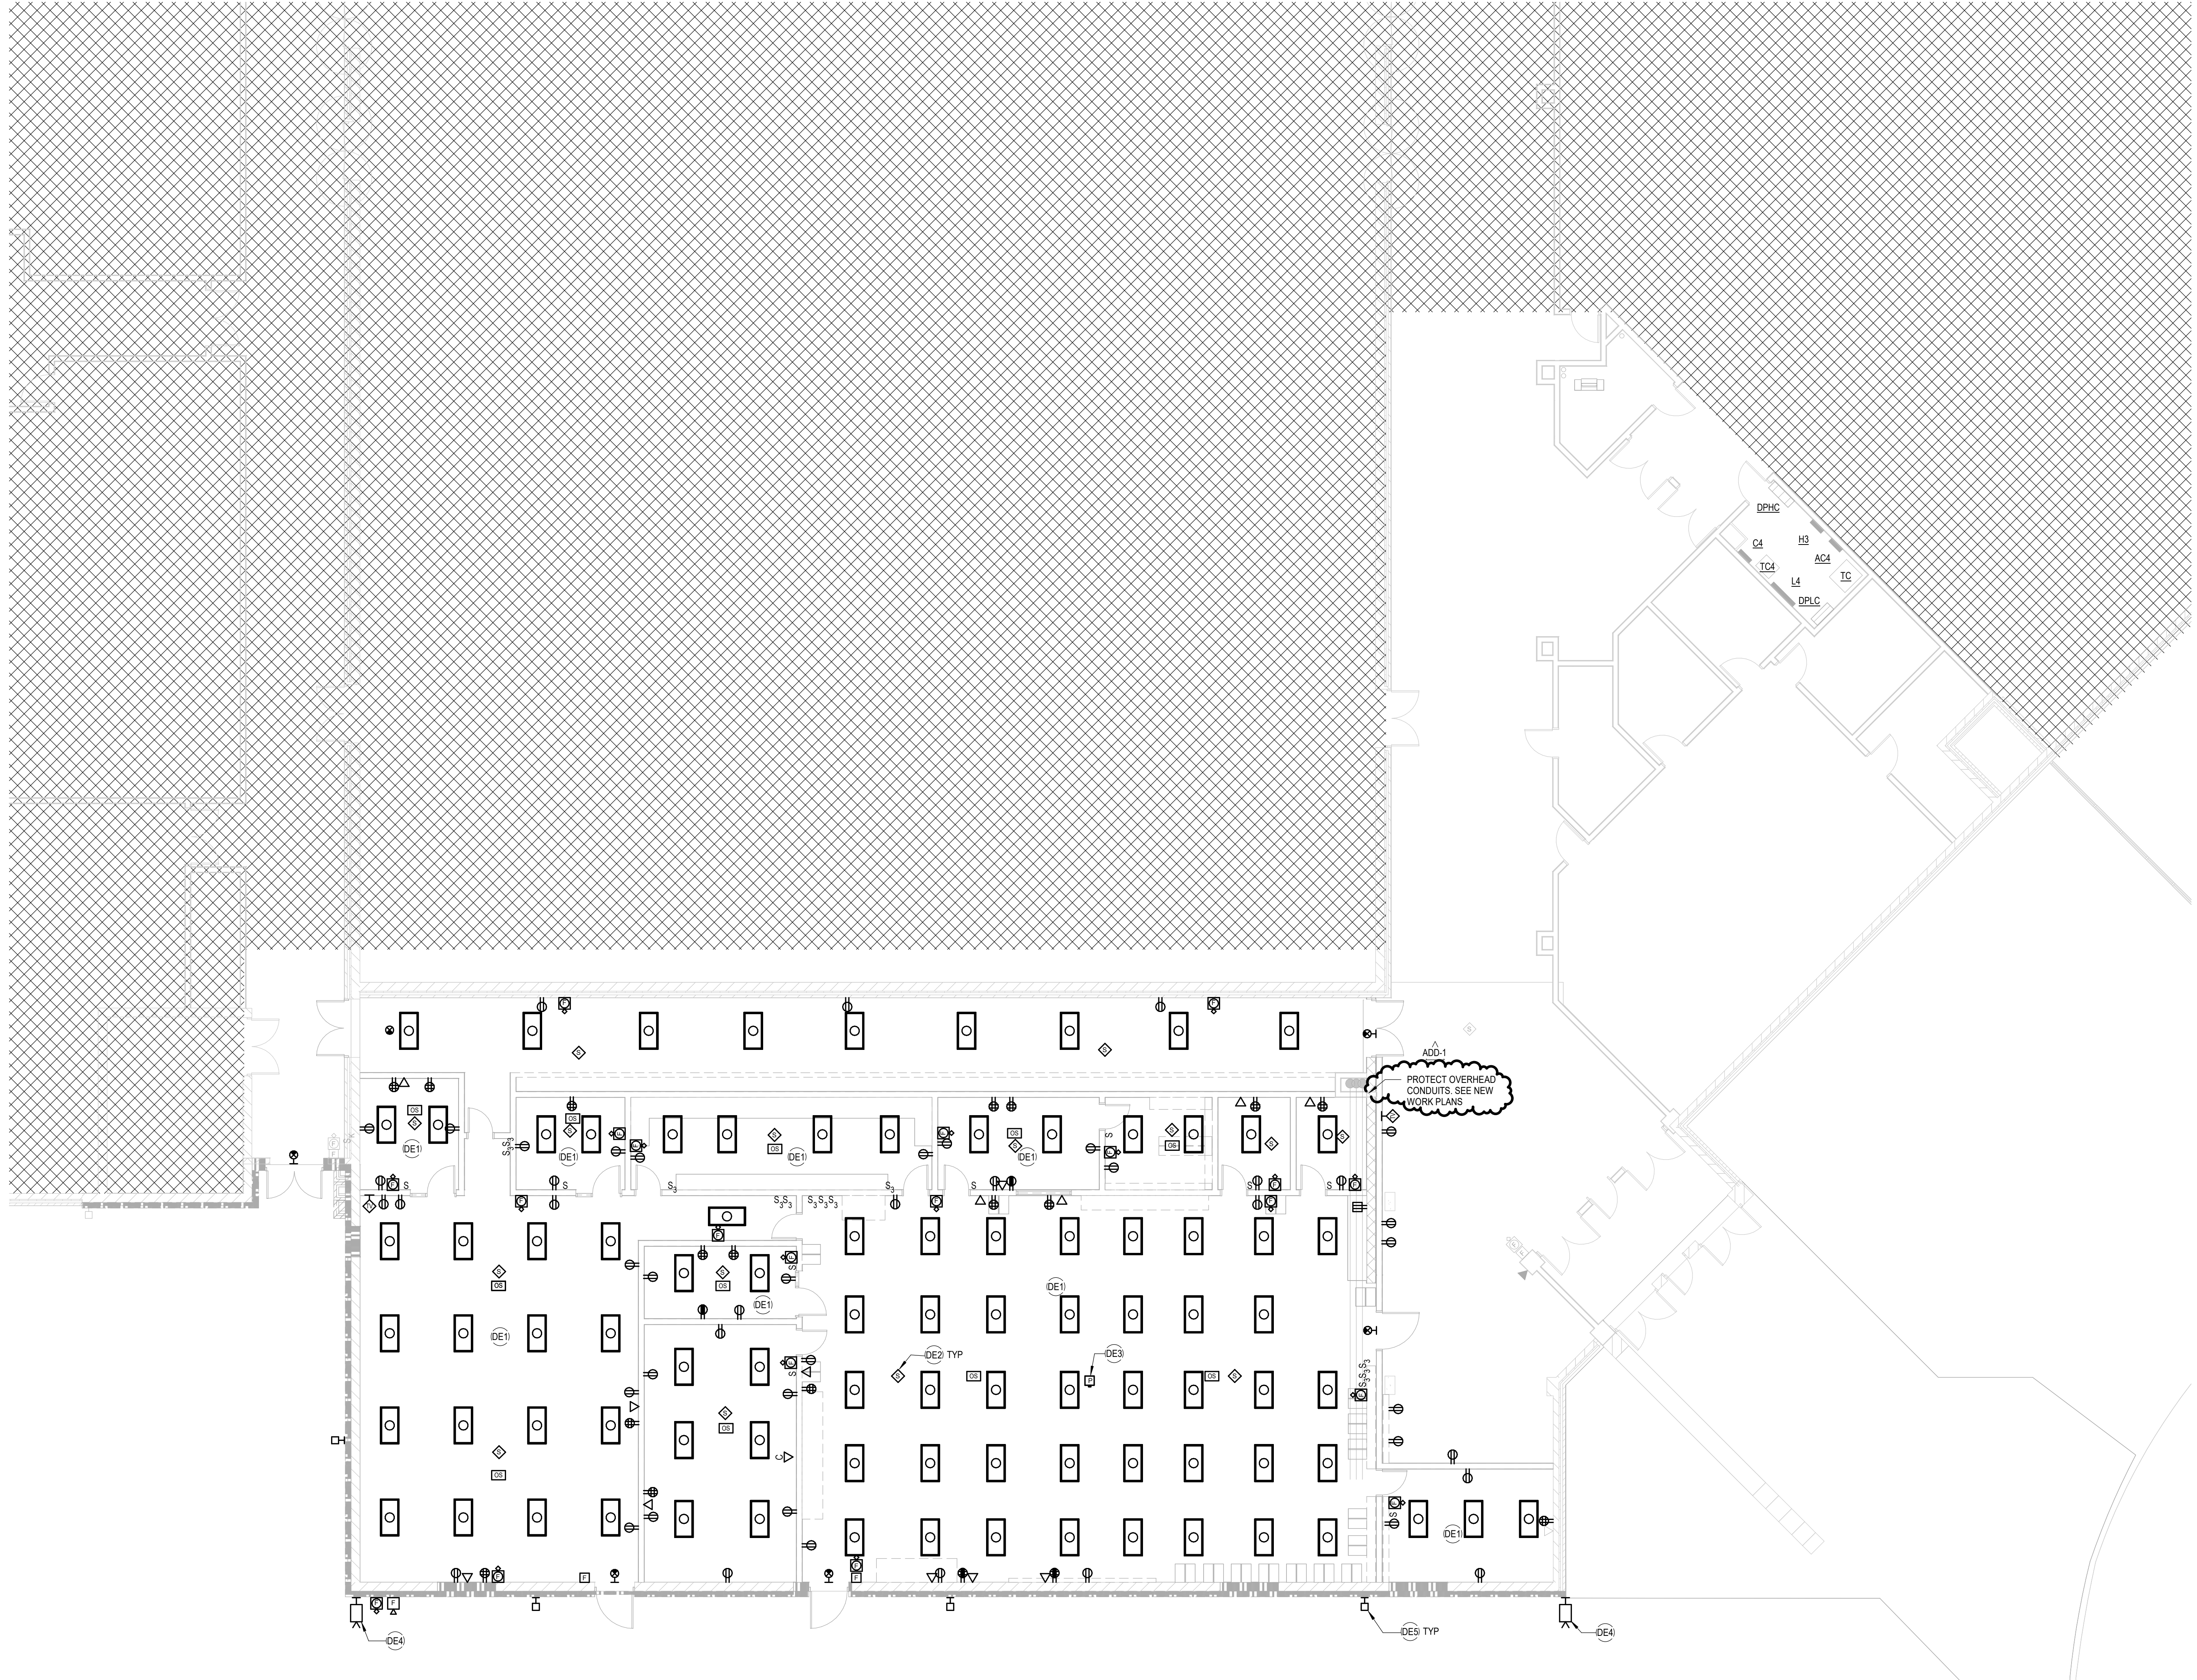

- SHEET NOTES**
- DE1 DEMOLISH ALL ELECTRICAL SYSTEMS IN THE ROOM INCLUDING LIGHTING, CONTROLS, FIRE ALARM, AND RECEPTACLES.
 - DE2 DEMOLISH INTERCOM SPEAKERS AND RETURN TO OWNER.
 - DE3 DEMOLISH ANY EQUIPMENT IN THIS ROOM INCLUDING PROJECTOR AND SOUND REINFORCEMENT SPEAKERS AND RETURN TO OWNER.
 - DE4 DEMOLISH SECURITY CAMERAS AND RETURN TO OWNER.
 - DE5 DEMOLISH EXTERIOR WALL PACKS.

LEVEL 01 - AREA B - ELECTRICAL DEMOLITION PLAN
 SCALE: 1/8" = 1'-0"

Autodesk Docs://99-23712-00_Crandall ISD - PAC/39-23712-00_Crandall ISD_EL_2024.rvt
 8/20/2024 2:28:39 PM

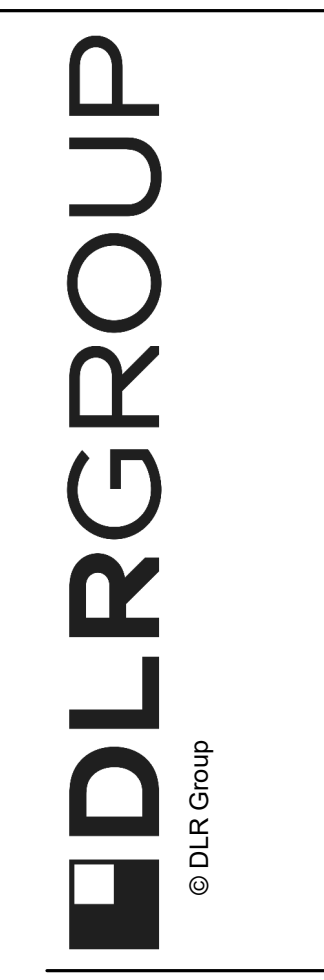


CRANDALL ISD HIGH SCHOOL
 PAC ADDITION
 13385 Fm 3039, Crandall, TX 75114

ISSUE FOR BID AND PERMIT
 2024.08.19
 REVISIONS
 A00-1 8824

39-23712-00
 LEVEL 01 - AREA B - ELECTRICAL DEMOLITION PLAN



ED1.1B

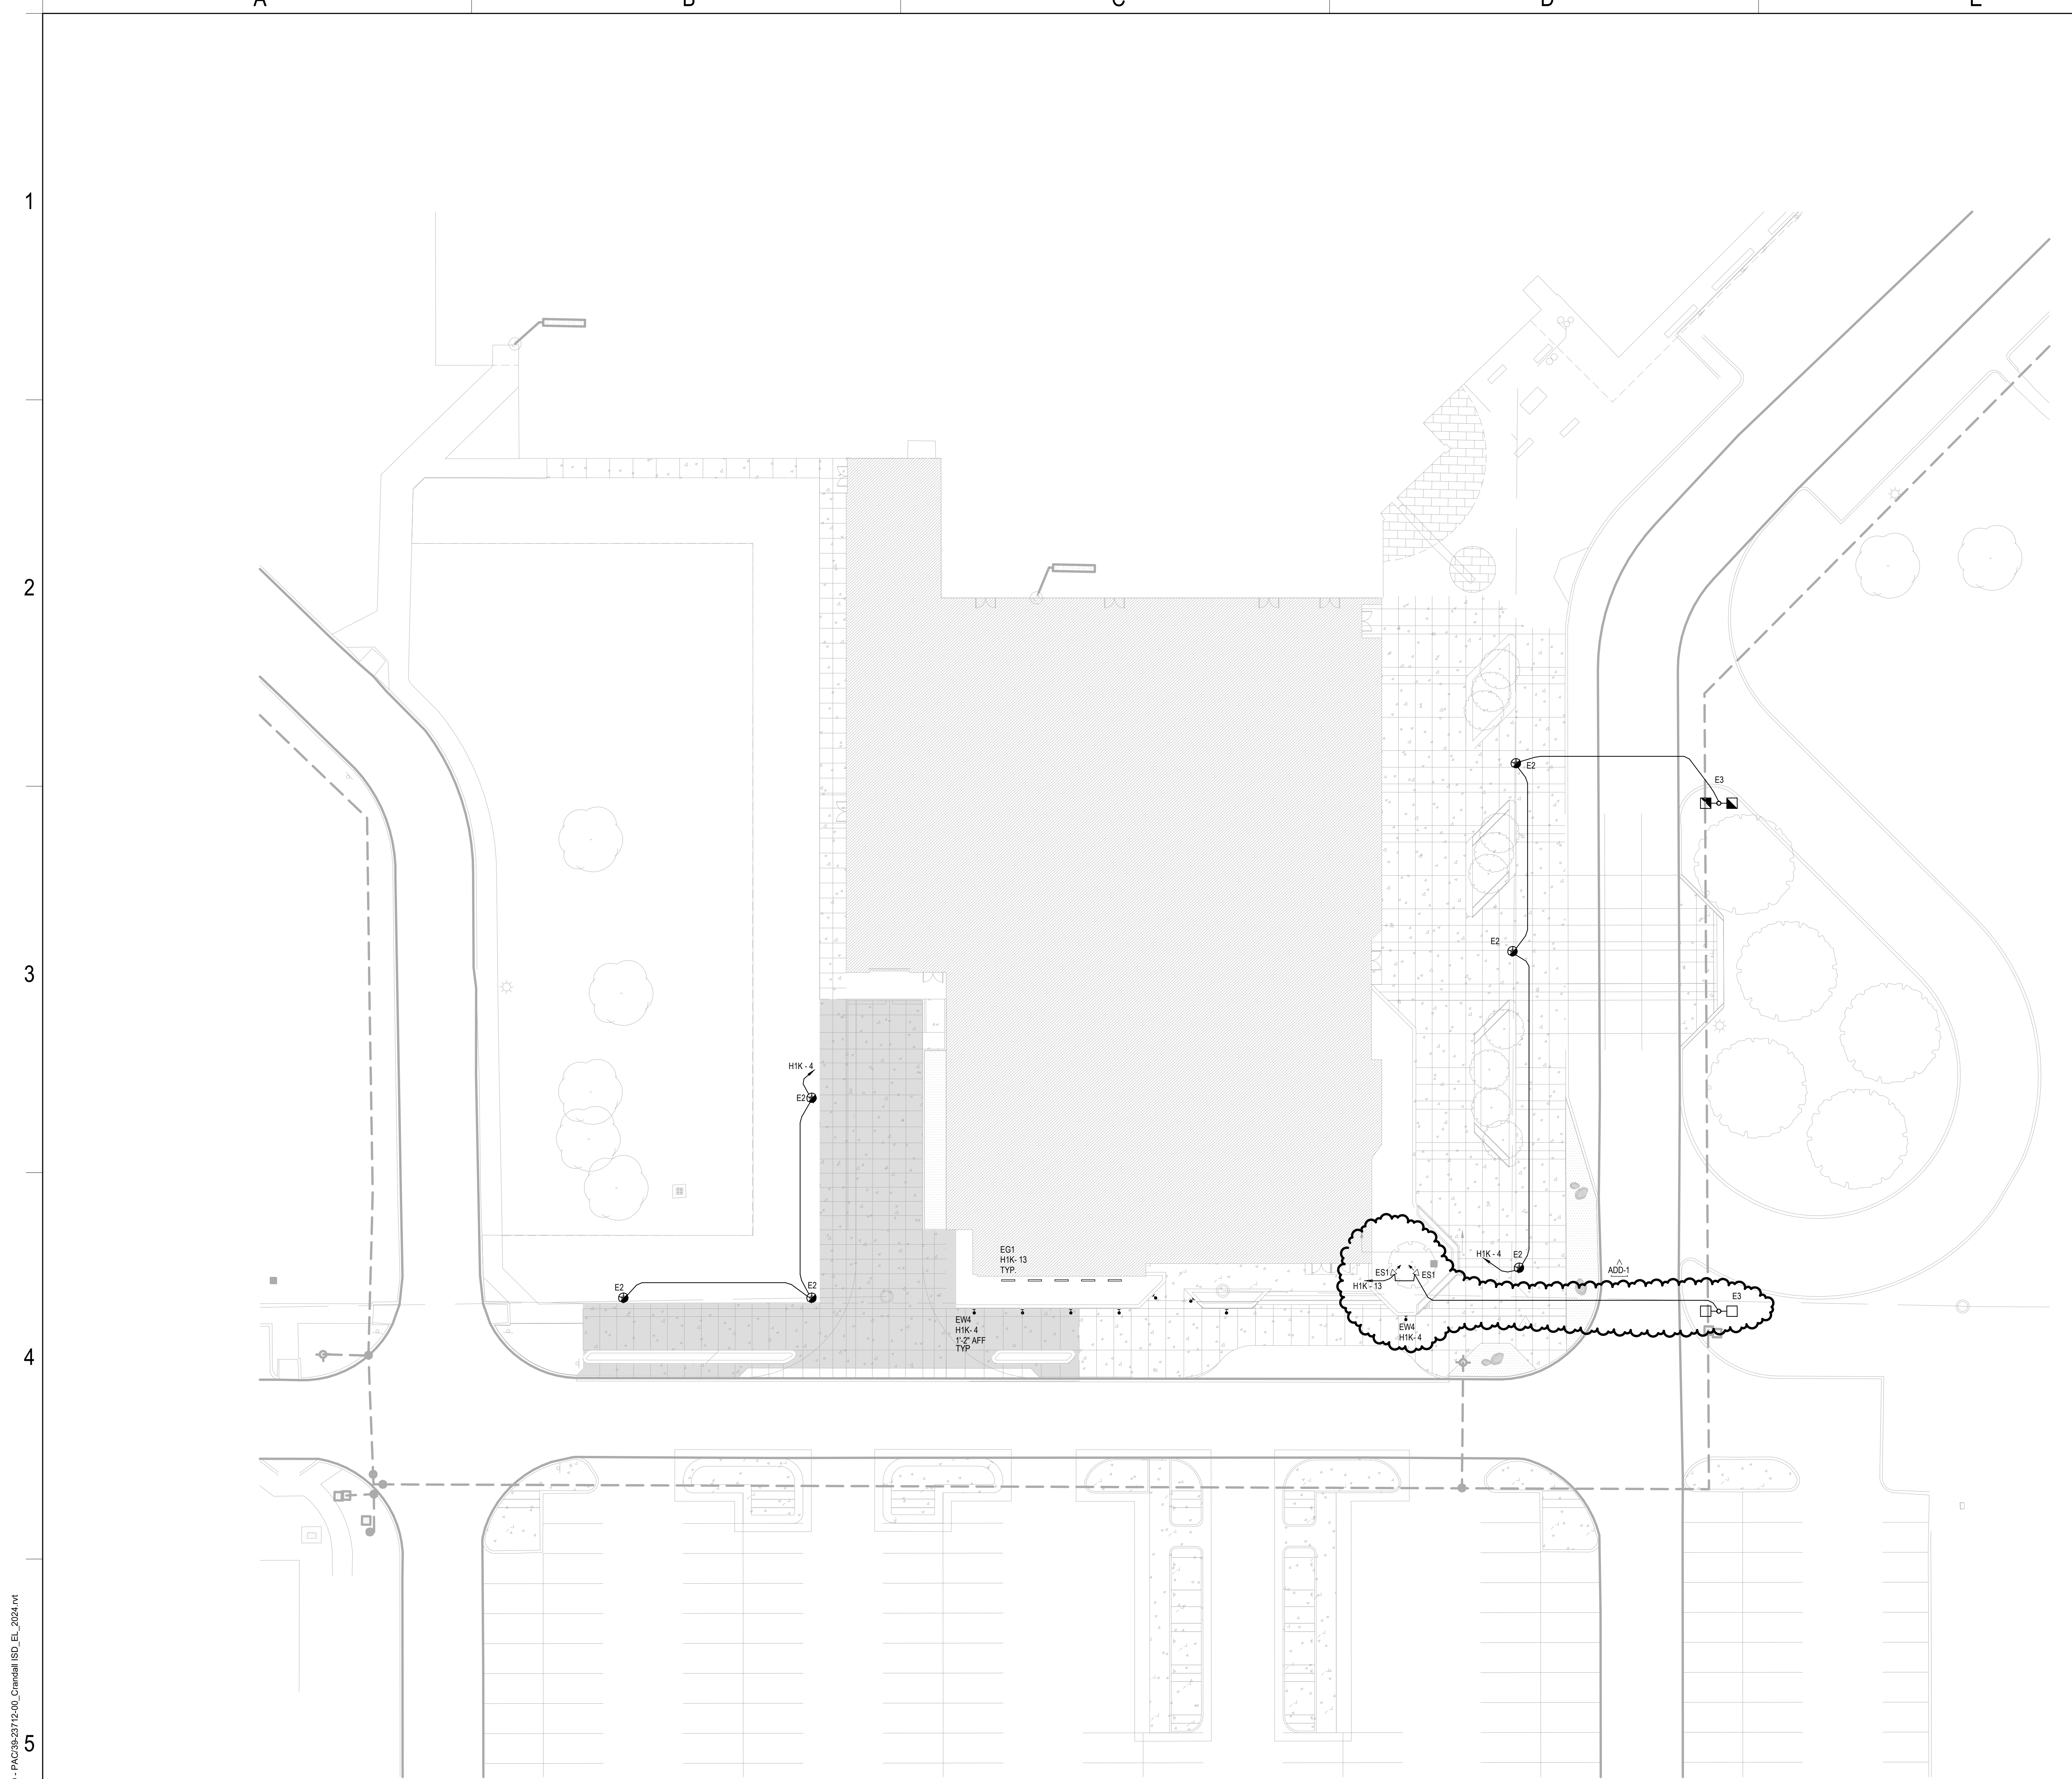

Autodesk Docs://99-23712-00_Crandall ISD - PAC/39-23712-00_Crandall ISD - EL_2024.rvt
 8/20/2024 2:28:40 PM


ELECTRICAL SITE PLAN
 SCALE: 1" = 20'-0"

SHEET NOTES

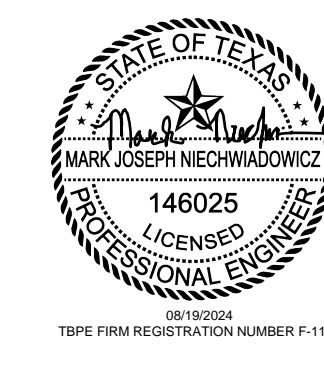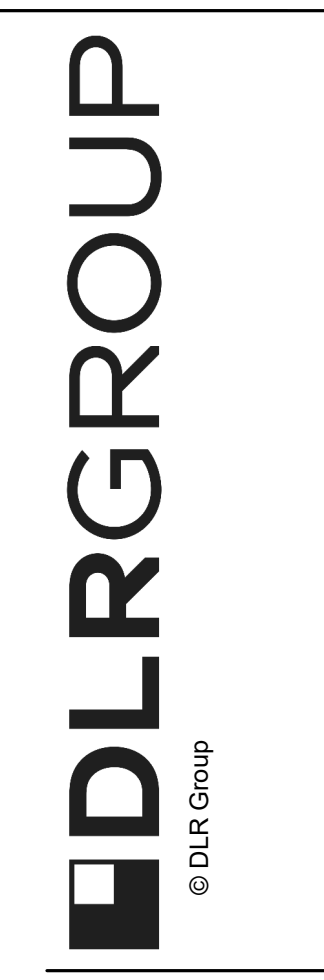

CRANDALL ISD HIGH SCHOOL
 PAC ADDITION
 13385 Fm 3039, Crandall, TX 75114

ISSUE FOR BID
 AND PERMIT
 2024.08.19
 REVISIONS
 A00-1 8824

39-23712-00
 ELECTRICAL SITE
 PLAN

ES1.1



1

2

3

4

5


A

C

D


E

F

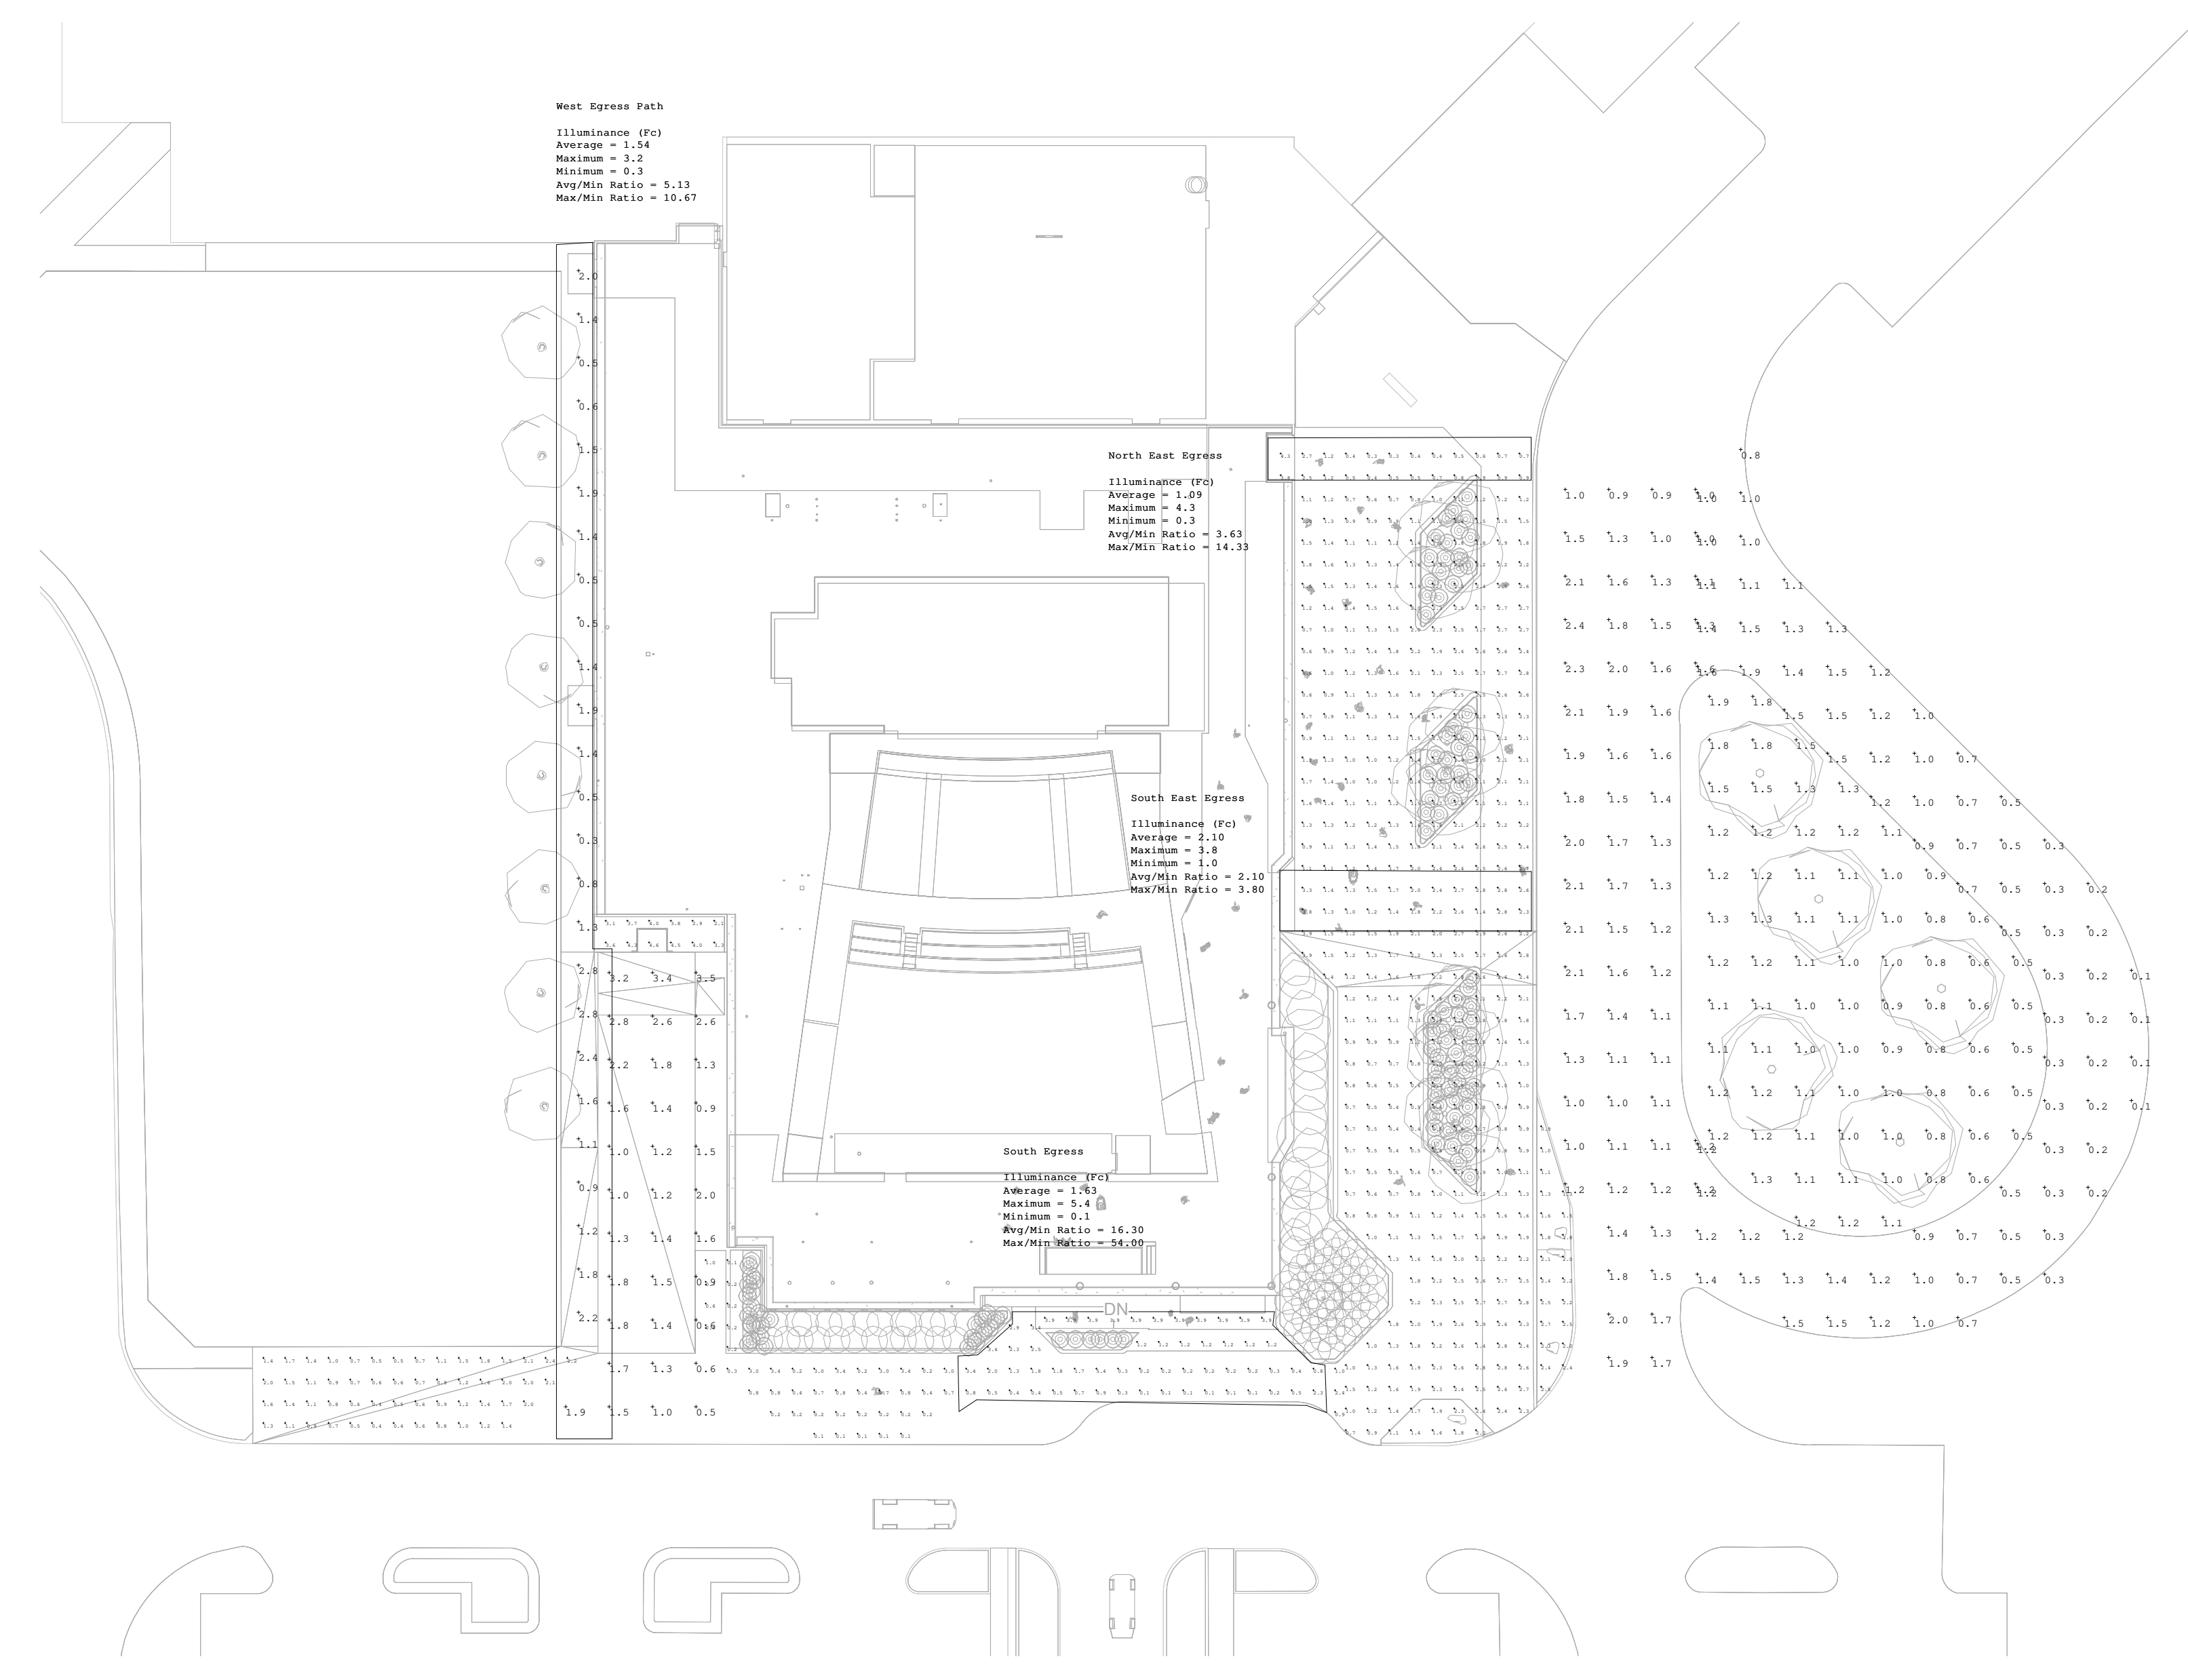


SITE LIGHTING EGRESS CALCULATIONS
SCALE: 1" = 30'-0"

A00-1

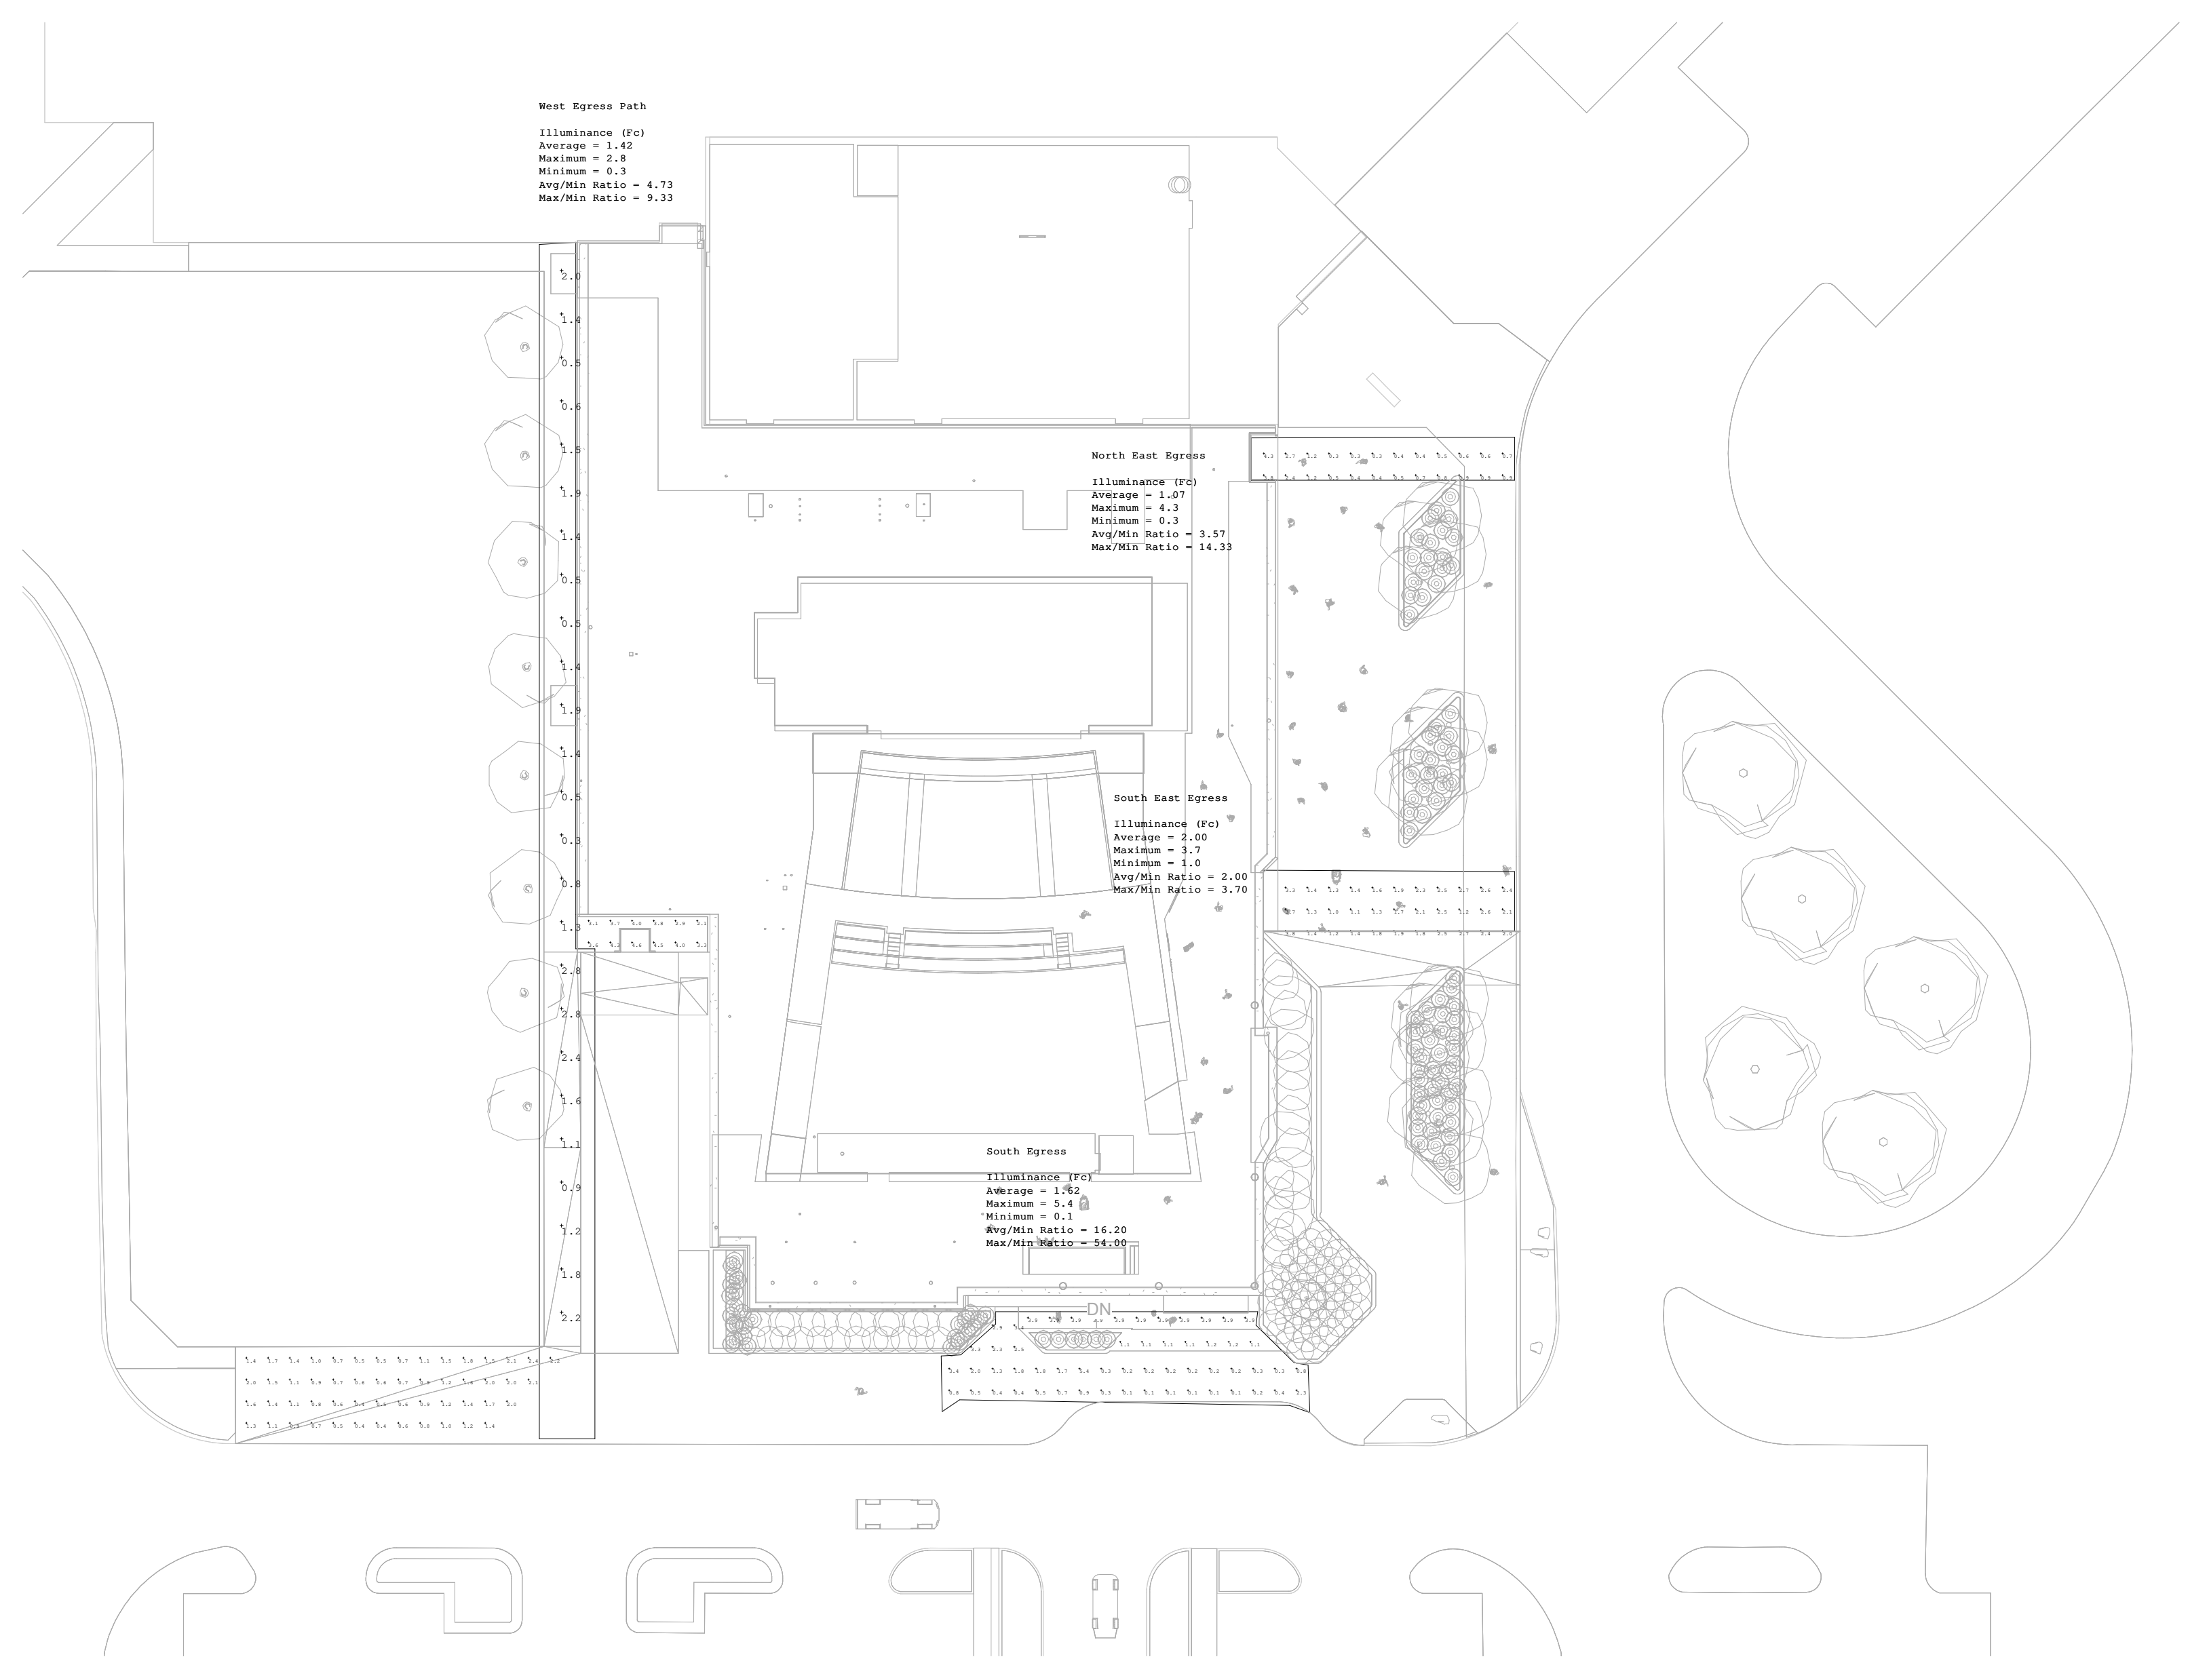

SITE LIGHTING EMERGENCY CALCULATIONS
SCALE: 1" = 30'-0"


A00-1

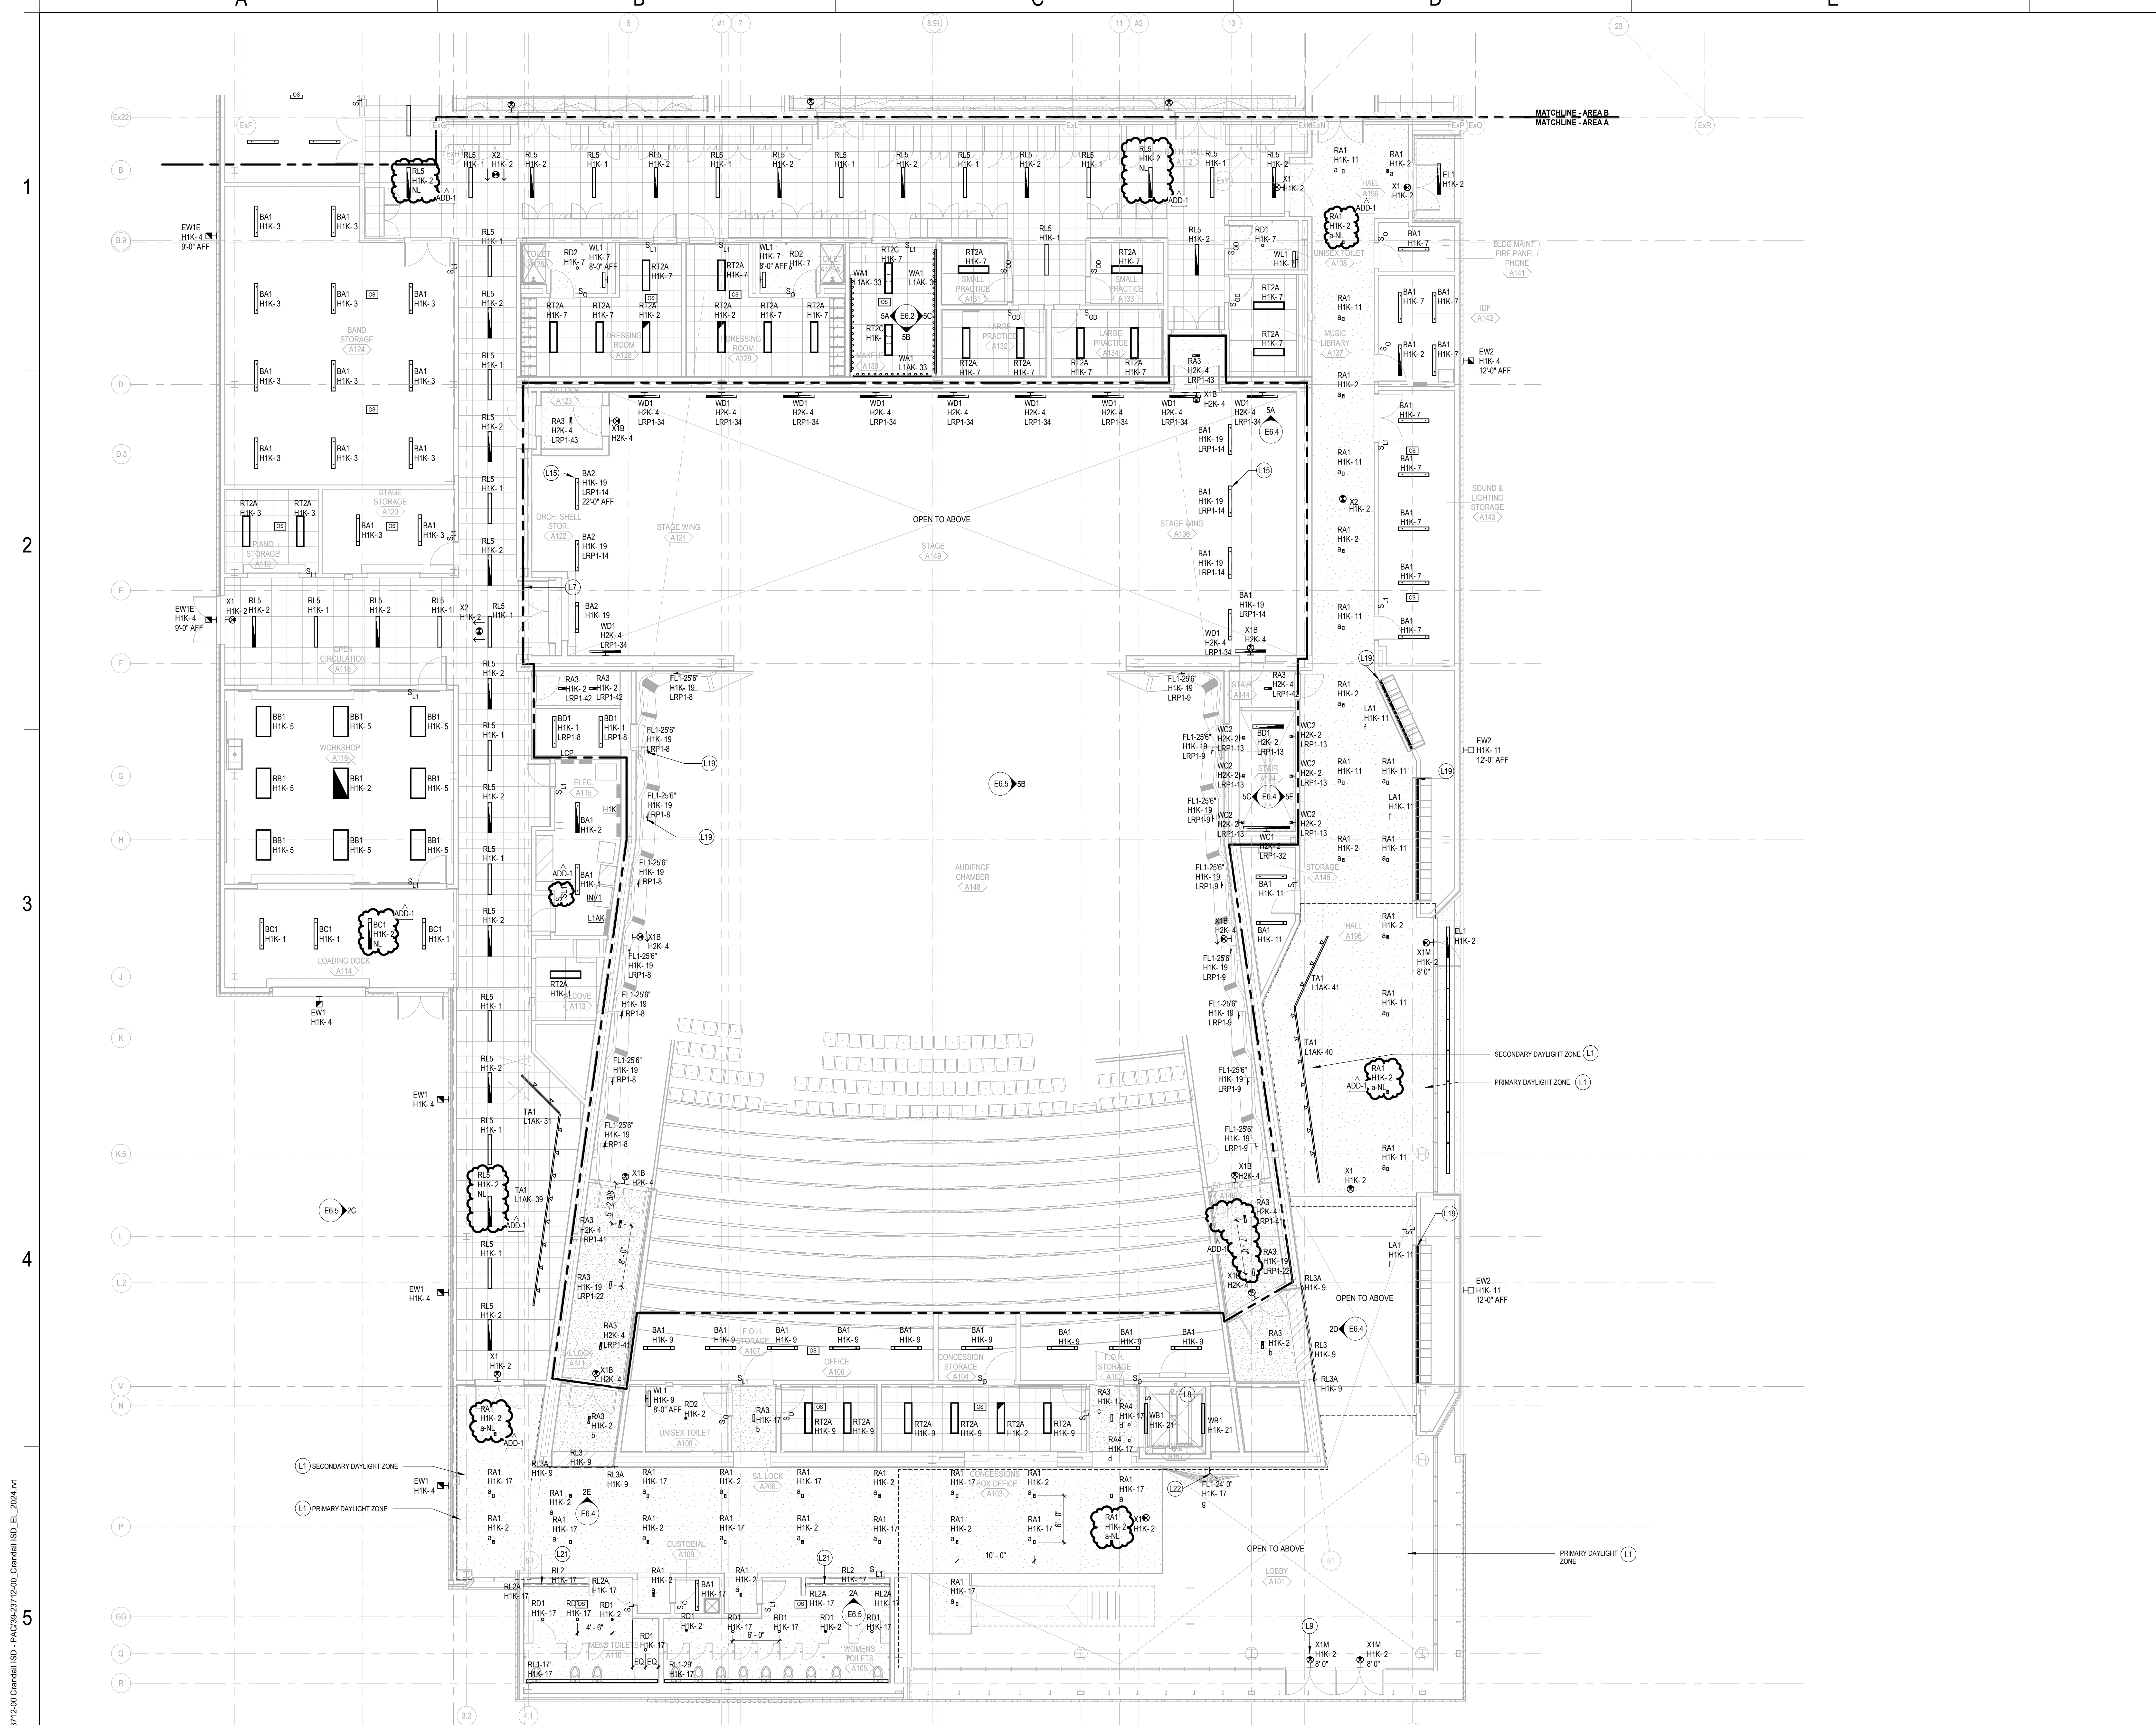

SHEET NOTES

- L1 GENERAL LIGHTING IN DAYLIGHT ZONES IS LESS THAN 150 WATTS. DAYLIGHT RESPONSIVE CONTROLS NOT REQUIRED PER 2021 IECC C408.
- L7 LIGHTING WITHIN BOUNDARY CONTROLLED BY THEATRICAL LIGHTING CONTROL SYSTEM. COORDINATE WITH OT SERIES SHEETS.
- L8 MOUNT SWITCH IN SHAFT AT 42" ABOVE LEVEL 1 FINISHED FLOOR. SWITCH CONTROLS LIGHTS IN ELEVATOR PIT. MOUNT LIGHT FIXTURES 6" ABOVE LEVEL 1 FINISHED FLOOR.
- L9 MOUNTED ABOVE MULLION. TYPICAL.
- L15 TYP. MOUNT TO UNDERSIDE OF CATWALK.
- L19 SEE MOUNTING DETAIL 5A/A11.10. IN ARCHITECTURAL DRAWINGS. MOUNT FIXTURE SO THAT ASYMMETRIC OPTICS POINT AWAY FROM THE WALL.
- L21 TYPICAL FOR RL2 & RL2A. PROVIDE A CONTINUOUS PORTAL. BOTTOM OF VERTICAL SECTION SHOULD ALIGN WITH TOP OF SINK COUNTER.
- L22 LOCATE REMOTE DRIVER BEHIND AN ACCESS PANEL IN ADJACENT HARD LID CEILING.

KEY PLAN

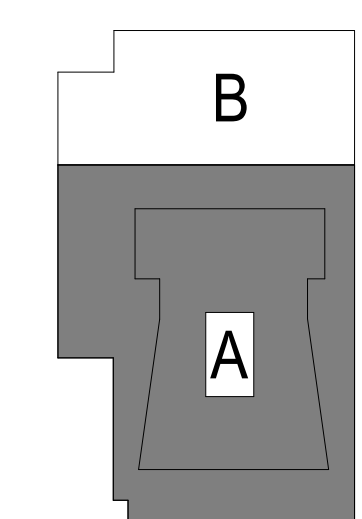

Autodesk Docs://99-23712-00_Crandall ISD - PAC/39-23712-00_Crandall ISD_EL_2024.rvt
 8/20/2024 2:28:52 PM


LEVEL 01 - AREA A - LIGHTING PLAN
 SCALE: 1/8" = 1'-0"



ISSUE FOR BID AND PERMIT
 2024.08.19
 REVISIONS
 ADD-1 8824


39-23712-00
LEVEL 01 - AREA A - LIGHTING PLAN

EL1.1A

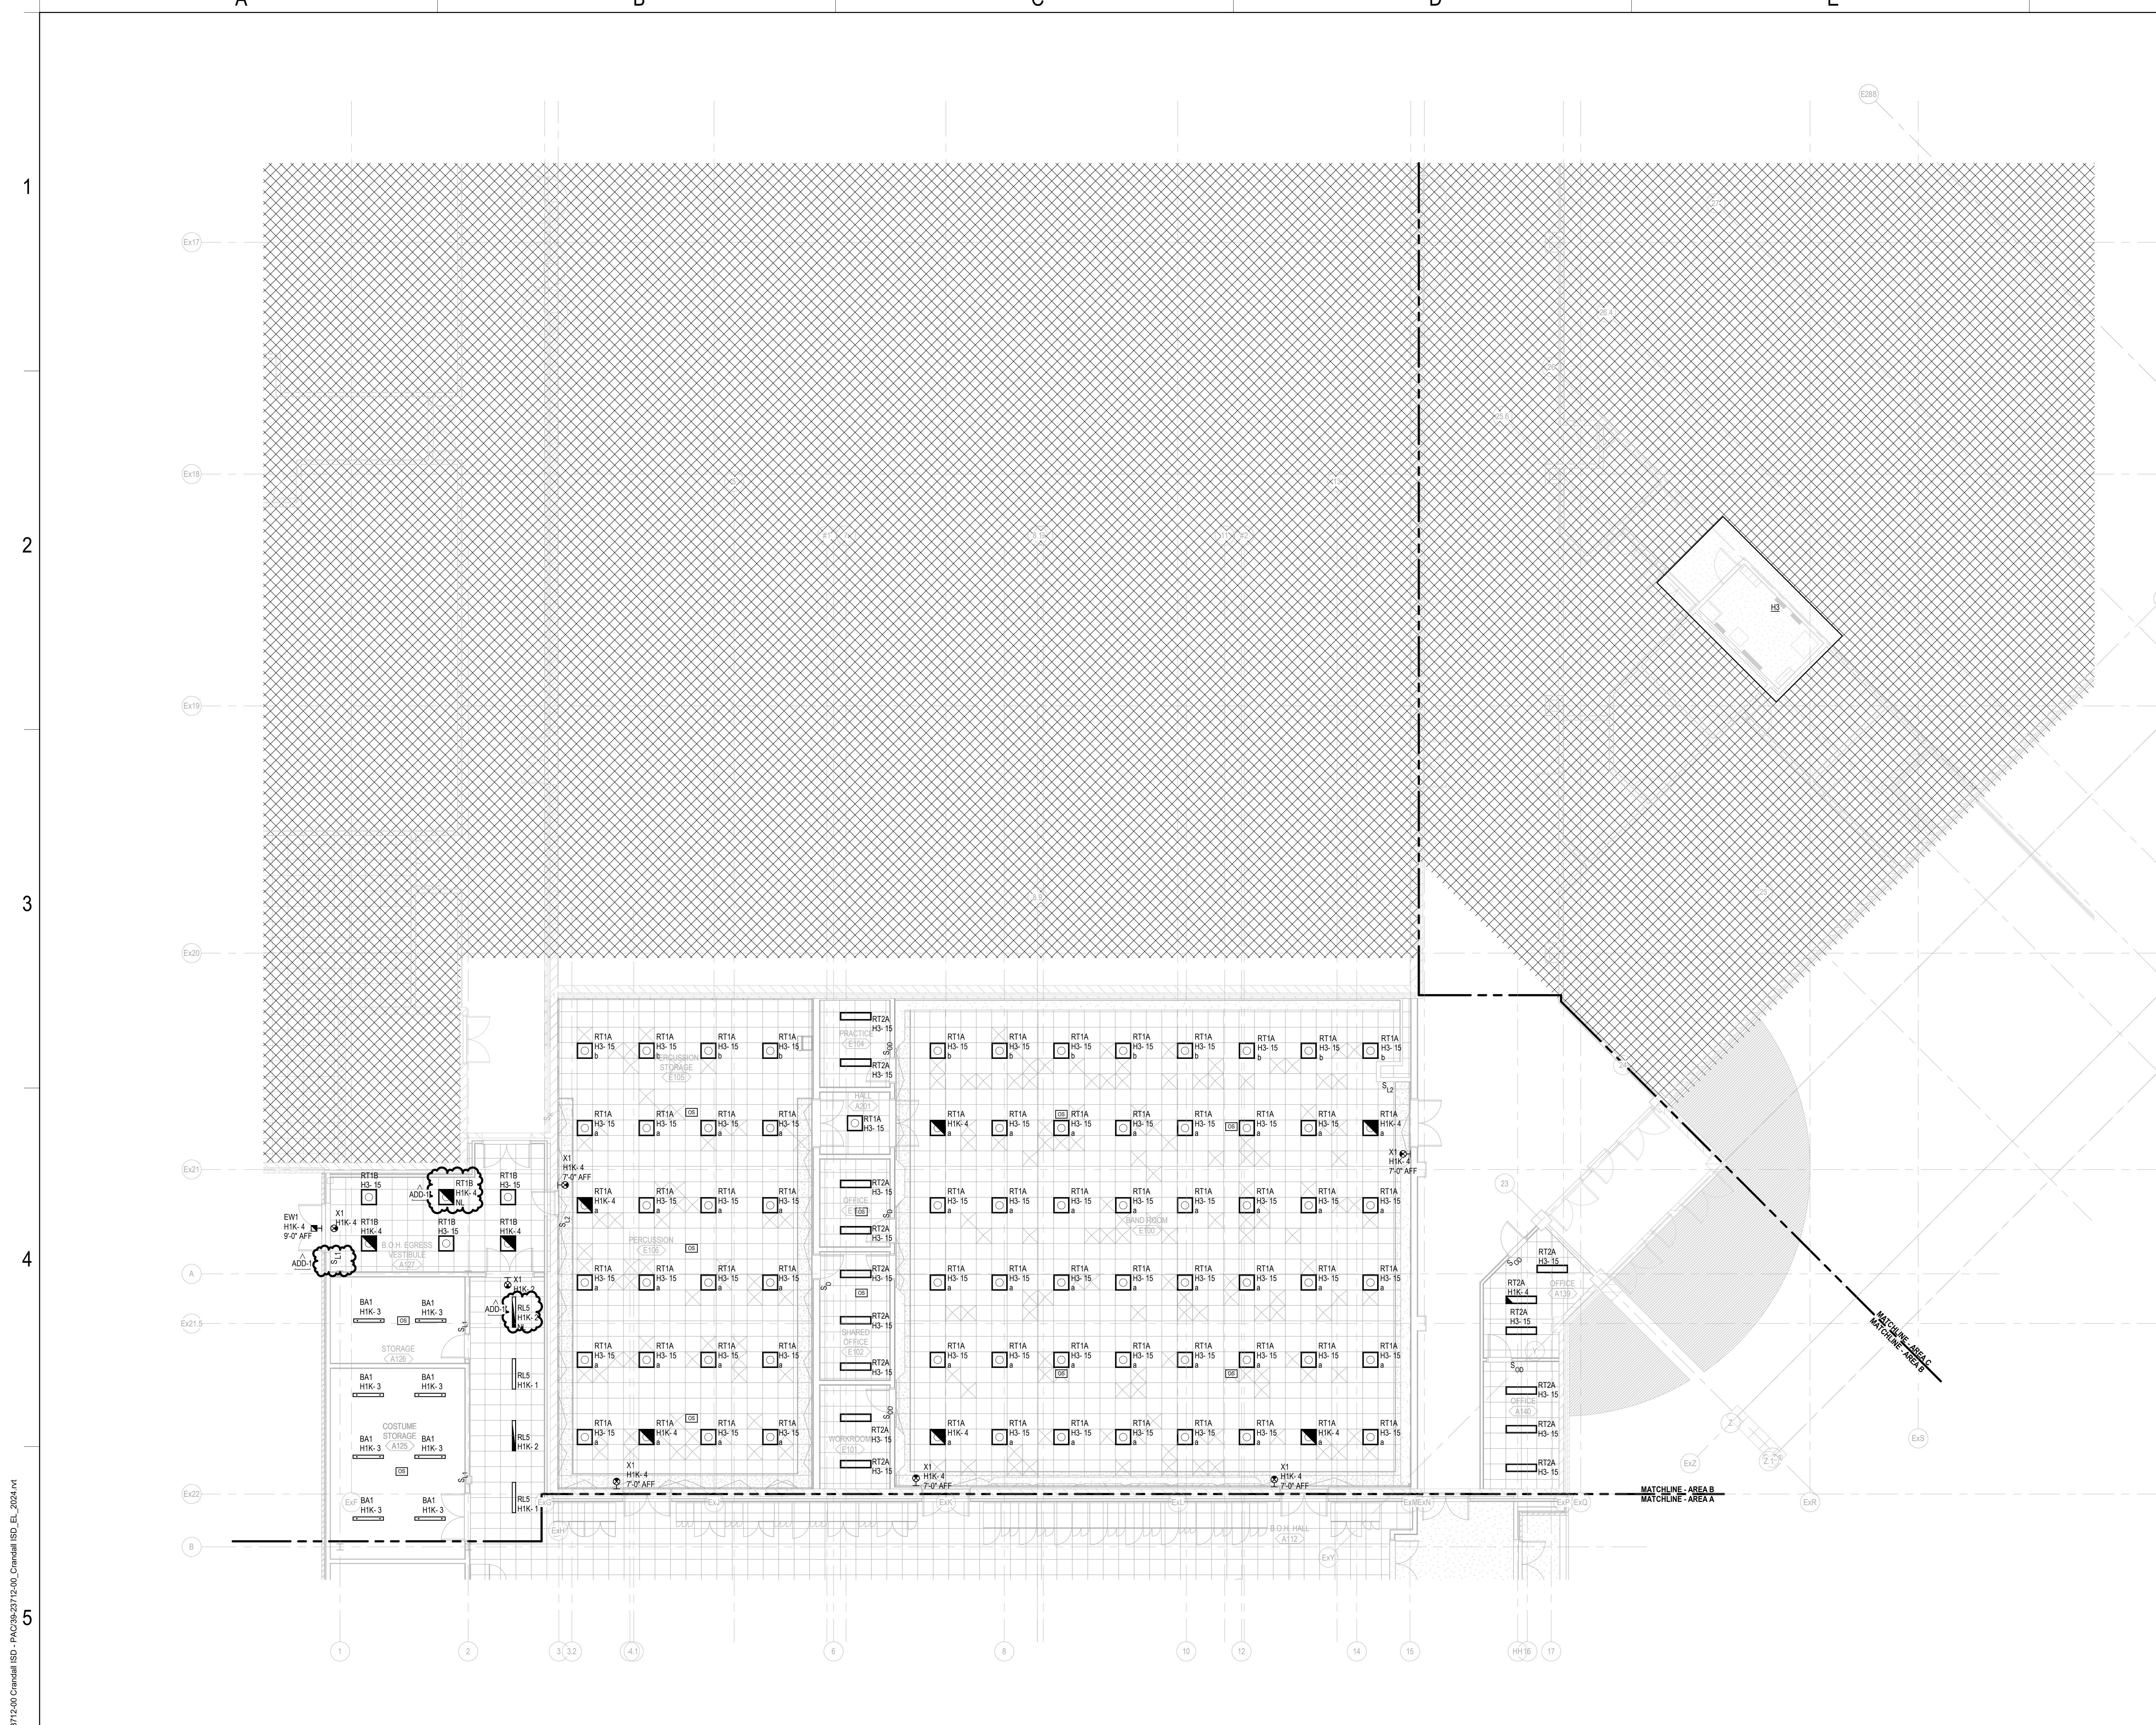


SHEET NOTES

KEY PLAN

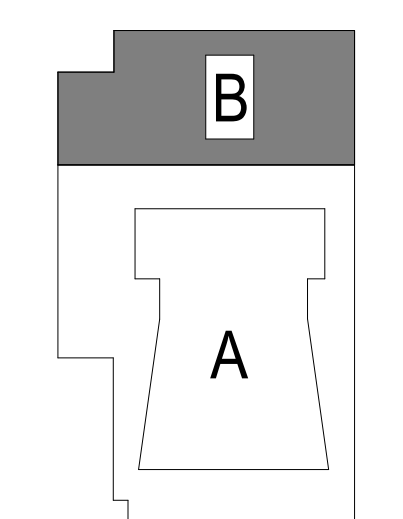


LEVEL 01 - AREA B - LIGHTING PLAN
SCALE: 1/8" = 1'-0"



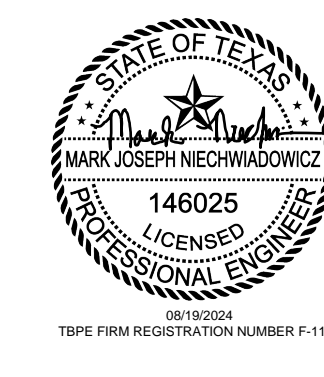


ISSUE FOR BID AND PERMIT
2024.08.19
REVISIONS
A00-1 8824

Autodesk Docs://99-23712-00 Crandall ISD - PAC/39-23712-00_Crandall ISD_EL_2024.rvt
8/20/2024 2:26:56 PM

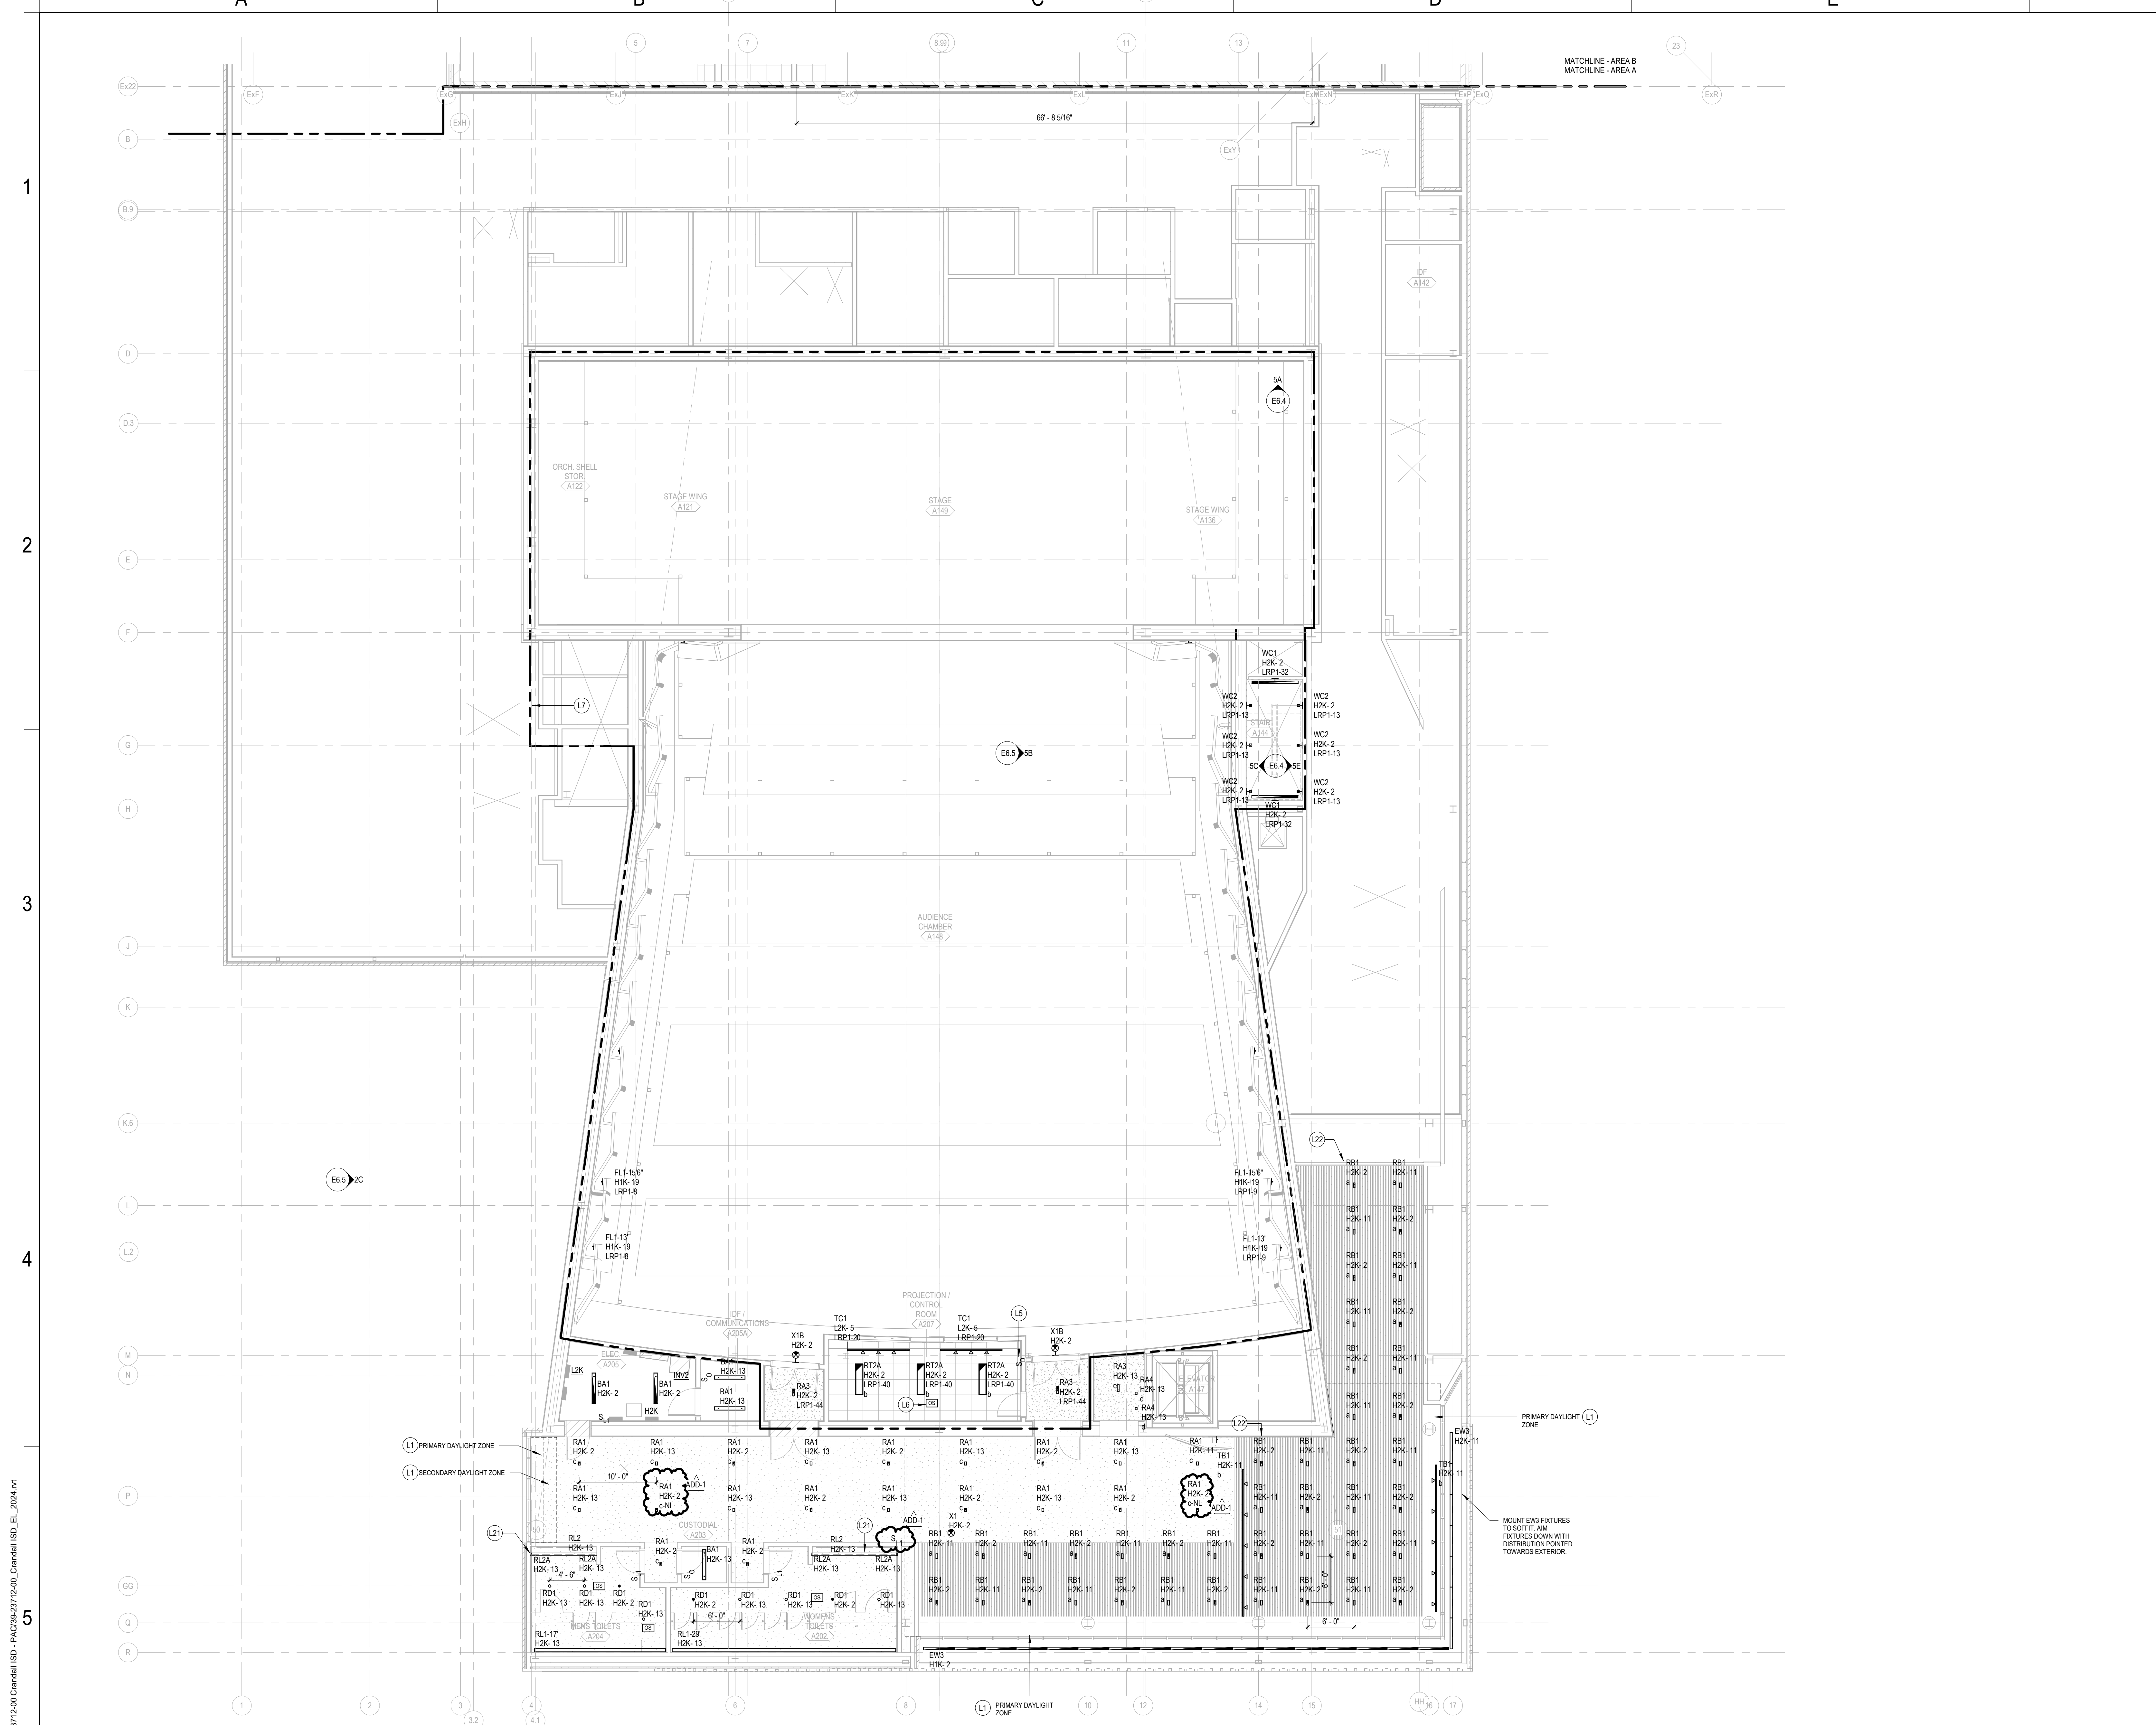

- SHEET NOTES**
- L1 GENERAL LIGHTING IN DAYLIGHT ZONES IS LESS THAN 150 WATTS. DAYLIGHT RESPONSIVE CONTROLS NOT REQUIRED PER 2021 IECC C405.
 - L5 0-10V DIMMER WITH ELV RELAY FOR LOCAL CONTROL OF TC1 TRACK FIXTURE. PROVIDE BLACK DEVICE AND FACEPLATE.
 - L6 PROVIDE BLACK VACANCY SENSOR COVER. COORDINATE WITH THEATRICAL LIGHTING CONTROL SYSTEM IN THIS SPACE.
 - L7 LIGHTING WITHIN BOUNDARY CONTROLLED BY THEATRICAL LIGHTING CONTROL SYSTEM. COORDINATE WITH QT SERIES SHEETS.
 - L21 TYPICAL FOR RL2 & RL2A. PROVIDE A CONTINUOUS PORTAL. BOTTOM OF VERTICAL SECTION SHOULD ALIGN WITH TOP OF SINK COUNTER.
 - L22 LOCATE REMOTE DRIVER BEHIND AN ACCESS PANEL IN ADJACENT HARD LID CEILING.

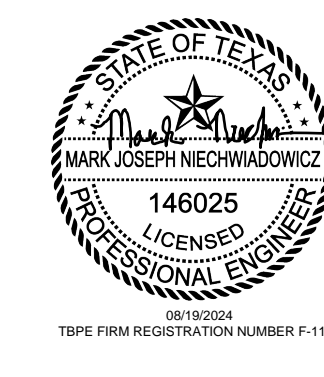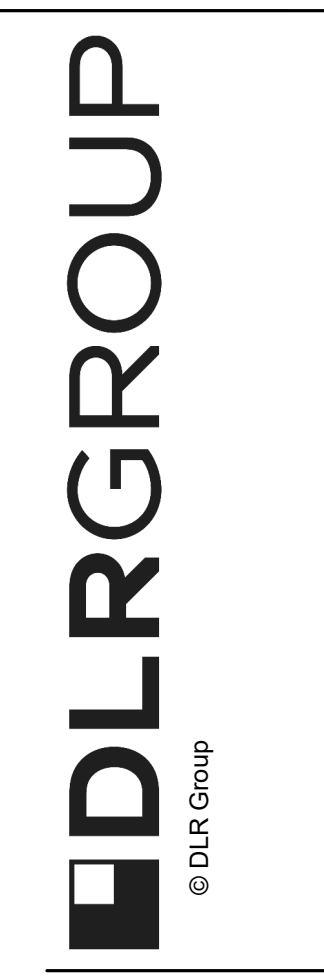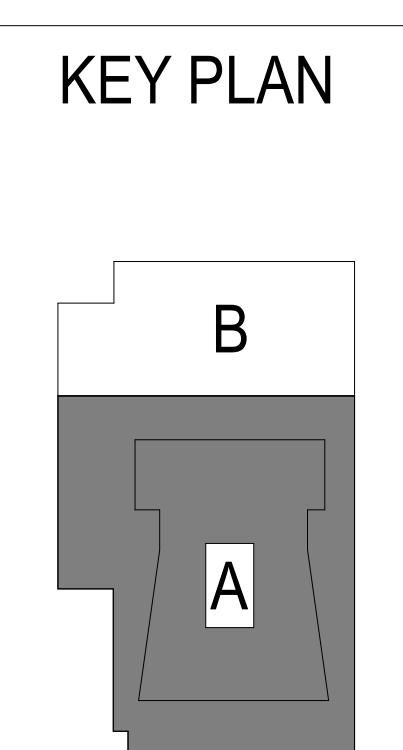

CRANDALL ISD HIGH SCHOOL
 PAC ADDITION
 13385 Fm 3038, Crandall, TX 75114

ISSUE FOR BID AND PERMIT
 2024.08.19
 REVISIONS
 A00-1 8824

39-23712-00
 LEVEL 02
 MEZZANINE -
 AREA A -
 LIGHTING PLAN

EL1.2A

Autodesk Docs://99-23712-00_Crandall ISD - PAC/39-23712-00_Crandall ISD_EL_2024.rvt
 8/20/2024 2:25:04 PM

LEVEL 02 MEZZANINE - AREA A - LIGHTING PLAN
 SCALE: 1/8" = 1'-0"

A:\desk\Docs\192-23712-00_Crandall ISD - PAC\39-23712-00_Crandall ISD - EL_2024.rvt
8/20/2024 2:25:07 PM

1

2

3

4

5

A



B

C

D



E

F

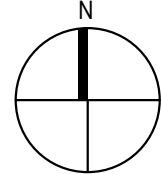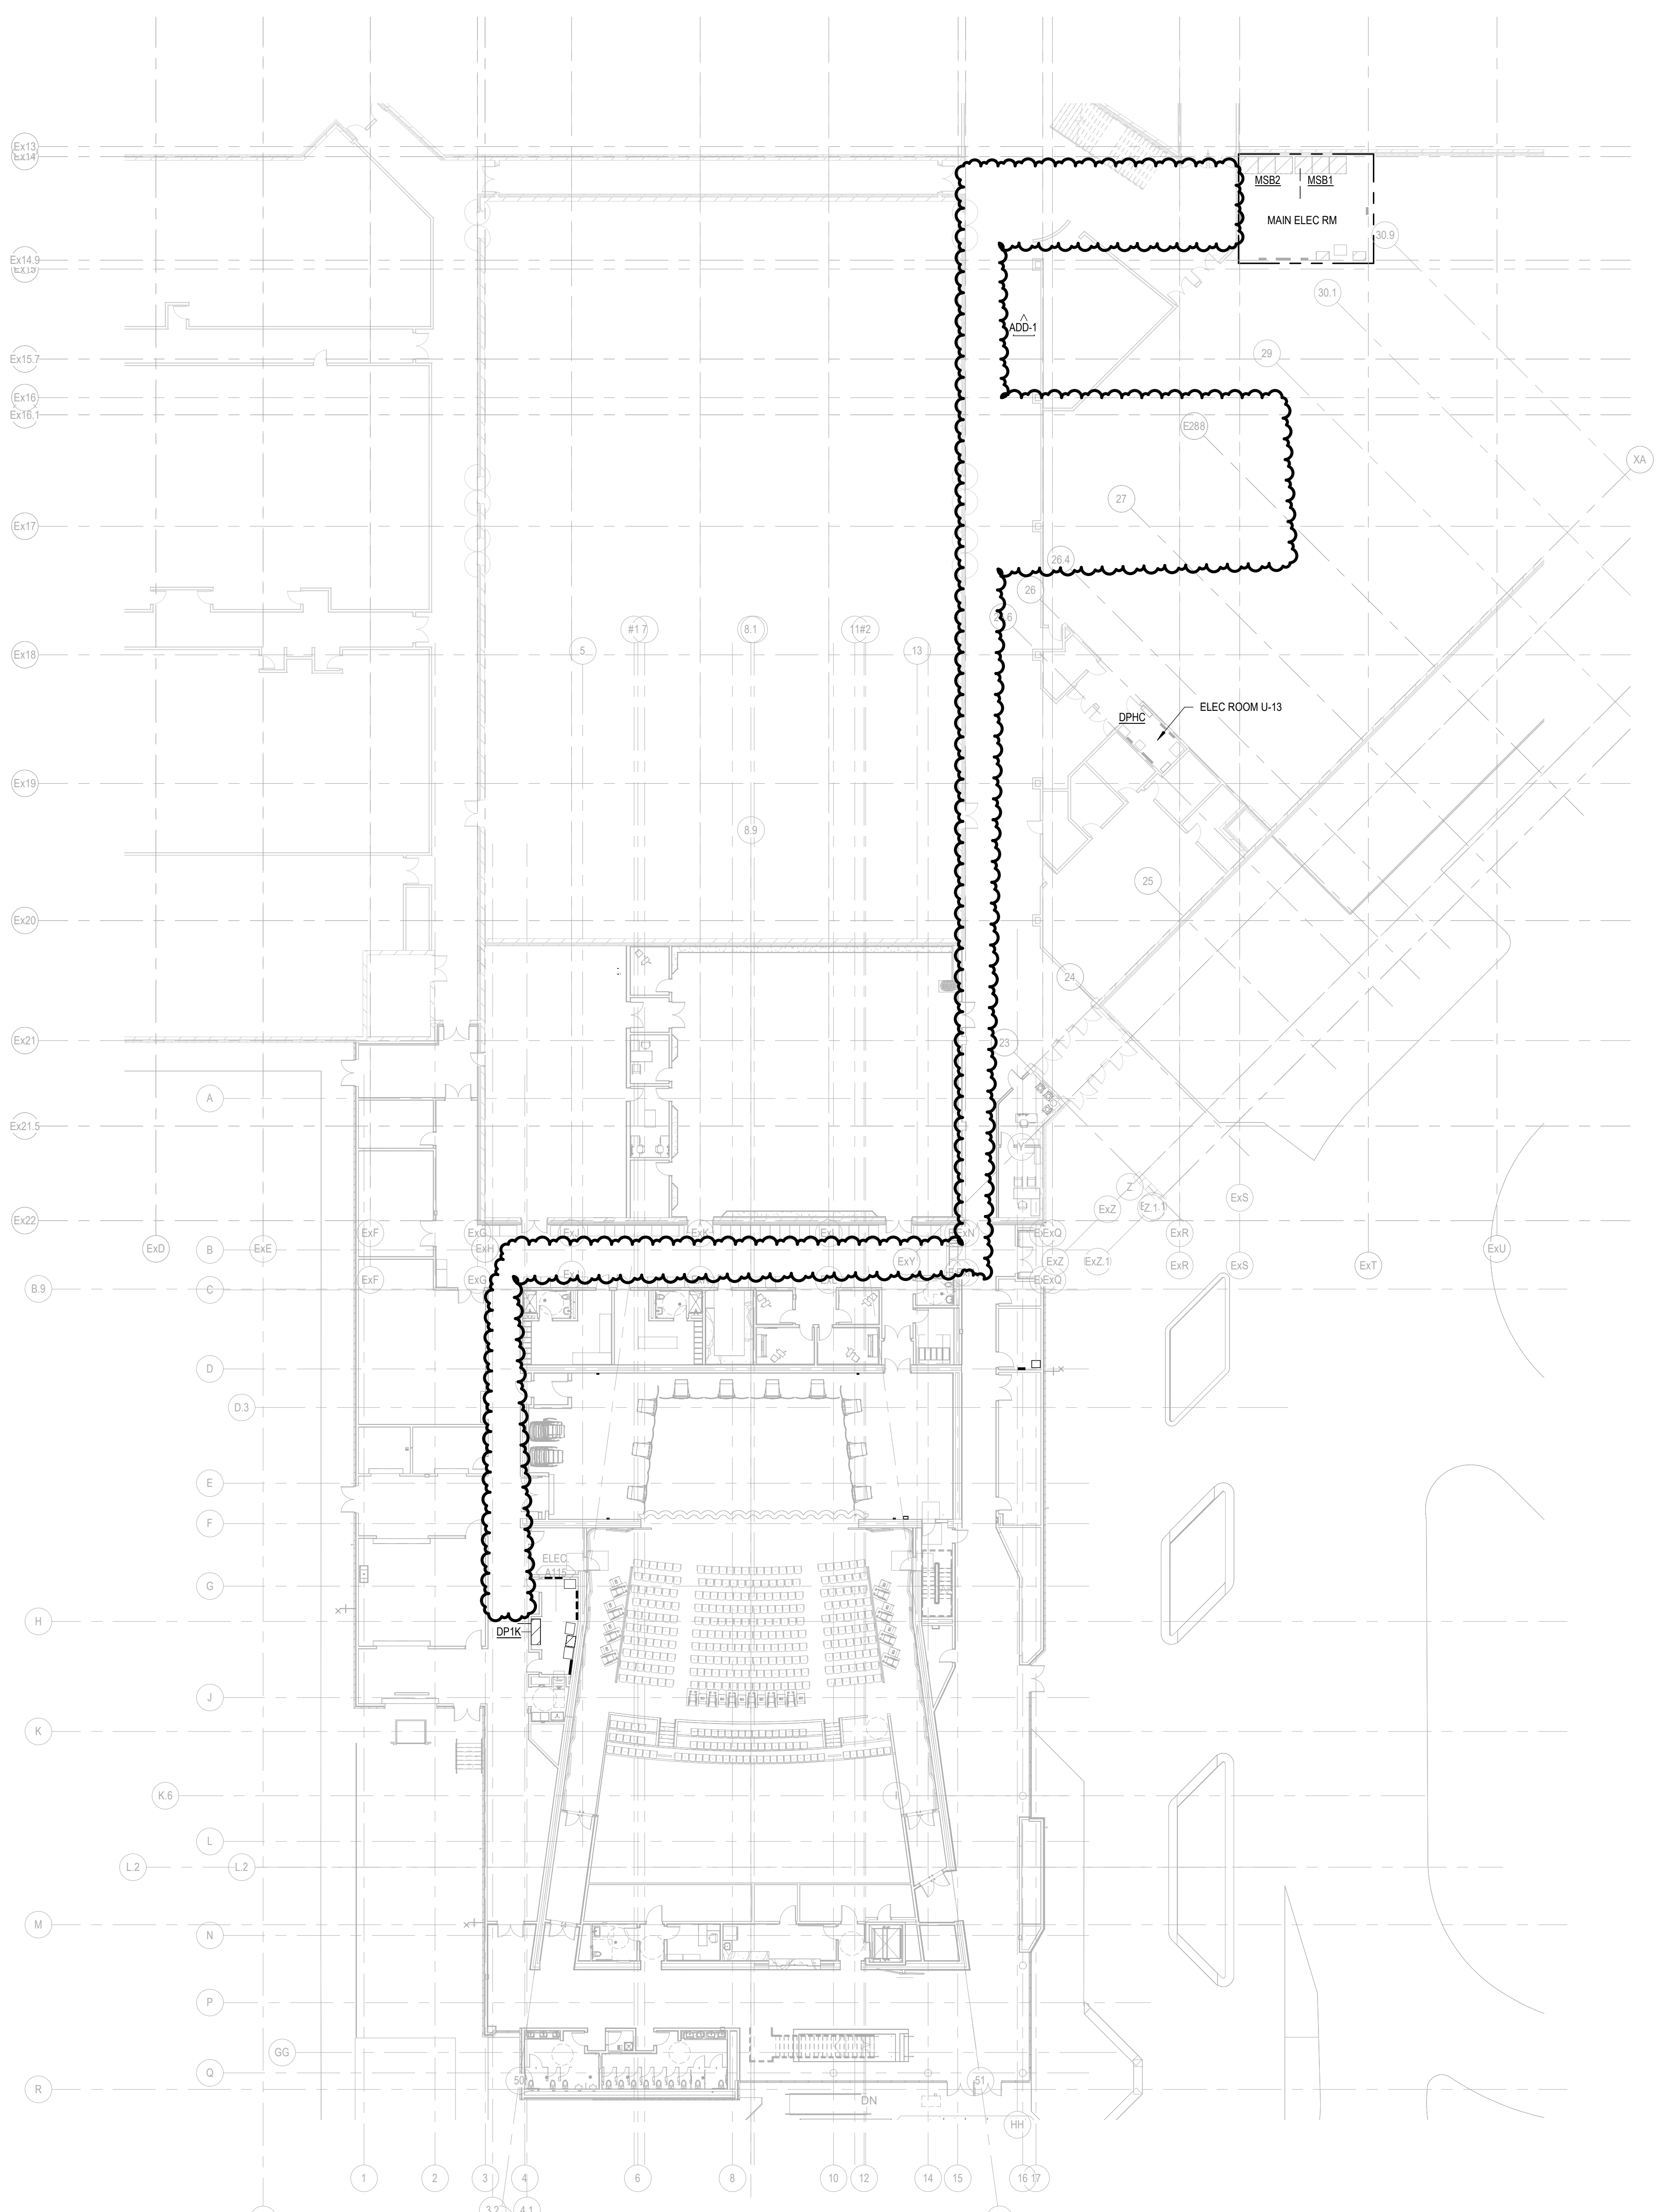

LEVEL 01 - OVERALL POWER PLAN
SCALE: 1" = 20'-0"



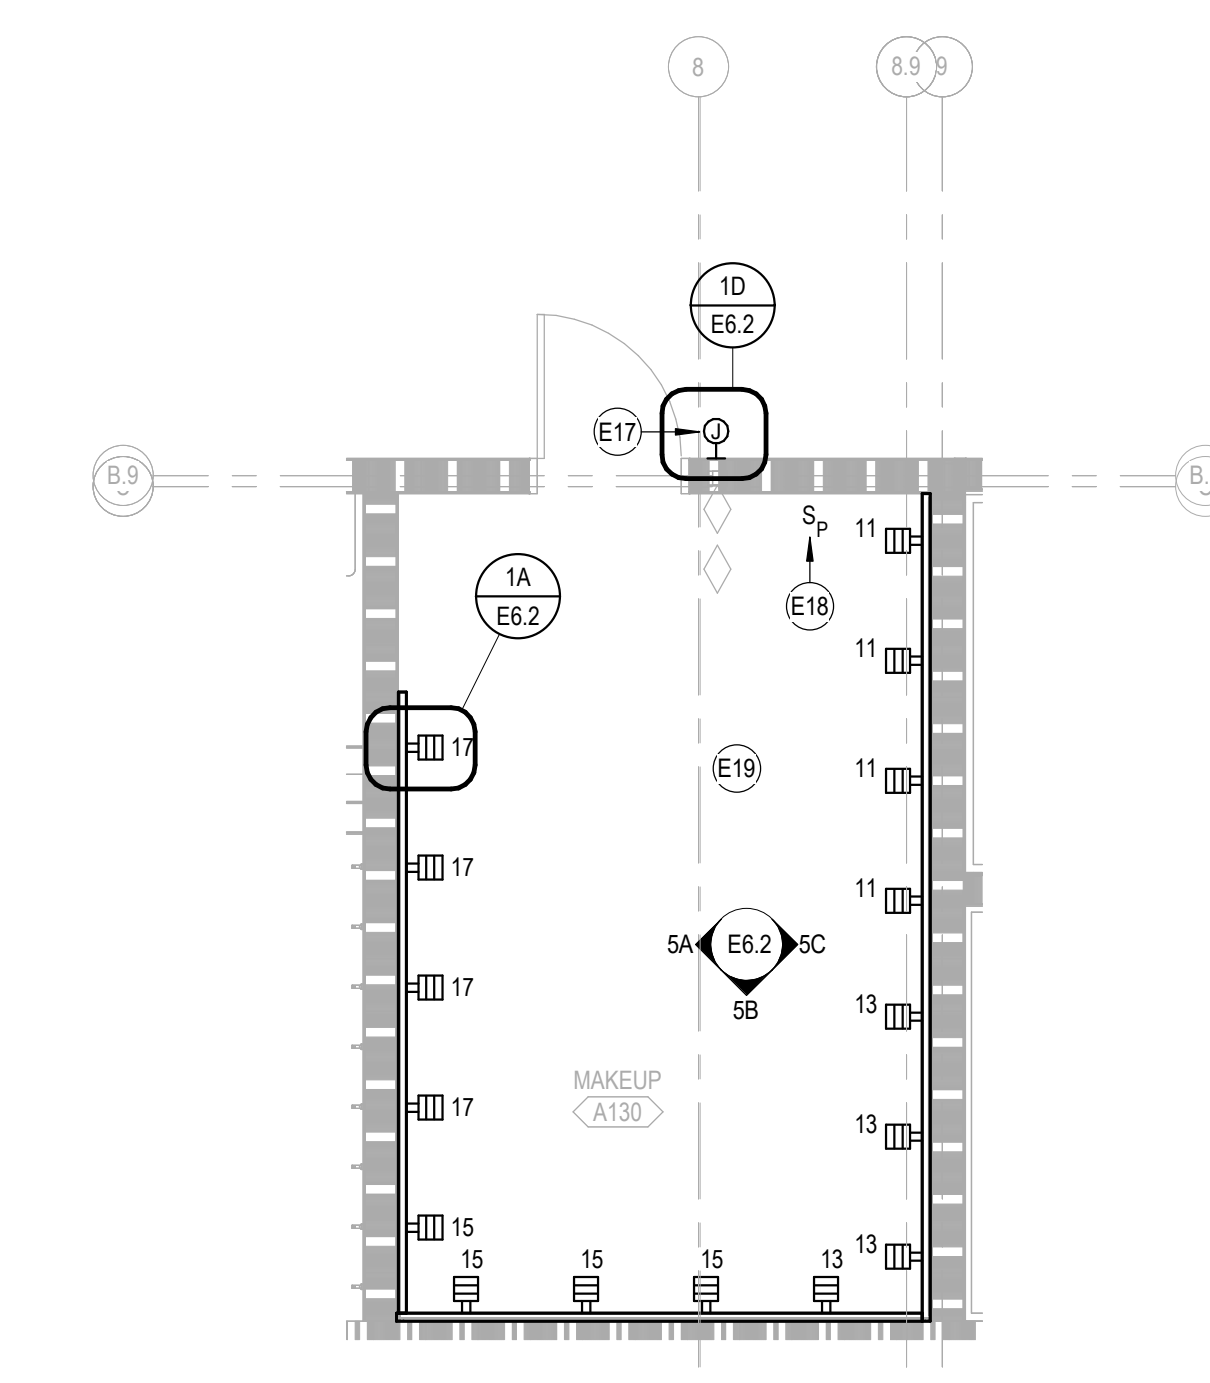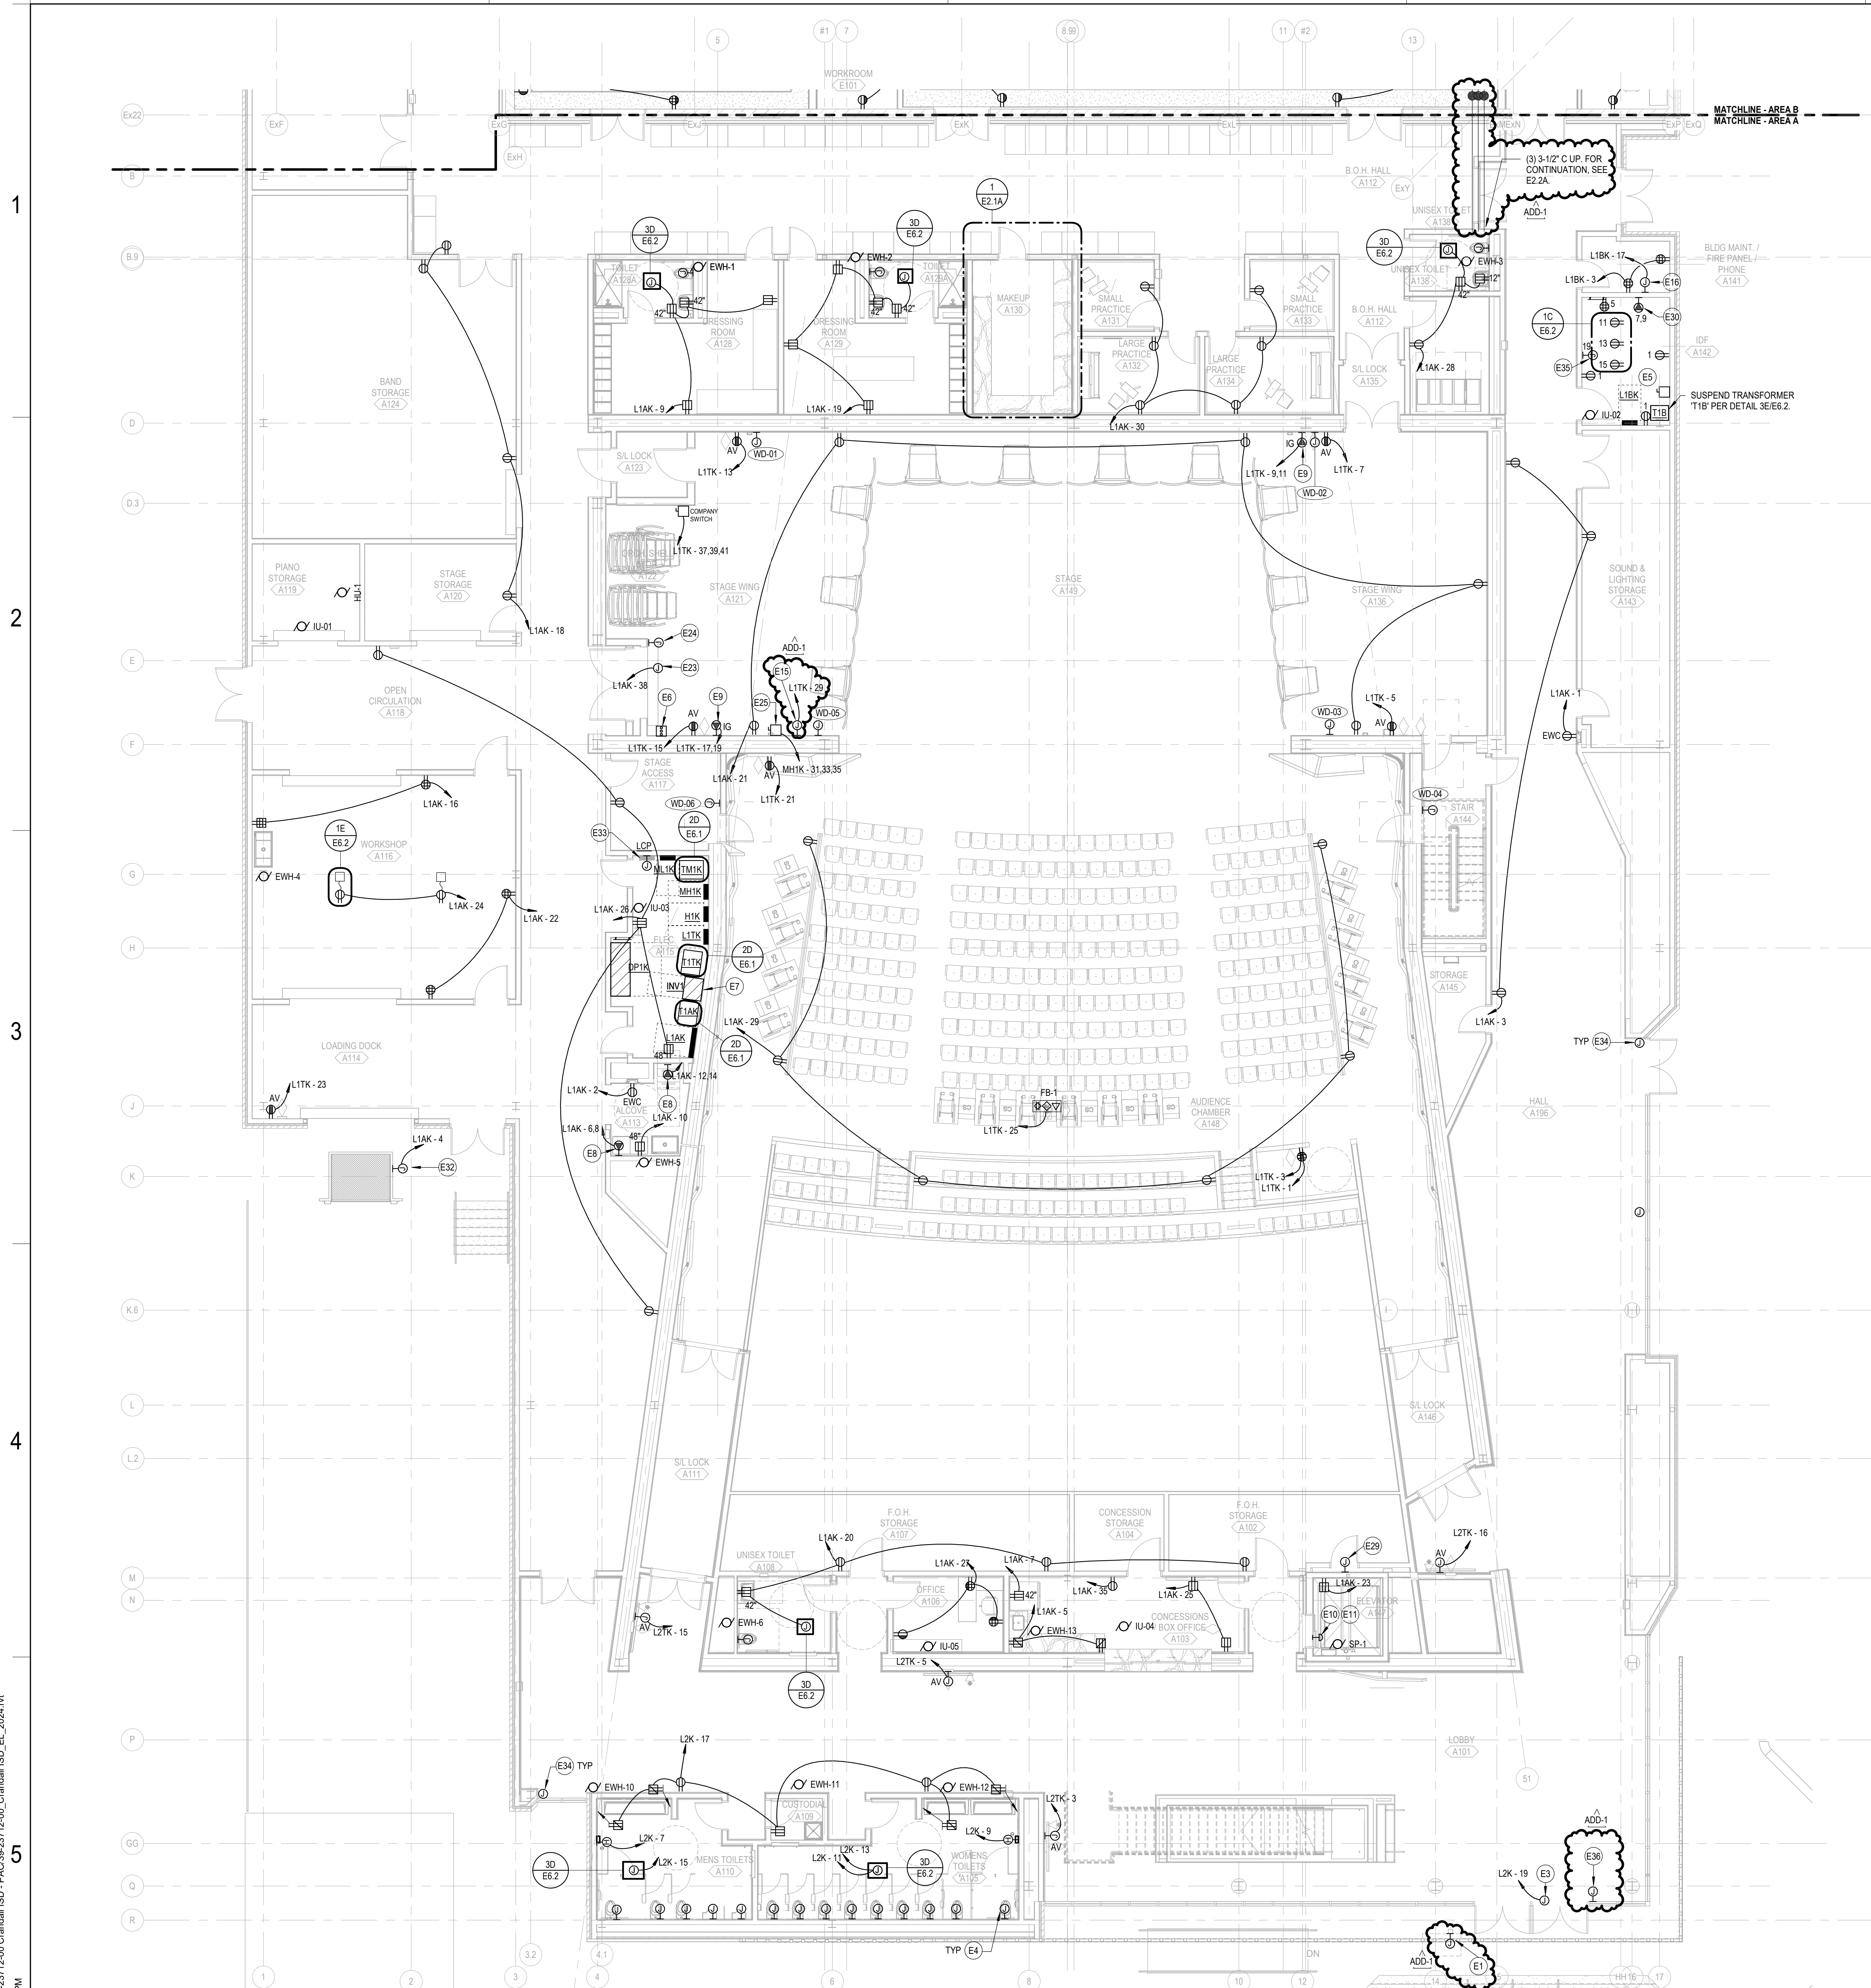


GENERAL NOTES

A PROVIDE BLACK RECEPTILES WITH BLACK NYLON FACEPLATES IN THE AUDITORIUM AND STAGE.

SHEET NOTES

- E1 PUSHBUD FOR ADA OPERATOR MOUNTED ON BOLLARD. PROVIDE 1" TO AUTO DOOR OPERATOR. ACTUATOR FURNISHED BY DIV 8. INSTALL AND CONNECT DOOR ADD-1.
- ADD-1 ACTUATOR. SEE RETAIL SPEC 2 FOR CONDUIT ROUTING.
- E3 CONNECT POWER DOOR OPERATOR TO CIRCUIT SHOWN. PROVIDE 182 WIRE TO EACH DOOR ACTUATOR.
- E4 PROVIDE 4" SQUARE FLUSH JUNCTION BOX WITH PLASTER RING. INSTALL MECHANICAL FURNISHED. SLENDRO, SENSOR AND COVER PLATE. LOW VOLTAGE WIRING DAISY CHAINED BETWEEN UNITS TO TRANSFORMER PROVIDED BY MECHANICAL CONTRACTOR.
- E5 ALL CIRCUITS IN THIS ROOM CONNECTED TO PANEL L18.
- E6 PUSHBUTTON CONTROL FOR MOTORIZED DOOR. FURNISHED BY DIVISION 8. PUSHBUTTON CONTROL AND SAFETY SYSTEM INSTALLED AND CONNECTED BY DIV 26.
- E7 FLOOR MOUNTED CENTRAL BATTERY INVERTER. HOMERUN 30-2W TO PANEL H1. SEE INVERTER SCHEDULE ON E6.2 FOR ADDITIONAL INFORMATION.
- E8 NEMA 6-20R WITH 20-2V. VERIFY WITH OWNER. FURNISHED EQUIPMENT PRIOR TO INSTALLATION.
- E9 NEMA L21-30R WITH 30-2W.
- E10 CONNECT EMERGENCY STOP PUSHBUTTON TO CONTROL PANEL IN ELEVATOR CONTROL ROOM.
- E11 INSTALL DEVICES IN ELEVATOR PIT 12 INCHES ABOVE FIRST LEVEL FINISH FLOOR LINE.
- E15 WALL MOUNTED RIGGING CONTROLLER. PROVIDE CONNECTION TO FIRE ALARM CONTROL PANEL. COORDINATE WITH REVIEWED FIRE ALARM SHOP DRAWINGS.
- E16 PROVIDE REMOTE PILOT FACEPLATE AND CONNECT TO LIGHTS AND RECEPTACLES IN DRESSING ROOM PER NEC 500.74.
- E17 SWITCH CONNECTED TO CONTACTOR TO CONTROL POWER IN DRESSING ROOM.
- E18 CONNECT EACH RECEPTACLE IN THIS DRESSING ROOM TO CIRCUIT INDICATED IN PANEL L1A VIA MECHANICALLY HELD CONTACTOR. CONNECT THE CONTACTOR TO SWITCH AND REMOTE PILOT INDICATOR. PROVIDE ENGRAVED STAINLESS STEEL FACEPLATE LABELED "RECEPTACLE POWER".
- E23 PROVIDE POWER FOR OVERHEAD MOTORIZED DOOR. PROVIDE RECEPTACLE OR MOTOR RATED TOGGLE SWITCH AND CONNECT TO OPERATOR AND CIRCUIT SHOWN. CONFIRM CONNECTION REQUIREMENTS WITH REVIEWED SHOP DRAWINGS.
- E24 PROVIDE SINGLE GANG OUTLET BOX AT 12" AFF WITH 1/2" C TO OPERATOR FOR SAFETY SENSOR WIRING. PROVIDE ON BOTH SIDES IF REQUIRED. COORDINATE WITH REVIEWED SHOP DRAWINGS.
- E25 PROVIDE POWER FOR FIRE HOIST MOTOR. 20-3W. 30A/3P NF DISCONNECT.
- E29 ALARM PANEL LOCATION FOR ELEVATOR SUMP PUMP. PROVIDE POWER PER MECHANICAL CONNECTION SCHEDULE AND 1-INCH CONDUIT FOR OIL SENSOR CABLE TO SUMP PIT. NO JUNCTION BOXES IN HOISTWAY FOR SENSOR CABLE.
- E30 NEMA L5-30R WITH 30-2W.
- E32 CONNECTION TO DOCK LEVELER. CONNECT TO CIRCUIT INDICATED.
- E33 CONNECTION TO LIGHTING CONTROL PANEL. COORDINATE WITH REVIEWED SHOP DRAWINGS.
- E34 (2) 1/2" C FROM OF CURTAIN WALL SYSTEM TO STRUCTURE FOR CONNECTION OF FUTURE MOTORIZED SHADING SYSTEM.
- E35 PROVIDE CONNECTION FOR FUTURE DOOR CONTROL PUMP. PROVIDE POWER PER MECHANICAL CONNECTION SCHEDULE AND 1-INCH CONDUIT FOR OIL SENSOR CABLE TO SUMP PIT. NO JUNCTION BOXES IN HOISTWAY FOR SENSOR CABLE.
- E36 PUSHBUD FOR ADA OPERATOR MOUNTED ON BOLLARD. PROVIDE 1" TO AUTO DOOR OPERATOR. ACTUATOR FURNISHED BY DIV 8. INSTALL AND CONNECT THE DOOR ACTUATOR. SEE RETAIL SPEC 2 FOR CONDUIT ROUTING.

KEY PLAN

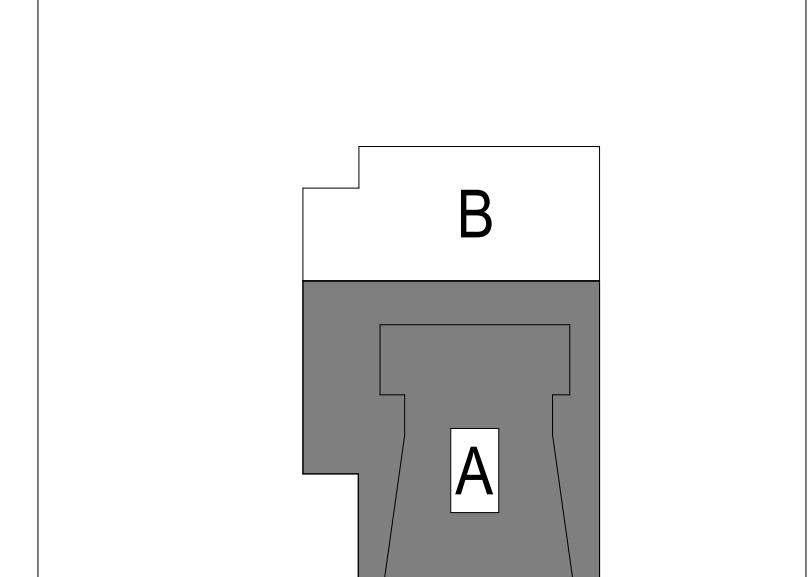

Autodesk Docs/199-23712-00 Crandall ISD - PAC/23-23712-00 Crandall ISD_EL_2024.rvt
8/20/2024 2:28:18 PM

LEVEL 01 - AREA A - POWER PLAN
SCALE: 1/8" = 1'-0"

ENLARGED POWER PLAN MAKEUP A130
SCALE: 1/4" = 1'-0"

DLR GROUP
© DLR Group


CRANDALL ISD HIGH SCHOOL
PAC ADDITION
13385 Fm 3038, Crandall, TX 75741

ISSUE FOR BID AND PERMIT
2024.08.19
REVISIONS
ADD-1 8824

39-23712-00
LEVEL 01 - AREA A - POWER PLAN
E2.1A


A:\desk\Docs\199-23712-00 Crandall ISD - PAC\39-23712-00_Crandall ISD_EL_2024.rvt
8/20/2024 2:29:21 PM

1
2
3
4
5

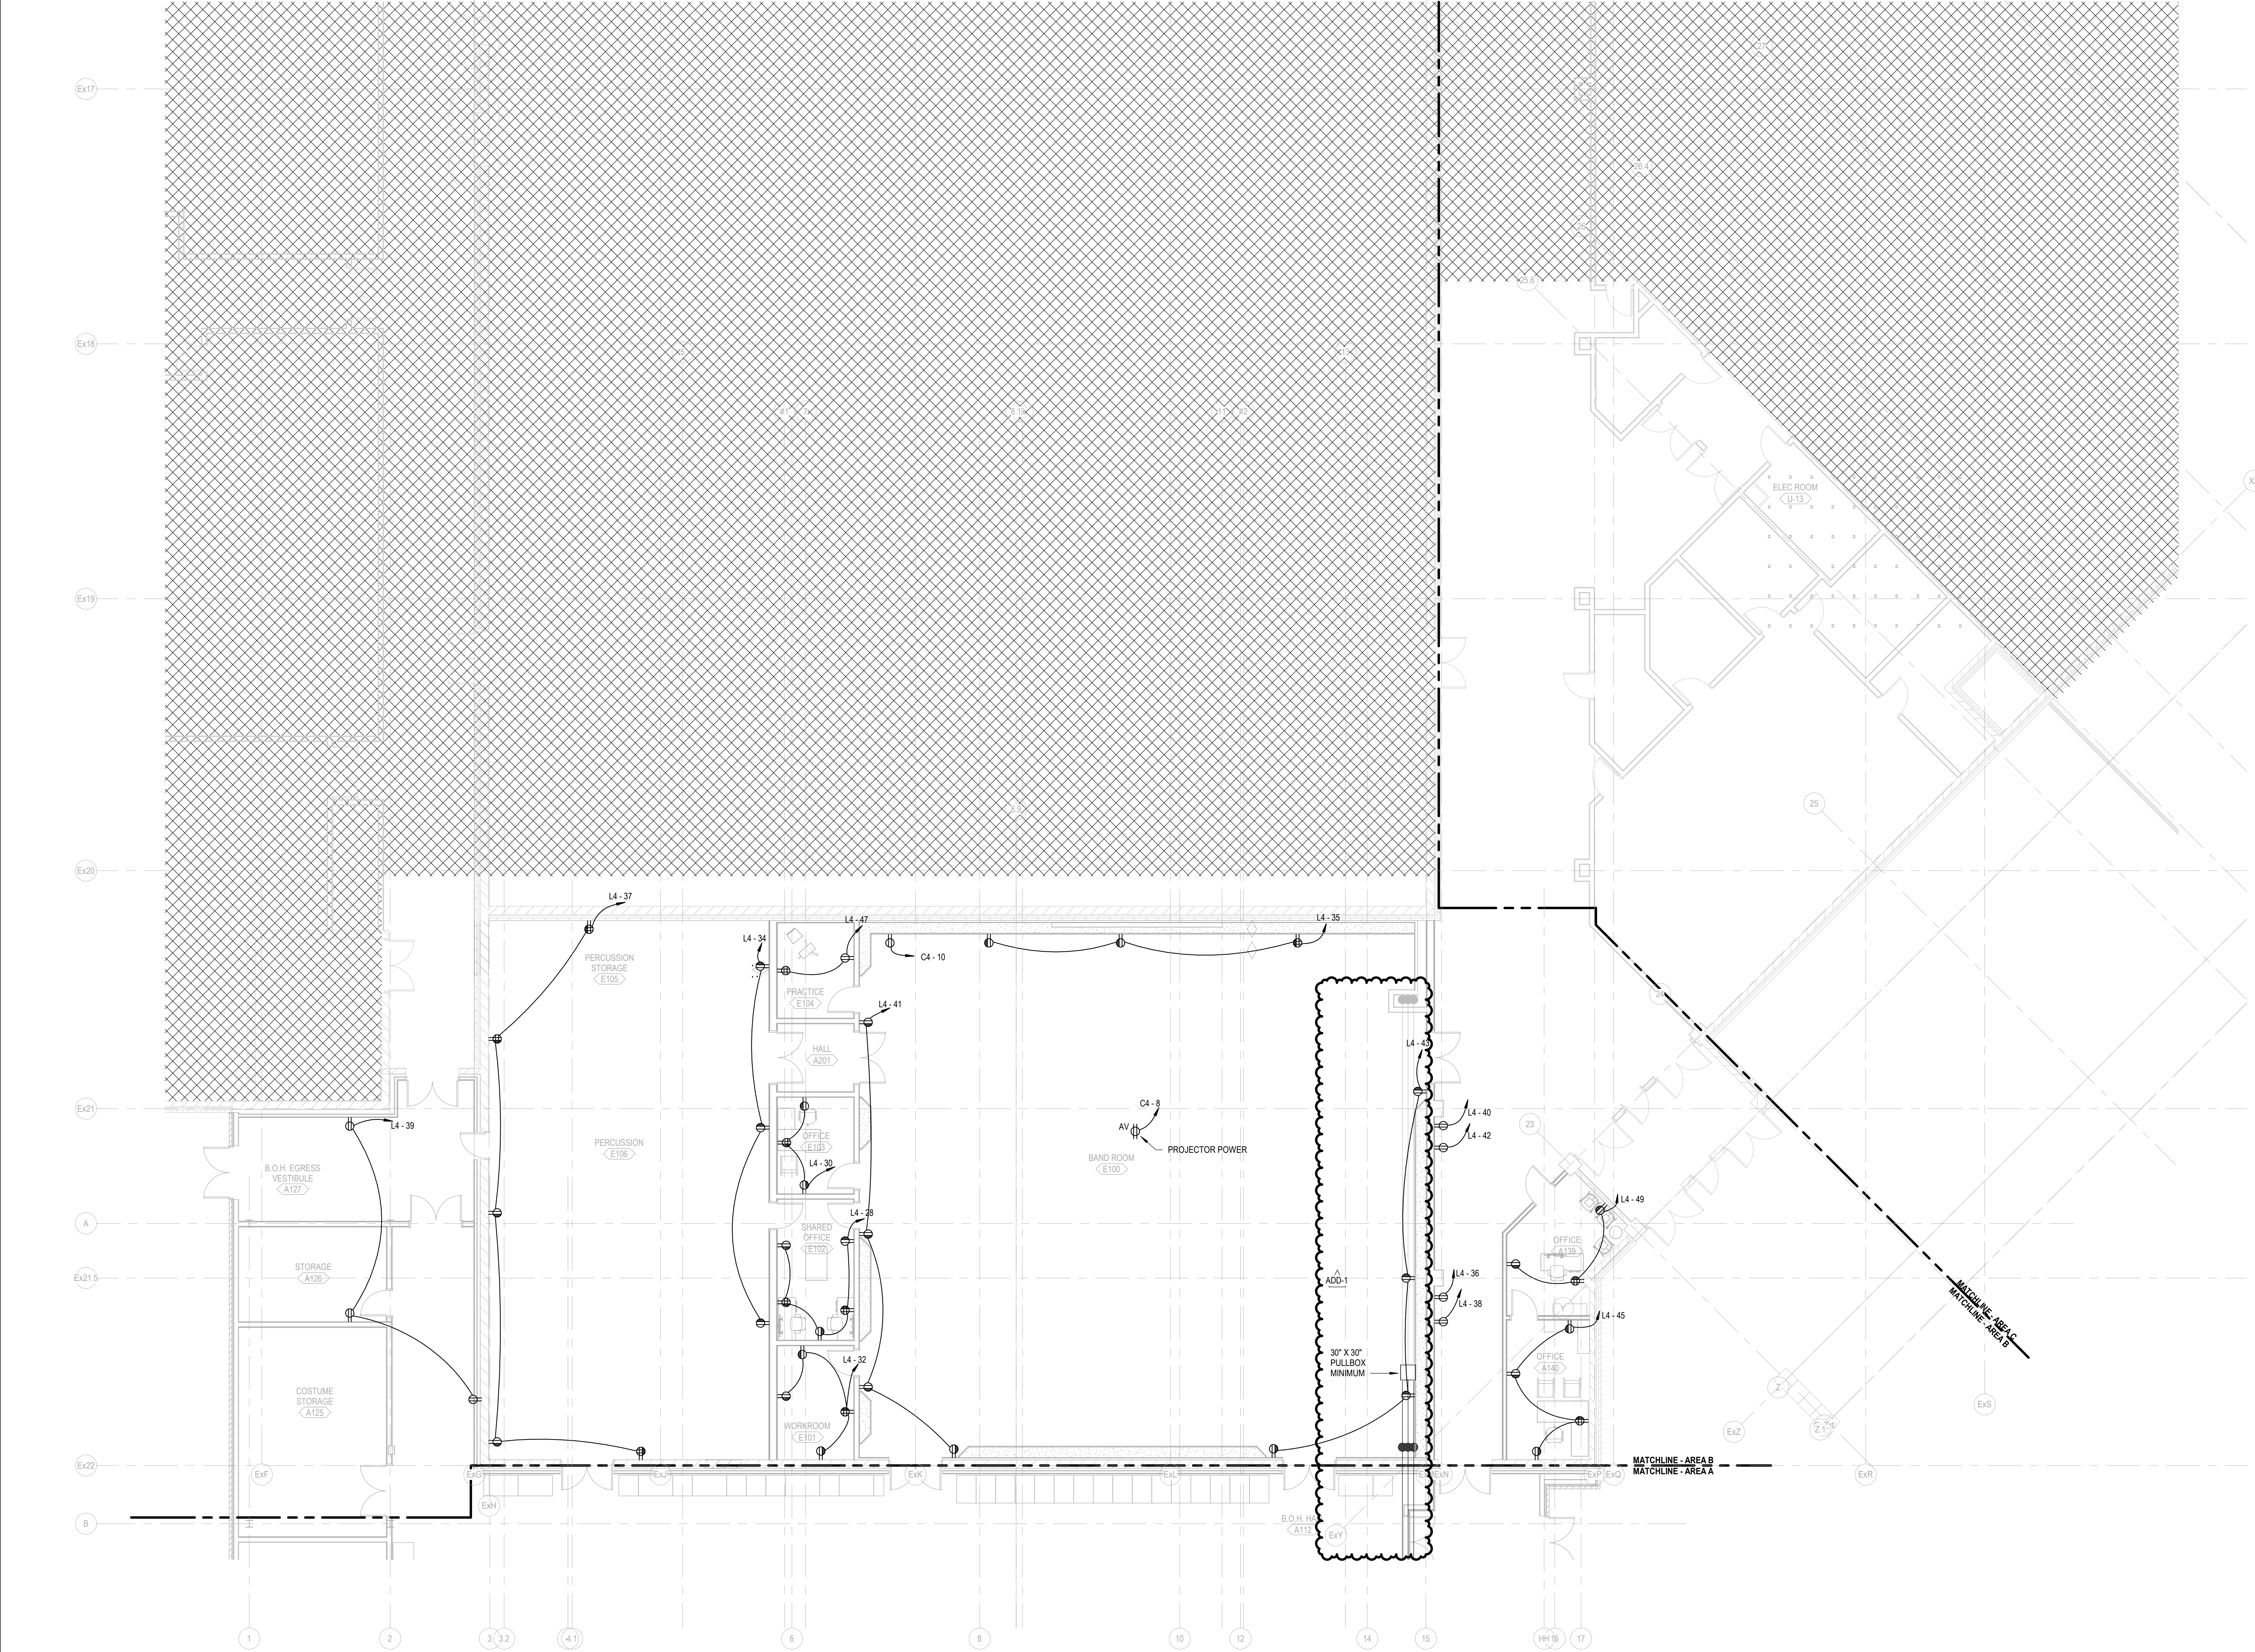

SHEET NOTES

KEY PLAN

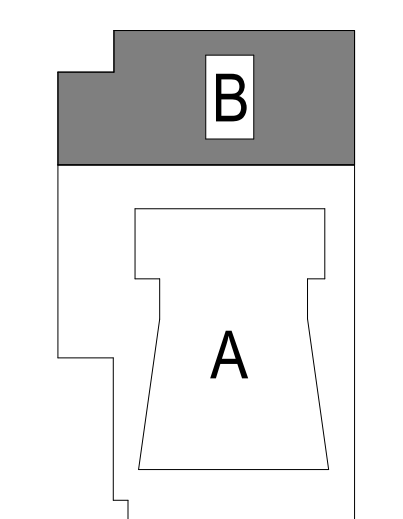


LEVEL 01 - AREA B - POWER PLAN
SCALE: 1/8" = 1'-0"



ISSUE FOR BID AND PERMIT
2024.08.19
REVISIONS
ADD-1 8824

39-23712-00
LEVEL 01 - AREA B - POWER PLAN

E2.1B

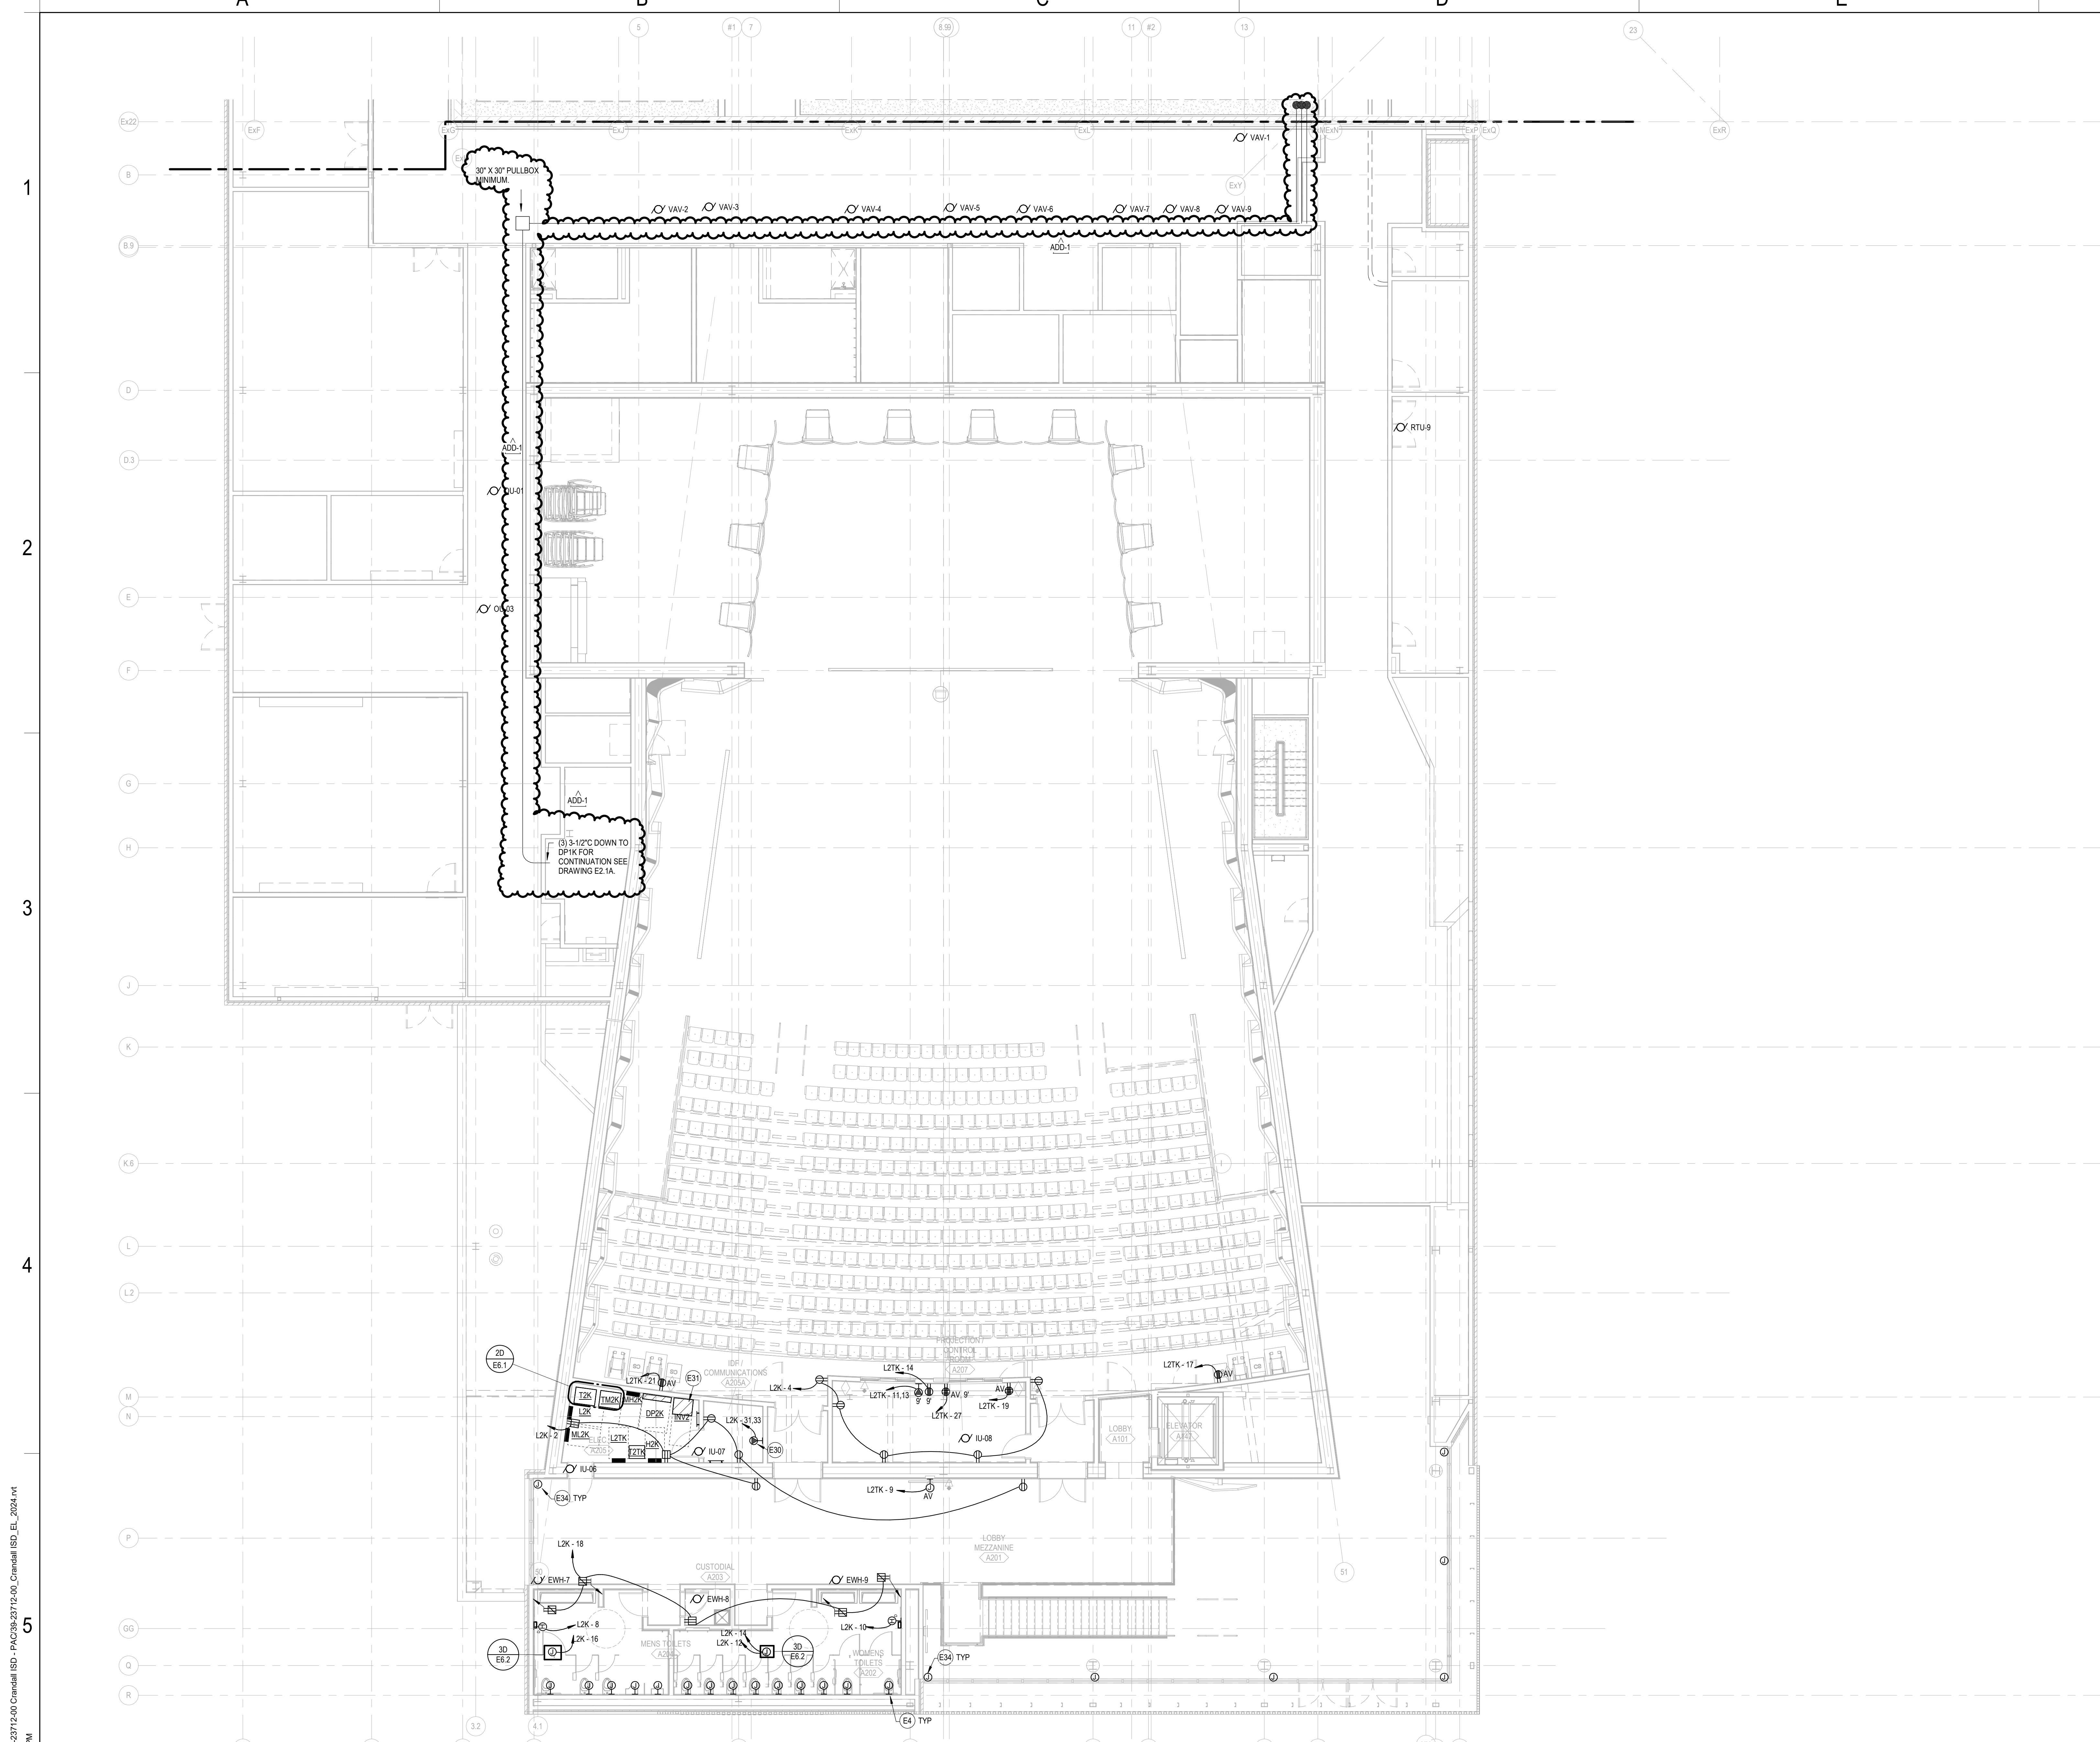


GENERAL NOTES

A PROVIDE BLACK RECEPTILES WITH BLACK NYLON FACEPLATES IN THE AUDITORIUM AND STAGE.

SHEET NOTES


- E4 PROVIDE 4" SQUARE FLUSH JUNCTION BOX WITH PLASTER RING. INSTALL MECHANICAL FURNISHED SOLENOID, SENSOR AND COVER PLATE. LOW VOLTAGE WIRING DAISY CHAINED BETWEEN UNITS TO TRANSFORMER PROVIDED BY MECHANICAL CONTRACTOR.
- E30 NEMA 15-30R WITH 30-2W
- E31 FLOOR MOUNTED CENTRAL BATTERY INVERTER. HOMERUN 30-2W TO PANEL H2. SEE INVERTER SCHEDULE ON E2.2 FOR ADDITIONAL INFORMATION.
- E34 (2) 1/2" FROM OF CURTAIN WALL SYSTEM TO STRUCTURE FOR CONNECTION OF FUTURE MOTORIZED SHADING SYSTEM.

KEY PLAN

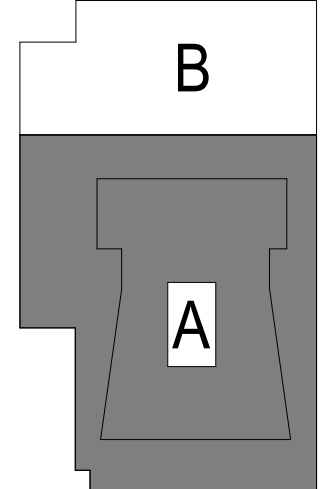

Autodesk Docs://99-23712-00_Crandall ISD - PAC/39-23712-00_Crandall ISD_EL_2024.rvt
 8/20/2024 2:25:26 PM

LEVEL 02 MEZZANINE - AREA A - POWER PLAN
 SCALE: 1/8" = 1'-0"

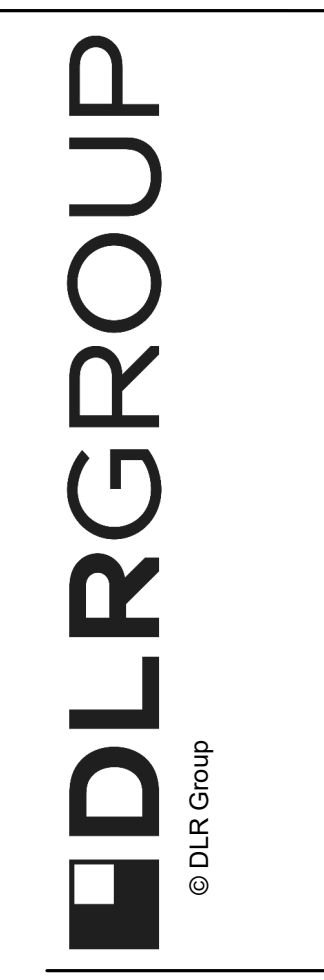


CRANDALL ISD HIGH SCHOOL
 PAC ADDITION
 13385 Fm 3038, Crandall, TX 75114

ISSUE FOR BID AND PERMIT
 2024.08.19
 REVISIONS
 A00-1 8824


39-23712-00
 LEVEL 02
 MEZZANINE -
 AREA A - POWER
 PLAN

E2.2A

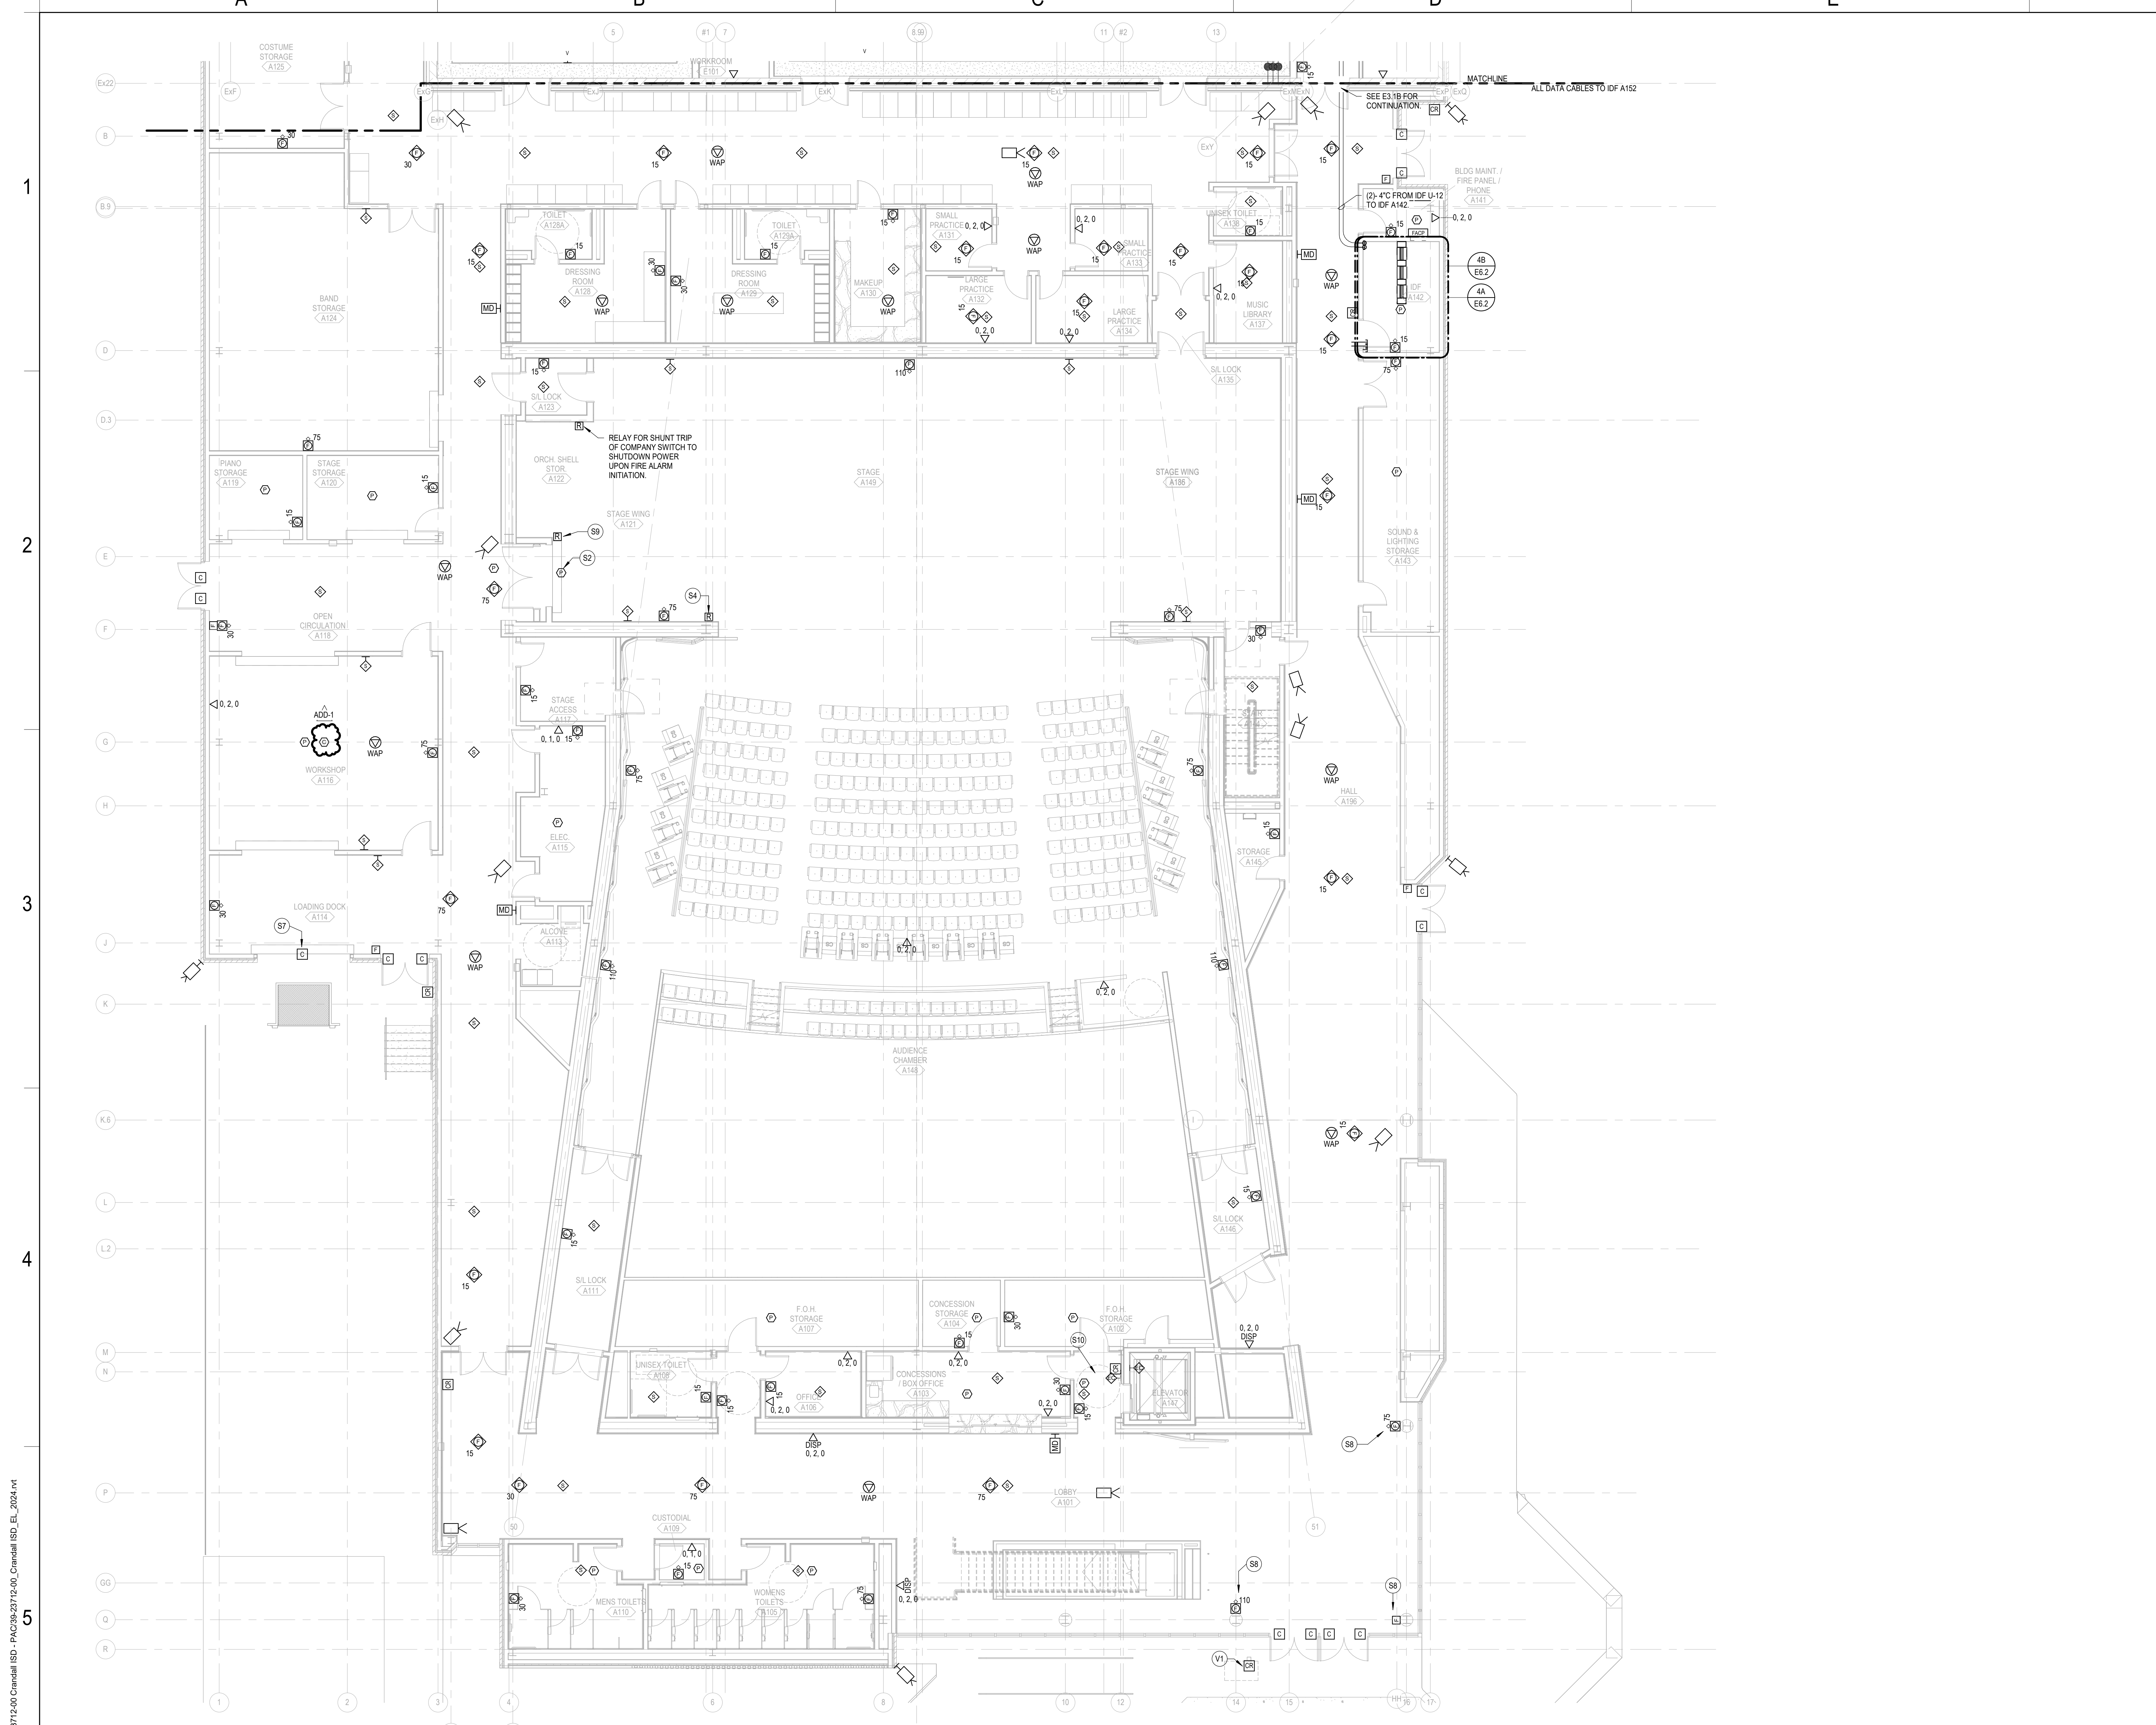

- SHEET NOTES**
- S2 PROVIDE 34°C TO OVERHEAD DOOR FOR DOOR POSITION SWITCH. COORDINATE LOCATION WITH SECURITY CONTRACTOR.
 - S4 PROVIDE FIRE ALARM CONTROL MODULE FOR RELEASE OF FIRE CURTAIN.
 - S7 PROVIDE 34°C TO OVERHEAD DOOR FOR DOOR POSITION SWITCH. COORDINATE LOCATION WITH SECURITY CONTRACTOR.
 - S8 MOUNT FIRE ALARM DEVICE ON WRAPPED COLUMN. INSTALL RECESSED BACK BOX FOR FLUSH MOUNTING OF DEVICE.
 - S9 FIRE ALARM RELAY ABOVE DOOR FOR RELEASE OF COILING DOOR UPON AREA DETECTION ON EITHER SIDE OF DOOR.
 - S10 CO-LOCATE CARD READER WITH ELEVATOR CALL BUTTONS.
 - V1 CARD READER MOUNTED ON BOLLARD. SEE DETAIL 3D/E6.2.


KEY PLAN

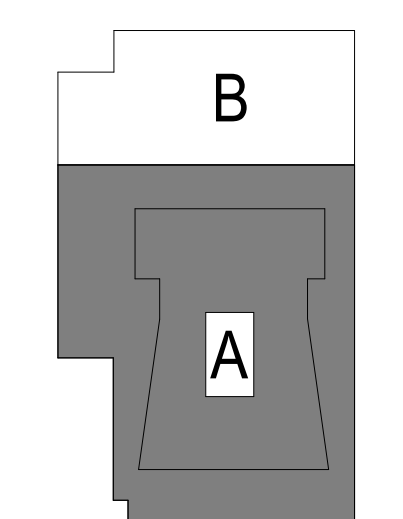

Autodesk Docs//39-23712-00_Crandall ISD - PAC/39-23712-00_Crandall ISD_EL_2024.rvt
8/20/2024 2:29:29 PM

LEVEL 01 - AREA A - SPECIAL SYSTEMS PLAN
SCALE: 1/8" = 1'-0"


Autodesk Docs://99-23712-00_Crandall ISD - PAC/39-23712-00_Crandall ISD_EL_2024.rvt
8/20/2024 2:29:30 PM

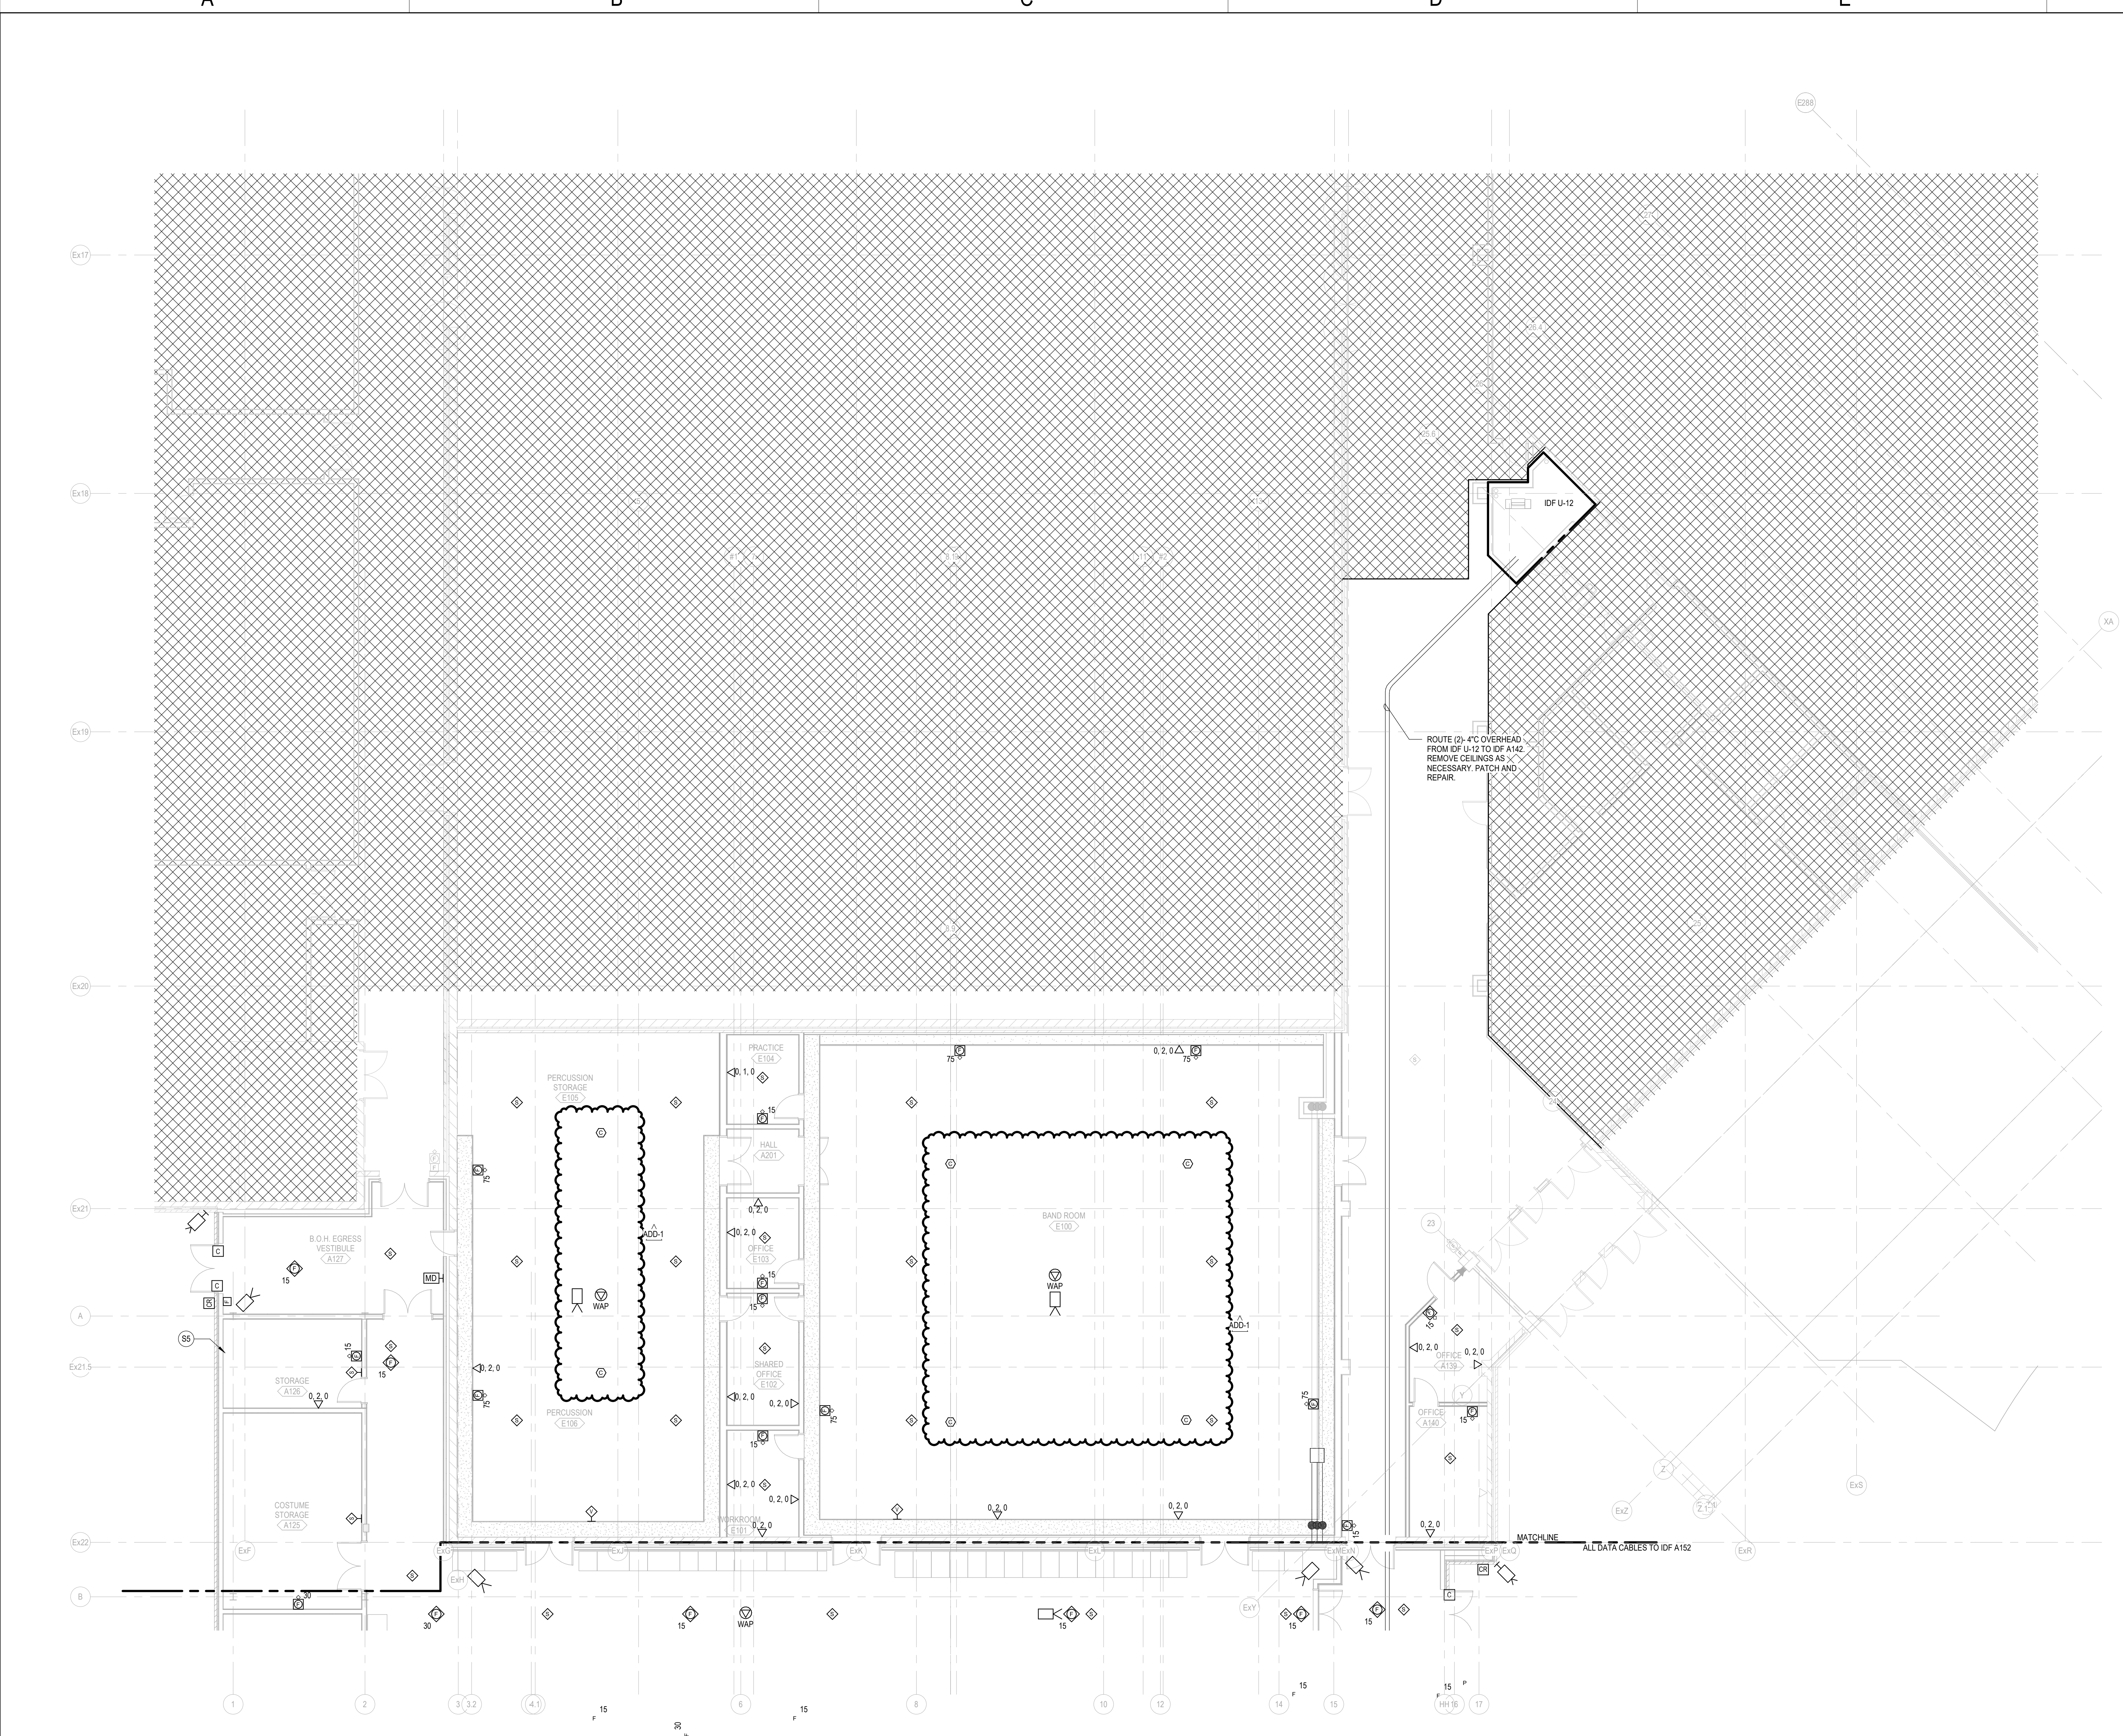


SHEET NOTES

S5 PROVIDE TAMPER AND FLOW SWITCHES FOR FIRE SUPPRESSION SYSTEMS. COORDINATE WITH FIRE SUPPRESSION DRAWINGS.

KEY PLAN

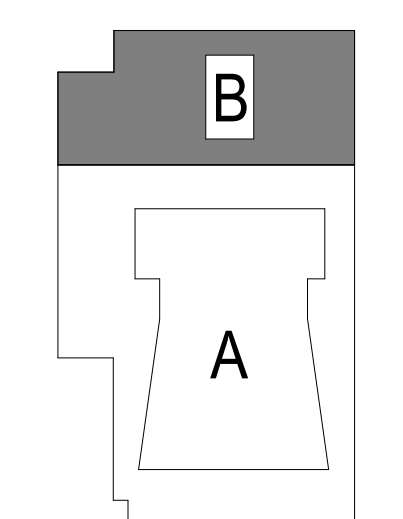

LEVEL 01 - AREA B - SPECIAL SYSTEMS PLAN
SCALE: 1/8" = 1'-0"

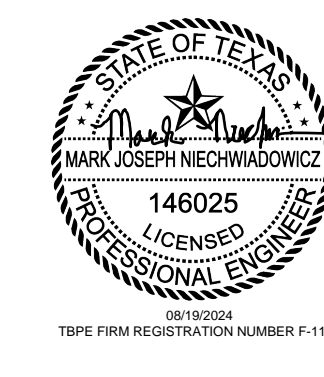


ISSUE FOR BID AND PERMIT
2024.08.19
REVISIONS
A00-1 8824

39-23712-00

LEVEL 01 - AREA B - SPECIAL SYSTEMS PLAN

E3.1B

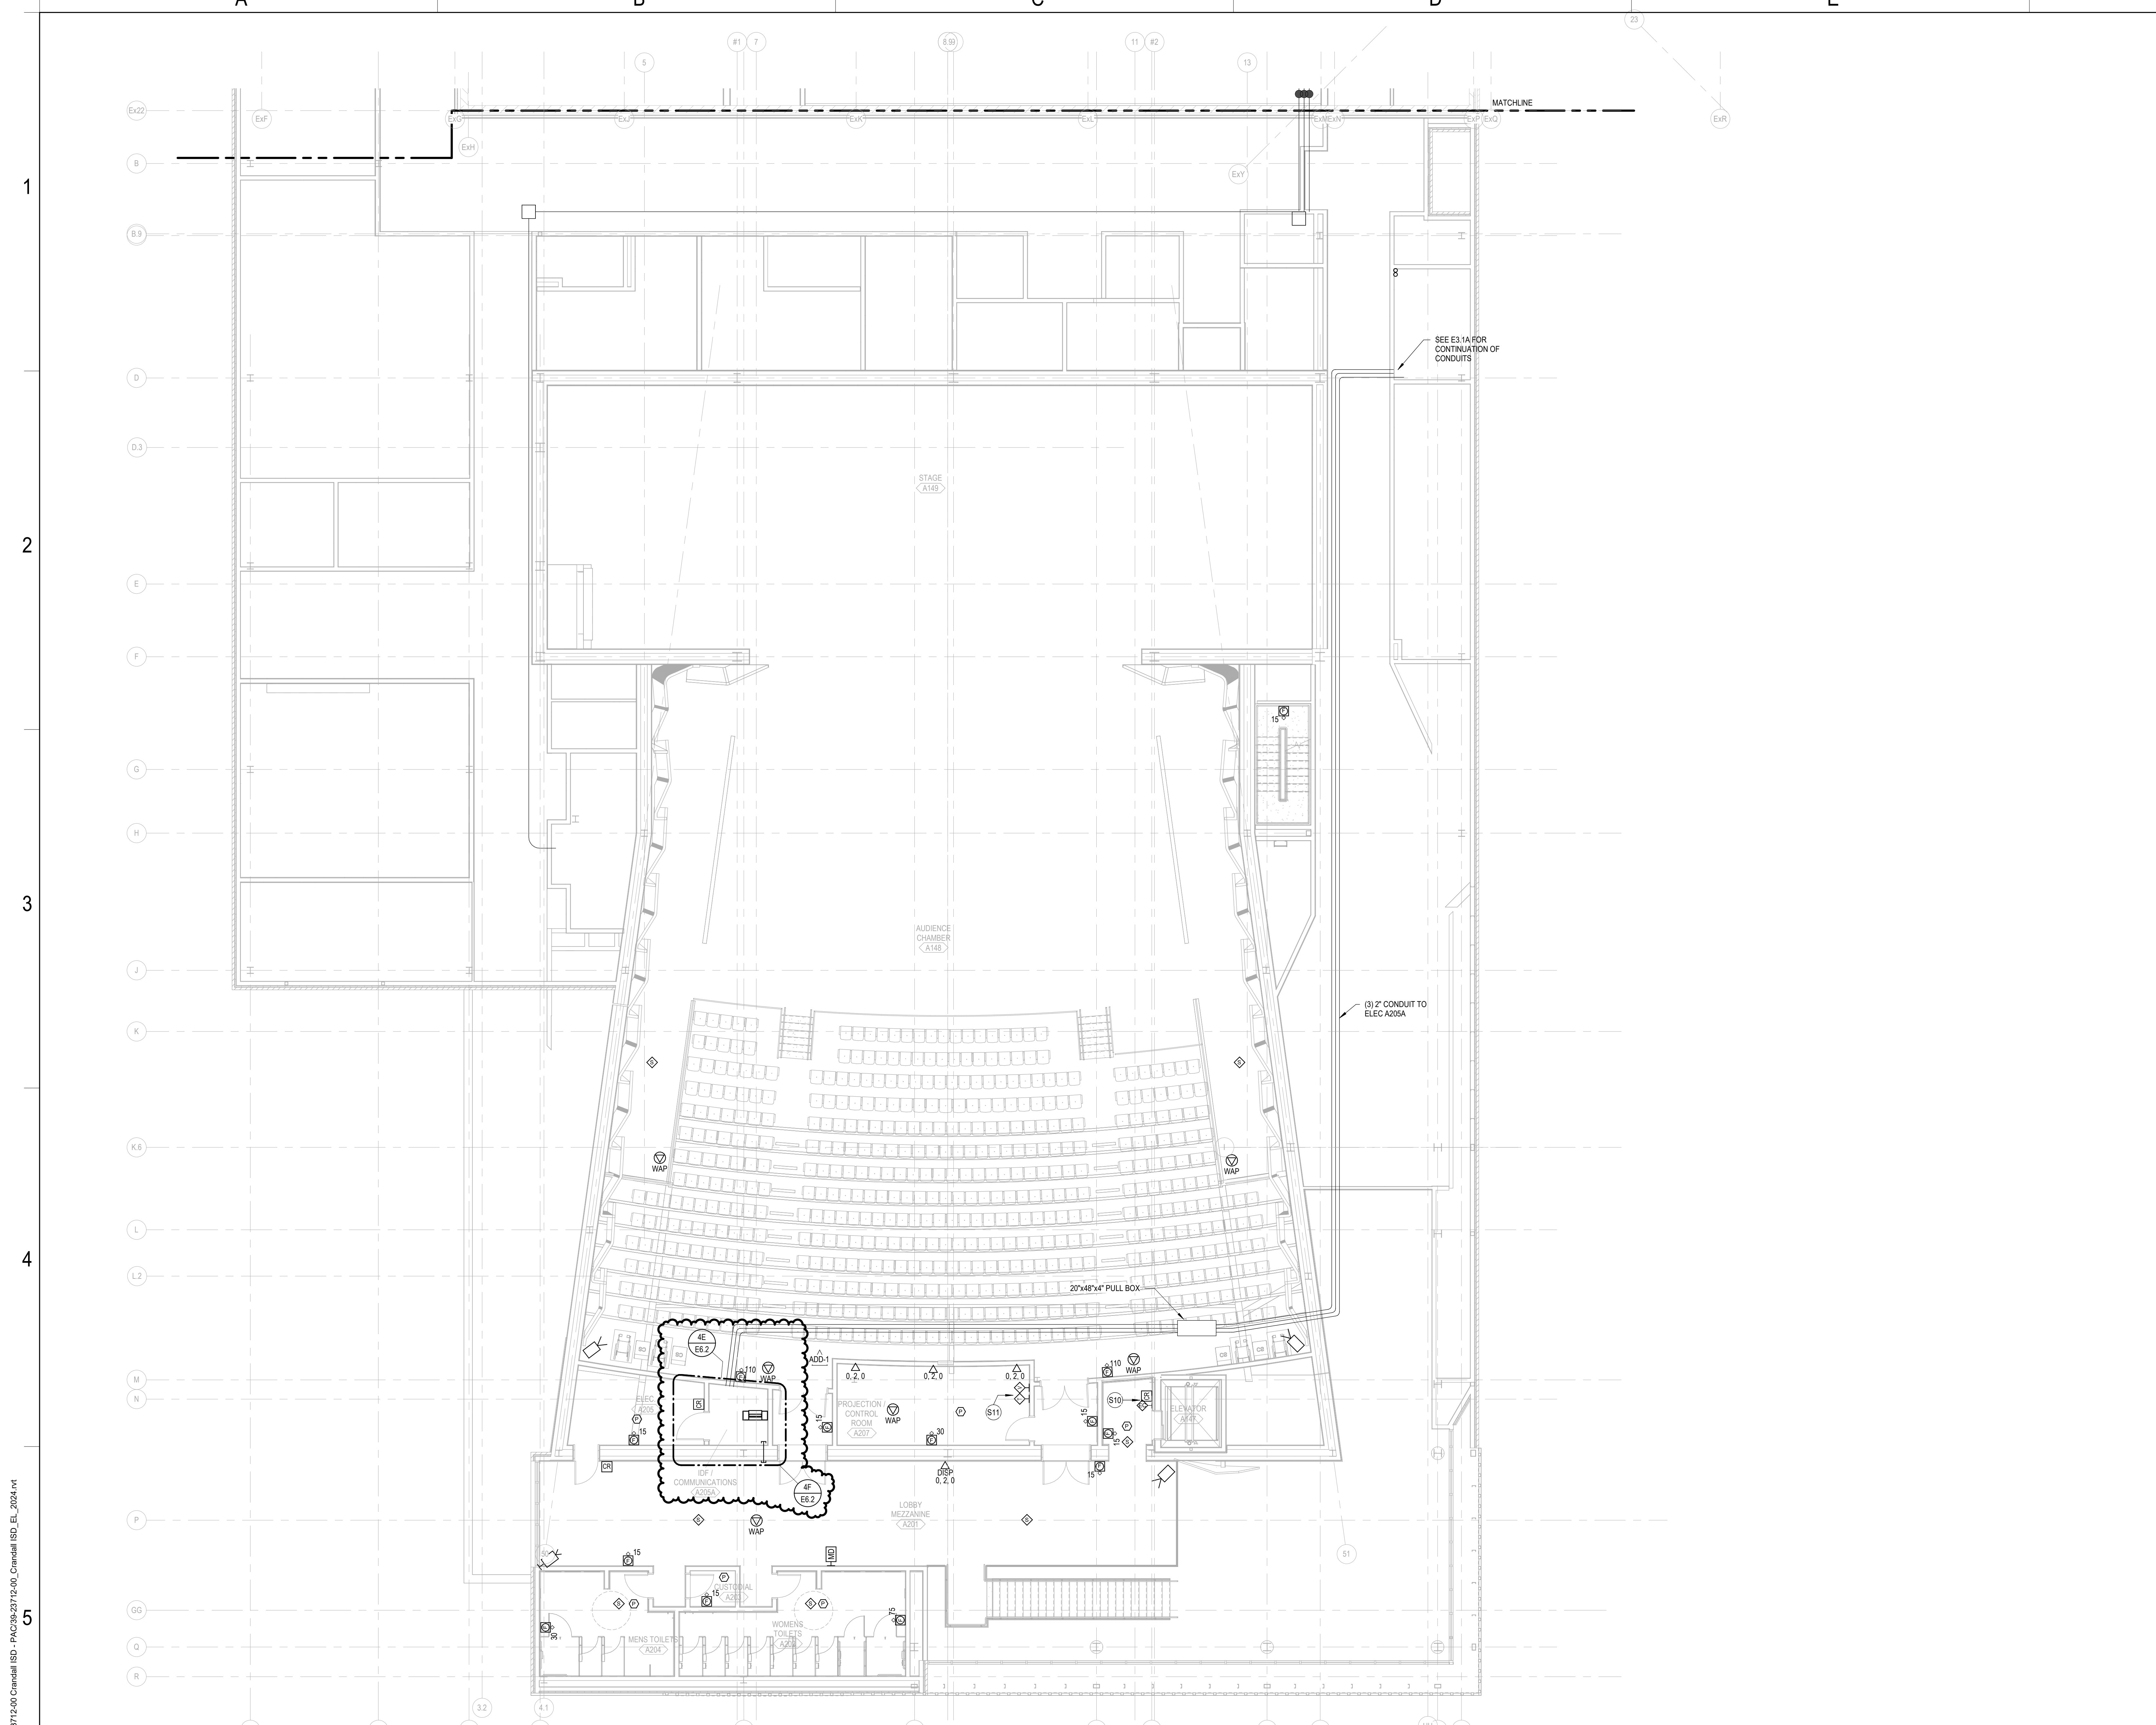


GENERAL NOTES

A ALL DATA CABLES THIS SHEET TO COMM ROOM A205A

SHEET NOTES

S10 CO-Locate CARD READER WITH ELEVATOR CALL BUTTONS

S11 PROVIDE TIMER AND RELAY CONNECTED TO TURN OFF ALL INTERCOM SPEAKERS ASSOCIATED WITH THE AUDITORIUM AND STAGE AREA. WHEN TIMER IS OFF, SPEAKERS TURN ON.

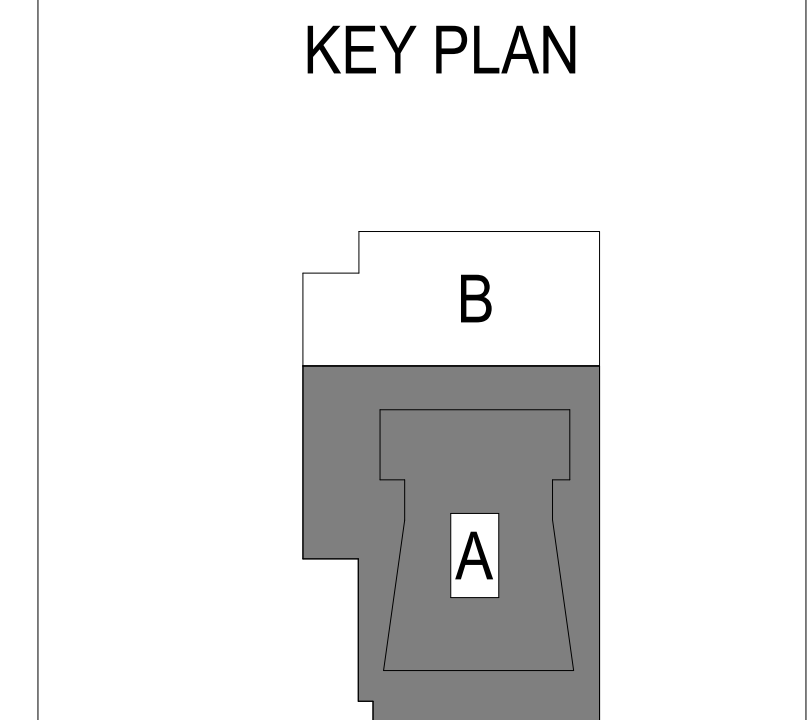

LEVEL 02 MEZZANINE - AREA A - SPECIAL SYSTEMS PLAN

E3.2A

Autodesk Docs://99-23712-00_Crandall ISD - PAC/39-23712-00_Crandall ISD_EL_2024.rvt
8/20/2024 2:29:35 PM



LEVEL 02 MEZZANINE - AREA A - SPECIAL SYSTEMS PLAN
SCALE: 1/8" = 1'-0"

D L R GROUP
© D L R Group

CRANDALL ISD HIGH SCHOOL
PAC ADDITION
13385 Fm 3039, Crandall, TX 75114




ISSUE FOR BID AND PERMIT
2024.08.19
REVISIONS
A00-1 8824

39-23712-00
LEVEL 02 MEZZANINE - AREA A - SPECIAL SYSTEMS PLAN

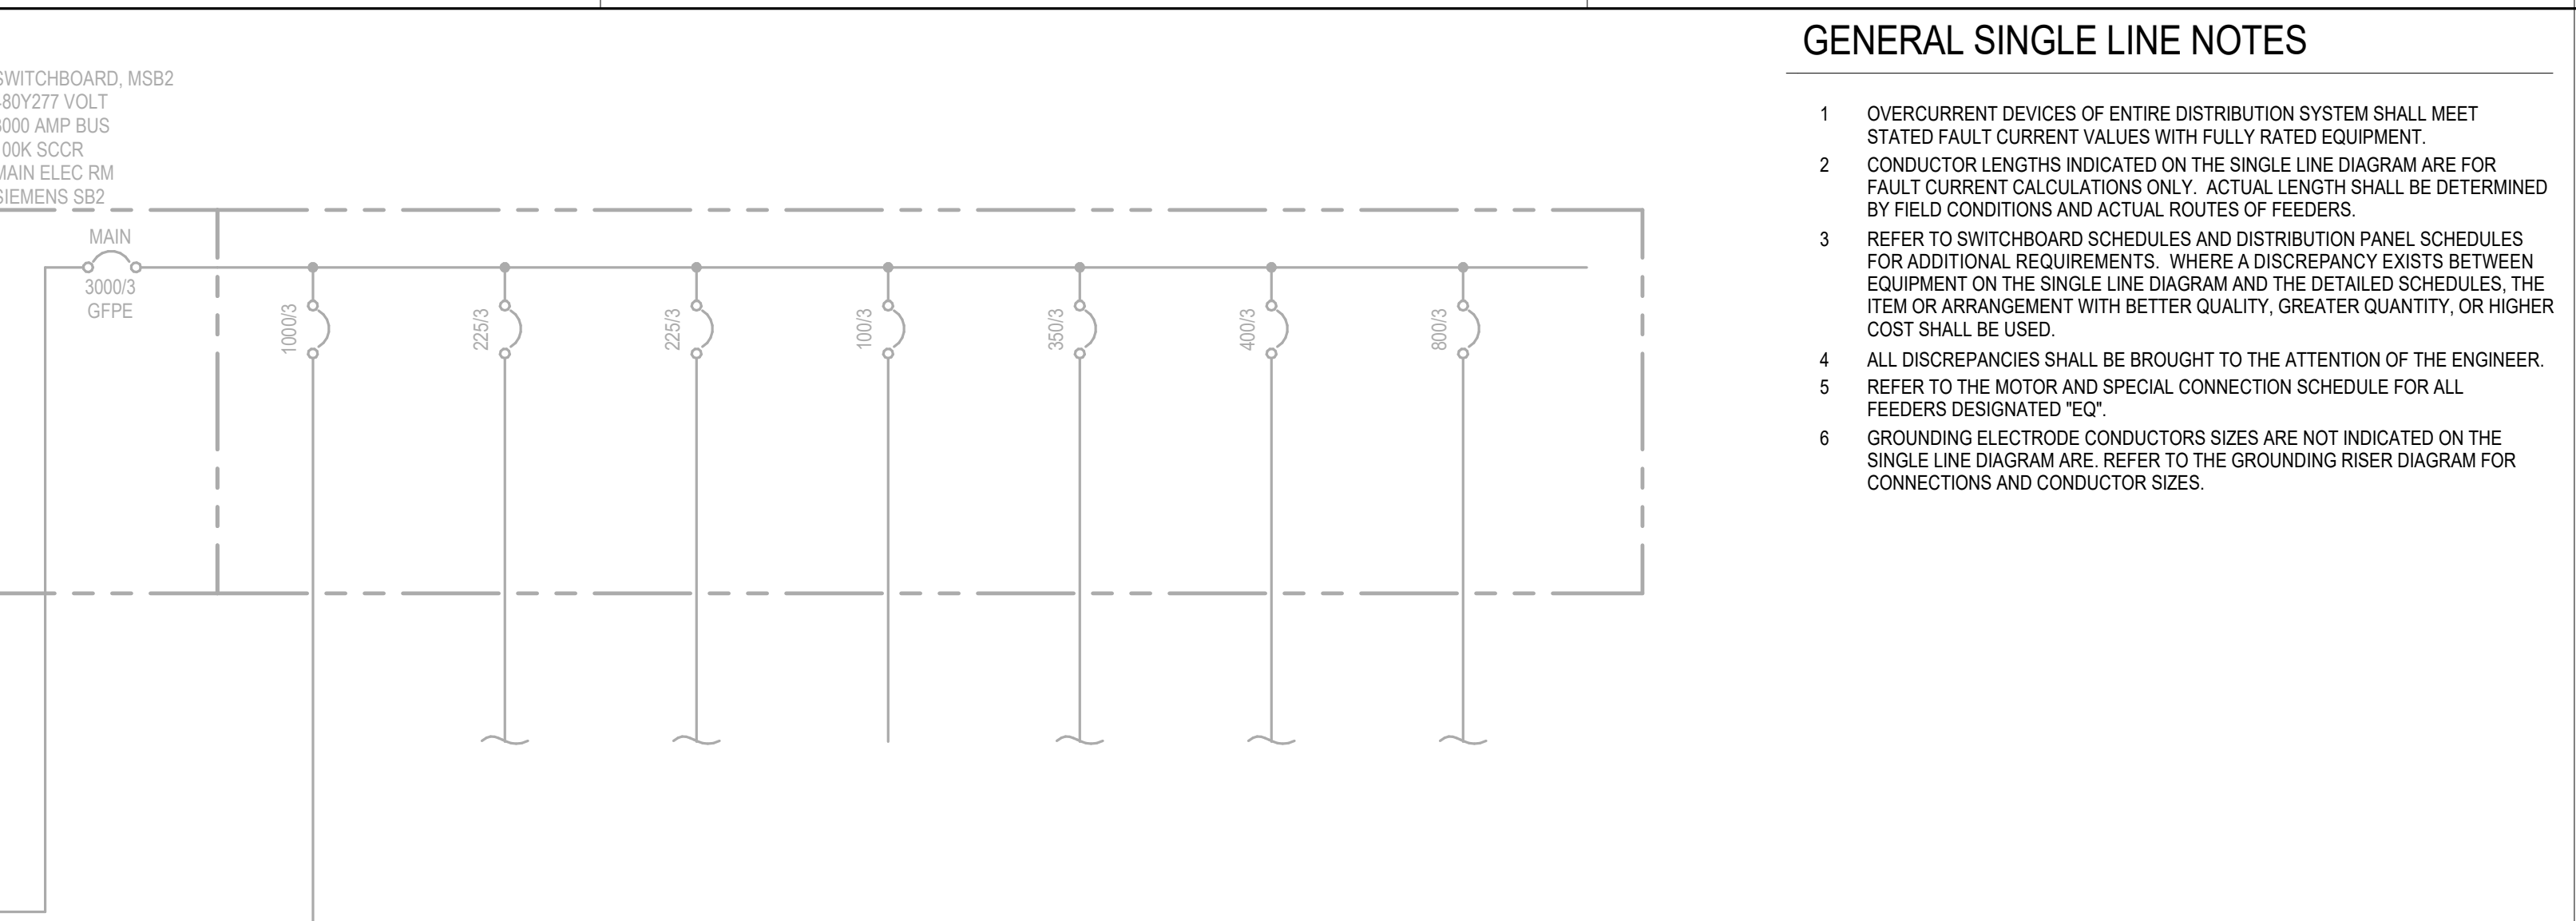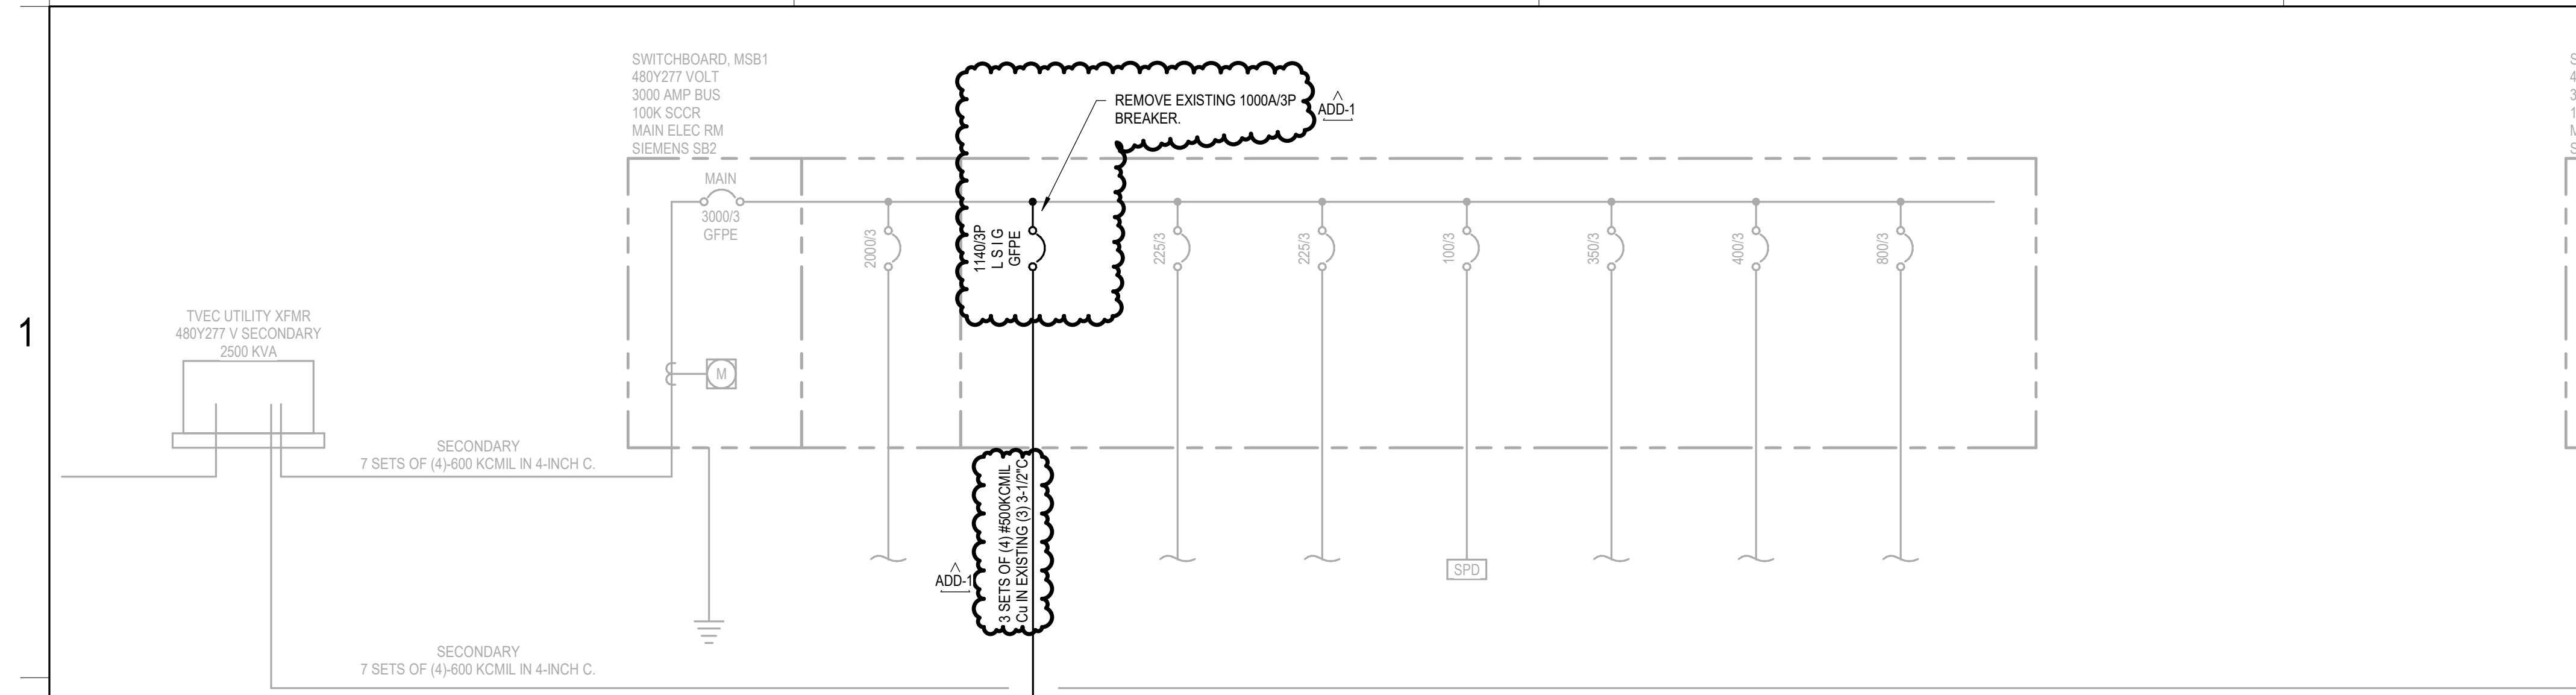

GENERAL SINGLE LINE NOTES

- OVERCURRENT DEVICES OF ENTIRE DISTRIBUTION SYSTEM SHALL MEET STATED FAULT CURRENT VALUES WITH FULLY RATED EQUIPMENT.
- CONDUCTOR LENGTHS INDICATED ON THE SINGLE LINE DIAGRAM ARE FOR FAULT CURRENT CALCULATIONS ONLY. ACTUAL LENGTH SHALL BE DETERMINED BY FIELD CONDITIONS AND ACTUAL ROUTES OF FEEDERS.
- REFER TO SWITCHBOARD SCHEDULES AND DISTRIBUTION PANEL SCHEDULES FOR ADDITIONAL REQUIREMENTS. WHERE A DISCREPANCY EXISTS BETWEEN EQUIPMENT ON THE SINGLE LINE DIAGRAM AND THE DETAILED SCHEDULES, THE ITEM OR SPECIFICATION WITH BETTER QUALITY, GREATER QUANTITY, OR HIGHER COST SHALL BE USED.
- ALL DISCREPANCIES SHALL BE BROUGHT TO THE ATTENTION OF THE ENGINEER.
- REFER TO THE MOTOR AND SPECIAL CONNECTION SCHEDULE FOR ALL FEEDERS DESIGNATED 'EQ'.
- GROUNDING ELECTRODE CONDUCTOR SIZES ARE NOT INDICATED ON THE SINGLE LINE DIAGRAM ARE. REFER TO THE GROUNDING RISER DIAGRAM FOR CONNECTIONS AND CONDUCTOR SIZES.

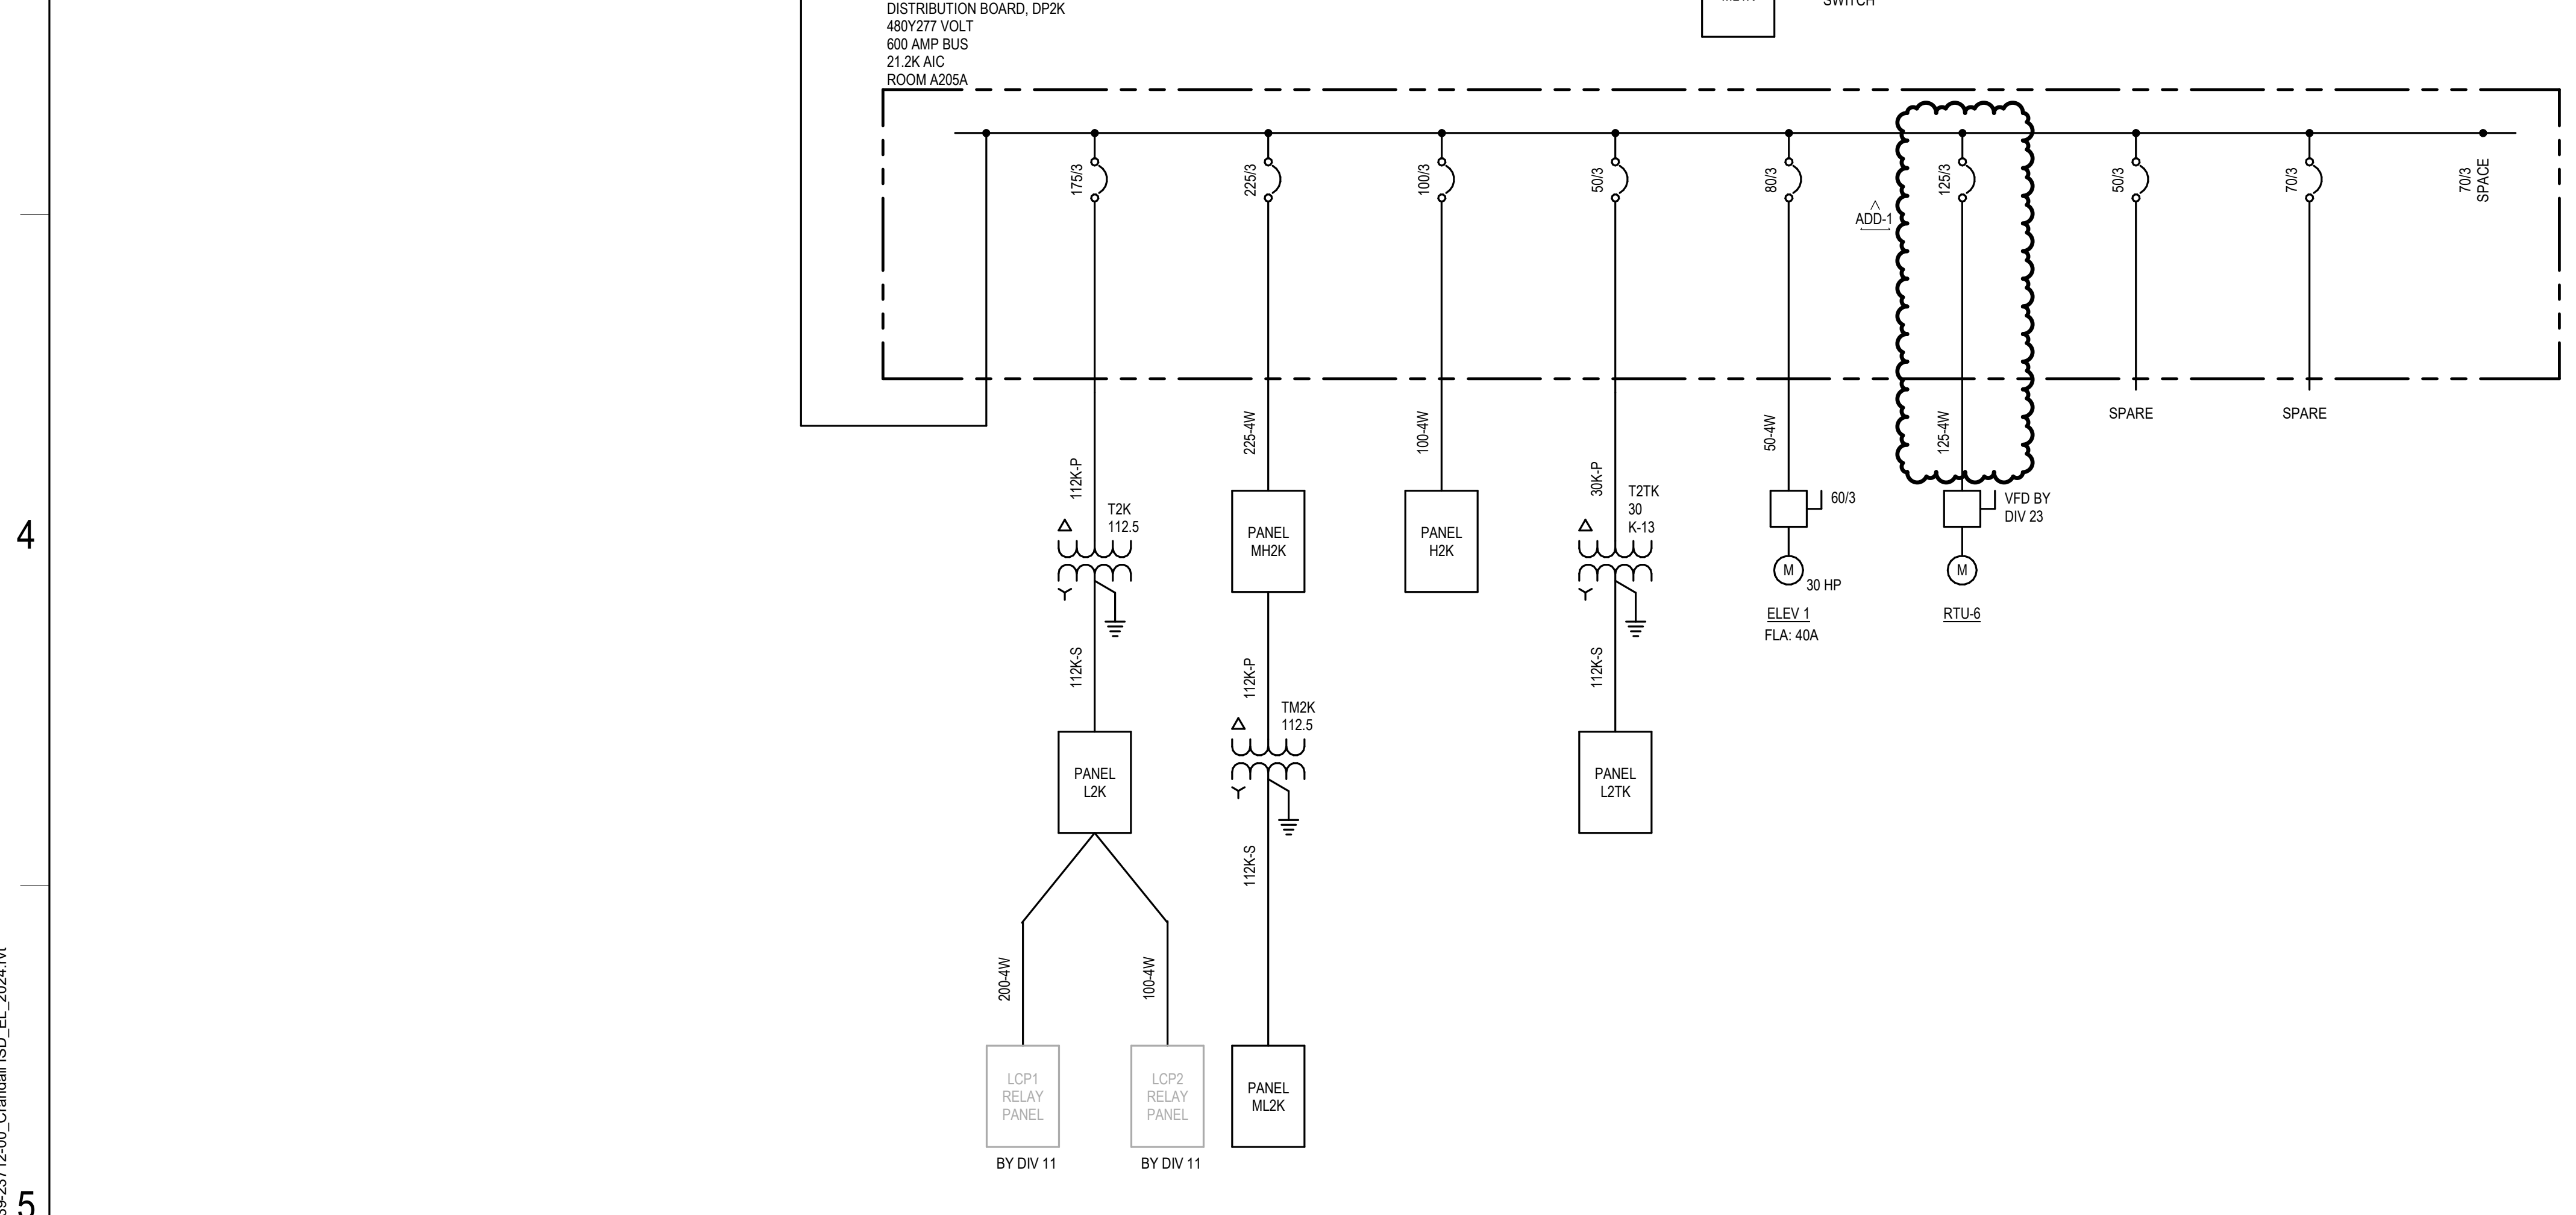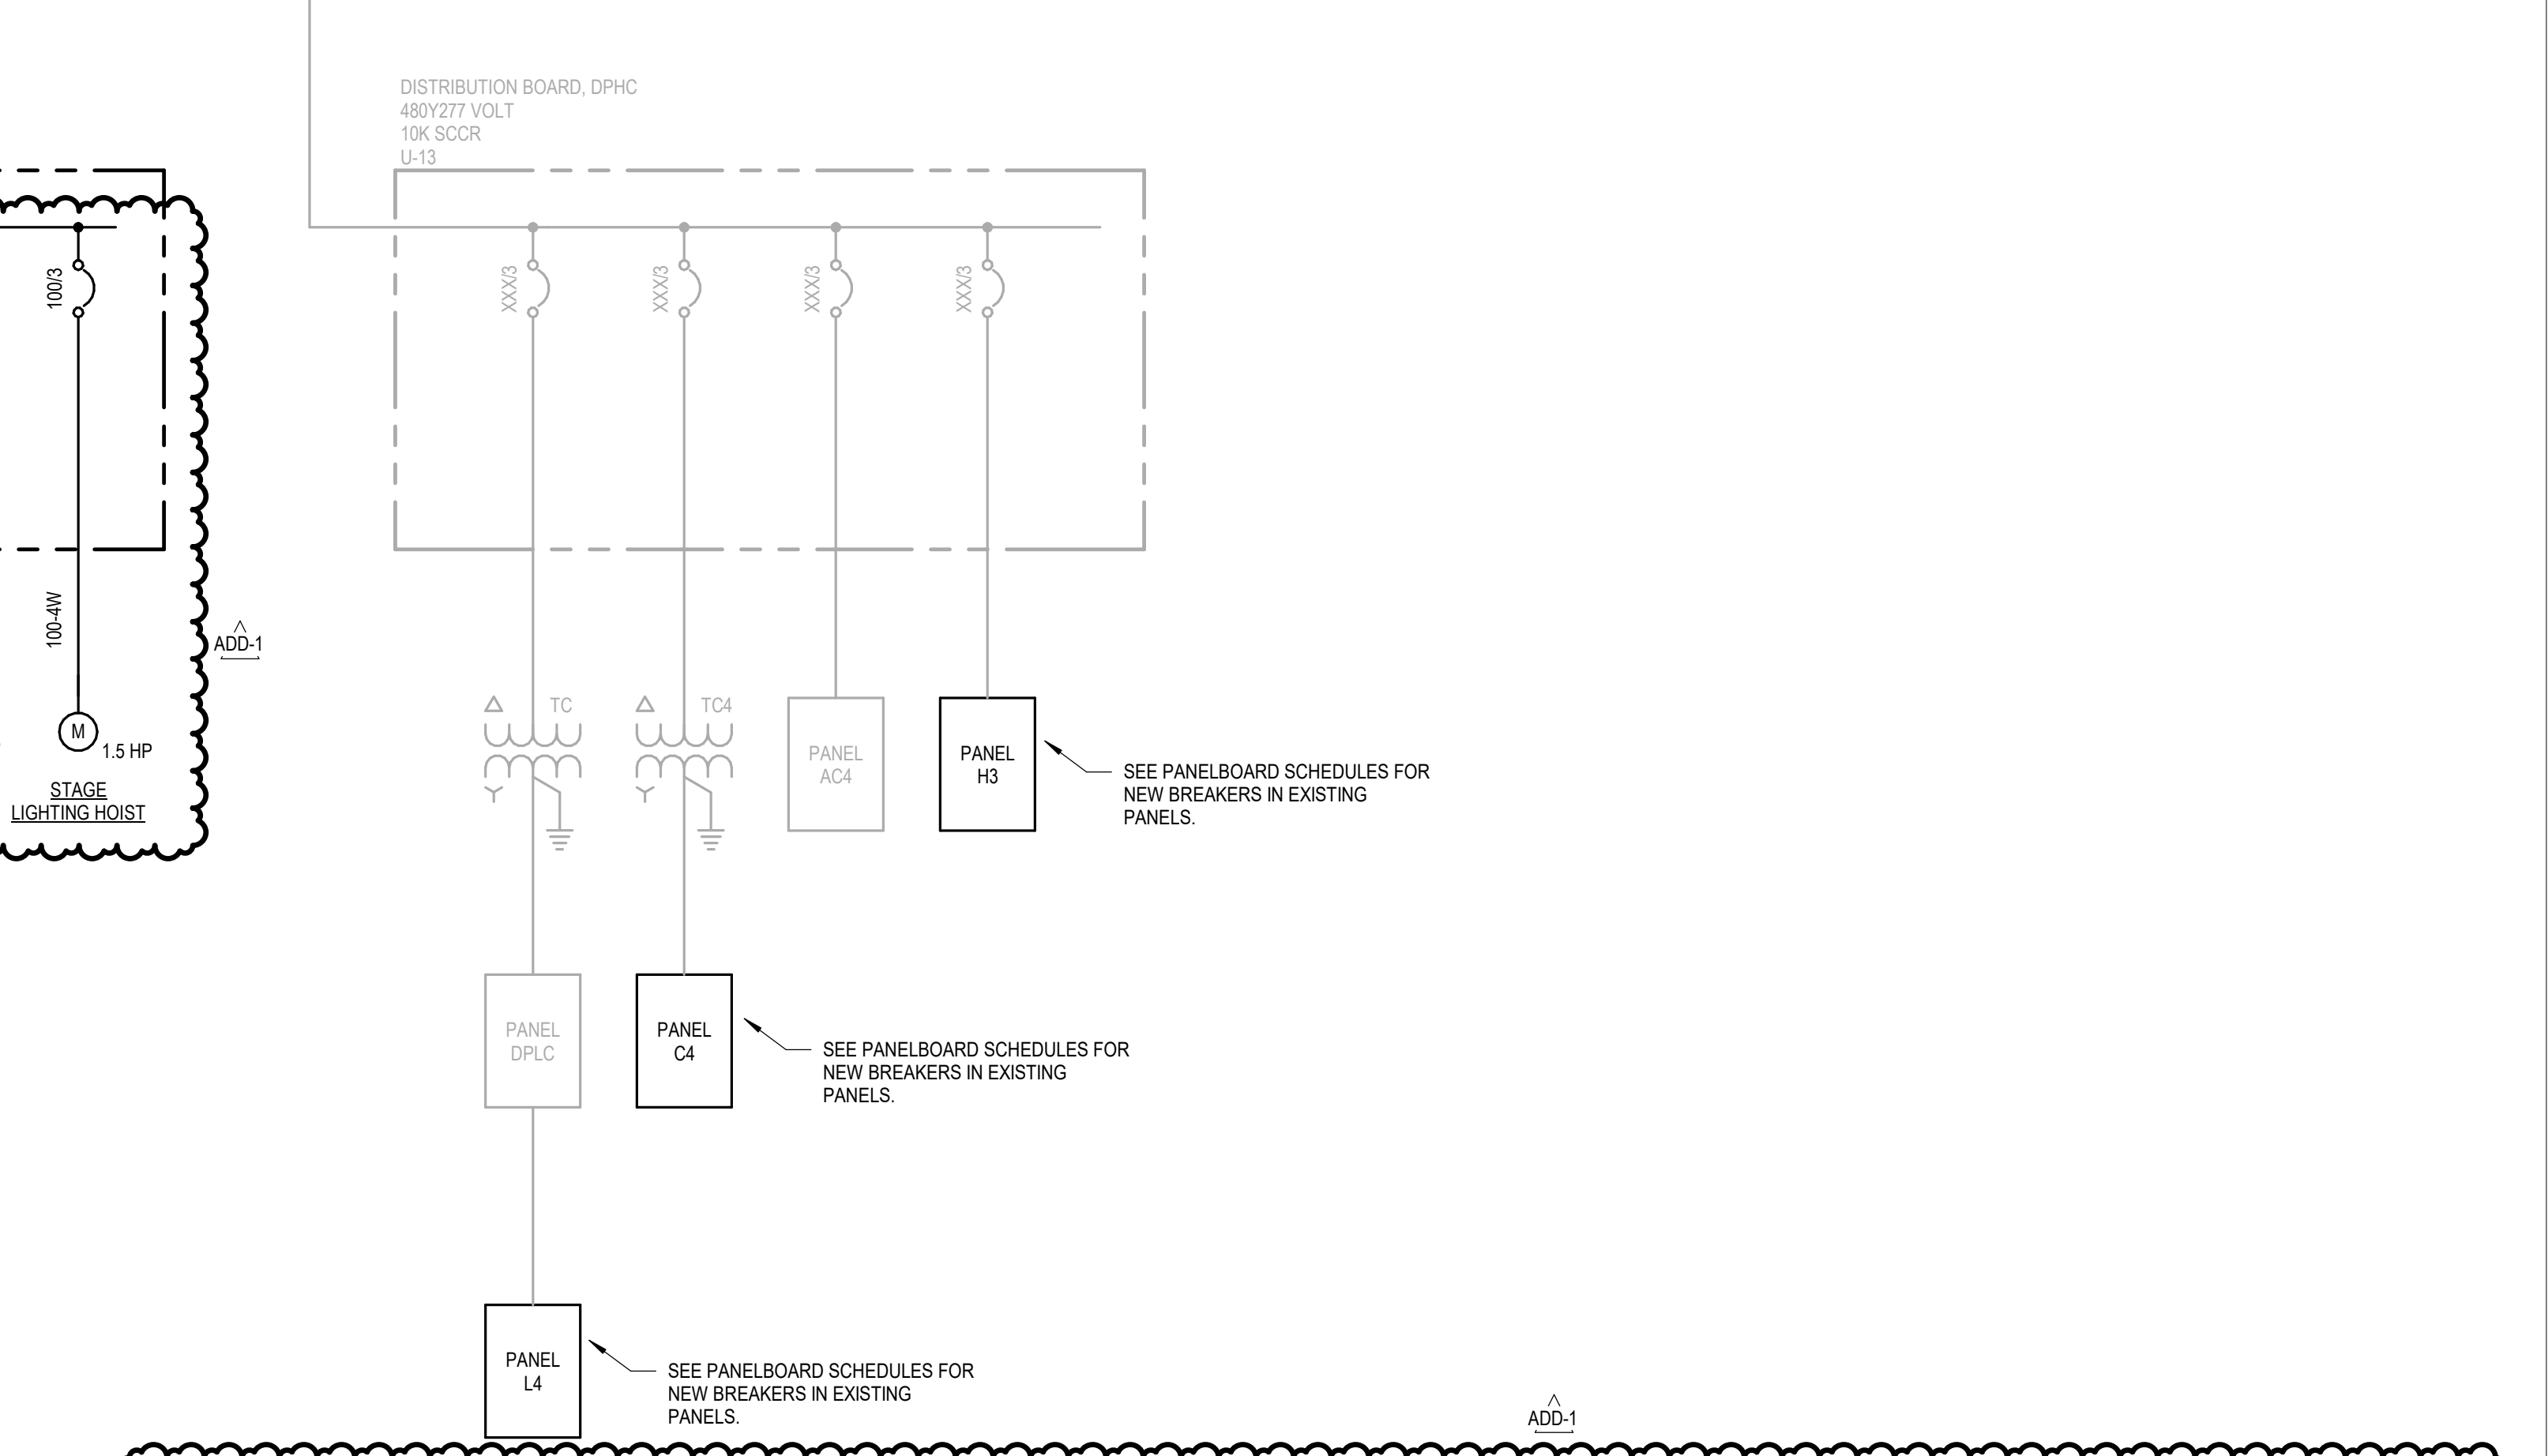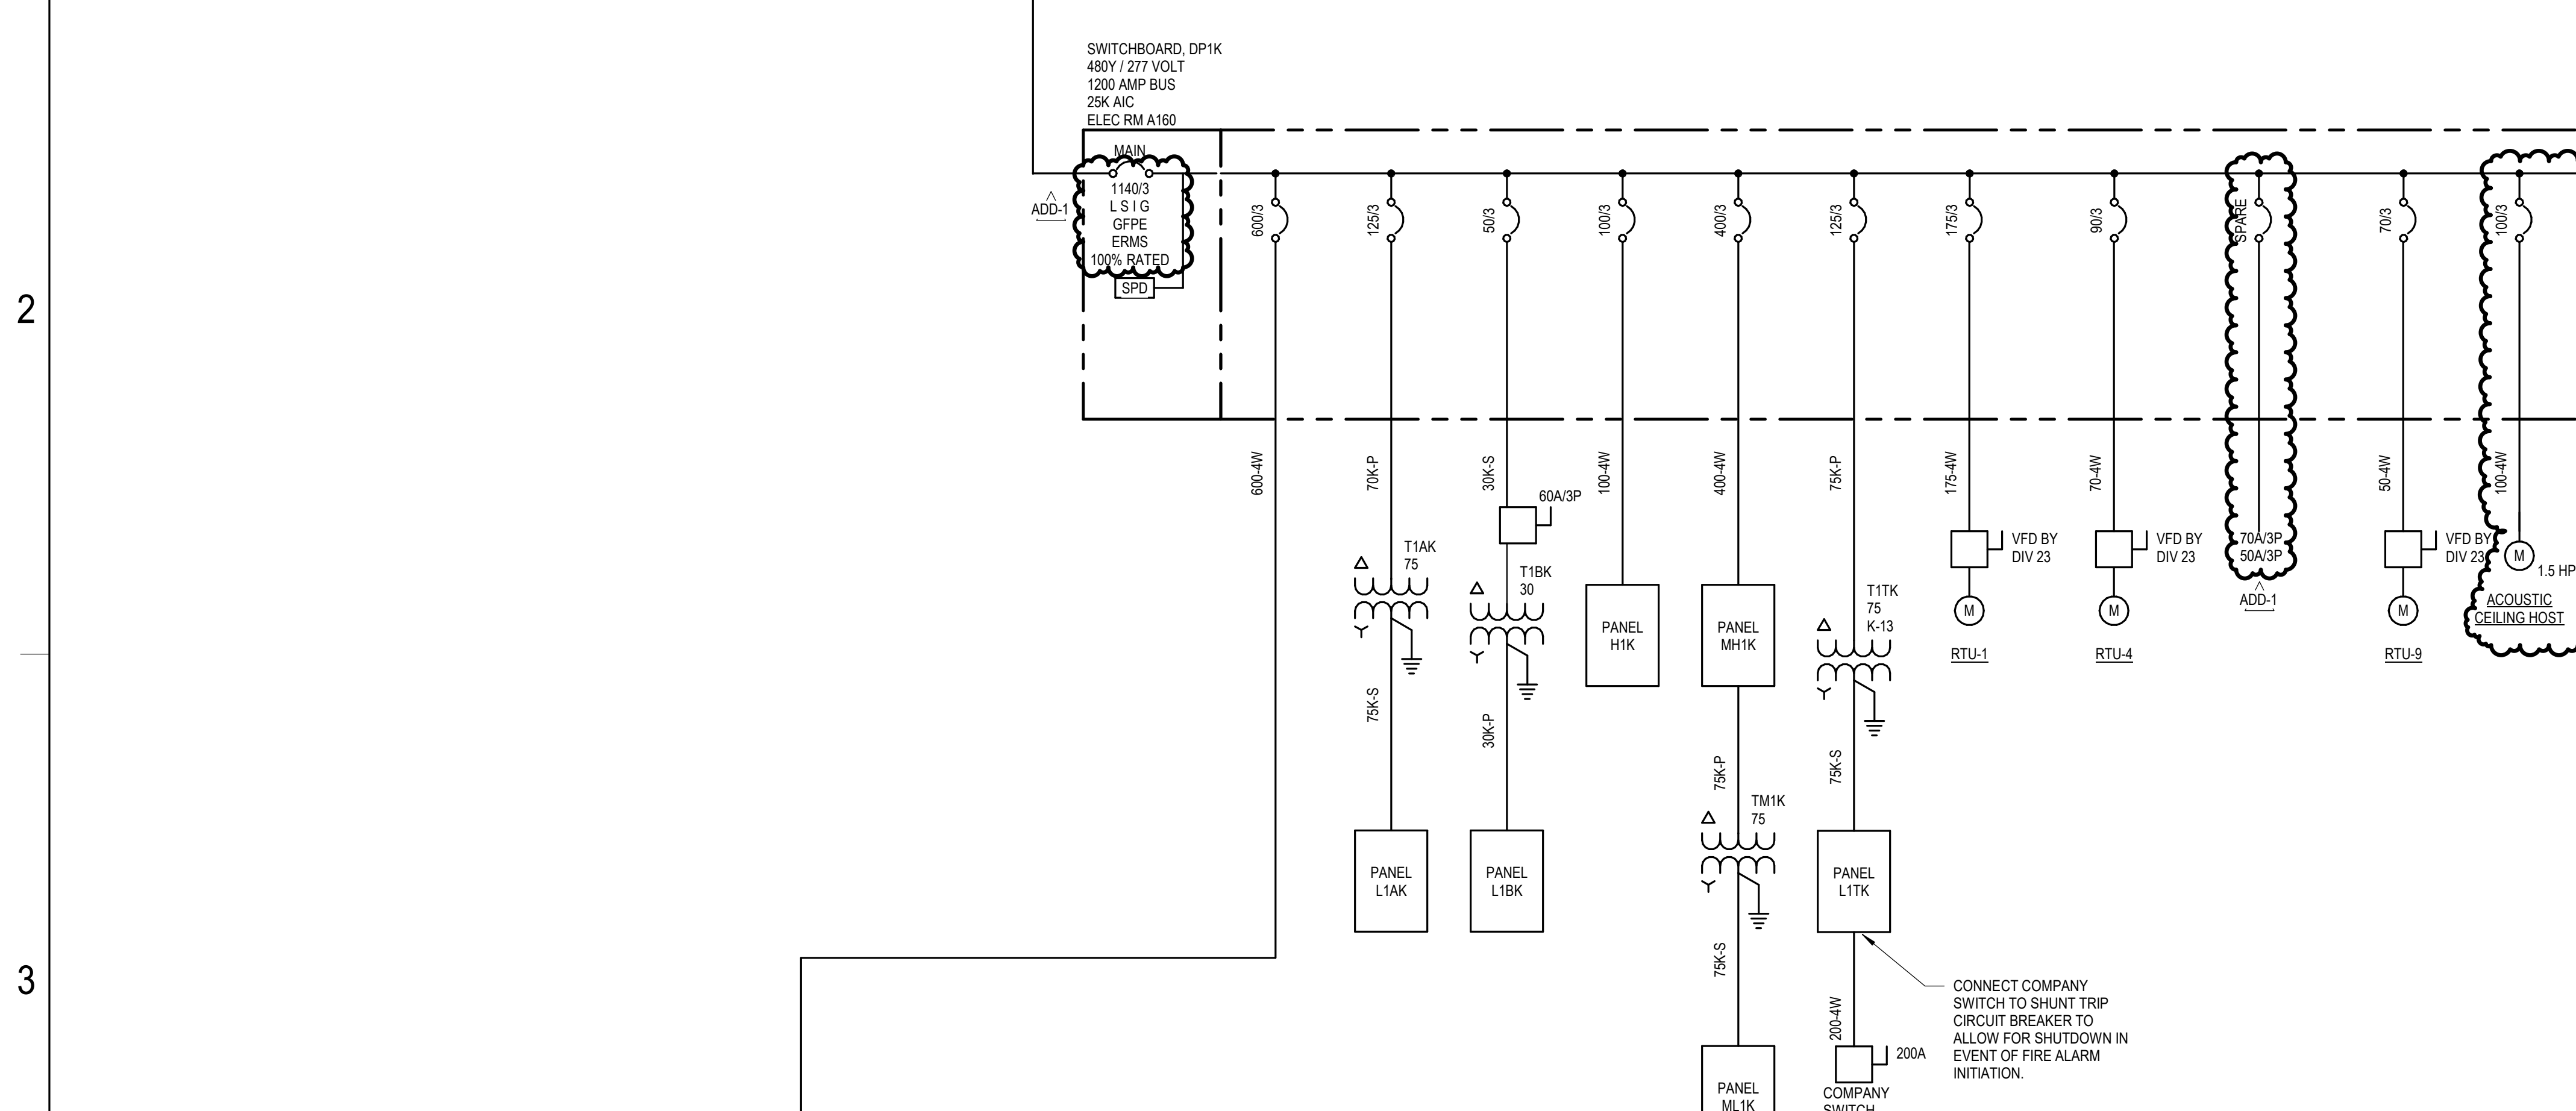

FEEDER SCHEDULE - COPPER

| MARK (AMPS) | # SETS | Ø N | GND | CONDUIT SIZE | | |
|-------------|--------|-----|-----|--------------|--------|--------|
| | | | | -4W | -3W | -2W |
| 15 | 1 | 12 | 12 | 3/4" | 3/4" | 3/4" |
| 20 | 1 | 12 | 12 | 3/4" | 3/4" | 3/4" |
| 25 | 1 | 10 | 10 | 3/4" | 3/4" | 3/4" |
| 30 | 1 | 10 | 10 | 3/4" | 3/4" | 3/4" |
| 35 | 1 | 8 | 10 | 3/4" | 3/4" | 3/4" |
| 40 | 1 | 8 | 10 | 3/4" | 3/4" | 3/4" |
| 45 | 1 | 6 | 10 | 1" | 1" | 3/4" |
| 50 | 1 | 6 | 10 | 1" | 1" | 3/4" |
| 60 | 1 | 4 | 10 | 1-1/4" | 1" | 3/4" |
| 70 | 1 | 4 | 8 | 1-1/4" | 1" | 3/4" |
| 80 | 1 | 3 | 8 | 1-1/4" | 1-1/4" | 1" |
| 90 | 1 | 2 | 8 | 1-1/4" | 1-1/4" | 1" |
| 100 | 1 | 1 | 8 | 1-1/2" | 1-1/2" | 1-1/4" |
| 110 | 1 | 1 | 6 | 1-1/2" | 1-1/2" | 1-1/4" |
| 125 | 1 | 1 | 6 | 1-1/2" | 1-1/2" | 1-1/4" |
| 150 | 1 | 1/0 | 6 | 2" | 2" | 1-1/2" |
| 175 | 1 | 2/0 | 6 | 2" | 2" | 1-1/2" |
| 200 | 1 | 3/0 | 6 | 2" | 2" | 1-1/2" |
| 225 | 1 | 4/0 | 4 | 2-1/2" | 2" | 1-1/2" |
| 250 | 1 | 250 | 4 | 2-1/2" | 2" | 1-1/2" |
| 300 | 1 | 350 | 4 | 3" | 2-1/2" | 2" |
| 350 | 1 | 500 | 3 | 3-1/2" | 3" | 2-1/2" |
| 400 | 1 | 600 | 3 | 3-1/2" | 3" | 2-1/2" |
| 400 | 2 | 3/0 | 3 | 2" | 2" | 1-1/2" |
| 450 | 2 | 4/0 | 2 | 2-1/2" | 2" | 1-1/2" |
| 500 | 2 | 250 | 2 | 2-1/2" | 2-1/2" | 2" |
| 600 | 2 | 350 | 1 | 3" | 2-1/2" | 2" |
| 700 | 2 | 500 | 1/0 | 3-1/2" | 3" | 2-1/2" |
| 800 | 2 | 600 | 1/0 | 3-1/2" | 3" | 2-1/2" |
| 1000 | 3 | 400 | 2/0 | 3" | 3" | 2-1/2" |
| 1200 | 3 | 600 | 3/0 | 3-1/2" | 3-1/2" | 3" |
| 1600 | 4 | 600 | 4/0 | 3-1/2" | 3-1/2" | 3" |
| 2000 | 5 | 600 | 250 | 4" | 3-1/2" | 3" |
| 2500 | 6 | 600 | 350 | 4" | 3-1/2" | 3" |
| 3000 | 8 | 500 | 400 | 3-1/2" | 3" | 2-1/2" |
| 4000 | 10 | 600 | 500 | 4" | 3-1/2" | 3" |

ABBREVIATIONS:
Ø PHASE
N NEUTRAL
GND EQUIPMENT GROUNDING CONDUCTOR
-4W FOUR WIRE + GROUND (3Ø N, GND)
-3W THREE WIRE + GROUND (3Ø GND or 2Ø N, GND)
-2W TWO WIRE + GROUND

NOTES:
1. CONDUCTOR AMPACITIES ARE BASED ON NEC TABLE 310.15(B)(16).
2. CONDUIT SIZES ARE BASED ON A MAXIMUM FILL RATIO OF 40%.
3. SCHEDULE SHALL BE USED FOR FEEDERS AND BRANCH CIRCUITS WHERE APPLICABLE.
4. ALL FEEDERS AND BRANCH CIRCUITS SHALL INCLUDE AN EQUIPMENT GROUNDING CONDUCTOR. SCHEDULE IS VALID FOR TYPE THHN, THWN-2, AND XHHW-2 CONDUCTORS. SEE SPECIFICATIONS FOR CONDUCTOR TYPES REQUIRED.
5. SCHEDULE IS VALID FOR TYPE EMT, IMC, FMC, LFMC, HDPE, AND RNC-40 RACEWAYS. SEE SPECIFICATIONS FOR RACEWAY APPLICATIONS.
6. SCHEDULE IS VALID FOR TYPE THHN, THWN-2, AND XHHW-2 CONDUCTORS. SEE SPECIFICATIONS FOR CONDUCTOR TYPES REQUIRED.
7. USE A COPPER GROUNDING CONDUCTOR FOR THE 4000 AMP FEEDER AS LISTED ABOVE.
8. NOT ALL SIZES USED.

FEEDER SCHEDULE - ALUMINUM

| MARK (AMPS) | # SETS | Ø N | GND | CONDUIT SIZE | | |
|-------------|--------|-----|--------|--------------|--------|--------|
| | | | | -4W | -3W | -2W |
| 15 | 1 | 12 | 12 | 3/4" | 3/4" | 3/4" |
| 20 | 1 | 12 | 12 | 3/4" | 3/4" | 3/4" |
| 25 | 1 | 10 | 10 | 3/4" | 3/4" | 3/4" |
| 30 | 1 | 10 | 10 | 3/4" | 3/4" | 3/4" |
| 35 | 1 | 8 | 10 | 3/4" | 3/4" | 3/4" |
| 40 | 1 | 8 | 10 | 3/4" | 3/4" | 3/4" |
| 45 | 1 | 6 | 10 | 1" | 1" | 3/4" |
| 50 | 1 | 6 | 10 | 1" | 1" | 3/4" |
| 60 | 1 | 4 | 10 | 1-1/4" | 1" | 3/4" |
| 70 | 1 | 4 | 8 | 1-1/4" | 1" | 3/4" |
| 80 | 1 | 3 | 8 | 1-1/4" | 1-1/4" | 1" |
| 90 | 1 | 2 | 8 | 1-1/4" | 1-1/4" | 1" |
| 100 | 1 | 1 | 8 | 1-1/2" | 1-1/2" | 1-1/4" |
| 110 | 1 | 1 | 6 | 1-1/2" | 1-1/2" | 1-1/4" |
| 125 | 1 | 1 | 6 | 1-1/2" | 1-1/2" | 1-1/4" |
| 150 | 1 | 1/0 | 6 | 2" | 2" | 1-1/2" |
| 175 | 1 | 2/0 | 6 | 2" | 2" | 1-1/2" |
| 200 | 1 | 3/0 | 6 | 2" | 2" | 1-1/2" |
| 225 | 1 | 4/0 | 4 | 2-1/2" | 2" | 1-1/2" |
| 250 | 1 | 250 | 4 | 2-1/2" | 2" | 1-1/2" |
| 300 | 1 | 350 | 4 | 3" | 2-1/2" | 2" |
| 350 | 1 | 500 | 3 | 3-1/2" | 3" | 2-1/2" |
| 400 | 1 | 600 | 3 | 3-1/2" | 3" | 2-1/2" |
| 400 | 2 | 3/0 | 3 | 2" | 2" | 1-1/2" |
| 450 | 2 | 4/0 | 2 | 2-1/2" | 2" | 1-1/2" |
| 500 | 2 | 250 | 2 | 2-1/2" | 2-1/2" | 2" |
| 600 | 2 | 350 | 1 | 3" | 2-1/2" | 2" |
| 700 | 2 | 500 | 1/0 | 3-1/2" | 3" | 2-1/2" |
| 800 | 2 | 600 | 1/0 | 3-1/2" | 3" | 2-1/2" |
| 1000 | 3 | 400 | 2/0 | 3" | 3" | 2-1/2" |
| 1200 | 3 | 600 | 3/0 | 3-1/2" | 3-1/2" | 3" |
| 1600 | 4 | 600 | 4/0 | 3-1/2" | 3-1/2" | 3" |
| 2000 | 5 | 600 | 250 | 4" | 3-1/2" | 3" |
| 2500 | 6 | 600 | 350 | 4" | 3-1/2" | 3" |
| 3000 | 8 | 500 | 400 | 3-1/2" | 3" | 2-1/2" |
| 4000 | 11 | 750 | 500 cu | 4" | 4" | 3-1/2" |

ABBREVIATIONS:
Ø PHASE
N NEUTRAL
GND EQUIPMENT GROUNDING CONDUCTOR
-4W FOUR WIRE + GROUND (3Ø N, GND)
-3W THREE WIRE + GROUND (3Ø GND or 2Ø N, GND)
-2W TWO WIRE + GROUND

NOTES:
1. CONDUCTOR AMPACITIES ARE BASED ON NEC TABLE 310.15(B)(16).
2. CONDUIT SIZES ARE BASED ON A MAXIMUM FILL RATIO OF 40%.
3. SCHEDULE SHALL BE USED FOR FEEDERS AND BRANCH CIRCUITS WHERE APPLICABLE.
4. ALL FEEDERS AND BRANCH CIRCUITS SHALL INCLUDE AN EQUIPMENT GROUNDING CONDUCTOR. SCHEDULE IS VALID FOR TYPE THHN, THWN-2, AND XHHW-2 CONDUCTORS. SEE SPECIFICATIONS FOR CONDUCTOR TYPES REQUIRED.
5. SCHEDULE IS VALID FOR TYPE EMT, IMC, FMC, LFMC, HDPE, AND RNC-40 RACEWAYS. SEE SPECIFICATIONS FOR RACEWAY APPLICATIONS.
6. SCHEDULE IS VALID FOR TYPE THHN, THWN-2, AND XHHW-2 CONDUCTORS. SEE SPECIFICATIONS FOR CONDUCTOR TYPES REQUIRED.
7. USE A COPPER GROUNDING CONDUCTOR FOR THE 4000 AMP FEEDER AS LISTED ABOVE.
8. NOT ALL SIZES USED.

3-PHASE TRANSFORMER PRIMARY AND SECONDARY SCHEDULE - COPPER

| XFMR KVA | MARK | PRIMARY | | | SECONDARY | | | | | | | | | |
|----------|--------|---------|--------|-----|-----------|--------|--------|------|--------|-----|-----|----|--------|--------|
| | | AMPS | # SETS | Ø | GND | C | MARK | AMPS | # SETS | Ø | N | BJ | C | |
| 15 | 15K-P | 25 | 1 | 10 | 10 | 3/4" | 15K-S | 50 | 1 | 10 | 1 | 6 | 8 | 1-1/2" |
| 30 | 30K-P | 50 | 1 | 6 | 10 | 3/4" | 30K-S | 100 | 1 | 1 | 1 | 6 | 1-1/2" | |
| 45 | 45K-P | 70 | 1 | 4 | 8 | 1" | 45K-S | 150 | 1 | 1 | 10 | 6 | 2" | |
| 75 | 75K-P | 150 | 1 | 1/0 | 6 | 1-1/2" | 75K-S | 225 | 1 | 400 | 2 | 2 | 2-1/2" | |
| 112.5 | 112K-P | 175 | 1 | 2/0 | 6 | 1-1/2" | 112K-S | 350 | 1 | 500 | 1/0 | 3 | 3-1/2" | |
| 150 | 150K-P | 250 | 1 | 250 | 4 | 2" | 150K-S | 500 | 2 | 250 | 1/0 | 2 | 2-1/2" | |
| 225 | 225K-P | 350 | 1 | 500 | 3 | 3" | 225K-S | 700 | 2 | 500 | 2/0 | 2 | 3-1/2" | |
| 300 | 300K-P | 500 | 2 | 250 | 2 | 2-1/2" | 300K-S | 1000 | 3 | 400 | 3/0 | 3" | | |

ABBREVIATIONS:
Ø PHASE
BJ BONDING JUMPER
C CONDUIT SIZE
N NEUTRAL
GND EQUIPMENT GROUNDING CONDUCTOR
-P PRIMARY - THREE WIRE + GROUND (3Ø GND)
-S SECONDARY - FOUR WIRE + BONDING JUMPER (3Ø, N, BJ)

NOTES:
1. CONDUCTOR AMPACITIES ARE BASED ON NEC TABLE 310.15(B)(16).
2. CONDUIT SIZES ARE BASED ON A MAXIMUM FILL RATIO OF 40%.
3. SCHEDULE SHALL BE USED FOR TRANSFORMERS WITH THE FOLLOWING CONFIGURATION: 480 V DELTA PRIMARY AND 208Y/120 V SECONDARY.
4. ALL FEEDERS TO TRANSFORMERS SHALL INCLUDE AN EQUIPMENT GROUNDING CONDUCTOR. SCHEDULE IS VALID FOR TYPE THHN, THWN-2, AND XHHW-2 CONDUCTORS. SEE SPECIFICATIONS FOR CONDUCTOR TYPES REQUIRED.
5. SCHEDULE IS VALID FOR TYPE EMT, IMC, FMC, LFMC, HDPE, AND RNC-40 RACEWAYS. SEE SPECIFICATIONS FOR RACEWAY APPLICATIONS.
6. SCHEDULE IS VALID FOR TYPE THHN, THWN-2, AND XHHW-2 CONDUCTORS. SEE SPECIFICATIONS FOR CONDUCTOR TYPES REQUIRED.
7. NOT ALL SIZES USED.

3-PHASE TRANSFORMER PRIMARY AND SECONDARY SCHEDULE - ALUMINUM

| XFMR KVA | MARK | PRIMARY | | | SECONDARY | | | | | | | | | |
|----------|--------|---------|--------|-----|-----------|--------|--------|------|--------|-----|-----|----|--------|--------|
| | | AMPS | # SETS | Ø | GND | C | MARK | AMPS | # SETS | Ø | N | BJ | C | |
| 15 | 15K-P | 25 | 1 | 10 | 10 | 3/4" | 15K-S | 50 | 1 | 10 | 1 | 6 | 8 | 1-1/2" |
| 30 | 30K-P | 50 | 1 | 6 | 10 | 3/4" | 30K-S | 100 | 1 | 1 | 1 | 6 | 1-1/2" | |
| 45 | 45K-P | 70 | 1 | 4 | 8 | 1" | 45K-S | 150 | 1 | 1 | 10 | 6 | 2" | |
| 75 | 75K-P | 150 | 1 | 1/0 | 6 | 1-1/2" | 75K-S | 225 | 1 | 300 | 4 | 2" | | |
| 112.5 | 112K-P | 175 | 1 | 2/0 | 6 | 1-1/2" | 112K-S | 350 | 1 | 500 | 1/0 | 3 | 3-1/2" | |
| 150 | 150K-P | 250 | 1 | 250 | 4 | 2" | 150K-S | 500 | 2 | 250 | 1/0 | 2 | 2-1/2" | |
| 225 | 225K-P | 350 | 1 | 500 | 3 | 3" | 225K-S | 700 | 2 | 500 | 2/0 | 2 | 3-1/2" | |
| 300 | 300K-P | 500 | 2 | 250 | 2 | 2-1/2" | 300K-S | 1000 | 3 | 400 | 3/0 | 3" | | |


ABBREVIATIONS:
Ø PHASE
BJ BONDING JUMPER
C CONDUIT SIZE
N NEUTRAL
GND EQUIPMENT GROUNDING CONDUCTOR
-P PRIMARY - THREE WIRE + GROUND (3Ø GND)
-S SECONDARY - FOUR WIRE + BONDING JUMPER (3Ø, N, BJ)

NOTES:
1. CONDUCTOR AMPACITIES ARE BASED ON NEC TABLE 310.15(B)(16).
2. CONDUIT SIZES ARE BASED ON A MAXIMUM FILL RATIO OF 40%.
3. SCHEDULE SHALL BE USED FOR TRANSFORMERS WITH THE FOLLOWING CONFIGURATION: 480 V DELTA PRIMARY AND 208Y/120 V SECONDARY.
4. ALL FEEDERS TO TRANSFORMERS SHALL INCLUDE AN EQUIPMENT GROUNDING CONDUCTOR. SCHEDULE IS VALID FOR TYPE THHN, THWN-2, AND XHHW-2 CONDUCTORS. SEE SPECIFICATIONS FOR CONDUCTOR TYPES REQUIRED.
5. SCHEDULE IS VALID FOR TYPE EMT, IMC, FMC, LFMC, HDPE, AND RNC-40 RACEWAYS. SEE SPECIFICATIONS FOR RACEWAY APPLICATIONS.
6. SCHEDULE IS VALID FOR TYPE THHN, THWN-2, AND XHHW-2 CONDUCTORS. SEE SPECIFICATIONS FOR CONDUCTOR TYPES REQUIRED.
7. NOT ALL SIZES USED.

ELECTRICAL ONE-LINE DIAGRAM

ES.1 NO SCALE

Audodesk Docs/195-23712-00_Crandall ISD - PAC239-23712-00_Crandall ISD_EL_2024.rvt 8/20/2024 2:29:36 PM

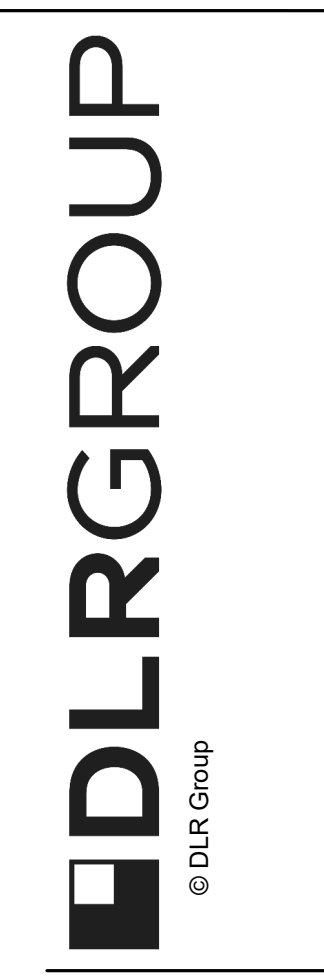


CRANDALL ISD HIGH SCHOOL
PAC ADDITION
13385 Fm 3036, Crandall, TX 75114


ISSUE FOR BID AND PERMIT
2024.08.19
REVISIONS
ADD-1 8924

39-23712-00
ELECTRICAL DIAGRAMS


E5.1

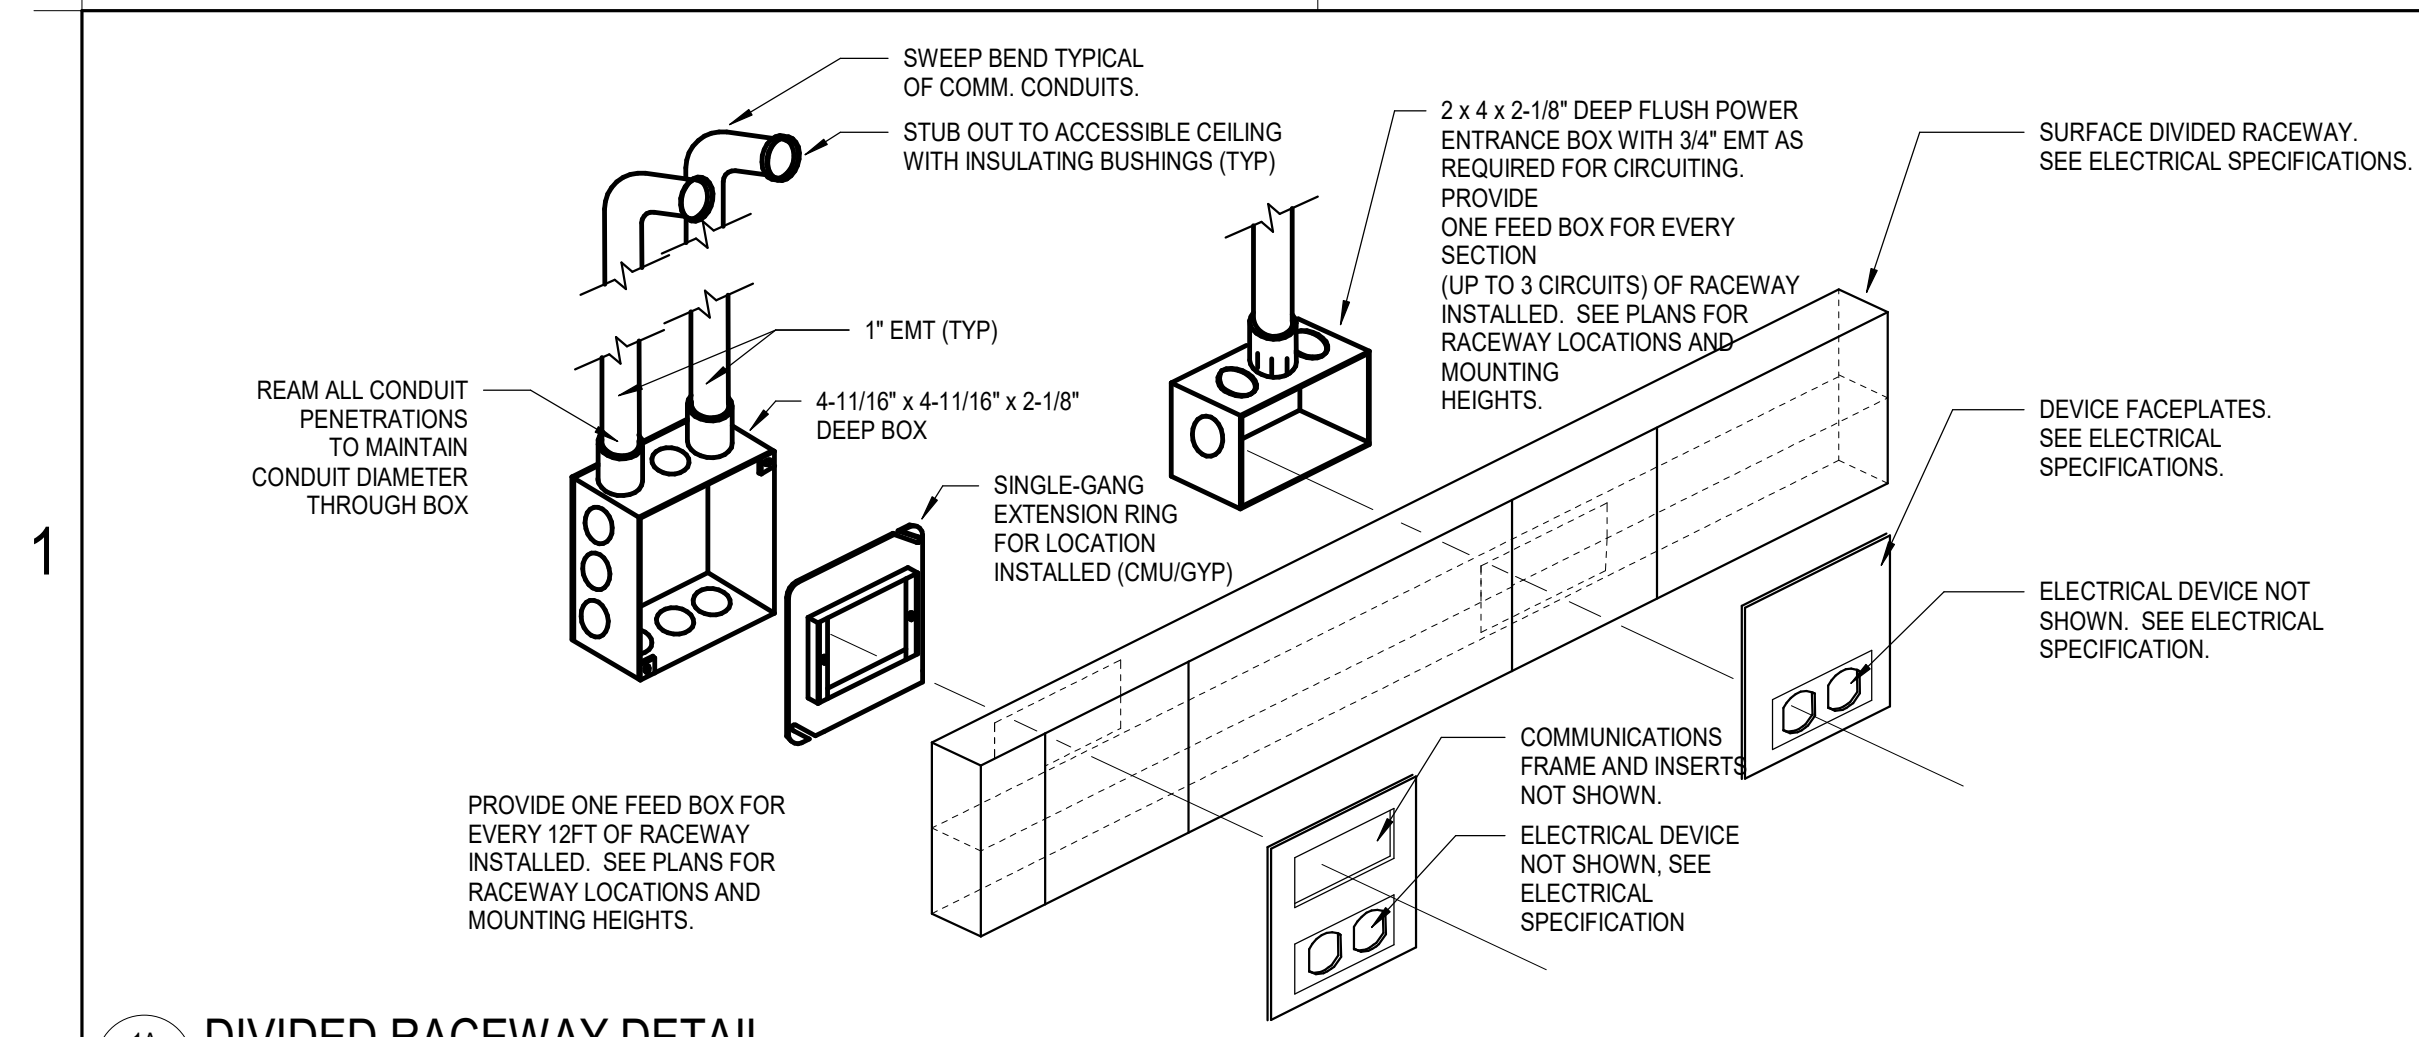


1A DIVIDED RACEWAY DETAIL
E6.2 NO SCALE

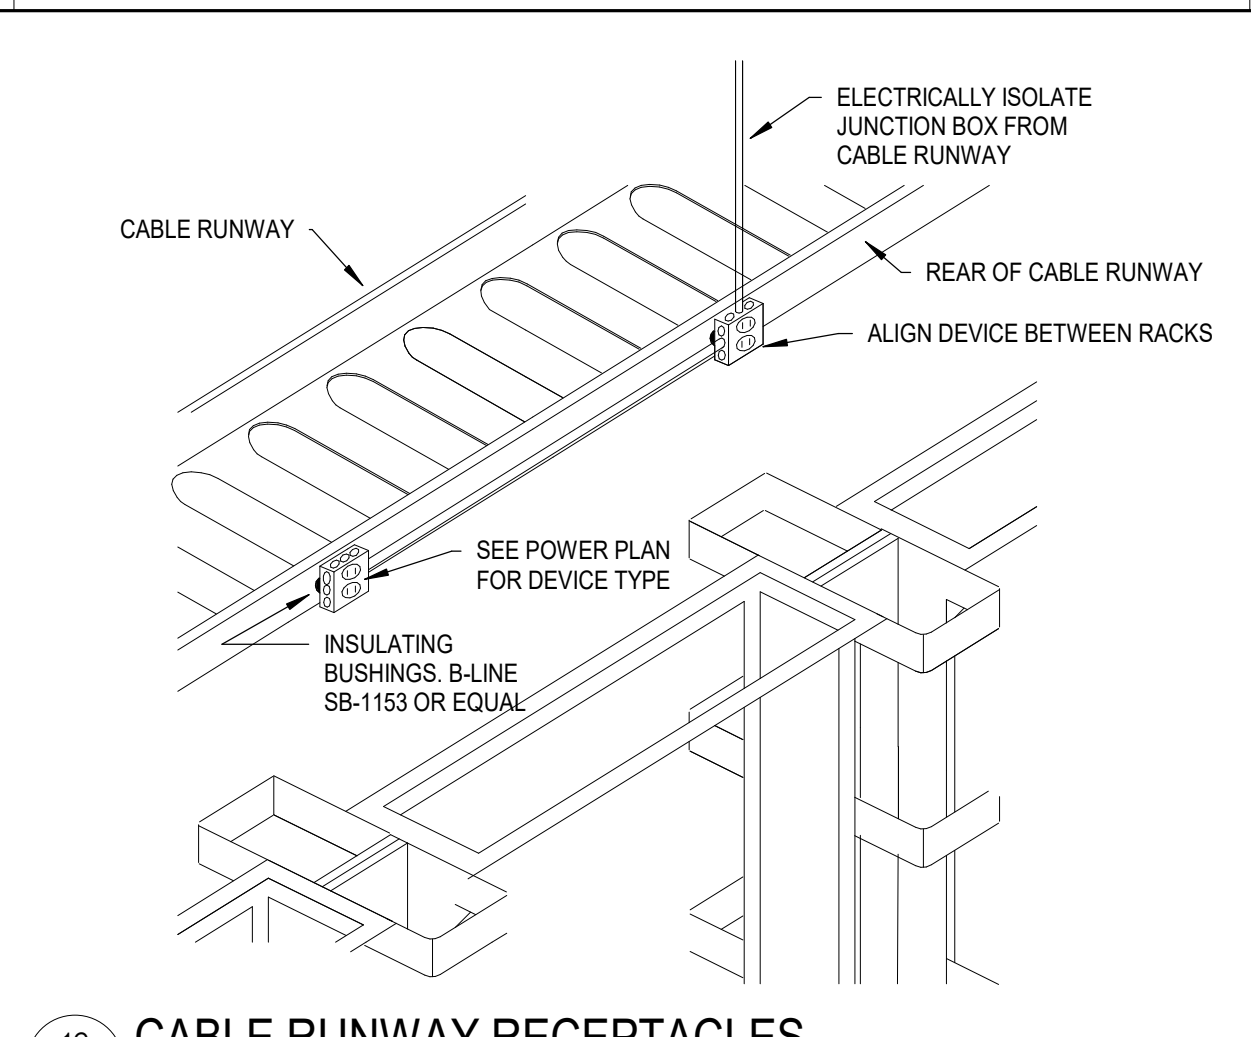

1C CABLE RUNWAY RECEPTACLES
E6.2 NO SCALE

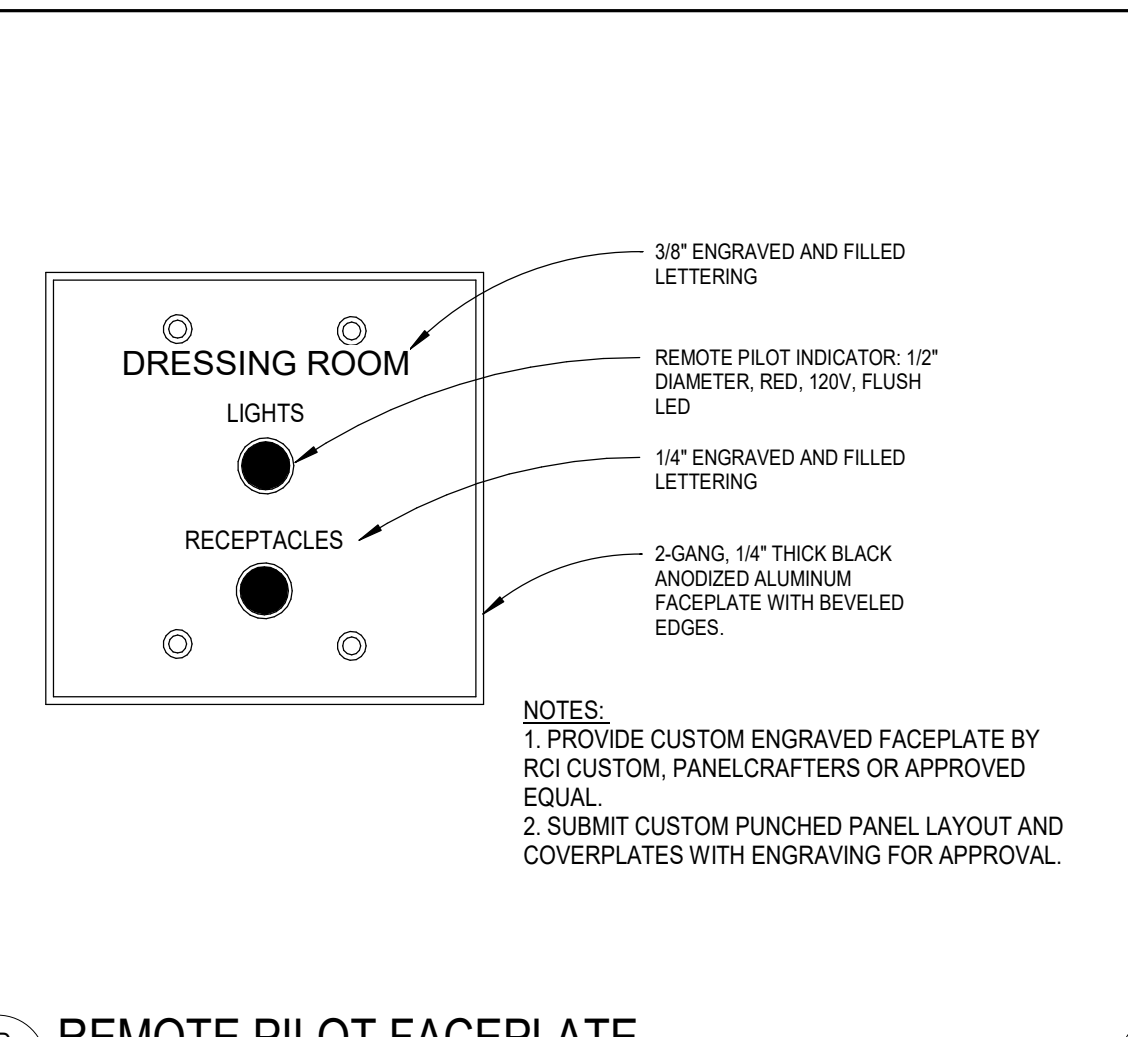

1D REMOTE PILOT FACEPLATE
E6.2 NO SCALE

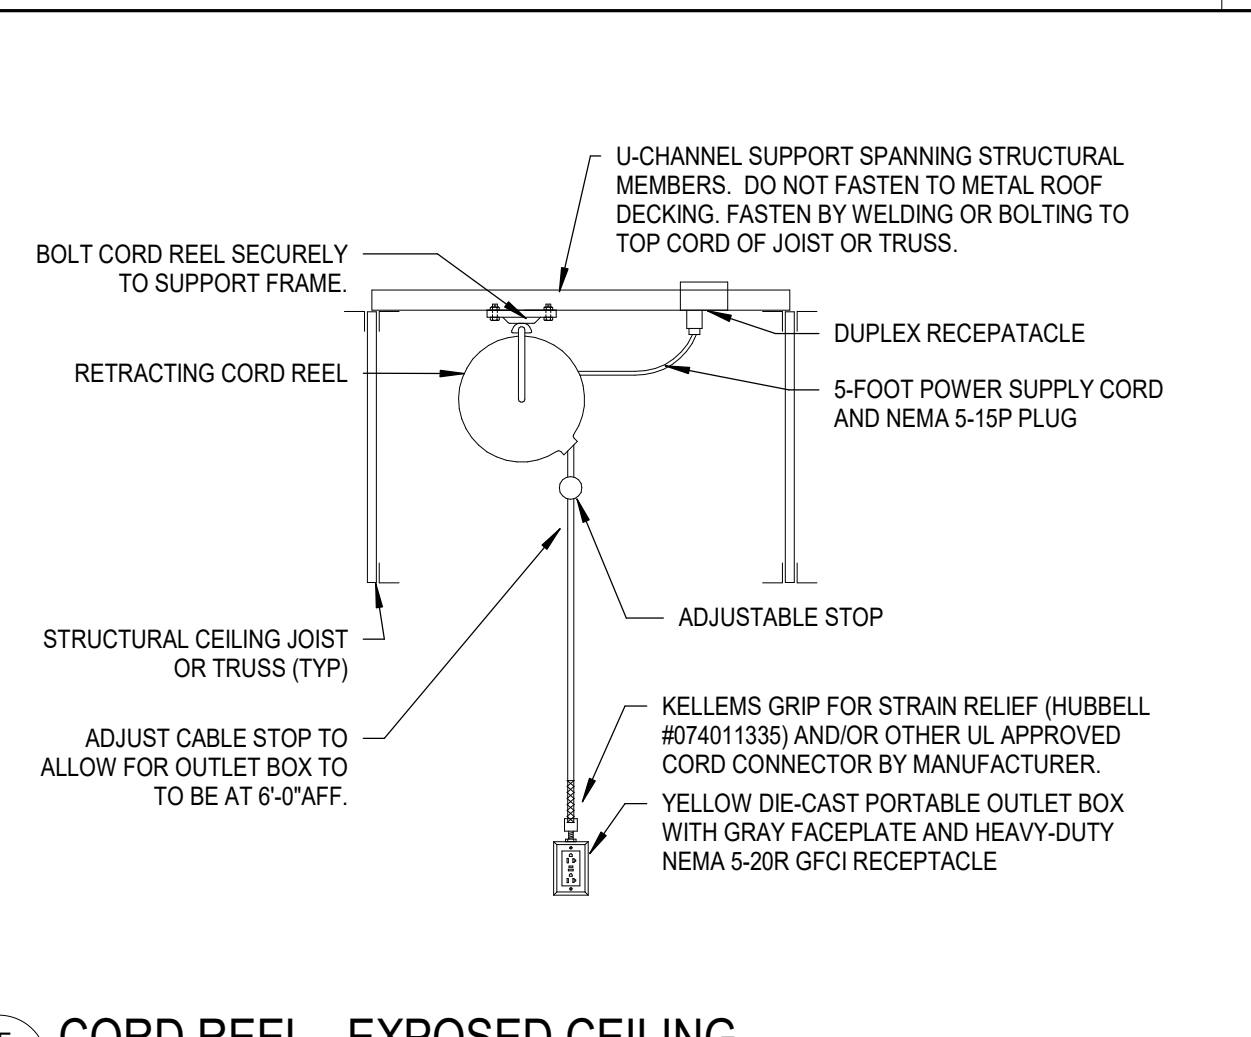


1E CORD REEL - EXPOSED CEILING
E6.2 NO SCALE

FLOOR BOX SCHEDULE


GENERAL NOTES:
 A. BASIS OF DESIGN IS LEGRAND, PROVIDE EQUAL FROM HUBBELL.
 B. PROVIDE UL LISTED DIVIDERS BETWEEN POWER AND LOW VOLTAGE DEVICES.
 C. COMMUNICATIONS (COMM) OUTLETS PER DETAIL.
 D. SOUND OUTLET PER NOTES AND DETAILS.
 E. VIDEO OUTLET PER NOTES AND DETAILS.
 F. THEATRICAL LIGHTING OUTLET PER NOTES AND DETAILS.

NOTES:
 1. PROVIDE BRACKET FOR MOUNTING COMMUNICATION JACKS WITH TIA-606 IDENTIFICATION LABELS. COORDINATE BEZEL WITH COMMUNICATIONS CABLING CONTRACTOR.
 2. SEE PLANS FOR RECEPTACLE TYPE.


| ID | APPLICATION | FLOORING TYPE | COVER | | POSITIONS / DEVICES | | | | BASIS OF DESIGN | | NOTES |
|------|-------------|---------------|------------------------|------------------|---------------------|----|----|------------|-----------------|--------|-------|
| | | | TYPE | COLOR / MATERIAL | 1 | 2 | 3 | 4 | MANUFACTURER | MODEL | |
| FB-1 | ON GRADE | CARPET | FLANGED, CARPET INSERT | BLACK | DUPLEX 5-20R | AV | AV | THEATRICAL | WIEMOLD | EFB-8S | 1 |

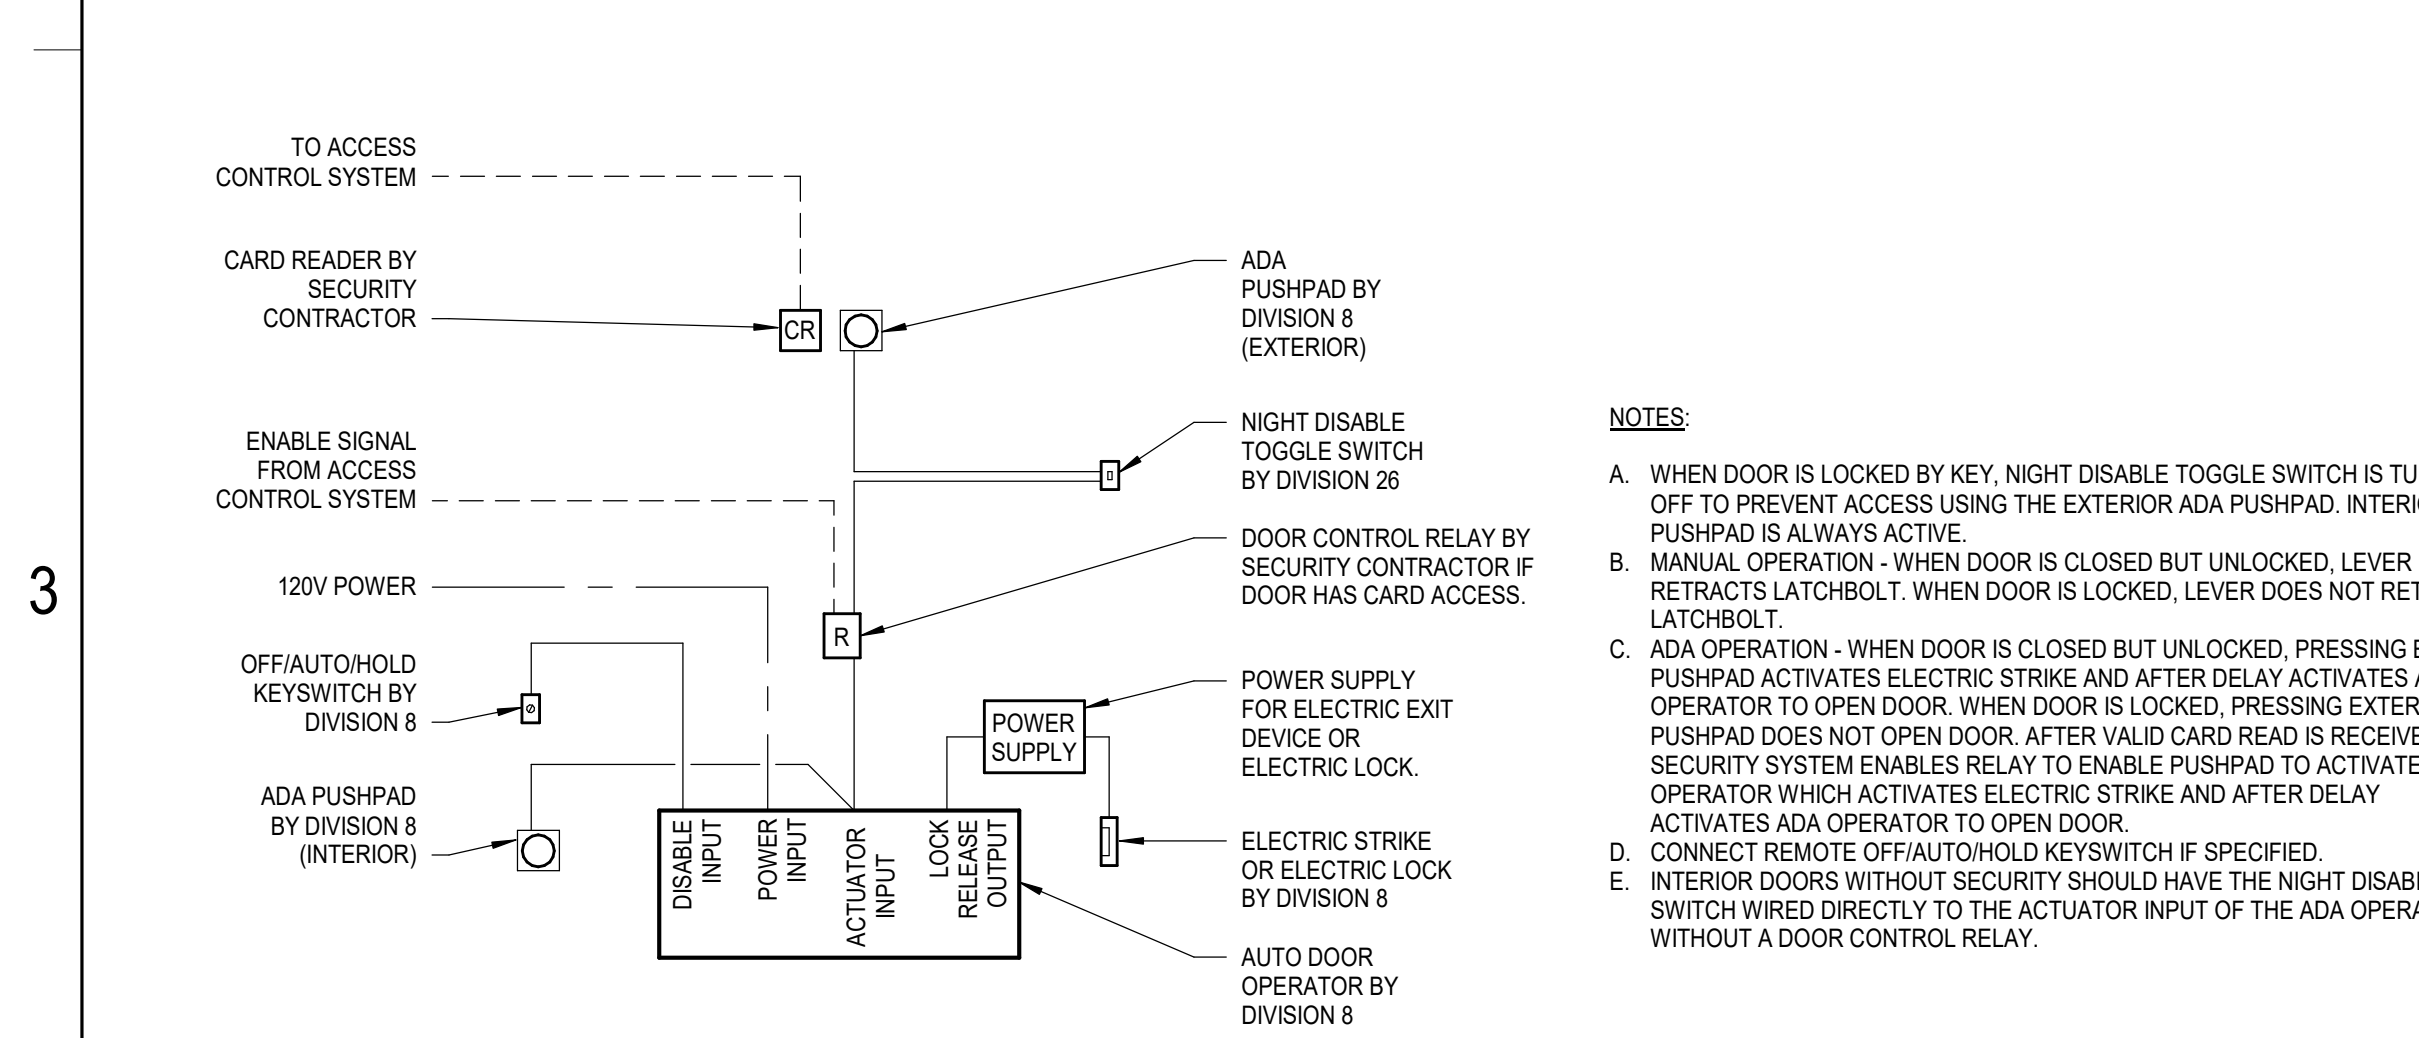


3A ADA OPERATOR CONNECTION
E6.2 NO SCALE

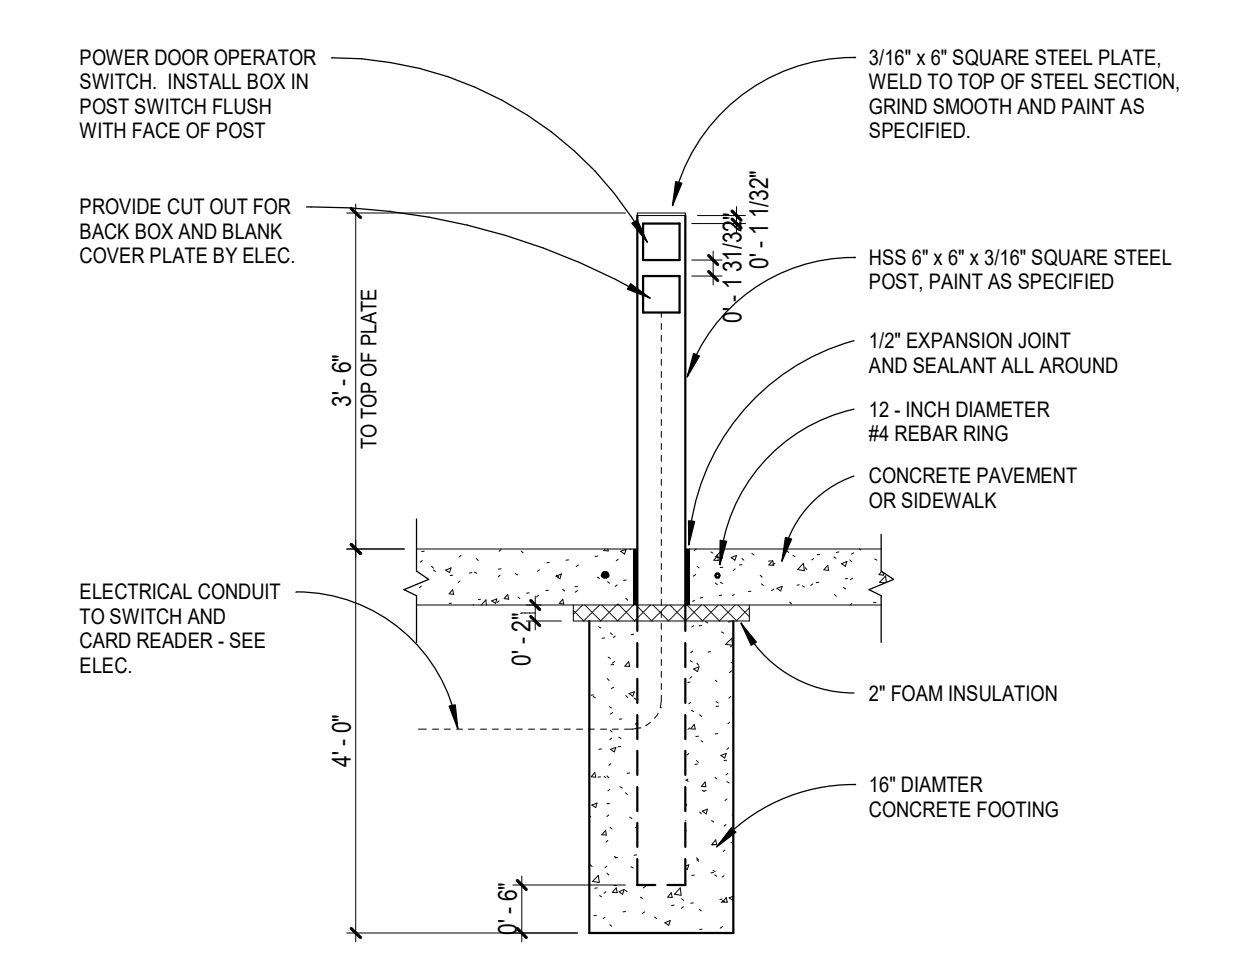


3C DOOR OPERATOR POST
E6.2 NO SCALE

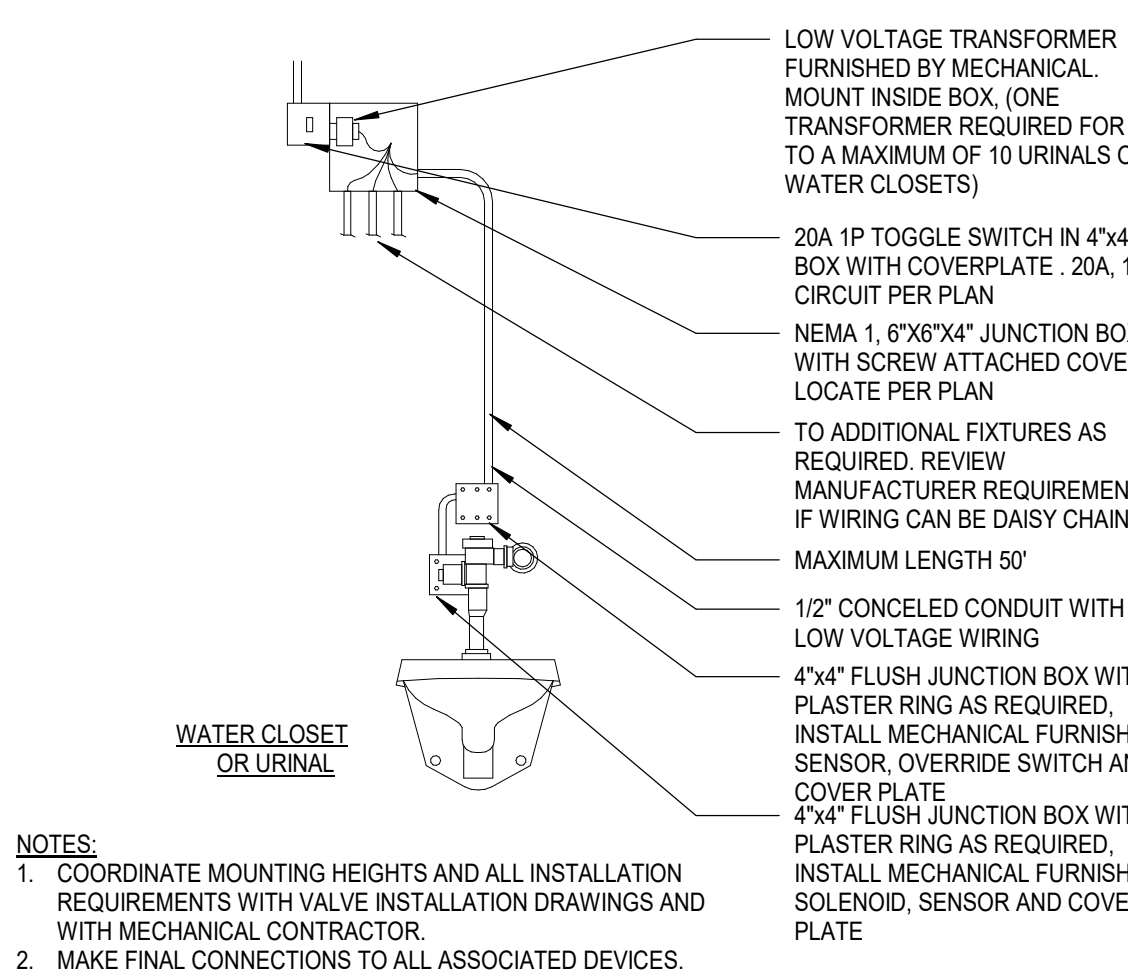


3D AUTO. FLUSHING CONTROL DIAGRAM
E6.2 NO SCALE

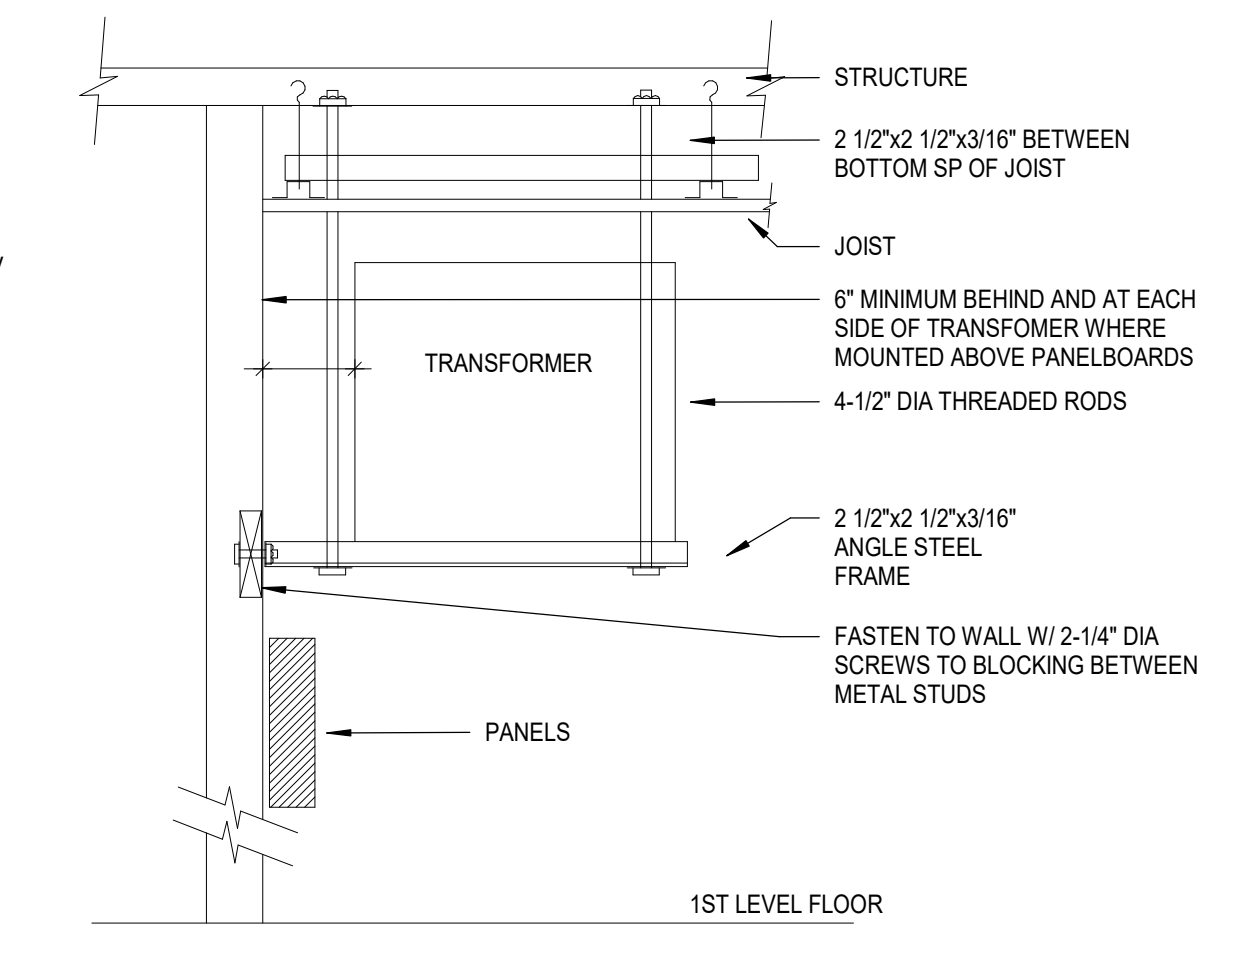


3E DRY-TYPE TRANSFORMER CEILING HUNG
E6.2 NO SCALE

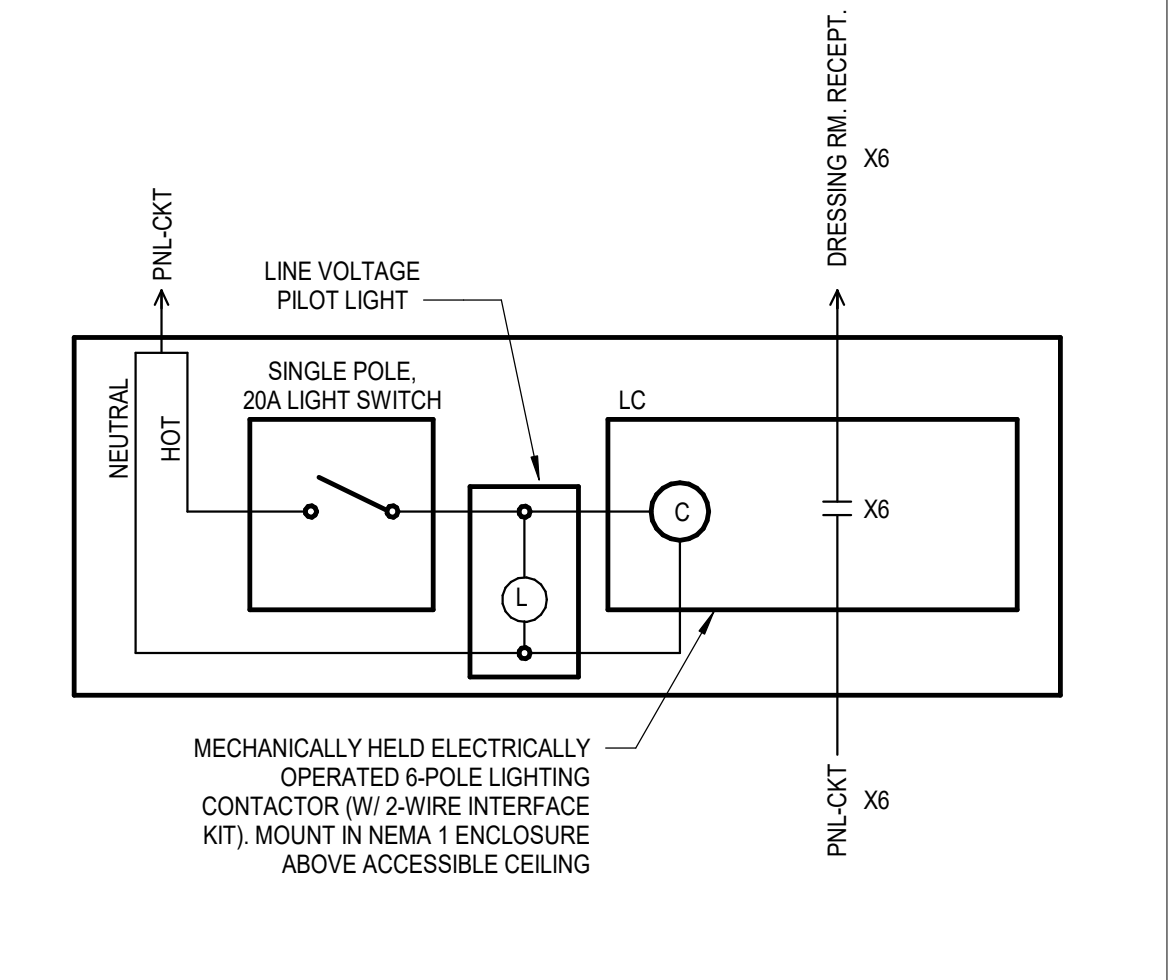


3F DRESSING ROOM CONTACTOR DIAGRAM
E6.2 NO SCALE

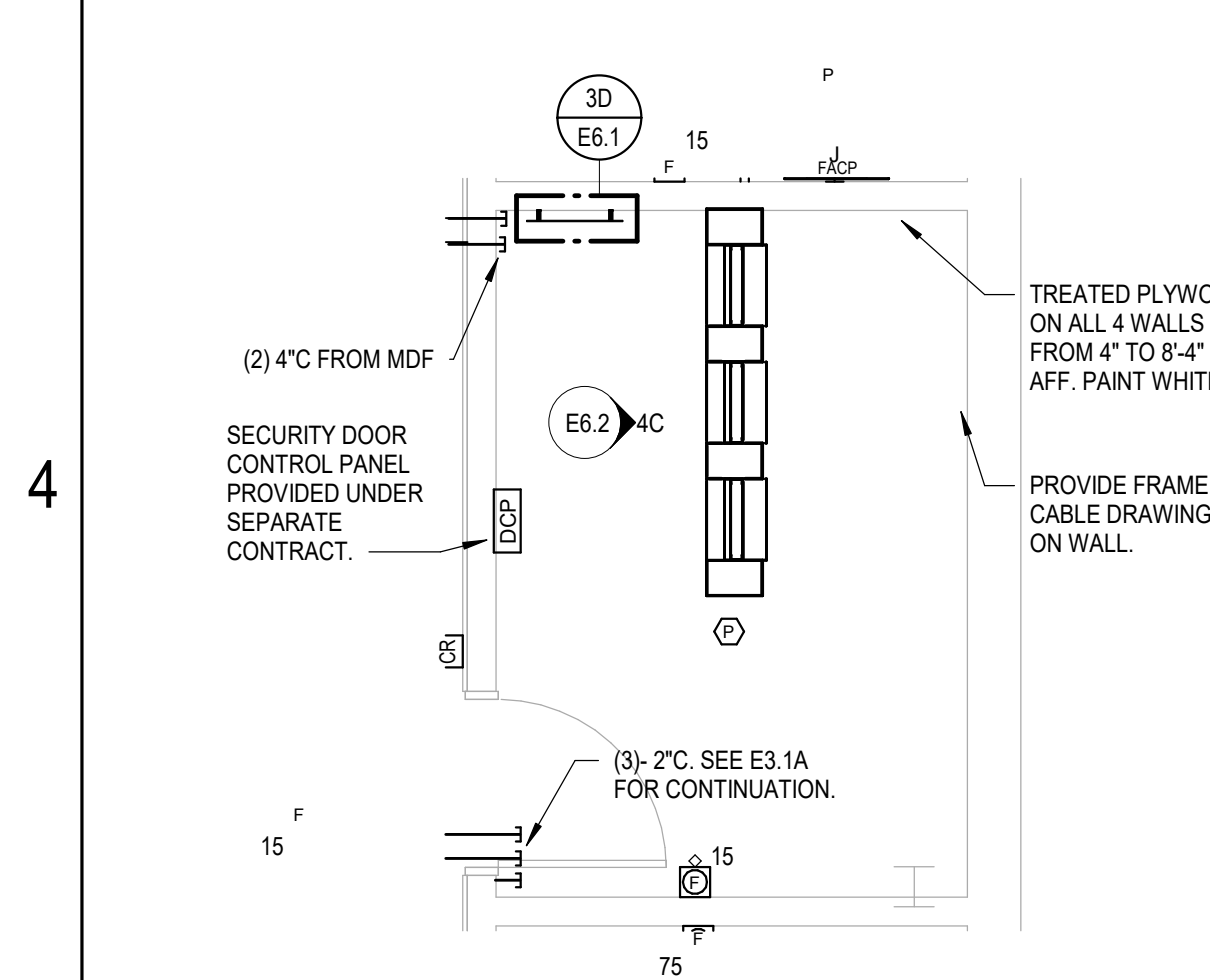


4A ENLARGED EQUIPMENT PLAN IDF A158
E6.2 SCALE: 1/4\"/>

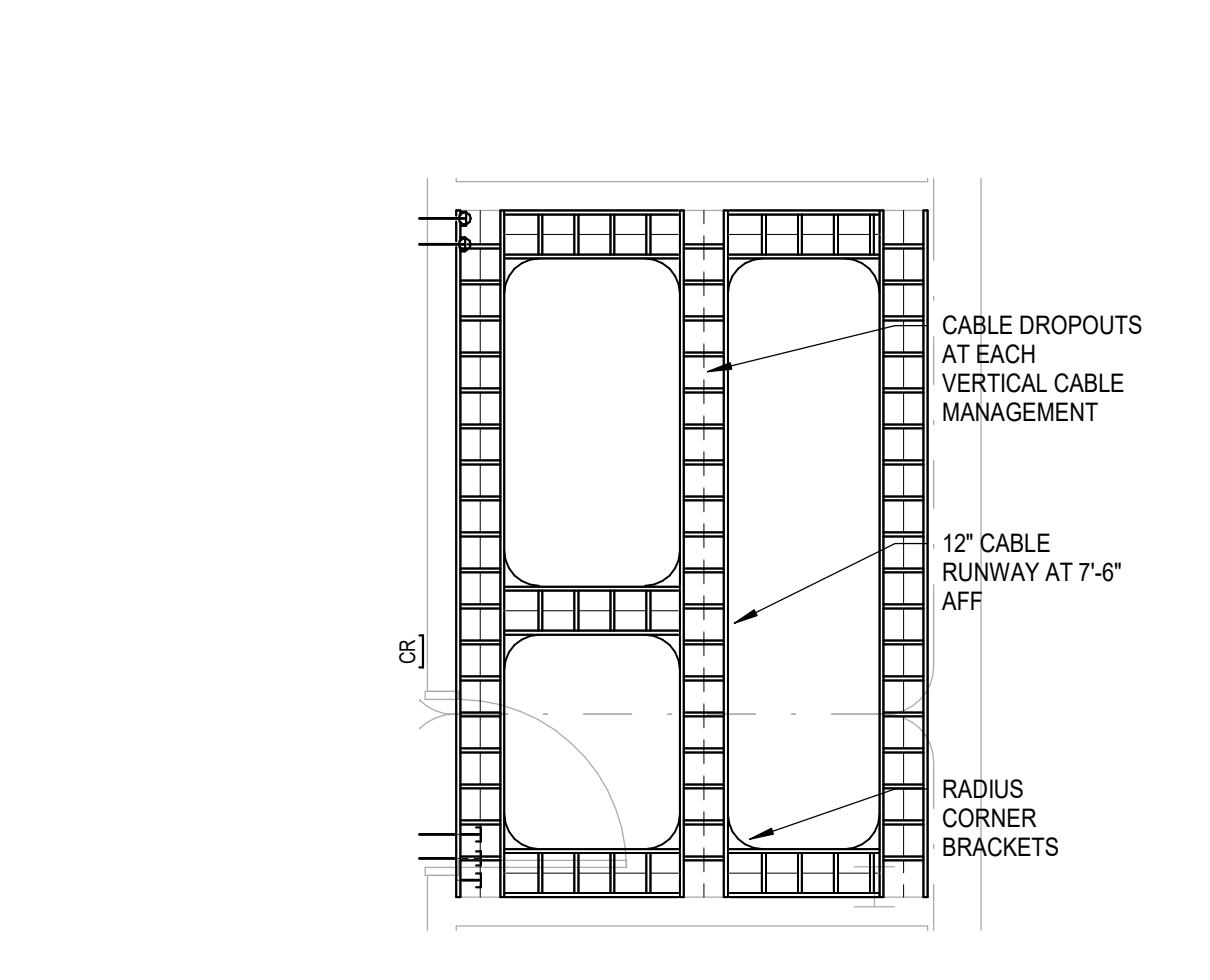


4B ENLARGED CABLE RUNWAY PLAN IDF A158
E6.2 SCALE: 1/4\"/>

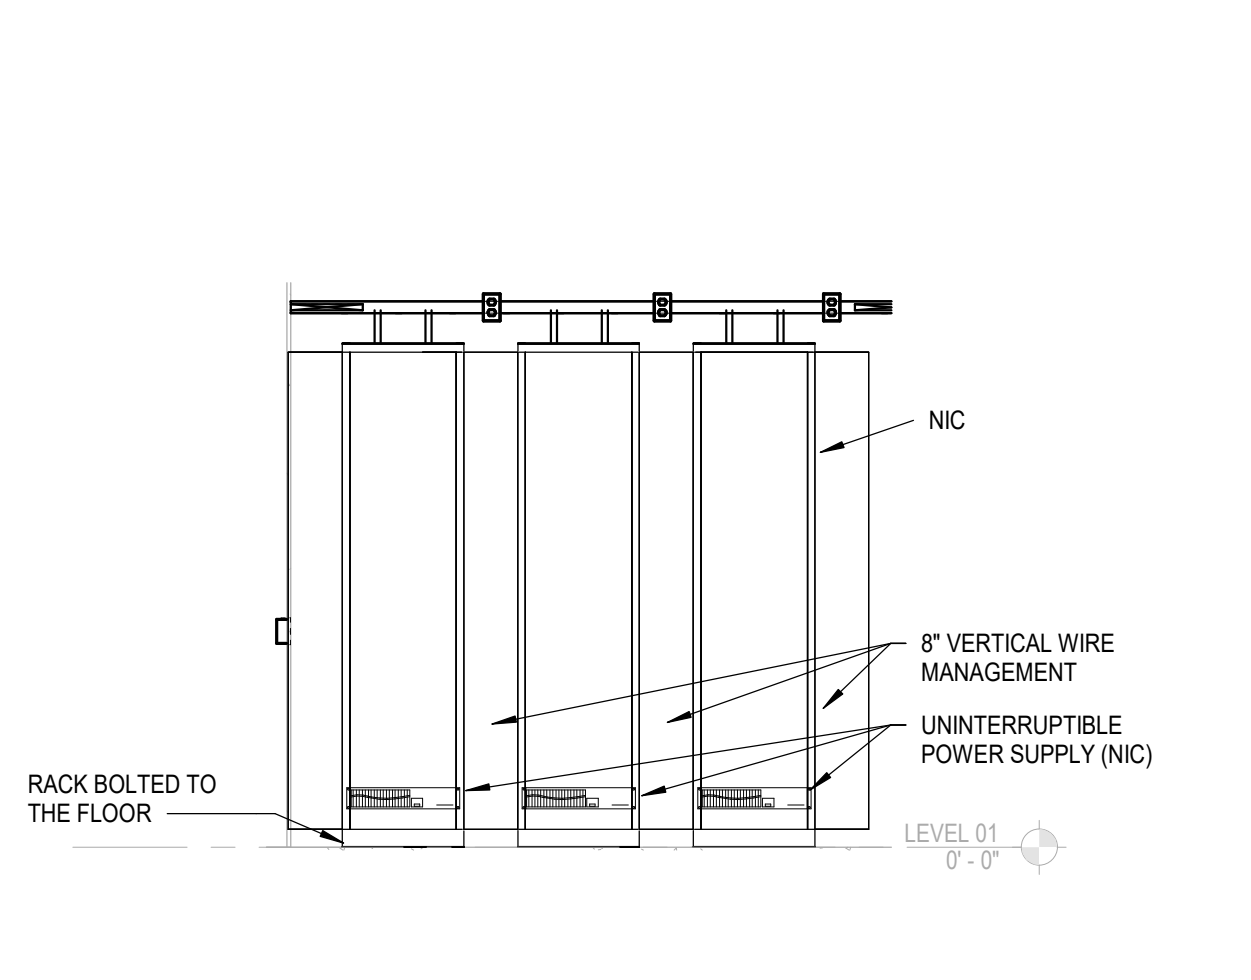


4C IDF A158 RACK ELEVATION
E6.2 SCALE: 3/8\"/>

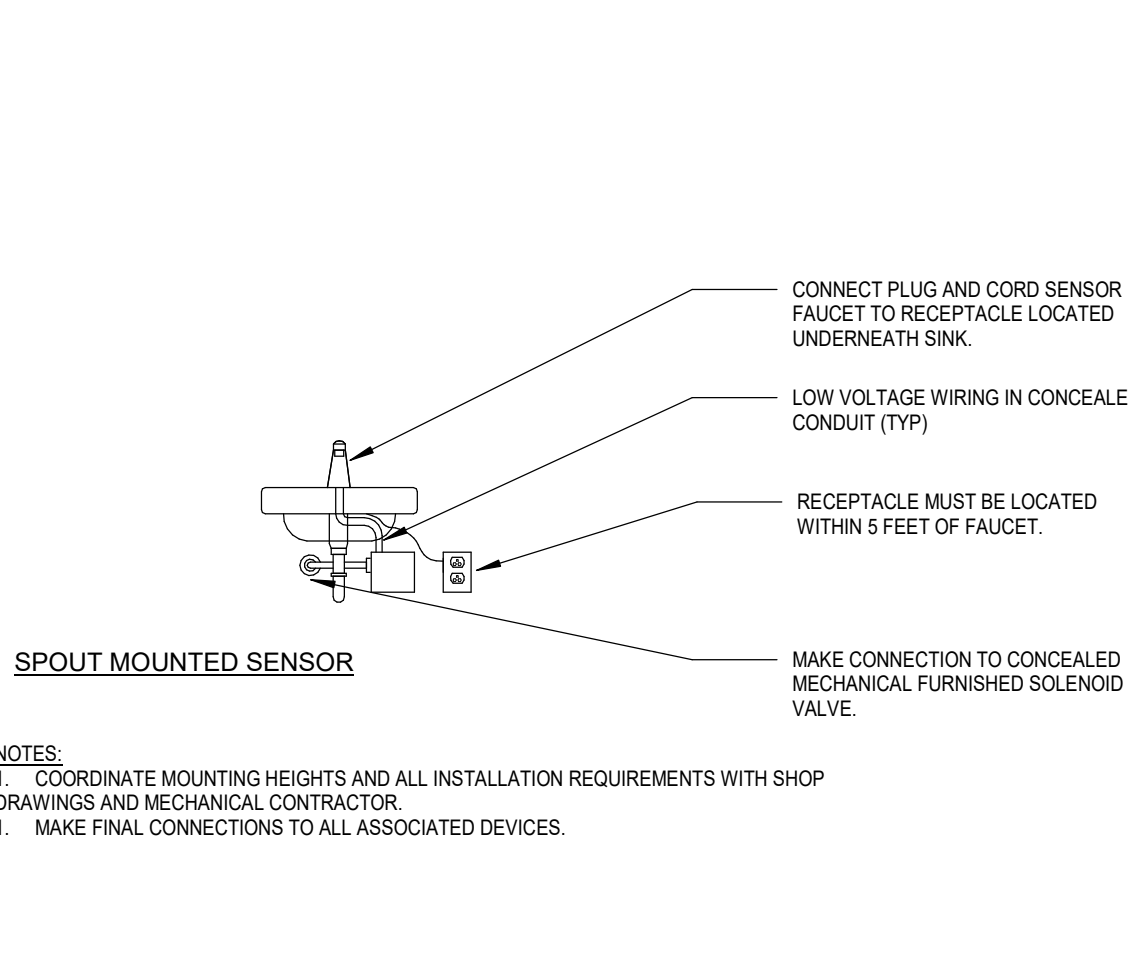


4D AUTO. LAV/WASH FOUNTAIN DIAGRAM
E6.2 NO SCALE

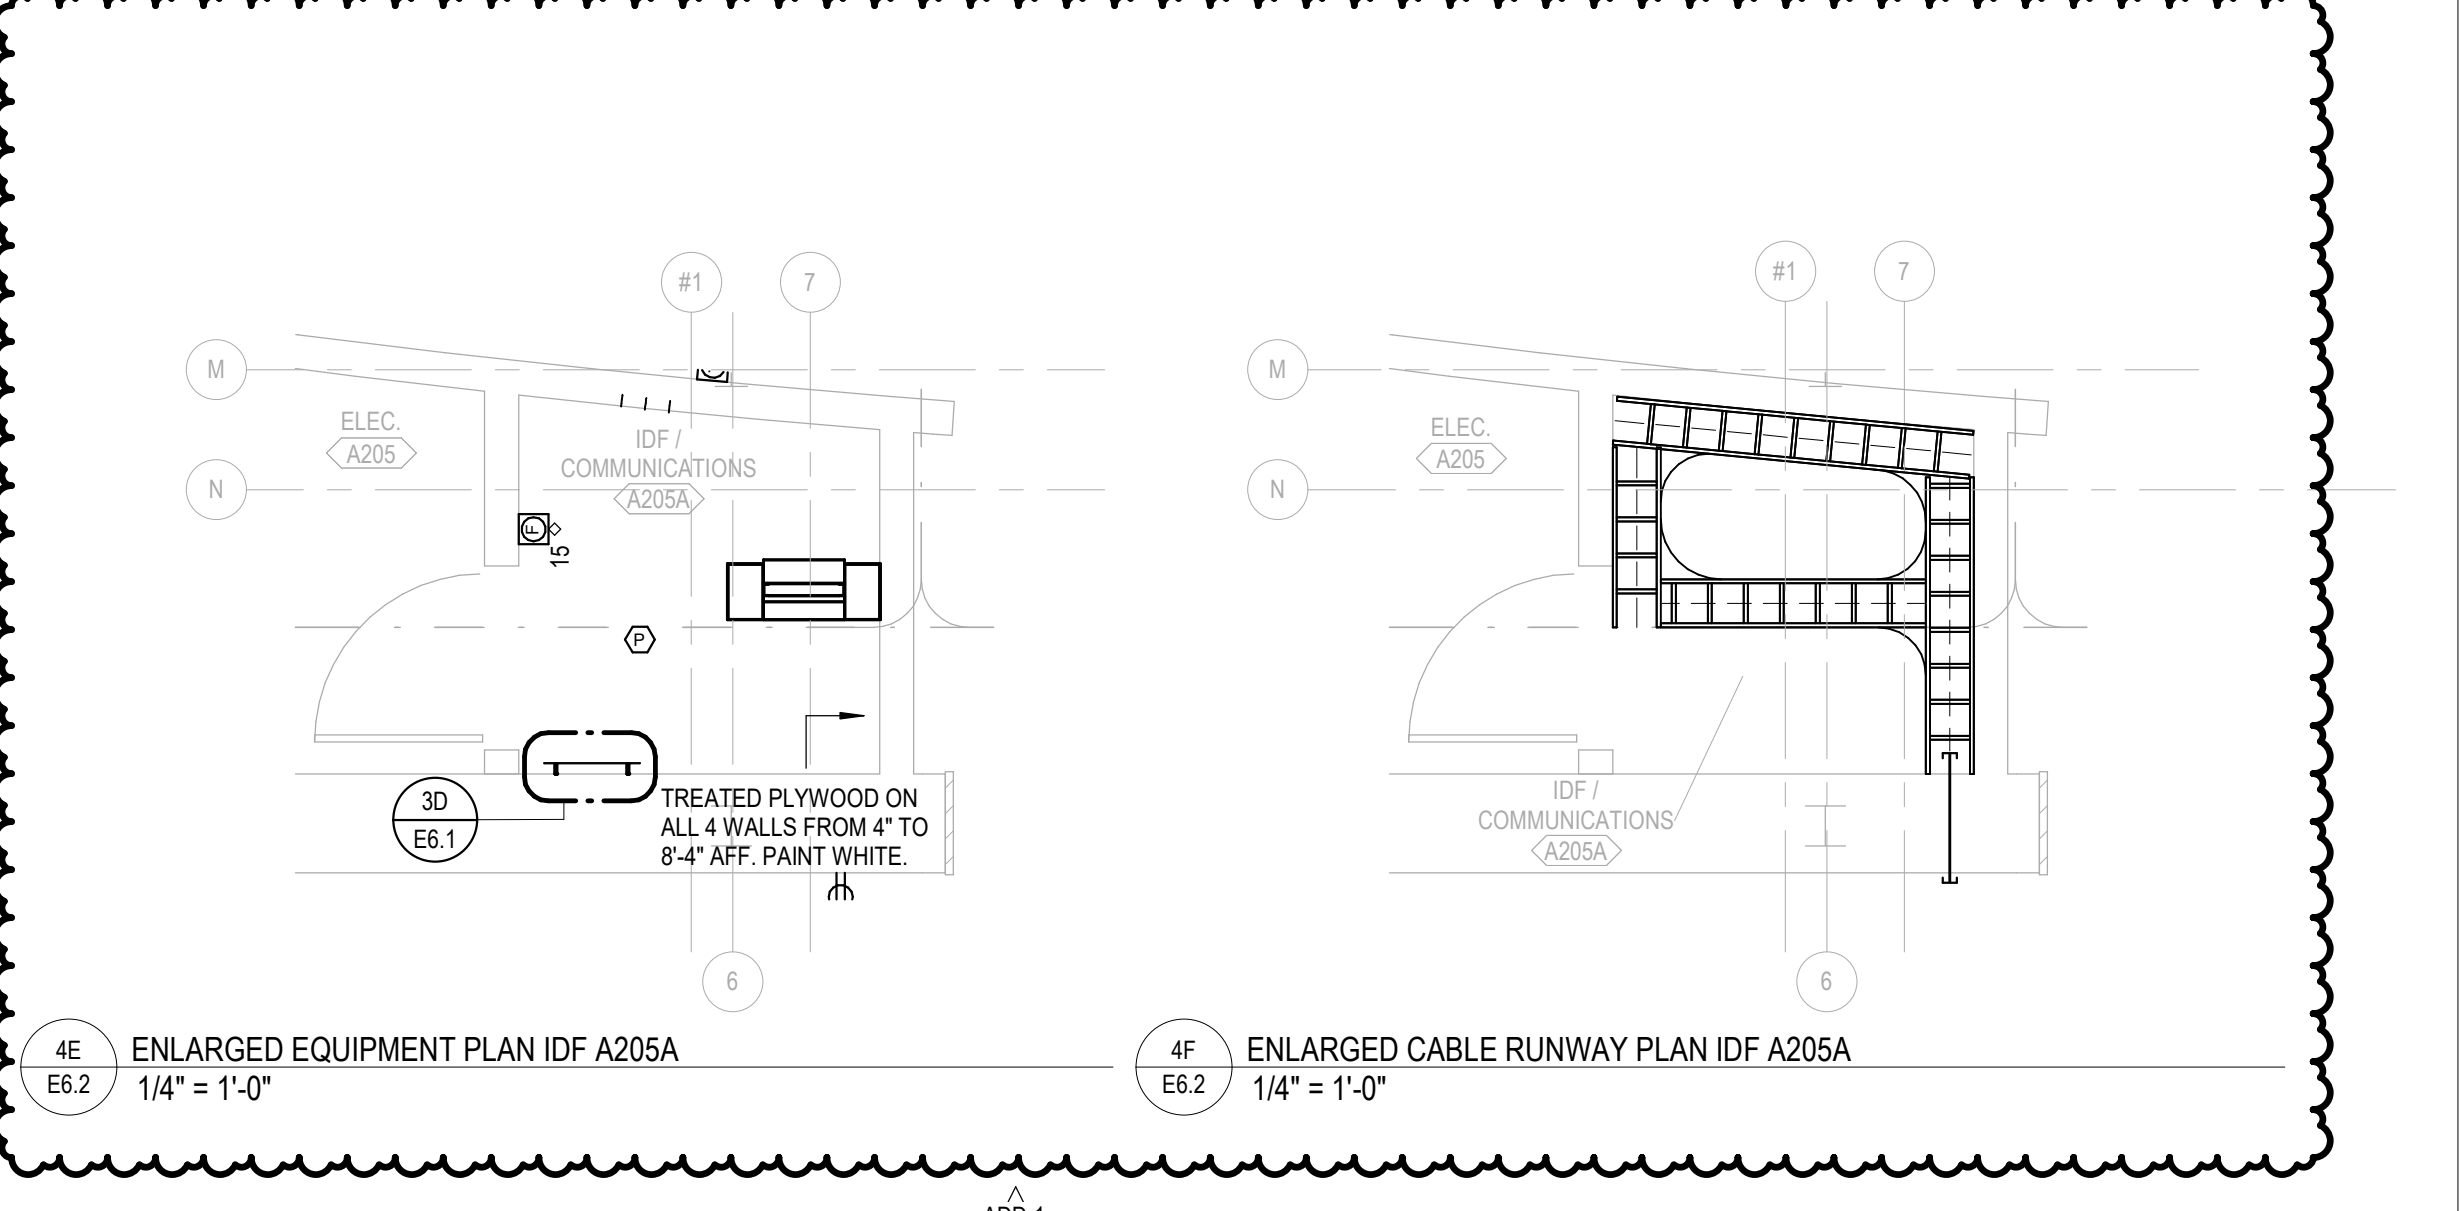


4E ENLARGED EQUIPMENT PLAN IDF A205A
E6.2 1/4\"/>

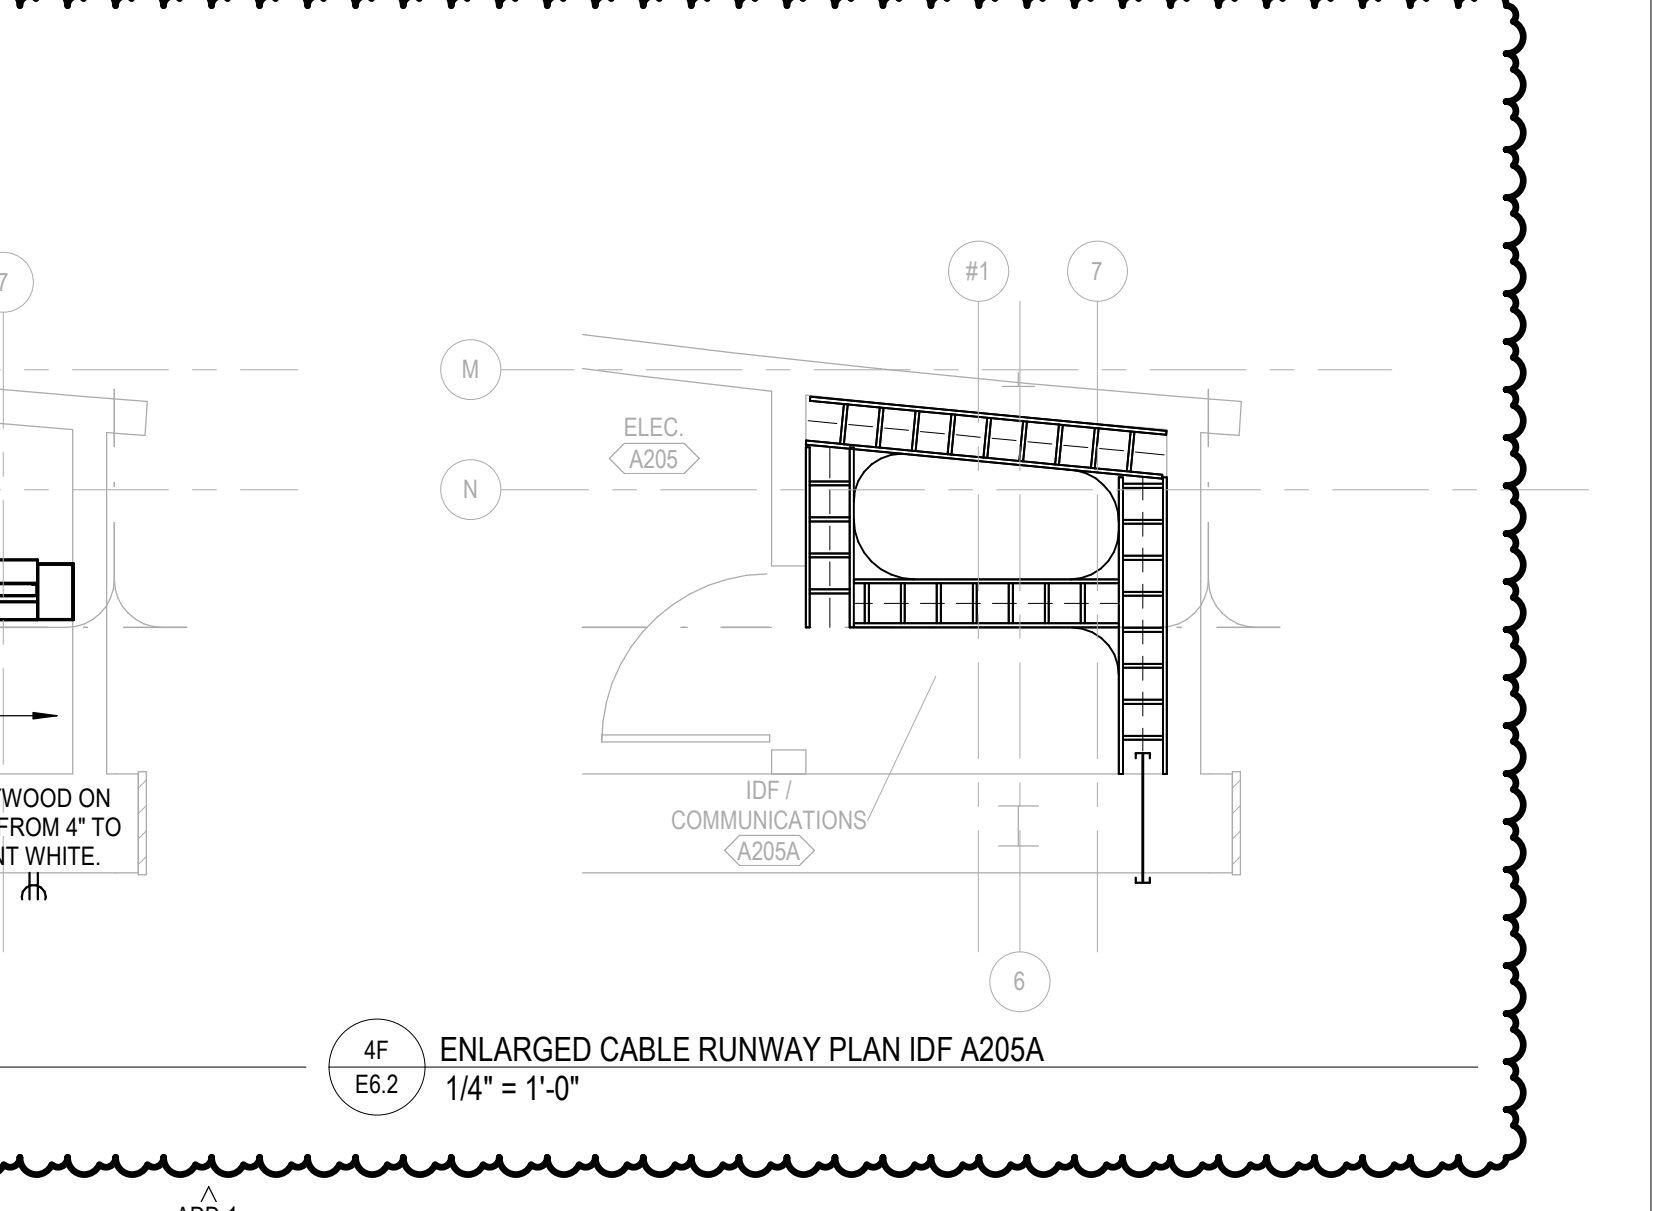


4F ENLARGED CABLE RUNWAY PLAN IDF A205A
E6.2 1/4\"/>

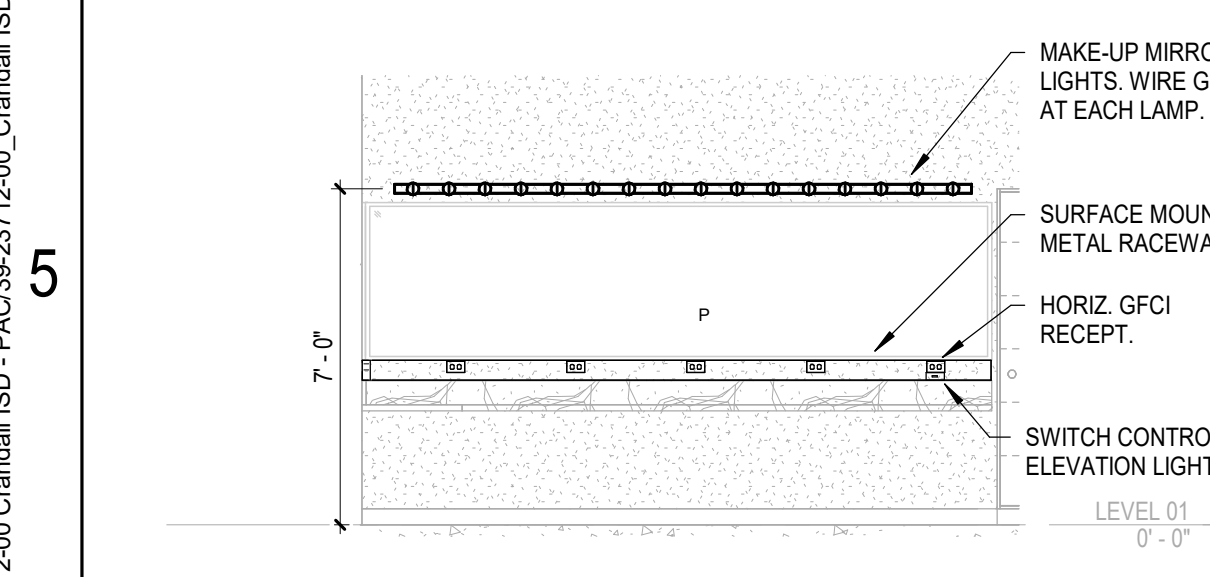

5A MAKEUP ELEVATION WEST
E6.2 SCALE: 1/4\"/>

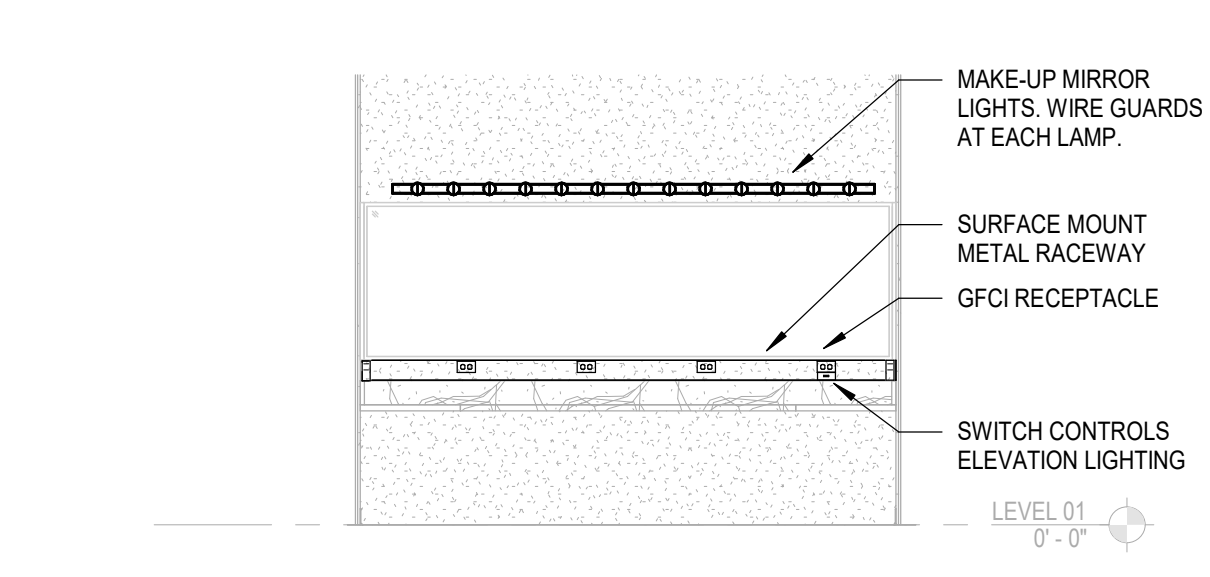

5B MAKEUP ELEVATION SOUTH
E6.2 SCALE: 1/4\"/>

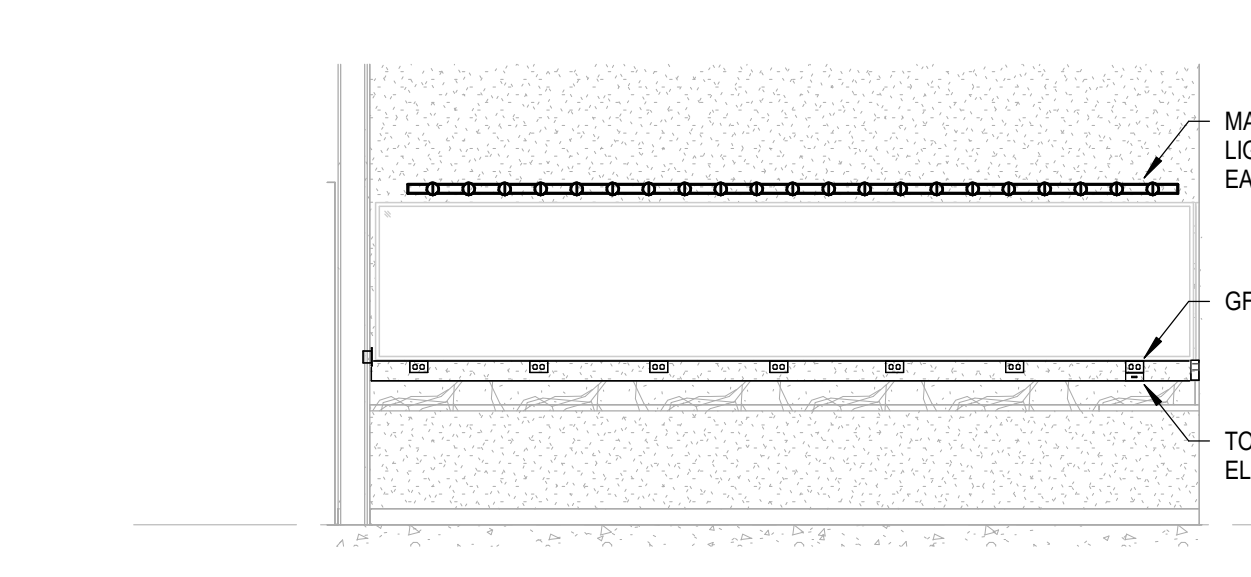

5C MAKEUP ELEVATION EAST
E6.2 SCALE: 1/4\"/>



Autodesk Docs://99-23712-00_Crandall ISD - PAC/39-23712-00_Crandall ISD_EL_2024.rvt 8/20/2024 2:29:40 PM

FAN SCHEDULE

NOTES:
 1. FAN PROVIDED WITH FACTORY MOUNTED DISCONNECT SWITCH
 2. PROVIDE CONNECTION TO MOTORIZED DAMPER
 3. INTERCONNECT WITH RTU-7
 4.
 5.

| ID | SERVES | ECM | LOAD | | | | VOLTAGE (V) | PHASE | DISCONNECT | STARTER | PANEL | CIRCUIT NO. | CONDUIT & WIRE SIZE | NOTES | |
|------|-----------------|-----|------|---------|---------|-----------|-------------|-------|------------|-----------|-----------|-------------|---------------------|-------|-----------------|
| | | | HP | FLA (A) | MCA (A) | MOCOP (A) | | | | | | | | | TOTAL LOAD (VA) |
| EF-1 | DRESSING ROOMS | Yes | 0.1 | 1.5 | 1.9 | 15 | 180 | 120 | 1 | BY DIV 23 | NEMA 00 | ML1K | 27 | 15-2W | 1.2 |
| EF-2 | LOBBY RESTROOMS | Yes | 0.5 | 6.6 | 8.2 | 15 | 792 | 120 | 1 | BY DIV 23 | NEMA 00 | ML2K | 1 | 15-2W | 1.2 |
| EF-3 | WORKSHOP | Yes | 0.1 | 1.5 | 1.9 | 15 | 180 | 120 | 1 | BY DIV 23 | NEMA 00 | ML1K | 27 | 15-2W | 1.2,3 |
| EF-4 | WORKSHOP | Yes | 0.1 | 1.5 | 1.9 | 15 | 180 | 120 | 1 | BY DIV 23 | BY DIV 23 | ML1K | 27 | 15-2W | 1.2,3 |

VARIABLE AIR VOLUME TERMINAL UNIT SCHEDULE

NOTES:
 1.
 2.
 3.
 4.
 5.

| ID | LOCATION | LOAD | | | | VOLTAGE (V) | PHASE | DISCONNECT | PANEL | CIRCUIT NO. | CONDUIT & WIRE SIZE | NOTES |
|-------|----------|---------|---------|-----------|-----------------|-------------|-------|------------|-------|-------------|---------------------|-------|
| | | FLA (A) | MCA (A) | MOCOP (A) | TOTAL LOAD (VA) | | | | | | | |
| VAV-1 | ROOF | 14.5 | 18.1 | 20 | 4,011 | 277 | 1 | BY DIV 23 | MHK | 1 | 20-3W | |
| VAV-2 | ROOF | 3.6 | 4.5 | 15 | 997 | 277 | 1 | BY DIV 23 | MHK | 3 | 15-3W | |
| VAV-3 | ROOF | 3.6 | 4.5 | 15 | 997 | 277 | 1 | BY DIV 23 | MHK | 5 | 15-3W | |
| VAV-4 | ROOF | 9 | 11.3 | 15 | 2,504 | 277 | 1 | BY DIV 23 | MHK | 7 | 15-3W | |
| VAV-5 | ROOF | 3.6 | 4.5 | 15 | 997 | 277 | 1 | BY DIV 23 | MHK | 9 | 15-3W | |
| VAV-6 | ROOF | 5.4 | 6.8 | 15 | 1,507 | 277 | 1 | BY DIV 23 | MHK | 11 | 15-3W | |
| VAV-7 | ROOF | 3.6 | 4.5 | 15 | 997 | 277 | 1 | BY DIV 23 | MHK | 13 | 15-3W | |
| VAV-8 | ROOF | 3.6 | 4.5 | 15 | 997 | 277 | 1 | BY DIV 23 | MHK | 15 | 15-3W | |
| VAV-9 | ROOF | 3.6 | 4.5 | 15 | 997 | 277 | 1 | BY DIV 23 | MHK | 17 | 15-3W | |

HUMIDIFIER SCHEDULE

NOTES:
 1.
 2.
 3.
 4.
 5.

| ID | LOCATION | | HP | LOAD | | | | VOLTAGE (V) | PHASE | DISCONNECT | STARTER | PANEL | CIRCUIT NO. | CONDUIT & WIRE SIZE | NOTES |
|------|----------|---------------|----|---------|---------|-----------|-----------------|-------------|-------|------------|---------|-------|-------------|---------------------|-------|
| | NO. | NAME | | FLA (A) | MCA (A) | MOCOP (A) | TOTAL LOAD (VA) | | | | | | | | |
| HU-1 | A143 | PIANO STORAGE | 0 | 16.8 | 21 | 25 | 2,016 | 120 | 1 | BY DIV 23 | ML1K | 29 | 25-2W | | |

PUMP SCHEDULE

NOTES:
 1. SEE PLANS FOR ALARM PANEL LOCATION. ROUTE CIRCUIT SHOWN TO ALARM PANEL. CONNECT OUTPUT OF ALARM PANEL TO SIMPLEX RECEPTACLE IN ELEVATOR PIT.
 2. PROVIDE PATHWAY FOR OIL MINDER SENSOR CABLE FROM ALARM PANEL TO SUMP PIT SENSOR.
 3.
 4.
 5.

| ID | LOCATION | | SERVES | ECM | HP | LOAD | | | | VOLTAGE (V) | PHASE | DISCONNECT | STARTER | PANEL | CIRCUIT NO. | CONDUIT & WIRE SIZE | NOTES |
|------|----------|------|----------|-----|------|---------|---------|-----------|-----------------|-------------|-------|---------------|------------------------------|-------|-------------|---------------------|-------|
| | NO. | NAME | | | | FLA (A) | MCA (A) | MOCOP (A) | TOTAL LOAD (VA) | | | | | | | | |
| SP-1 | | | ELEVATOR | No | 0.75 | 12 | 15 | 20 | 1,440 | 120 | 1 | CORD AND PLUG | FLOAT SWITCH AND ALARM PANEL | L1AK | 37 | 20-2W | 1.2 |

ELECTRIC WATER HEATER SCHEDULE

NOTES:
 1.
 2.
 3.
 4.
 5.

| ID | LOCATION | HP | SCR | LOAD | | | | VOLTAGE (V) | PHASE | DISCONNECT | PANEL | CIRCUIT NO. | CONDUIT & WIRE SIZE | NOTES |
|--------|--------------------|------|-----|---------|---------|-----------|-----------------|-------------|-------|---------------------------|-------|-------------|---------------------|-------|
| | | | | FLA (A) | MCA (A) | MOCOP (A) | TOTAL LOAD (VA) | | | | | | | |
| EWH-1 | DRESSING ROOMS | 16.6 | YES | 40 | 40 | 40 | 8,300 | 208 | 1 | MOTOR RATED TOGGLE SWITCH | ML1K | 1.3 | 40-2W | |
| EWH-2 | DRESSING ROOMS | 16.6 | YES | 40 | 40 | 40 | 8,300 | 208 | 1 | MOTOR RATED TOGGLE SWITCH | ML1K | 5.7 | 40-2W | |
| EWH-3 | DRESSING ROOMS | 16.6 | YES | 40 | 40 | 40 | 8,300 | 208 | 1 | MOTOR RATED TOGGLE SWITCH | ML1K | 9.11 | 40-2W | |
| EWH-4 | UNISEX TOILET | 3.6 | YES | 17 | 20 | 20 | 3,600 | 208 | 1 | MOTOR RATED TOGGLE SWITCH | ML1K | 13.15 | 40-2W | |
| EWH-5 | UNISEX TOILET | 8.7 | YES | 40 | 40 | 40 | 8,300 | 208 | 1 | MOTOR RATED TOGGLE SWITCH | ML1K | 17.19 | 20-2W | |
| EWH-6 | CUSTODIAL | 24 | YES | 29 | 30 | 30 | 24,000 | 480 | 3 | MOTOR RATED TOGGLE SWITCH | ML1K | 21.23 | 40-2W | |
| EWH-7 | CUSTODIAL | 3.6 | YES | 17 | 20 | 20 | 3,600 | 208 | 1 | MOTOR RATED TOGGLE SWITCH | ML2K | 37.30,41 | 30-3W | |
| EWH-8 | LOBBY RESTROOMS | 8.7 | YES | 40 | 40 | 40 | 8,300 | 208 | 1 | MOTOR RATED TOGGLE SWITCH | ML2K | 9.11 | 20-2W | |
| EWH-9 | LOBBY RESTROOMS | 24 | YES | 29 | 30 | 70 | 24,000 | 480 | 3 | MOTOR RATED TOGGLE SWITCH | ML2K | 28.30 | 40-2W | |
| EWH-10 | MEZZANINE | 8.7 | YES | 40 | 40 | 40 | 8,300 | 208 | 1 | MOTOR RATED TOGGLE SWITCH | ML2K | 1.3,5 | 30-3W | |
| EWH-11 | MEZZANINE | 8.7 | YES | 40 | 40 | 40 | 8,300 | 208 | 1 | MOTOR RATED TOGGLE SWITCH | ML2K | 13.15 | 40-2W | |
| EWH-12 | WORKSHOP | 24 | YES | 29 | 30 | 70 | 24,000 | 480 | 3 | MOTOR RATED TOGGLE SWITCH | ML2K | 17.19 | 40-2W | |
| EWH-13 | ALCOVE | 8.7 | YES | 40 | 40 | 40 | 8,300 | 208 | 1 | MOTOR RATED TOGGLE SWITCH | ML2K | 7.9,11 | 30-3W | |
| EWH-14 | ALCOVE | 8.7 | YES | 40 | 40 | 40 | 8,300 | 208 | 1 | MOTOR RATED TOGGLE SWITCH | ML2K | 5.7 | 40-2W | |
| EWH-15 | BOX OFFICE & CONS. | 8.7 | YES | 40 | 40 | 40 | 8,300 | 208 | 1 | MOTOR RATED TOGGLE SWITCH | ML2K | 32.34 | 40-2W | |

ROOF-TOP UNIT SCHEDULE

NOTES:
 1. PROVIDE DUCT SMOKE DETECTOR IN SUPPLY AND RETURN DUCTS PER IFC REQUIREMENTS.
 2.
 3.
 4.
 5.

| ID | LOCATION | CFM | LOAD | | | | VOLTAGE (V) | PHASE | DISCONNECT | STARTER | PANEL | CIRCUIT NO. | CONDUIT & WIRE SIZE | NOTES |
|-------|----------|-----------|---------|---------|-----------|-----------------|-------------|-------|---------------|---------------|-------|-------------|---------------------|-------|
| | | | FLA (A) | MCA (A) | MOCOP (A) | TOTAL LOAD (VA) | | | | | | | | |
| RTU-1 | ROOF | 14230 CFM | 149 | 150 | 175 | 123,876 | 480 | 3 | VFD BY DIV 23 | VFD BY DIV 23 | DP1K | 7 | SEE ONE-LINE | 1 |
| RTU-2 | ROOF | 2530 CFM | 33.7 | 39.9 | 60 | 28,018 | 480 | 3 | VFD BY DIV 23 | VFD BY DIV 23 | MHK | 2.4,6 | 40-4W | 1 |
| RTU-3 | ROOF | 2750 CFM | 37.0 | 43.2 | 70 | 30,720 | 480 | 3 | VFD BY DIV 23 | VFD BY DIV 23 | MHK | 8 | 40-4W | 1 |
| RTU-4 | ROOF | 5930 CFM | 61.8 | 68 | 90 | 57,360 | 480 | 3 | VFD BY DIV 23 | VFD BY DIV 23 | DP1K | 8 | SEE ONE-LINE | 1 |
| RTU-5 | ROOF | 5300 CFM | 55.3 | 61.5 | 80 | 51,480 | 480 | 3 | VFD BY DIV 23 | VFD BY DIV 23 | MHK | 32.34,36 | 40-4W | 1 |
| RTU-6 | ROOF | 5300 CFM | 55.3 | 61.5 | 80 | 51,480 | 480 | 3 | VFD BY DIV 23 | VFD BY DIV 23 | MHK | 8 | SEE ONE-LINE | 1 |
| RTU-7 | ROOF | 2750 CFM | 37.0 | 43.2 | 70 | 30,720 | 480 | 3 | VFD BY DIV 23 | VFD BY DIV 23 | MHK | 14,16,18 | 40-4W | 1 |
| RTU-8 | ROOF | 2550 CFM | 21.7 | 24.9 | 35 | 18,041 | 480 | 3 | VFD BY DIV 23 | VFD BY DIV 23 | MHK | 20,22,24 | 30-4W | 1 |
| RTU-9 | ROOF | 5000 CFM | 42.7 | 49 | 70 | 35,500 | 480 | 3 | VFD BY DIV 23 | VFD BY DIV 23 | DP1K | 10 | SEE ONE-LINE | 1 |

SPLIT SYSTEM INDOOR UNIT ELEC. CONNECTION SCHEDULE

NOTES:
 1. POWER FOR INDOOR UNITS ARE PROVIDED BY OUTDOOR UNIT.
 2. PROVIDE 34°C BETWEEN INDOOR AND OUTDOOR UNIT FOR CONTROL WIRING.
 3.
 4.
 5.

| ID | LOCATION | LOAD | | | | VOLTAGE (V) | PHASE | DISCONNECT | PANEL | CIRCUIT NO. | CONDUIT & WIRE SIZE | NOTES |
|-------|--------------------------|---------|---------|-----------|-----------------|-------------|-------|---------------------------|-------|-------------|---------------------|-------|
| | | FLA (A) | MCA (A) | MOCOP (A) | TOTAL LOAD (VA) | | | | | | | |
| IU-01 | PIANO STORAGE | 0.3 | 0.4 | 15 | 62 | 208 | 1 | MOTOR RATED TOGGLE SWITCH | ML2K | 21.23 | 15-2W | 1.2 |
| IU-02 | IDF | 0.6 | 0.8 | 20 | 125 | 208 | 1 | MOTOR RATED TOGGLE SWITCH | ML2K | 25.27 | 20-2W | 1.2 |
| IU-03 | ELEC. ROOM | 0.6 | 0.8 | 20 | 125 | 208 | 1 | MOTOR RATED TOGGLE SWITCH | ML2K | 28.31 | 20-2W | 1.2 |
| IU-04 | BOX OFFICE & CONCESSIONS | 1.1 | 1.4 | 15 | 229 | 208 | 1 | MOTOR RATED TOGGLE SWITCH | ML2K | 33.35 | 20-2W | 1.2 |
| IU-05 | MGR / FIRST AID | 0.5 | 0.6 | 15 | 104 | 208 | 1 | MOTOR RATED TOGGLE SWITCH | ML2K | 37.39 | 15-2W | 1.2 |
| IU-06 | ELEC. ROOM | 0.6 | 0.8 | 20 | 125 | 208 | 1 | MOTOR RATED TOGGLE SWITCH | ML2K | 2.4 | 20-2W | 1.2 |
| IU-07 | ELEC. ROOM | 0.6 | 0.7 | 20 | 121 | 208 | 1 | MOTOR RATED TOGGLE SWITCH | ML2K | 6.8 | 20-2W | 1.2 |
| IU-08 | ELEC. ROOM | 1.1 | 1.4 | 15 | 229 | 208 | 1 | MOTOR RATED TOGGLE SWITCH | ML2K | 10.12 | 20-2W | 1.2 |
| IU-09 | ELEC. ROOM | 0.6 | 0.7 | 20 | 121 | 208 | 1 | MOTOR RATED TOGGLE SWITCH | ML2K | 38.40 | 20-2W | 1.2 |
| IU-10 | ELEC. ROOM | 0.6 | 0.7 | 20 | 121 | 208 | 1 | MOTOR RATED TOGGLE SWITCH | ML2K | 18.20 | 20-2W | 1.2 |

SPLIT SYSTEM CONDENSING UNIT ELEC. CONNECTION SCHEDULE

NOTES:
 1.
 2.
 3.
 4.
 5.

| ID | LOCATION | LOAD | | | | VOLTAGE (V) | PHASE | DISCONNECT | PANEL | CIRCUIT NO. | CONDUIT & WIRE SIZE | NOTES |
|-------|----------|---------|---------|-----------|-----------------|-------------|-------|------------------|-------|-------------|---------------------|-------|
| | | FLA (A) | MCA (A) | MOCOP (A) | TOTAL LOAD (VA) | | | | | | | |
| OU-01 | ROOF | 12 | 12.3 | 15 | 2,496 | 208 | 1 | NEMA 3R NF 30A2P | ML2K | 21.23 | 15-2W | |
| OU-02 | ROOF | 18.3 | 19.8 | 20 | 3,806 | 208 | 1 | NEMA 3R NF 30A2P | ML2K | 25.27 | 20-2W | |
| OU-03 | ROOF | 18.3 | 19.8 | 20 | 3,806 | 208 | 1 | NEMA 3R NF 30A2P | ML2K | 29.31 | 20-2W | |
| OU-04 | ROOF | 12 | 13.3 | 15 | 2,496 | 208 | 1 | NEMA 3R NF 30A2P | ML2K | 33.35 | 20-2W | |
| OU-05 | ROOF | 7.5 | 8 | 15 | 1,560 | 208 | 1 | NEMA 3R NF 30A2P | ML2K | 37.39 | 15-2W | |
| OU-06 | ROOF | 18.3 | 19.8 | 20 | 3,806 | 208 | 1 | NEMA 3R NF 30A2P | ML2K | 2.4 | 20-2W | |
| OU-07 | ROOF | 13.3 | 14.8 | 20 | 2,766 | 208 | 1 | NEMA 3R NF 30A2P | ML2K | 6.8 | 20-2W | |
| OU-08 | ROOF | 12 | 13.1 | 15 | 2,496 | 208 | 1 | NEMA 3R NF 30A2P | ML2K | 10.12 | 20-2W | |
| OU-09 | ROOF | 13.3 | 14.8 | 20 | 2,766 | 208 | 1 | NEMA 3R NF 30A2P | ML2K | 38.40 | 20-2W | |
| OU-10 | ROOF | 13.3 | 14.8 | 20 | 2,766 | 208 | 1 | NEMA 3R NF 30A2P | ML2K | 18.20 | 20-2W | |



TIRE PRINT REGISTRATION NUMBER F-1111



CRANDALL ISD HIGH SCHOOL
 PAC ADDITION
 13385 Fm 3038, Crandall, TX 75114

ISSUE FOR BID AND PERMIT
 2024.08.19
 REVISIONS
 ADD-1 8824

39-23712-00
 ELECTRICAL SCHEDULES

E7.2



TYPE AND REGISTRATION NUMBER: P-111



ISSUE FOR BID
AND PERMIT
2024.08.19
REVISIONS
ADD-1 8924

39-23712-00
ELECTRICAL
SCHEDULES

E7.3

| PANEL: L1AK | | | | | | | | | | | | | | |
|-----------------------|--|----------|---|----------|-----------------|--------------|--------------|--------------|-----------|-----------------------|-------|----------|---|-----|
| LOCATION: ELEC. A160 | | | | | VOLTS: 208Y/120 | | | | | MOUNTING: SURFACE | | | | |
| BUS RATING: 1200.0 A | | | | | PHASES: 3 | | | | | FED FROM: L1AK | | | | |
| MAIN BREAKER: 11400.3 | | | | | WIRES: 4 | | | | | INTEGRAL SPD: YES | | | | |
| SCCR: 25 KA | | | | | SCCR: 8 KA | | | | | LUG ACCESSORIES: NONE | | | | |
| CKT | CIRCUIT DESCRIPTION | BKR TRIP | P | BKR TYPE | LOAD TYPE | PHASE A (VA) | PHASE B (VA) | PHASE C (VA) | LOAD TYPE | BKR TRIP | P | BKR TYPE | CIRCUIT DESCRIPTION | CKT |
| 1 | EW-HALL A196 | 20 | 1 | G | R | 500 | 500 | | | | | | EW-CLOVE A113 | 2 |
| 3 | R-HALL A196, A143 | 20 | 1 | R | R | | 540 | 1,560 | | | | | DOCK LEVER | 4 |
| 5 | R BOX OFFICE & CONCESSIONS A165 | 20 | 1 | R | R | | | 360 | 1,500 | | | | R-ALCOVE A113 DRYER | 6 |
| 7 | R BOX OFFICE & CONCESSIONS A165 FRIDGE | 20 | 1 | R | R | 180 | 1,500 | | | | | | R-ALCOVE A113 WASHER | 8 |
| 9 | R DRESSING ROOM A128 A128A VALVES | 20 | 1 | R | O | | | 800 | 1,000 | | | | R-ALCOVE A113 ICE MACHINE | 10 |
| 11 | R MAKEUP A187 COUNTER | 20 | 1 | R | R | | | | 720 | 1,500 | | | R-ALCOVE A113 ICE MACHINE | 12 |
| 13 | R MAKEUP A187 COUNTER | 20 | 1 | R | O | 720 | 1,500 | | | | | | R-ALCOVE A113 ICE MACHINE | 14 |
| 15 | R MAKEUP A187 COUNTER | 20 | 1 | R | R | | | | 720 | 720 | | | R-WORKSHOP A116 W/N | 16 |
| 17 | R MAKEUP A187 COUNTER | 20 | 1 | R | R | | | | | | | | R-STORAGE A120 A124 | 18 |
| 19 | R DRESSING ROOM A129 A129A VALVES | 20 | 1 | R | O | 1,080 | 900 | | | | | | R-STORAGE TOILET A102, A104, A107, A108 | 20 |
| 21 | R STAGE WING A186 | 20 | 1 | R | R | | | | 900 | 720 | | | R-WORKSHOP A116 E.S. | 22 |
| 23 | R-ELEVATOR A147 | 20 | 1 | R | R | | | | | | | | R-WORKSHOP A116 CORD REEL | 24 |
| 25 | R-CONCESSIONS A103 | 20 | 1 | R | R | 360 | 900 | | | | | | R-ELEC. OPEN CIRC. A115, A117, A120 | 26 |
| 27 | R OFFICE A106 | 20 | 1 | R | R | | | | 900 | 720 | | | R-TOILET LIBRARY A137 A138 VALVES | 28 |
| 29 | R AUDIENCE CHAMBER A148 | 20 | 1 | R | R | | | | 1,080 | 1,080 | | | R-PRACTICE A131-A134 | 30 |
| 31 | L TRACK, OPEN CIRCULATION A138 | 20 | 1 | L | L | 525 | 1,200 | | | 120 | 1,200 | | INDEX STRIP LIGHT RIGHT | 32 |
| 33 | R MAKEUP A187 | 20 | 1 | R | R | | | | | | | | INDEX STRIP LIGHT LEFT | 34 |
| 35 | R CONCESSIONS EQUIPMENT | 20 | 1 | G | R | | | | | 1,600 | 1,200 | | INDEX STRIP LIGHT LEFT | 36 |
| 37 | SP-1 | 20 | 1 | M | M | 1,440 | 250 | | | | | | OVERHEAD DOOR-STRAP A149 | 38 |
| 39 | L TRACK OPEN CIRCULATION A138 | 20 | 1 | L | L | | | 1,675 | 1,725 | | | | L-TRACK A196 | 40 |
| 41 | L-TRACK A196 | 20 | 1 | L | L | | | | 750 | 0 | | | SPARE | 42 |
| 43 | SPARE | 20 | 1 | SPARE | SPARE | 0 | 0 | 0 | 0 | 0 | 0 | | SPARE | 44 |
| 45 | SPARE | 20 | 1 | SPARE | SPARE | 0 | 0 | 0 | 0 | 0 | 0 | | SPARE | 46 |
| 47 | SPARE | 20 | 1 | SPARE | SPARE | 0 | 0 | 0 | 0 | 0 | 0 | | SPARE | 48 |
| 49 | SPARE | 20 | 1 | SPARE | SPARE | 0 | 0 | 0 | 0 | 0 | 0 | | SPARE | 50 |
| 51 | SPARE | 20 | 1 | SPARE | SPARE | 0 | 0 | 0 | 0 | 0 | 0 | | SPARE | 52 |
| 53 | SPARE | 20 | 1 | SPARE | SPARE | 0 | 0 | 0 | 0 | 0 | 0 | | SPARE | 54 |
| 55 | SPARE | 20 | 1 | SPARE | SPARE | 0 | 0 | 0 | 0 | 0 | 0 | | SPARE | 56 |
| 57 | SPARE | 20 | 1 | SPARE | SPARE | 0 | 0 | 0 | 0 | 0 | 0 | | SPARE | 58 |
| 59 | SPARE | 20 | 1 | SPARE | SPARE | 0 | 0 | 0 | 0 | 0 | 0 | | SPARE | 60 |
| 61 | SPARE | 20 | 1 | SPARE | SPARE | 0 | 0 | 0 | 0 | 0 | 0 | | SPARE | 62 |
| 63 | SPARE | 20 | 1 | SPARE | SPARE | 0 | 0 | 0 | 0 | 0 | 0 | | SPARE | 64 |
| 65 | SPARE | 20 | 1 | SPARE | SPARE | 0 | 0 | 0 | 0 | 0 | 0 | | SPARE | 66 |
| 67 | SPARE | 20 | 1 | SPARE | SPARE | 0 | 0 | 0 | 0 | 0 | 0 | | SPARE | 68 |
| 69 | SPARE | 20 | 1 | SPARE | SPARE | 0 | 0 | 0 | 0 | 0 | 0 | | SPARE | 70 |
| 71 | SPARE | 20 | 1 | SPARE | SPARE | 0 | 0 | 0 | 0 | 0 | 0 | | SPARE | 72 |
| 73 | SPARE | 20 | 1 | SPARE | SPARE | 0 | 0 | 0 | 0 | 0 | 0 | | SPARE | 74 |
| 75 | SPARE | 20 | 1 | SPARE | SPARE | 0 | 0 | 0 | 0 | 0 | 0 | | SPARE | 76 |
| 77 | SPARE | 20 | 1 | SPARE | SPARE | 0 | 0 | 0 | 0 | 0 | 0 | | SPARE | 78 |
| 79 | SPARE | 20 | 1 | SPARE | SPARE | 0 | 0 | 0 | 0 | 0 | 0 | | SPARE | 80 |
| 81 | SPARE | 20 | 1 | SPARE | SPARE | 0 | 0 | 0 | 0 | 0 | 0 | | SPARE | 82 |
| 83 | SPARE | 20 | 1 | SPARE | SPARE | 0 | 0 | 0 | 0 | 0 | 0 | | SPARE | 84 |
| TOTAL LOAD: | | | | | | 11555 VA | 13600 VA | | | 11770 VA | | | | |
| TOTAL AMPS: | | | | | | 96.3 A | 113.6 A | | | 98.4 A | | | | |

| LOAD TYPE | LOAD DESCRIPTION | CONNECTED LOAD (VA) | DEMAND FACTOR | ESTIMATED DEMAND (VA) | DEMAND FACTOR NOTES | BKR TYPE | PANEL TOTALS |
|-----------|------------------|---------------------|---------------|-----------------------|--|------------------|----------------------------|
| L | LIGHTING | 4995 VA | 100.00% | 4995 VA | CONTINUOUS LOAD @ 125% | G = GFCI (5mA) | CONNECTED LOAD: 27 kVA |
| R | RECEPTACLES | 25320 VA | 88.75% | 17860 VA | FIRST 10kVA @ 100%, REMAINDER @ 50% | GP = GFCI (30mA) | ESTIMATED DEMAND: 29 kVA |
| K | KITCHEN | 0 VA | 0.00% | 0 VA | NON-DWELLING KITCHEN LOADS, NEC ART. 220 | ST = SHUNT TRIP | CONNECTED CURRENT: 102.5 A |
| M | MOTOR | 3000 VA | 100.00% | 3000 VA | LARGEST MOTOR, NEC ART. 430 | LO = LOCK OUT | EMD CURRENT: 81.2 A |
| C | COOLING | 0 VA | 0.00% | 0 VA | | | |
| H | HEATING | 0 VA | 0.00% | 0 VA | | | |
| O | OTHER | 3610 VA | 100.00% | 3610 VA | | | |
| SPARE | SPARE | 0 VA | 0.00% | 0 VA | | | |

| PANEL: L1BK | | | | | | | | | | | | | | |
|----------------------|-------------------------------|----------|---|----------|-----------------|--------------|--------------|--------------|-----------|-----------------------|---|----------|---------------------|-----|
| LOCATION: ELEC. A158 | | | | | VOLTS: 208Y/120 | | | | | MOUNTING: SURFACE | | | | |
| BUS RATING: 50 A | | | | | PHASES: 3 | | | | | FED FROM: T18 | | | | |
| MAIN BREAKER: 50 A | | | | | WIRES: 4 | | | | | INTEGRAL SPD: YES | | | | |
| SCCR: 1.3 KA | | | | | SCCR: 1.3 KA | | | | | LUG ACCESSORIES: NONE | | | | |
| CKT | CIRCUIT DESCRIPTION | BKR TRIP | P | BKR TYPE | LOAD TYPE | PHASE A (VA) | PHASE B (VA) | PHASE C (VA) | LOAD TYPE | BKR TRIP | P | BKR TYPE | CIRCUIT DESCRIPTION | CKT |
| 1 | R-IDF WEST AND EAST WALL A158 | 20 | 1 | R | R | 1,080 | 0 | | | | | | SPARE | 2 |
| 3 | R-BLDG MAIN A141 | 20 | 1 | R | R | | 720 | 0 | | | | | SPARE | 4 |
| 5 | R-IDF NORTH WALL A158 | 20 | 1 | R | R | | | 360 | 0 | | | | SPARE | 6 |
| 7 | UPS-IDF A142 | 30 | 2 | R | R | 1,500 | 0 | 1,500 | 0 | | | | SPARE | 8 |
| 9 | R-IDF A158 | 20 | 1 | R | R | | | 180 | 0 | | | | SPARE | 10 |
| 11 | R-IDF A158 | 20 | 1 | R | R | 180 | 0 | | 180 | 0 | | | SPARE | 12 |
| 13 | R-IDF A158 | 20 | 1 | R | R | | | | 180 | 0 | | | SPARE | 14 |
| 15 | R-IDF A158 | 20 | 1 | R | R | | | | | 180 | 0 | | SPARE | 16 |
| 17 | FIRE ALARM CONTROL PANEL | 20 | 1 | O | O | | | | 500 | 0 | | | SPARE | 18 |
| 19 | DOOR CONTROL PANEL | 20 | 1 | O | O | 500 | 0 | | | 0 | 0 | | SPARE | 20 |
| 21 | SPARE | 20 | 1 | SPARE | SPARE | 0 | 0 | 0 | 0 | 0 | 0 | | SPARE | 22 |
| 23 | SPARE | 20 | 1 | SPARE | SPARE | 0 | 0 | 0 | 0 | 0 | 0 | | SPARE | 24 |
| 25 | SPARE | 20 | 1 | SPARE | SPARE | 0 | 0 | 0 | 0 | 0 | 0 | | SPARE | 26 |
| 27 | SPARE | 20 | 1 | SPARE | SPARE | 0 | 0 | 0 | 0 | 0 | 0 | | SPARE | 28 |
| 29 | SPARE | 20 | 1 | SPARE | SPARE | 0 | 0 | 0 | 0 | 0 | 0 | | SPARE | 30 |
| 31 | SPARE | 20 | 1 | SPARE | SPARE | 0 | 0 | 0 | 0 | 0 | 0 | | SPARE | 32 |
| 33 | SPARE | 20 | 1 | SPARE | SPARE | 0 | 0 | 0 | 0 | 0 | 0 | | SPARE | 34 |
| 35 | SPARE | 20 | 1 | SPARE | SPARE | 0 | 0 | 0 | 0 | 0 | 0 | | SPARE | 36 |
| 37 | SPARE | 20 | 1 | SPARE | SPARE | 0 | 0 | 0 | 0 | 0 | 0 | | SPARE | 38 |
| 39 | SPARE | 20 | 1 | SPARE | SPARE | 0 | 0 | 0 | 0 | 0 | 0 | | SPARE | 40 |
| 41 | SPARE | 20 | 1 | SPARE | SPARE | 0 | 0 | 0 | 0 | 0 | 0 | | SPARE | 42 |
| TOTAL LOAD: | | | | | | 3280 VA | 2400 VA | 1040 VA | | | | | | |
| TOTAL AMPS: | | | | | | 28.9 A | 21.7 A | 8.7 A | | | | | | |

| LOAD TYPE | LOAD DESCRIPTION | CONNECTED LOAD (VA) | DEMAND FACTOR | ESTIMATED DEMAND (VA) | DEMAND FACTOR NOTES | BKR TYPE | PANEL TOTALS |
|-----------|------------------|---------------------|---------------|-----------------------|--|------------------|---------------------------|
| L | LIGHTING | 0 VA | 0.00% | 0 VA | CONTINUOUS LOAD @ 125% | G = GFCI (5mA) | CONNECTED LOAD: 7 kVA |
| R | RECEPTACLES | 5700 VA | 100.00% | 5700 VA | FIRST 10kVA @ 100%, REMAINDER @ 50% | GP = GFCI (30mA) | ESTIMATED DEMAND: 7 kVA |
| K | KITCHEN | 0 VA | 0.00% | 0 VA | NON-DWELLING KITCHEN LOADS, NEC ART. 220 | ST = SHUNT TRIP | CONNECTED CURRENT: 18.6 A |
| M | MOTOR | 0 VA | 0.00% | 0 VA | LARGEST MOTOR, NEC ART. 430 | LO = LOCK OUT | EMD CURRENT: 18.6 A |
| C | COOLING | 0 VA | 0.00% | 0 VA | | | |
| H | HEATING | 0 VA | 0.00% | 0 VA | | | |
| O | OTHER | 1000 VA | 100.00% | 1000 VA | | | |
| SPARE | SPARE | 0 VA | 0.00% | 0 VA | | | |

| CKT | CIRCUIT DESCRIPTION | BKR TRIP | P | BKR TYPE | LOAD TYPE | PHASE A (VA) | PHASE B (VA) | PHASE C (VA) | LOAD TYPE | BKR TRIP | P | BKR TYPE | CIRCUIT DESCRIPTION | CKT |
|-------------|--|----------|---|----------|-----------|--------------|--------------|--------------|-----------|----------|---|----------|-------------------------------|-----|
| 1 | EXISTING - LTG-F110,MRS | -- | 1 | 20 | -- | -- | -- | -- | | 20 | 1 | -- | EXISTING - LTG-G114,F107 | 2 |
| 3 | EXISTING - LTG-G101,G104-G108 | -- | 1 | 20 | -- | -- | -- | -- | | 20 | 1 | -- | EXISTING - CORRIDIOR LTG | 4 |
| 5 | EXISTING - LTG-G111,G112,G113 | -- | 1 | 20 | -- | -- | -- | -- | | 20 | 1 | -- | EXISTING - LTG-G102,G103,G110 | 6 |
| 7 | EXISTING - LTG-F113 | -- | 1 | 20 | -- | -- | -- | -- | | 20 | 1 | -- | EXISTING - LTG-CAFETERIUM | 8 |
| 9 | EXISTING - LTG-CAFETERIUM | -- | 1 | 20 | -- | -- | -- | -- | | 20 | 1 | -- | EXISTING - LTG-CAFETERIUM | 10 |
| 11 | EXISTING - LTG-F116,F118,F120,F121, SNAC | -- | 1 | 20 | -- | -- | -- | -- | | 20 | 1 | -- | EXISTING - LTG-CAFETERIUM | 12 |
| 13 | EXISTING - LTG-KITCHEN | -- | 1 | 20 | -- | -- | -- | -- | | 20 | 1 | -- | EXISTING - LTG-STAGE | 14 |
| 15 | L-BANDROOM,PERCUSSION (1) | 20 | 1 | L | L | | 3,351 | | | 0 | | | EXISTING - CRAC- | 16 |
| 17 | SPARE | 20 | 1 | SPARE | SPARE | 0 | 0 | 0 | 0 | 0 | 0 | | EXISTING - CAFETERIA | 18 |
| 19 | SPARE | 20 | 1 | SPARE | SPARE | 0 | 0 | 0 | 0 | 0 | 0 | | EXISTING - CAFETERIA | 20 |
| 21 | SPARE | 25 | 1 | SPARE | SPARE | 0 | 0 | 0 | 0 | 0 | 0 | | SPARE | 22 |
| 23 | SPARE | -- | 1 | SPARE | SPARE | 0 | 0 | 0 | 0 | 0 | 0 | | SPARE | 24 |
| 25 | SPARE | -- | 1 | SPARE | SPARE | 0 | 0 | 0 | 0 | 0 | 0 | | SPARE | 26 |
| 27 | SPARE | -- | 1 | SPARE | SPARE | 0 | 0 | 0 | 0 | 0 | 0 | | SPARE | 28 |
| 29 | SPARE | -- | 1 | SPARE | SPARE | 0 | 0 | 0 | 0 | 0 | 0 | | SPARE | 30 |
| 31 | SPARE | -- | 1 | SPARE | SPARE | 0 | 0 | 0 | 0 | 0 | 0 | | SPARE | 32 |
| 33 | SPARE | -- | 1 | SPARE | SPARE | 0 | 0 | 0 | 0 | 0 | 0 | | SPARE | 34 |
| 35 | SPARE | -- | 1 | SPARE | SPARE | 0 | 0 | 0 | 0 | 0 | 0 | | SPARE | 36 |
| 37 | SPARE | -- | 1 | SPARE | SPARE | 0 | 0 | 0 | 0 | 0 | 0 | | SPARE | 38 |
| 39 | SPARE | -- | 1 | SPARE | SPARE | 0 | 0 | 0 | 0 | 0 | 0 | | SPARE | 40 |
| 41 | SPARE | -- | 1 | SPARE | SPARE | 0 | 0 | 0 | 0 | 0 | 0 | | SPARE | 42 |
| TOTAL LOAD: | | | | | | 8 VA | 3351 VA | 0 VA | | | | | | |
| TOTAL AMPS: | | | | | | 0.0 A | 12.1 A | 0.0 A | | | | | | |

| PANEL: MH1K | | | | | | | | | | | | | | |
|----------------------|---------------------|----------|---|----------|-----------------|--------------|--------------|--------------|-----------|-----------------------|---|----------|---------------------|-----|
| LOCATION: ELEC. A160 | | | | | VOLTS: 480Y/277 | | | | | MOUNTING: SURFACE | | | | |
| BUS RATING: 400 A | | | | | PHASES: 3 | | | | | FED FROM: DP1K | | | | |
| MAIN BREAKER: 400 A | | | | | WIRES: 4 | | | | | INTEGRAL SPD: NO | | | | |
| SCCR: 23.9 KA | | | | | SCCR: 23.9 KA | | | | | LUG ACCESSORIES: NONE | | | | |
| CKT | CIRCUIT DESCRIPTION | BKR TRIP | P | BKR TYPE | LOAD TYPE | PHASE A (VA) | PHASE B (VA) | PHASE C (VA) | LOAD TYPE | BKR TRIP | P | BKR TYPE | CIRCUIT DESCRIPTION | CKT |
| 1 | VAV-1 | 20 | 1 | M | M | 4,011 | 9,339 | | | | | | RTU-2 | 2 |
| 3 | VAV-2 | 15 | 1 | M | M | | 997 | 9,339 | | | | | RTU-2 | 4 |
| 5 | VAV-3 | 15 | 1 | M | M | | | 997 | 9,339 | | | | RTU-2 | 6 |
| 7 | VAV-4 | 15 | 1 | M | M | 2,554 | 7,676 | | | | | | | |

